

INDEX TO DRAWINGS	
SHEET NO	DESCRIPTION
1	TITLE SHEET
2	PLAN
3	STRIPING PLAN, NOTES AND DETAILS
4	MISC., CROSSWALK AND STRIPING DETAILS
5-II	STANDARD DETAILS

STATE OF HAWAII

DEPARTMENT OF TRANSPORTATION

LAND TRANSPORTATION FACILITIES DIVISION

HONOLULU, HAWAII

"AS BUILT"

PLANS FOR

PUUNENE AVENUE


TRAFFIC SIGNALS AT KAMEHAMEHA AVENUE

PROJ. NO. 350A-01-76

DISTRICT OF WAILUKU


ISLAND OF MAUI

LOCATION OF PROJECT

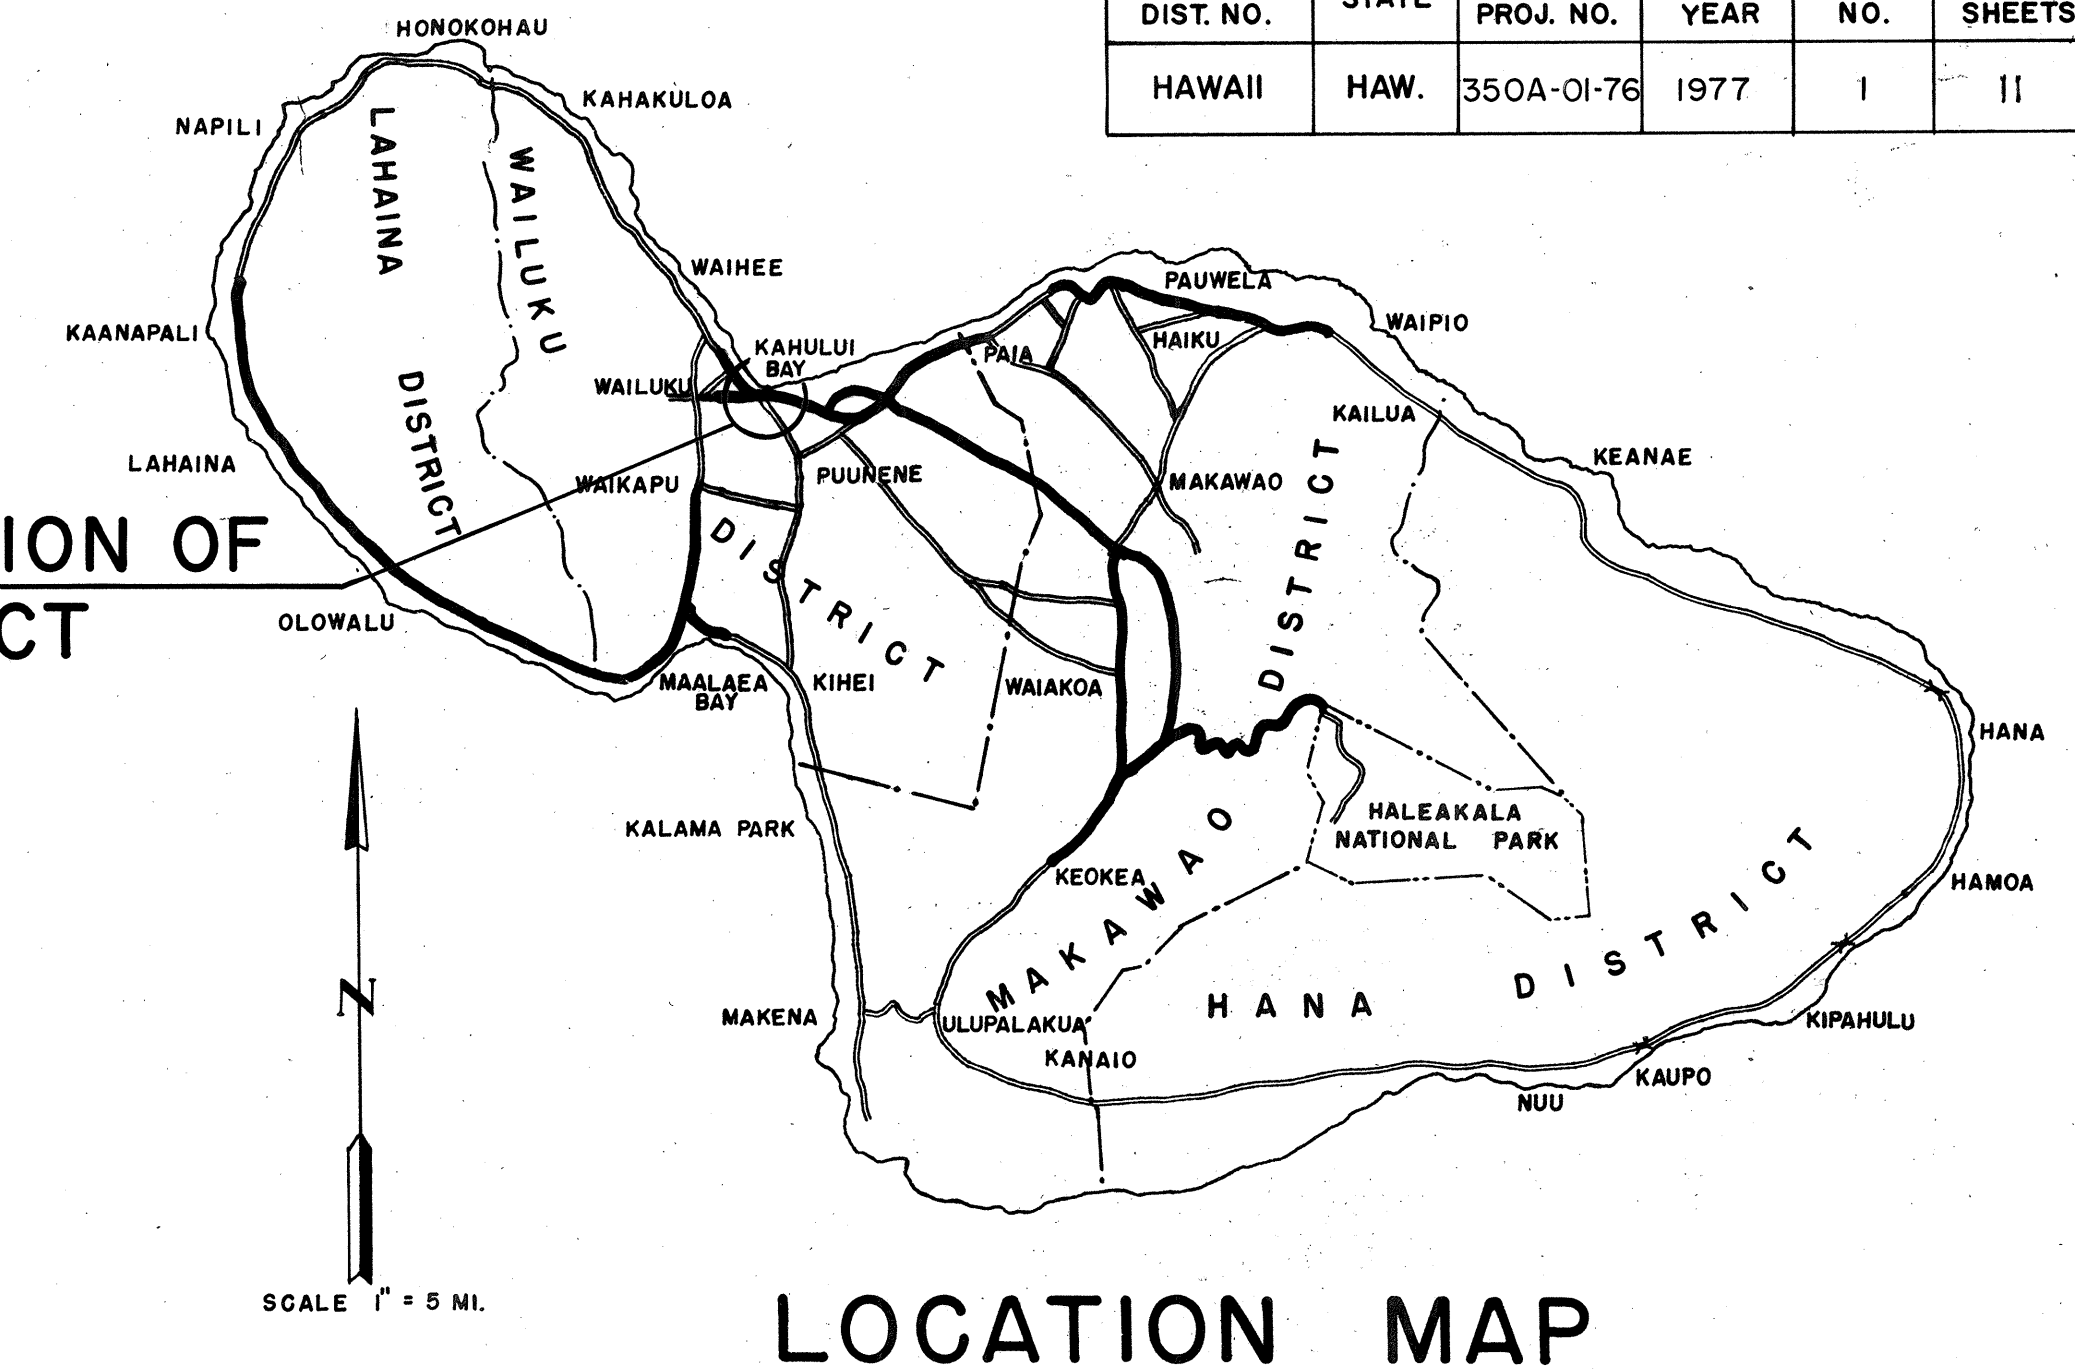

— FEDERAL AID PROJECTS PREVIOUSLY CONSTRUCTED OR UNDER CONSTRUCTION

FED. ROAD DIST. NO.	STATE	PROJ. NO.	FISCAL YEAR	SHEET NO.	TOTAL SHEETS
HAWAII	HAW.	350A-01-76	1977	1	11

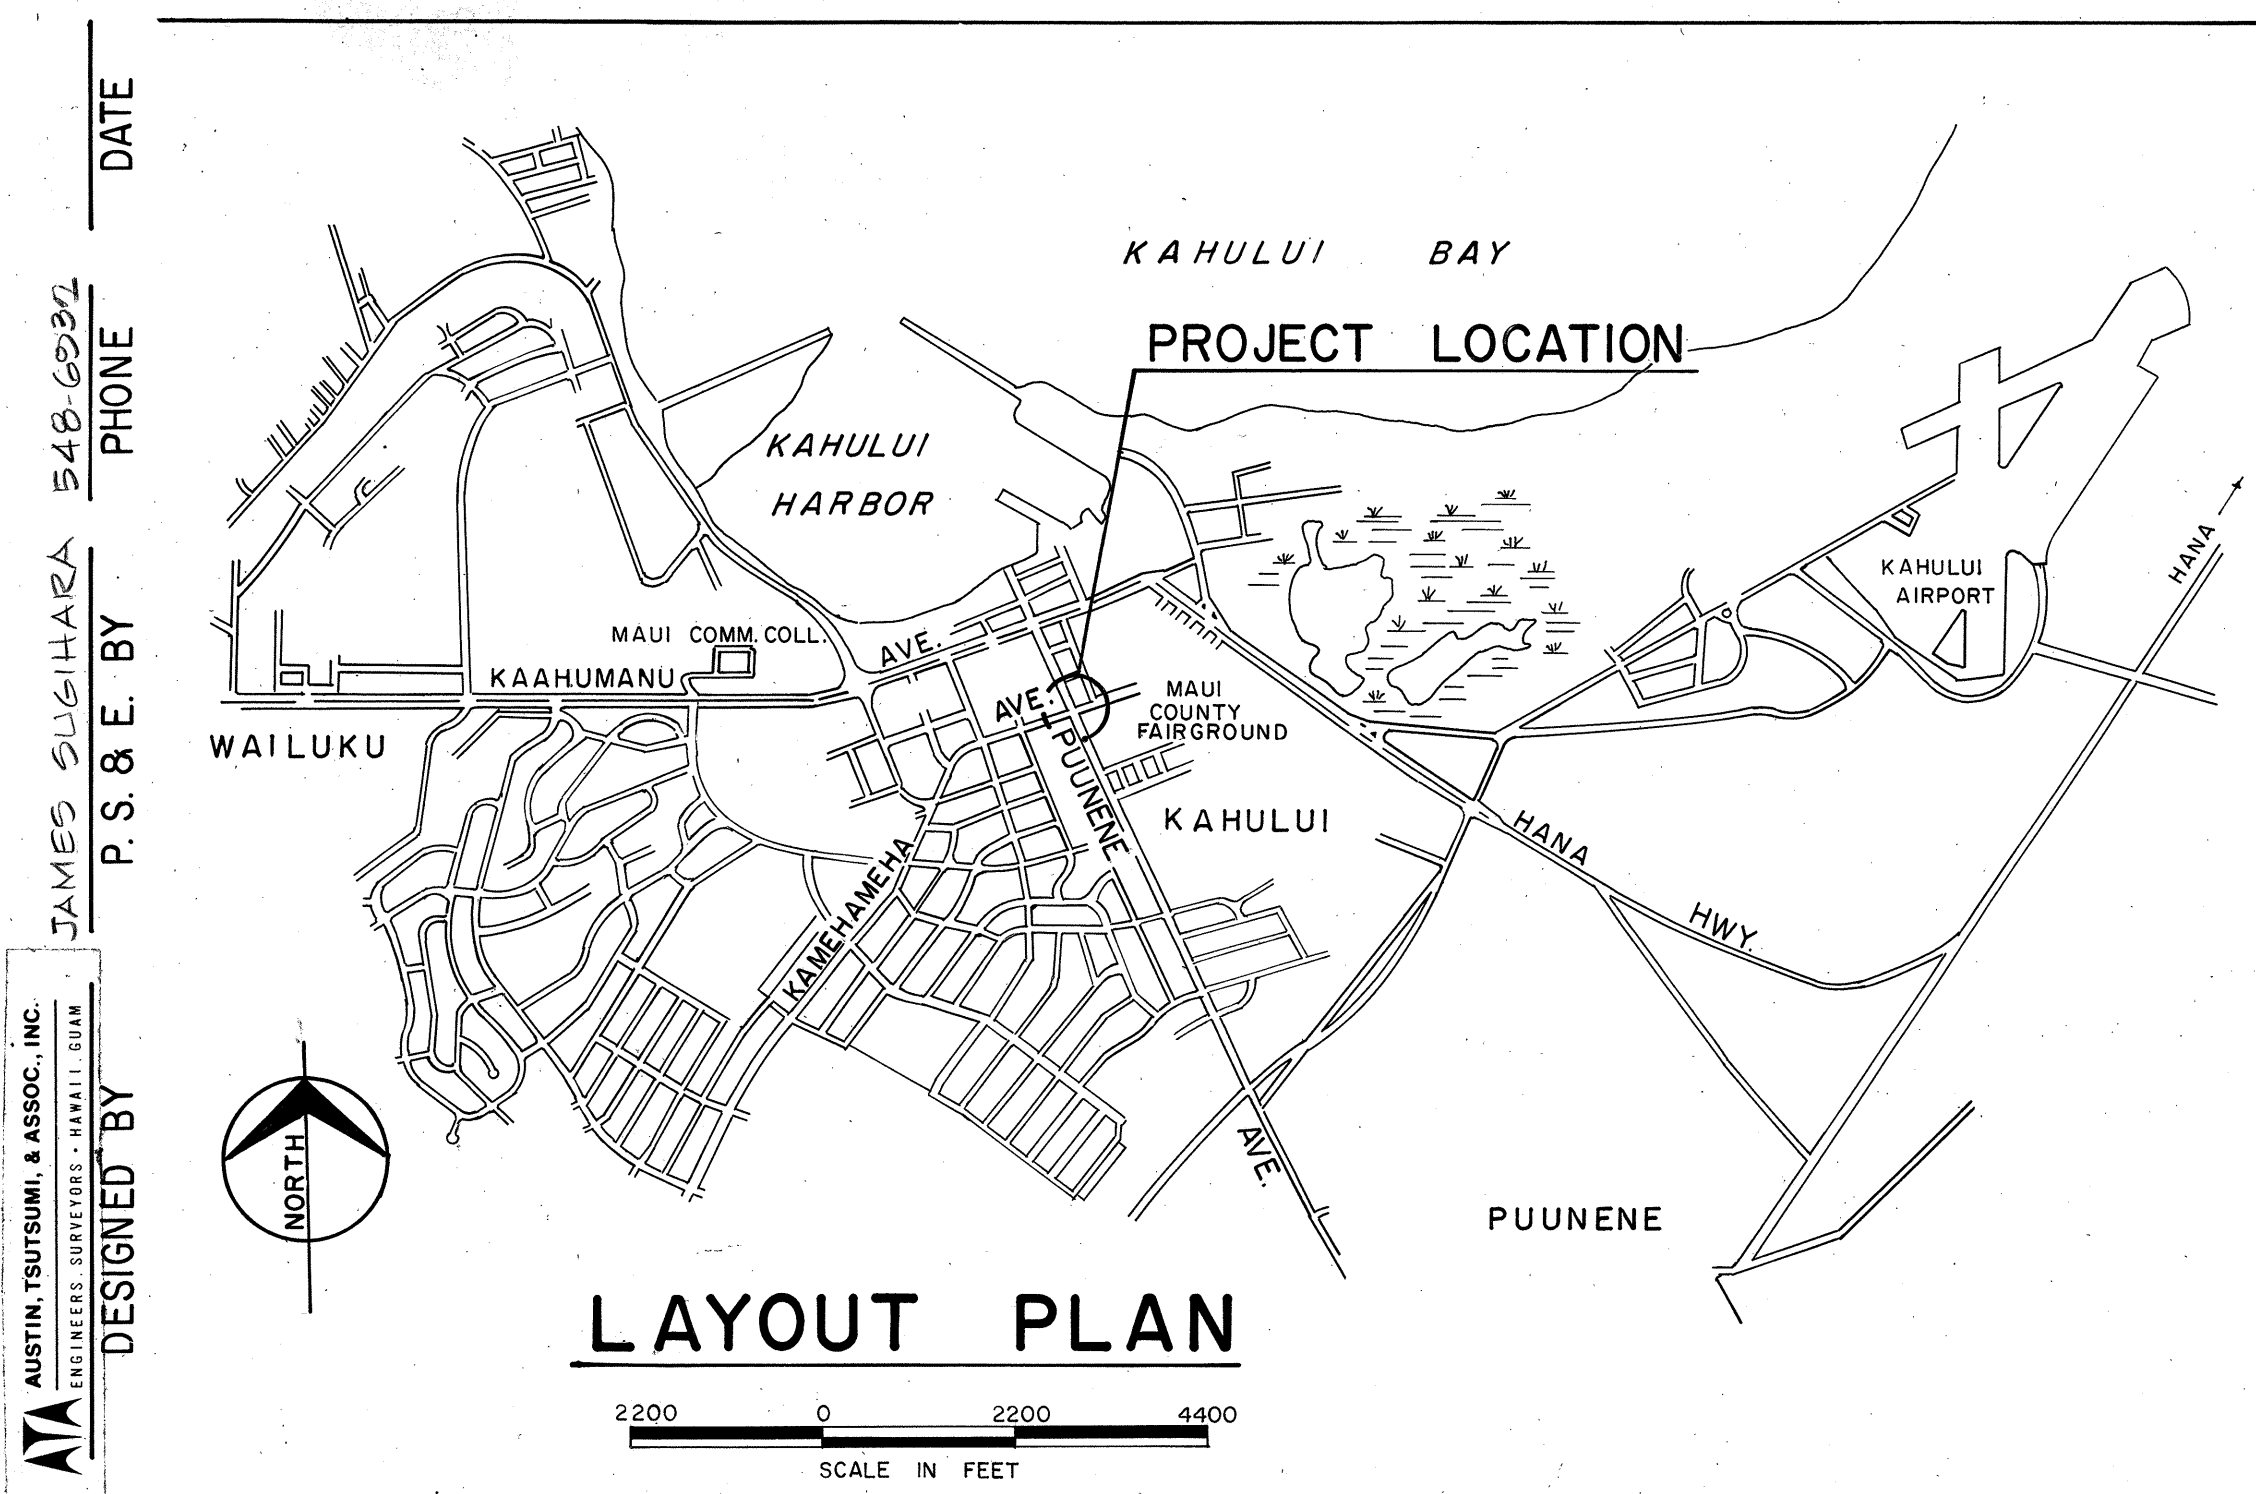

NO AS-BUILT CHANGES
MADE DURING CONSTRUCTION.

Manuel J. Silva 1 Dec 81
PROJECT ENGINEER DATE

DESIGN CLASSIFICATION	
ADT (1976)	11,920
ADT (1996)	19,630
DHV	1,590
D	50/50
T	3.5%
T24	4.0%
V	35 MPH

DEPARTMENT OF TRANSPORTATION STATE OF HAWAII	
APPROVED:	
<i>R. Higashionna</i>	9-2-77
for DIR. OF TRANSPORTATION	DATE

DESIGNED BY
JAMES SUGIHARA
P. S. & E. BY
548-6932
PHONE
DATE