


FED. ROAD DIST. NO.	STATE	FED. AID PROJ. NO.	FISCAL YEAR	SHEET NO.	TOTAL SHEETS
HAWAII	HAW.	MG-3500(2)	1980	7	16

LEGEND:

- | | |
|--|---|
| | Construct Modified Type E Wheelchair Ramp |
| | Construct Type A Wheelchair Ramp |
| | Construct Type D Wheelchair Ramp |
| | New or Reconstructed PCC Sidewalk w/Type 2D or Modified Type 2D Curbing |
| | Existing PCC Sidewalk to Remain |
| | pp Existing Power Pole |
| | fh Existing Fire Hydrant |
| | Existing Pole with Anchor |
| | smh Existing Sewer Manhole |
| | wmh Existing Water Manhole |
| | wv Existing Water Valve |
| | pbx Existing Traffic Signal Pullbox |
| | htbx Existing Hawaiian Telephone Co. Pullbox |
| | mon Existing Survey Monument |
| | t Existing Telephone Line |
| | w-6 Existing Water Line |
| | A-8 Existing Sewer Line |
| | e Existing Electric Line |
| | ED-24 Existing Drain Line |
| | cdi Existing Concrete Drop Intake |
| | cb Existing Catch Basin |
| | dmh Existing Drain Manhole |
| | pp Existing Power Pole To Be Removed |
| | PP New Power Pole |
| | EHH New Electric Handhole |
| | EMH New Electric Manhole |

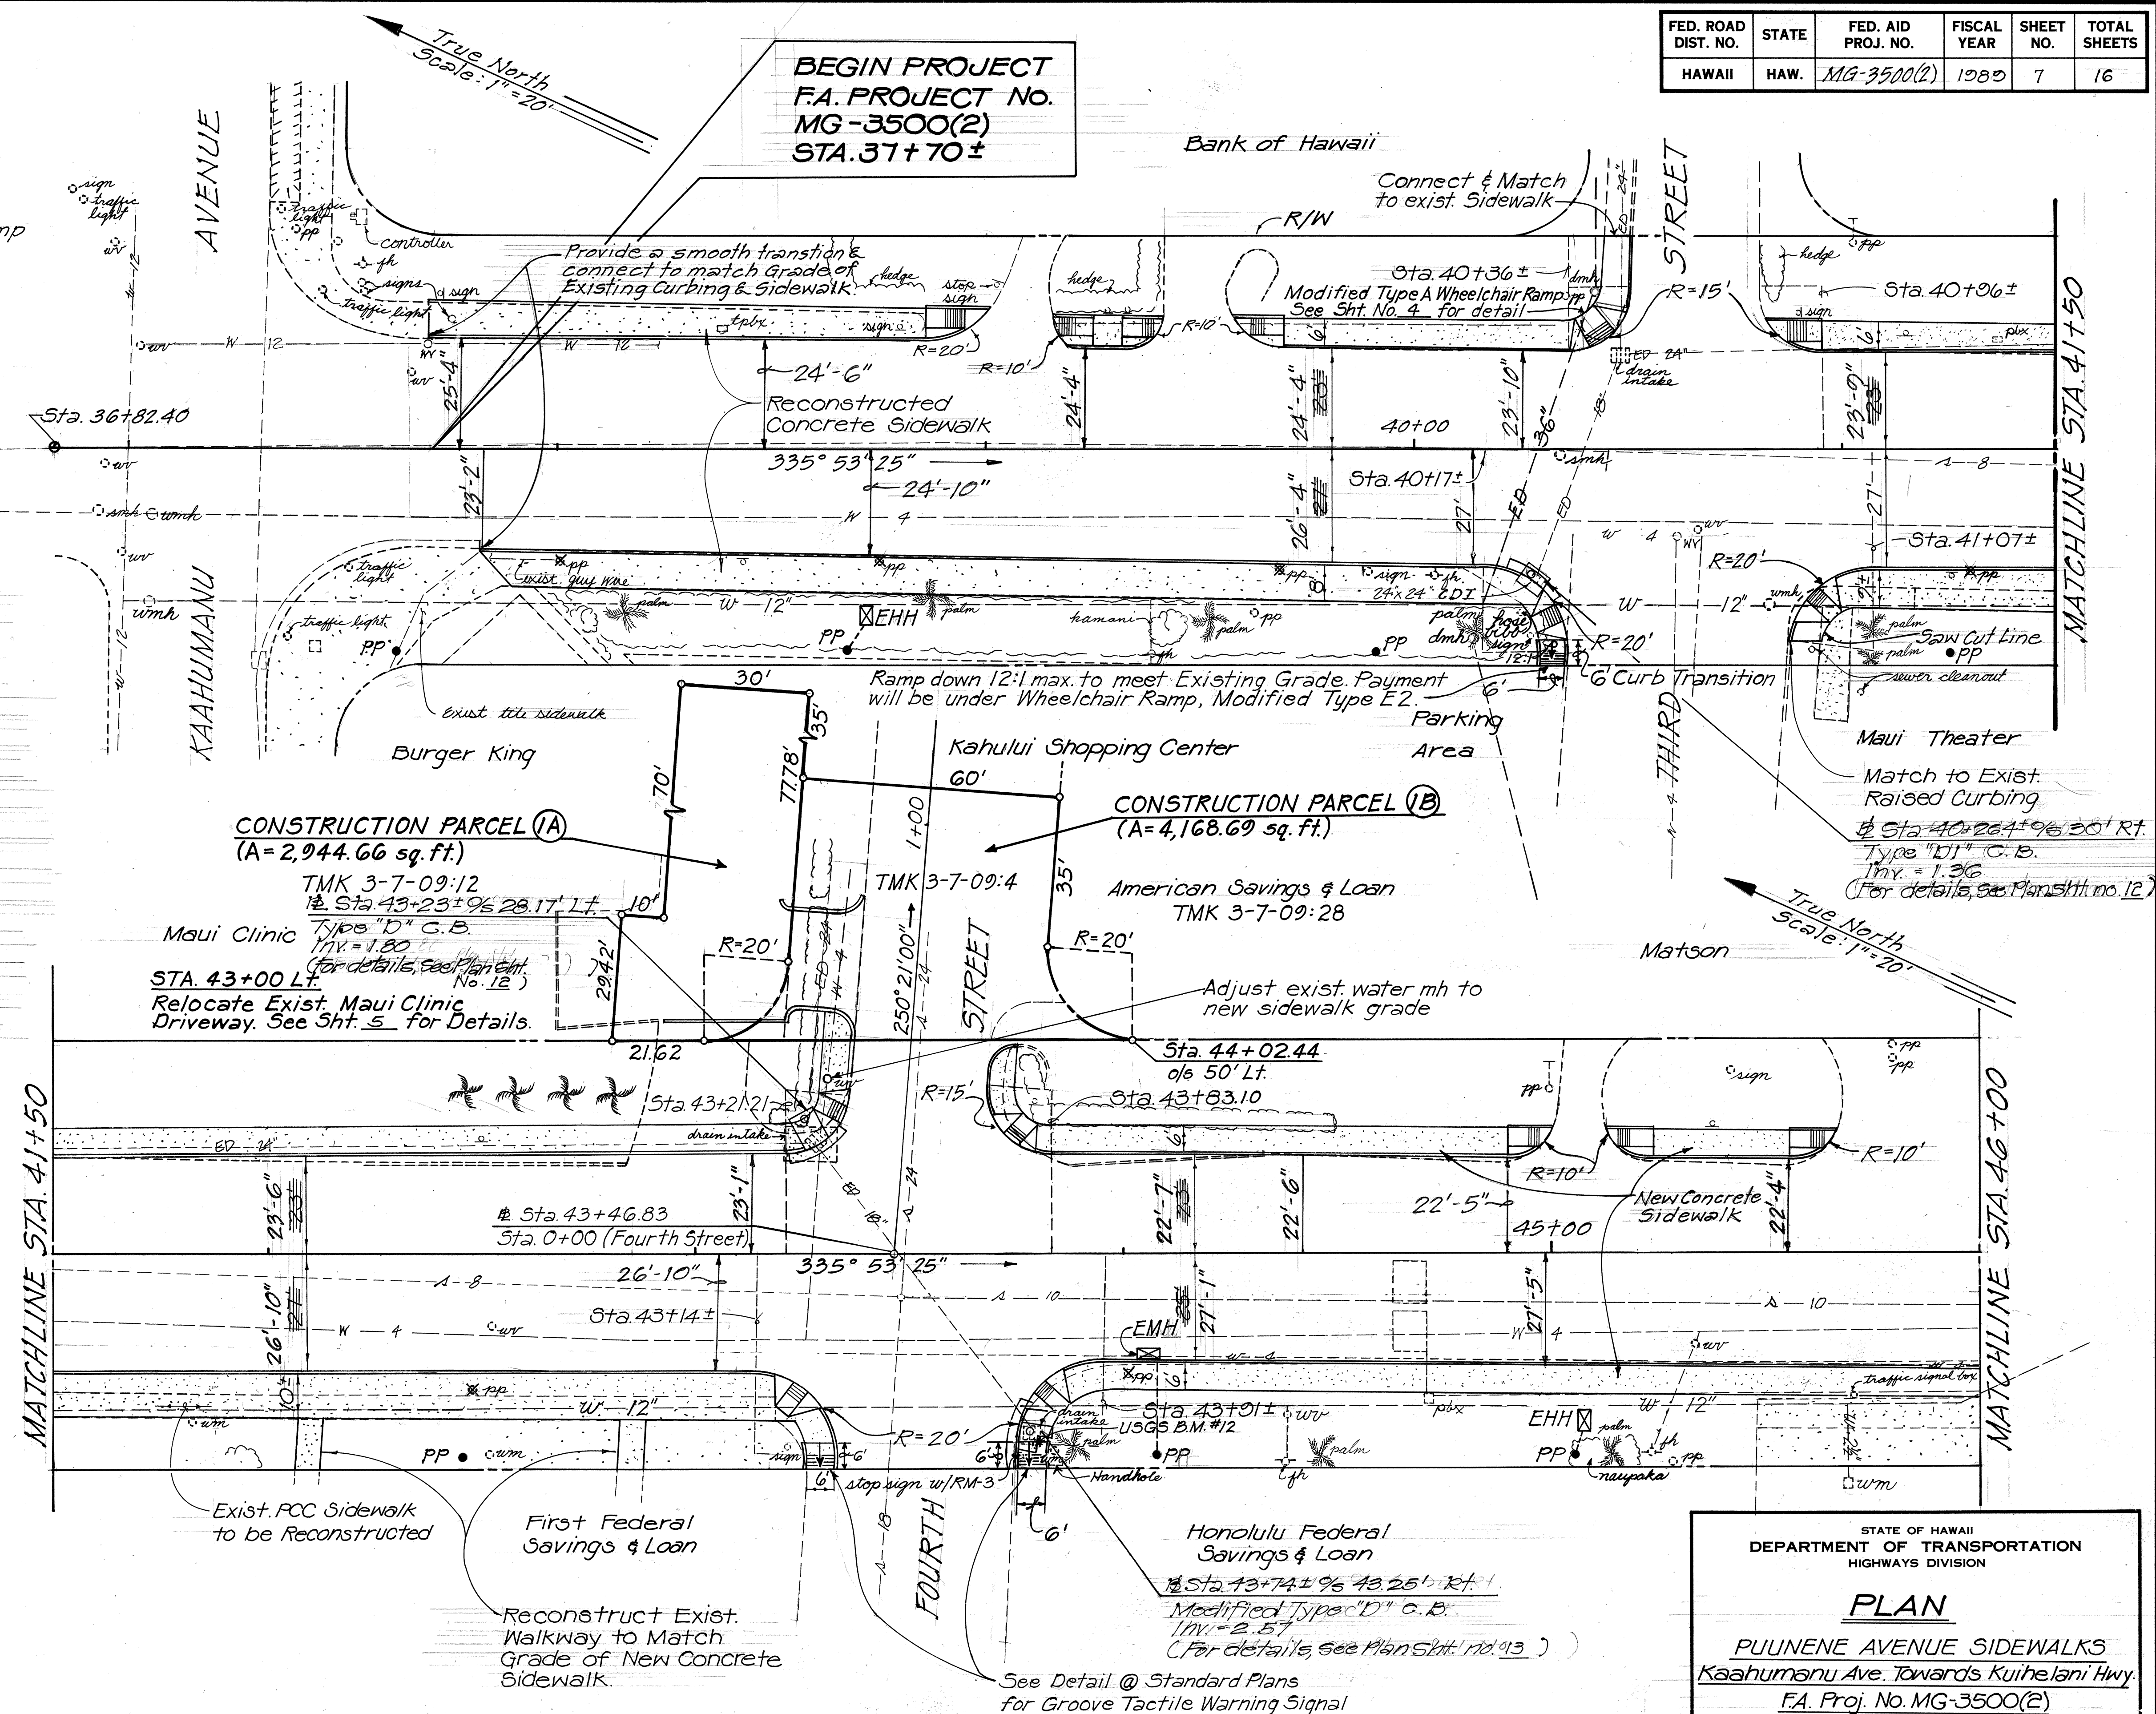

ORIGINAL PLAN	SURVEY PLOTTED BY _____ DATE _____
NOTE BOOK	DRAWN BY _____
	TRACED BY _____
	DESIGNED BY _____
	QUANTITIES BY _____
No. _____	CHECKED BY _____

STATE OF HAWAII
DEPARTMENT OF TRANSPORTATION
HIGHWAYS DIVISION


PLAN

PUUNENE AVENUE SIDEWALKS
Kaahumanu Ave. Towards Kulihehane Hwy.
F.A. Proj. No. MG-3500(2)

Scale: 1" = 20' Date: May, 1988

SHEET NO. 1 OF 5 SHEETS

FED. ROAD DIST. NO.	STATE	FED. AID PROJ. NO.	FISCAL YEAR	SHEET NO.	TOTAL SHEETS
HAWAII	HAW.	MG-3500(2)	1983	8	16

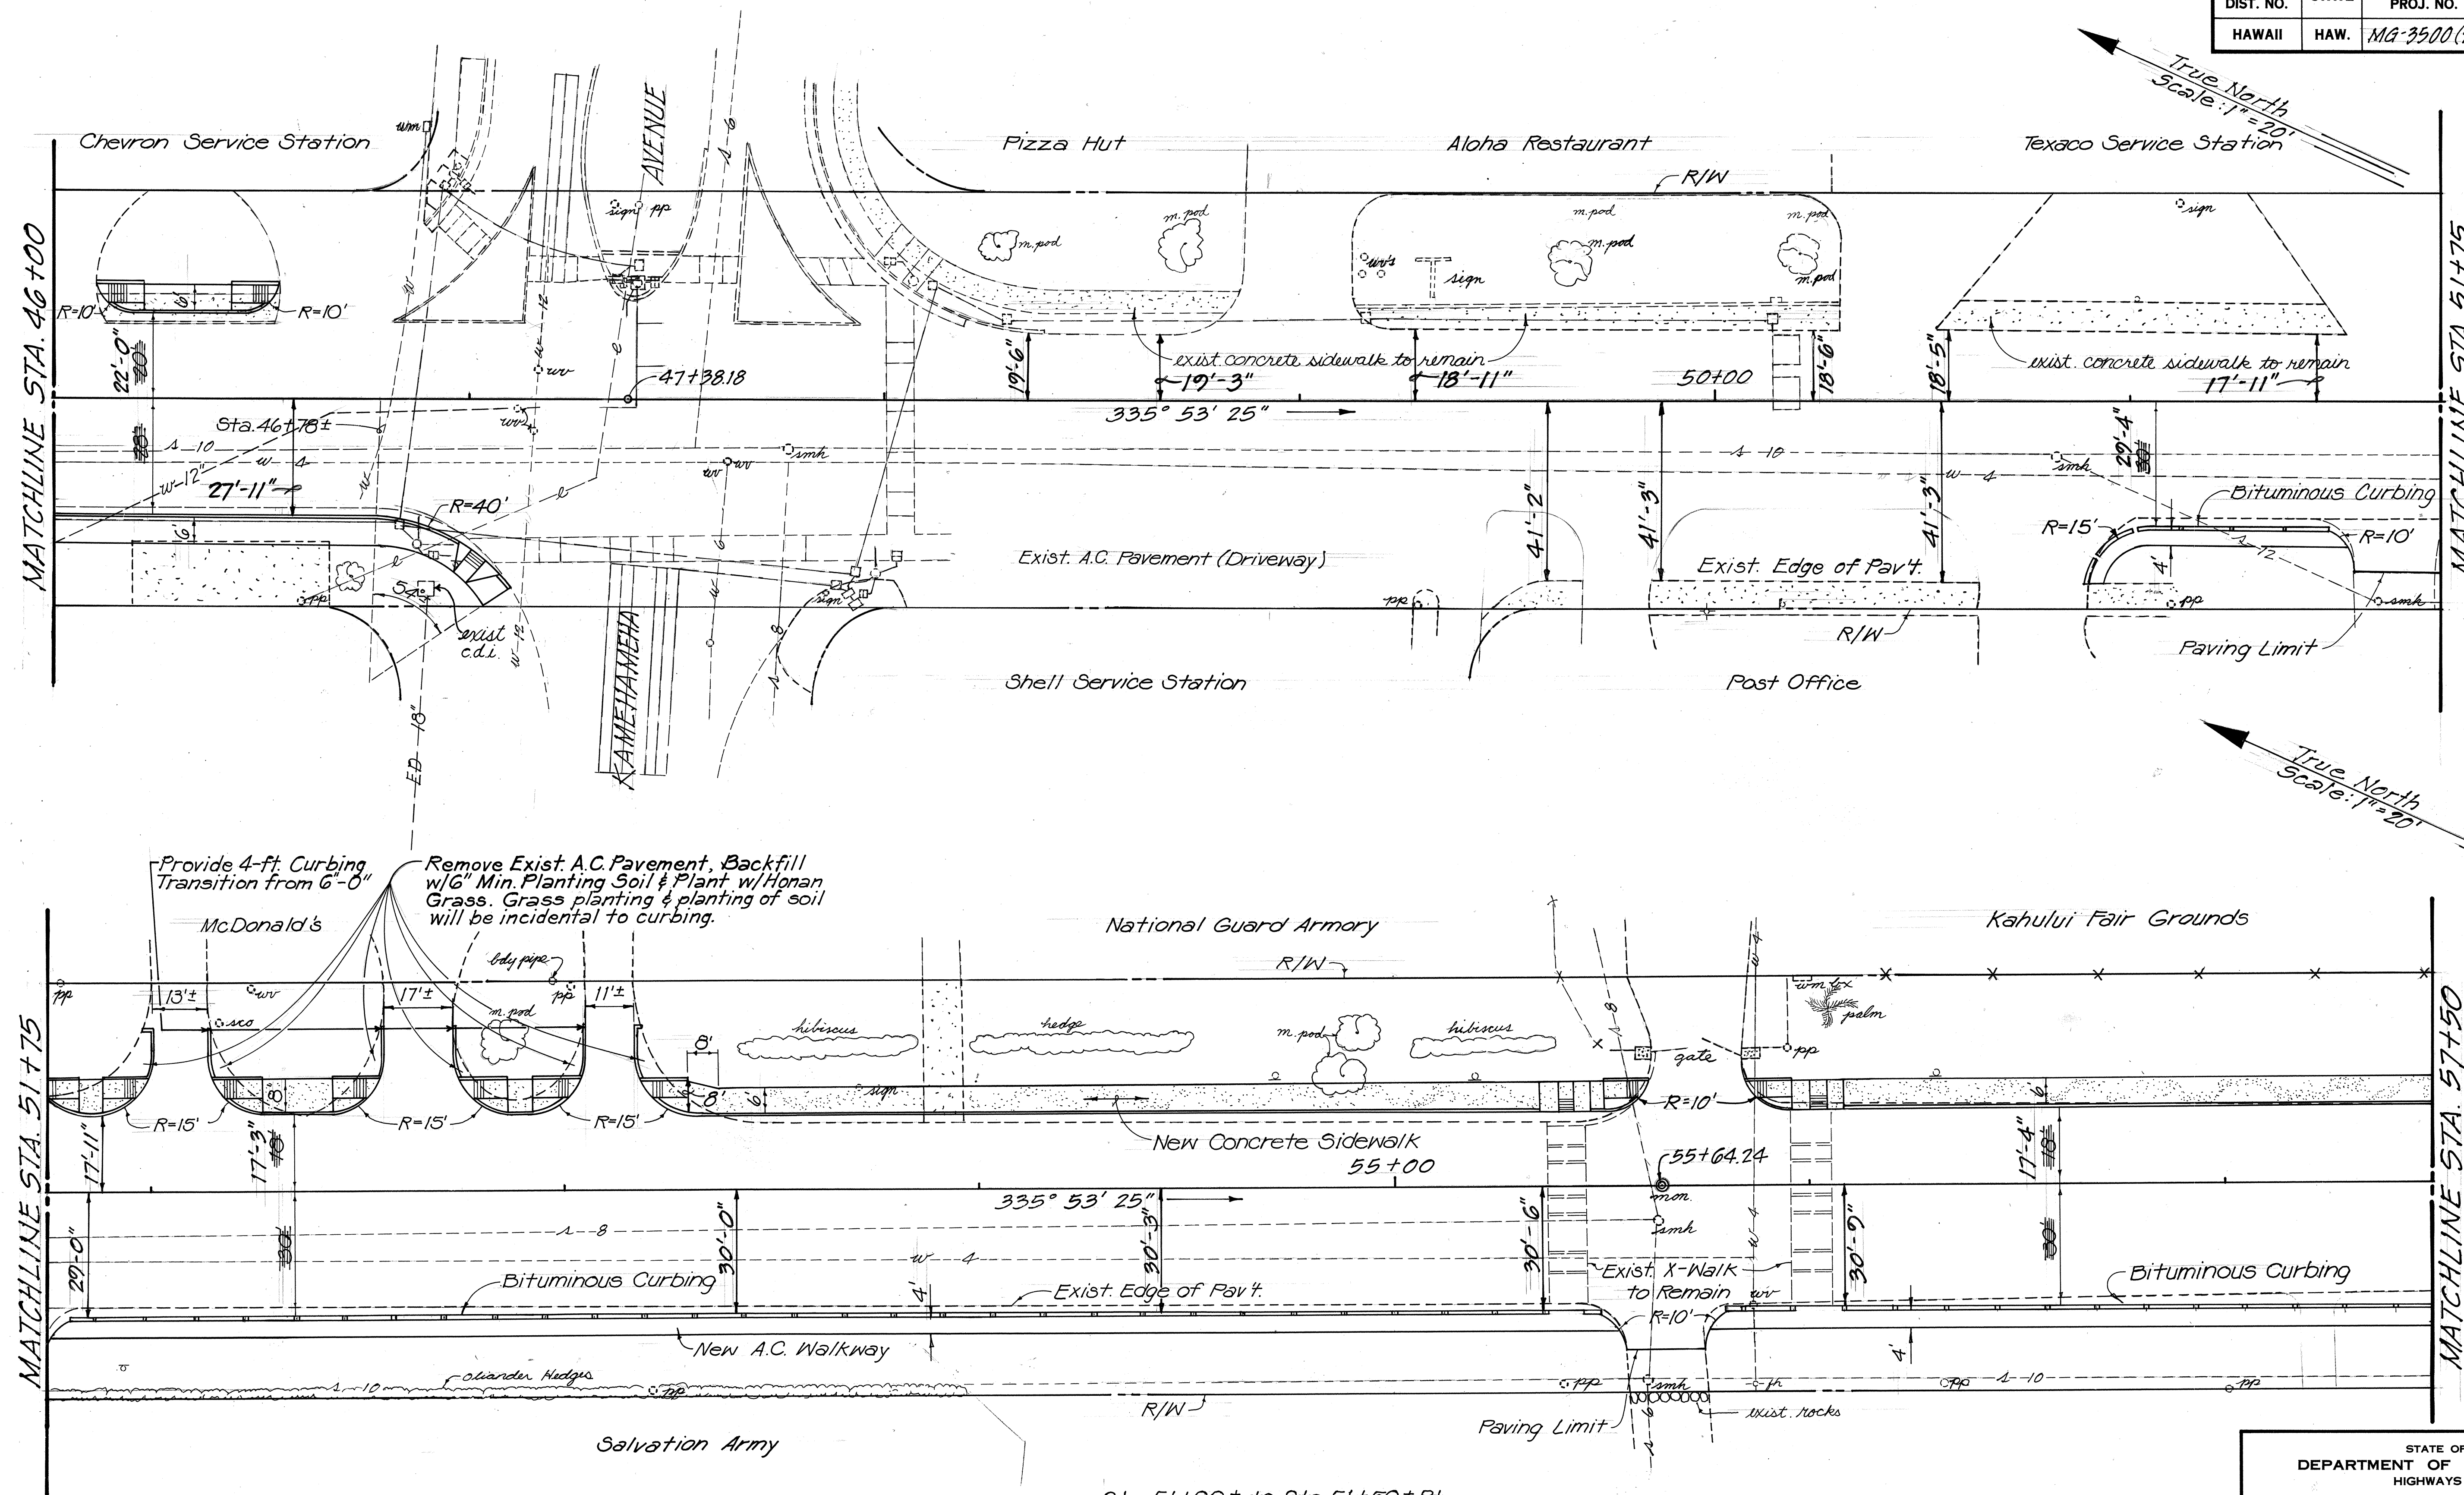

Provide 4-ft. Curbing Transition from 6'-0"

Remove Exist. A.C. Pavement, Backfill w/6" Min. Planting Soil & Plant w/Honan Grass. Grass planting & planting of soil will be incidental to curbing.

Sta 51+00± to Sta 51+50± Rt.
Sta 51+80± to Sta 55+50± Rt.
Construct 37'± Lt. of
Curb, Type G (Bituminous Curb)
For Details, see sht. 4 & the
Standard Plan.

STATE OF HAWAII
DEPARTMENT OF TRANSPORTATION
HIGHWAYS DIVISION


PLAN

Puunene Avenue Sidewalks
Kaahumanu Ave. Towards Kihelani Hwy
F.A. Proj. No MG-3500(2)

Scale: 1"=20' Date: May, 1983

SHEET No. 2 OF 5 SHEETS

FED. ROAD DIST. NO.	STATE	FED. AID PROJ. NO.	FISCAL YEAR	SHEET NO.	TOTAL SHEETS
HAWAII	HAW.	MG-3500(2)	1989	9	16

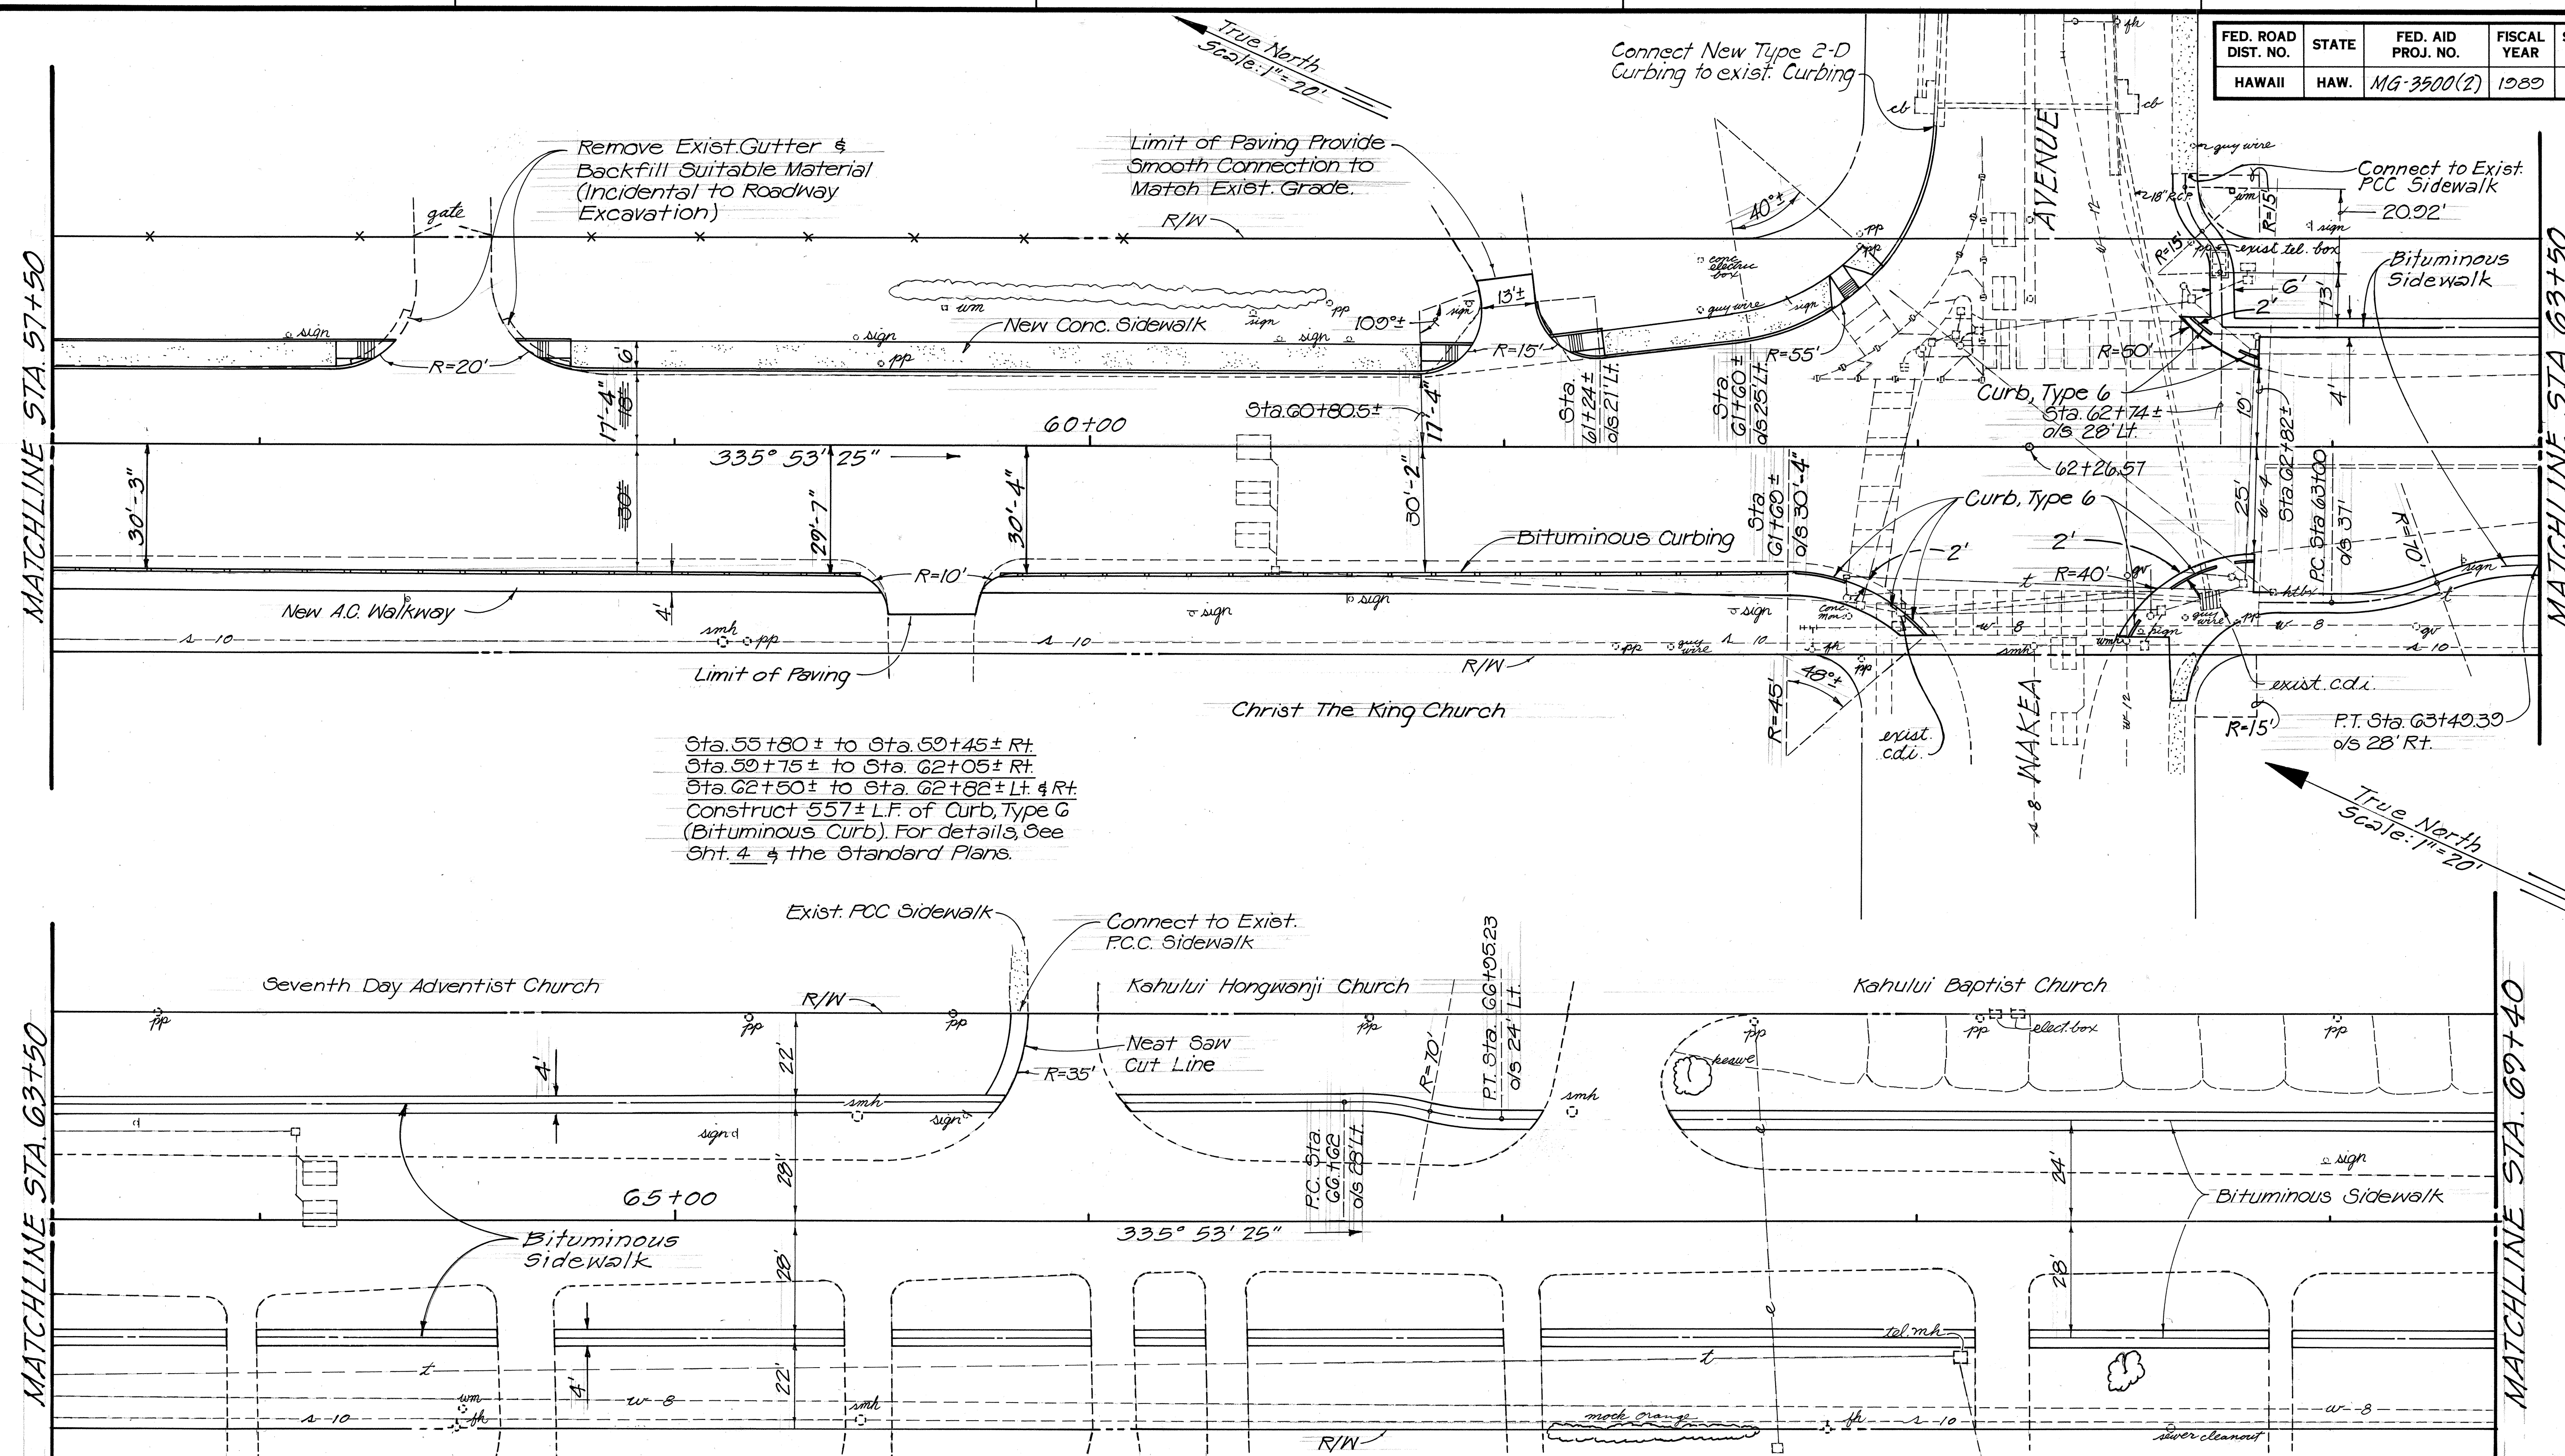

DATE	
SURVEY PLOTTED BY	
DESIGNED BY	
TRACED BY	
NOTE BOOK	
QUANTITIES BY	
CHECKED BY	

APPROVED:
Brian Hashiro
 For DIRECTOR, DEPARTMENT OF PUBLIC WORKS
 COUNTY OF MAUI

20 Oct. 1988
 DATE

STATE OF HAWAII
 DEPARTMENT OF TRANSPORTATION
 HIGHWAYS DIVISION


PLAN

PUUNENE AVENUE SIDEWALKS
 Kaahumanu Ave. Towards Kiihelani Hwy.
 F.A. Proj. No. MG-3500(2)

Scale: 1"=20' Date: May, 1988

SHEET NO. 9 OF 5 SHEETS

FED. ROAD DIST. NO.	STATE	FED. AID PROJ. NO.	FISCAL YEAR	SHEET NO.	TOTAL SHEETS
HAWAII	HAW.	MG-3500(2)	1980	10	16

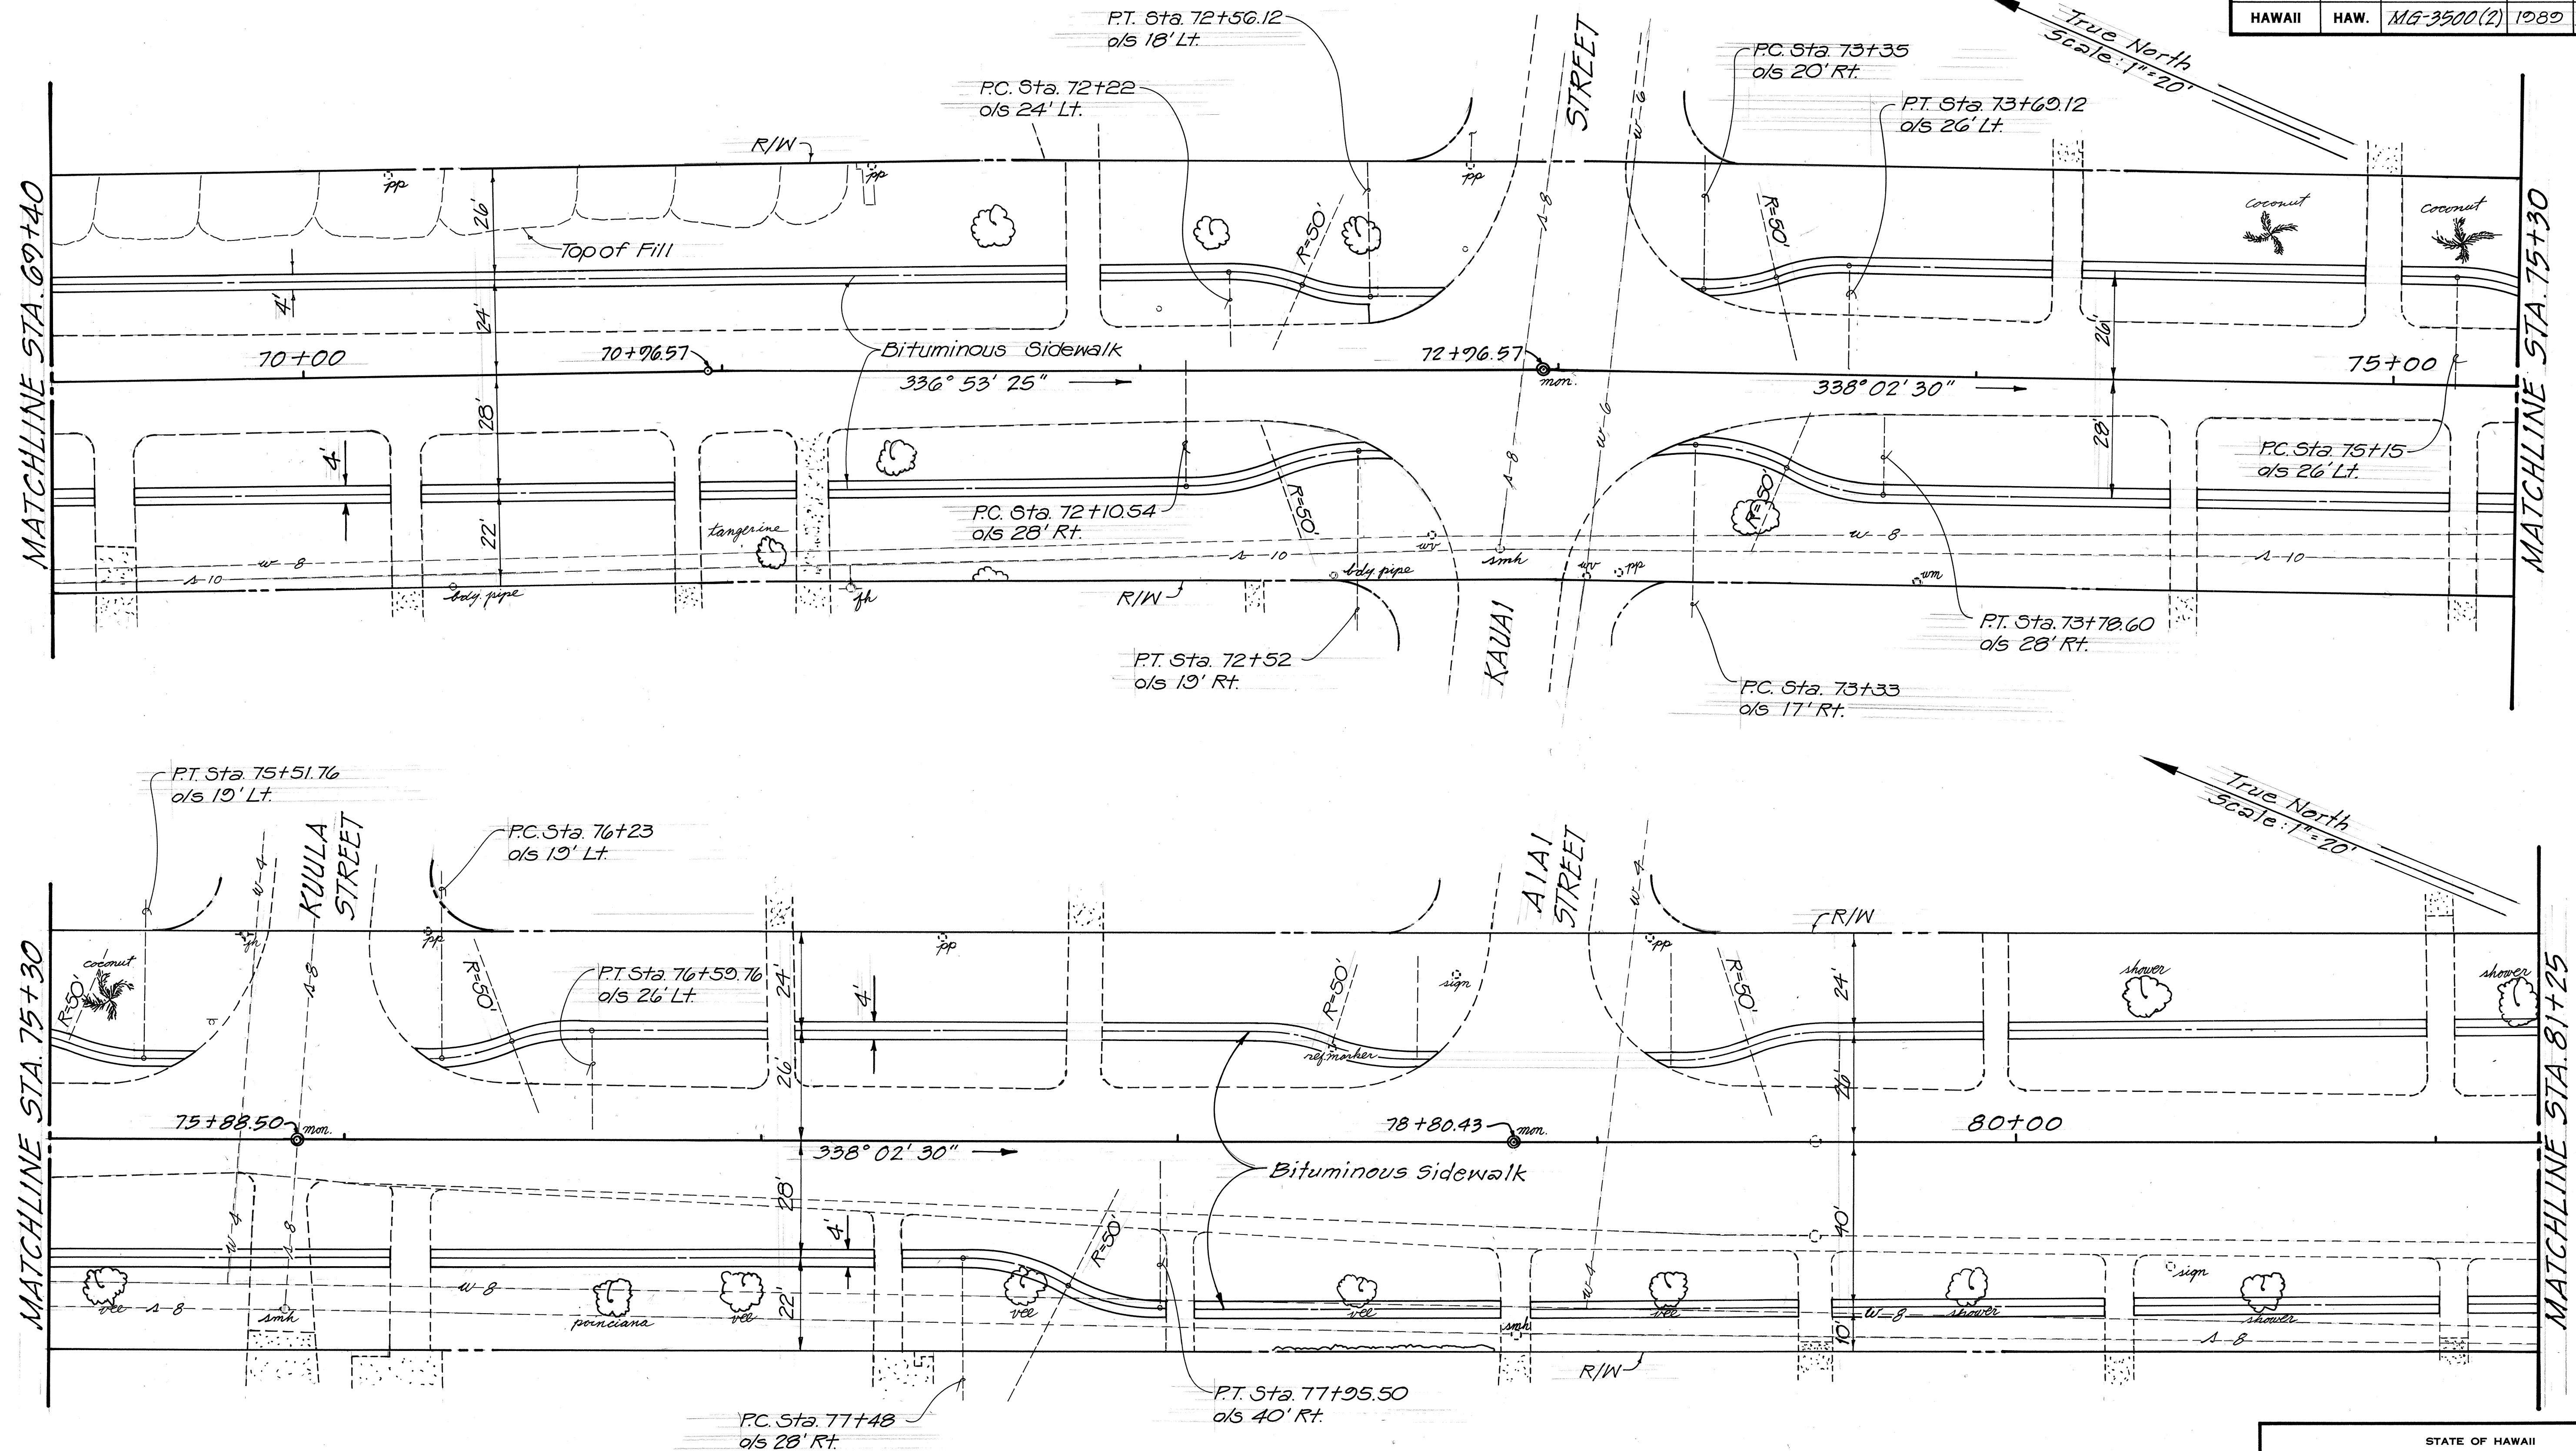

DATE	_____
SURVEY PLOTTED BY	_____
DESIGNED BY	_____
TRACED BY	_____
NOTED BY	_____
CHECKED BY	_____
NO.	_____

STATE OF HAWAII
DEPARTMENT OF TRANSPORTATION
HIGHWAYS DIVISION


PLAN

PUUNENE AVENUE SIDEWALKS
Kaahumanu Ave Towards Kiihelani Hwy.
F.A. Proj. No. MG-3500(2)

Scale: 1"=20' Date: May, 1980

SHEET NO. 4 OF 5 SHEETS

FED. ROAD DIST. NO.	STATE	FED. AID PROJ. NO.	FISCAL YEAR	SHEET NO.	TOTAL SHEETS
HAWAII	HAW.	MG-3500(2)	1989	11	16

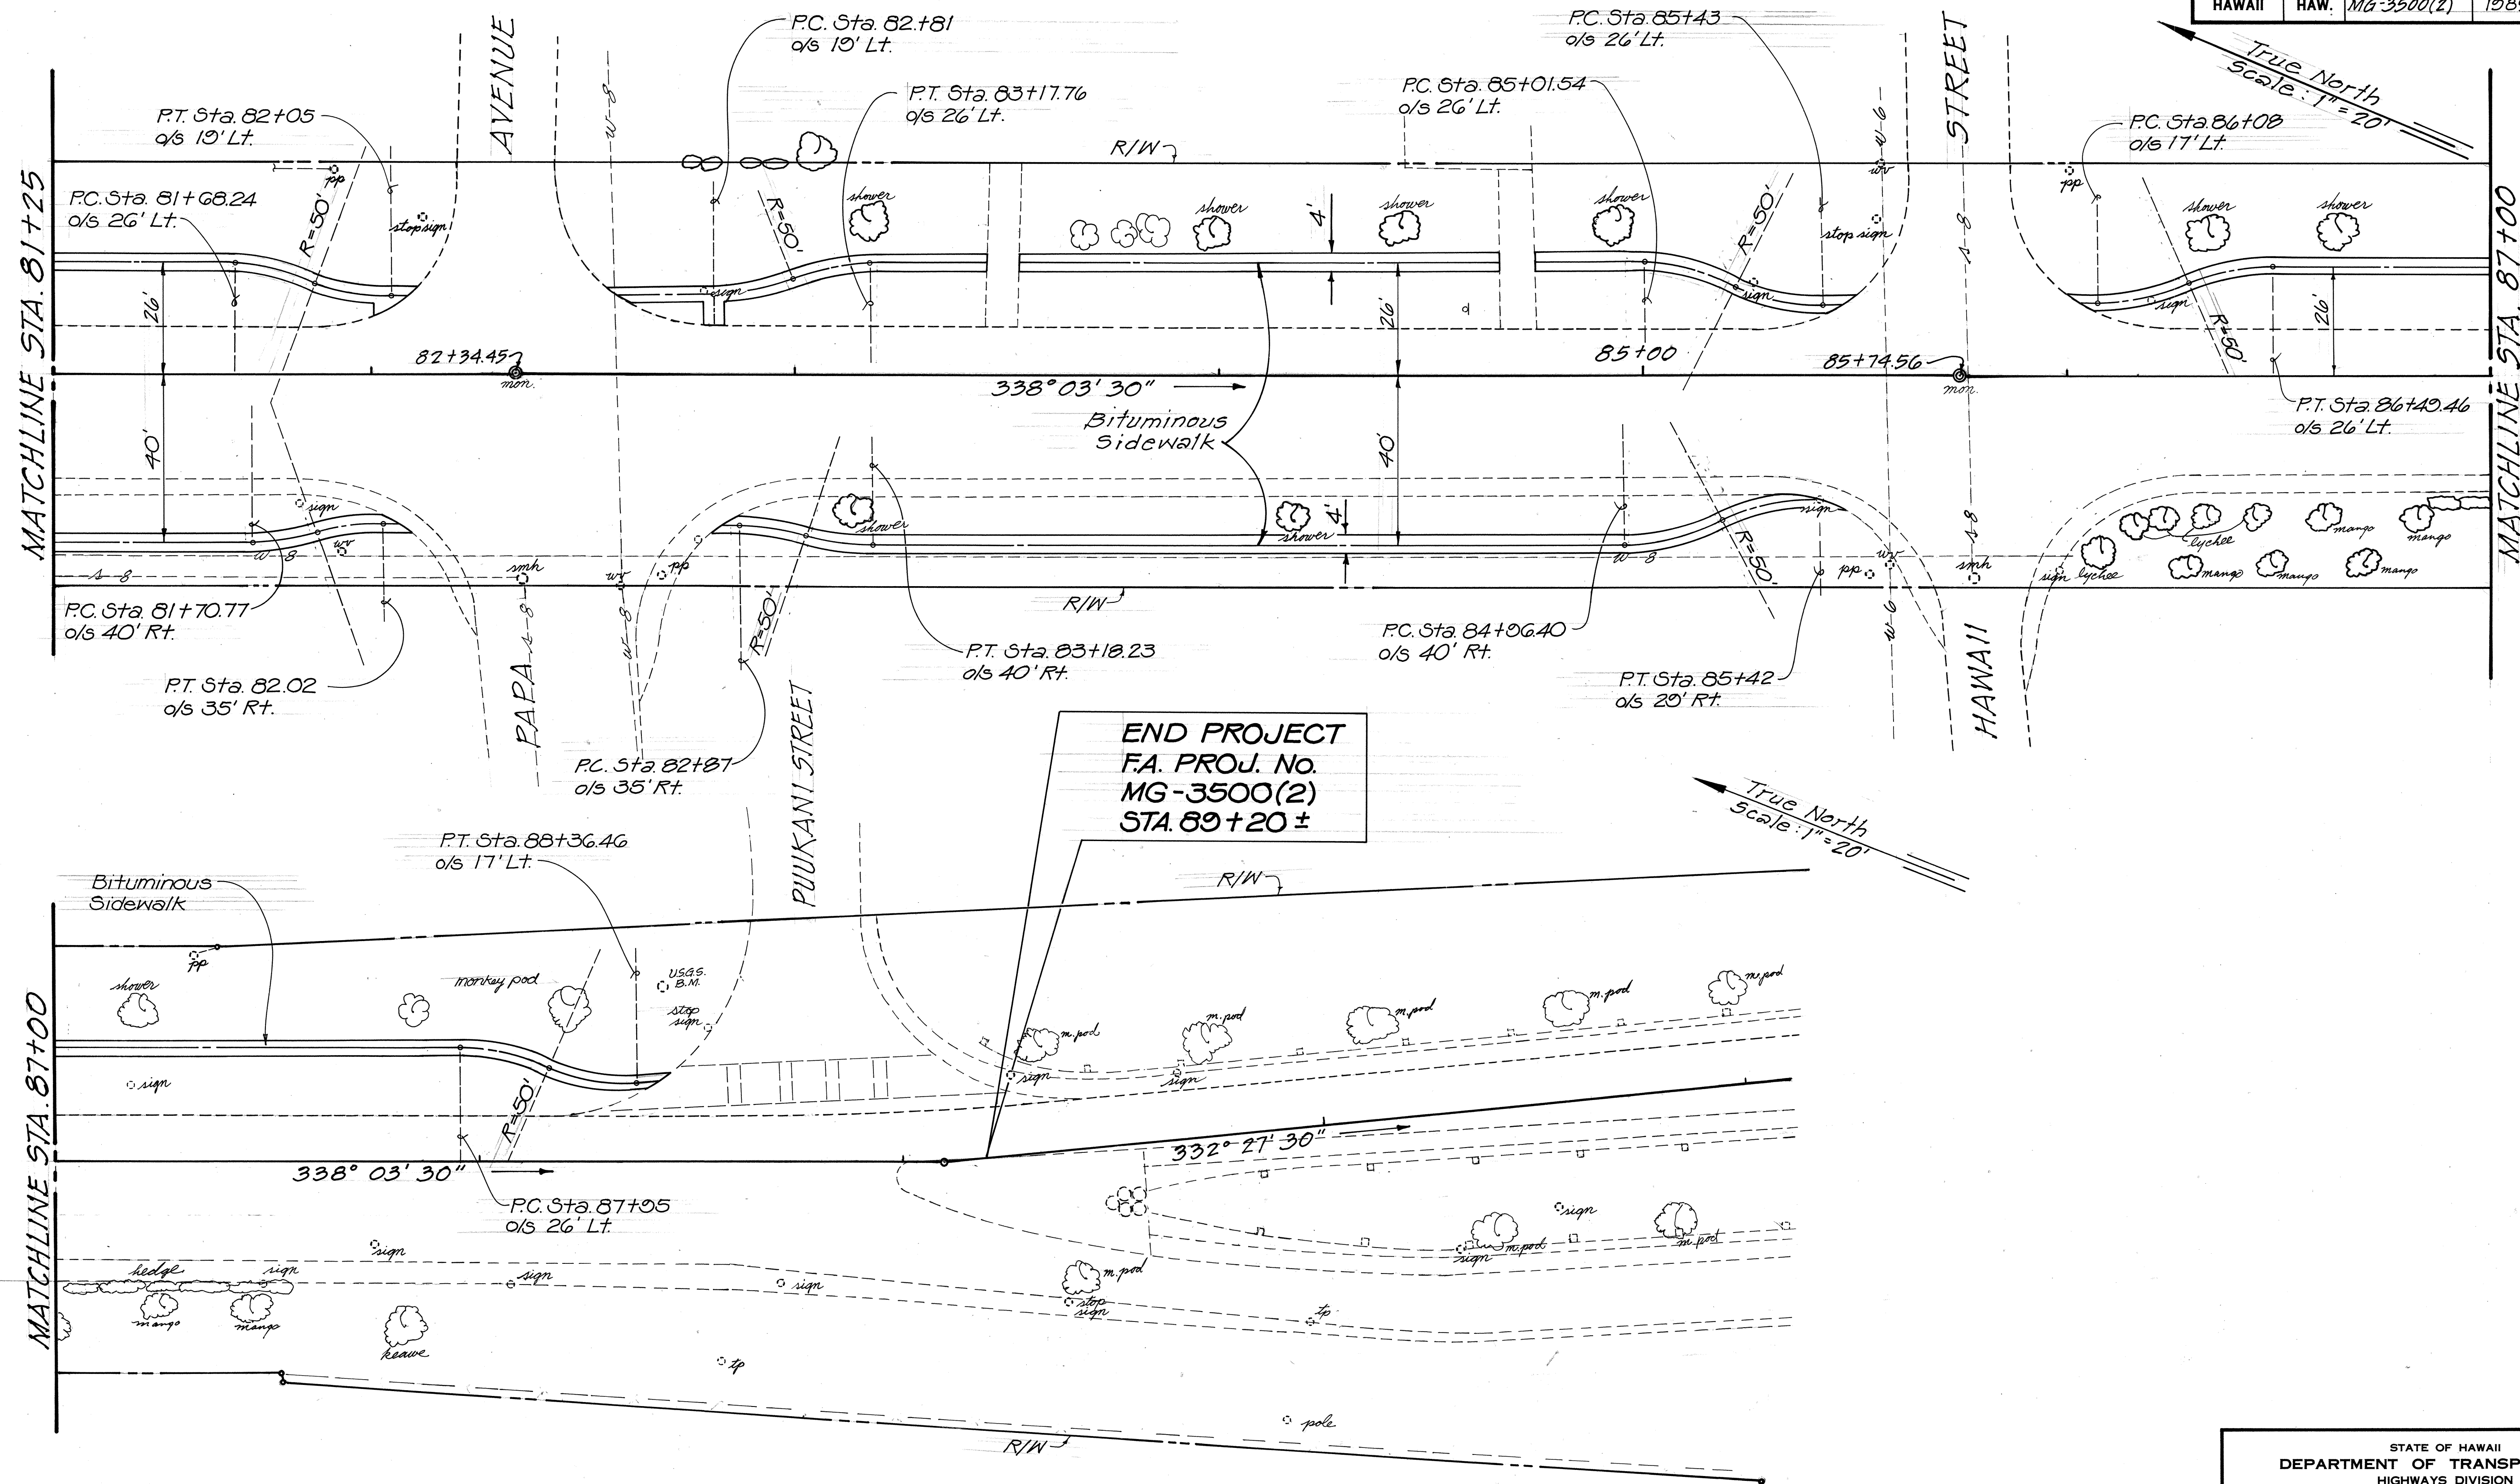

ORIGINAL PLAN	SURVEY PLOTTED BY _____ DATE _____
NOTE BOOK	DRAWN BY _____
	TRACED BY _____
	DESIGNED BY _____
	QUANTITIES BY _____
No. _____	CHECKED BY _____

STATE OF HAWAII
DEPARTMENT OF TRANSPORTATION
HIGHWAYS DIVISION

PLAN

PUUNENE AVENUE SIDEWALKS
Kaahumanu Ave. Towards Kiihelani Hwy.
F.A. Proj. No. MG-3500(2)

Scale: 1" = 20' Date: May, 1988

SHEET NO. 5 OF 5 SHEETS