

to this project. TOTAL SHEET COUNT after "AS-BUILT" posting 22 Shts.

MAY, 1989 DATE

548-7534 PHONE

A.YAMAGUCHI P. S. & E. BY


HWY - M DESIGNED

STATE OF HAWAII

DEPARTMENT OF TRANSPORTATION HIGHWAYS DIVISION HONOLULU, HAWAII "AS-BUILT" PLANS OF

KUIHELANI HIGHWAY RESURFACING HONOAPIILANI HIGHWAY TO KEOLANI PLACE PROJECT No. 380A-01-89M

> DISTRICT OF WAILUKU ISLAND OF MAUI

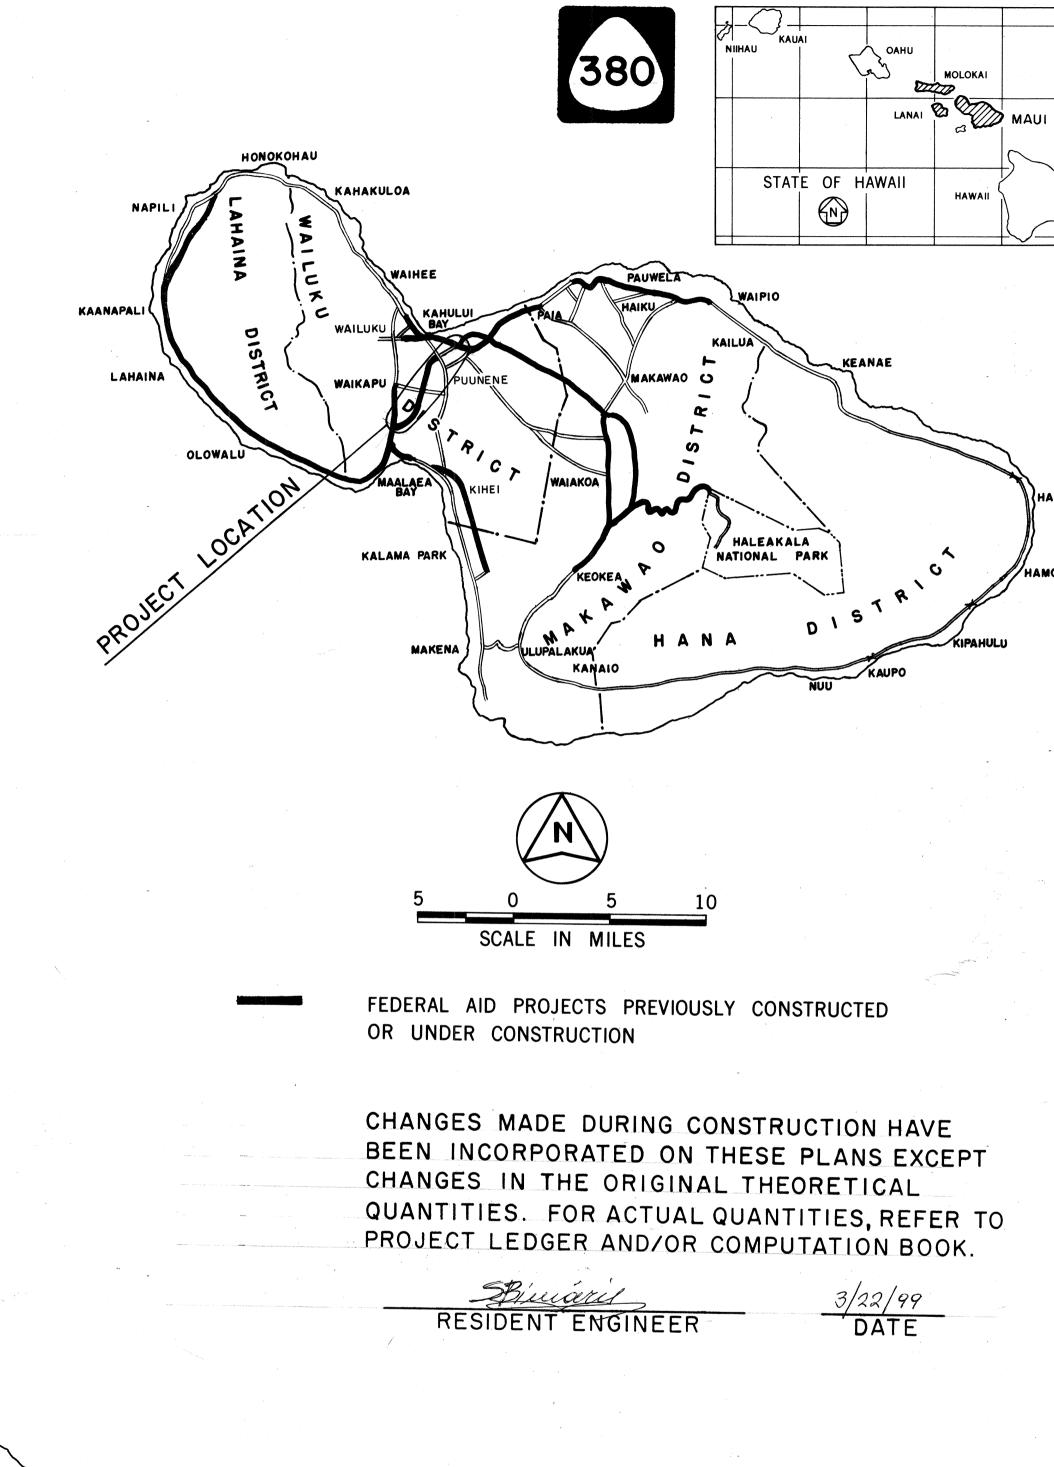


FED. ROAD DIST. NO.

HAWAII

FED. AID PROJ. NO.

HAW. 380A-01-89M 1989

TOTAL SHEETS

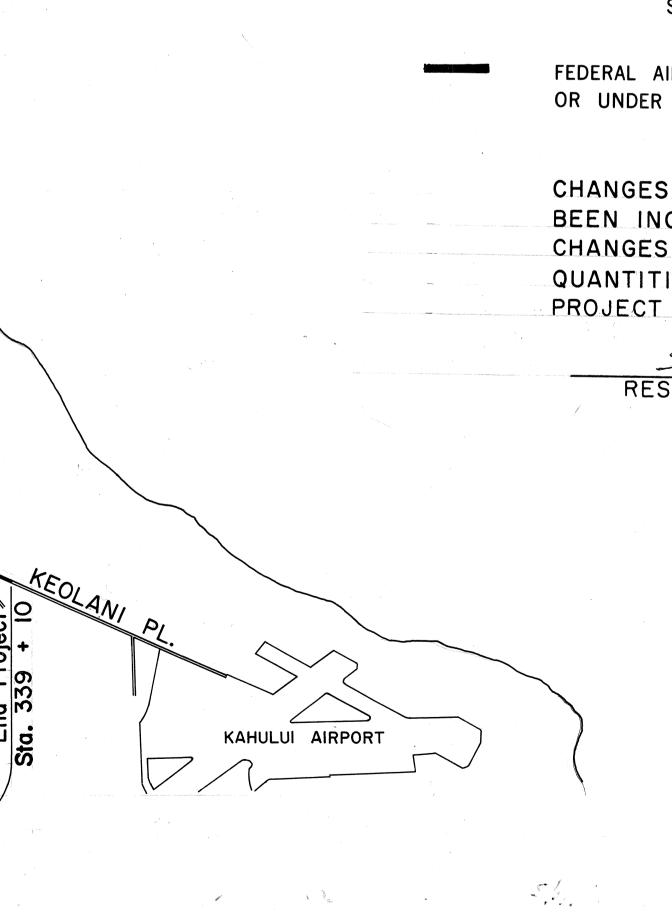

DEPARTMENT OF TRANSPORTATION STATE OF HAWAII

APPROVED:

WÁILUKU KAHULUI HARBOR KUIHELAN HIGHWAY DAIRY ROAD - Project No. 380A - 01 - 89M LAYOUT PLAN

Scale : |" = 2000'

6.394 Miles

PROJECT LENGTH