




FED. ROAD DIST. NO.	STATE	FED-AID PROJ. NO.	FISCAL YEAR	SHEET NO.	TOTAL SHEETS
HAWAII	HAW.	380A-01-89M	1989	3	21

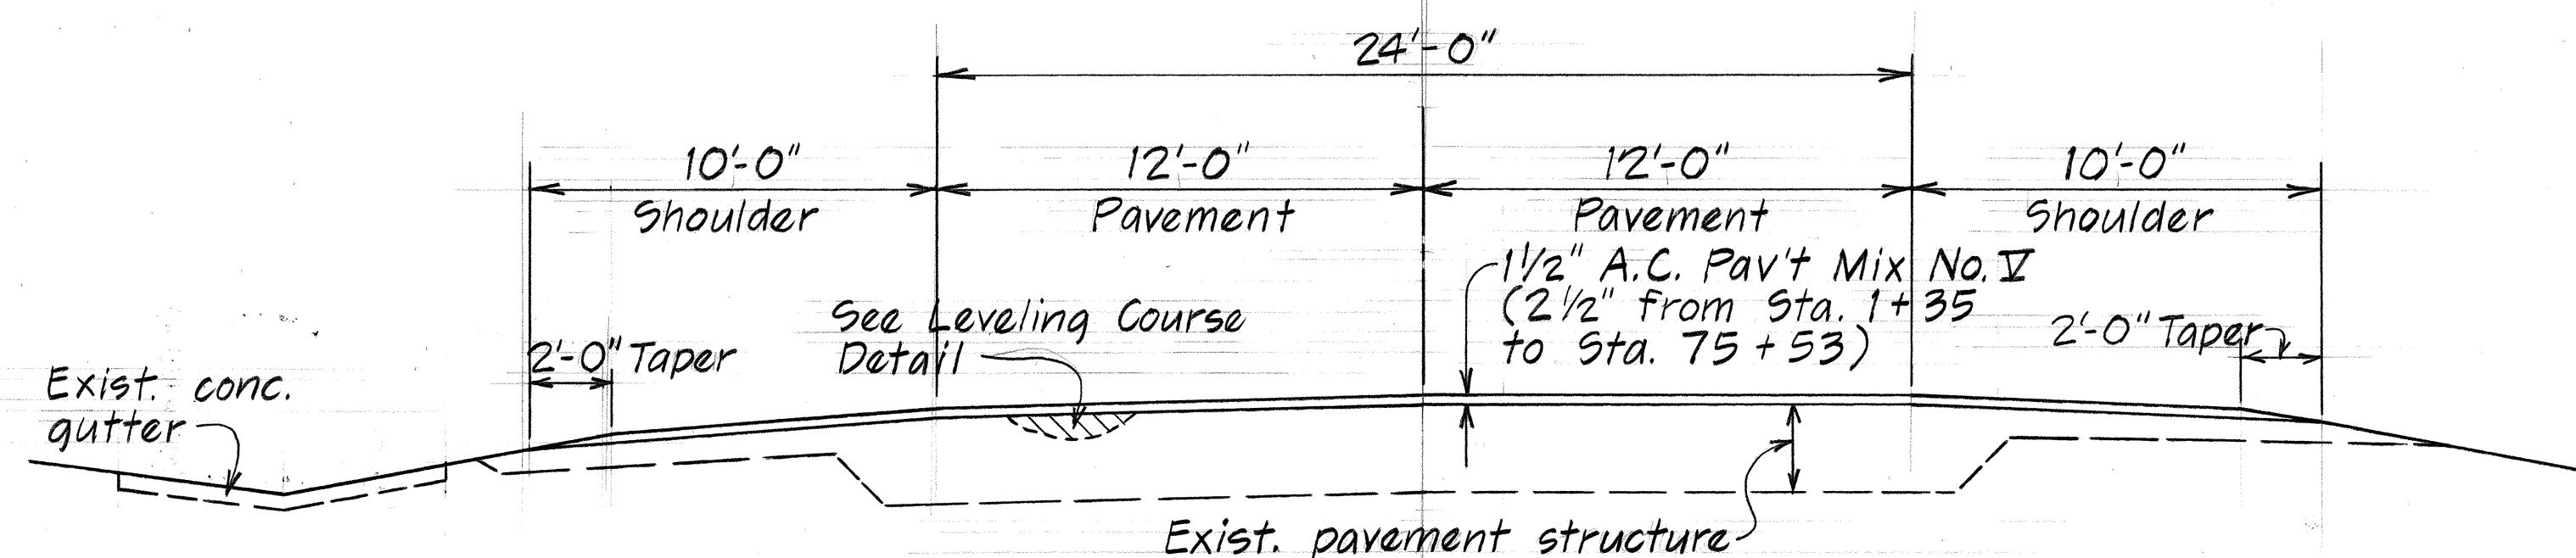


TYPICAL SECTION ALONG KUIHELANI HIGHWAY
Scale: 1/4" = 1'-0"

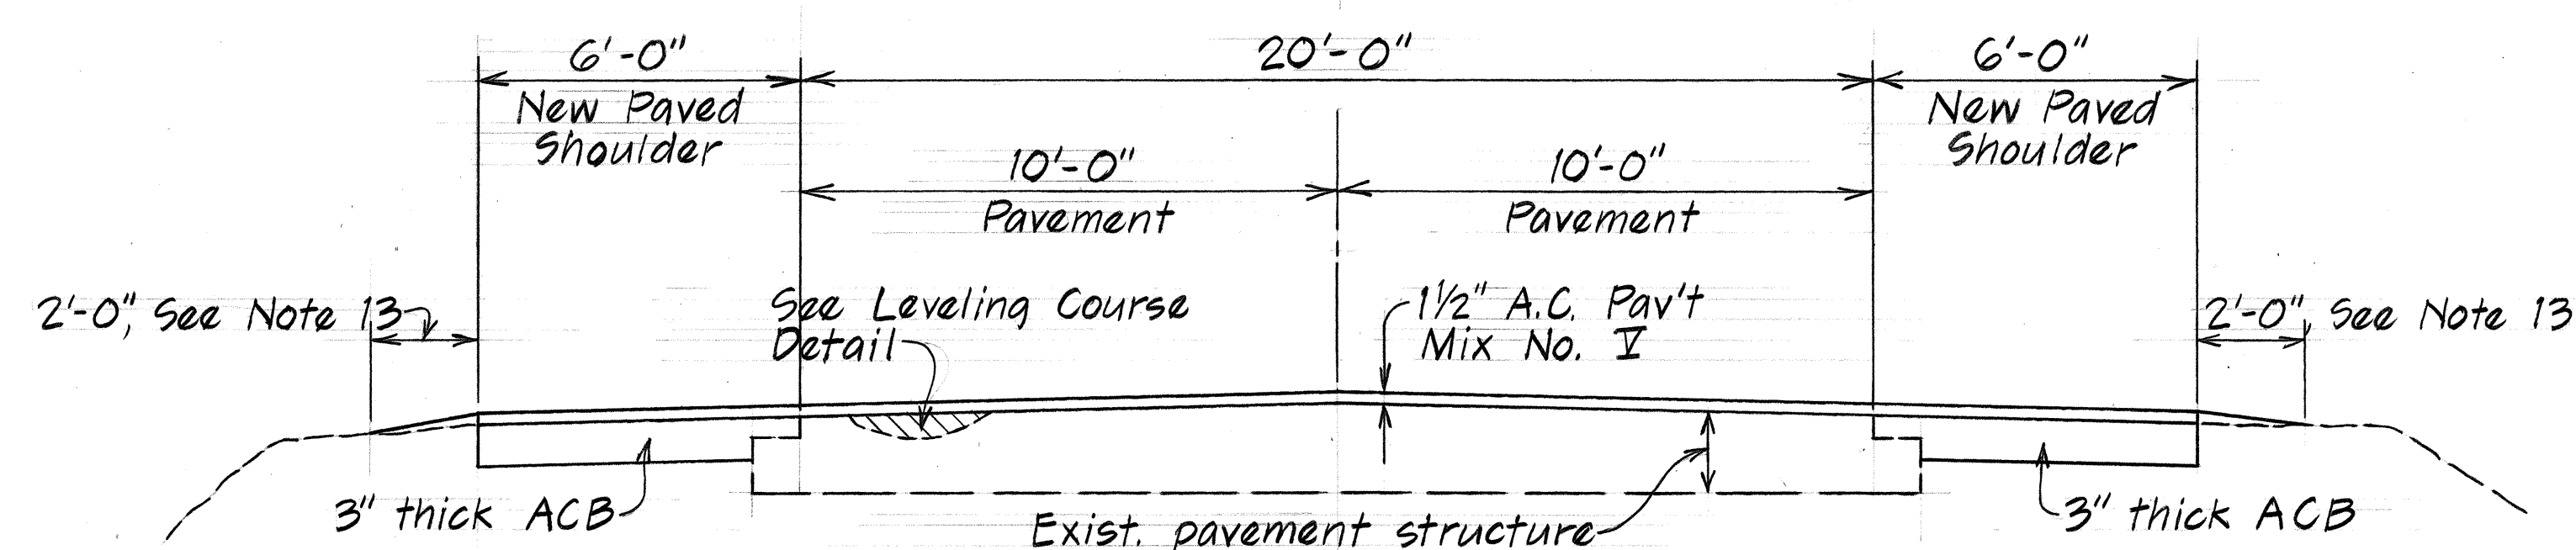


TYPICAL SECTION ALONG DAIRY RD. FROM PUUNENE AVE. TO STA. 313+80±
Not To Scale

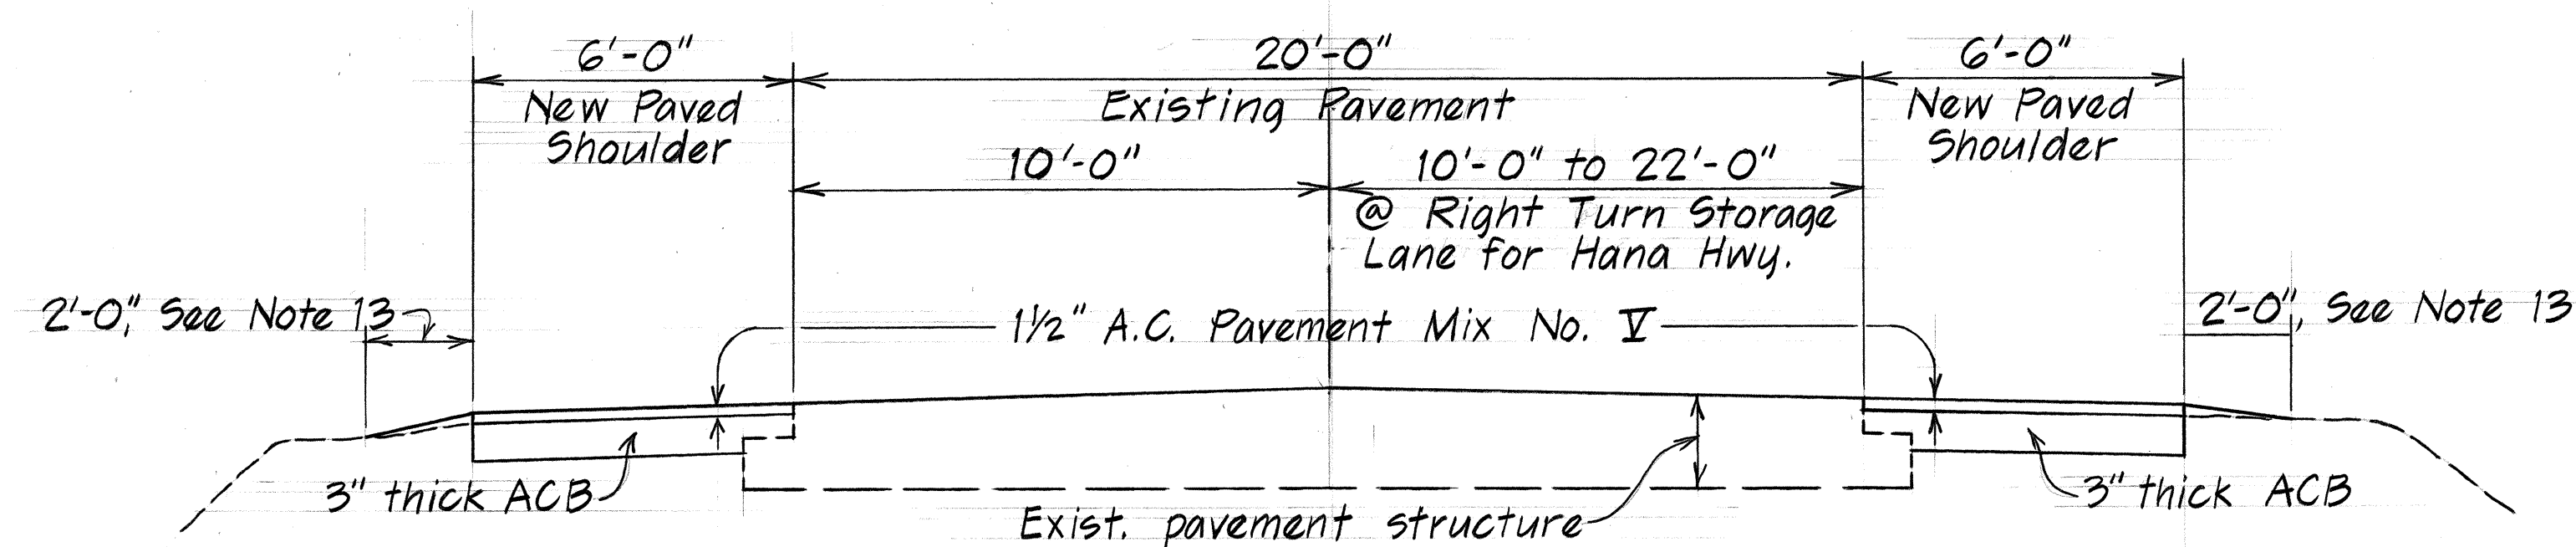


TYPICAL SECTION ALONG DAIRY RD. FROM 313+80± TO KEOLANI PLACE
Not To Scale

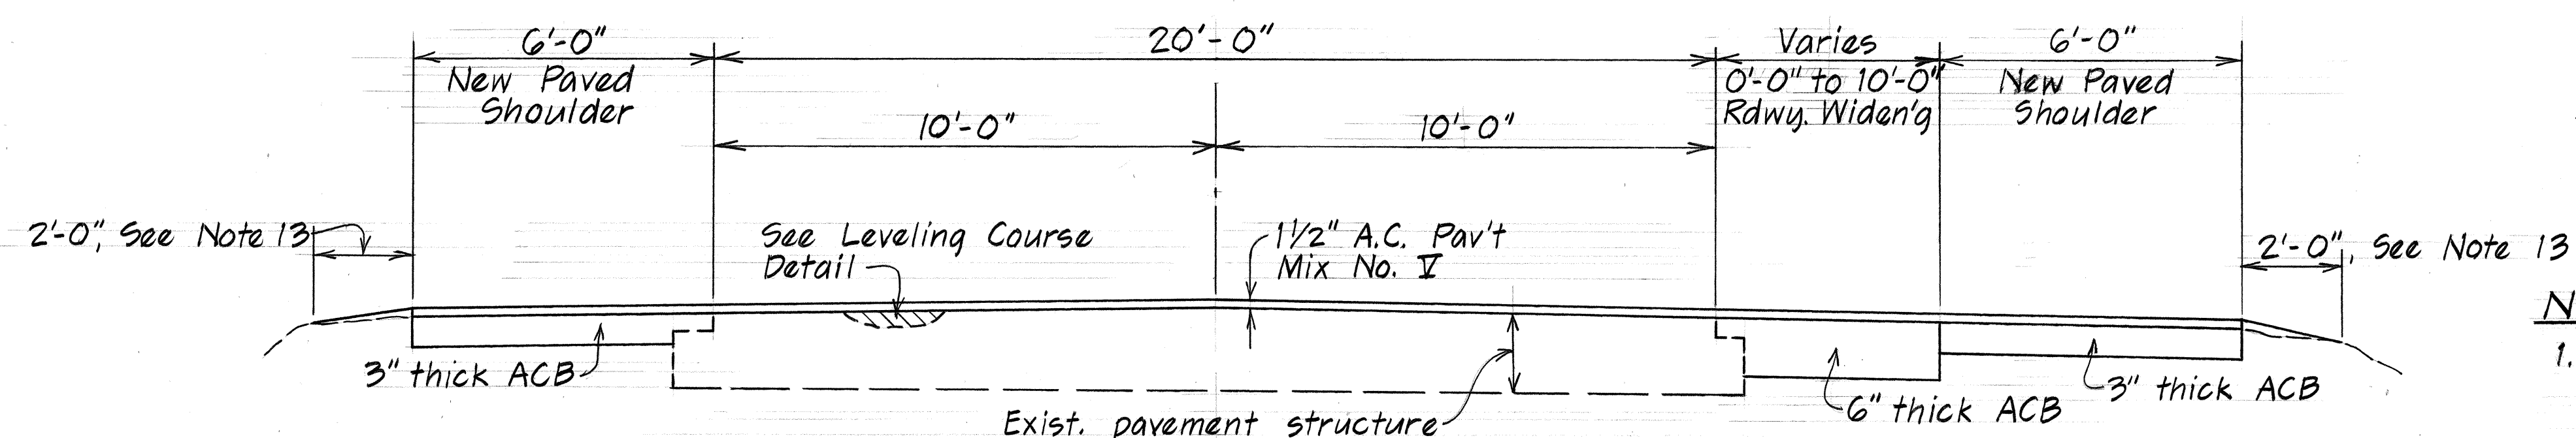


TYPICAL SECTION ALONG KEOLANI PLACE
Not To Scale

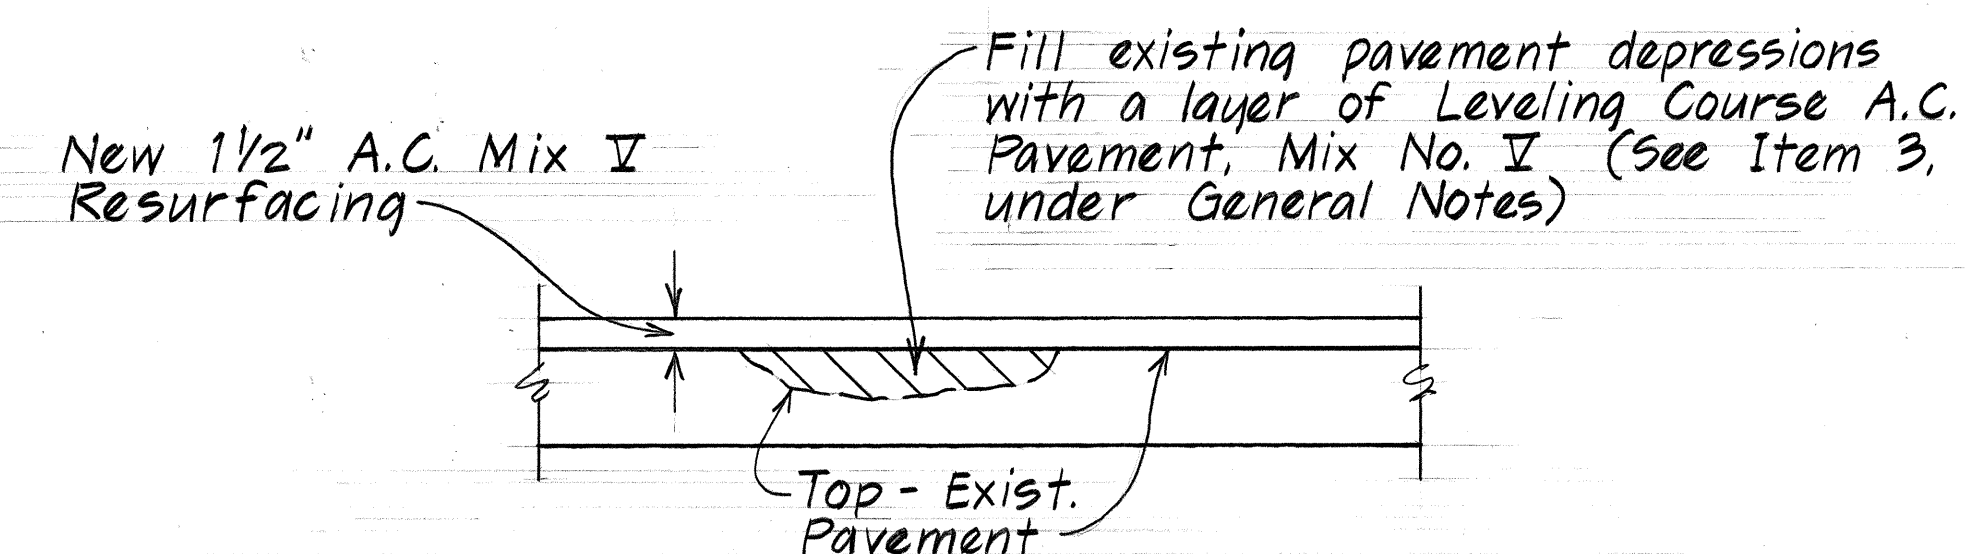

LEVELING COURSE DETAIL
Not To Scale

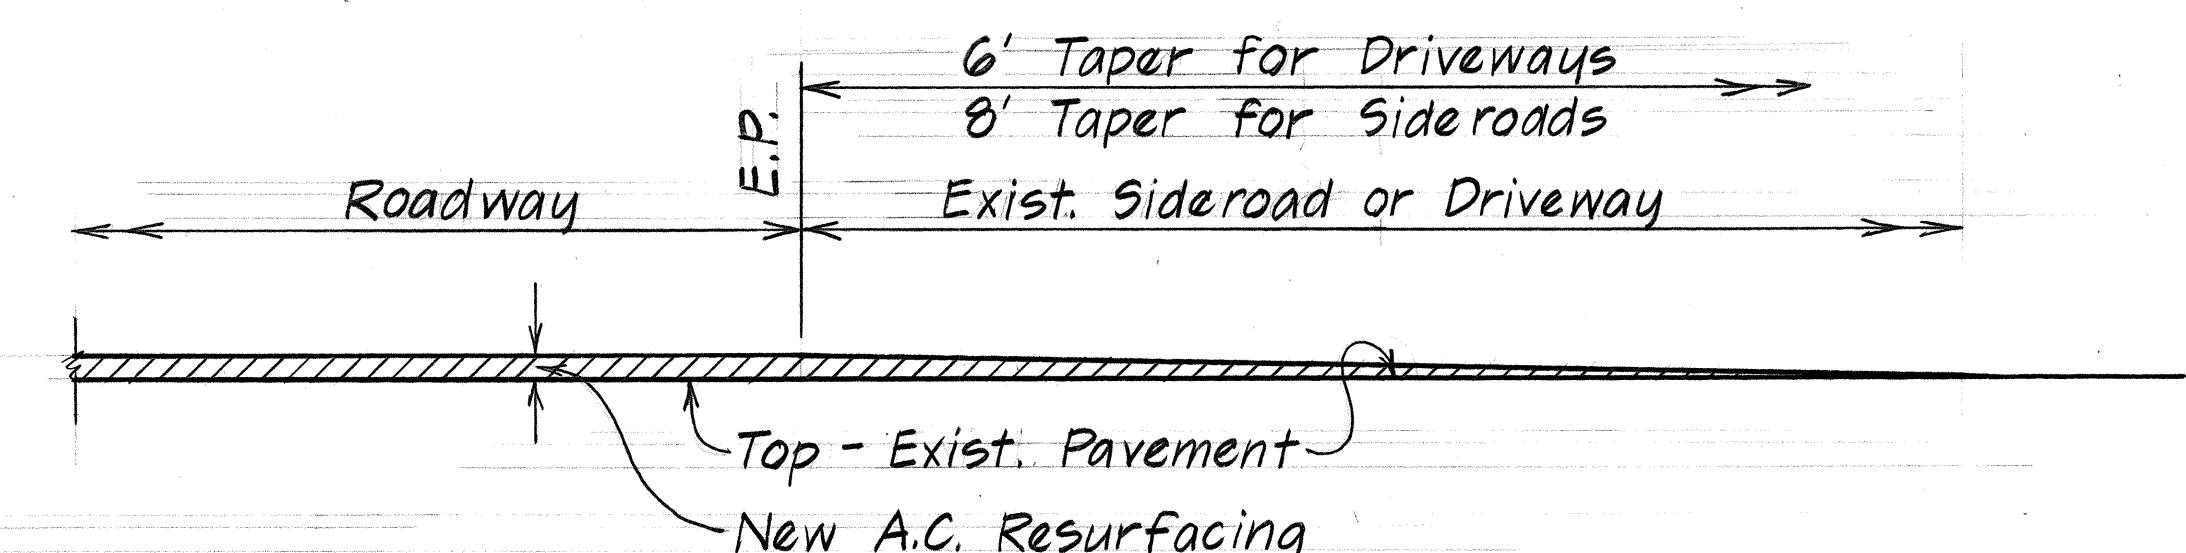

TYPICAL SECTION - SIDEROAD, DRIVEWAY CONNECTION
Scale: 3/4" = 1'-0"

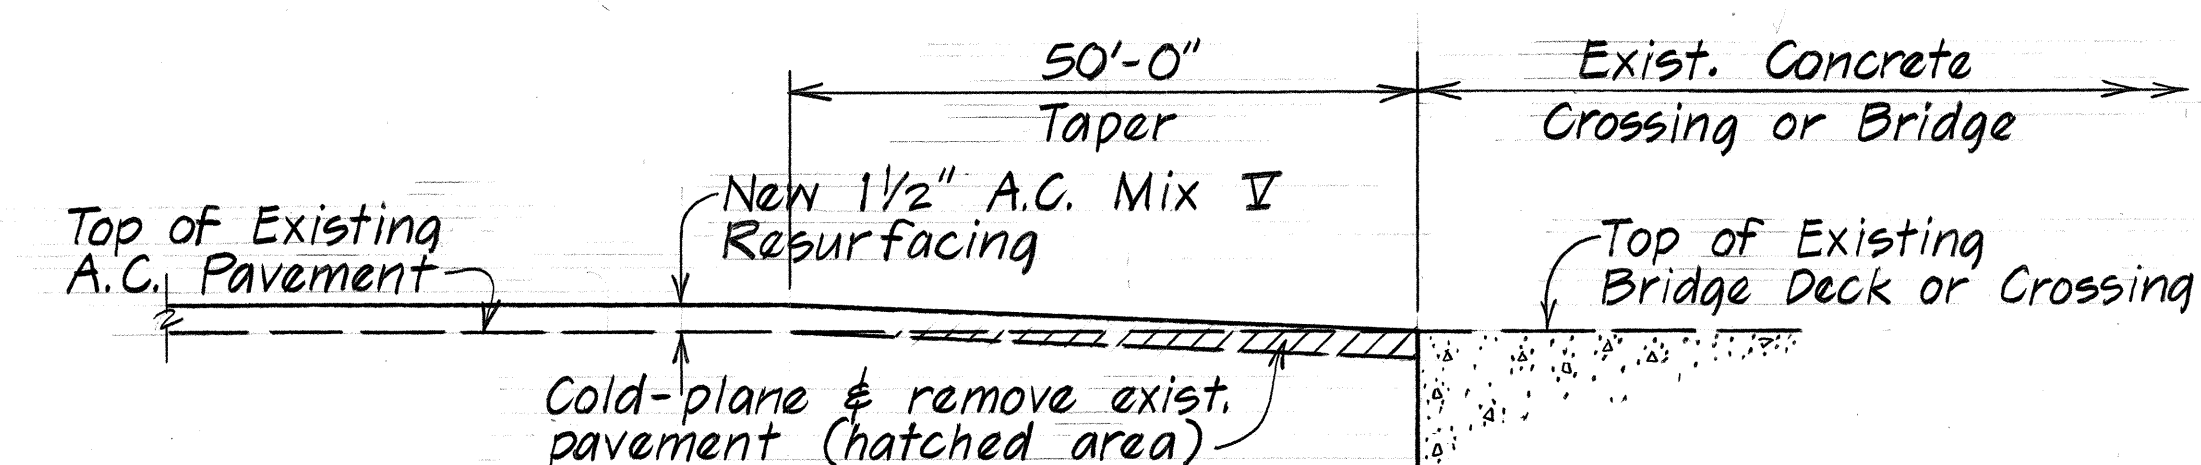

TYPICAL DETAIL - CONCRETE CROSSINGS, BRIDGES
Not To Scale

NOTES:

1. Taper shoulder from 2 1/2" to 1 1/2" A.C. for 8', then from 1 1/2" to 0 (zero) for 2' between Sta. 1+35 and Sta. 75+53.
2. Transition A.C. pavement from 2 1/2" to 1 1/2" along Kuihelani Highway between Sta. 75+53 and Sta. 76+03.
3. Where existing shoulders exists, resurface with 1 1/2" thick A.C. pavement, Mix no. V.

STATE OF HAWAII DEPARTMENT OF TRANSPORTATION HIGHWAYS DIVISION	
TYPICAL ROADWAY SECTIONS & DETAILS	
KUIHELANI HWY. RESURFACING	
PROJECT NO. 380A-01-89M	
Scale: As Noted	Date: May, 1989
SHEET No. 1 OF 1 SHEETS	

SURVEY PLOTTED BY	DATE
DESIGNED BY	
TRACED BY	
NOTED BY	
CHECKED BY	
ORIGINAL PLAN	
NOTE BOOK	
No.	