


FED. ROAD DIST. NO.	STATE	FEDERAL AID PROJ. NO.	FISCAL YEAR	SHEET NO.	TOTAL SHEETS
HAWAII	HAW.	HES-STP-3500(4)	1994	10	26

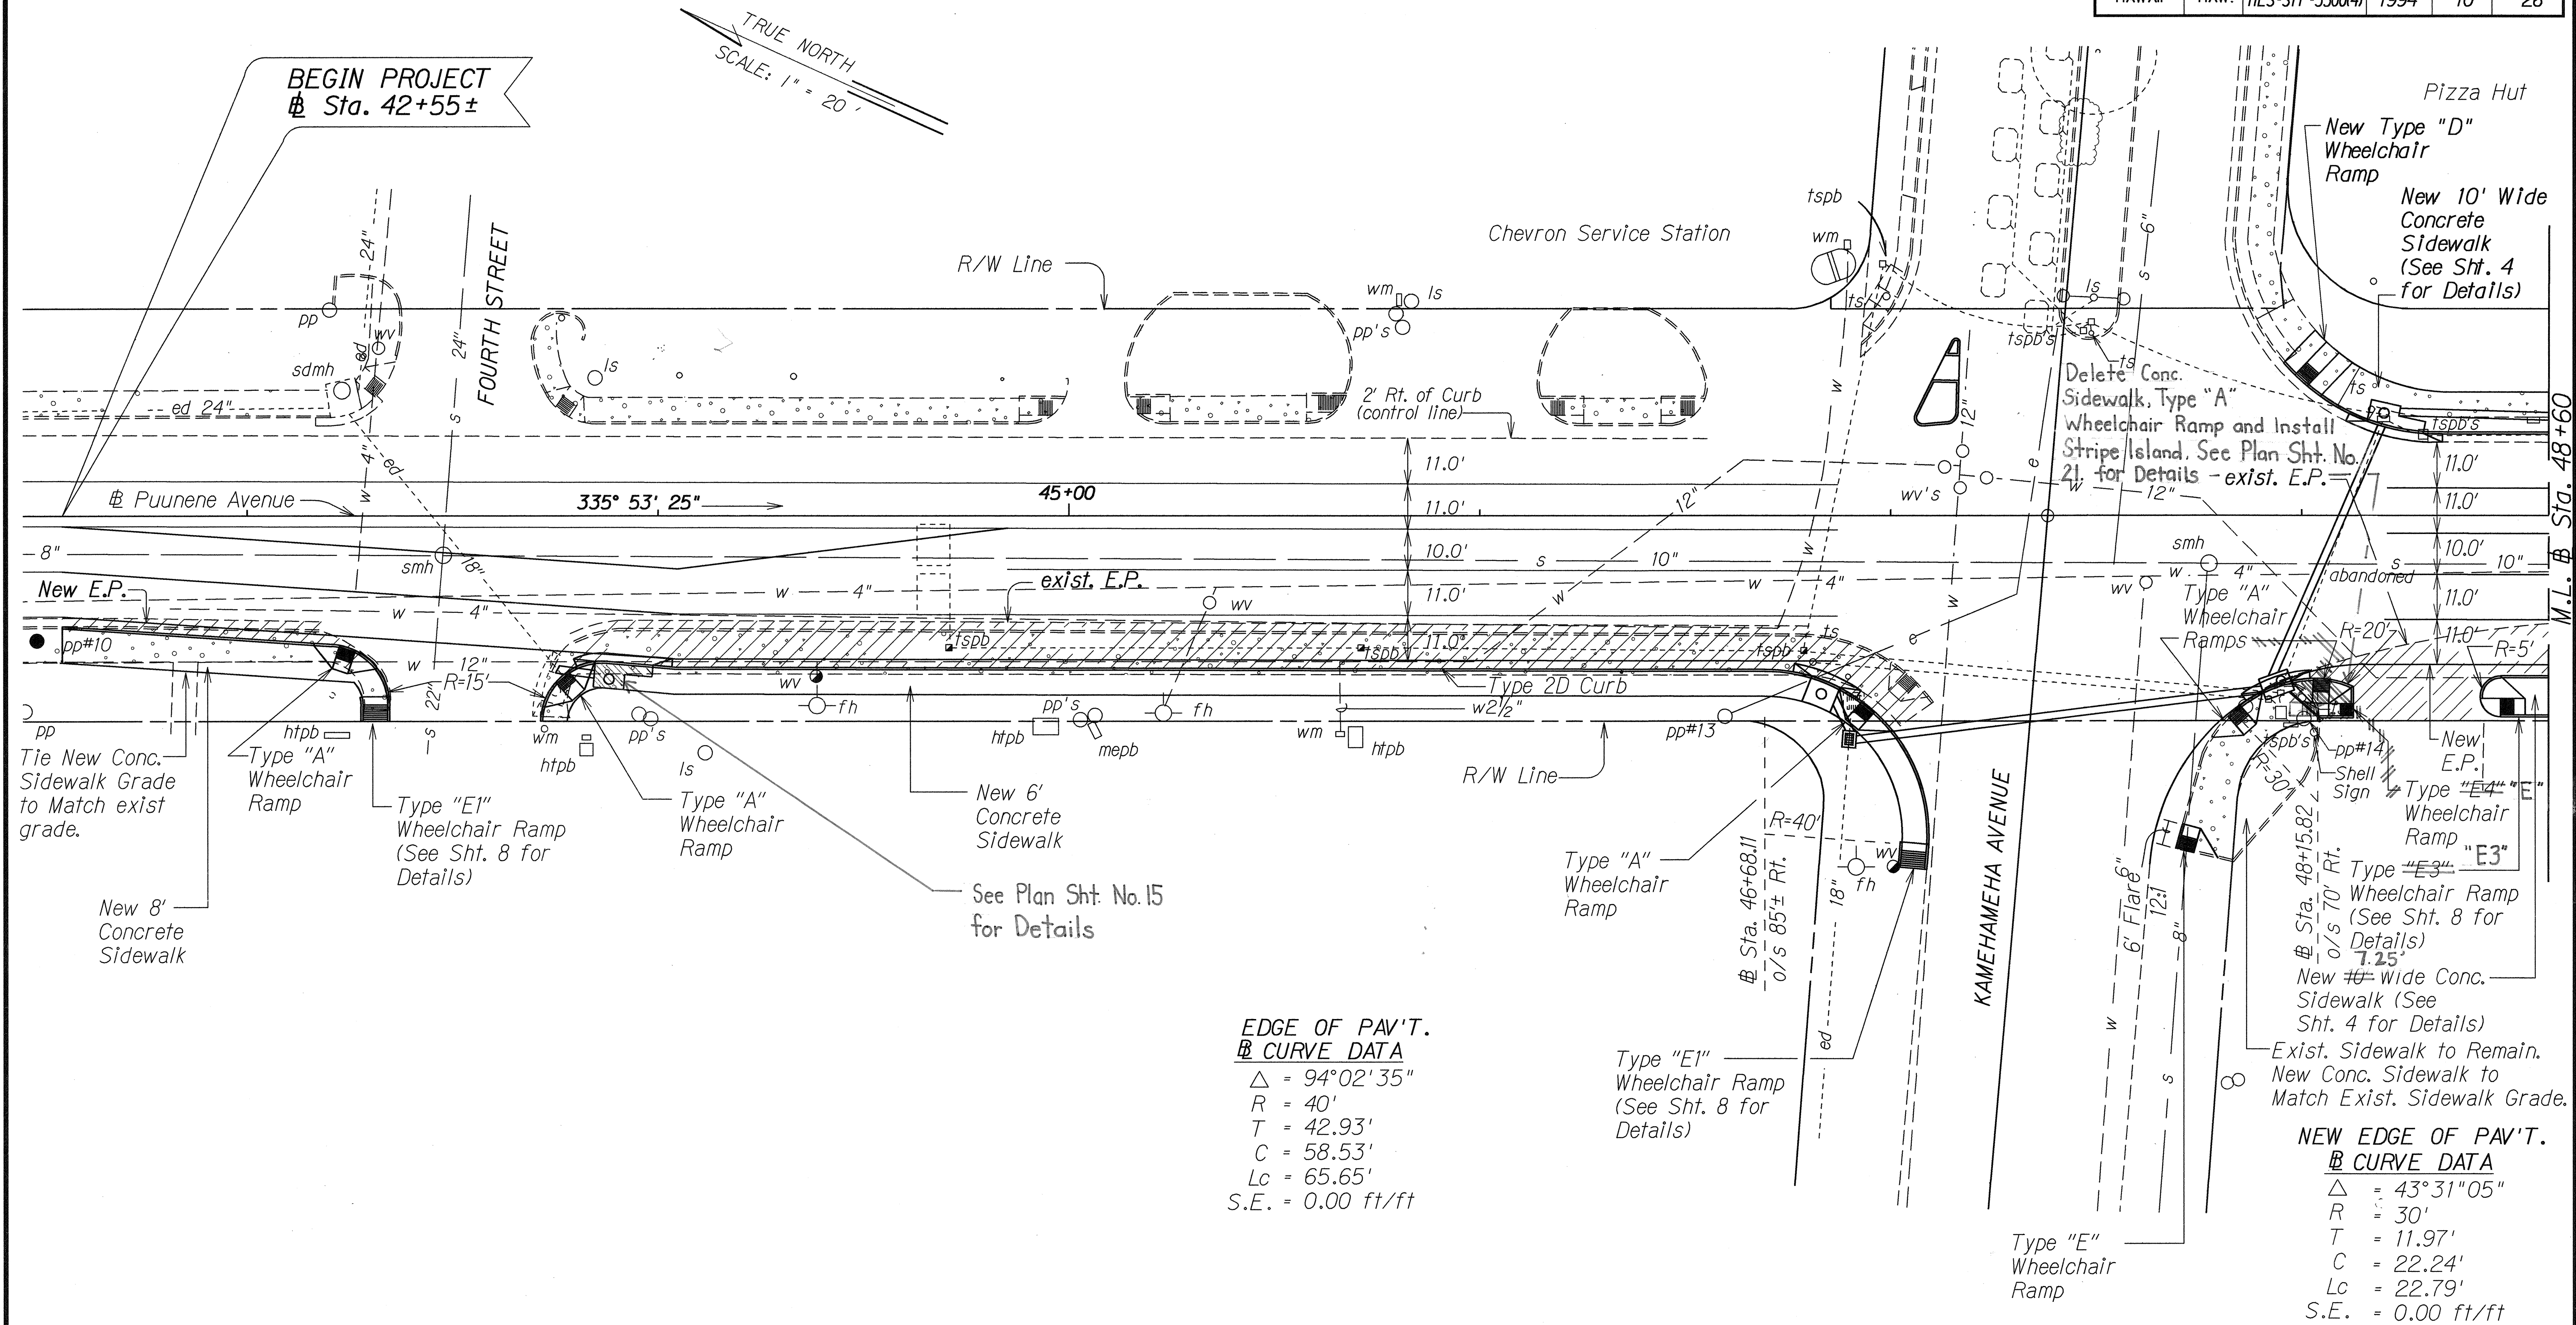

ORIGINAL PLAN	SURVEY PLOTTED BY	DATE
NOTED	DRAWN BY	12/01/93
CHECKED BY	DESIGNED BY	
	NOTED BY	
	CHECKED BY	

APPROVED:
George O. Kaya 12/01/93
 DIRECTOR, DEPARTMENT OF PUBLIC WORKS
 AND WASTE MANAGEMENT
 COUNTY OF MAUI

STATE OF HAWAII
 DEPARTMENT OF TRANSPORTATION
 HIGHWAYS DIVISION
DETAILED ROADWAY PLAN
 PUUNENE AVENUE
 INTERSECTION IMPROVEMENTS
 at Kamehameha Ave.
 F.A. Project No. HES-STP-3500(4)
 Scale: 1"=20' Date: August, 1993
 SHEET No. 1 OF 2 SHEETS

