
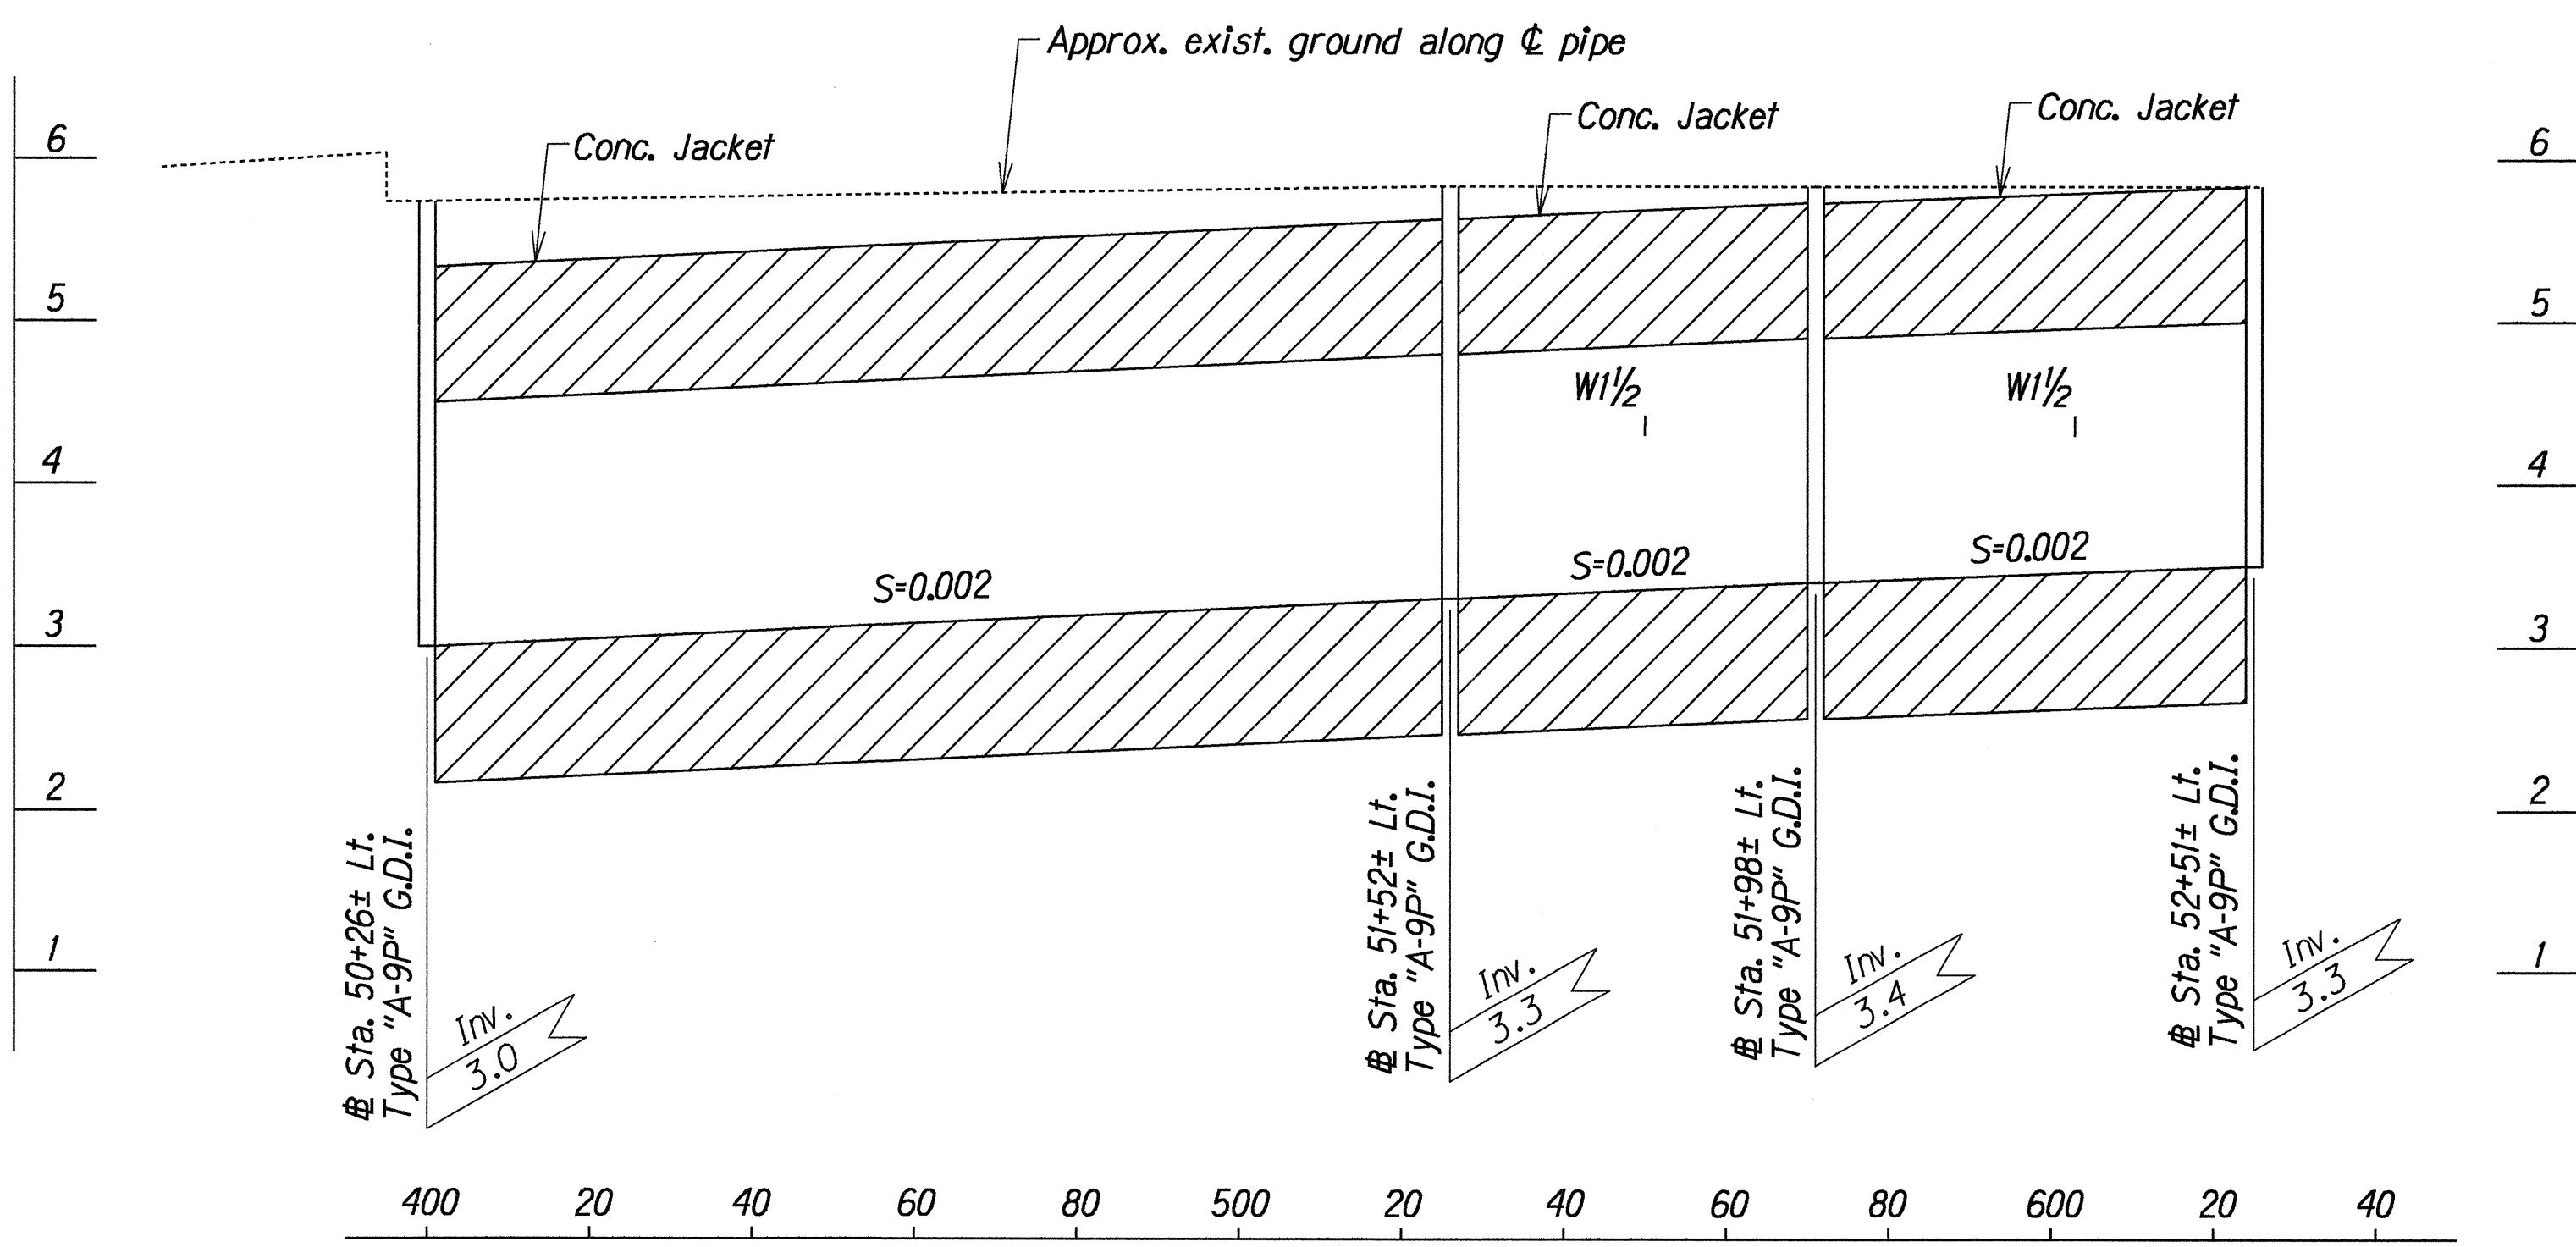


FED. ROAD DIST. NO.	STATE	FEDERAL AID PROJ. NO.	FISCAL YEAR	SHEET NO.	TOTAL SHEETS
HAWAII	HAW.	HES-STP-3500(4)	1994	17	26

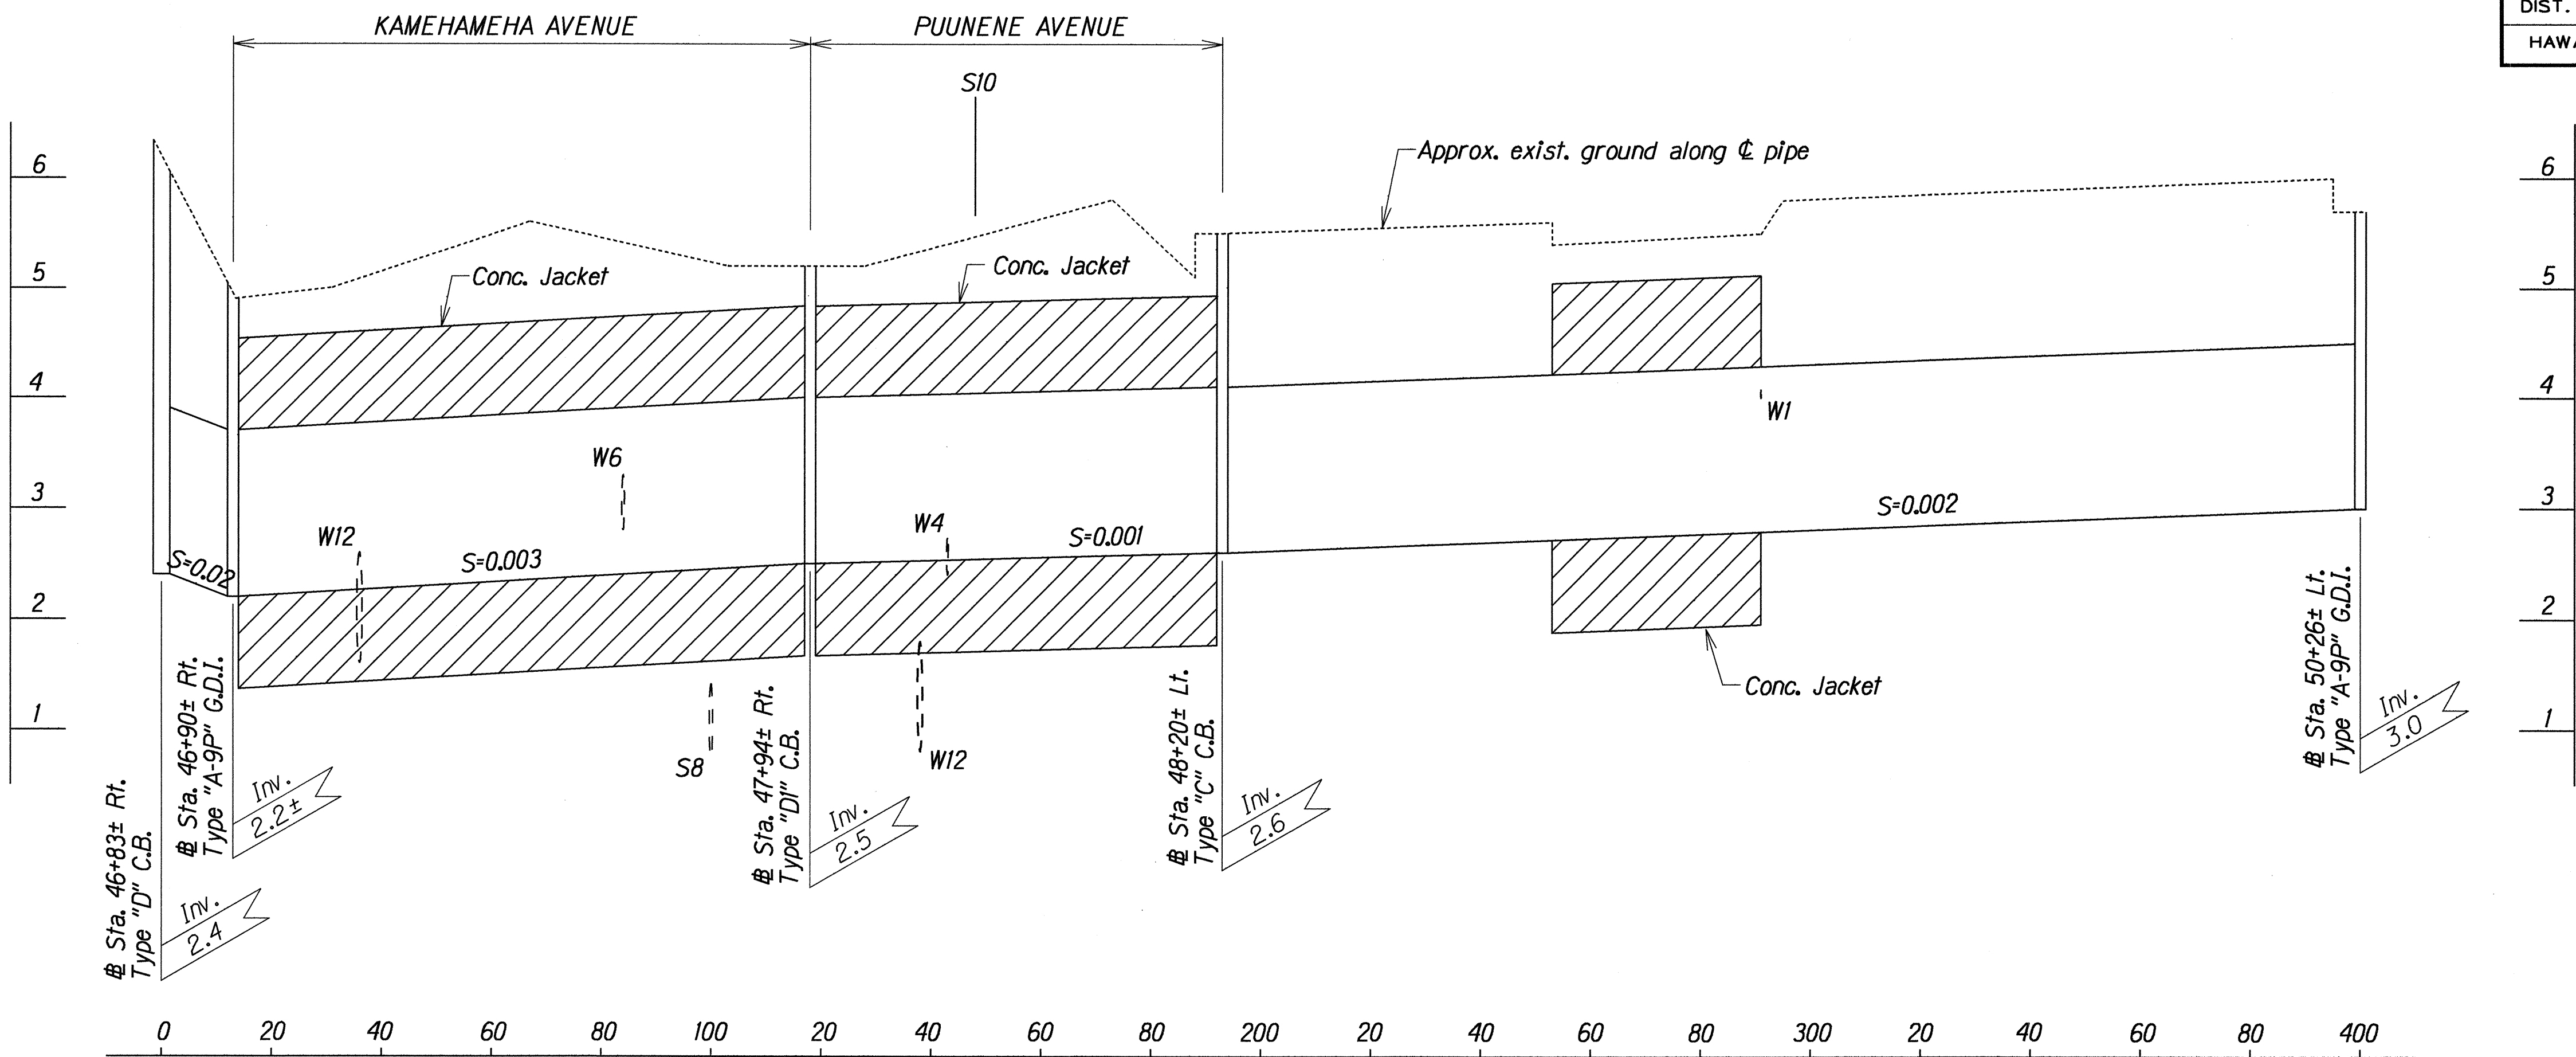

PROFILE ALONG 18" REINF. CONC. PIPE

Scale: Hor. = 1"=20'
Vert. = 1"=1'

SURVEY PLOTTED BY	DATE
DRAWN BY	
DESIGNED BY	
CHECKED BY	
NOTED BY	
DATE	

STATE OF HAWAII
DEPARTMENT OF TRANSPORTATION
HIGHWAYS DIVISION

DRAINAGE PROFILE

PUUNENE AVE. INTERSECTION IMP.
AT KAMEHAMEHA AVENUE
F.A. PROJECT NO. HES-STP-3500(4)

Scale: As Noted
Date: Aug. 1993

SHEET No. H3 OF 5 SHEETS