
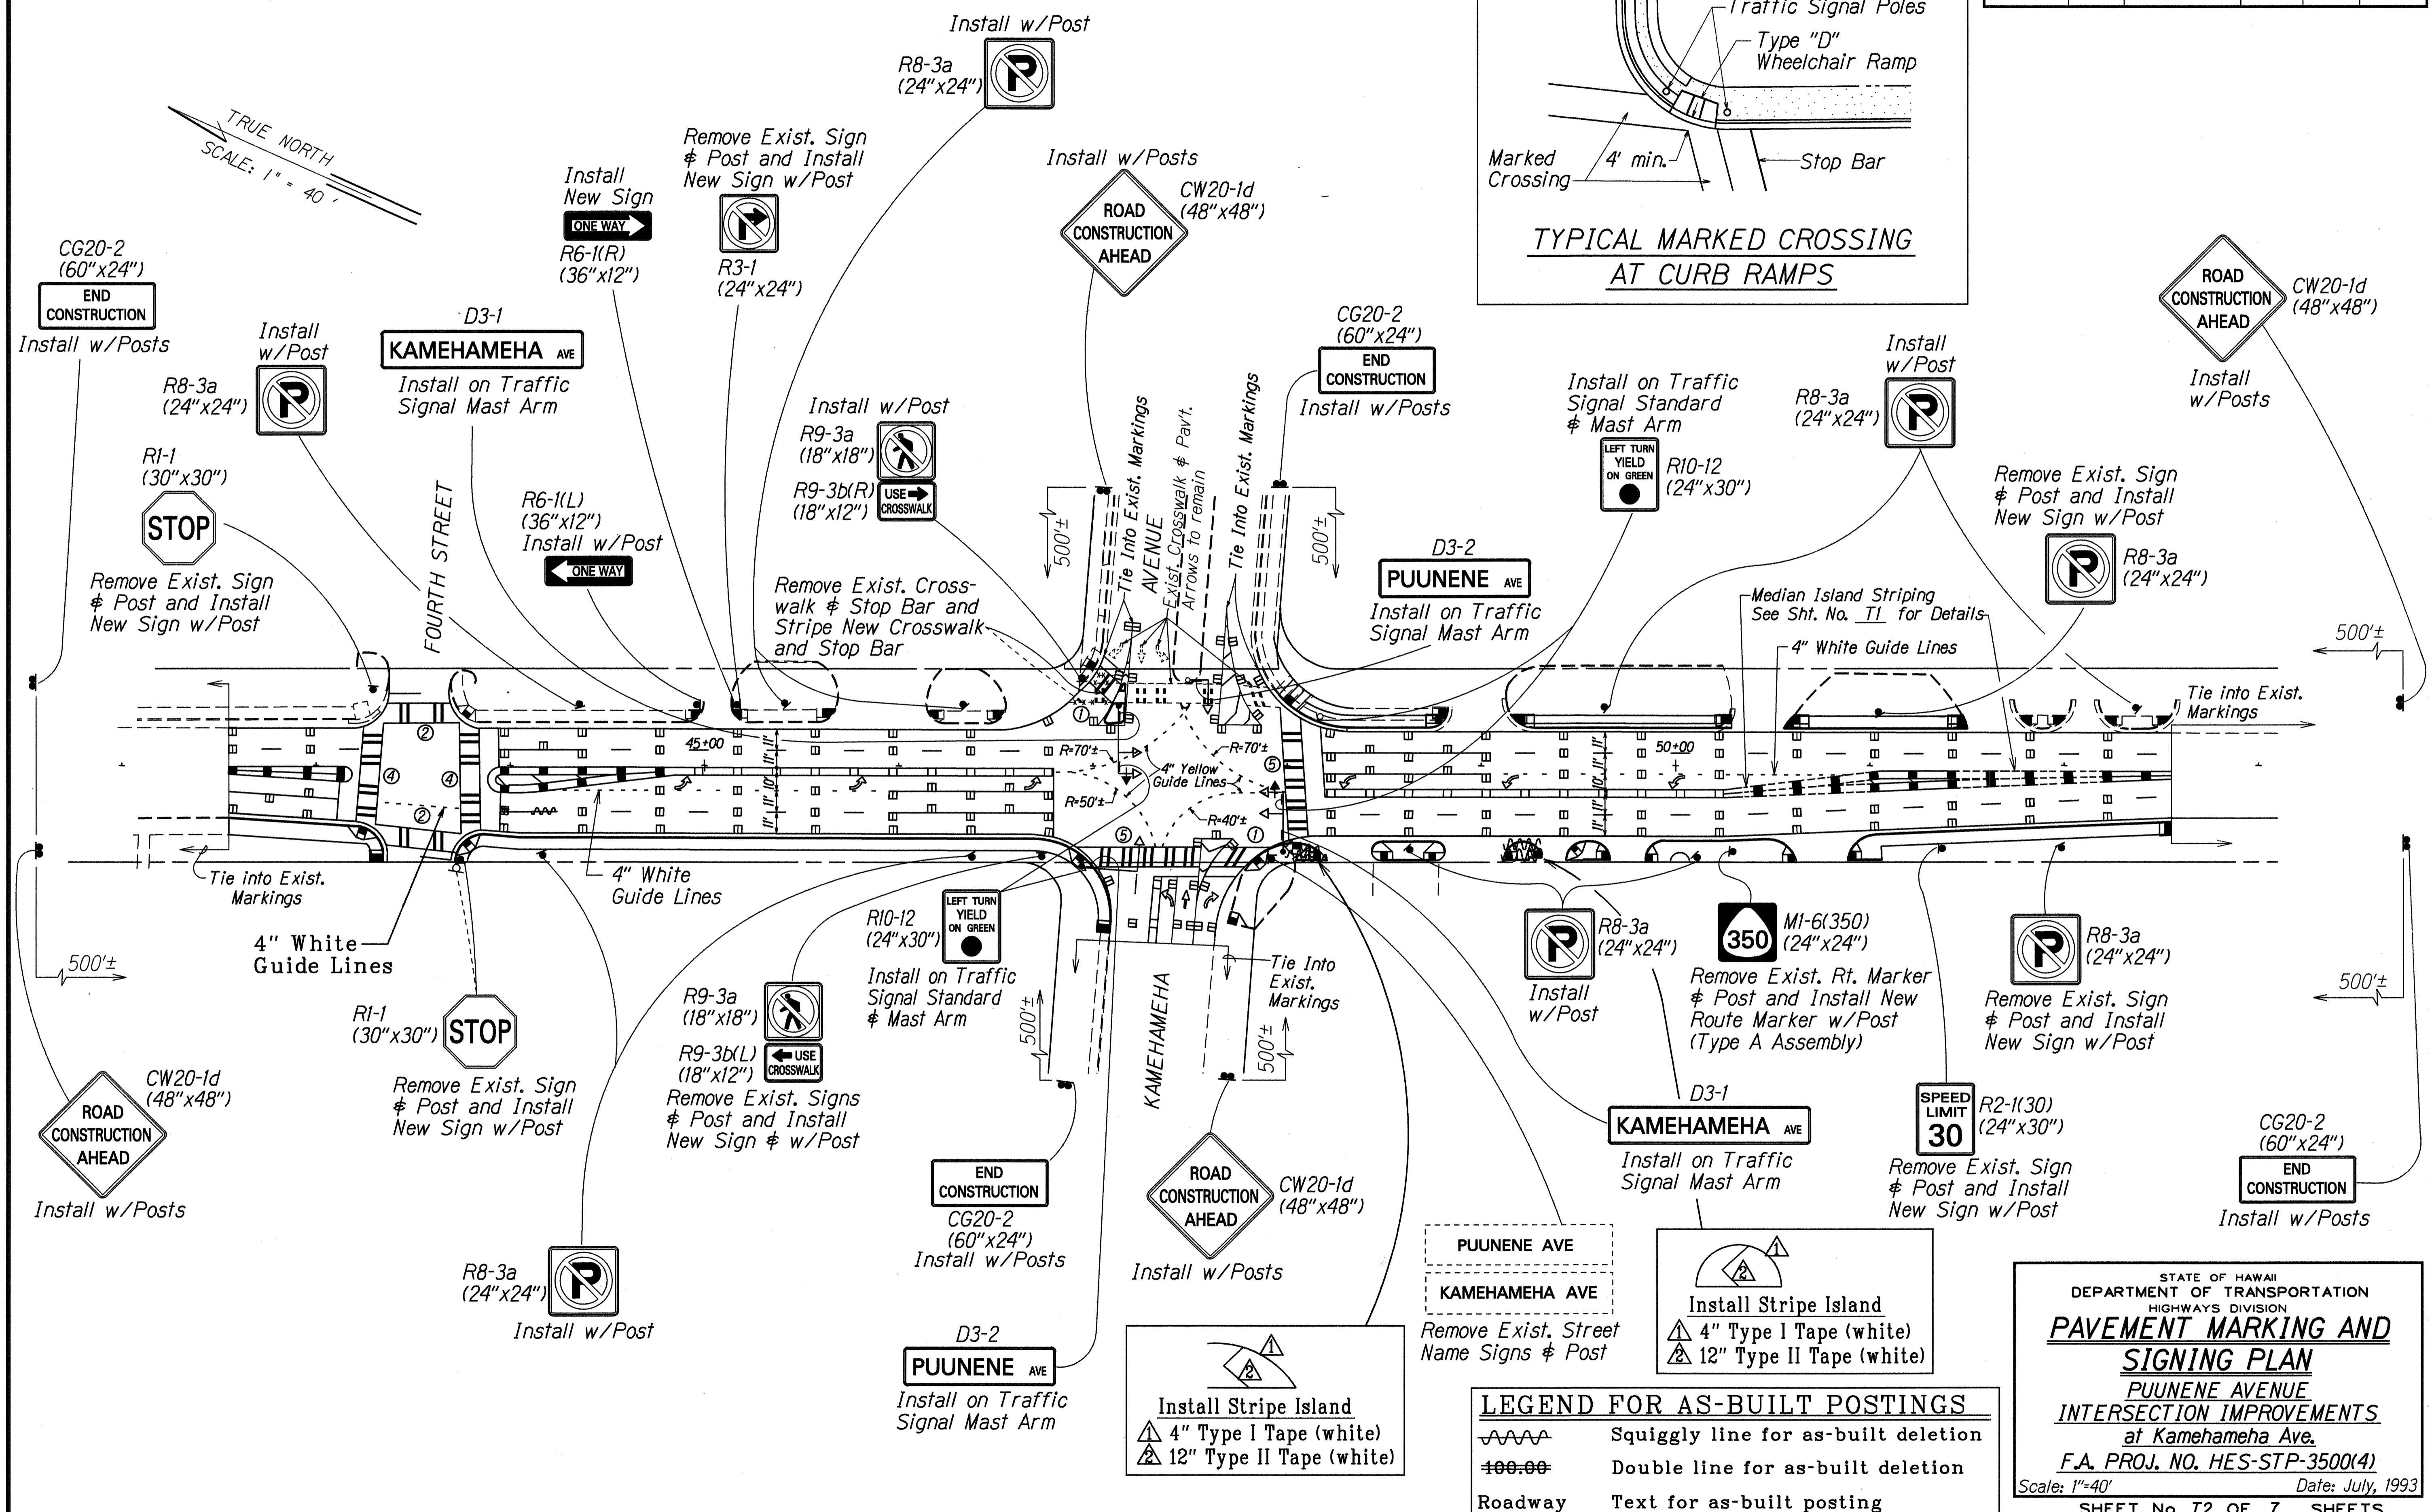


FED. ROAD DIST. NO.	STATE	FED. AID PROJ. NO.	FISCAL YEAR	SHEET NO.	TOTAL SHEETS
HAWAII	HAW.	HES-STP-3500(4)	1994	21	26

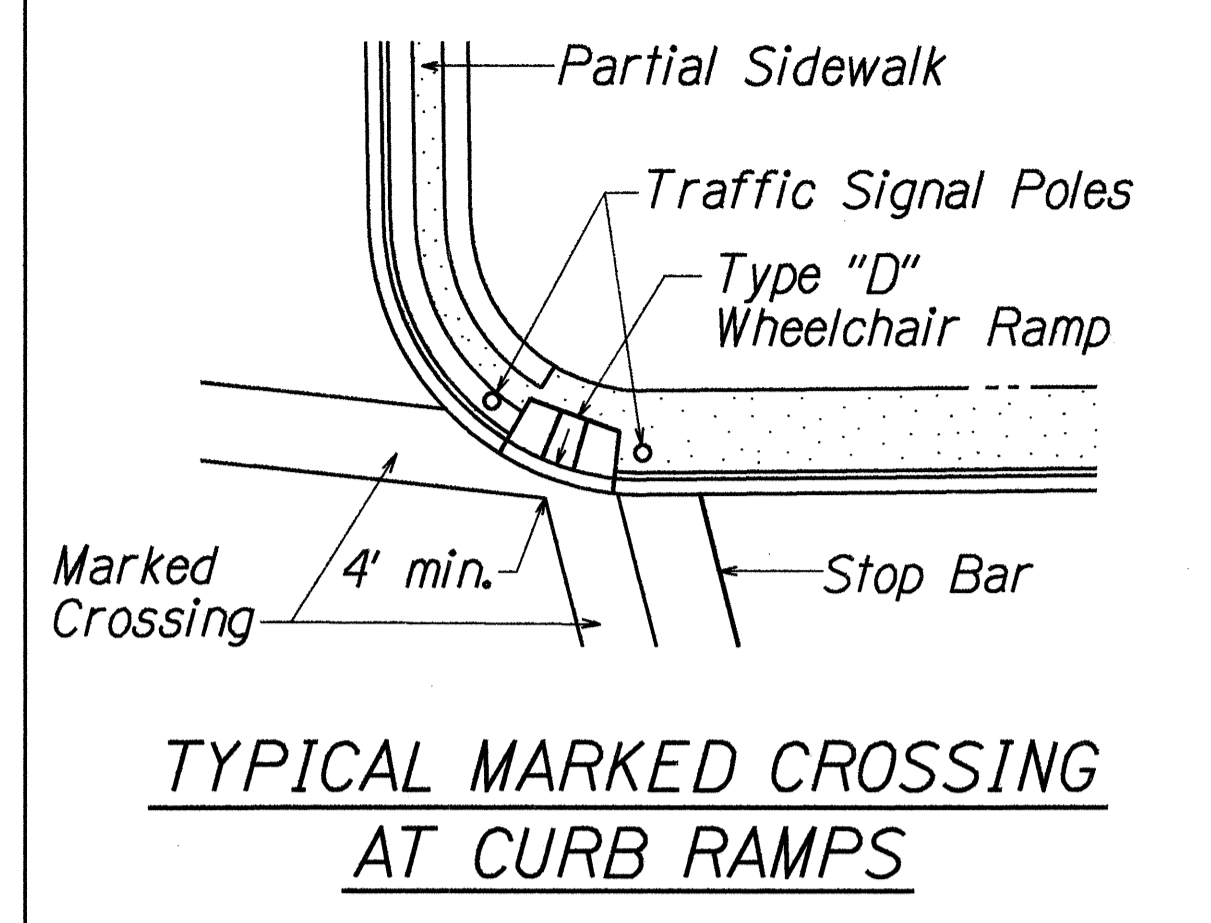

TRUE NORTH  
SCALE: 1" = 40'

DATE: \_\_\_\_\_  
SURVEY PLOTTED BY: \_\_\_\_\_  
PLAN DRAWN BY: \_\_\_\_\_  
NOTE BOOK NO. \_\_\_\_\_  
DESIGNED BY: \_\_\_\_\_  
CHECKED BY: \_\_\_\_\_

**LEGEND FOR AS-BUILT POSTINGS**

	Squiggly line for as-built deletion
	Double line for as-built deletion
Roadway	Text for as-built posting

STATE OF HAWAII  
DEPARTMENT OF TRANSPORTATION  
HIGHWAYS DIVISION

**PAVEMENT MARKING AND SIGNING PLAN**

PUUNENE AVENUE  
INTERSECTION IMPROVEMENTS  
at Kamehameha Ave.

F.A. PROJ. NO. HES-STP-3500(4)  
Scale: 1"=40' Date: July, 1993

SHEET No. T2 OF 7 SHEETS