
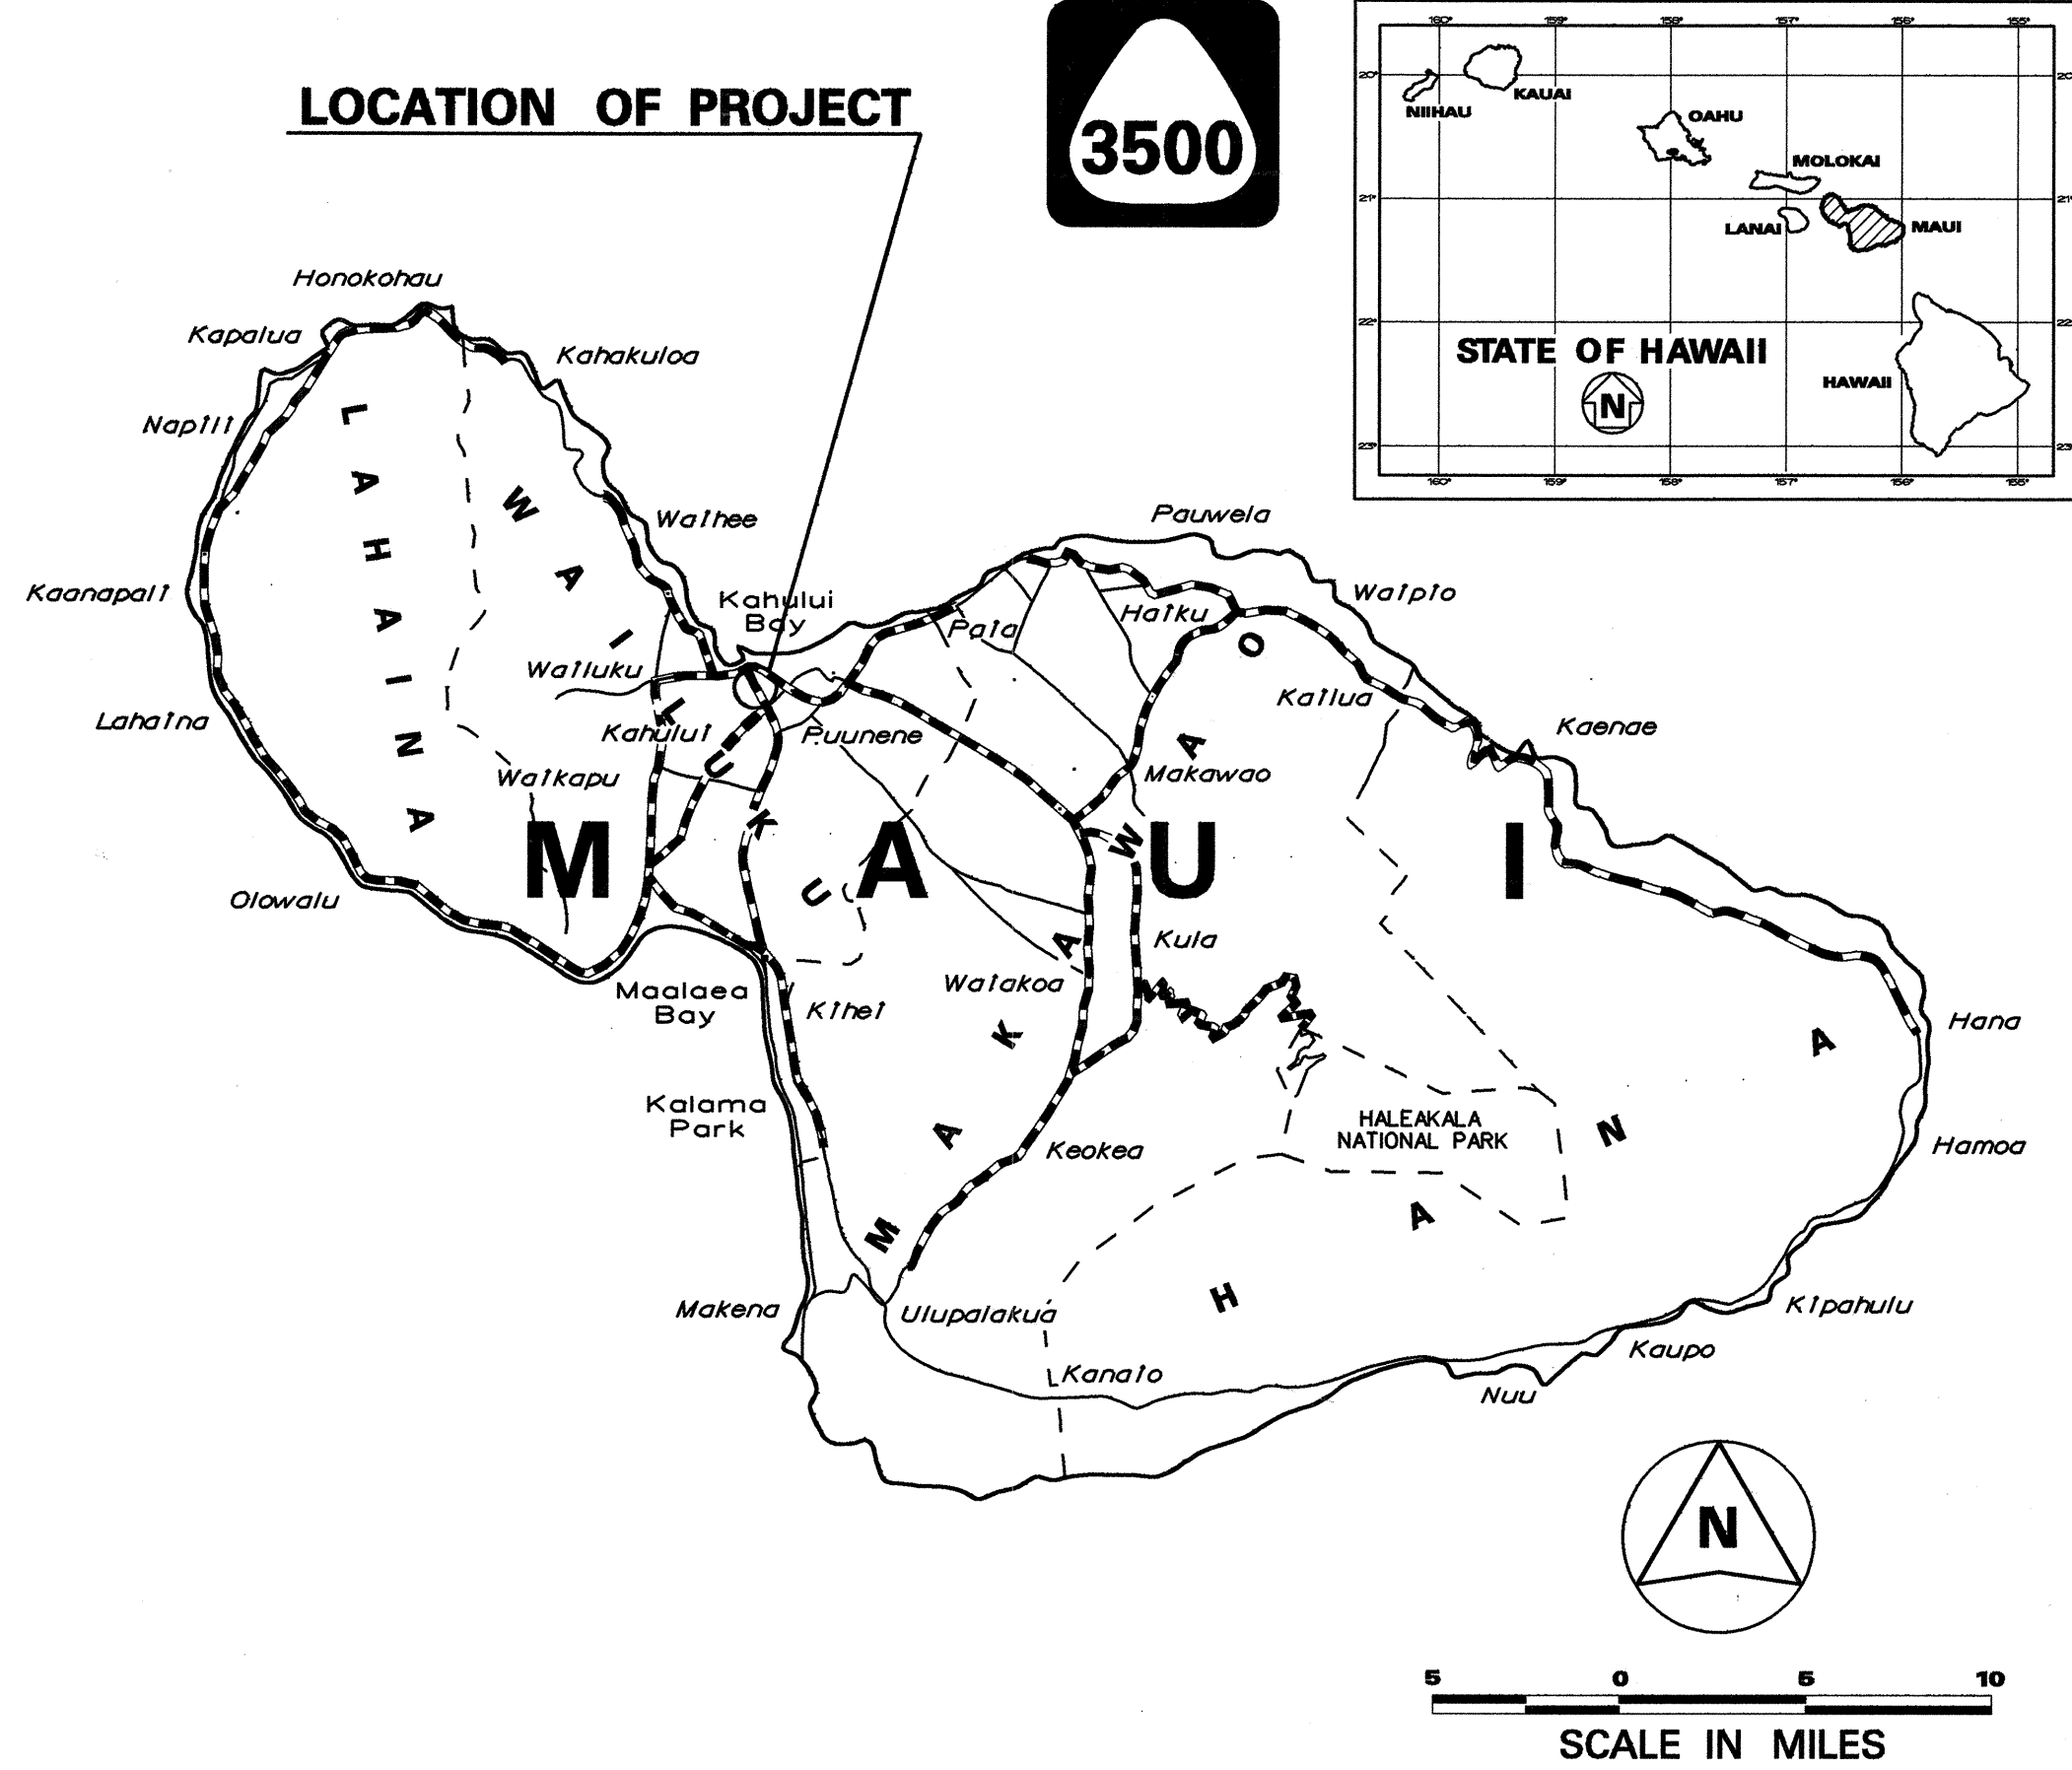


INDEX TO DRAWINGS	
SHEET NO.	DESCRIPTION
1	TITLE SHEET
2	STANDARD PLANS SUMMARY
3	GENERAL NOTES AND LEGEND
4 - 6	TYPICAL SECTIONS
7 - 8	TYPICAL DETAILS
9	PLAN
10 - 11	DETAILED ROADWAY PLANS
12	WATER NOTES
13	UTILITY RELOCATION PLAN
14	WATER RELOCATION PROFILES
15 - 16	DRAINAGE PLAN
17	DRAINAGE PROFILE
18 - 19	DRAINAGE DETAILS
20	PAVEMENT MARKING LEGEND, DETAILS & NOTES
21	PAVEMENT MARKING AND SIGNING PLAN
22	TRAFFIC SIGNAL LEGEND, DETAILS & NOTES
23	TRAFFIC SIGNAL PLAN
24	LOOP DETECTOR DETAILS
25	SIGN MOUNTING DETAIL
26	MISCELLANEOUS TRAFFIC SUMMARIES

STATE OF HAWAII
DEPARTMENT OF TRANSPORTATION
HIGHWAYS DIVISION
HONOLULU, HAWAII
"AS-BUILT"
PLANS FOR
PUUNENE AVENUE
INTERSECTION IMPROVEMENTS
AT KAMEHAMEHA AVENUE
FEDERAL-AID PROJECT NO. HES-STP-3500(4)
DISTRICT OF WAILUKU
ISLAND OF MAUI

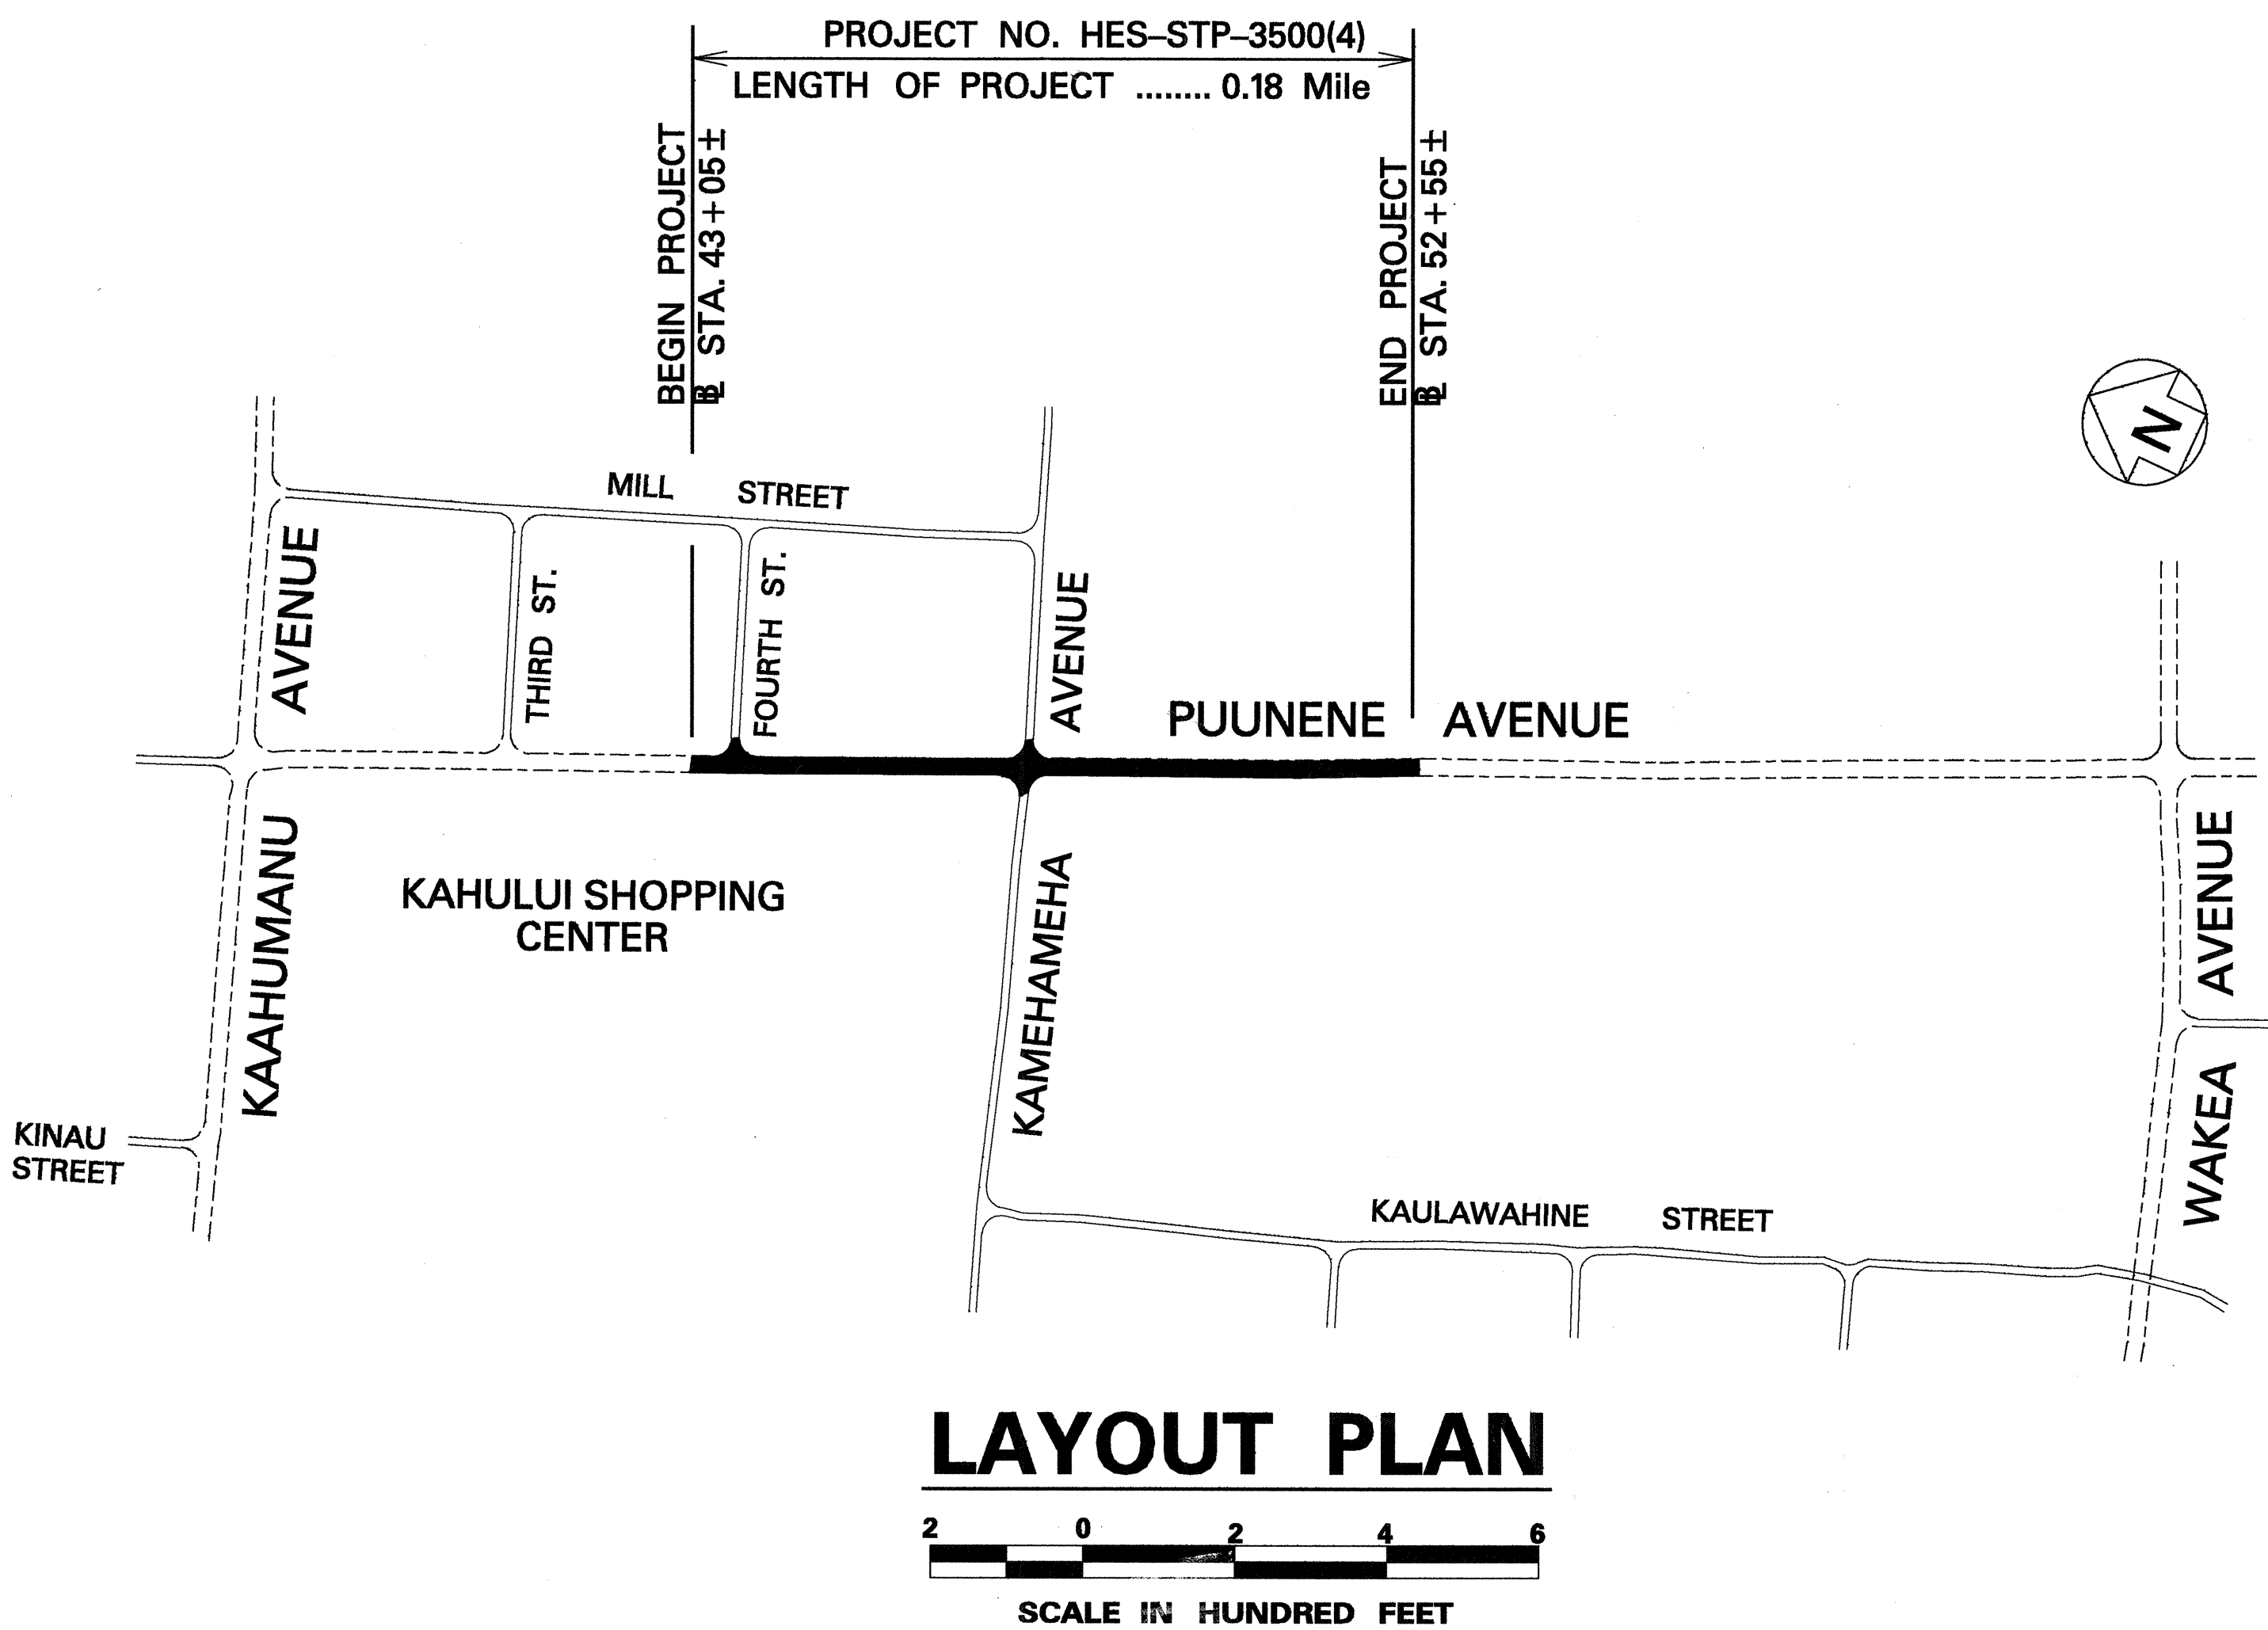

DESIGN DESIGNATION

ADT (1994)	20,000
ADT (2014)	33,750
DHV	3,040
D	60/40
T ₂₄	4.0 %
K	9.0%
V (Posted)	30 M.P.H.

NOTE:
ALL CHANGES MADE DURING CONSTRUCTION
HAVE BEEN NOTED IN RED ON THESE
TRACINGS AND CHECKED BY:

Resident Engineer
RESIDENT ENGINEER

9/3/98
DATE

DEPARTMENT OF TRANSPORTATION
STATE OF HAWAII

APPROVED:
Dir. of Transportation
DIR. OF TRANSPORTATION

12/30/93
DATE

HWY-DD UNIT A
DESIGNED BY

JULIUS B. FRONDA
P.S. & E.BY

587-2246
PHONE

DEC., 1993
DATE