



FED. ROAD DIST. NO.	STATE	FED. AID PROJ. NO.	FISCAL YEAR	SHEET NO.	TOTAL SHEETS
HAWAII	HAW.	HES-STP-3500(4)	1994	23	26

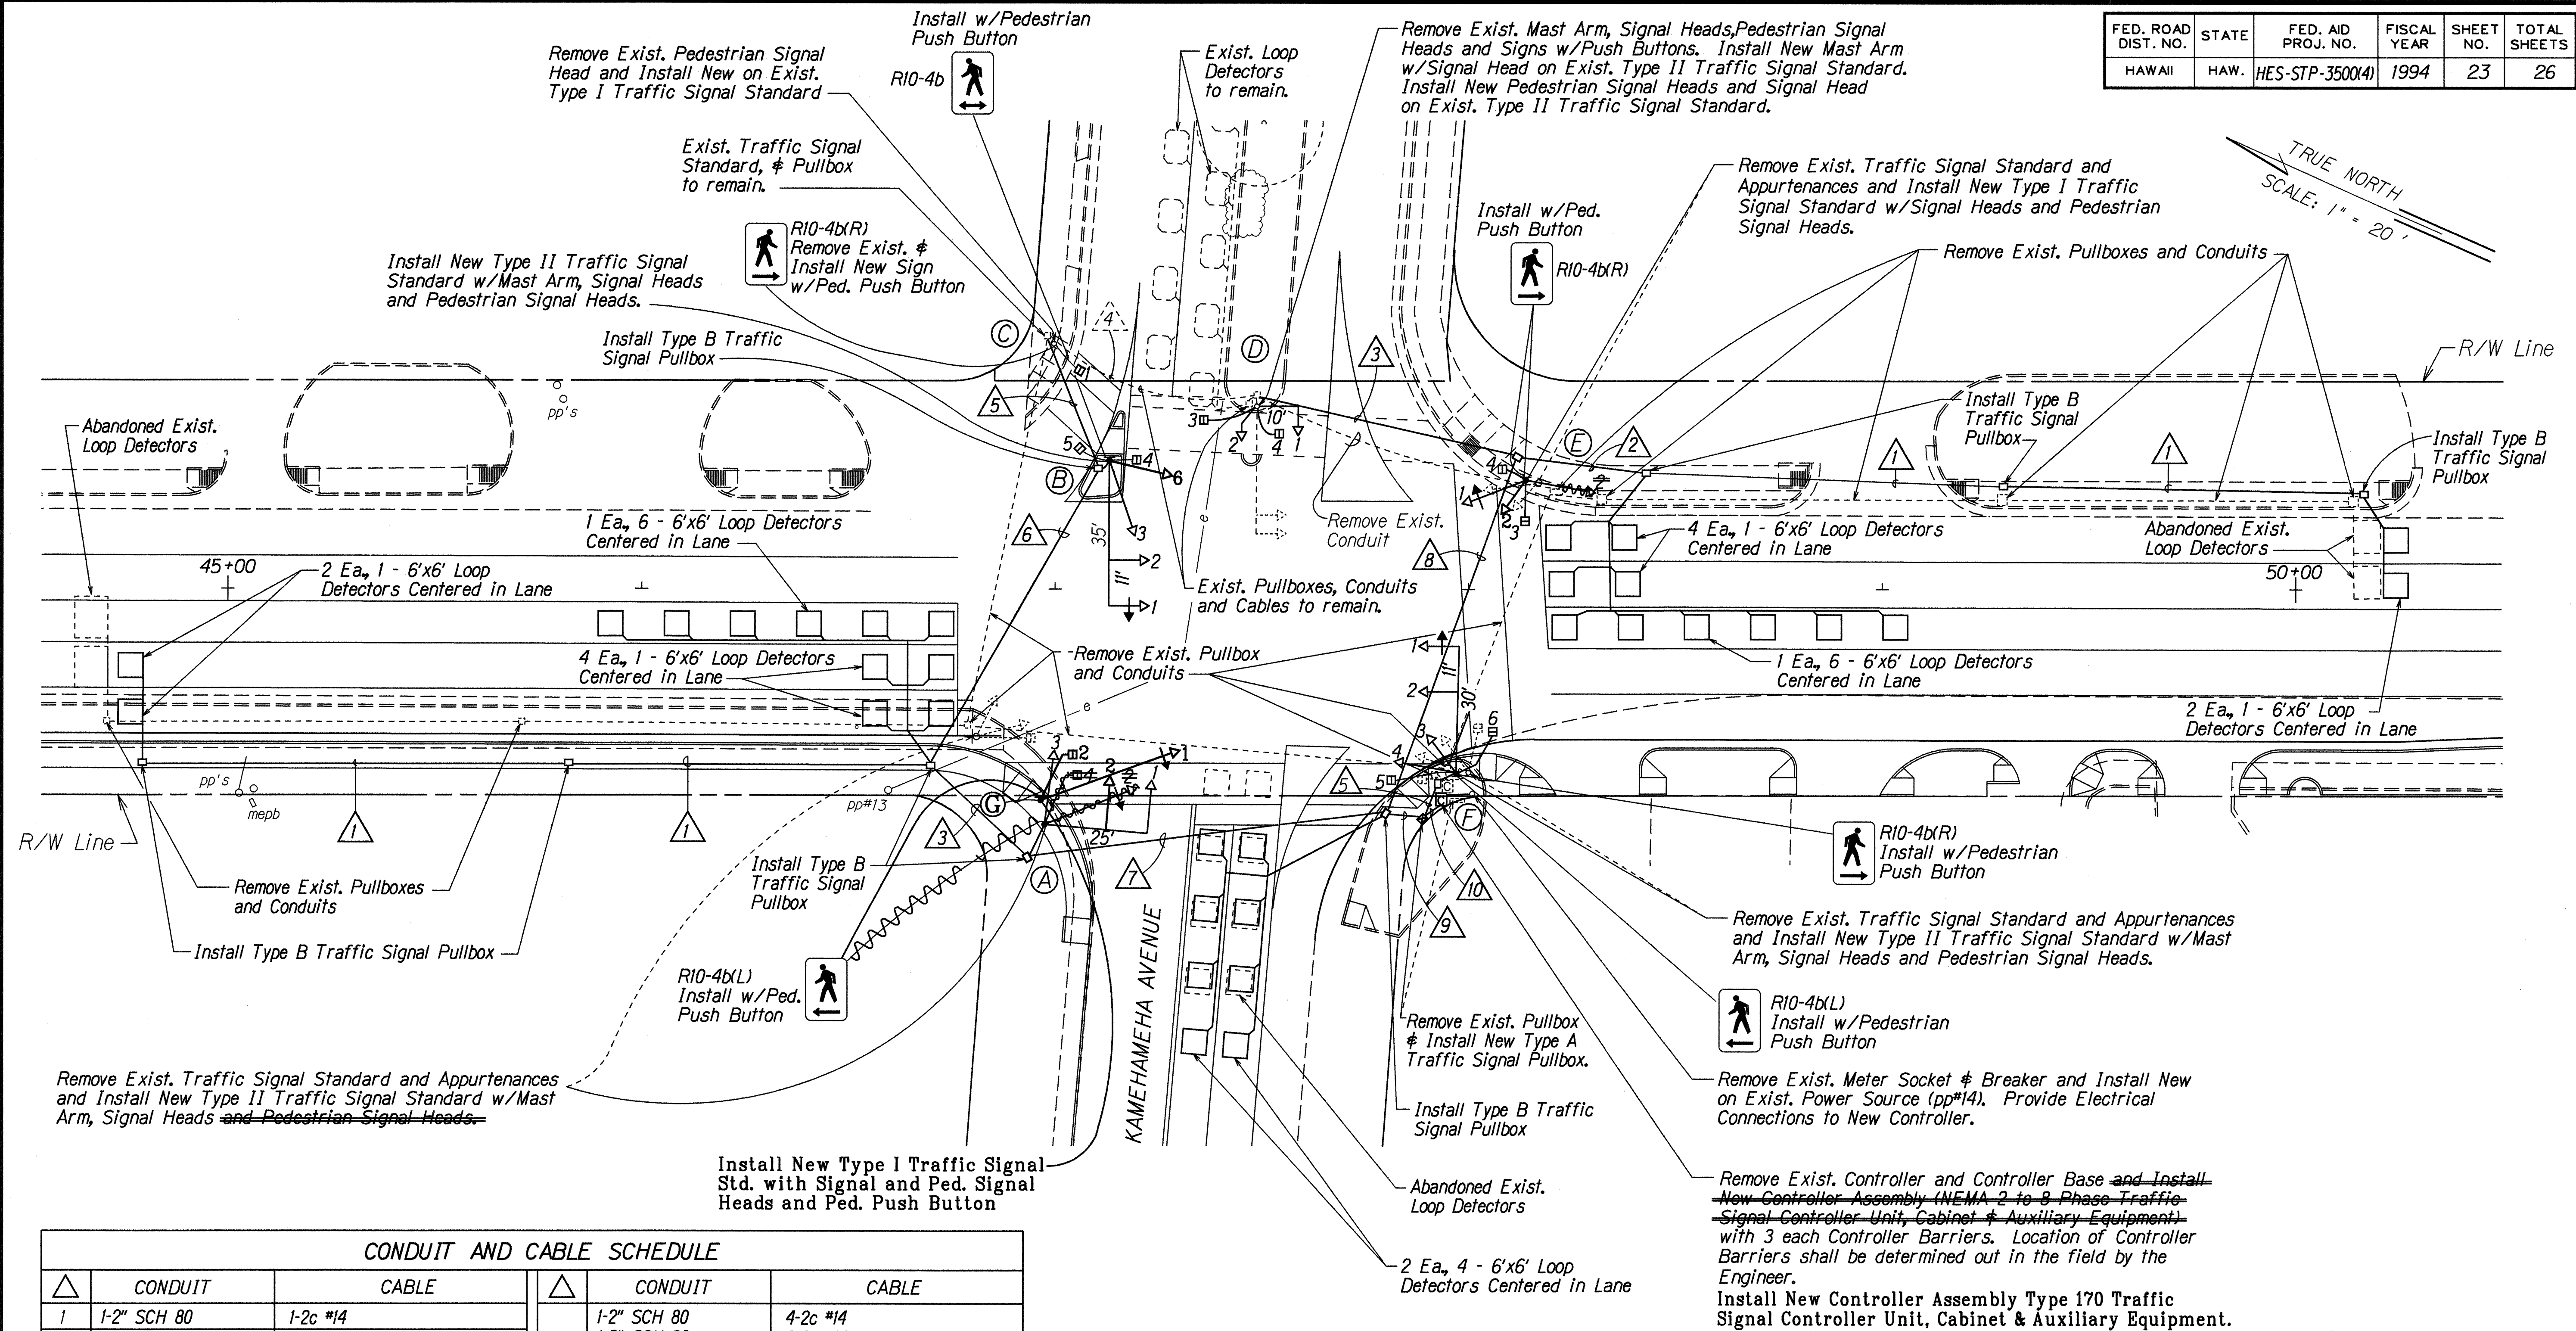

CONDUIT AND CABLE SCHEDULE					
△	CONDUIT	CABLE	△	CONDUIT	CABLE
1	1-2" SCH 80	1-2c #14	8	1-2" SCH 80	4-2c #14
2	1-2" SCH 80	3-2c #14		1-2" SCH 80	2-2c #14
3	1-2" SCH 80	3-2c #14		1-2" SCH 80	1-26c #14
	1-2" SCH 80	1-26c #14		1-2" SCH 80	SPARE
	1-2" SCH 80	SPARE	9	1-2" SCH 80	4-2c #14
4	1-2" SCH 80 (exist.)	1-2c #14 (exist. to remain)		1-2" SCH 80	4-2c #14
	1-2" SCH 80 (exist.)	1-26c #14 (exist. to remain)		1-2" SCH 80	3-2c #14
	1-2" SCH 80 (exist.)	SPARE		1-2" SCH 80	1-26c #14
5	1-2" SCH 80	1-2c #14	10	1-2" SCH 80	SPARE
	1-2" SCH 80	1-26c #14		1-2" SCH 80	4-2c #14
	1-2" SCH 80	SPARE		1-2" SCH 80	4-2c #14
6	1-2" SCH 80	1-26c #14		1-2" SCH 80	4-2c #14
	1-2" SCH 80	SPARE		1-2" SCH 80	1-26c #14
	1-2" SCH 80	SPARE		1-2" SCH 80	1-26c #14
7	1-2" SCH 80	4-2c #14		1-2" SCH 80	SPARE
	1-2" SCH 80	1-26c #14			
	1-2" SCH 80	SPARE			

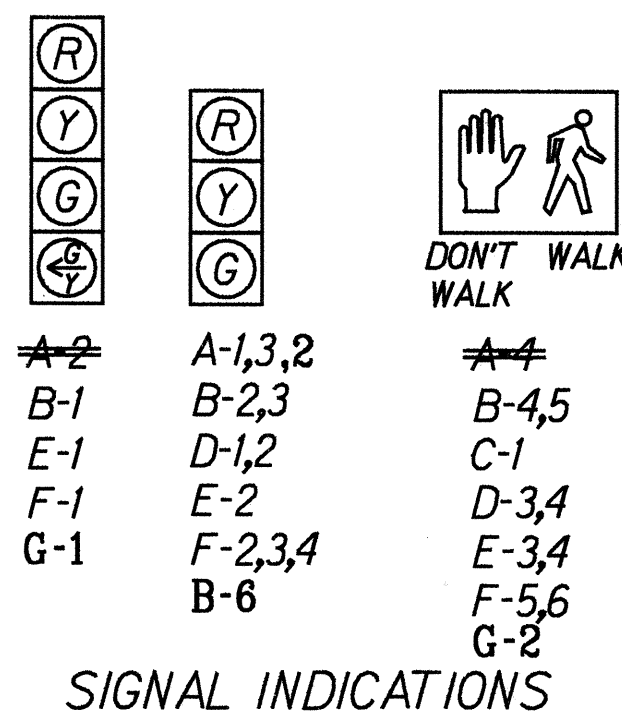

LEGEND FOR AS-BUILT POSTINGS	
	Squiggly line for as-built deletion
	Double line for as-built deletion
	Text for as-built posting

STATE OF HAWAII
DEPARTMENT OF TRANSPORTATION
HIGHWAYS DIVISION

TRAFFIC SIGNAL PLAN

PUUNENE AVENUE

INTERSECTION IMPROVEMENTS

at Kamehameha Ave.

F.A. PROJ. NO. HES-STP-3500(4)

Scale: 1" = 20' Date: July, 1993

SHEET No. 24 OF 7 SHEETS

"AS-BUILT"