
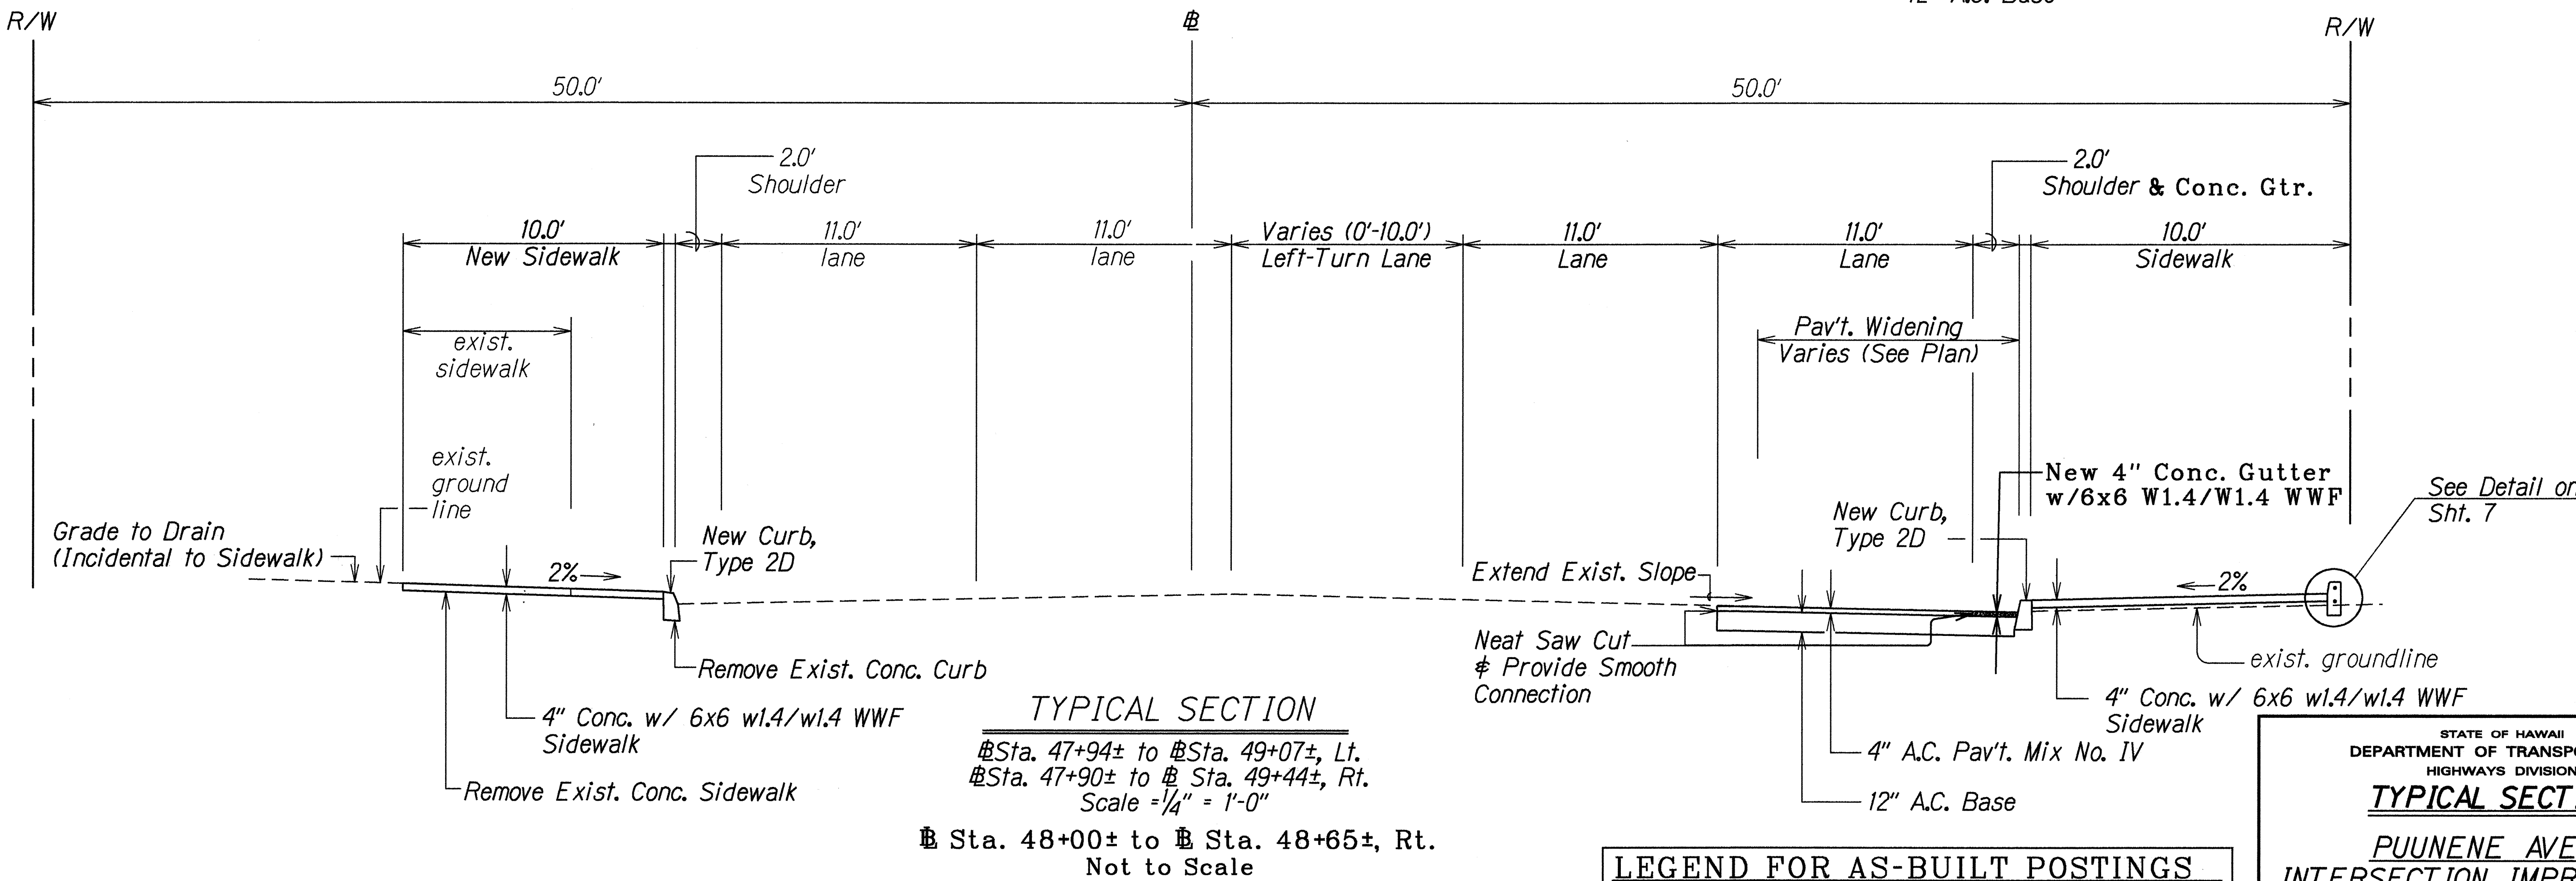


| FED. ROAD DIST. NO. | STATE | FEDERAL AID PROJ. NO. | FISCAL YEAR | SHEET NO. | TOTAL SHEETS |
|---------------------|-------|-----------------------|-------------|-----------|--------------|
| HAWAII              | HAW.  | HES-STP-3500(4)       | 1994        | 4         | 26           |


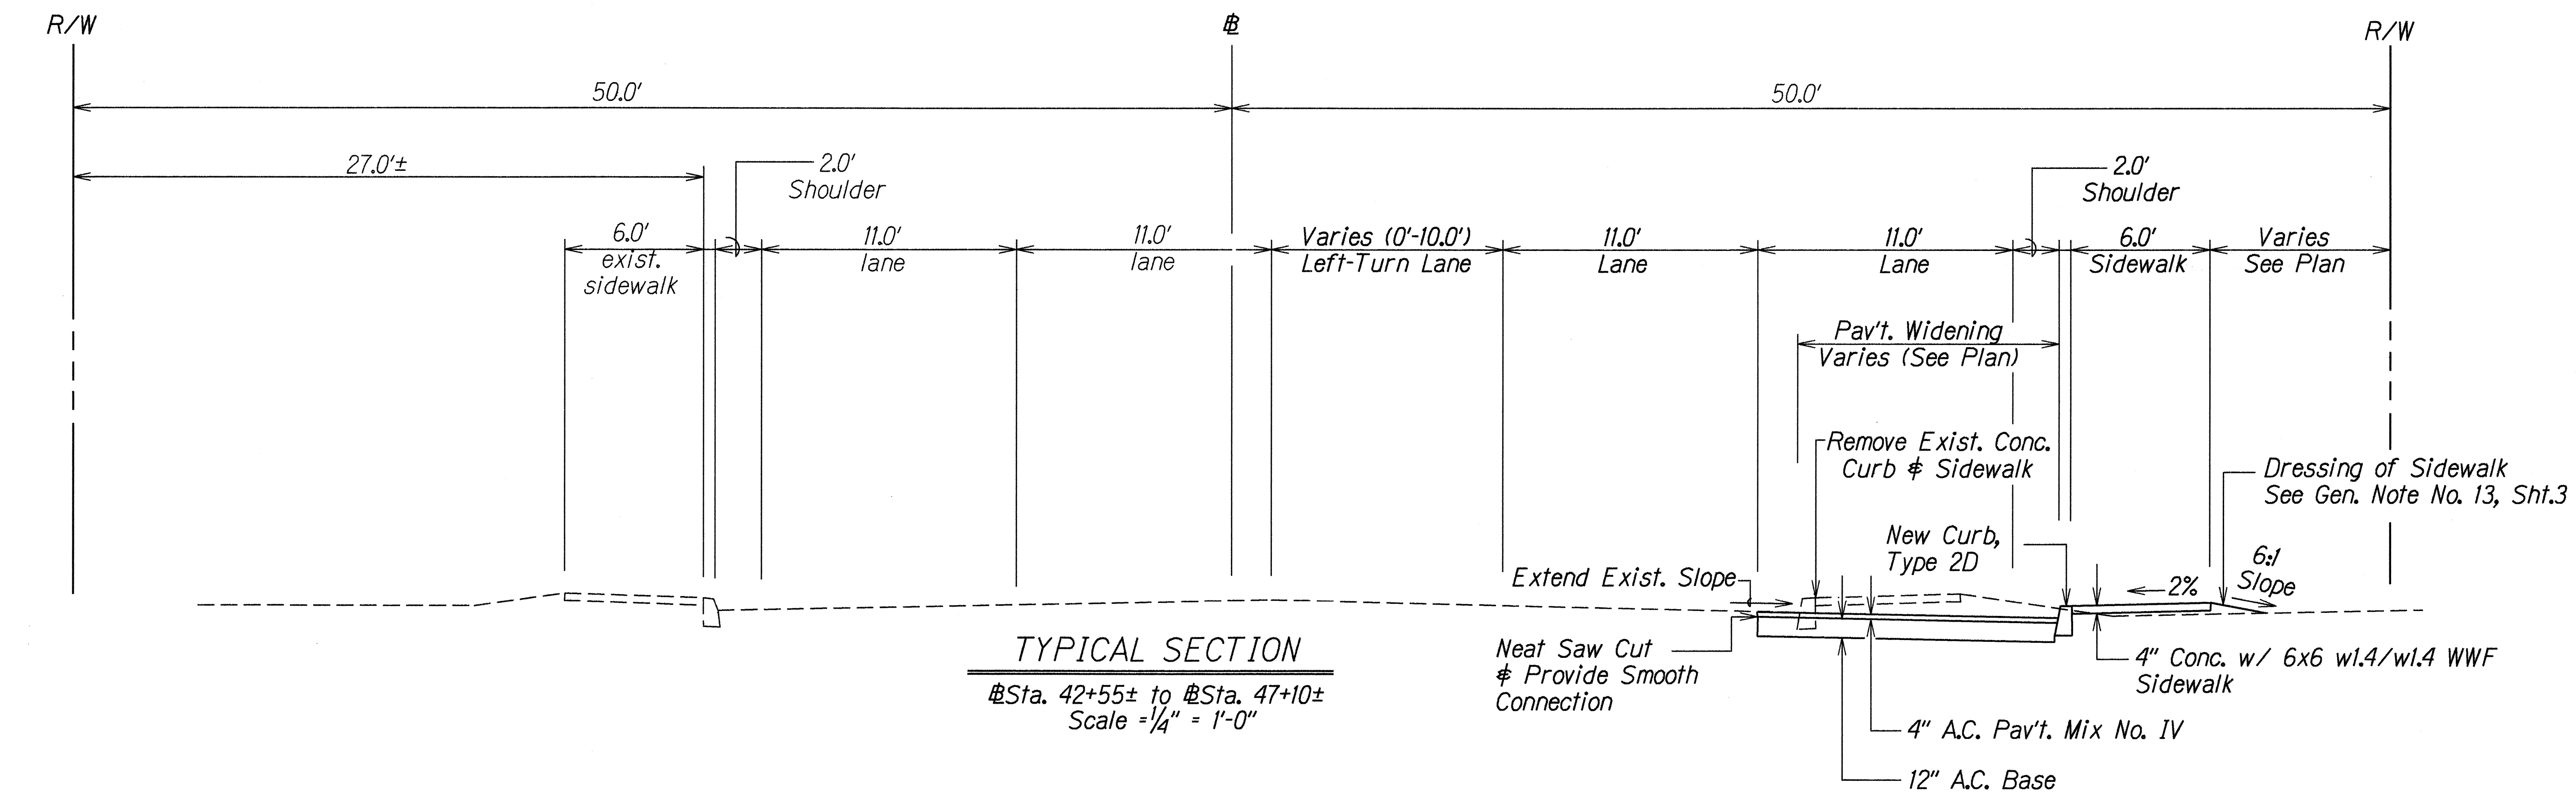


| LEGEND FOR AS-BUILT POSTINGS |                                     |
|------------------------------|-------------------------------------|
|                              | Squiggly line for as-built deletion |
|                              | Double line for as-built deletion   |
|                              | Text for as-built posting           |

STATE OF HAWAII  
 DEPARTMENT OF TRANSPORTATION  
 HIGHWAYS DIVISION  
**TYPICAL SECTION**  
 PUUNENE AVENUE  
 INTERSECTION IMPROVEMENTS  
 at Kamehameha Avenue  
 F.A. Project No. HES-STP-3500(4)  
 Scale: As Shown Date: December, 1993  
 SHEET No. 1 OF 3 SHEETS

"AS-BUILT"


| FED. ROAD DIST. NO. | STATE | FEDERAL AID PROJ. NO. | FISCAL YEAR | SHEET NO. | TOTAL SHEETS |
|---------------------|-------|-----------------------|-------------|-----------|--------------|
| HAWAII              | HAW.  | HES-STP-3500(4)       | 1994        | 5         | 26           |

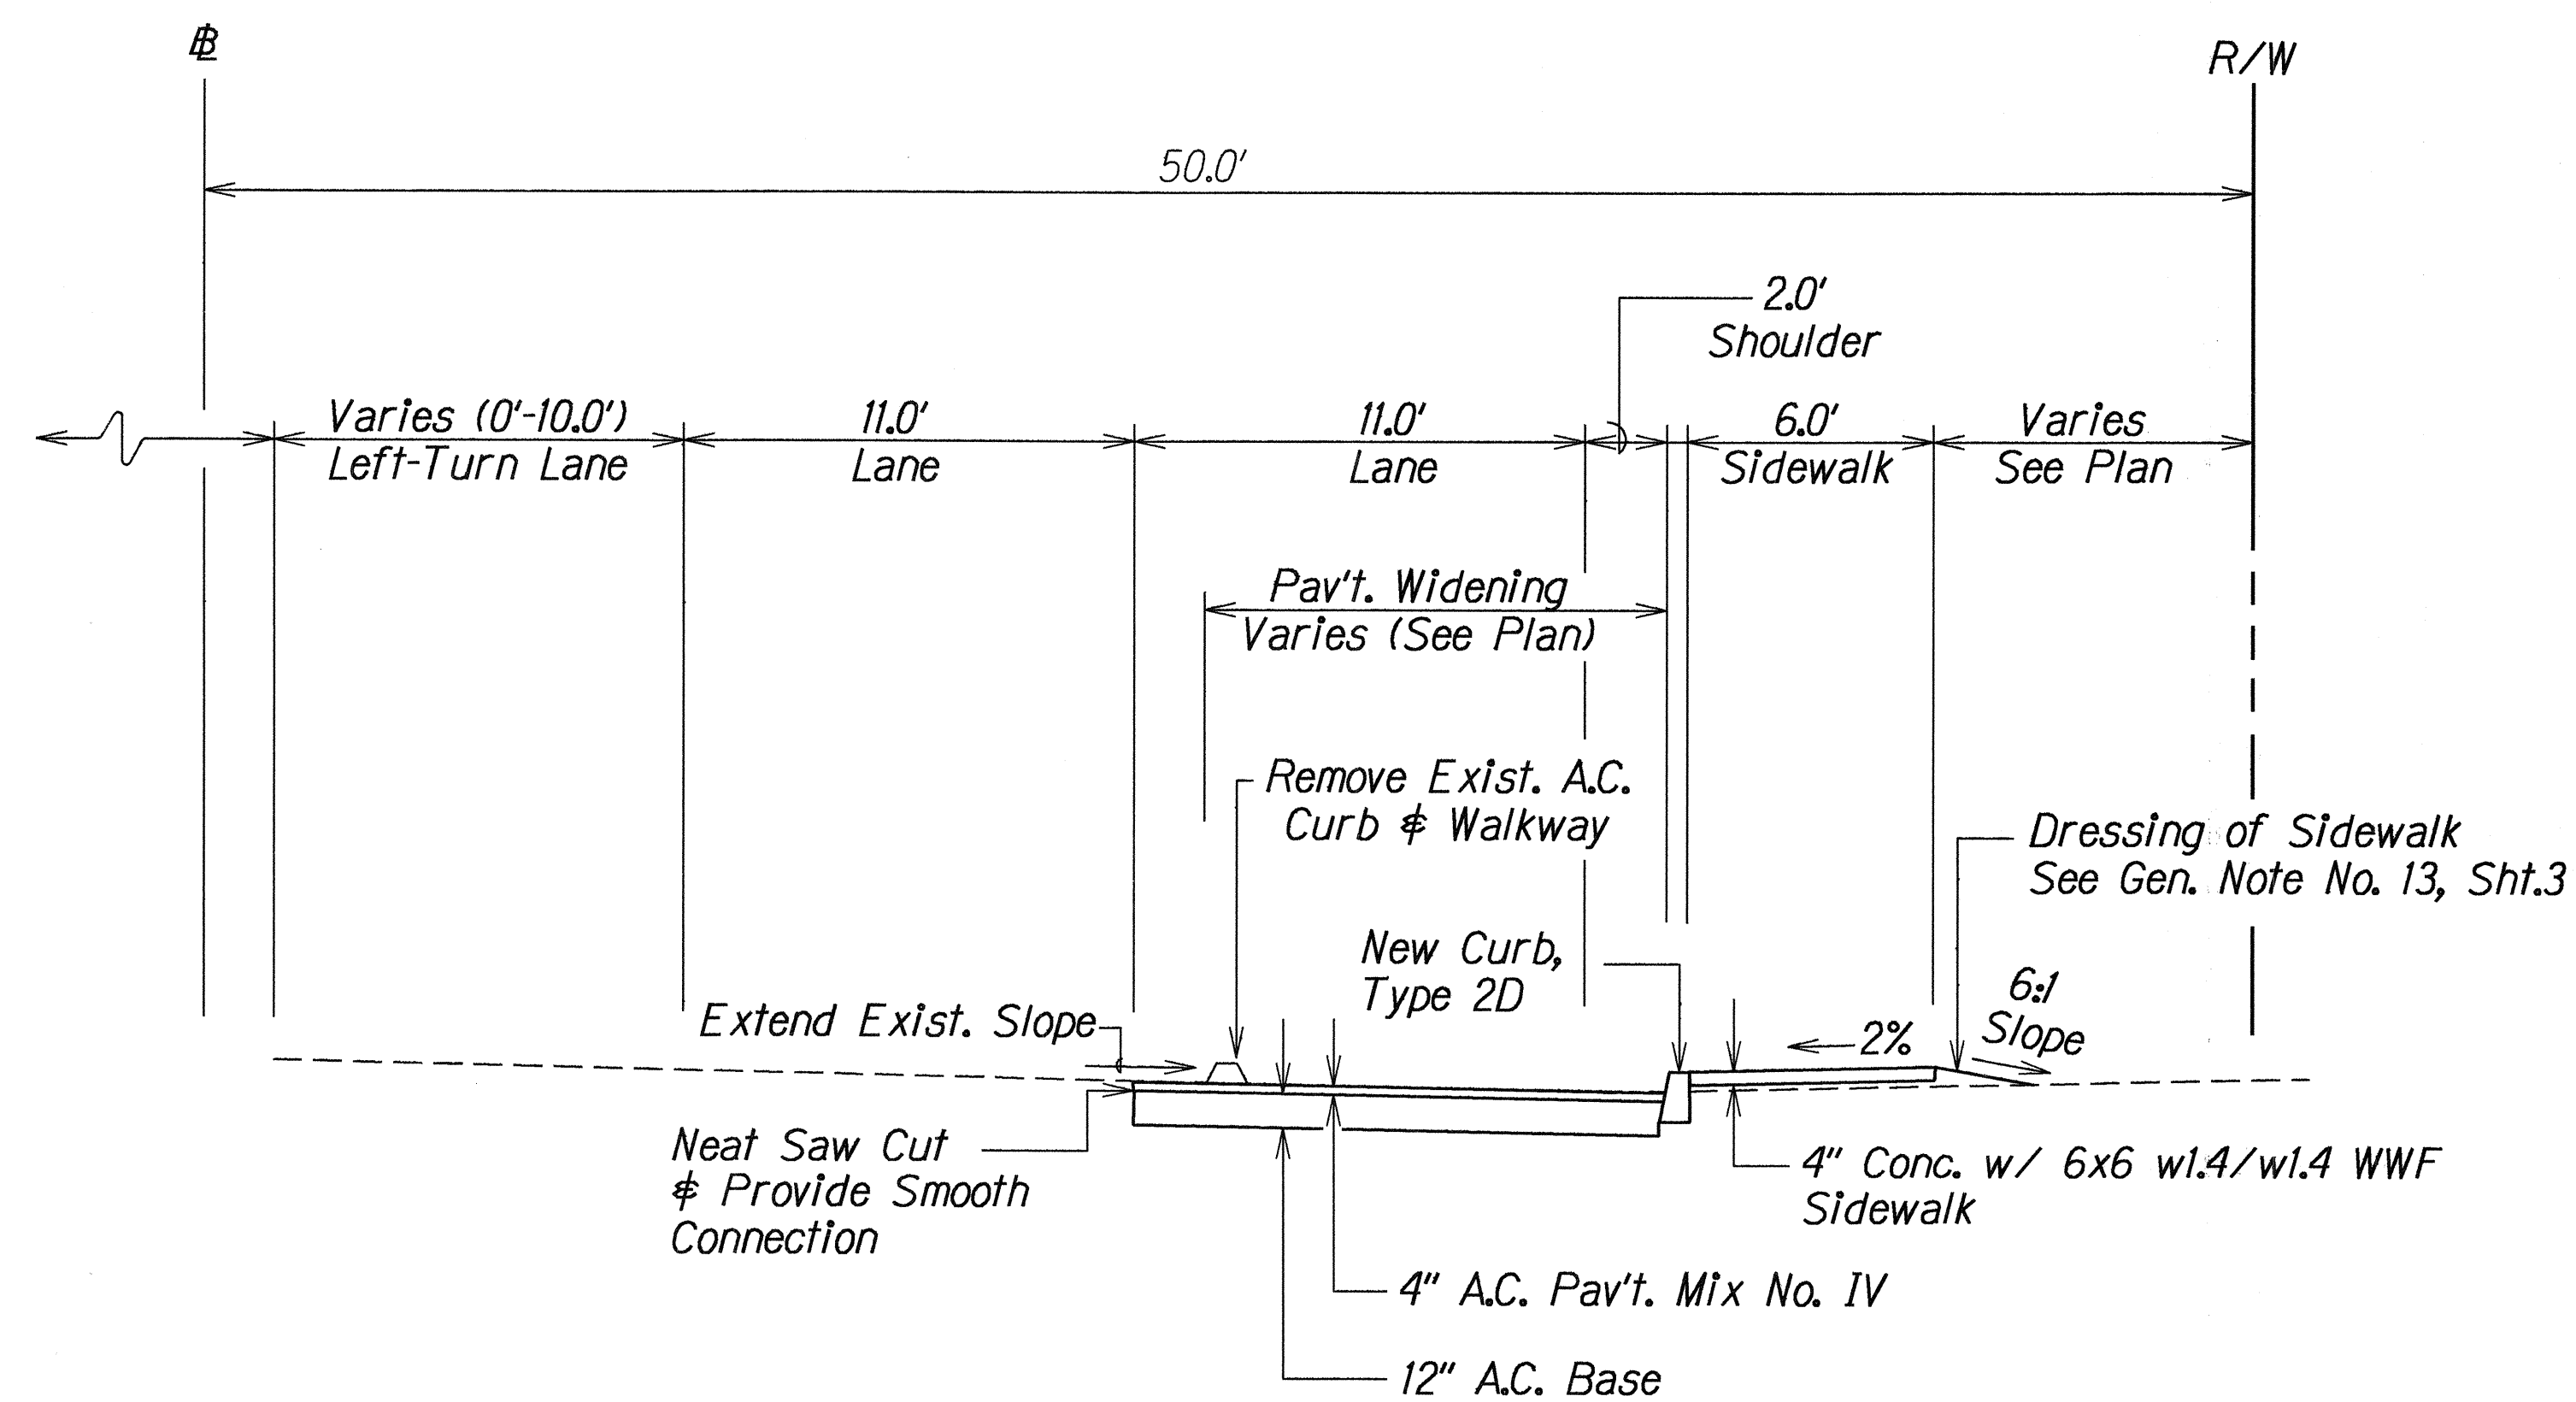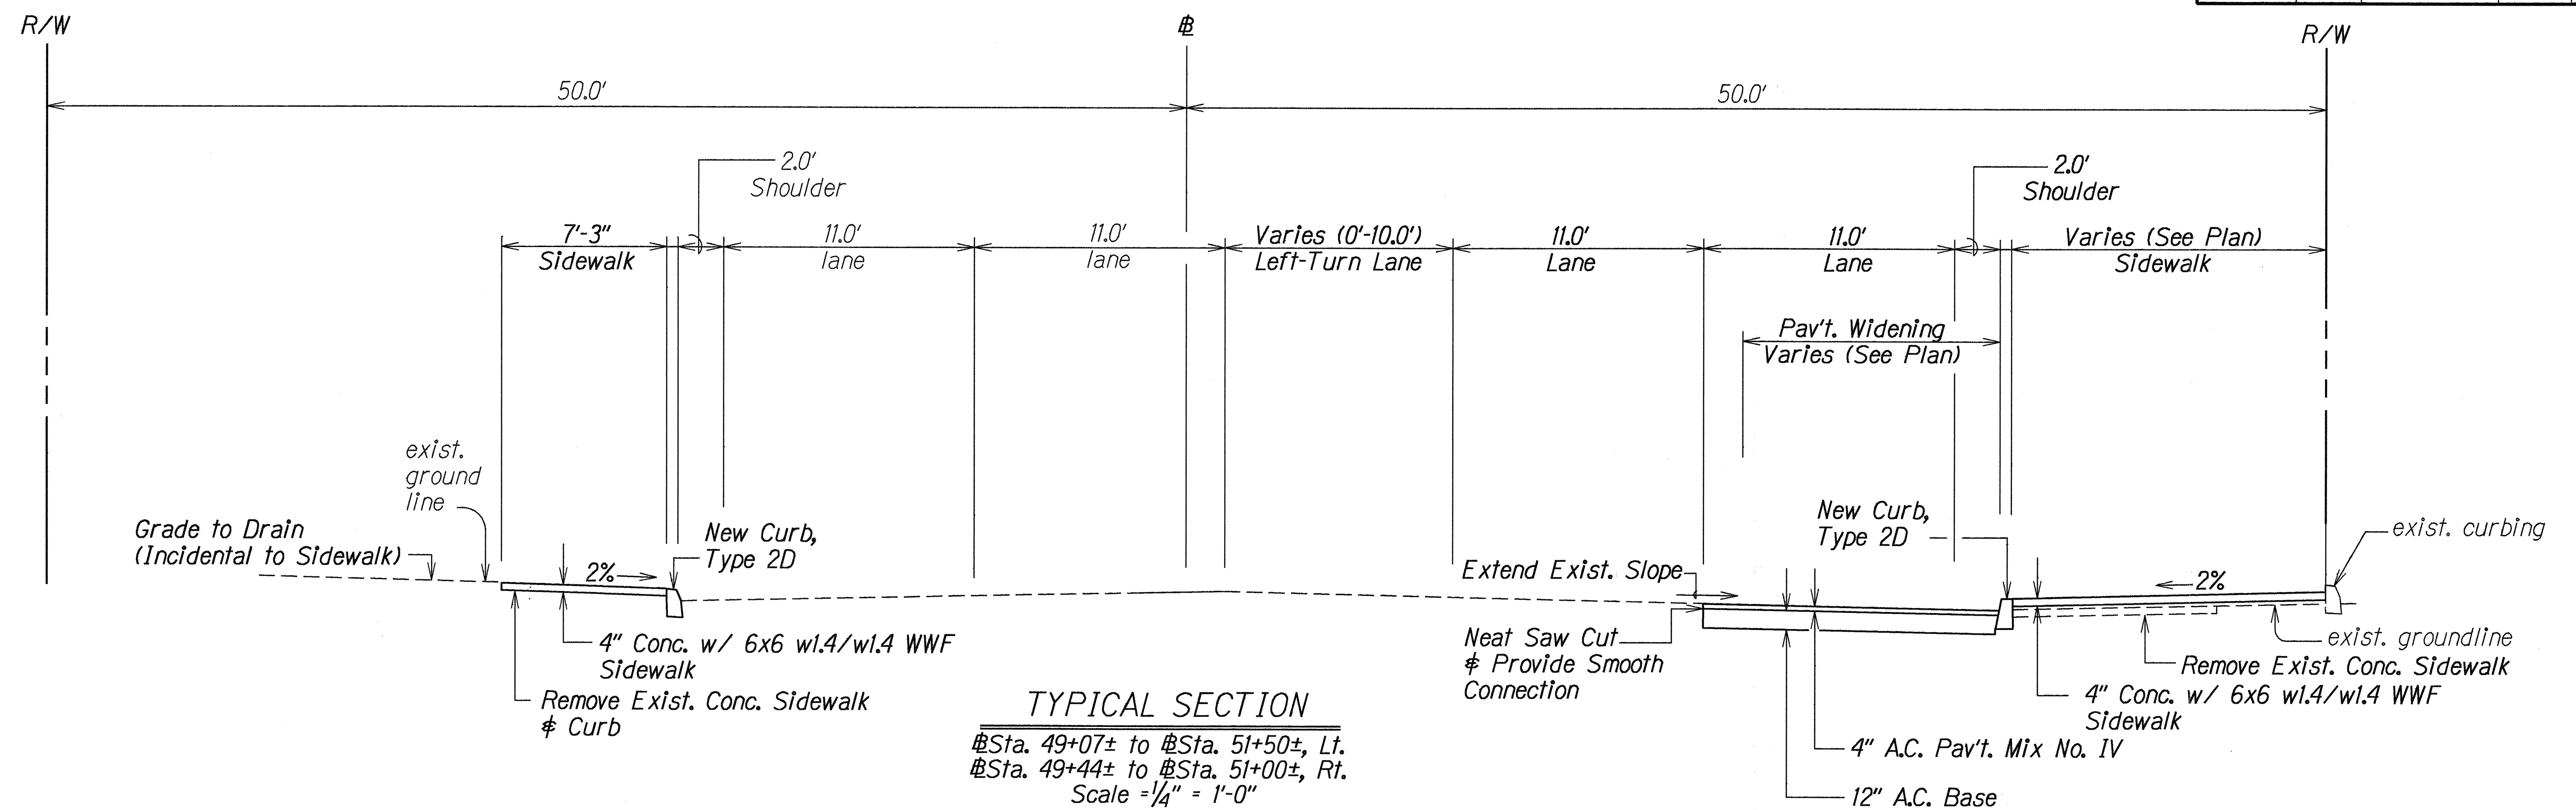

|                   |      |
|-------------------|------|
| ORIGINAL PLAN     | DATE |
| SURVEY PLOTTED BY |      |
| DRAWN BY          |      |
| DESIGNED BY       |      |
| CHECKED BY        |      |
| NOTED BY          |      |
| IN CHARGE         |      |

STATE OF HAWAII  
 DEPARTMENT OF TRANSPORTATION  
 HIGHWAYS DIVISION  
**TYPICAL SECTION**  
**PUUNENE AVENUE**  
**INTERSECTION IMPROVEMENTS**  
**at Kamehameha Avenue**  
 F.A. Project No. HES-STP-3500(4)  
 Scale: As Shown Date: December, 1993  
 SHEET No. 2 OF 3 SHEETS

| FED. ROAD DIST. NO. | STATE | FEDERAL AID PROJ. NO. | FISCAL YEAR | SHEET NO. | TOTAL SHEETS |
|---------------------|-------|-----------------------|-------------|-----------|--------------|
| HAWAII              | HAW.  | HES-STP-3500(4)       | 1994        | 6         | 26           |

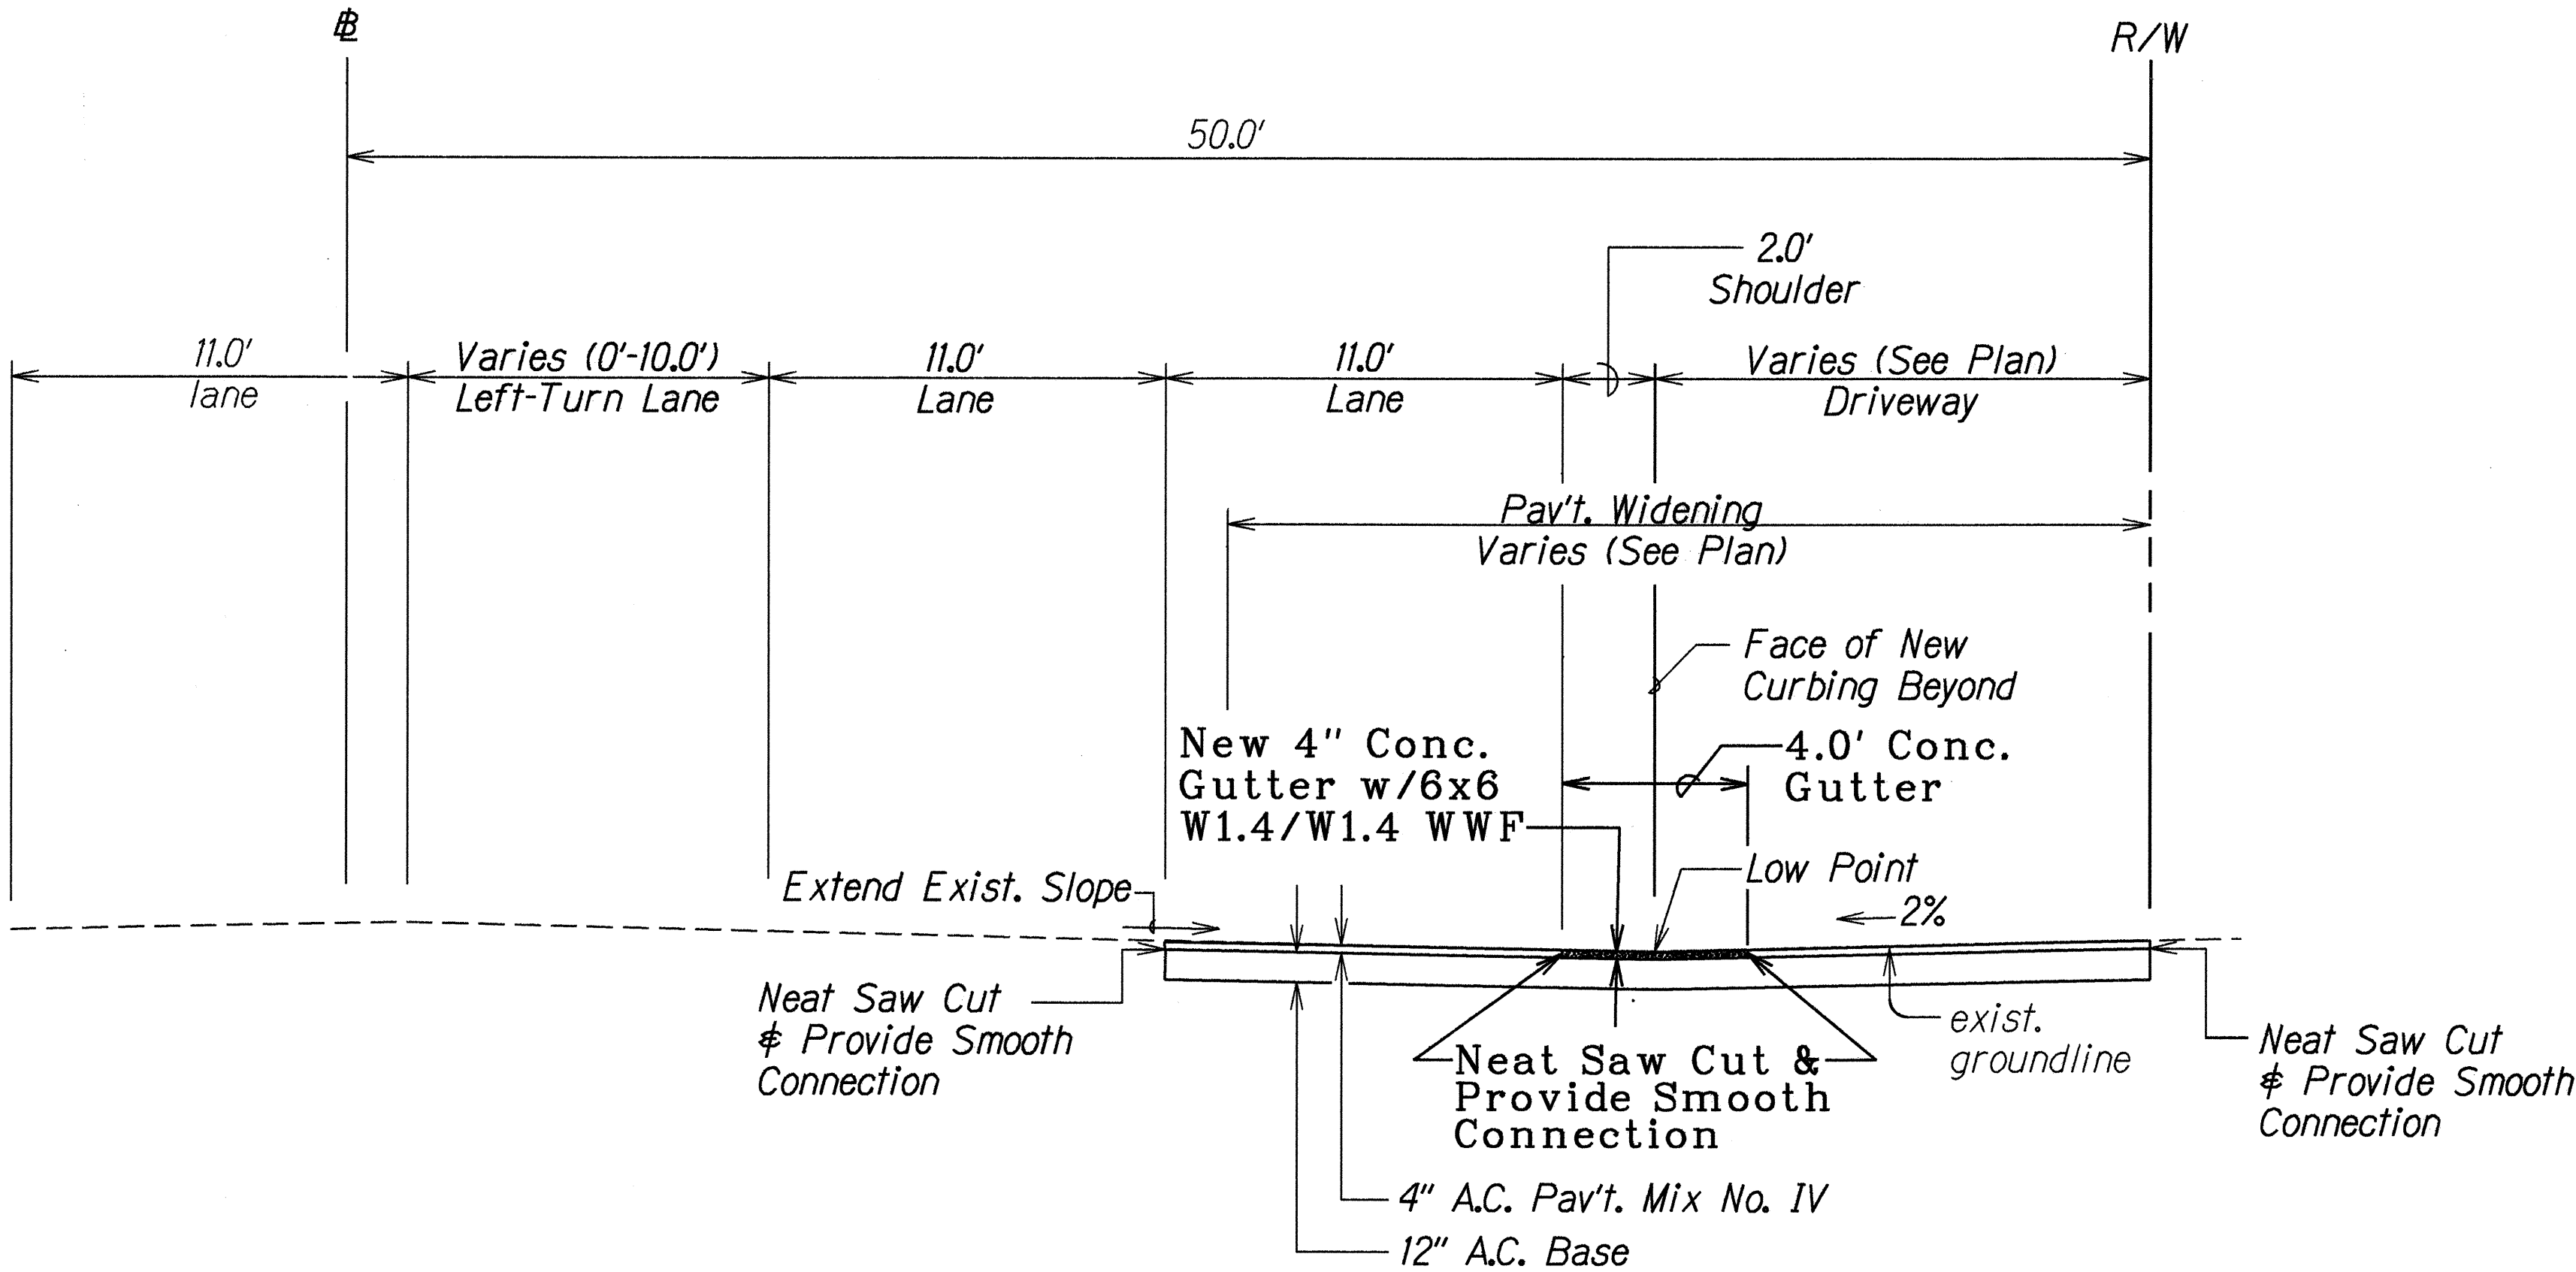

TYPICAL SECTION AT DRIVEWAYS

CLSta. 47+95± to CLSta. 51+00±  
Scale = 1/4" = 1'-0"  
CL Sta. 48+00± to CL Sta. 48+65±, Rt.

|               |                   |      |
|---------------|-------------------|------|
| ORIGINAL PLAN | SURVEY PLOTTED BY | DATE |
| NOTE BOOK     | DRAWN BY          |      |
| DESIGNED BY   | TRACED BY         |      |
| CHECKED BY    | DESIGNED BY       |      |
| NO. 100013    | CHECKED BY        |      |

| LEGEND FOR AS-BUILT POSTINGS |                                     |
|------------------------------|-------------------------------------|
|                              | Squiggly line for as-built deletion |
|                              | Double line for as-built deletion   |
| Roadway                      | Text for as-built posting           |

STATE OF HAWAII  
DEPARTMENT OF TRANSPORTATION  
HIGHWAYS DIVISION

TYPICAL SECTION  
PUUNENE AVENUE  
INTERSECTION IMPROVEMENTS  
at Kamehameha Avenue  
F.A. Project No. HES-STP-3500(4)  
Scale: As Shown Date: December, 1993  
SHEET No. 3 OF 3 SHEETS

"AS-BUILT"