


FED. ROAD DIST. NO.	STATE	FEDERAL AID PROJ. NO.	FISCAL YEAR	SHEET NO.	TOTAL SHEETS
HAWAII	HAW.	HES-STP-3500(4)	1994	13	26

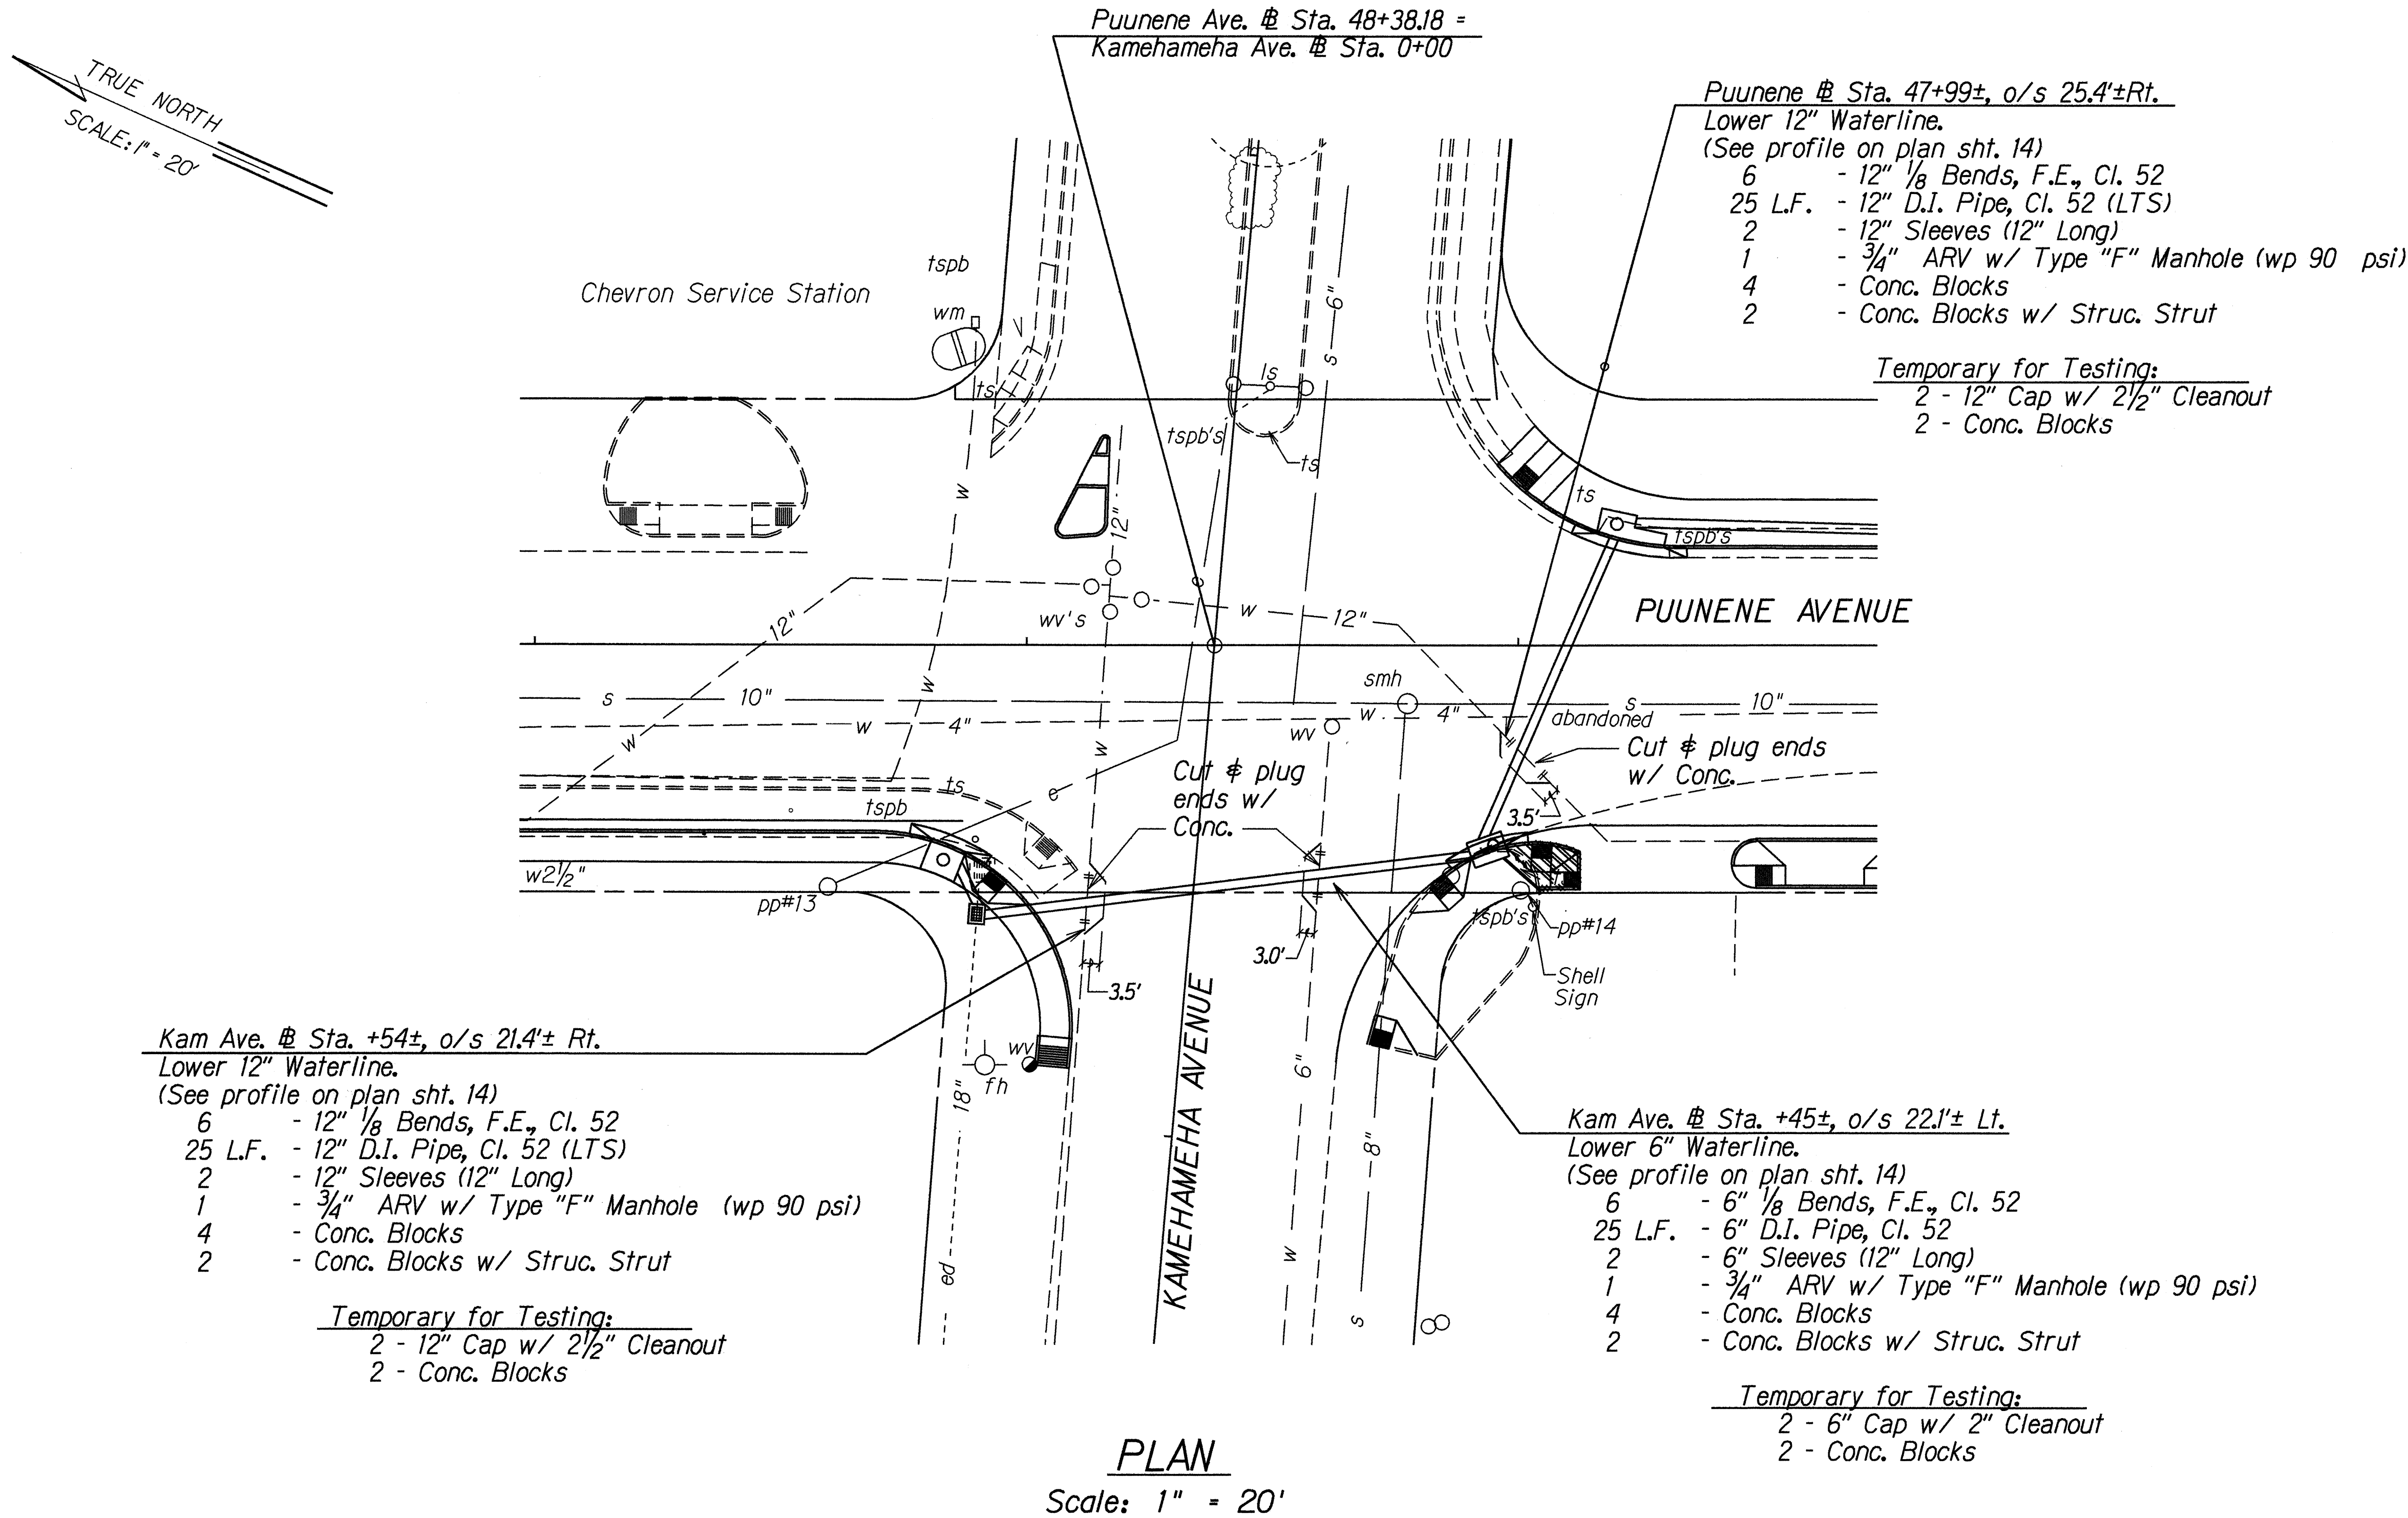

ORIGINAL PLAN	SURVEY PLOTTED BY	DATE
TRACED BY	DRAWN BY	
NOTE BOOK	CHECKED BY	
08/19/94	QUANTITIES BY	
N. [Signature]	CHECKED BY	

LEGEND FOR AS-BUILT POSTINGS	
	Squiggly line for as-built deletion
	Double line for as-built deletion
Roadway	Text for as-built posting

STATE OF HAWAII
DEPARTMENT OF TRANSPORTATION
HIGHWAYS DIVISION
UTILITY RELOCATION PLAN
PUUNENE AVENUE
INTERSECTION IMPROVEMENTS
at Kamehameha Ave.
F.A. Project No. HES-STP-3500(4)
Scale: As Shown Date: December, 1993
SHEET No. 1 OF 1 SHEETS