STATE OF HAWAII

## DEPARTMENT OF TRANSPORTATION

HIGHWAYS DIVISION HONOLULU, HAWAII


OF AS-BUILT

## **PLANS FOR**

## PUUNENE AVENUE IMPROVEMENTS

WAKEA AVENUE TOWARDS AIAI STREET
FEDERAL AID PROJECT NO. HES-STP-3500(3)

DISTRICT OF WAILUKU ISLAND OF MAUI

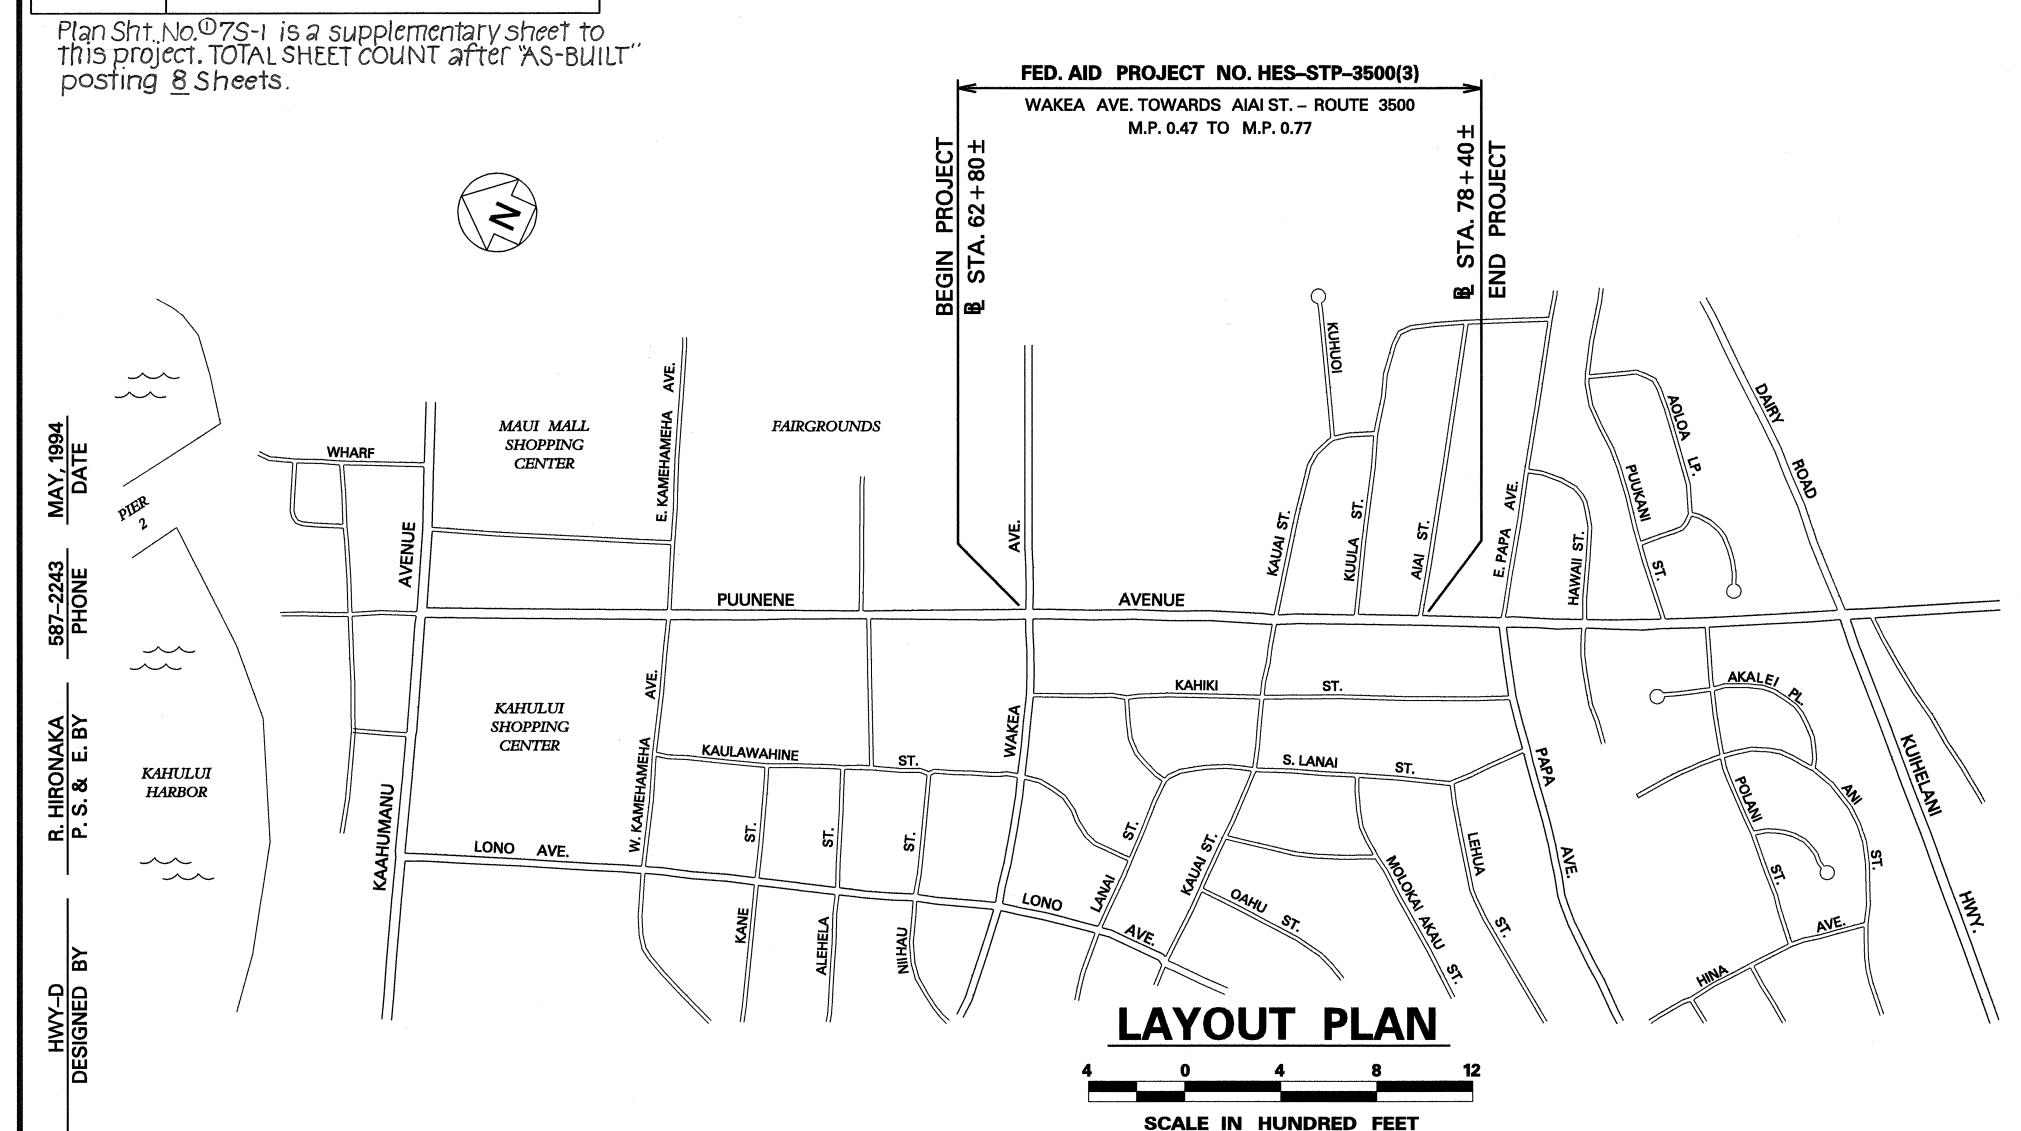

Honokohau

Kapalua

Rahakuloa

PROJECT LOCATION

STATE OF HAWAII

HAWAII

HAWAII

Bay

Fata

Rahakuloa

Rahaku

FED. ROAD DIST. NO.

STATE

FED. AID PROJ. NO.

HAW. | HES-STP-3500(3) | 1994

FISCAL YEAR

SHEETS

FEDERAL AID PROJECTS PREVIOUSLY CONSTRUCTED OR UNDER CONSTRUCTION

ROUTE 3500 MILE POST <u>0.47</u> TO MILE POST <u>0.77</u>

## DESIGN DESIGNATION

ADT (1993)	. 20,900
ADT (2003)	.26,300
DHV	. 2,400
D	. 60/40
T	. 3.5 %
T <sub>24</sub>	. 4.0 %

CHANGES MADE DURING CONSTRUCTION HAVE BEE INCORPORATED ON THESE PLANS EXCEPT CHANGE IN THE ORIGINAL THEORETICAL QUANTITIES. FO ACTUAL QUANTITIES, REFER TO PROJECT LEDGE AND/OR COMPUTATION BOOK.



DEPARTMENT OF TRANSPORTATION STATE OF HAWAII	
APPROVED:	
Hara	
DIR. OF TRANSPOR	TATION DATE