



FED. ROAD DIST. NO.	STATE	FED. AID PROJ. NO.	FISCAL YEAR	SHEET NO.	TOTAL SHEETS
HAWAII	HAW.	HES-STP-3500(3)	1994	4	7

NOTES


1. New paved shoulder tapers 2.0' to 4.0' from Sta. 62+80± to Sta. 63+30±.
2. New thru lanes taper 12.0' to 11.0' from Sta. 68+00± to Sta. 71+00±.
3. 4.0' min. ^{70+96±}grassed surface between E.S. and new sidewalk for Sta. ~~69+95±~~ RT. to Sta. 73+75± RT. 3.0' min. grassed surface between E.S. and new sidewalk for Sta. 76+20± RT. to Sta. 77+65± RT.
4. 20:1 max. slope across crosswalks with 10' tapers back to 12:1 max. typical slope.

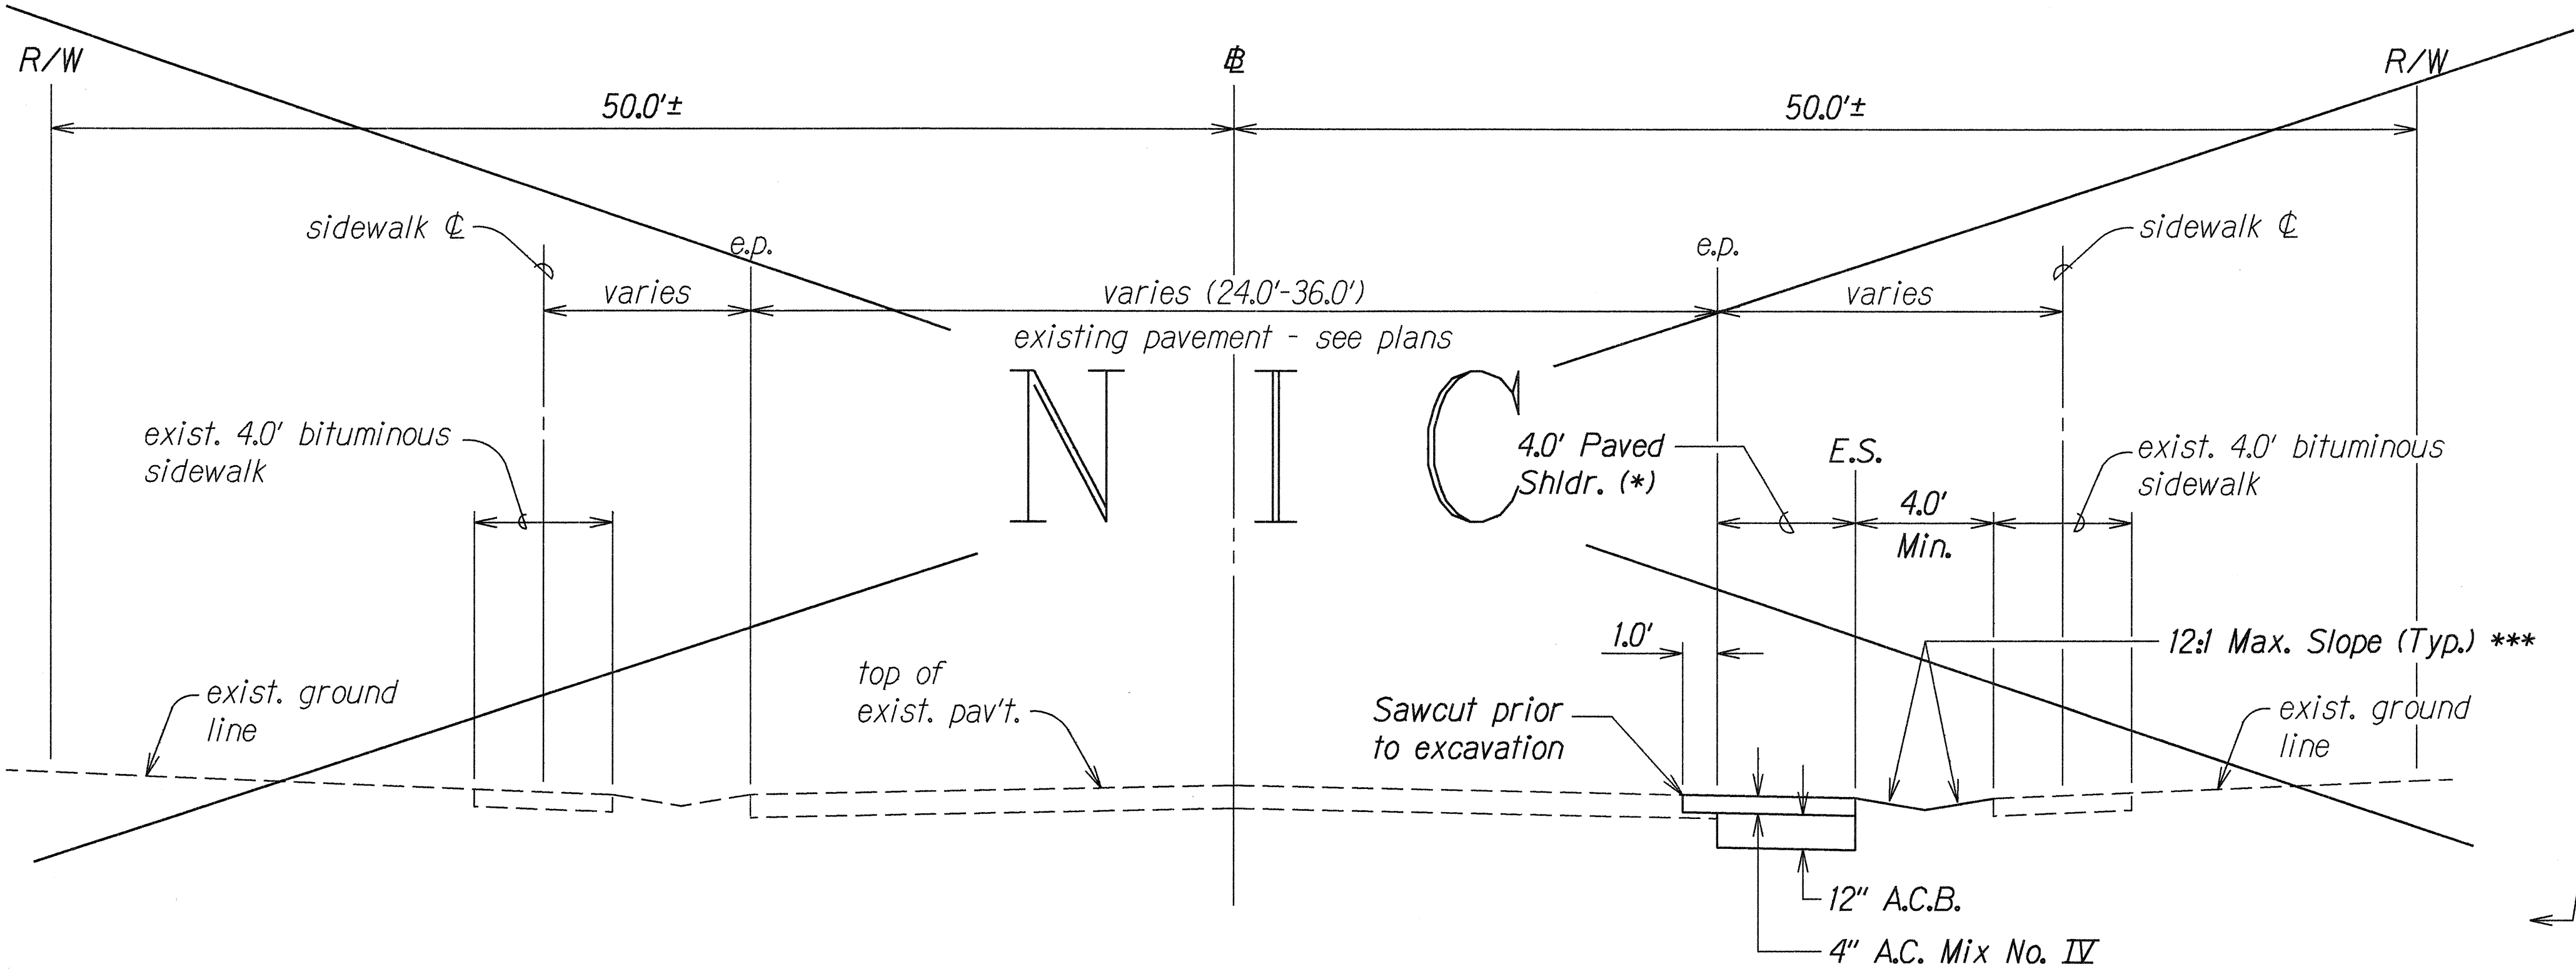

TYPICAL SECTION
 39
 PUUNENE AVE. # STA. 62+80± TO STA. 68+00±
 Not To Scale

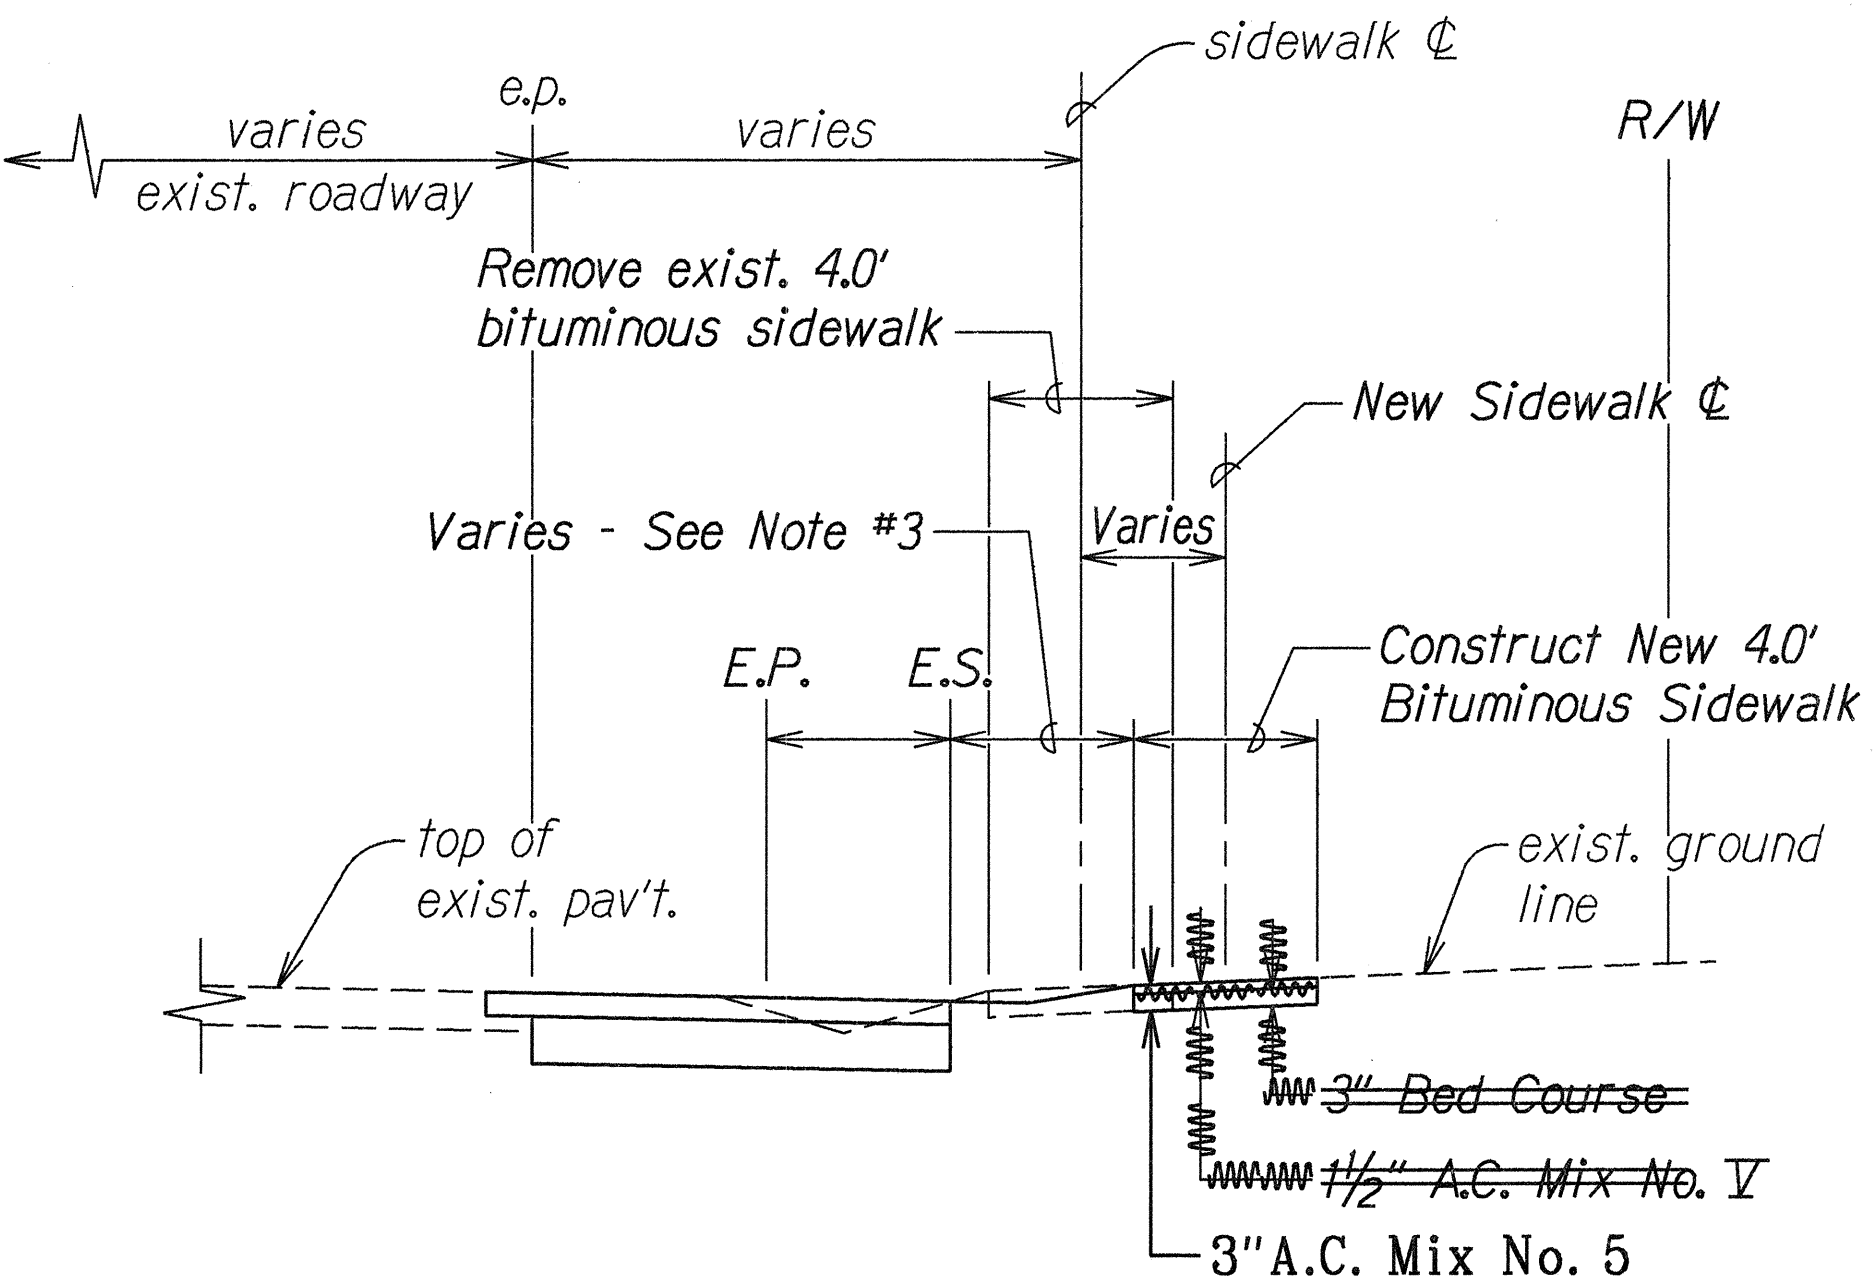

SIDEWALK ADJUSTMENT DETAIL
 PUUNENE AVE. # STA. 69+95± RT. TO STA. 73+75± RT.
 AND # STA. 76+20± RT. TO STA. 77+65± RT.
 Not To Scale

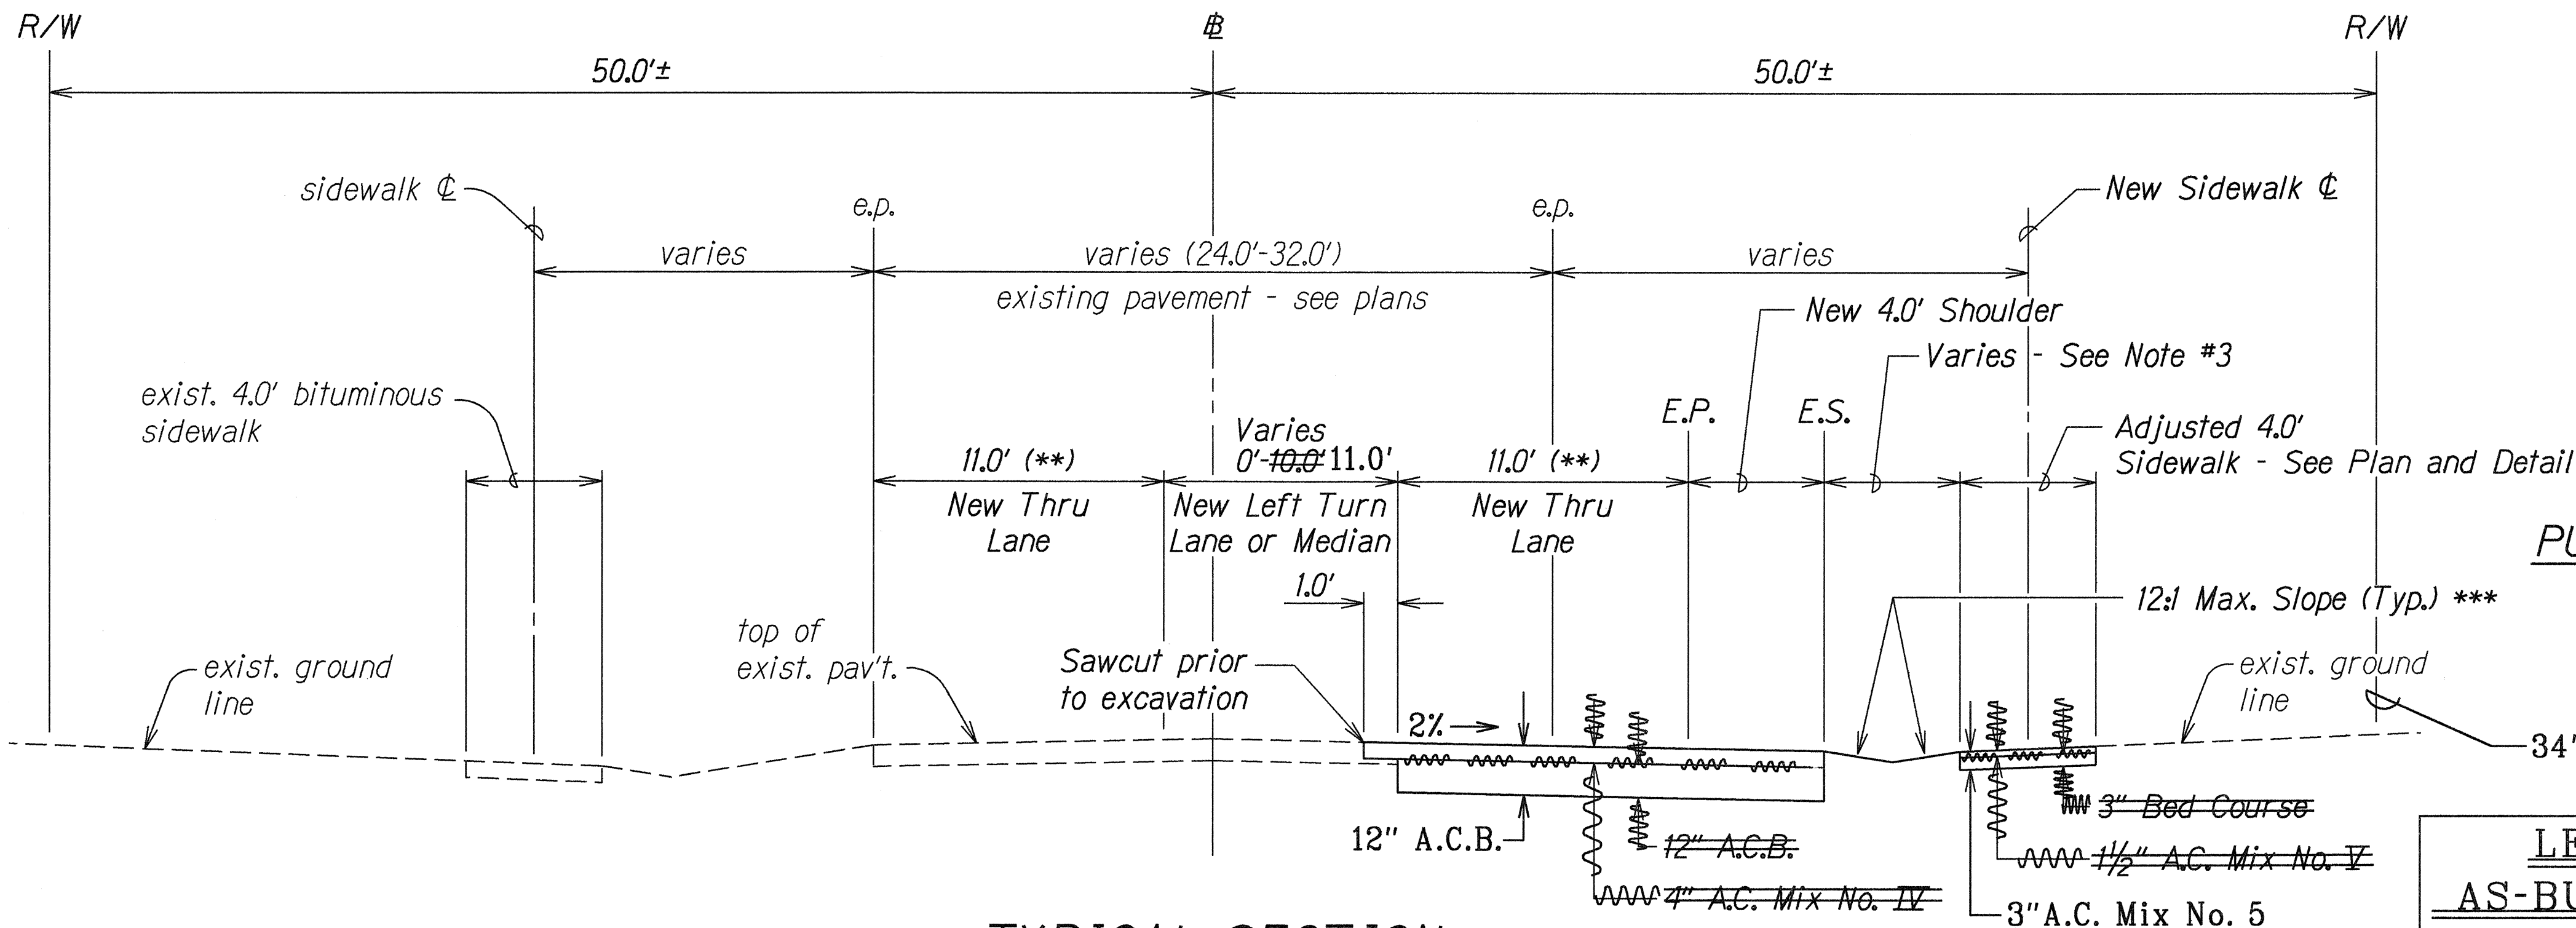

TYPICAL SECTION
 39
 PUUNENE AVE. # STA. 68+00± TO STA. 78+80±
 Not To Scale

LEGEND FOR AS-BUILT POSTINGS	
	Squiggly line for as-built deletion
	Double line for as-built deletion
Roadway	Text for as-built posting

STATE OF HAWAII DEPARTMENT OF TRANSPORTATION HIGHWAYS DIVISION	
TYPICAL SECTIONS AND DETAILS	
PUUNENE AVENUE IMPROVEMENTS	
Wakea Ave. Towards Aiai St.	
Fed. Aid. Project No. HES-STP-3500(3)	
Scale: As Shown	Date: August, 1993
SHEET No. 1 OF 1 SHEETS	

ORIGINAL PLAN	DATE
SURVEY PLOTTED BY	10/2/93
DRAWN BY	
DESIGNED BY	
CHECKED BY	
NOTED BY	
APPROVED BY	

- (*) See Note 1
 (**) See Note 2
 (***) See Note 4