



FED. ROAD DIST. NO.	STATE	FED. AID PROJ. NO.	FISCAL YEAR	SHEET NO.	TOTAL SHEETS
HAWAII	HAW.	NH-0380(10)	2013	90	166

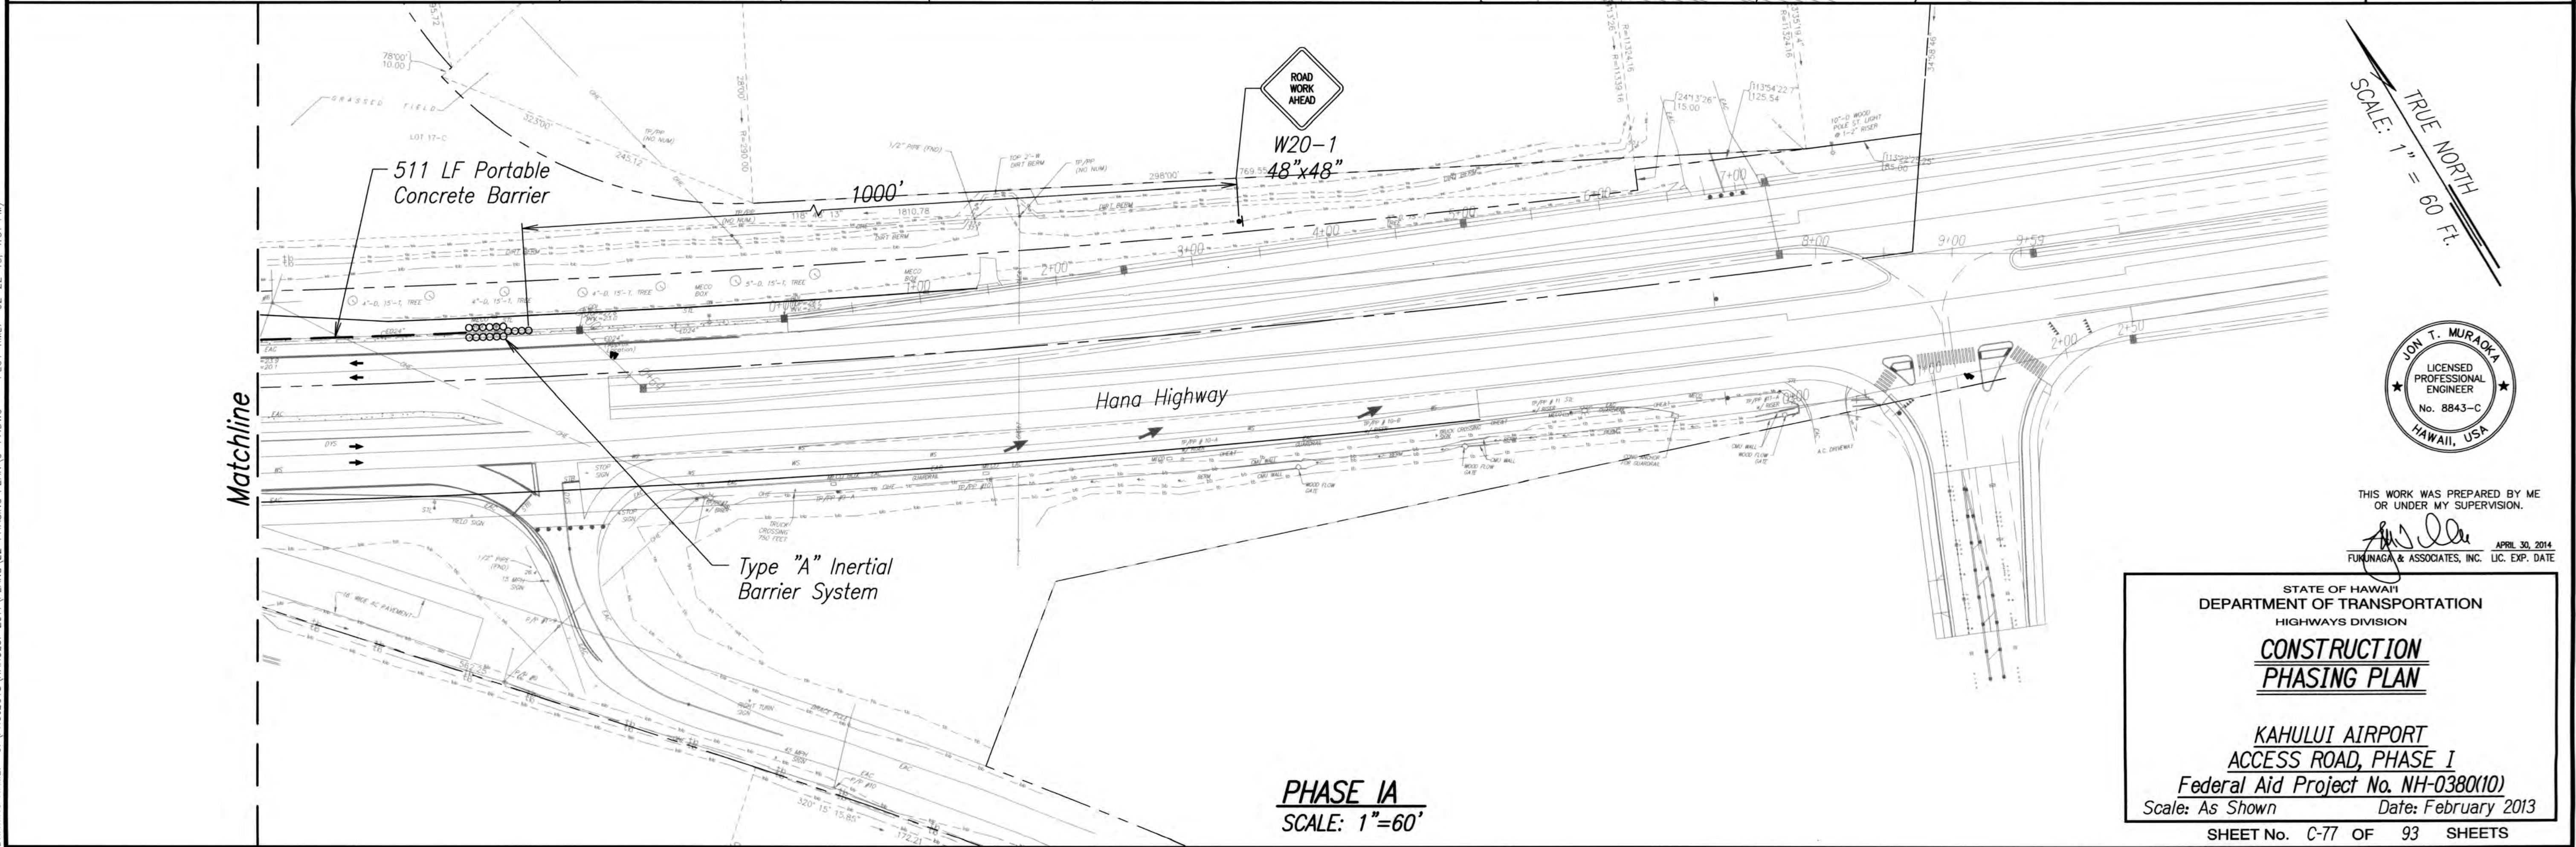

DATE	SURVEY PLOTTED BY
DATE	DRAWN BY
DATE	TRACED BY
DATE	QUANTITIES BY
DATE	CHECKED BY

DRAWING NAME: C:\PROJECTS\KAHULUI-2011\PLANS\22-PHASE PLAN\22-C-77.DWG PLOT TIME: 02-22-13, 4:51 PM

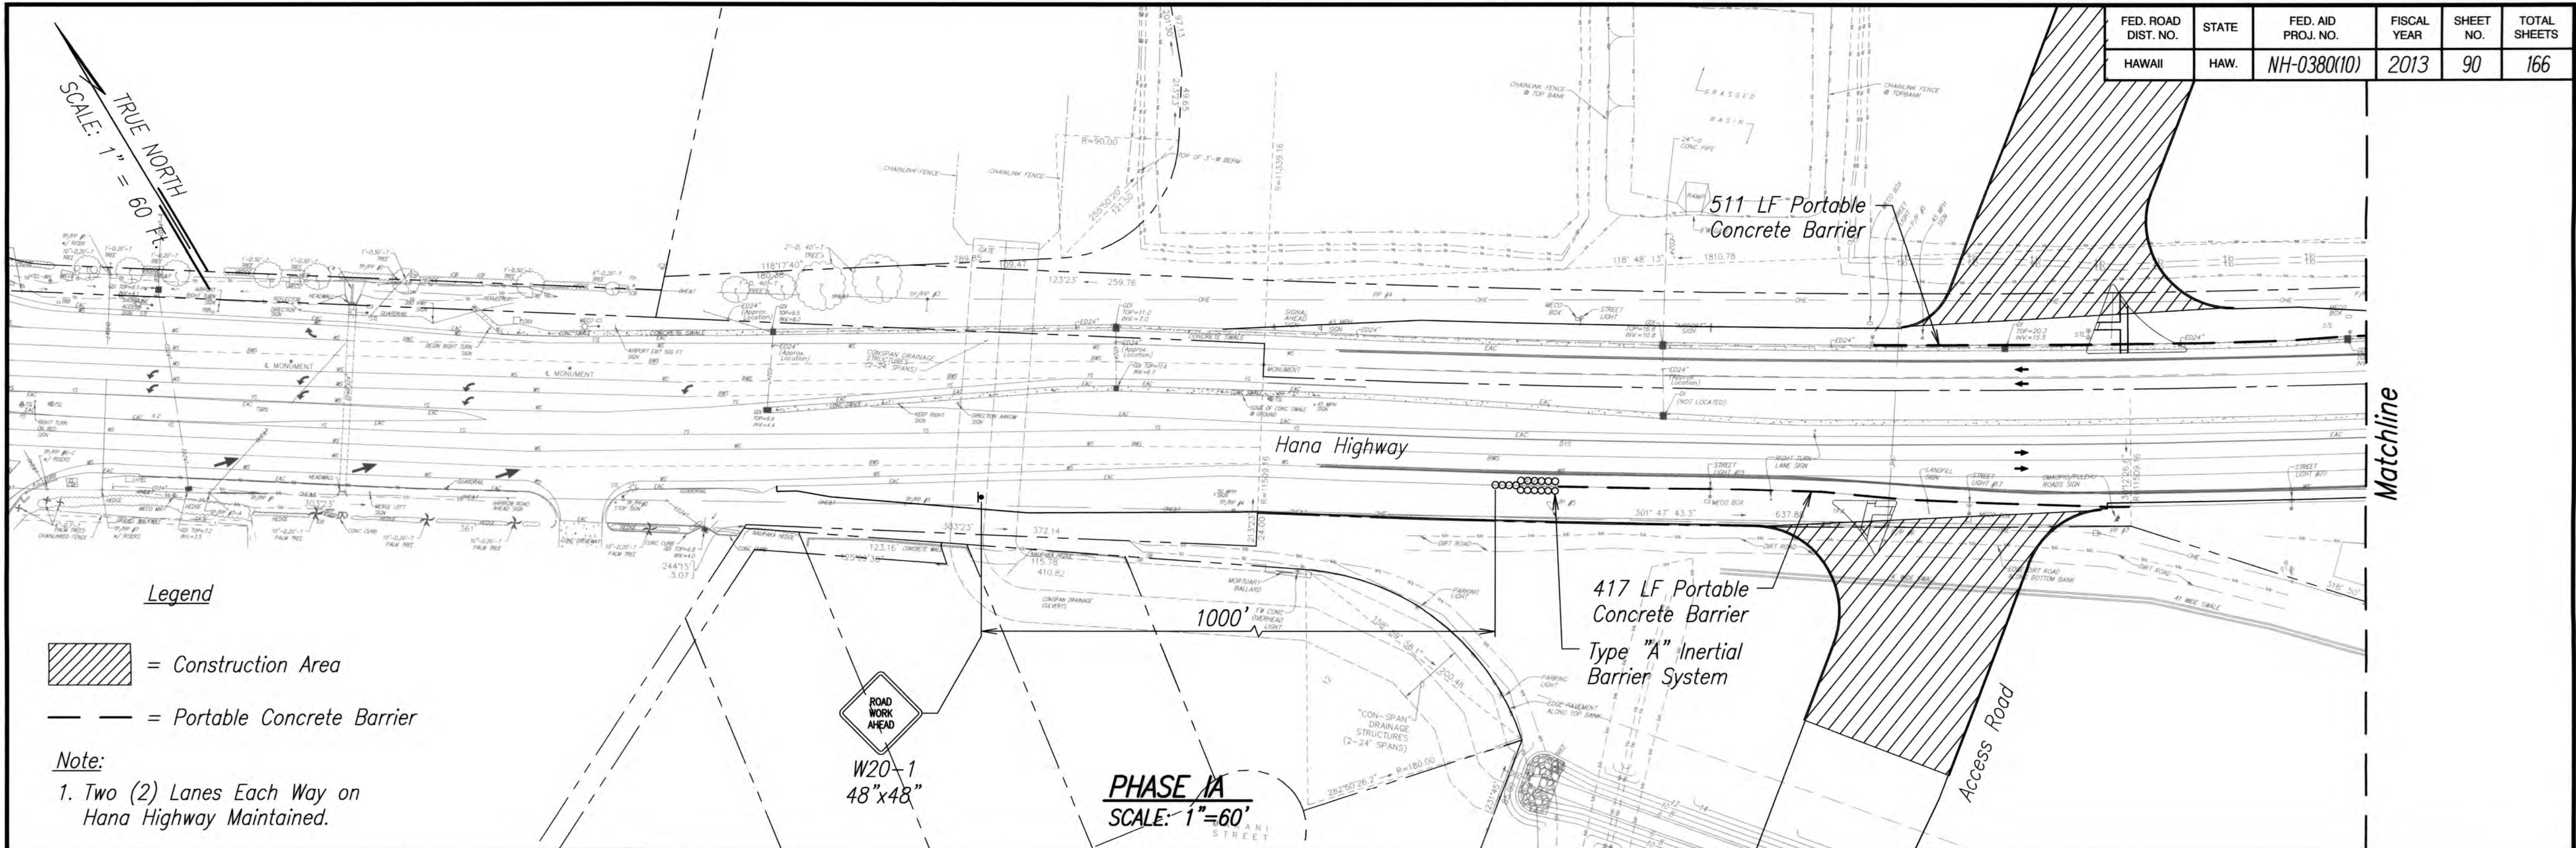

THIS WORK WAS PREPARED BY ME
OR UNDER MY SUPERVISION.

[Signature]
FUKUNAGA & ASSOCIATES, INC. LIC. EXP. DATE



STATE OF HAWAII
DEPARTMENT OF TRANSPORTATION
HIGHWAYS DIVISION

**CONSTRUCTION
PHASING PLAN**

KAHULUI AIRPORT
ACCESS ROAD, PHASE I
Federal Aid Project No. NH-0380(10)
Scale: As Shown Date: February 2013

SHEET No. C-77 OF 93 SHEETS



FED. ROAD DIST. NO.	STATE	FED. AID PROJ. NO.	FISCAL YEAR	SHEET NO.	TOTAL SHEETS
HAWAII	HAW.	NH-0380(10)	2013	91	166

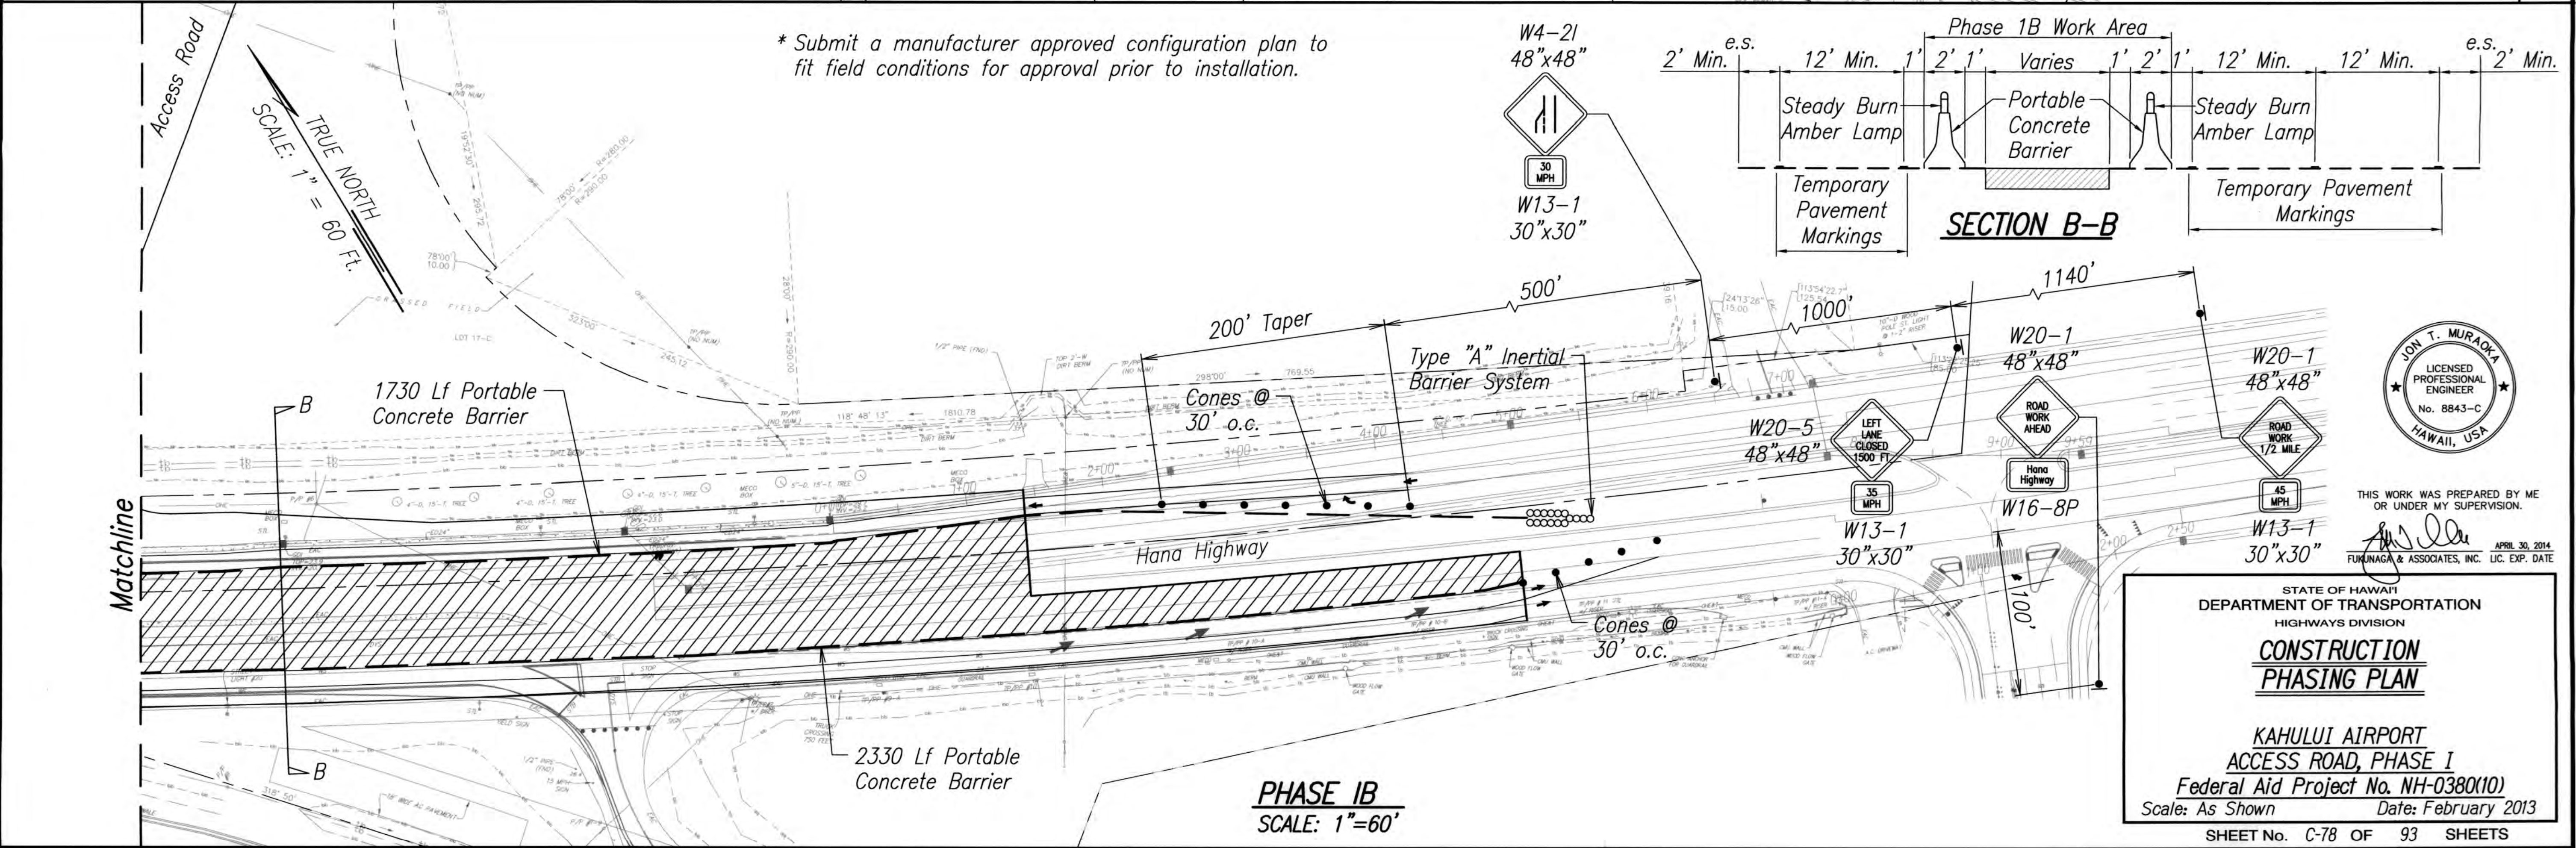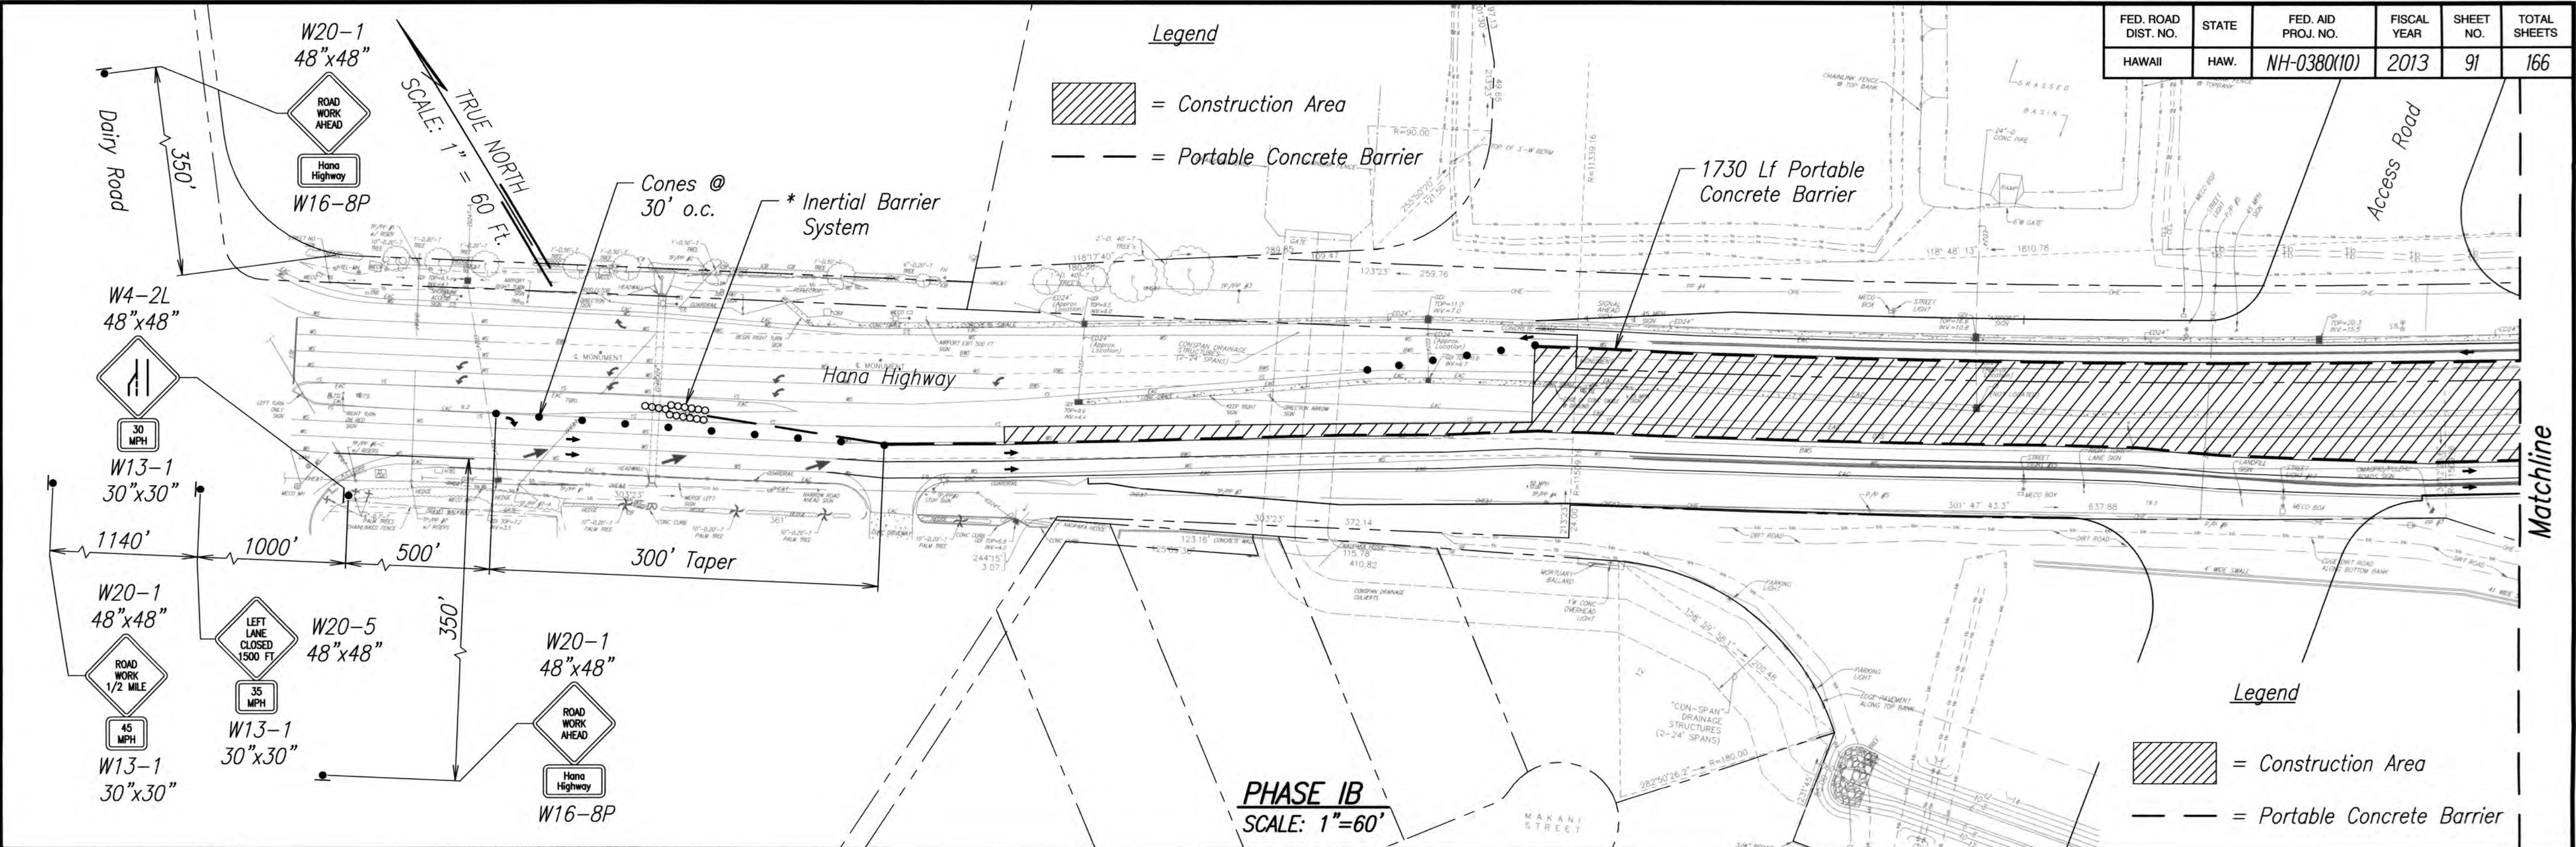

DATE	_____
SURVEY PLOTTED BY	_____
DRAWN BY	_____
TRACED BY	_____
QUANTITIES BY	_____
CHECKED BY	_____
ORIGINAL PLAN	_____
NOTE BOOK	_____
No.	_____

DRAWING NAME: C:\PROJECTS\KAHULUI-2011\PLANS\22-PHASING PLAN\C-78.DWG PLOT TIME: 02-22-13, 3:09 PM

FED. ROAD DIST. NO.	STATE	FED. AID PROJ. NO.	FISCAL YEAR	SHEET NO.	TOTAL SHEETS
HAWAII	HAW.	NH-0380(10)	2013	93 S-1	166

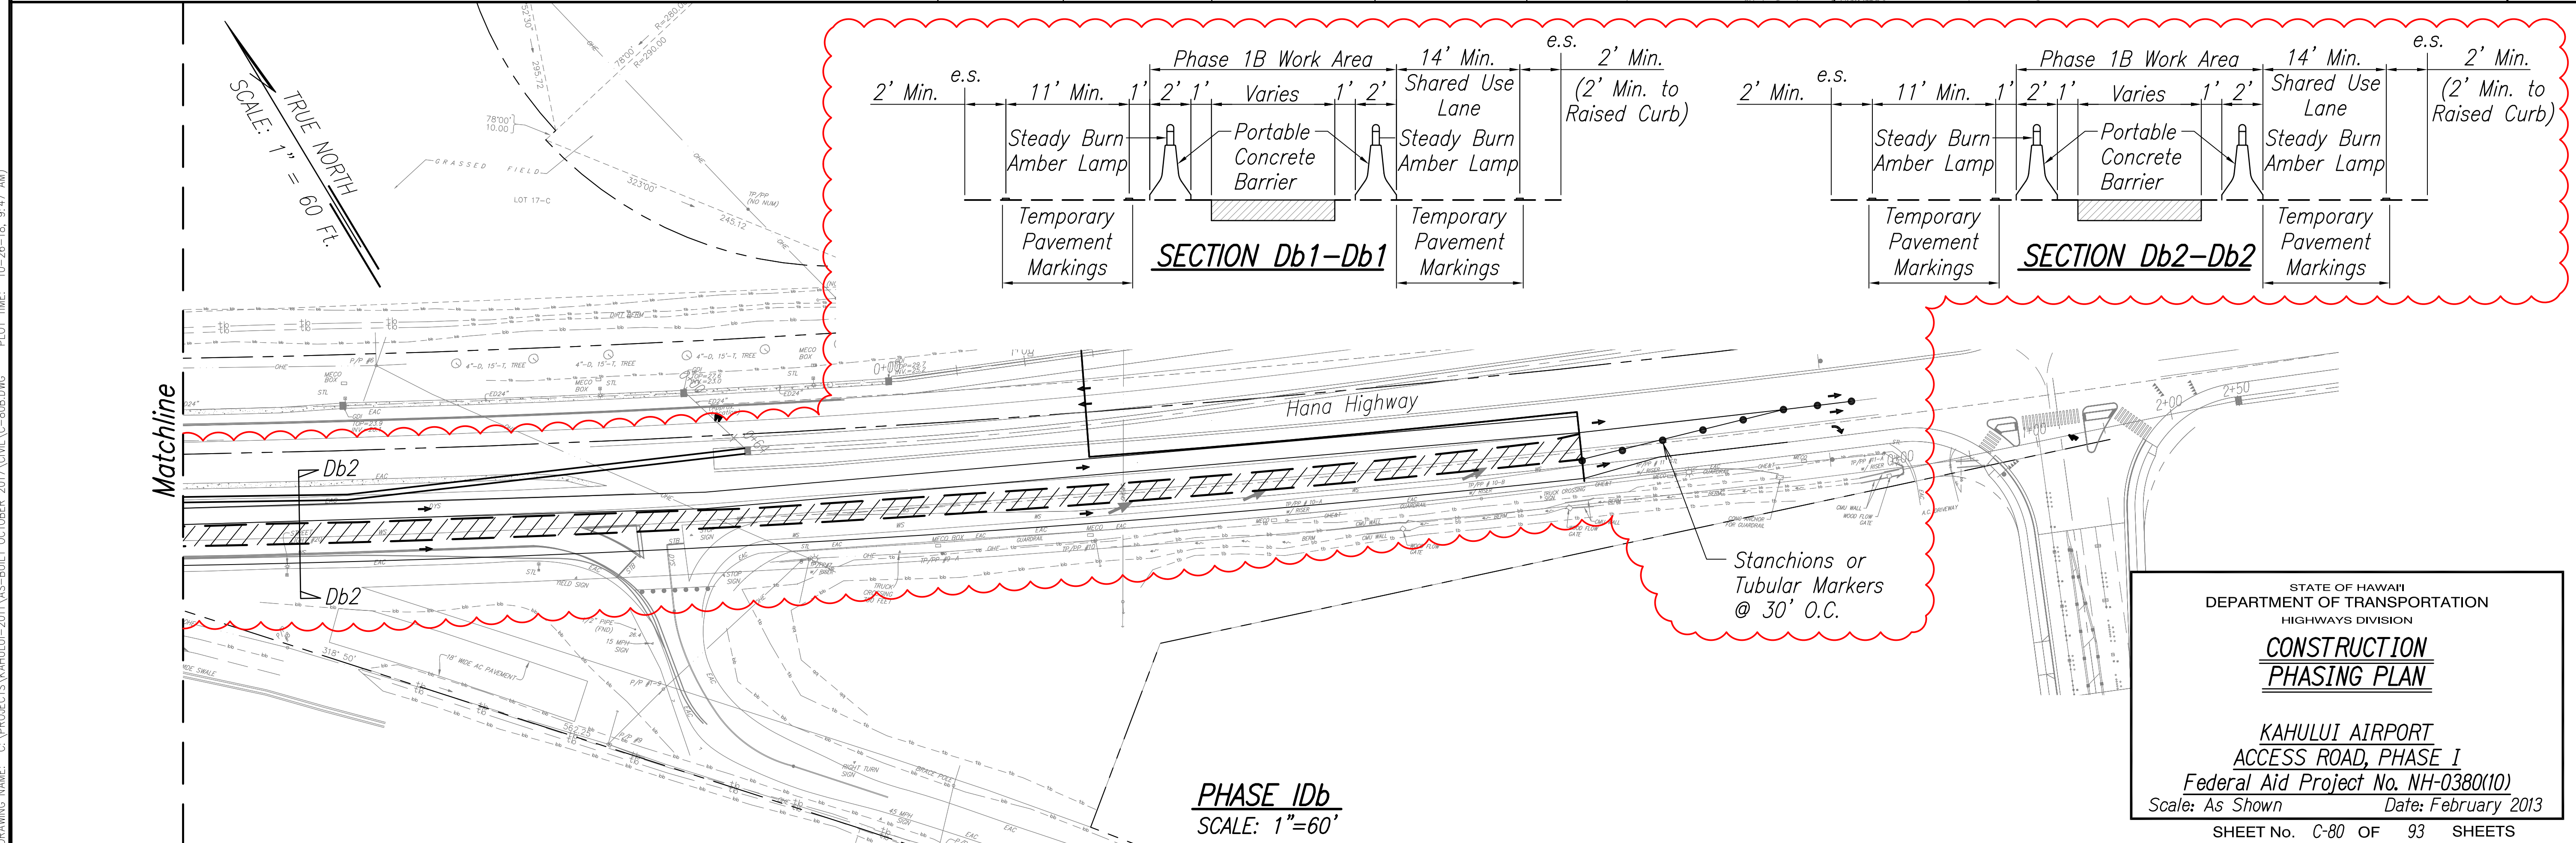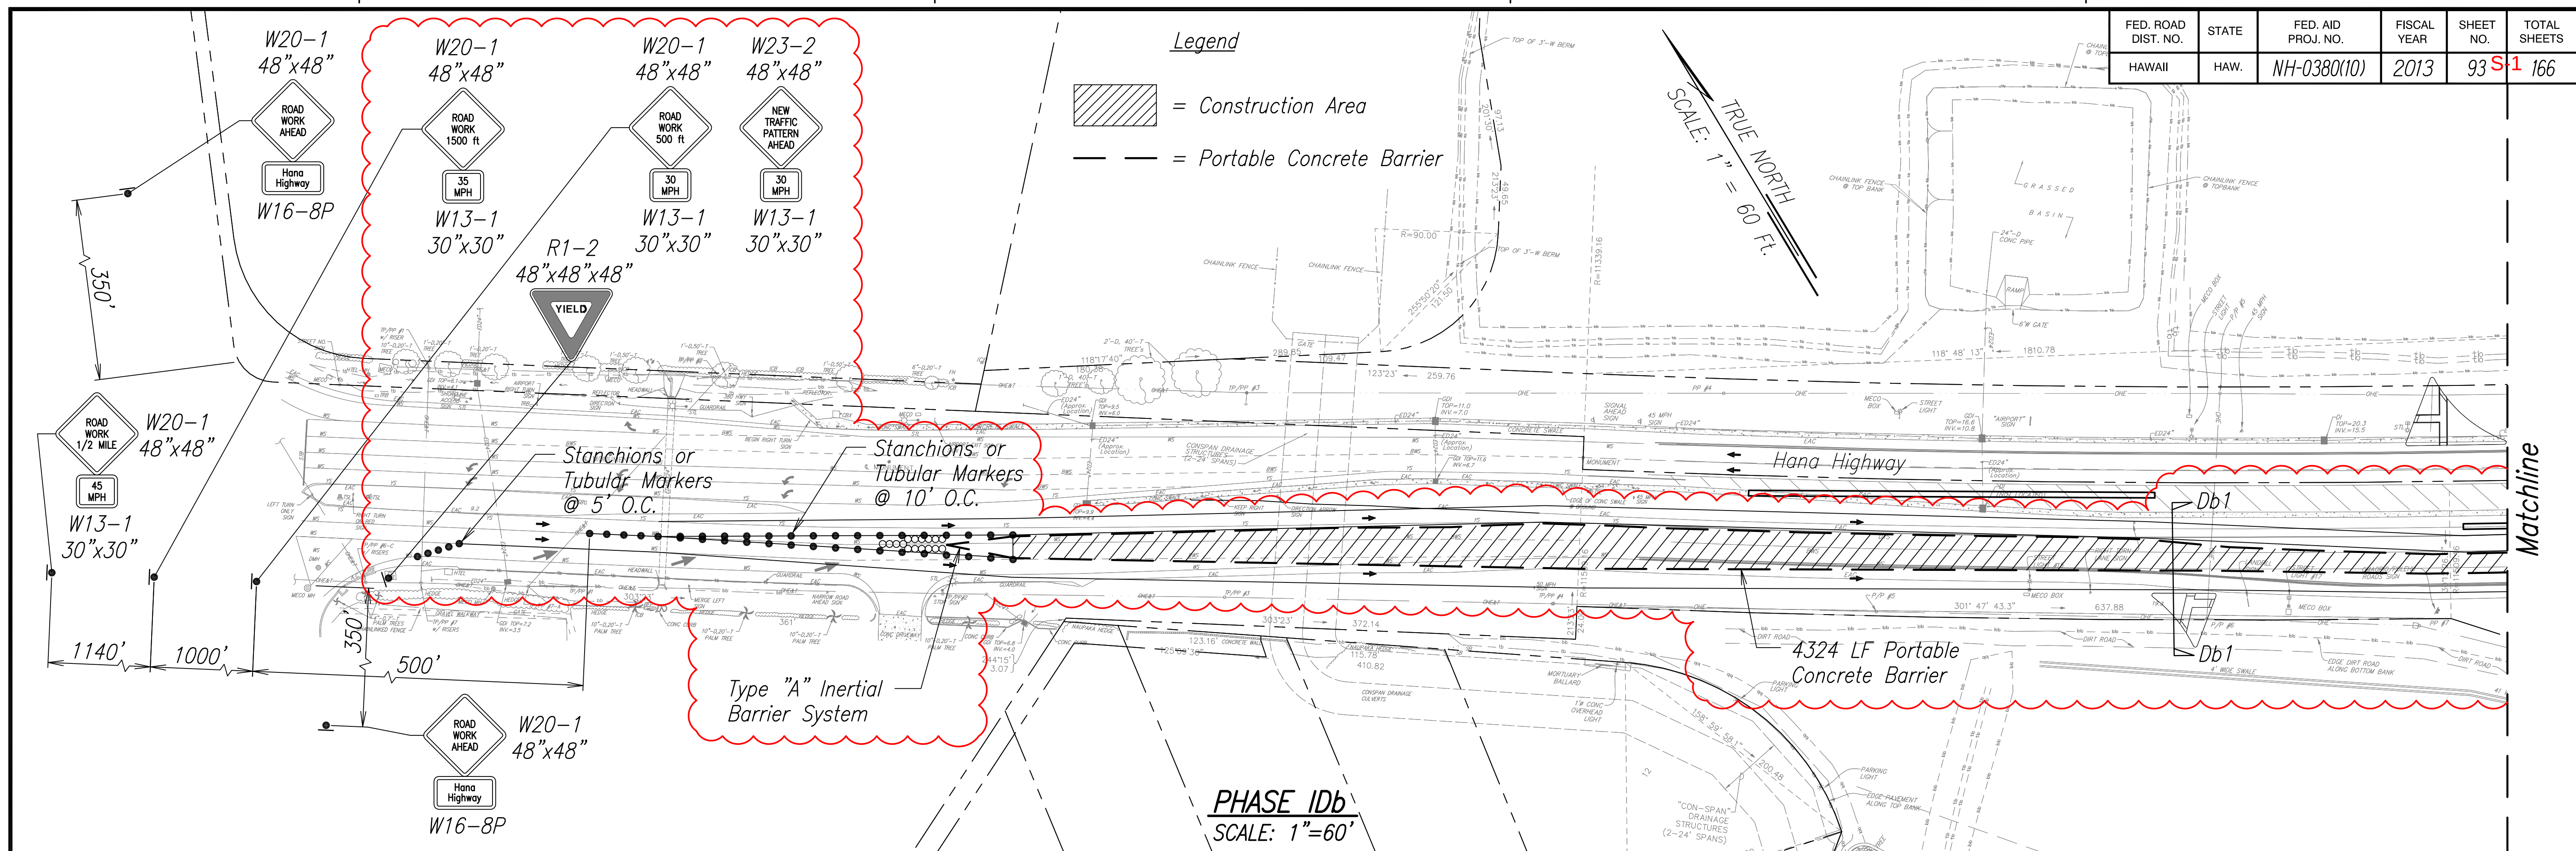

DATE	DESIGNED BY	CHECKED BY

ORIGINAL PLAN	SURVEY PLOTTED BY	DATE

NOTE BOOK	DESIGNED BY	DATE

QUANTITIES BY	DESIGNED BY	DATE

CRACKED BY	DESIGNED BY	DATE

DRAWING NAME: C:\PROJECTS\KAHULUI\2011\AS-BUILT OCTOBER 2017\CIVIL\C-80B.DWG PLOT TIME: 10-26-18, 9:47 AM

STATE OF HAWAII
DEPARTMENT OF TRANSPORTATION
HIGHWAYS DIVISION

**CONSTRUCTION
PHASING PLAN**





KAHULUI AIRPORT
ACCESS ROAD, PHASE 1
Federal Aid Project No. NH-0380(10)
Scale: As Shown Date: February 2013

SHEET No. C-80 OF 93 SHEETS

"AS-BUILT"

AS-BUILT DRAWINGS

FED. ROAD DIST. NO.	STATE	FED. AID PROJ. NO.	FISCAL YEAR	SHEET NO.	TOTAL SHEETS
HAWAII	HAW.	NH-0380(10)	2013	94	166

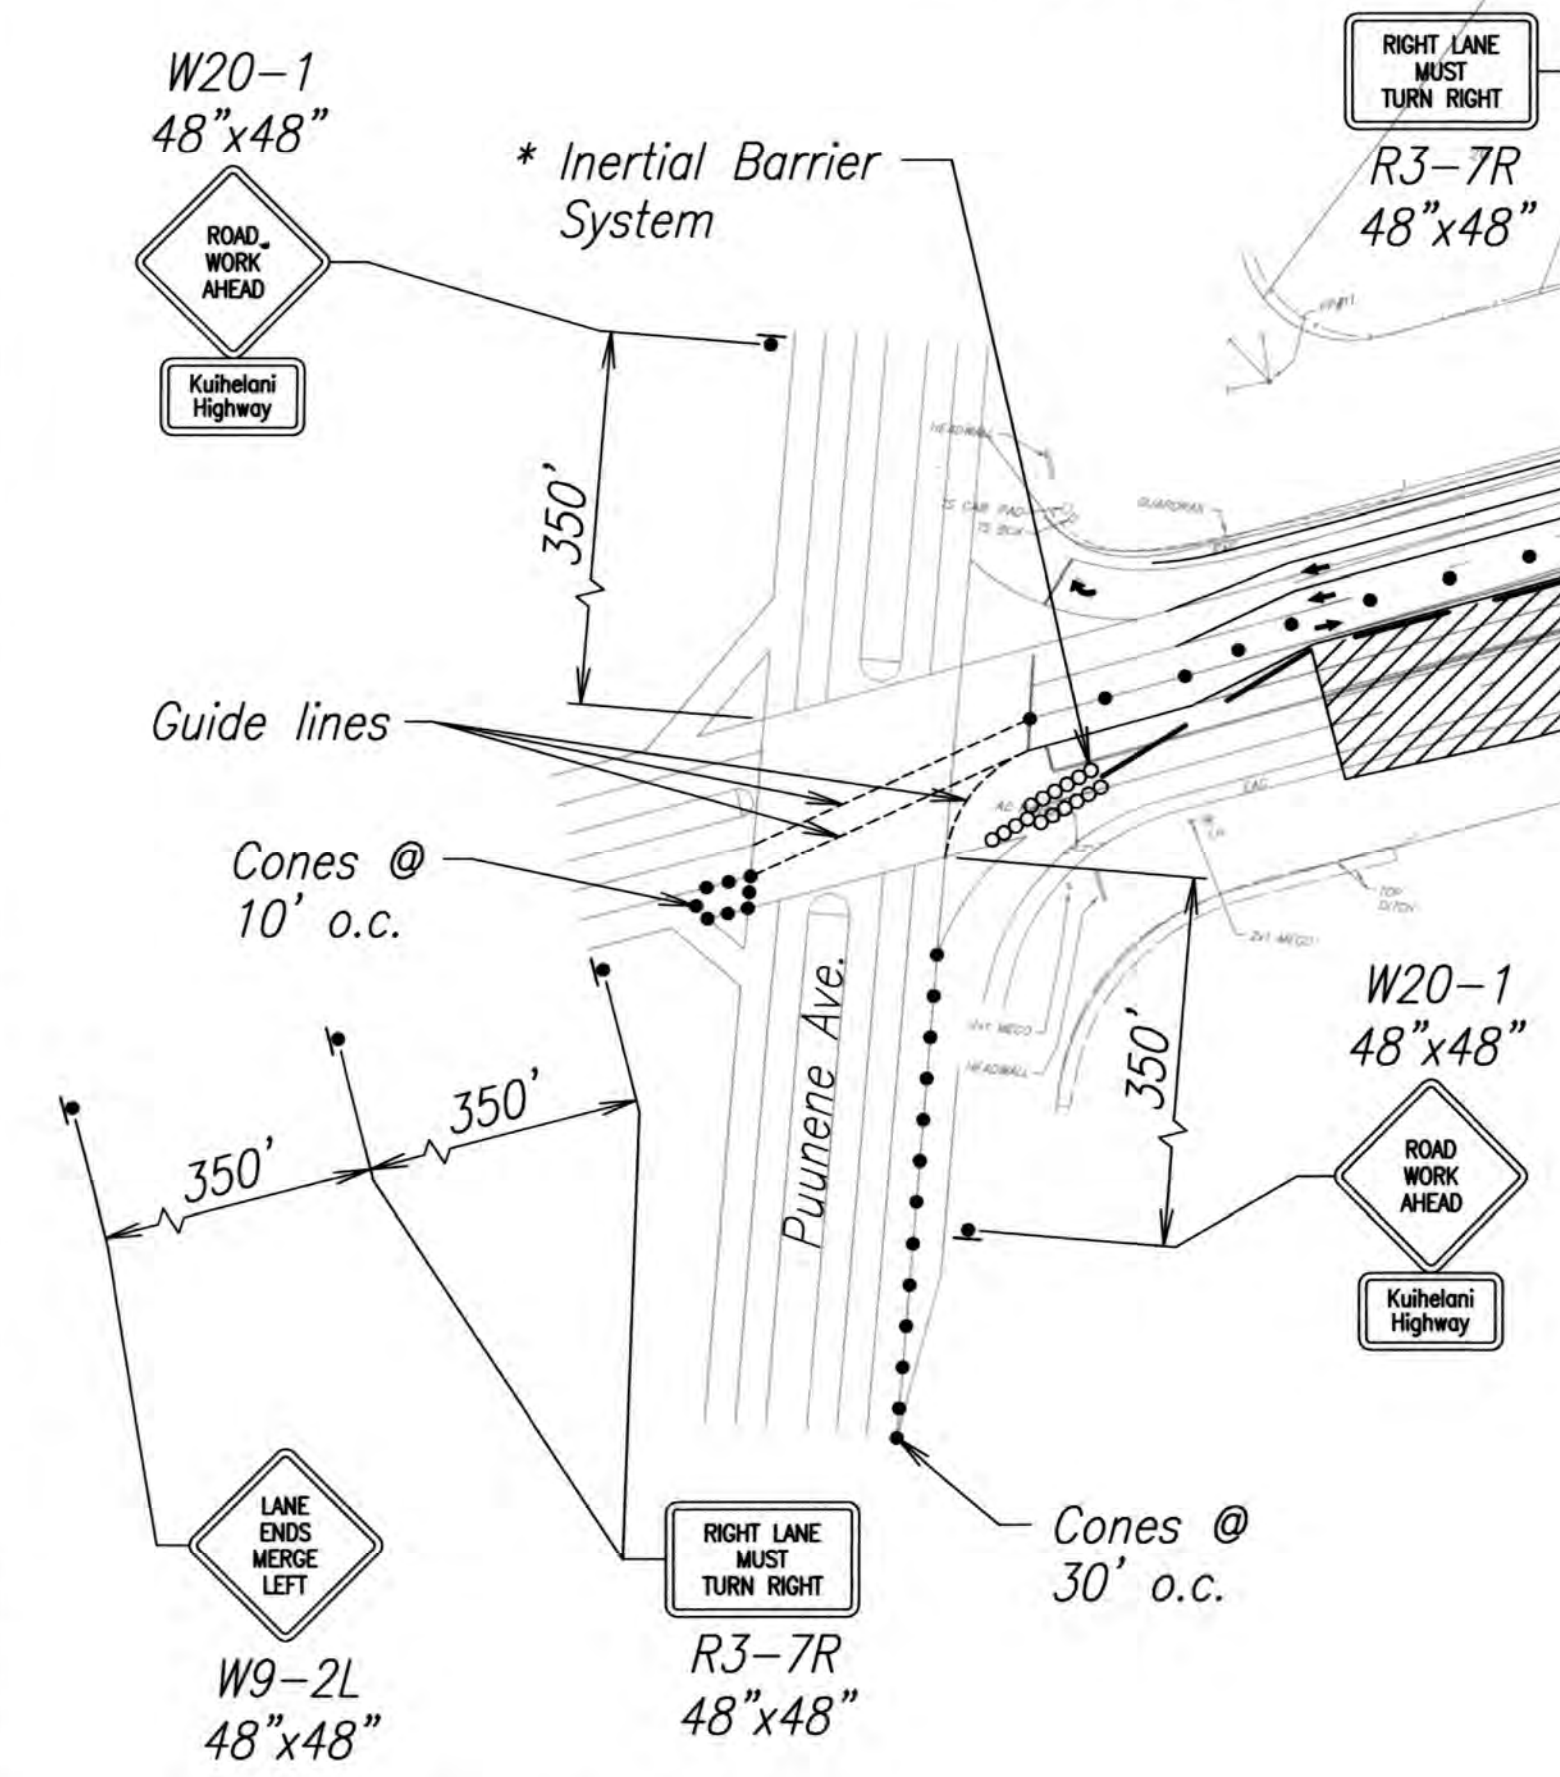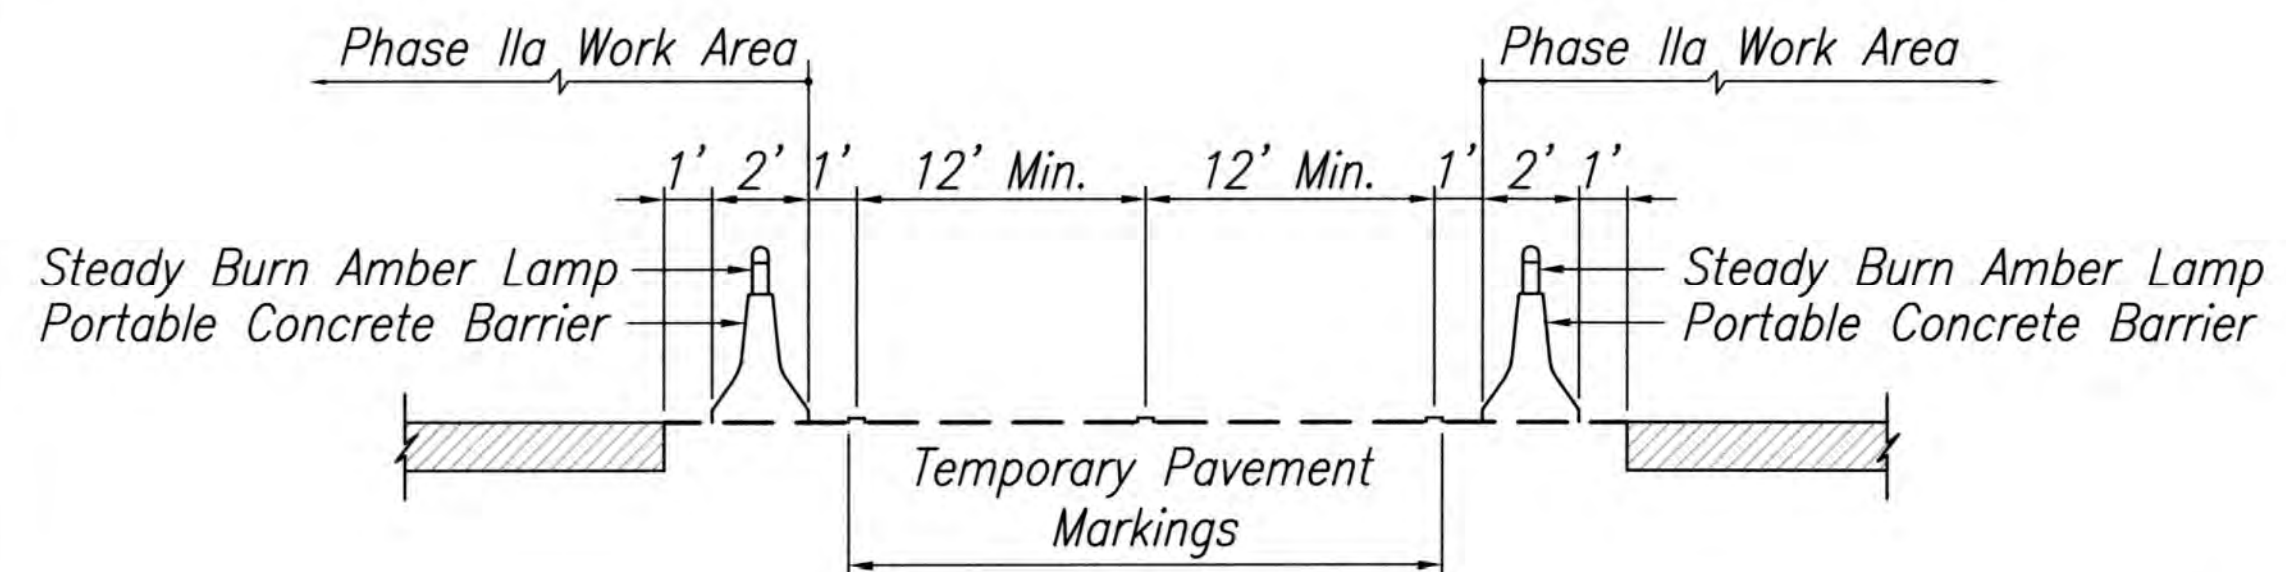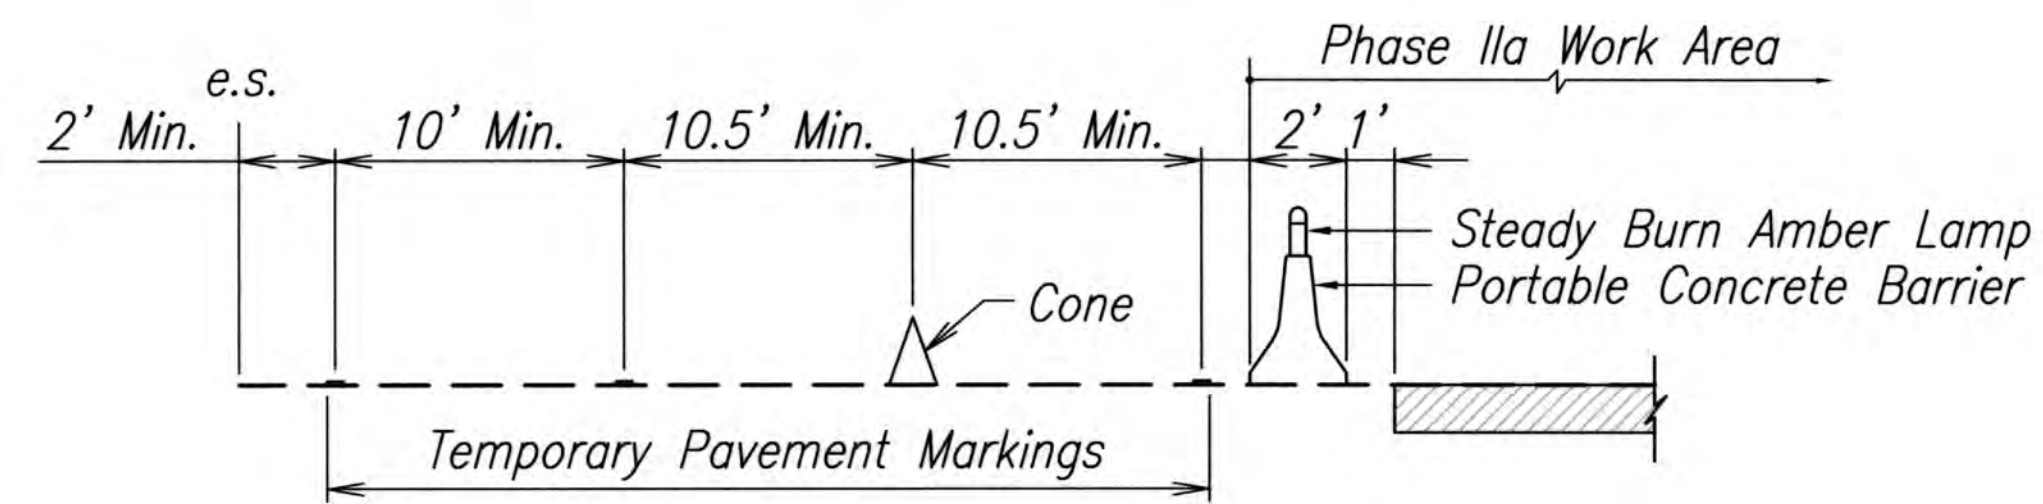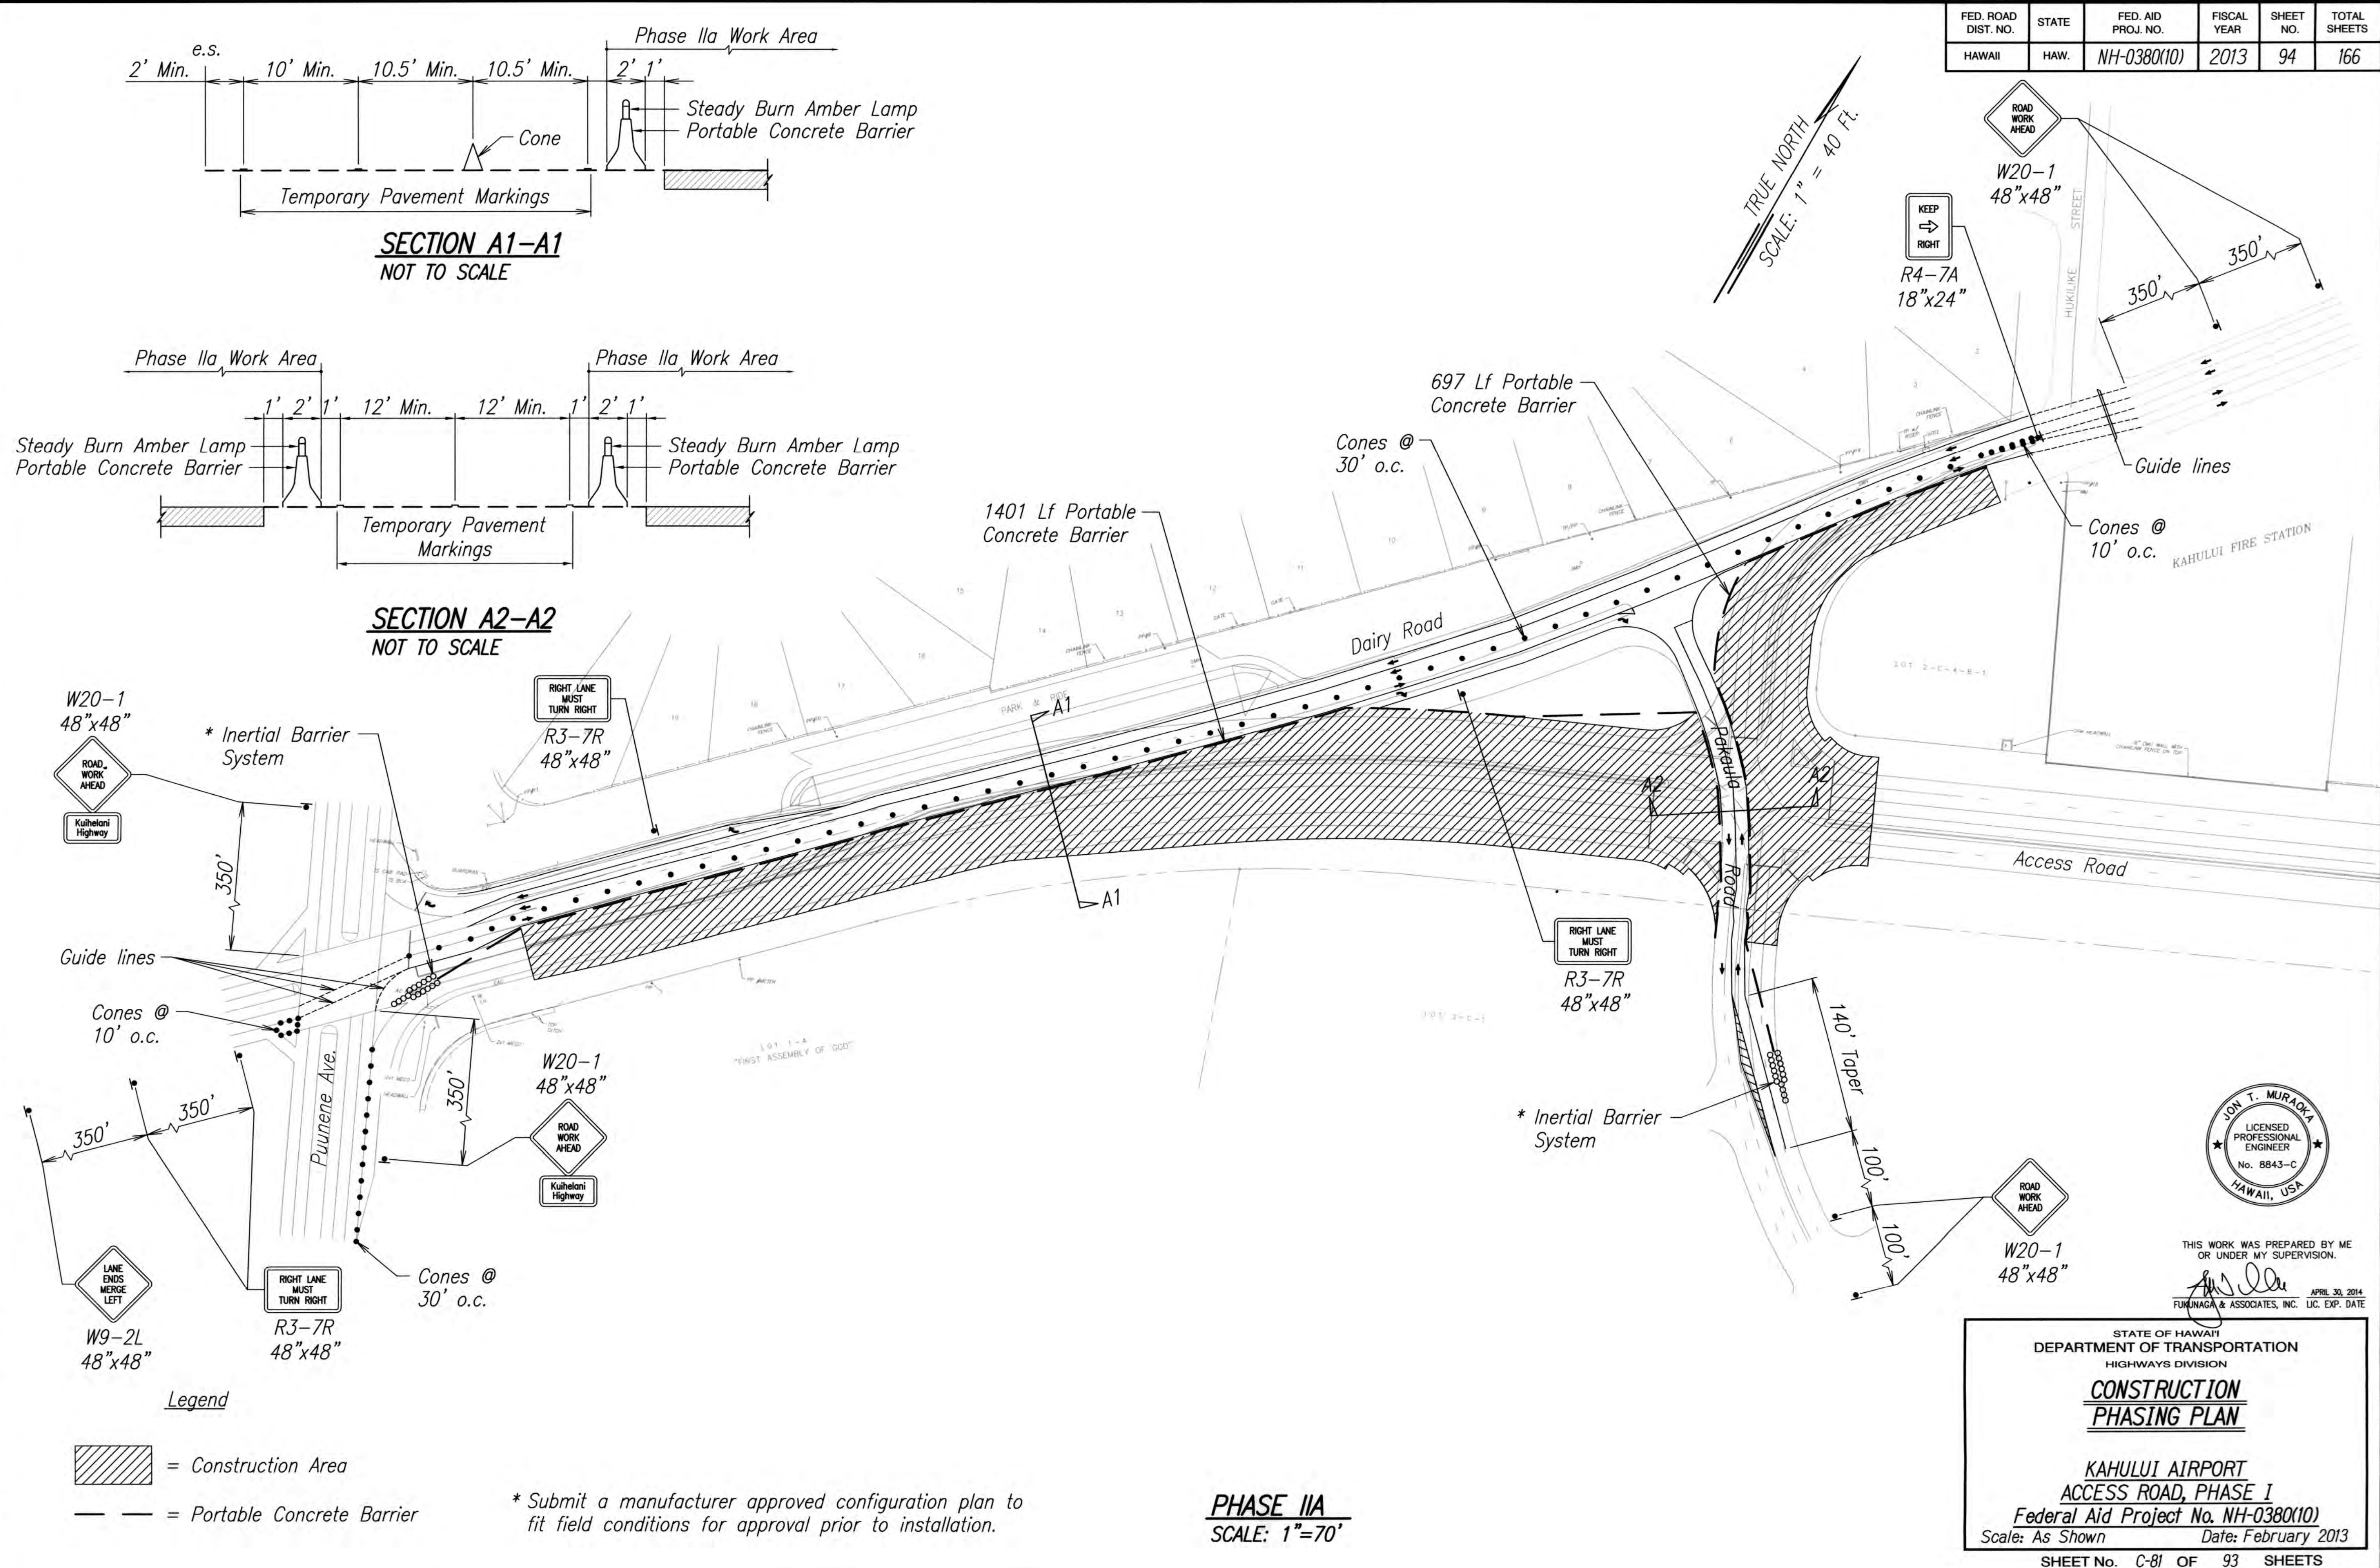

- Legend**
- = Construction Area
 - = Portable Concrete Barrier

* Submit a manufacturer approved configuration plan to fit field conditions for approval prior to installation.

PHASE IIA
SCALE: 1"=70'

STATE OF HAWAII
DEPARTMENT OF TRANSPORTATION
HIGHWAYS DIVISION

CONSTRUCTION PHASING PLAN

KAHULUI AIRPORT
ACCESS ROAD, PHASE I
Federal Aid Project No. NH-0380(10)
Scale: As Shown Date: February 2013

SHEET No. C-81 OF 93 SHEETS



THIS WORK WAS PREPARED BY ME OR UNDER MY SUPERVISION.

[Signature]
APRIL 30, 2014
FUKUNAGA & ASSOCIATES, INC. LIC. EXP. DATE

SURVEY PLOTTED BY	DATE
DRAWN BY	
TRACED BY	
QUANTITIES BY	
CHECKED BY	



DRAWING NAME: C:\PROJECTS\KAHULUI-2011\PLANS\22-PHASING PLAN\1-C-81.DWG PLOT TIME: 02-22-13, 3:13 PM





Construction Phase IIb

1. The option of using the new Access Road to Hana Highway is available to alleviate traffic.

* Submit a manufacturer approved configuration plan to fit field conditions for approval prior to installation.

Legend

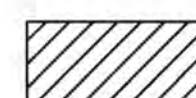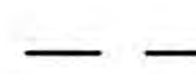-  = Construction Area
-  = Portable Concrete Barrier

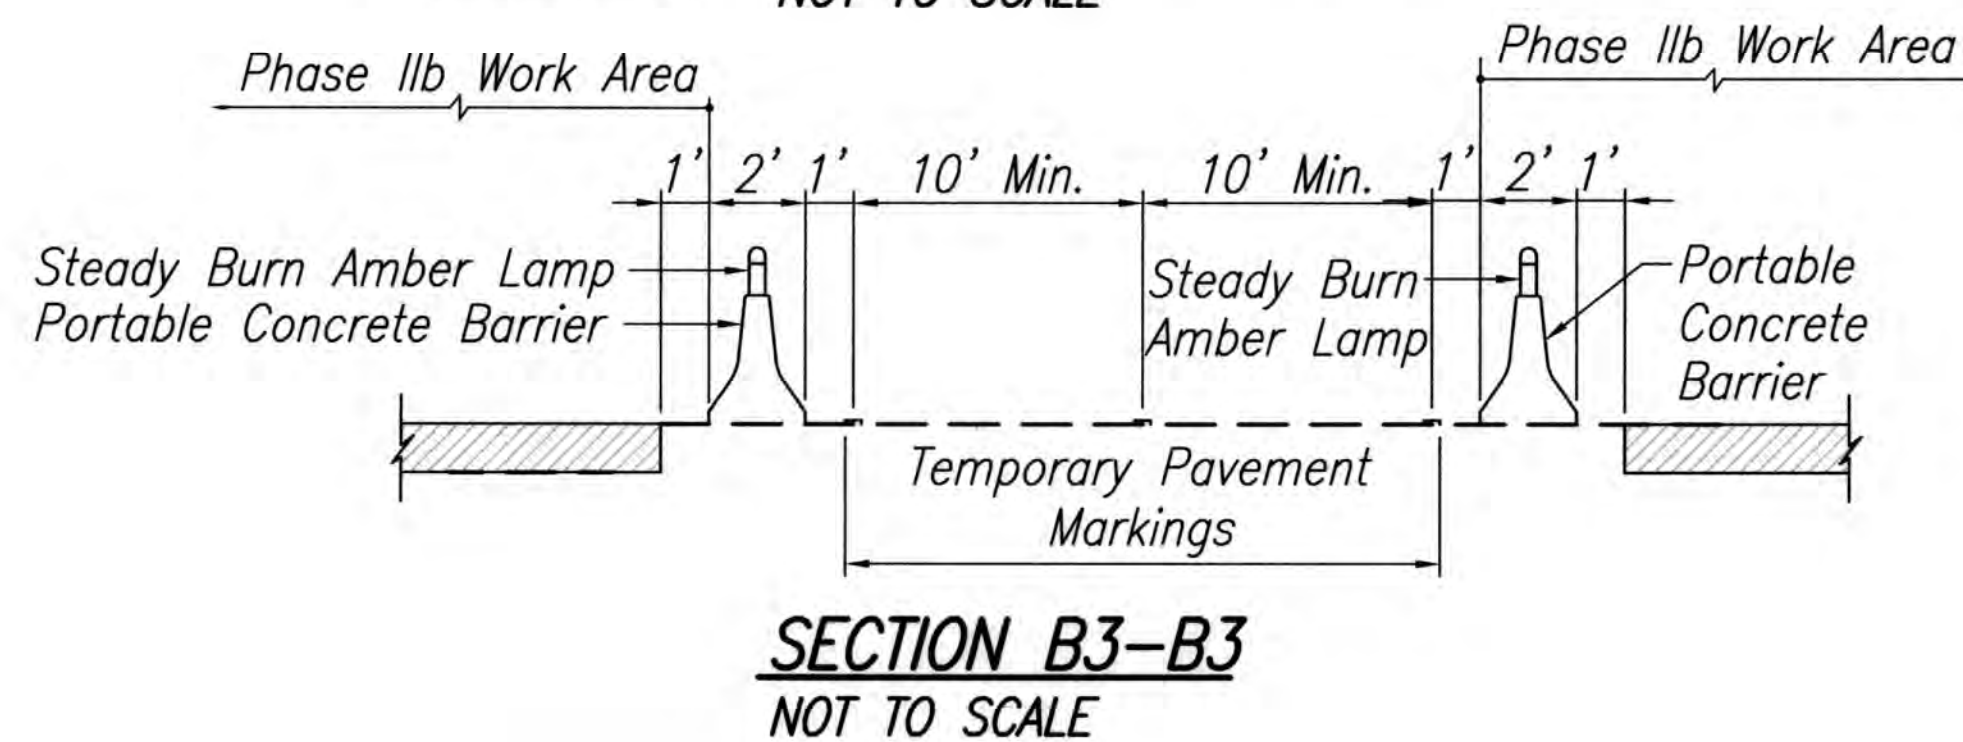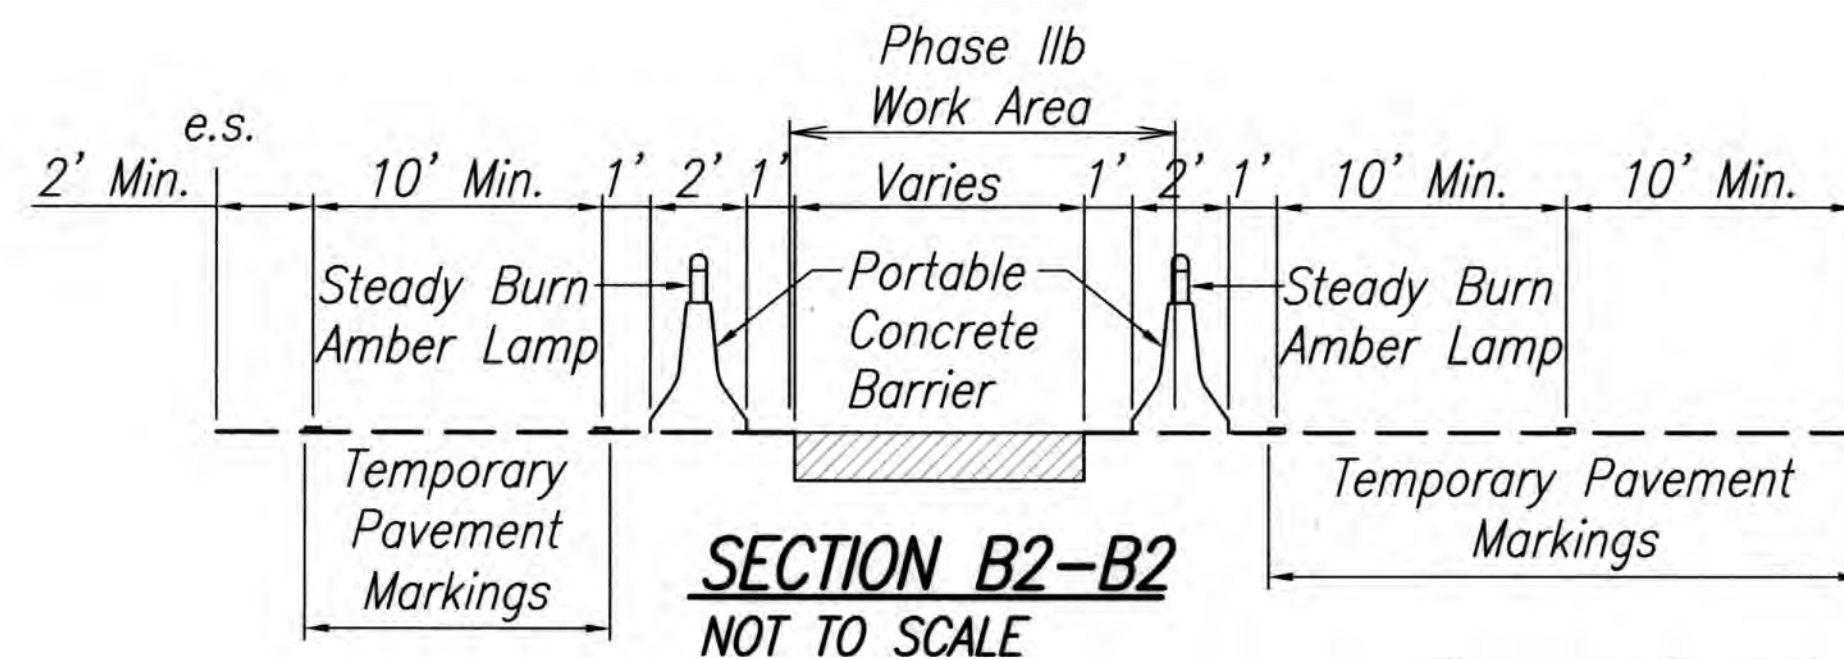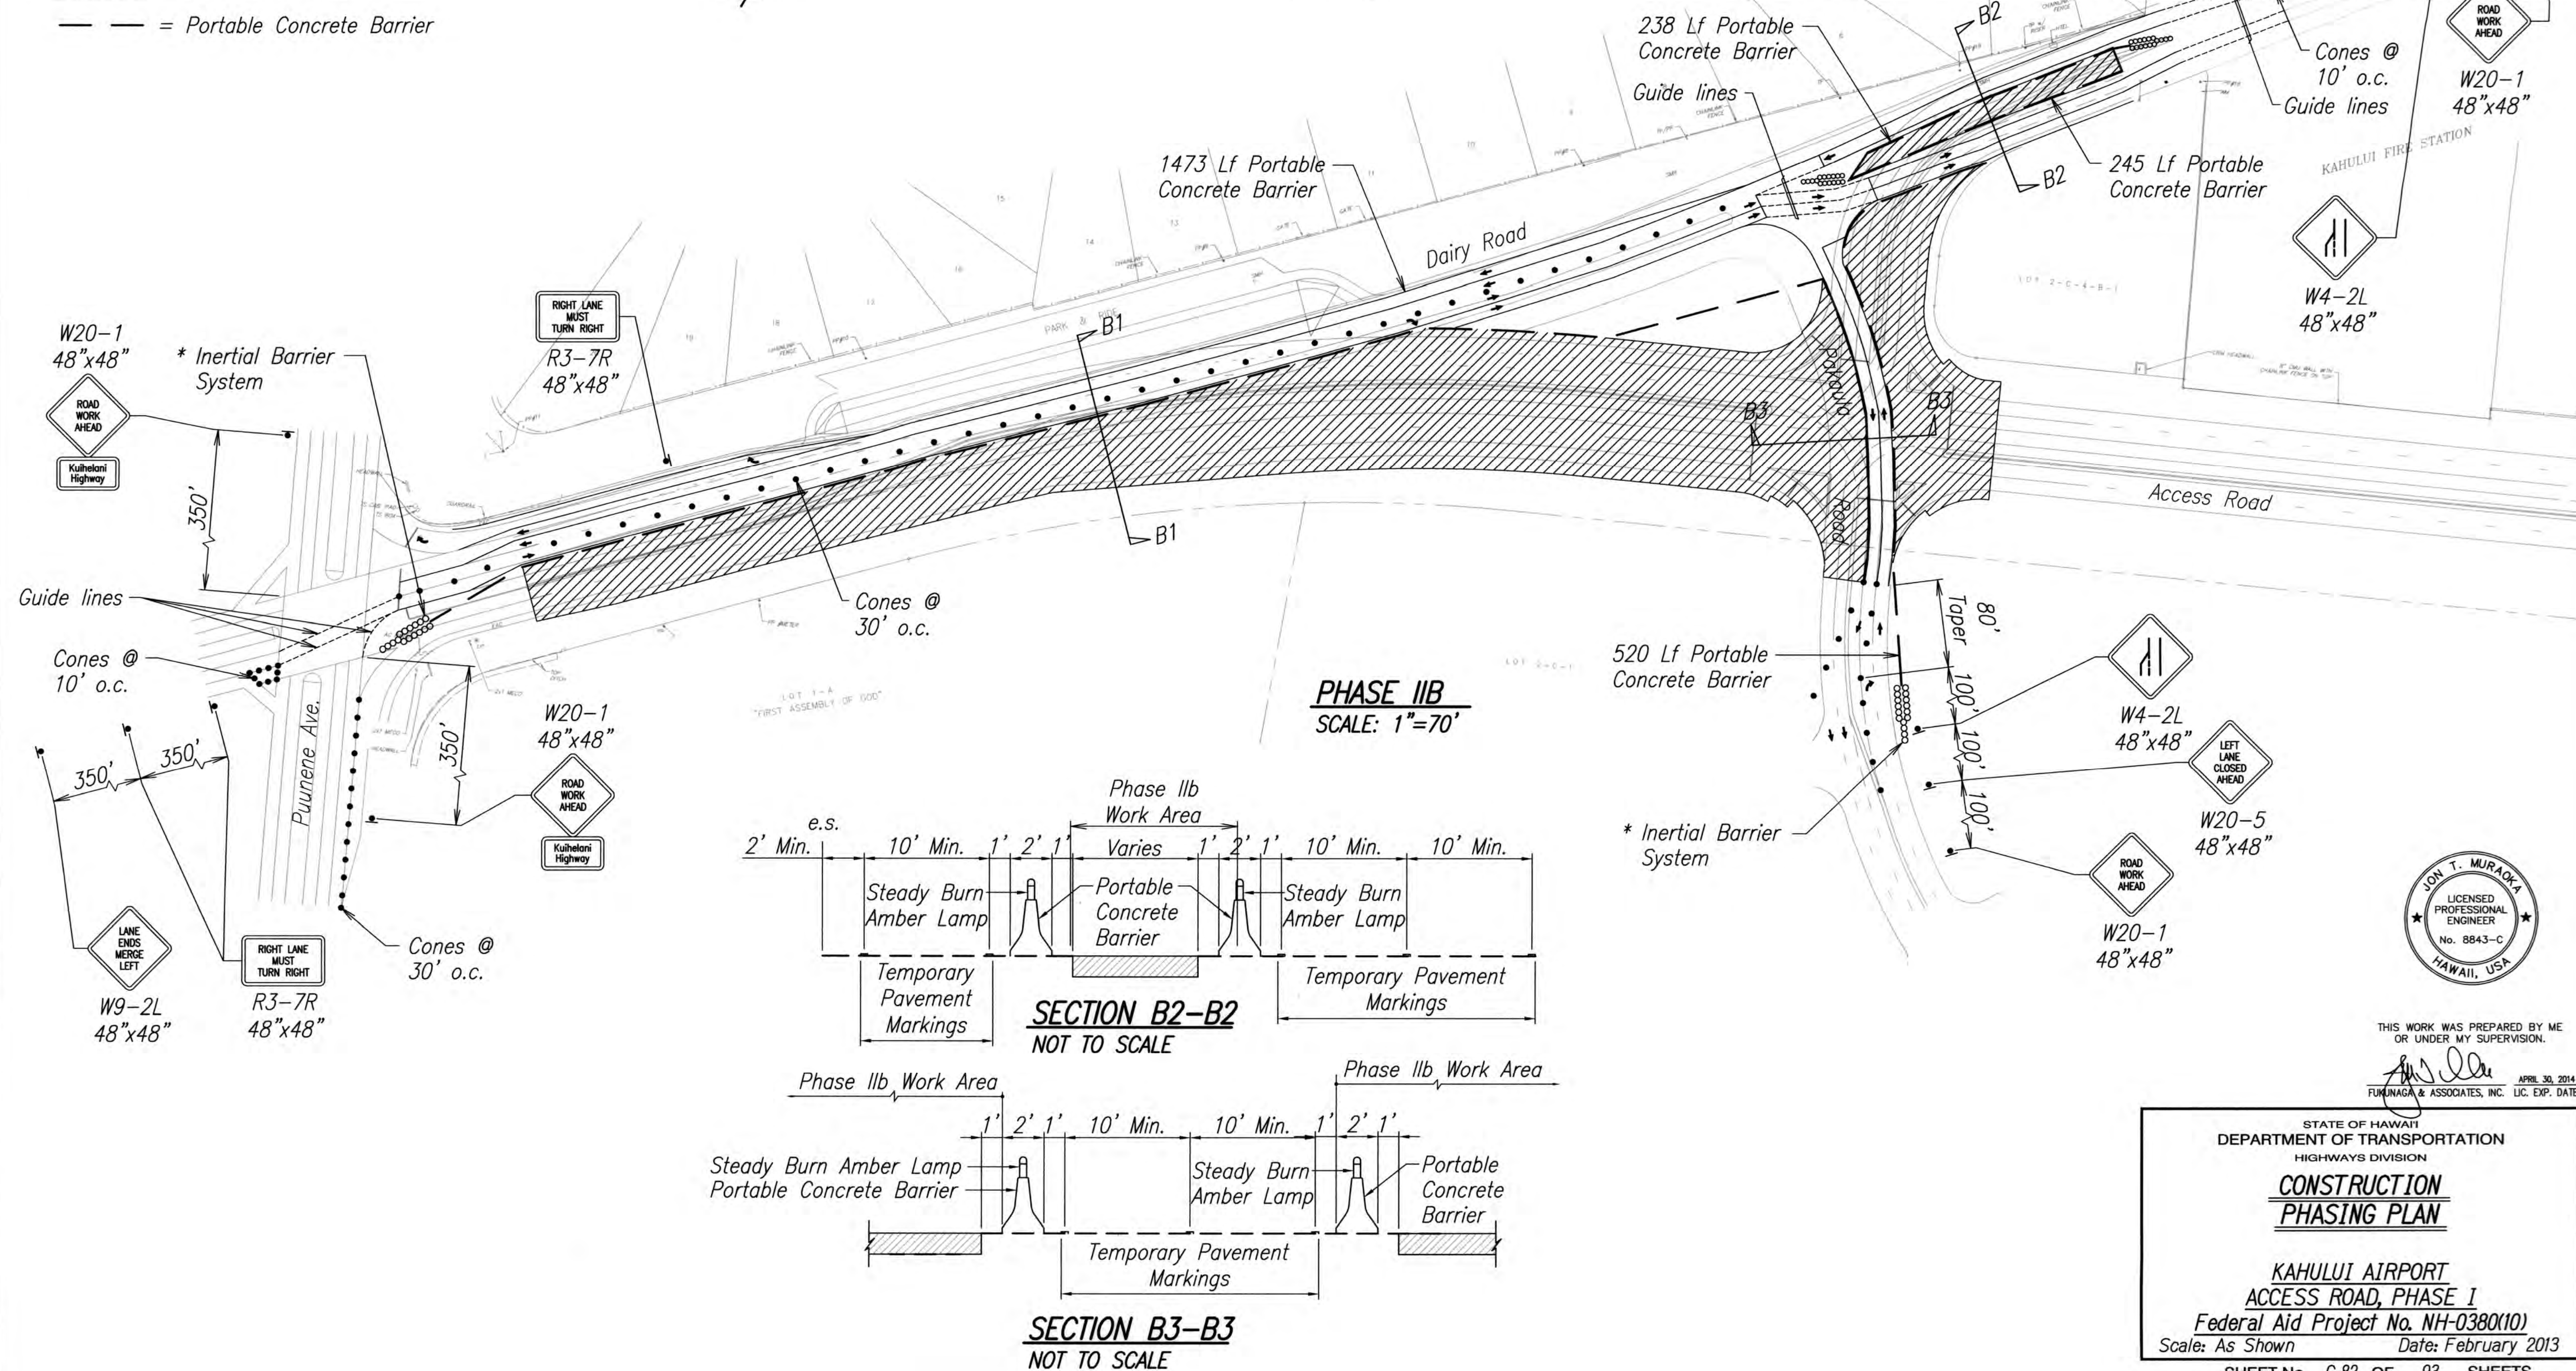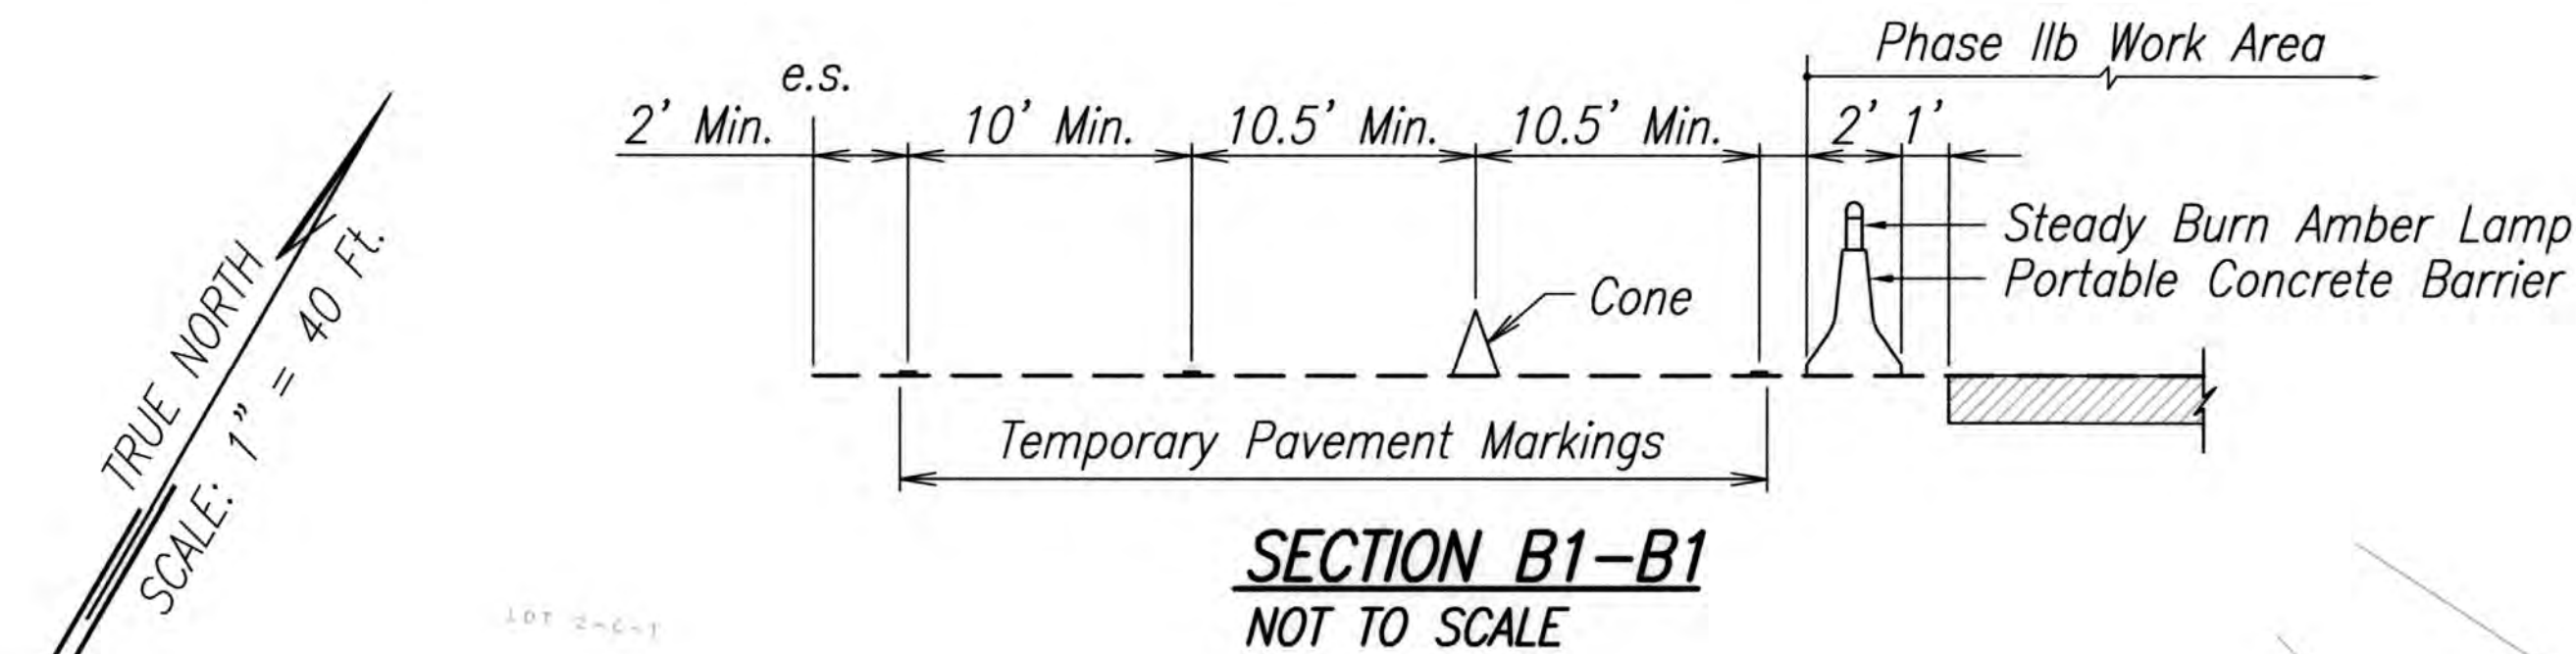

FED. ROAD DIST. NO.	STATE	FED. AID PROJ. NO.	FISCAL YEAR	SHEET NO.	TOTAL SHEETS
HAWAII	HAW.	NH-0380(10)	2013	95	166



THIS WORK WAS PREPARED BY ME OR UNDER MY SUPERVISION.
 APRIL 30, 2014
 FURUNAGA & ASSOCIATES, INC. LIC. EXP. DATE

STATE OF HAWAII
 DEPARTMENT OF TRANSPORTATION
 HIGHWAYS DIVISION
CONSTRUCTION PHASING PLAN
 KAHULUI AIRPORT
 ACCESS ROAD, PHASE I
 Federal Aid Project No. NH-0380(10)
 Scale: As Shown Date: February 2013
 SHEET No. C-82 OF 93 SHEETS

