



FED. ROAD DIST. NO.	STATE	FED. AID PROJ. NO.	FISCAL YEAR	SHEET NO.	TOTAL SHEETS
HAWAII	HAW.	NH-0380(10)	2013	28	166

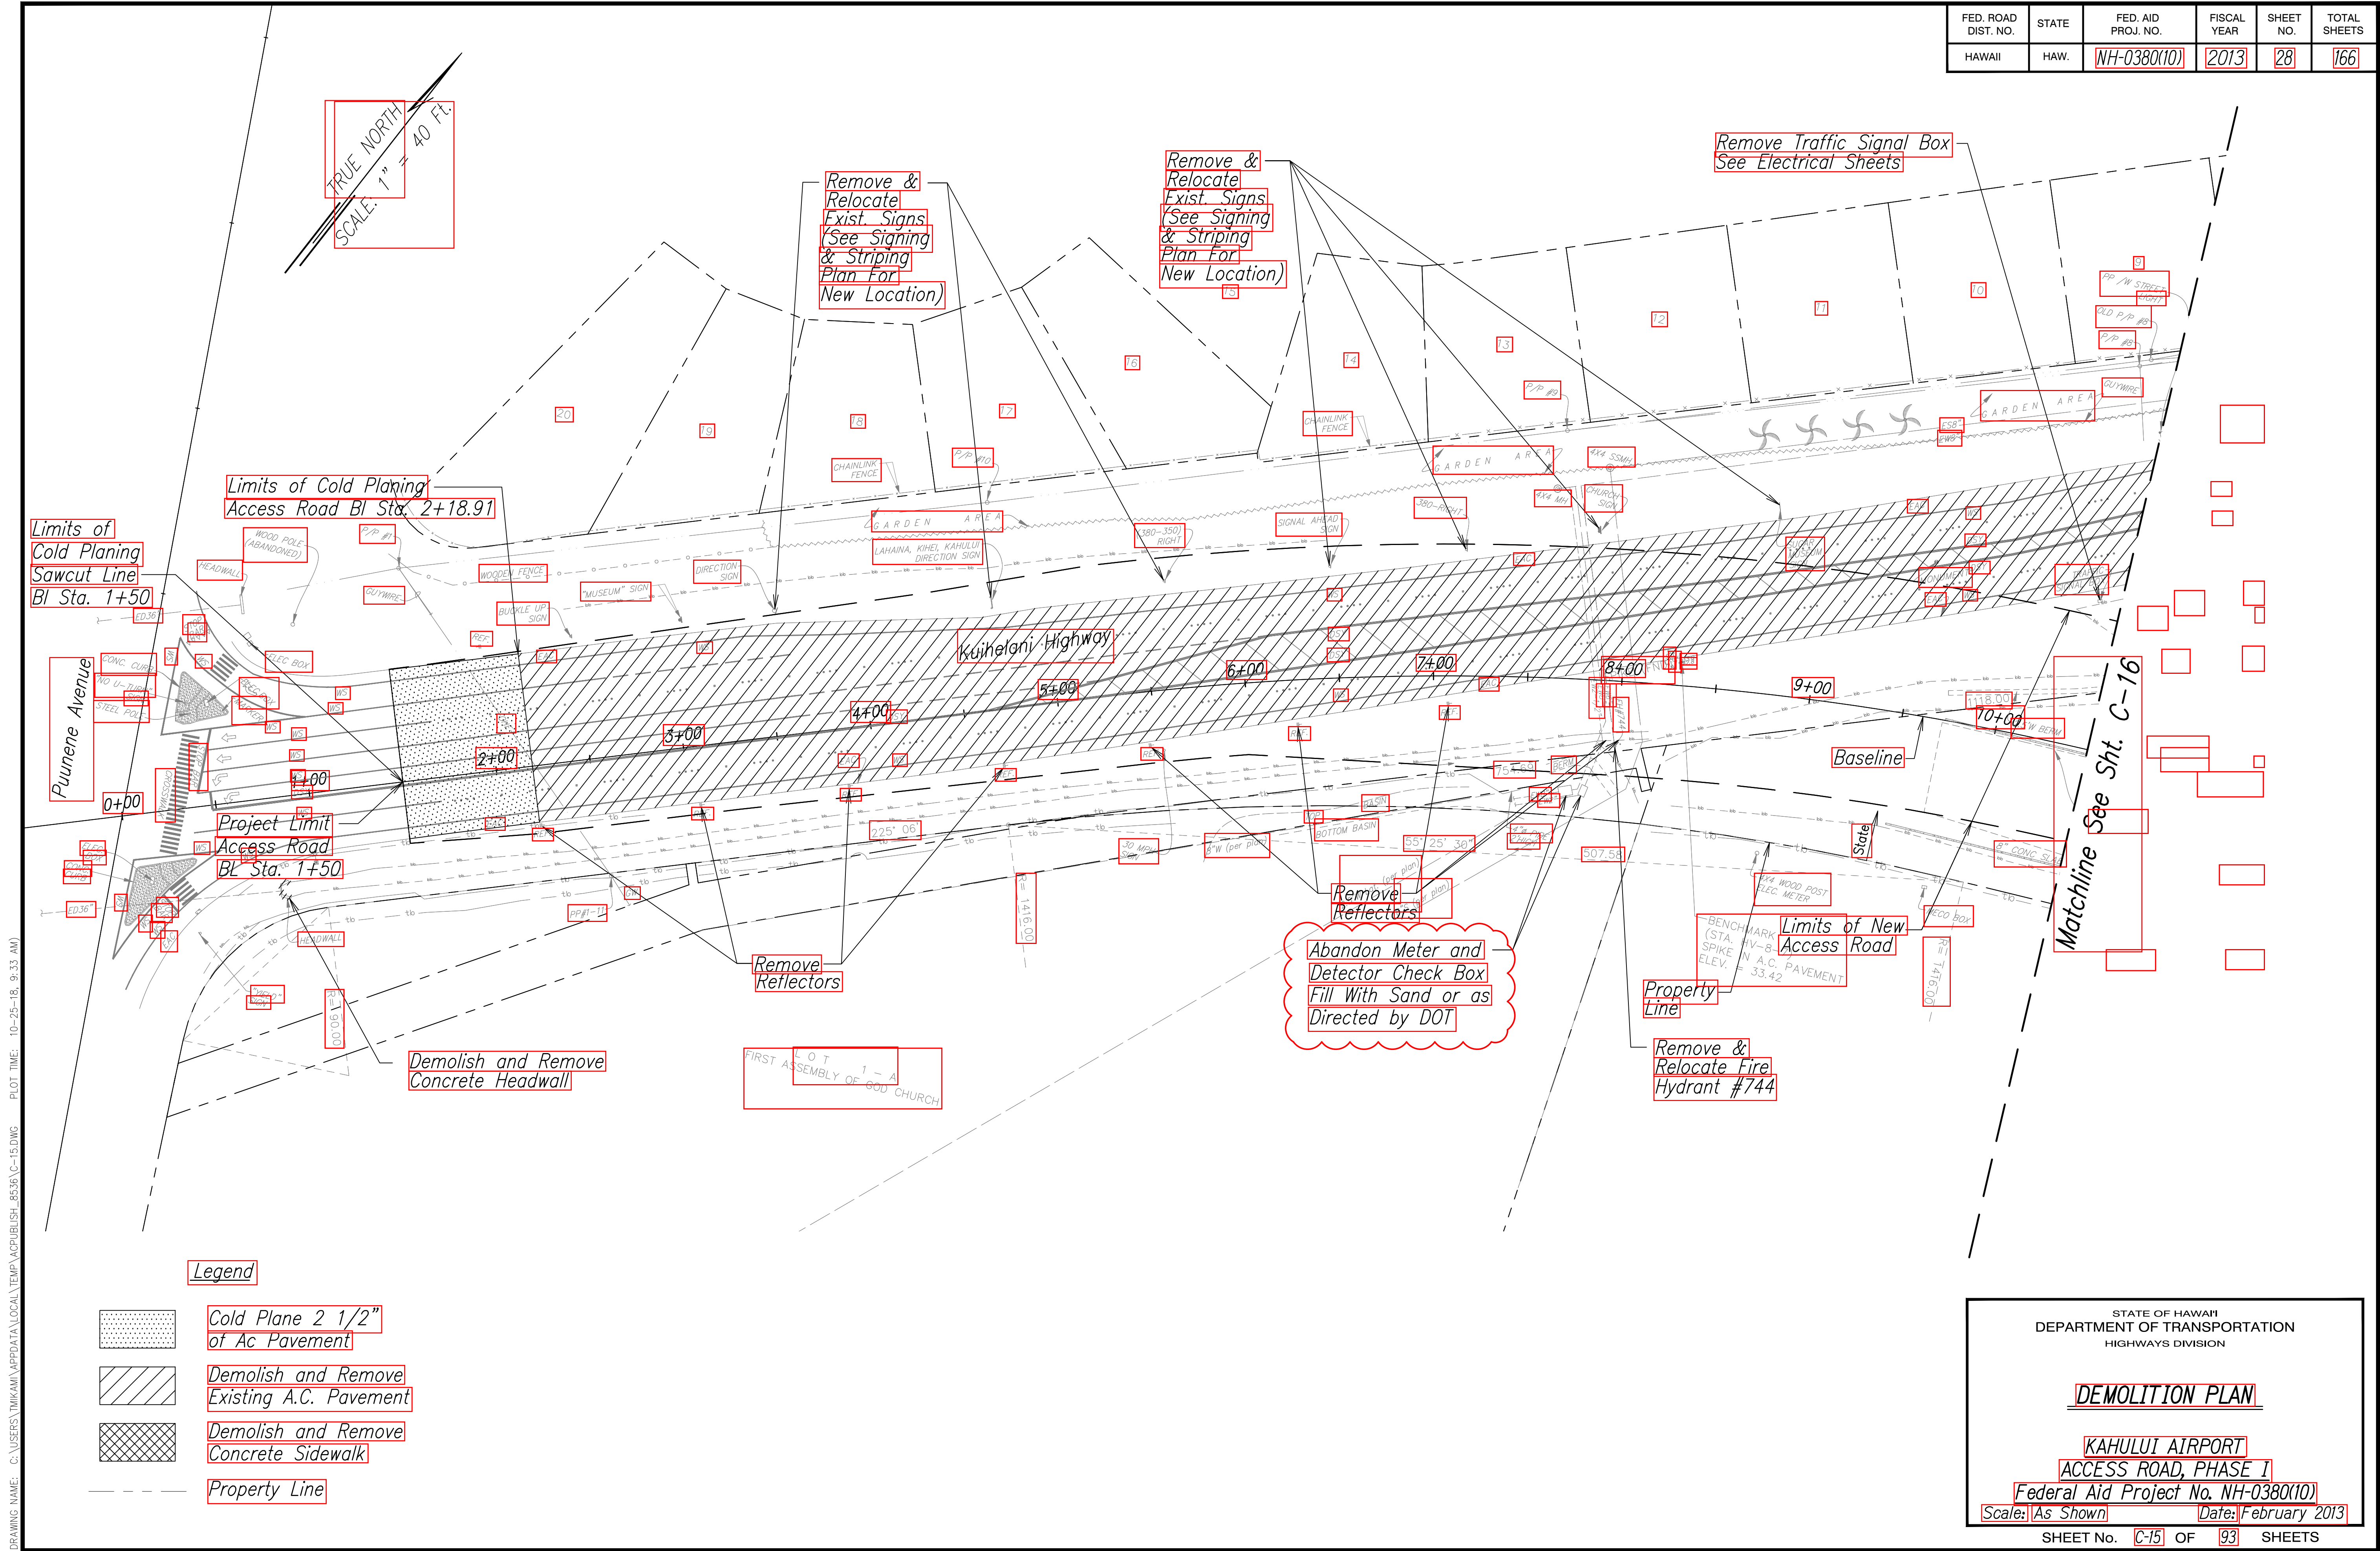

"AS-BUILT"

FED. ROAD DIST. NO.	STATE	FED. AID PROJ. NO.	FISCAL YEAR	SHEET NO.	TOTAL SHEETS
HAWAII	HAW.	NH-0380(10)	2013	30	166

TRUE NORTH
SCALE: 1" = 40 Ft.

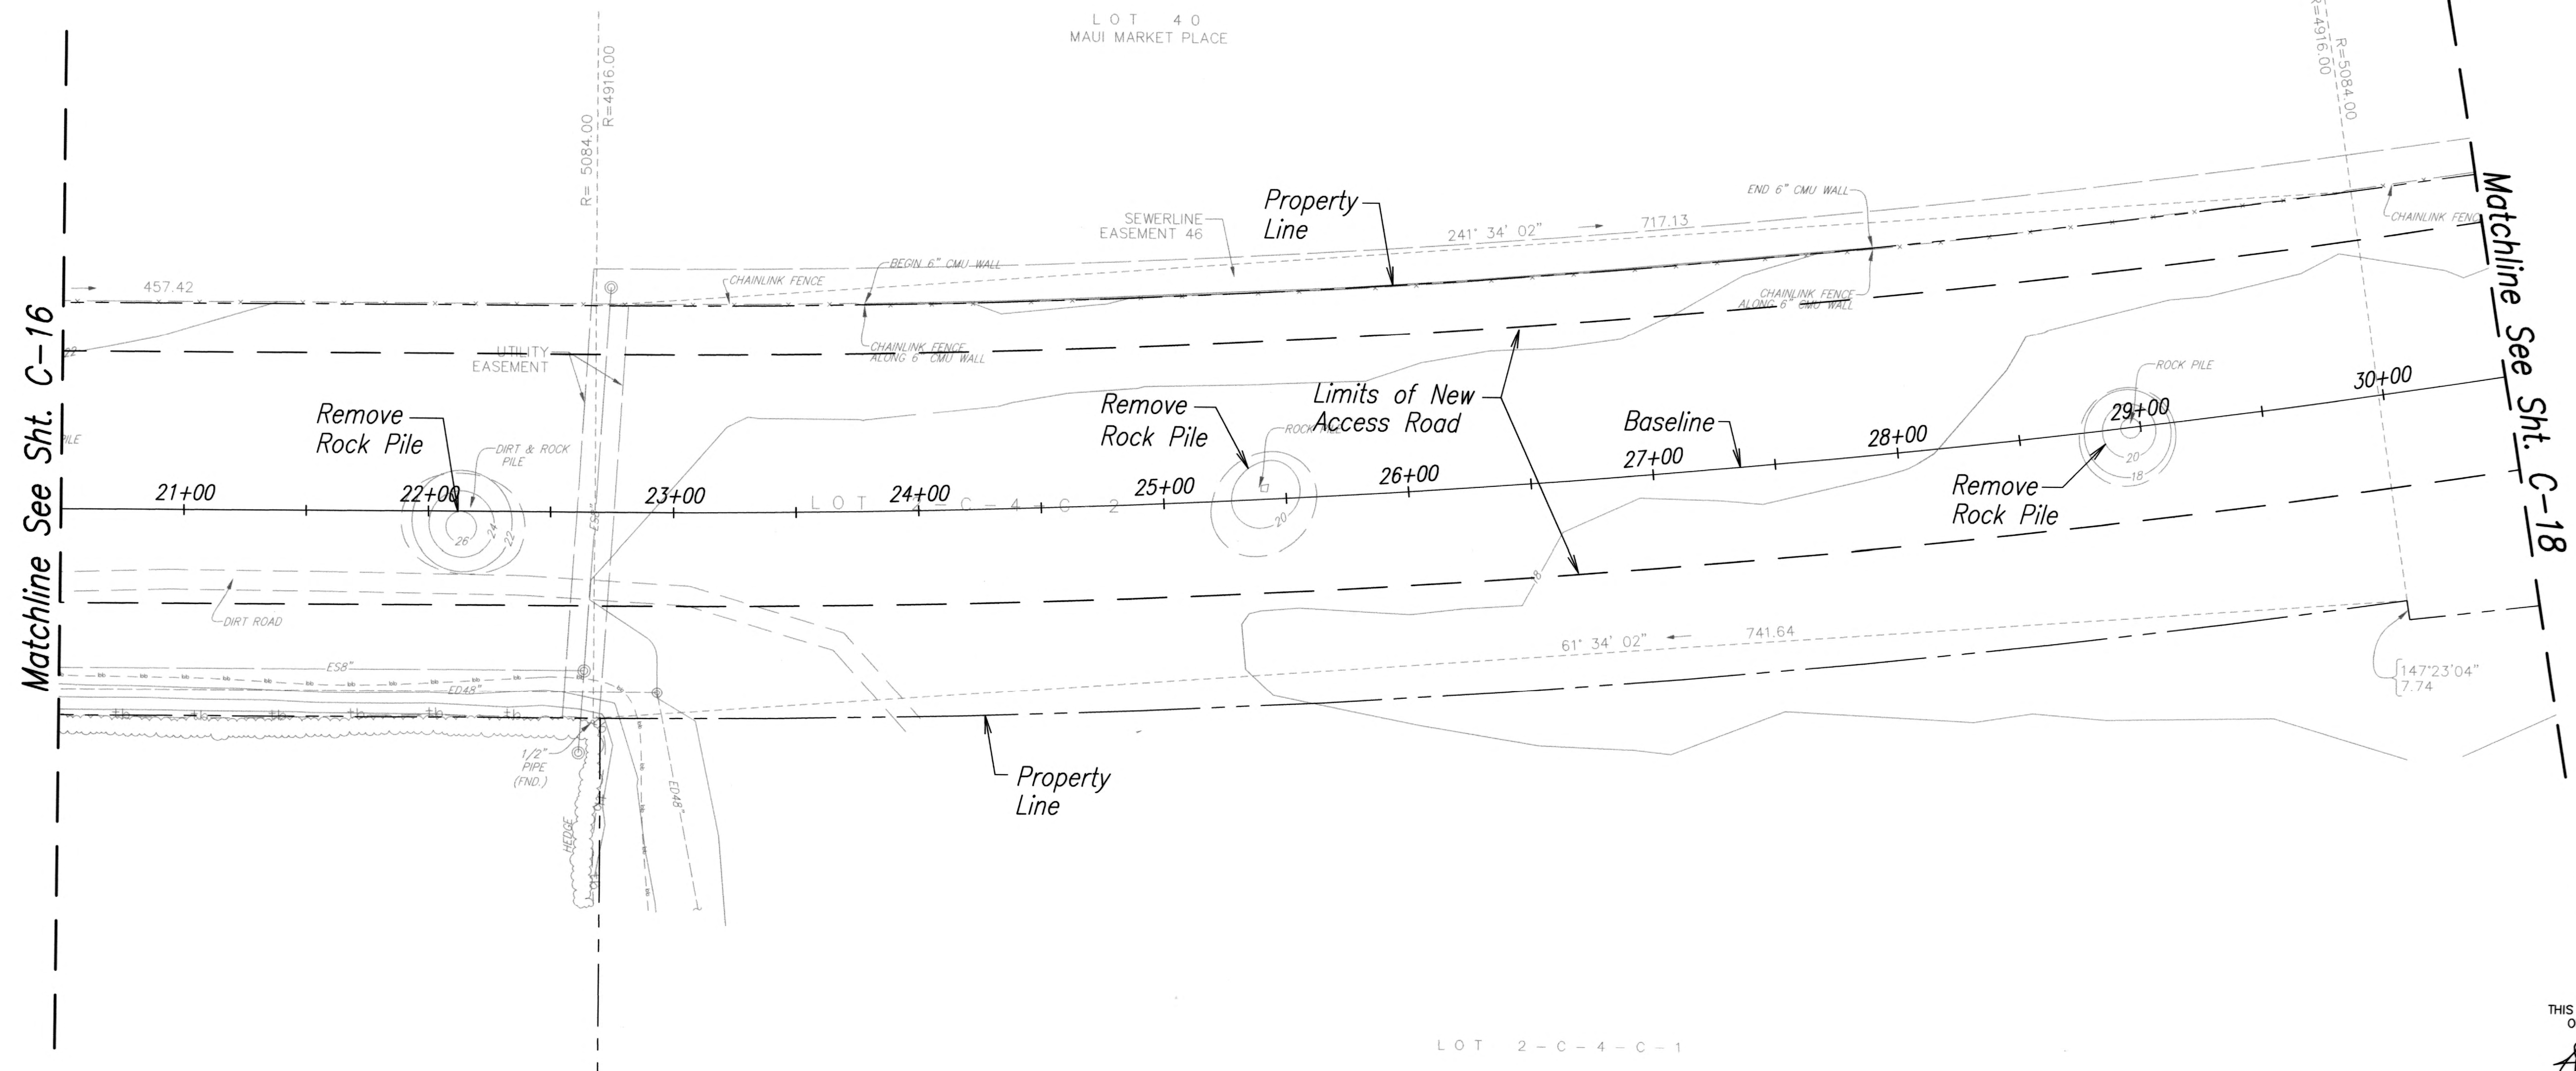

ORIGINAL PLAN	SURVEY PLOTTED BY	DATE
NOTE BOOK	DRAWN BY	
No.	QUANTITIES BY	
	CHECKED BY	

DRAWING NAME: C:\PROJECTS\KAHULUI-2011\PLANS\7-DEMOLITION PLAN\7-C-17 REV.DWG PLOT TIME: 02-22-13, 1:36 PM

- Legend**
- Demolish and Remove Existing A.C. Pavement
 - Demolish and Remove Concrete Sidewalk
 - Property Line




THIS WORK WAS PREPARED BY ME OR UNDER MY SUPERVISION.
APRIL 30, 2014
FUKUNAGA & ASSOCIATES, INC. LIC. EXP. DATE

STATE OF HAWAII
DEPARTMENT OF TRANSPORTATION
HIGHWAYS DIVISION

DEMOLITION PLAN

KAHULUI AIRPORT
ACCESS ROAD, PHASE I
Federal Aid Project No. NH-0380(10)
Scale: As Shown Date: February 2013
SHEET No. C-17 OF 93 SHEETS

FED. ROAD DIST. NO.	STATE	FED. AID PROJ. NO.	FISCAL YEAR	SHEET NO.	TOTAL SHEETS
HAWAII	HAW.	NH-0380(10)	2013	31	166

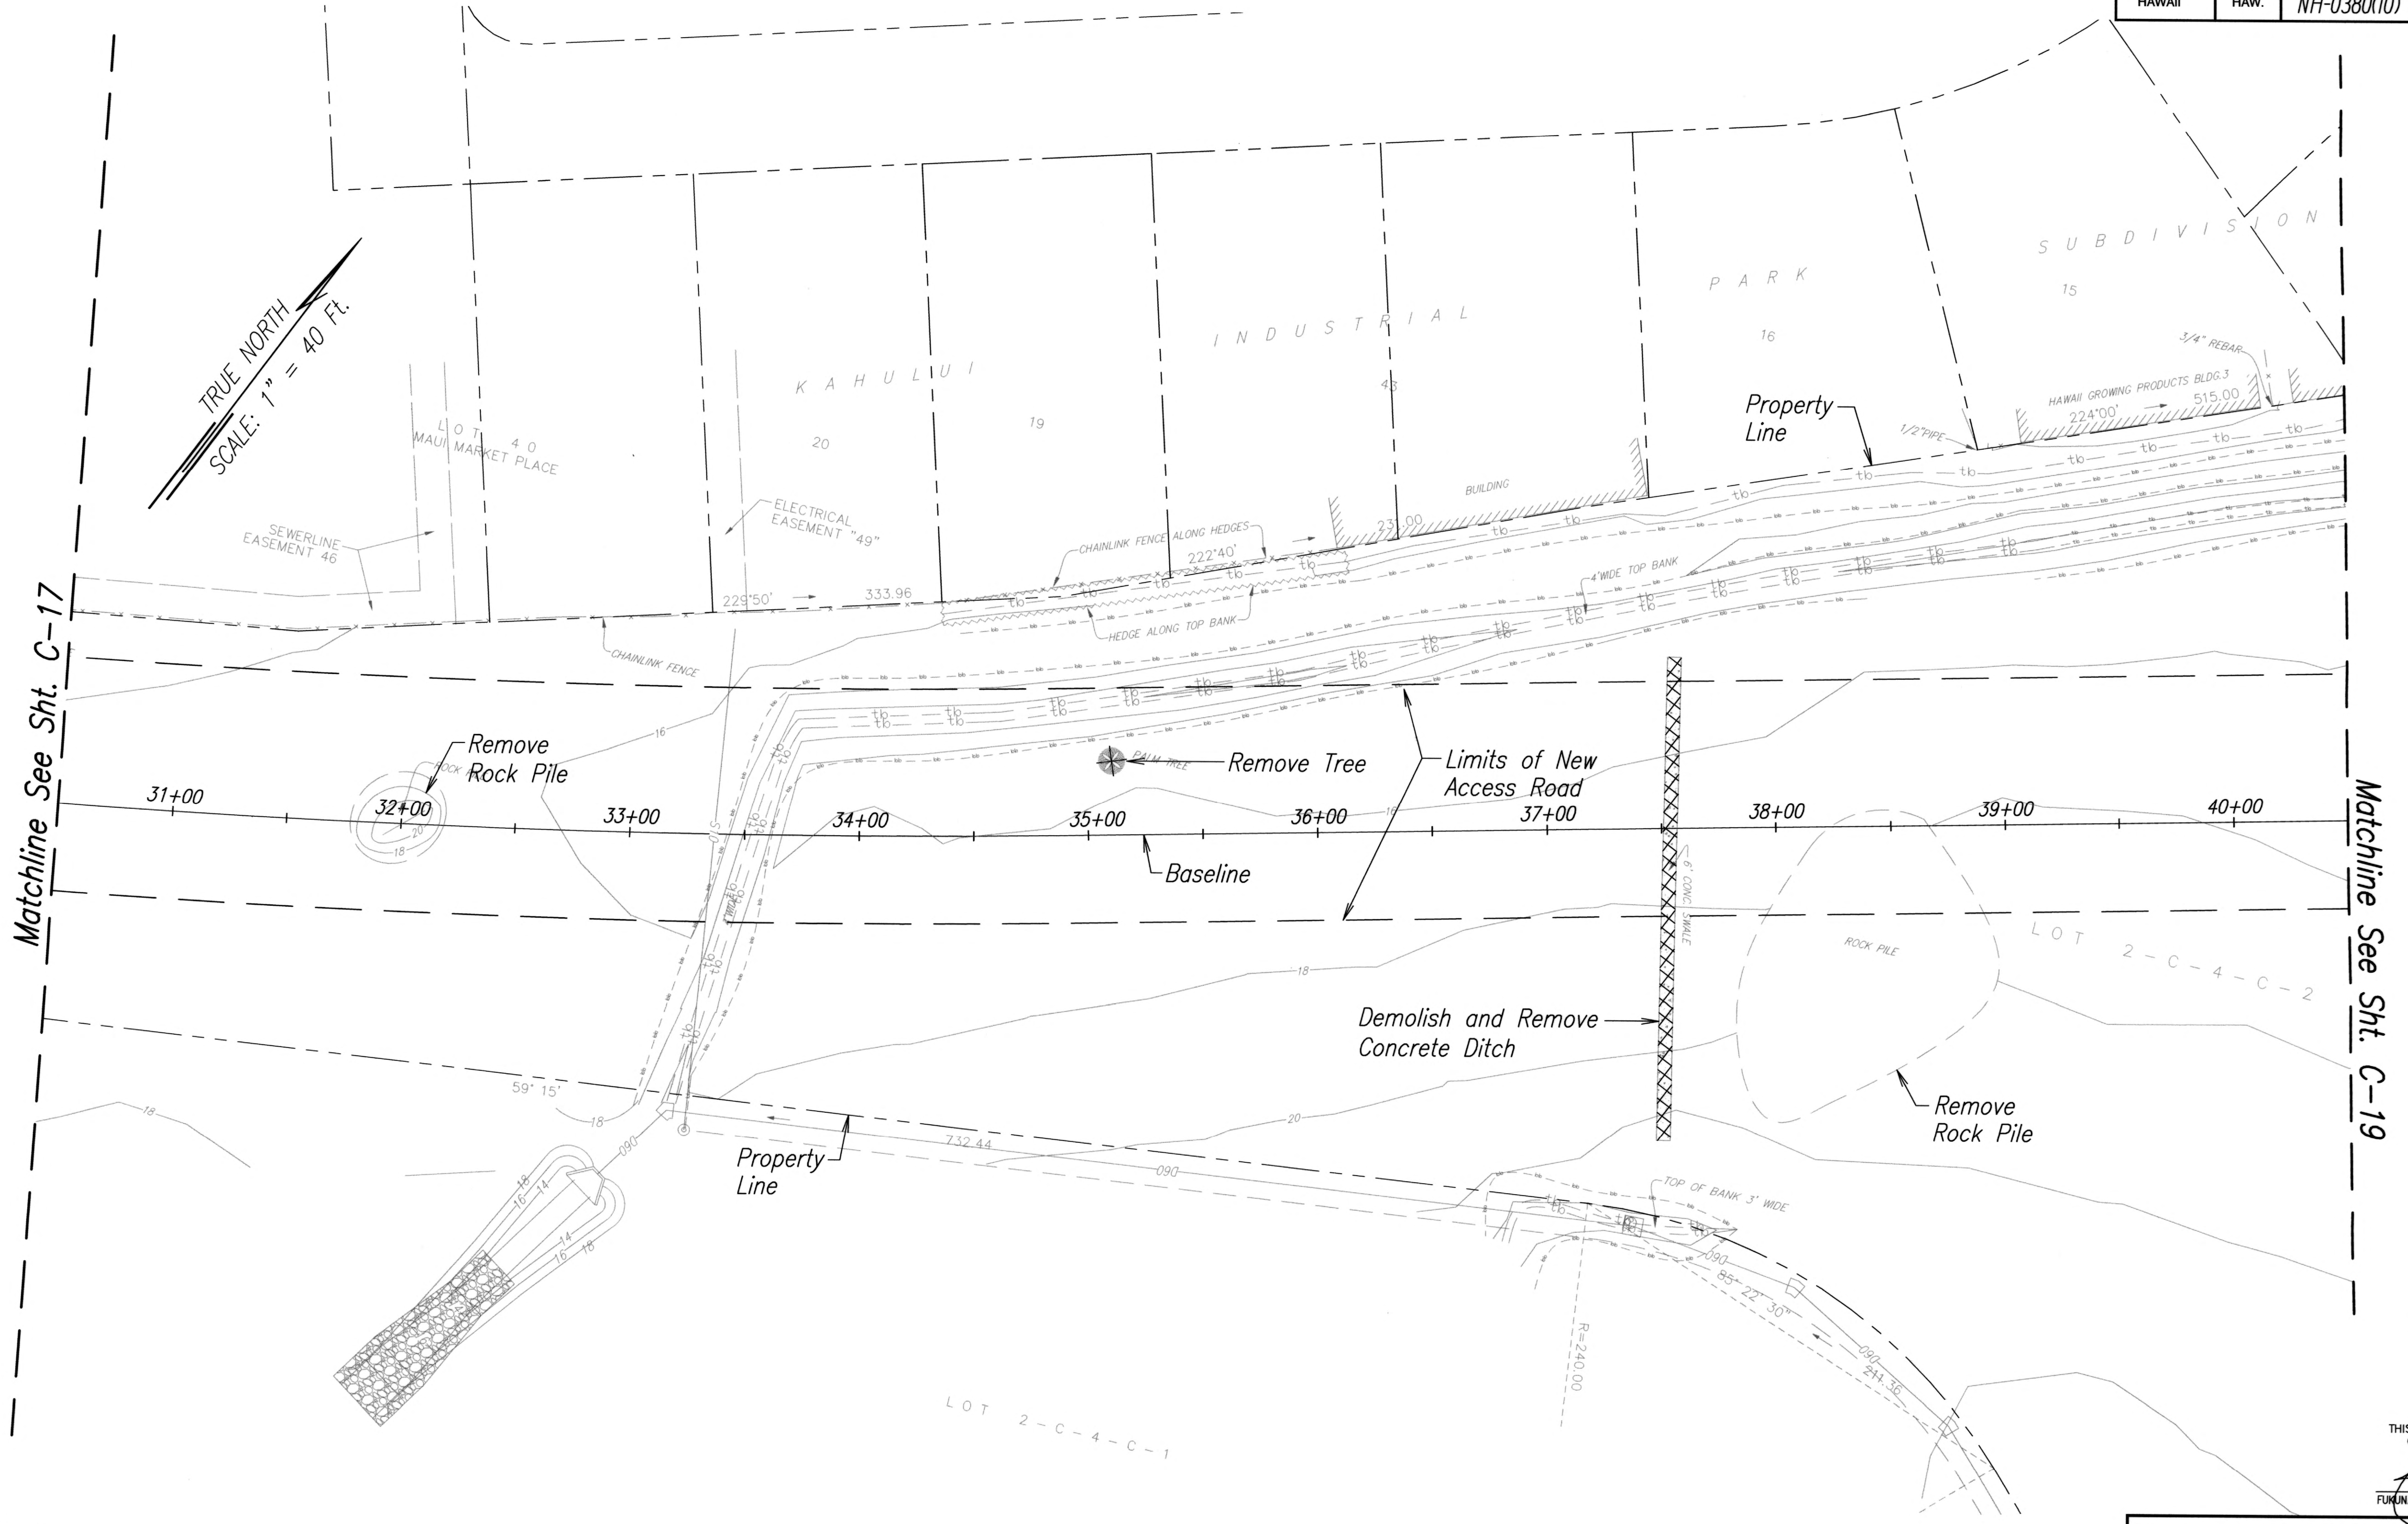

- Legend**
- Demolish and Remove Existing A.C. Pavement
 - Demolish and Remove Concrete Sidewalk
 - Property Line

ORIGINAL PLAN	SURVEY PLATTED BY	DATE
NOTE BOOK	DRAWN BY	
No.	DESIGNED BY	
	CHECKED BY	

DRAWING NAME: C:\PROJECTS\KAHULUI-2011\PLANS\7-DEMOLITION PLAN\C-18 REV.DWG PLOT TIME: 02-22-13, 1:37 PM



THIS WORK WAS PREPARED BY ME OR UNDER MY SUPERVISION.
[Signature]
FUMINAGA & ASSOCIATES, INC. APR 30, 2014 LIC. EXP. DATE

STATE OF HAWAII
DEPARTMENT OF TRANSPORTATION
HIGHWAYS DIVISION

DEMOLITION PLAN



KAHULUI AIRPORT
ACCESS ROAD, PHASE I
Federal Aid Project No. NH-0380(10)
Scale: As Shown Date: February 2013

SHEET No. C-18 OF 93 SHEETS


FED. ROAD DIST. NO.	STATE	FED. AID PROJ. NO.	FISCAL YEAR	SHEET NO.	TOTAL SHEETS
HAWAII	HAW.	NH-0380(10)	2013	32	166

DRAWING NAME: C:\PROJECTS\KAHULUI-2011\PLANS\7-DEMOLITION\PLAN\ C-19 REV.DWG PLOT TIME: 02-22-13, 1:37 PM

ORIGINAL PLAN	SURVEY PLOTTED BY	DATE
NOTE BOOK	DRAWN BY	
No.	DESIGNED BY	
	QUANTITIES BY	
	CHECKED BY	

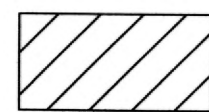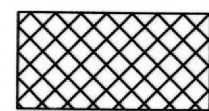- Legend**
-  Demolish and Remove Existing A.C. Pavement
 -  Demolish and Remove Concrete Sidewalk
 -  Property Line

Matchline See Sht. C-18

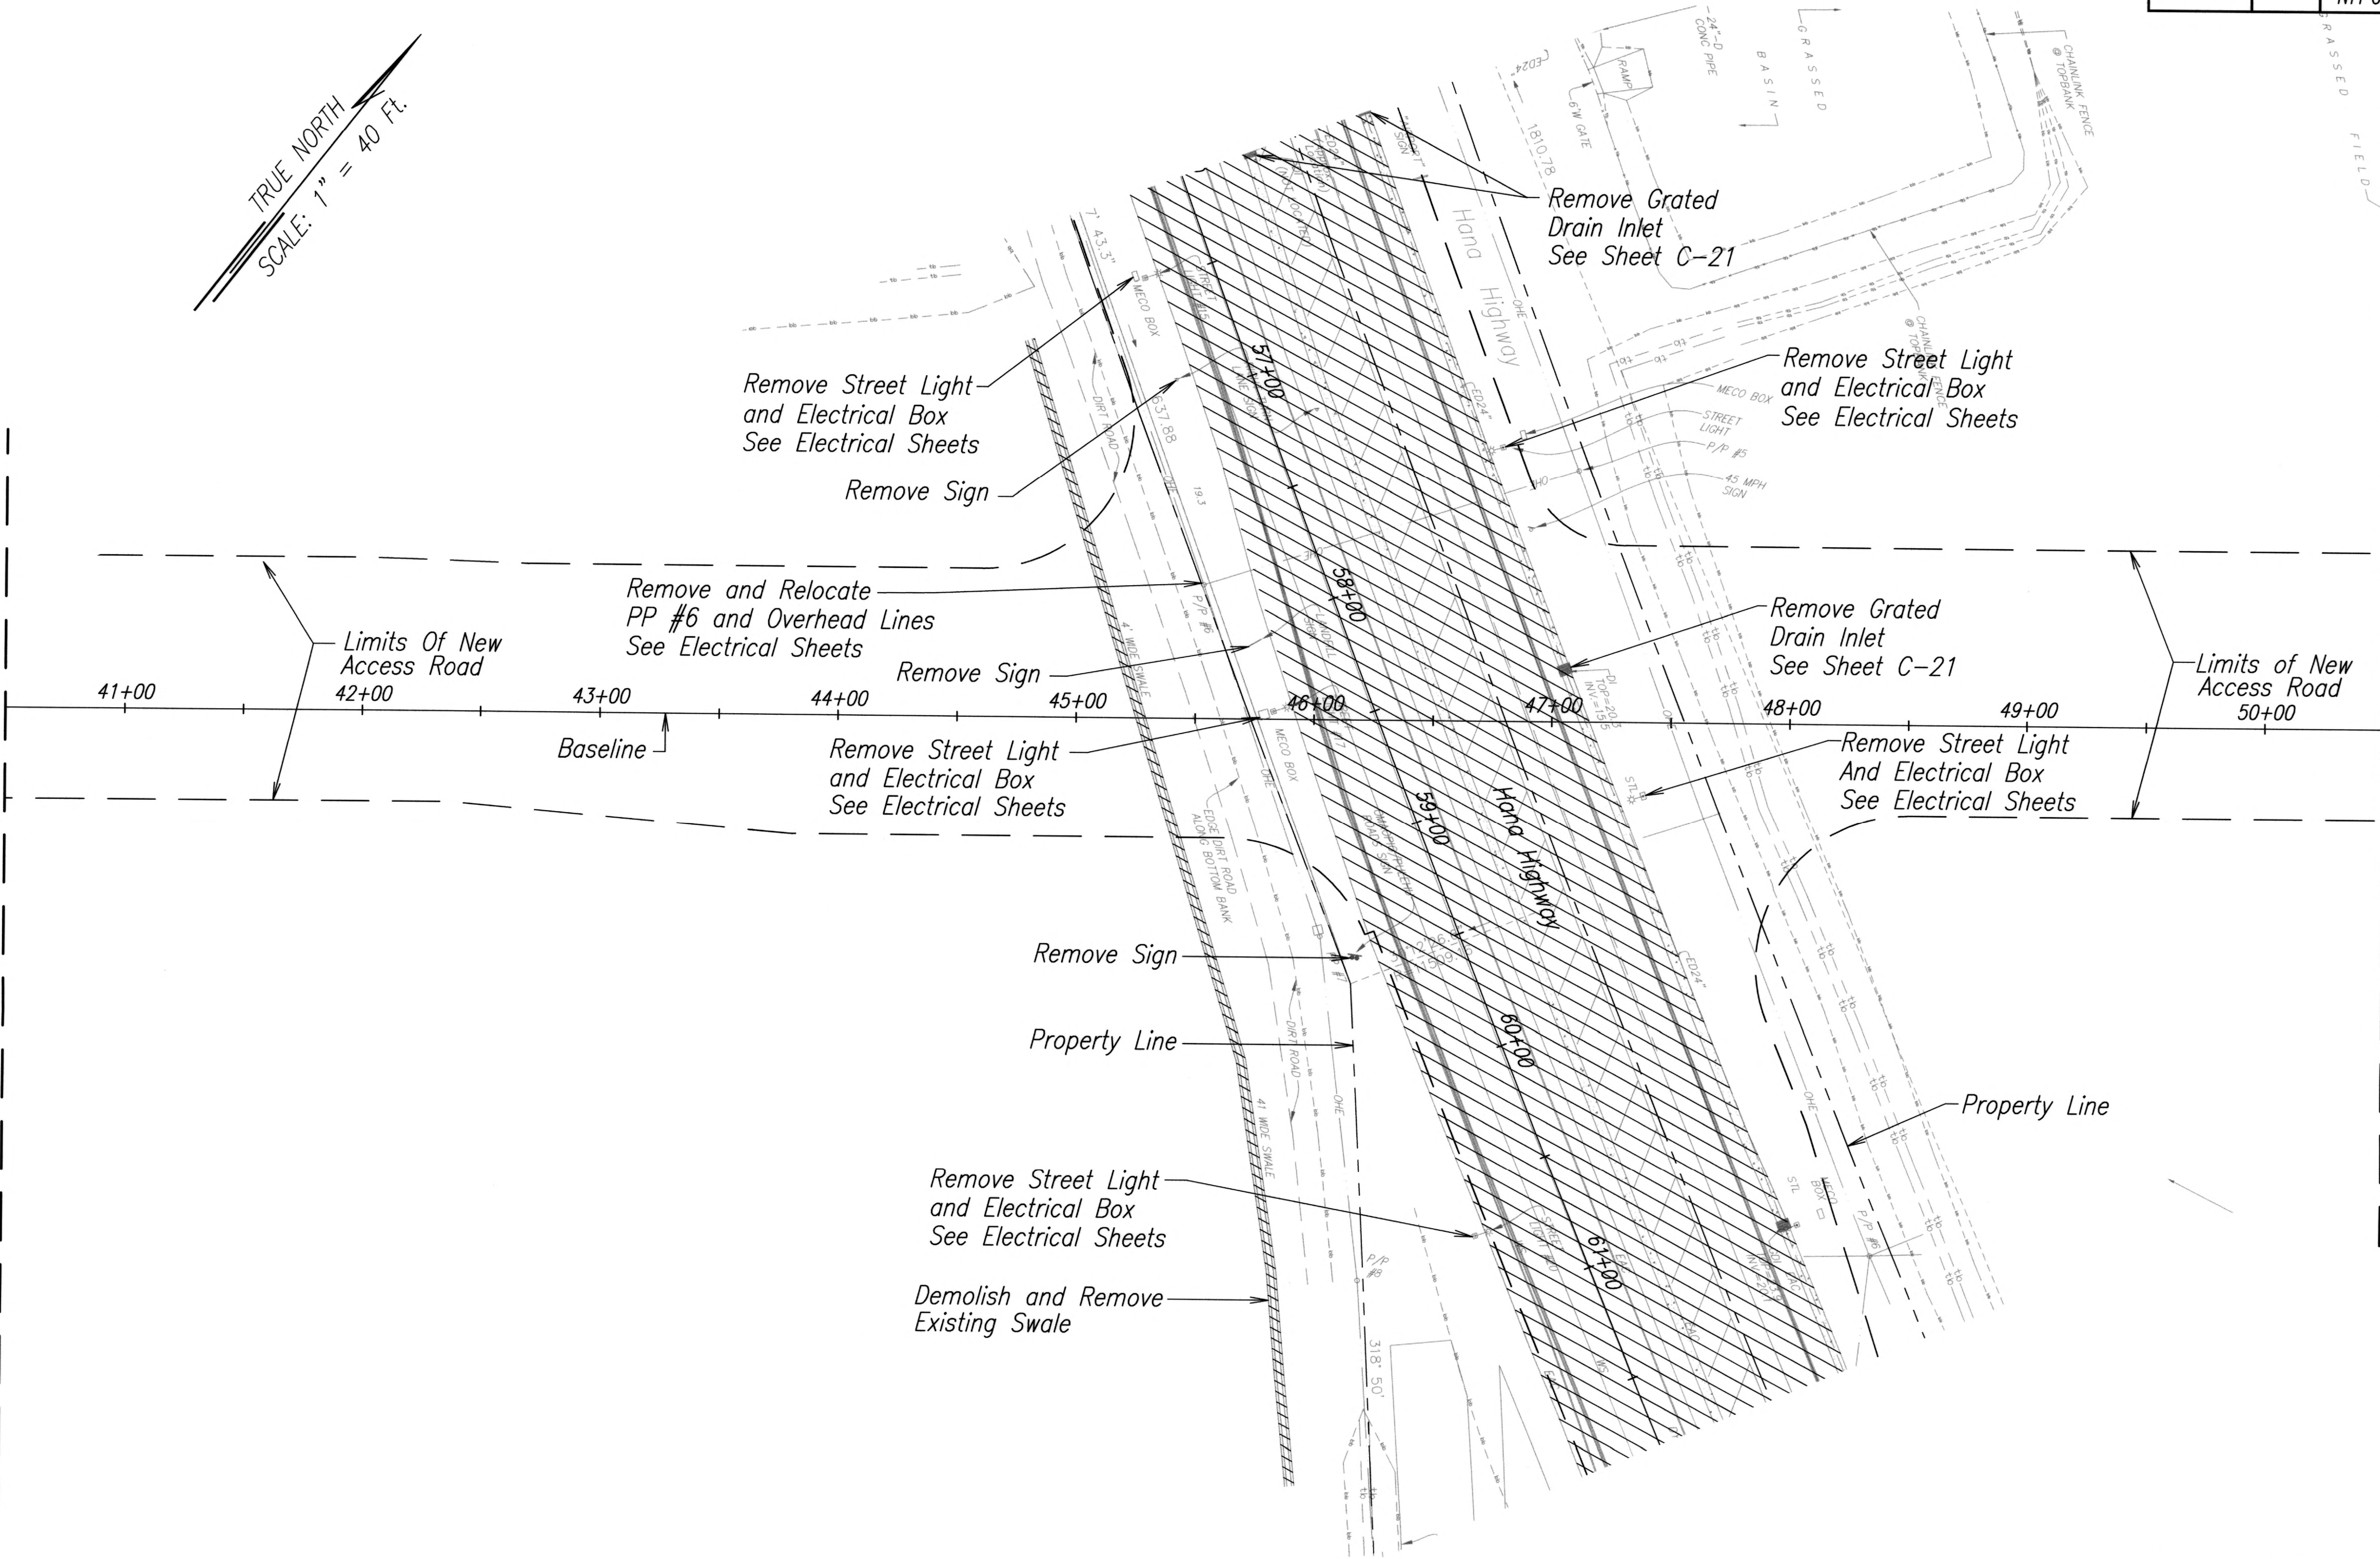

THIS WORK WAS PREPARED BY ME
OR UNDER MY SUPERVISION.
[Signature]
FUKUNAGA & ASSOCIATES, INC. L.C. EXP. DATE
APRIL 30, 2014


STATE OF HAWAII
DEPARTMENT OF TRANSPORTATION
HIGHWAYS DIVISION

DEMOLITION PLAN

KAHULUI AIRPORT
ACCESS ROAD, PHASE I
Federal Aid Project No. NH-0380(10)
Scale: As Shown Date: February 2013

SHEET No. C-19 OF 93 SHEETS


FED. ROAD DIST. NO.	STATE	FED. AID PROJ. NO.	FISCAL YEAR	SHEET NO.	TOTAL SHEETS
HAWAII	HAW.	NH-0380(10)	2013	33	166

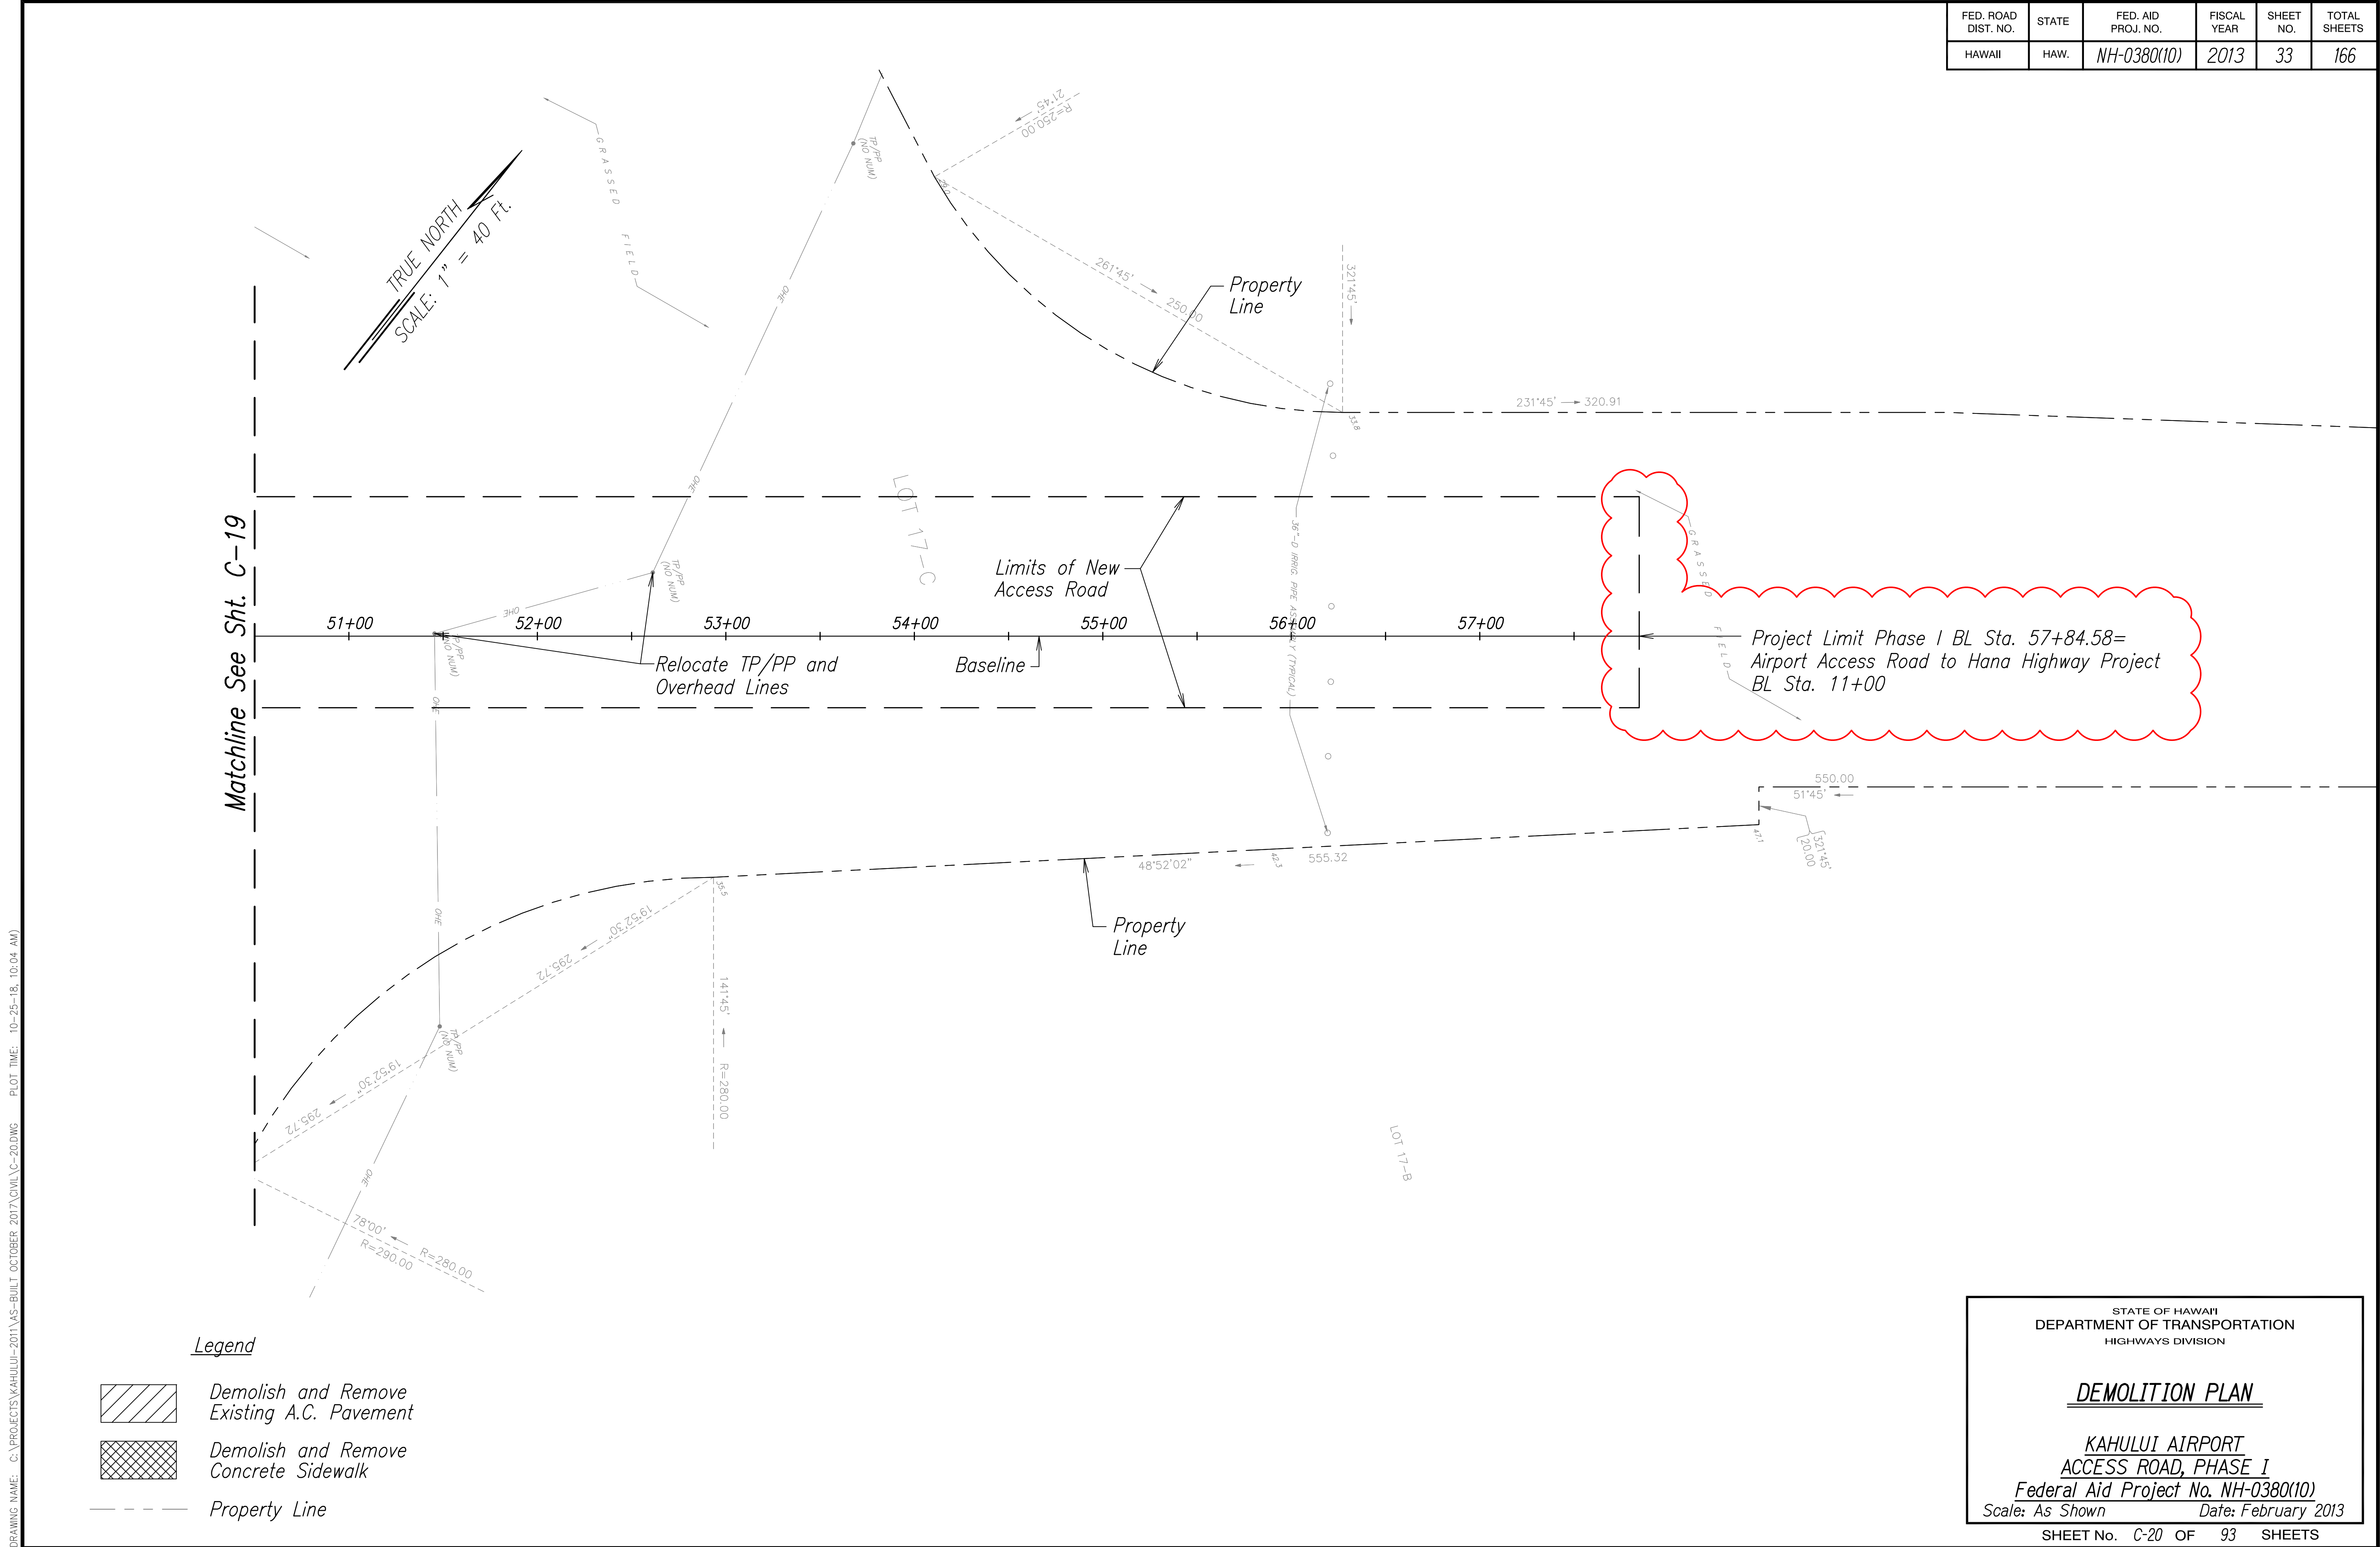

"AS-BUILT"

AS-BUILT DRAWINGS

FED. ROAD DIST. NO.	STATE	FED. AID PROJ. NO.	FISCAL YEAR	SHEET NO.	TOTAL SHEETS
HAWAII	HAW.	NH-0380(10)	2013	34	166

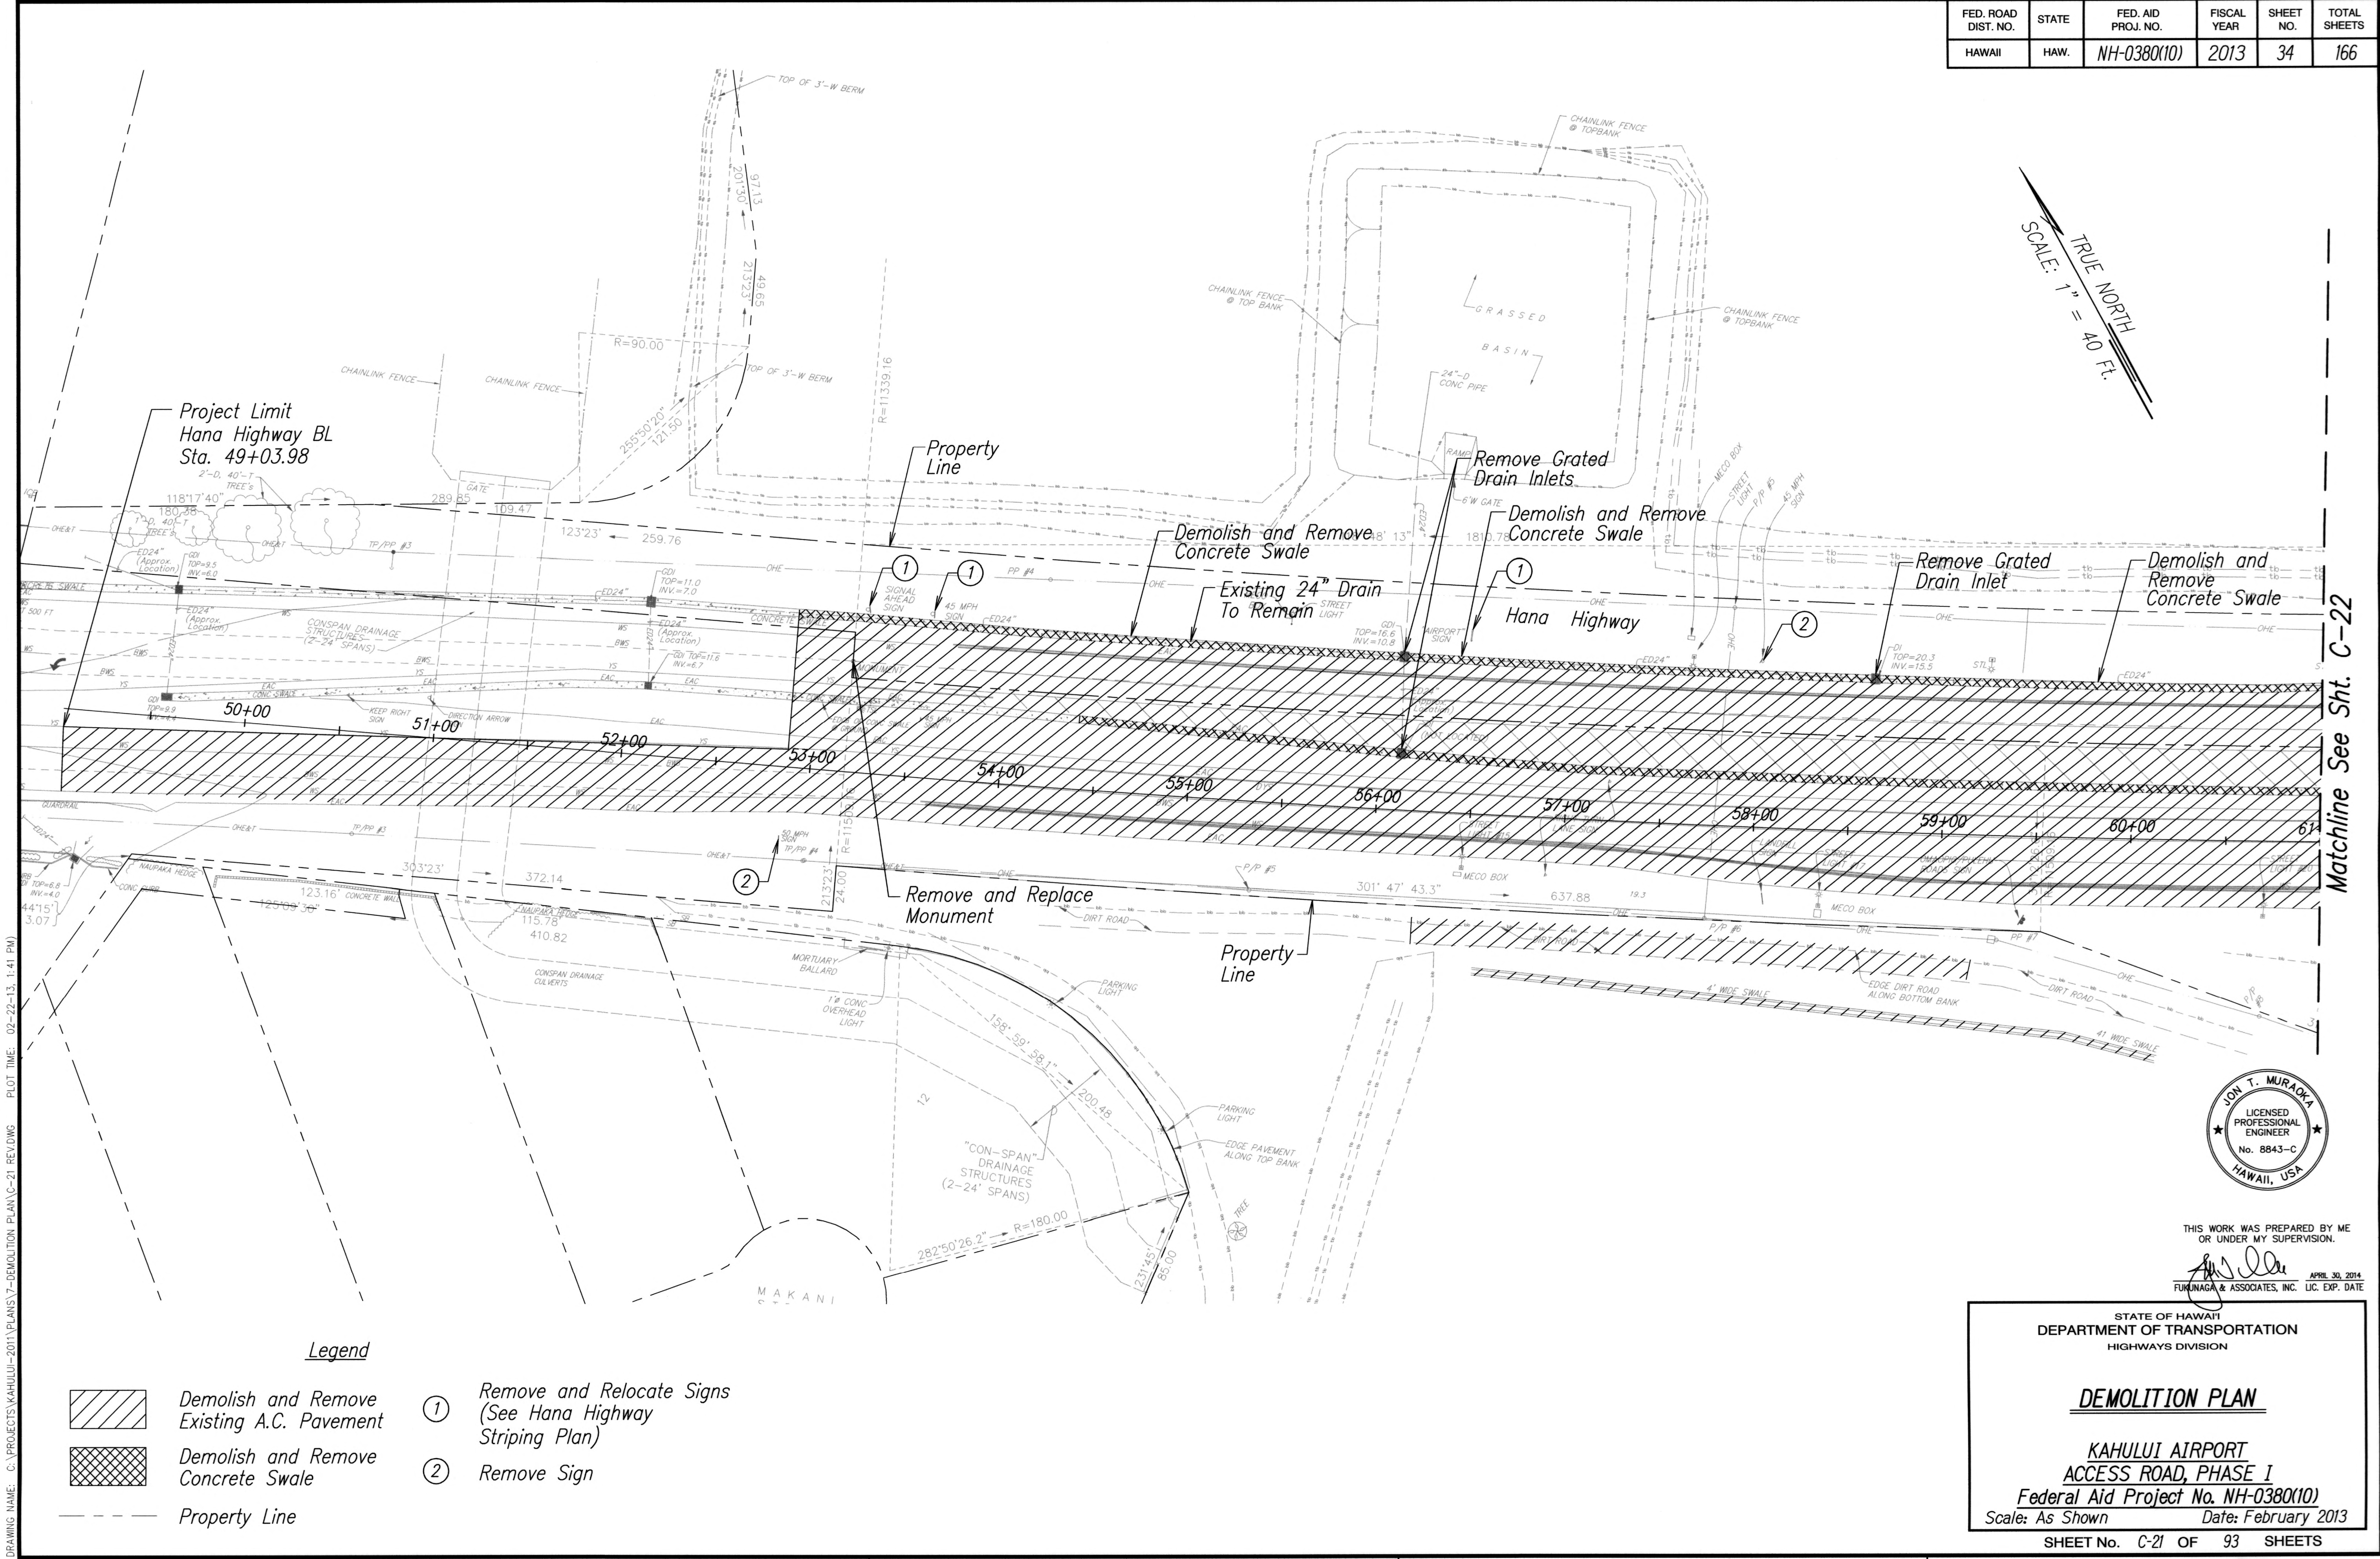

Matchline See Sht. C-22

DATE	_____
SURVEY PLOTTED BY	_____
DRAWN BY	_____
DESIGNED BY	_____
CHECKED BY	_____
ORIGINAL PLAN	_____
NOTE BOOK	_____
No.	_____

DRAWING NAME: C:\PROJECTS\KAHULUI-2011\PLANS\7-DEMOLITION PLAN\7-21 REV.DWG PLOT TIME: 02-22-13, 1:41 PM

- Legend**
- Demolish and Remove Existing A.C. Pavement
 - Demolish and Remove Concrete Swale
 - Property Line
 - Remove and Relocate Signs (See Hana Highway Striping Plan)
 - Remove Sign

STATE OF HAWAII
DEPARTMENT OF TRANSPORTATION
HIGHWAYS DIVISION

DEMOLITION PLAN

**KAHULUI AIRPORT
ACCESS ROAD, PHASE I**
Federal Aid Project No. NH-0380(10)
Scale: As Shown Date: February 2013

SHEET No. C-21 OF 93 SHEETS

THIS WORK WAS PREPARED BY ME
OR UNDER MY SUPERVISION.


JON T. MURAKAMI
LICENSED PROFESSIONAL ENGINEER
No. 8843-C
HAWAII, USA

APRIL 30, 2014
FURUNAGA & ASSOCIATES, INC. L.C. EXP. DATE

FED. ROAD DIST. NO.	STATE	FED. AID PROJ. NO.	FISCAL YEAR	SHEET NO.	TOTAL SHEETS
HAWAII	HAW.	NH-0380(10)	2013	35	166

Matchline See Sht. C-21

SCALE: 1" = 40 FT.
TRUE NORTH

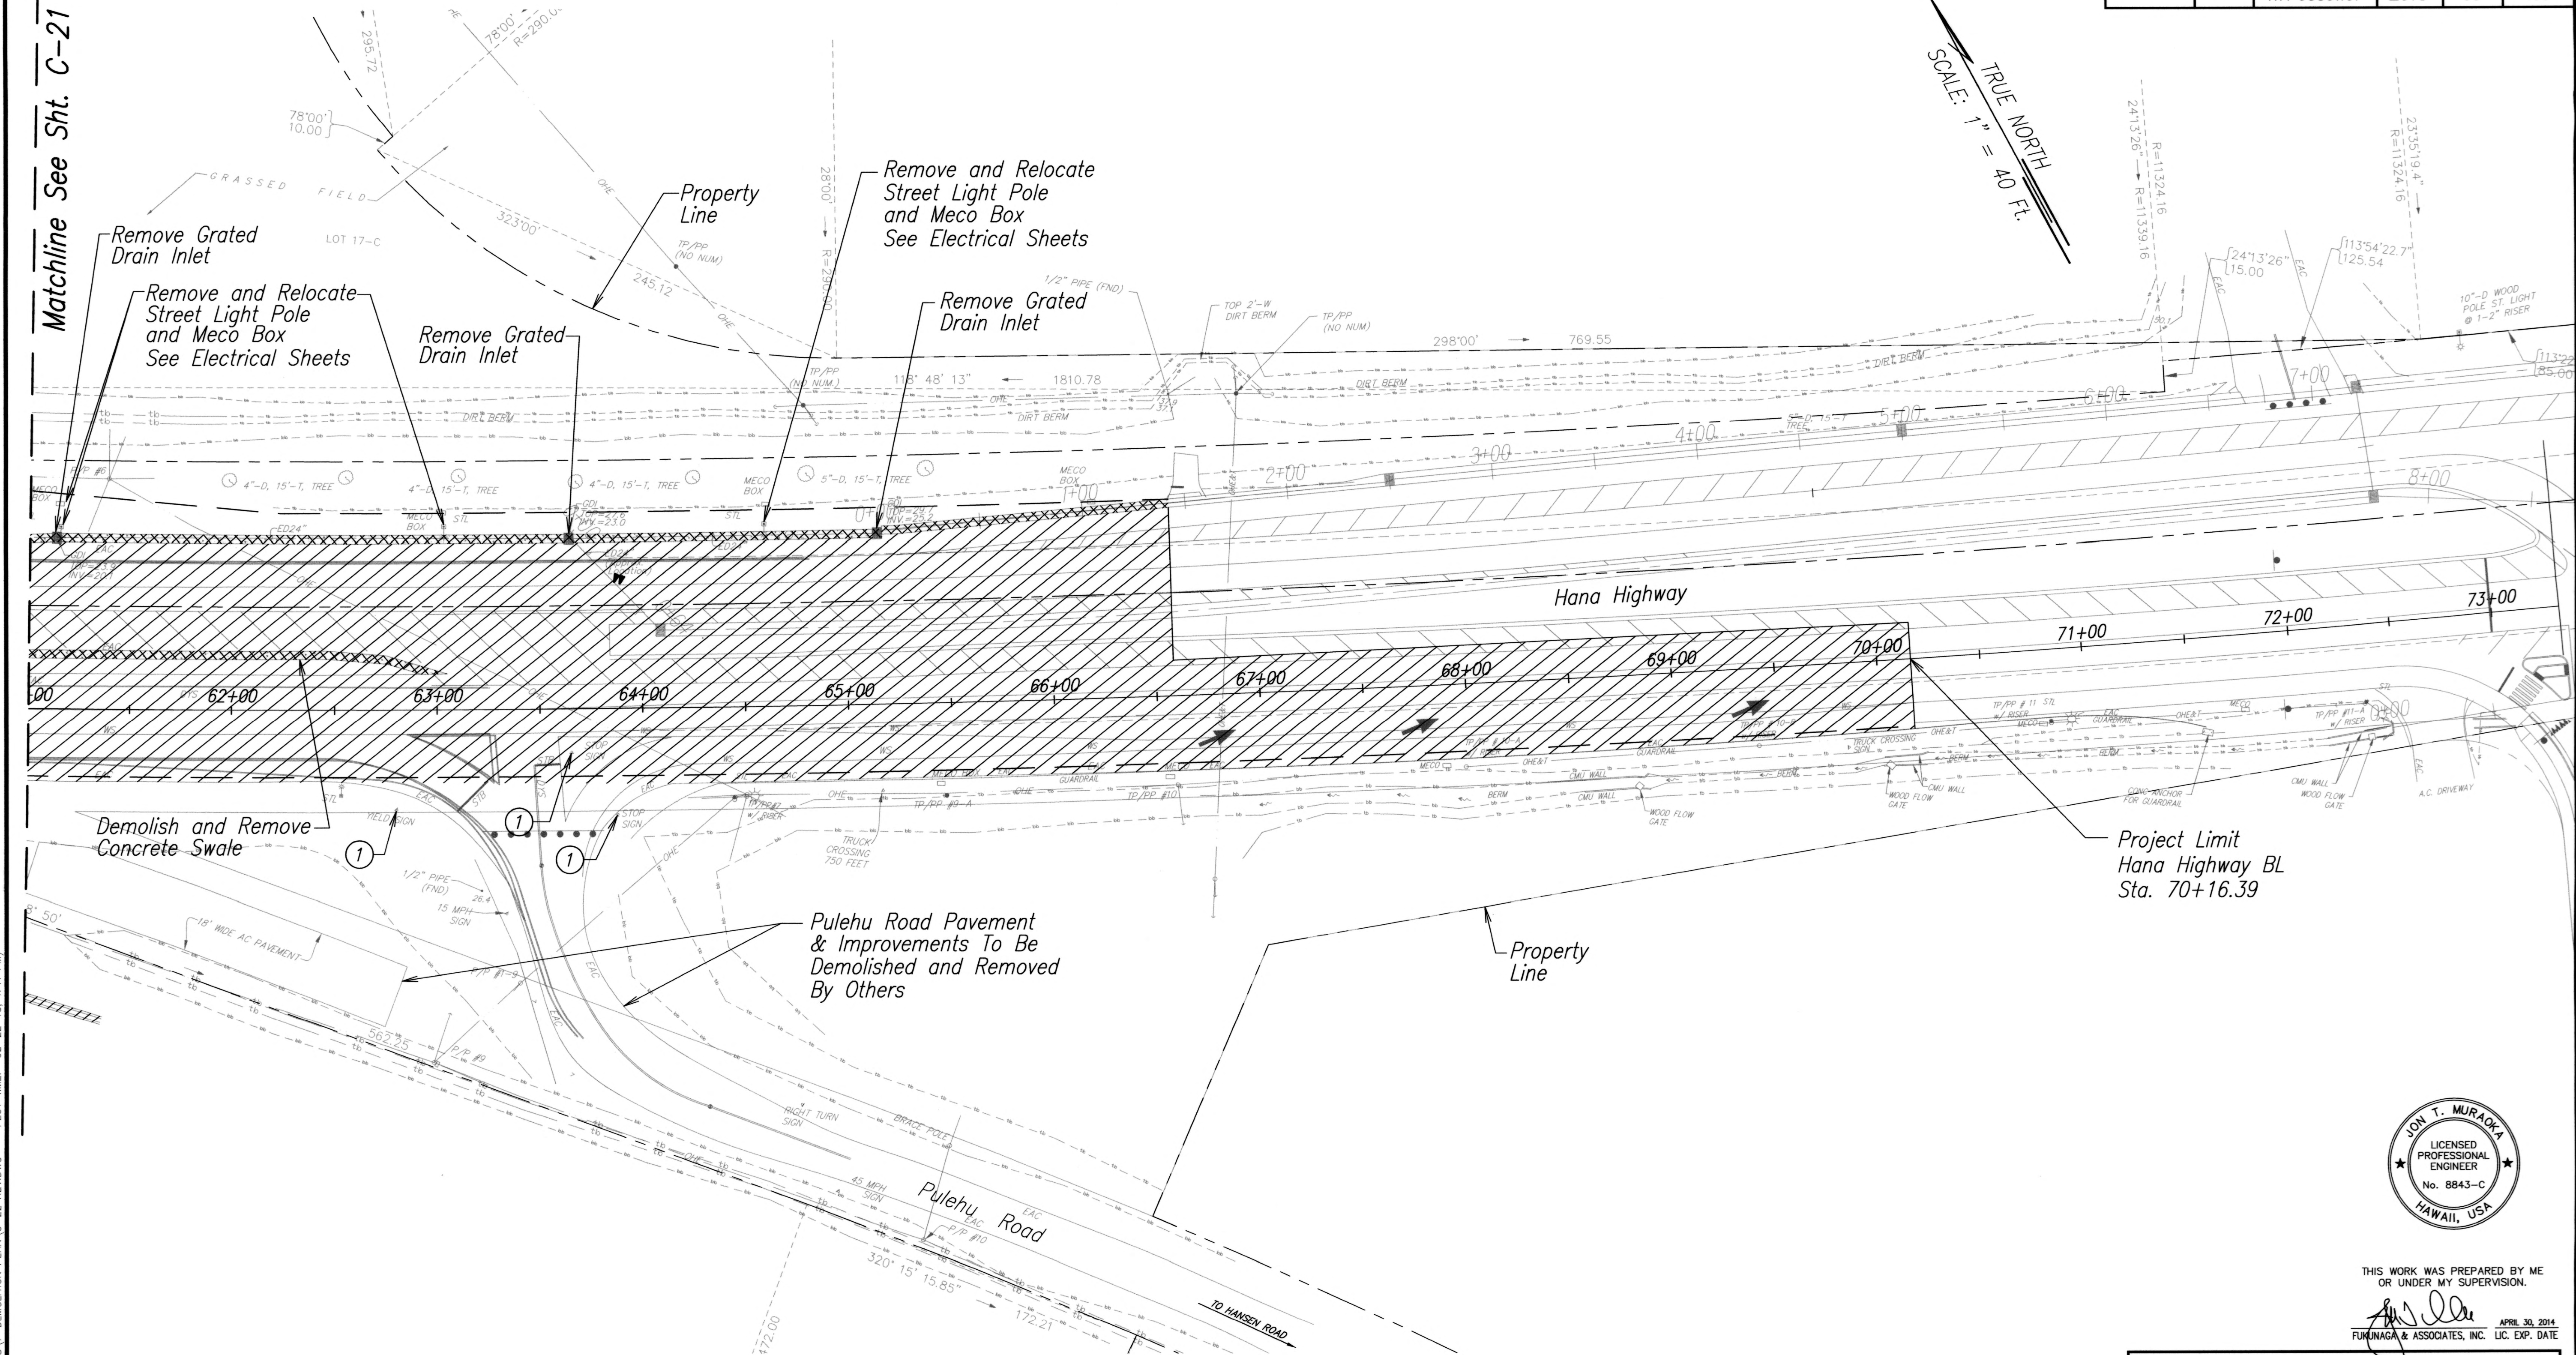

Legend

- Demolish and Remove Existing A.C. Pavement
- Demolish and Remove Concrete Swale
- Property Line
- Remove Sign



THIS WORK WAS PREPARED BY ME OR UNDER MY SUPERVISION.
[Signature]
FUKUNAGA & ASSOCIATES, INC. L.C. EXP. DATE APRIL 30, 2014

STATE OF HAWAII
DEPARTMENT OF TRANSPORTATION
HIGHWAYS DIVISION

DEMOLITION PLAN

**KAHULUI AIRPORT
ACCESS ROAD, PHASE I**
Federal Aid Project No. NH-0380(10)
Scale: As Shown Date: February 2013

SHEET No. C-22 OF 93 SHEETS