


FED. ROAD DIST. NO.	STATE	FED. AID PROJ. NO.	FISCAL YEAR	SHEET NO.	TOTAL SHEETS
HAWAII	HAW.	NH-0380(10)	2013	ADD. 85	166

DRAWING NAME: C:\PROJECTS\KAHULUI-2011\AS-BUILT OCTOBER 2017\CIVIL\G-72.DWG PLOT TIME: 10-25-18, 5:01 PM


ORIGINAL PLAN	SURVEY PLOTTED BY	DATE
NOTE BOOK	DRAWN BY	
QUANTITIES BY	DESIGNED BY	
CHECKED BY	CHECKED BY	

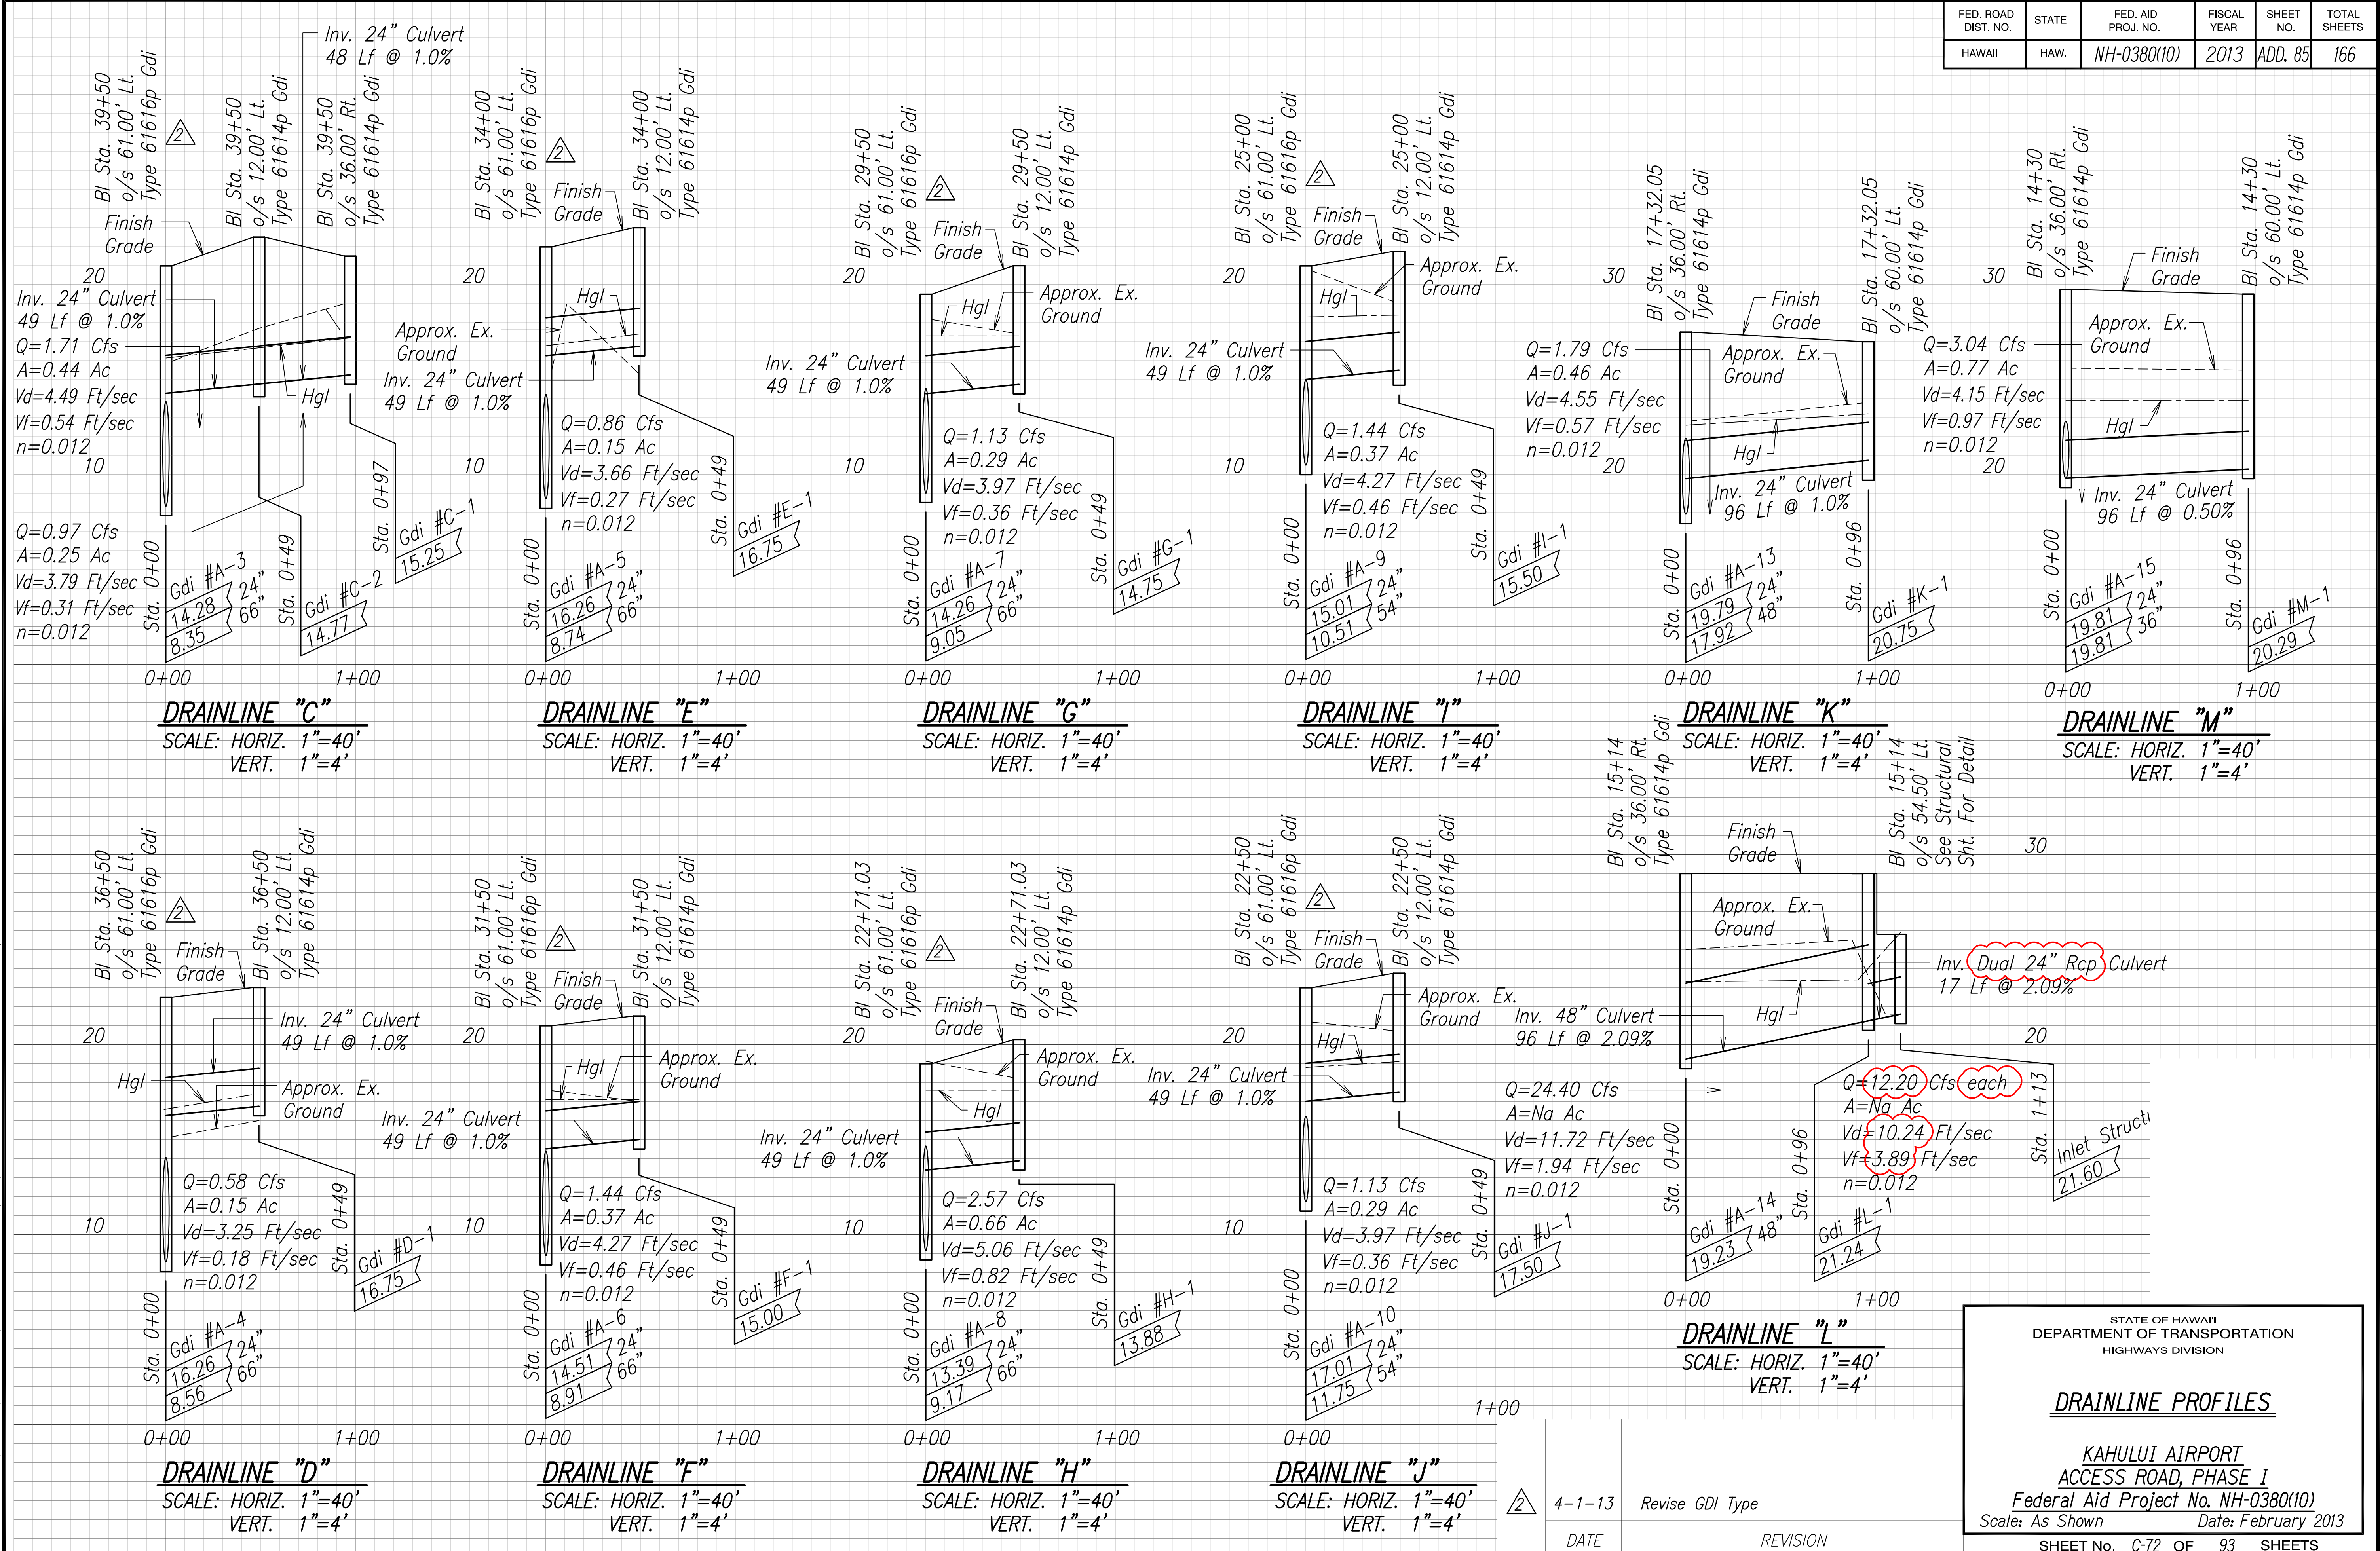


"AS-BUILT"

ADD. 85


FED. ROAD DIST. NO.	STATE	FED. AID PROJ. NO.	FISCAL YEAR	SHEET NO.	TOTAL SHEETS
HAWAII	HAW.	NH-0380(10)	2013	ADD. 86	166

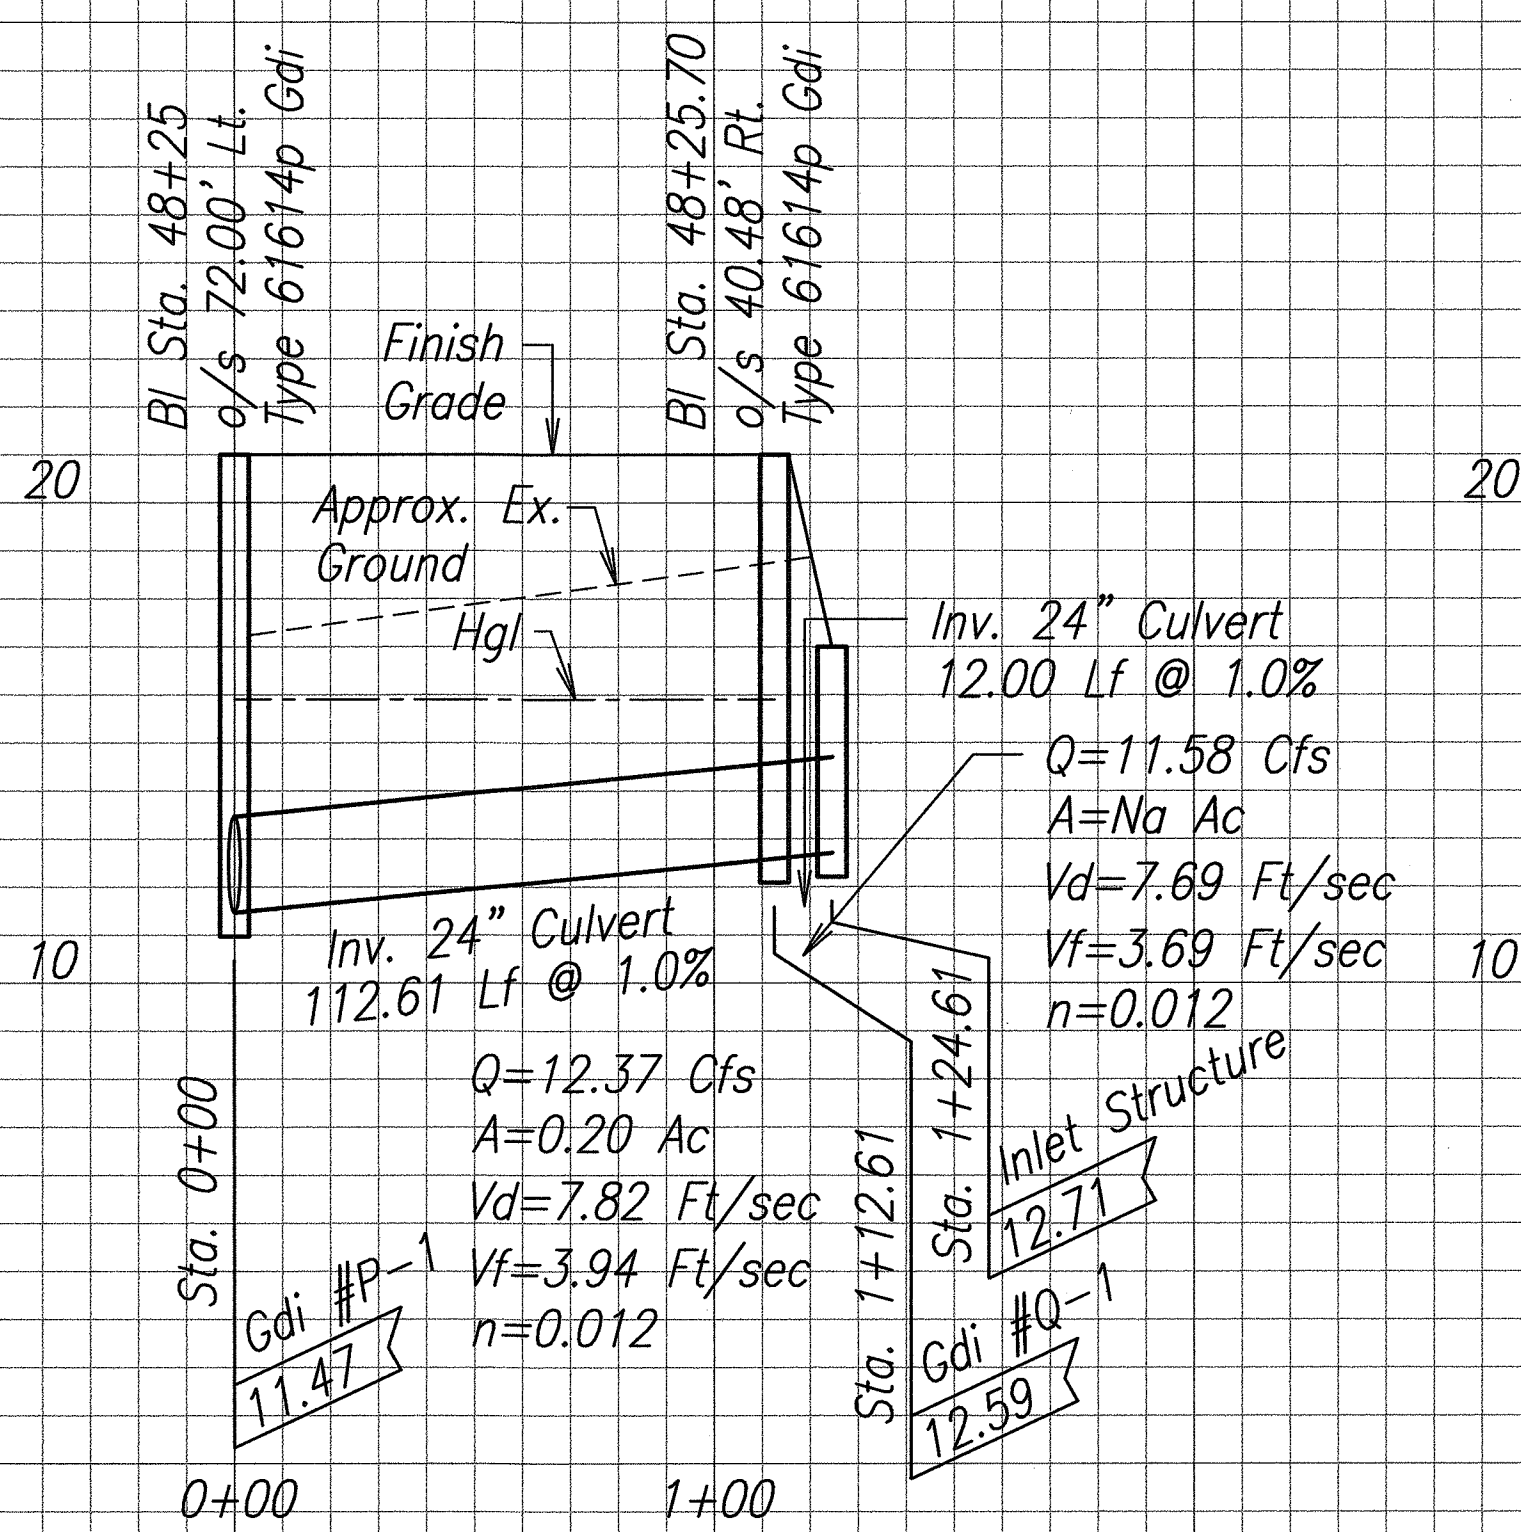


DRAINLINE "Q"
SCALE: HORIZ. 1"=40'
VERT. 1"=4'

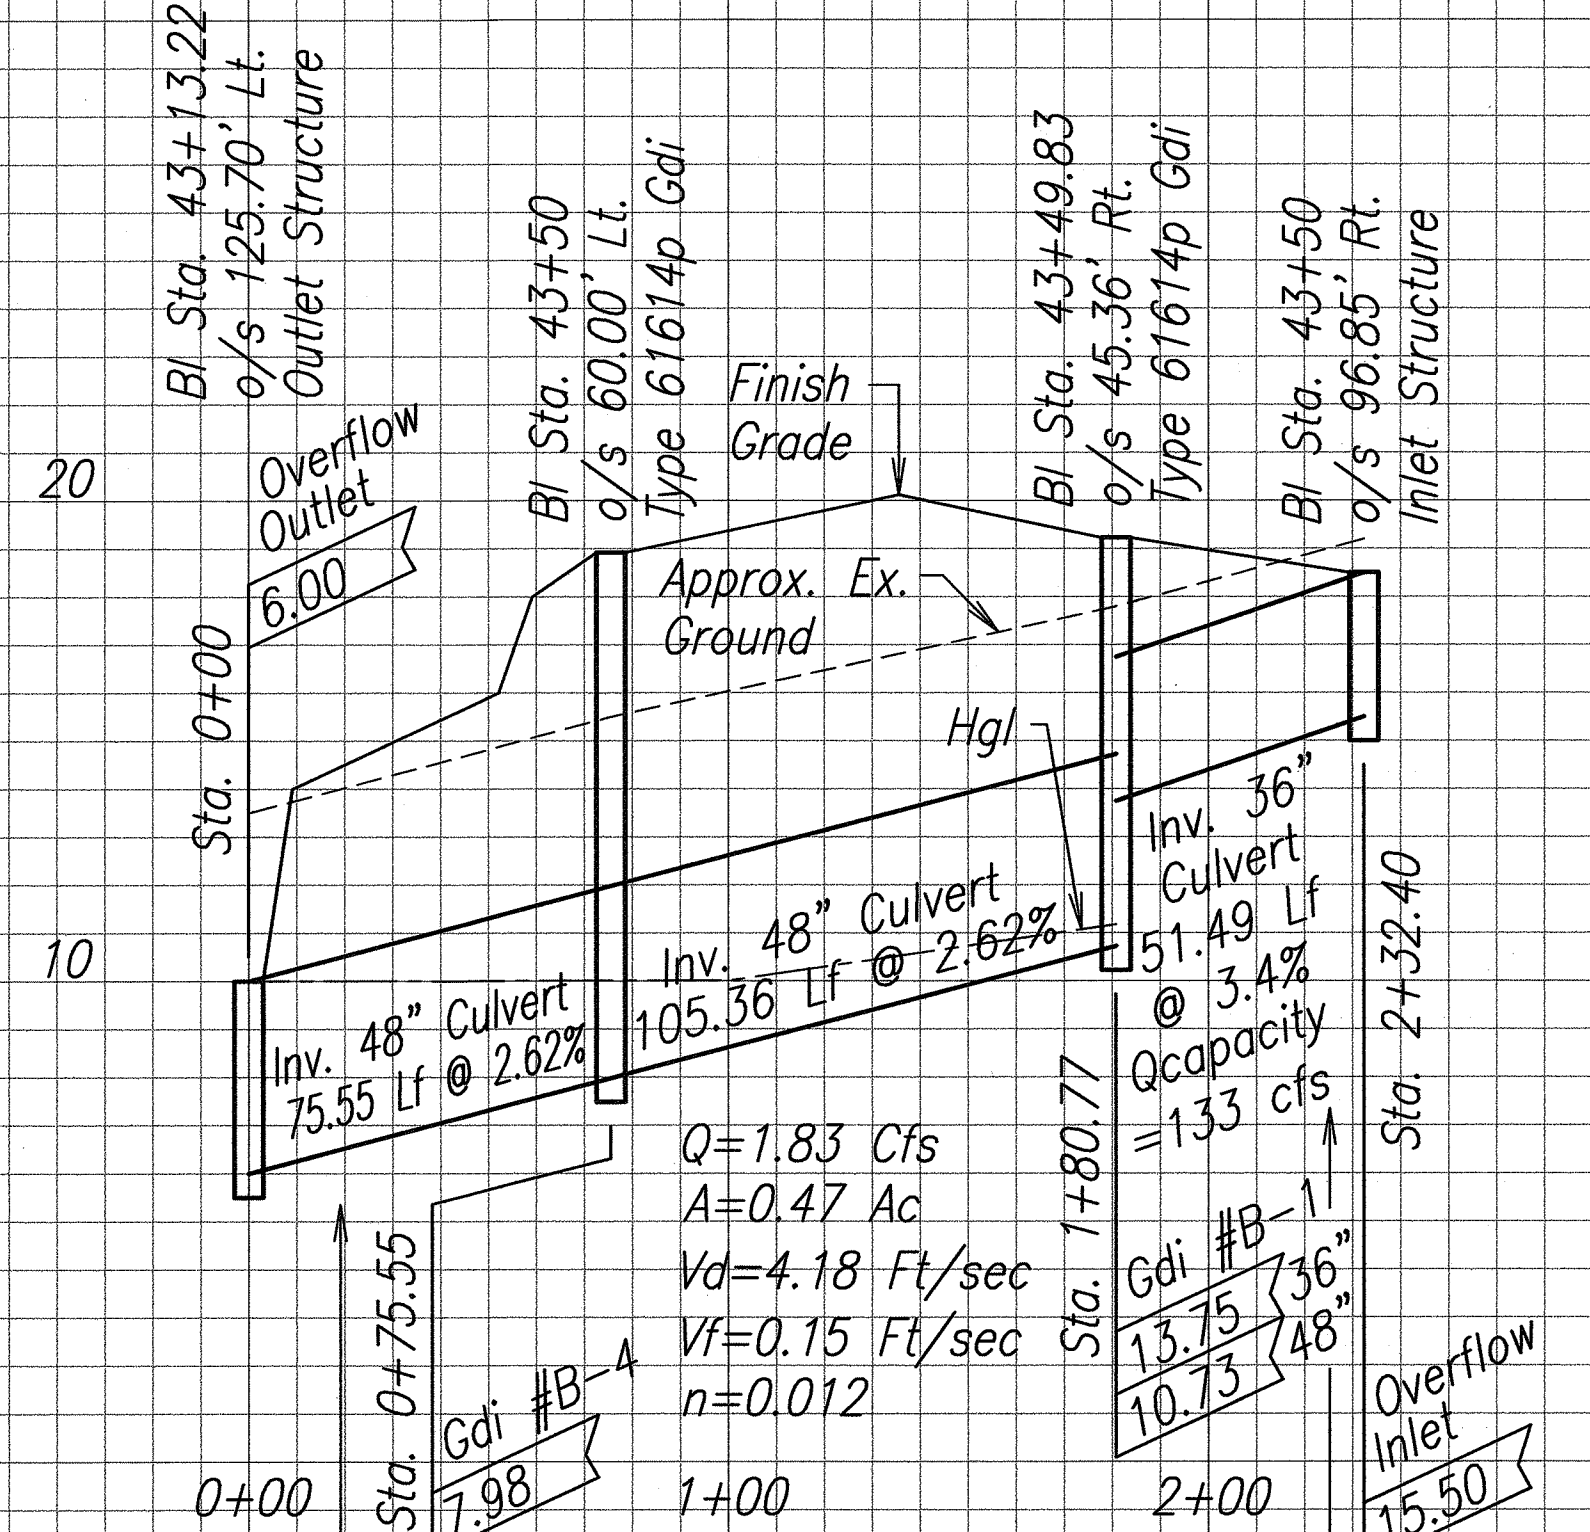


DETENTION BASIN OVERFLOW
SCALE: HORIZ. 1"=40'
VERT. 1"=4'

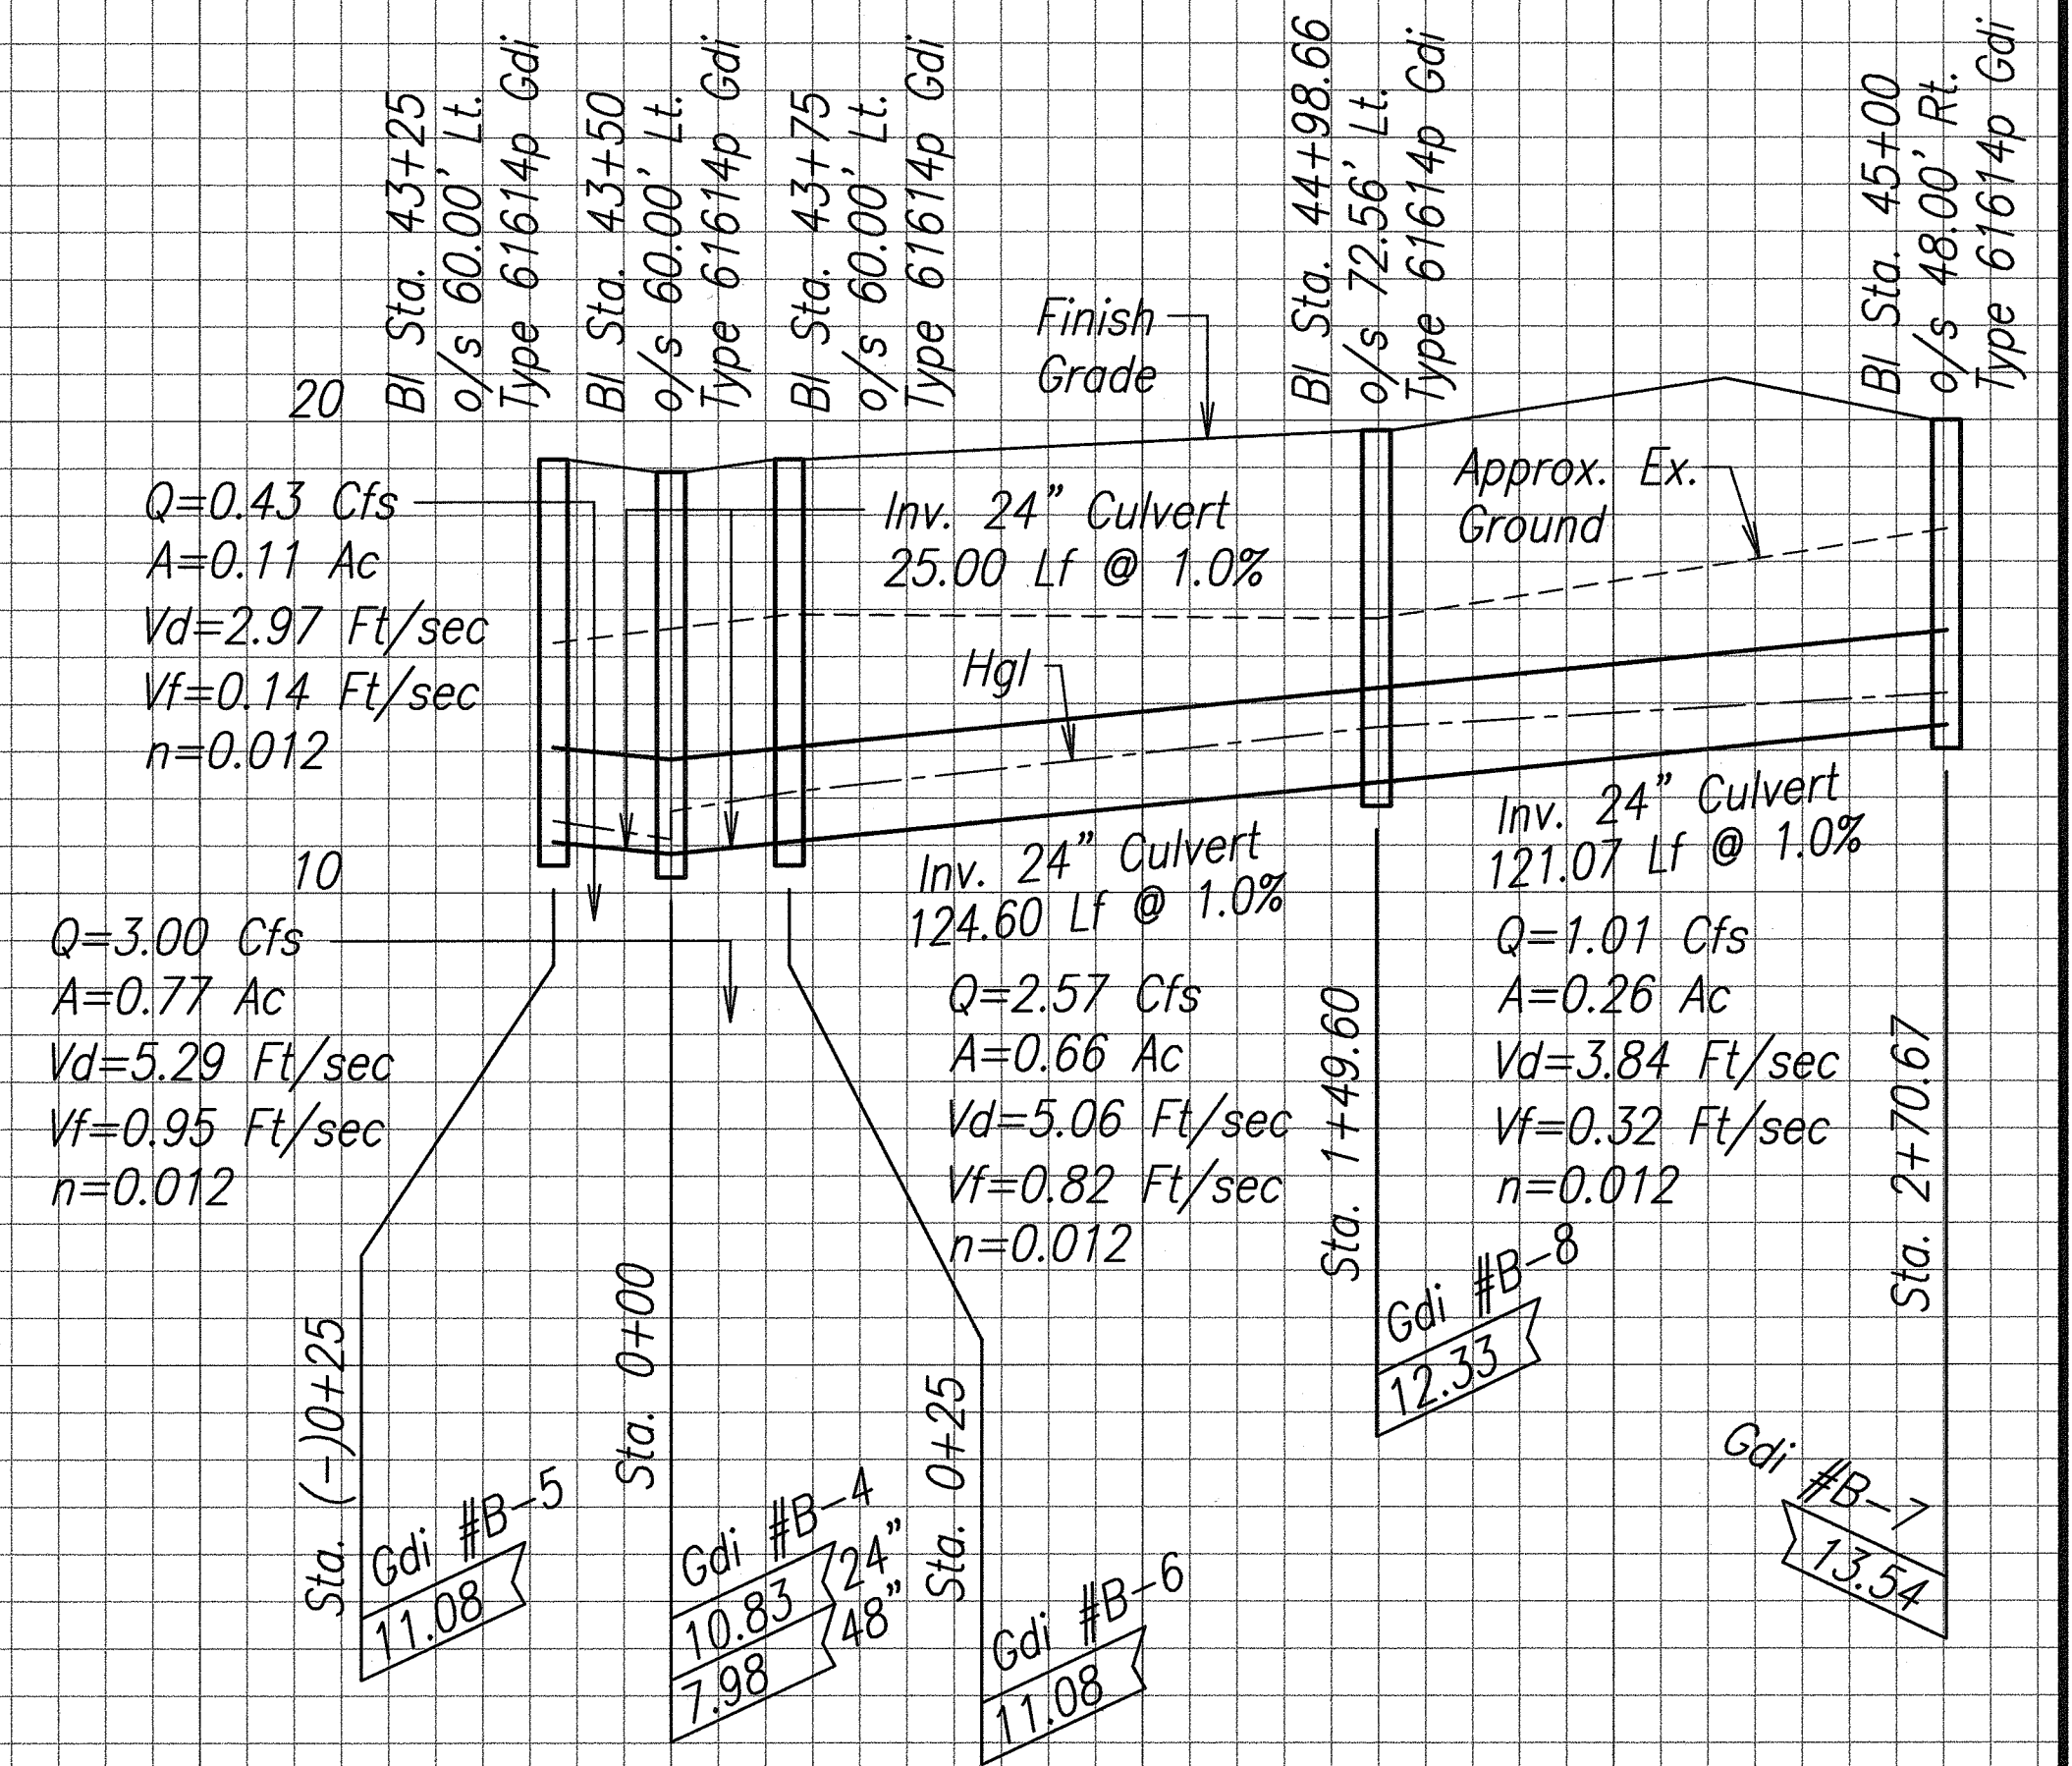

DRAINLINE "#B-5 - #B-7"
SCALE: HORIZ. 1"=40'
VERT. 1"=4'

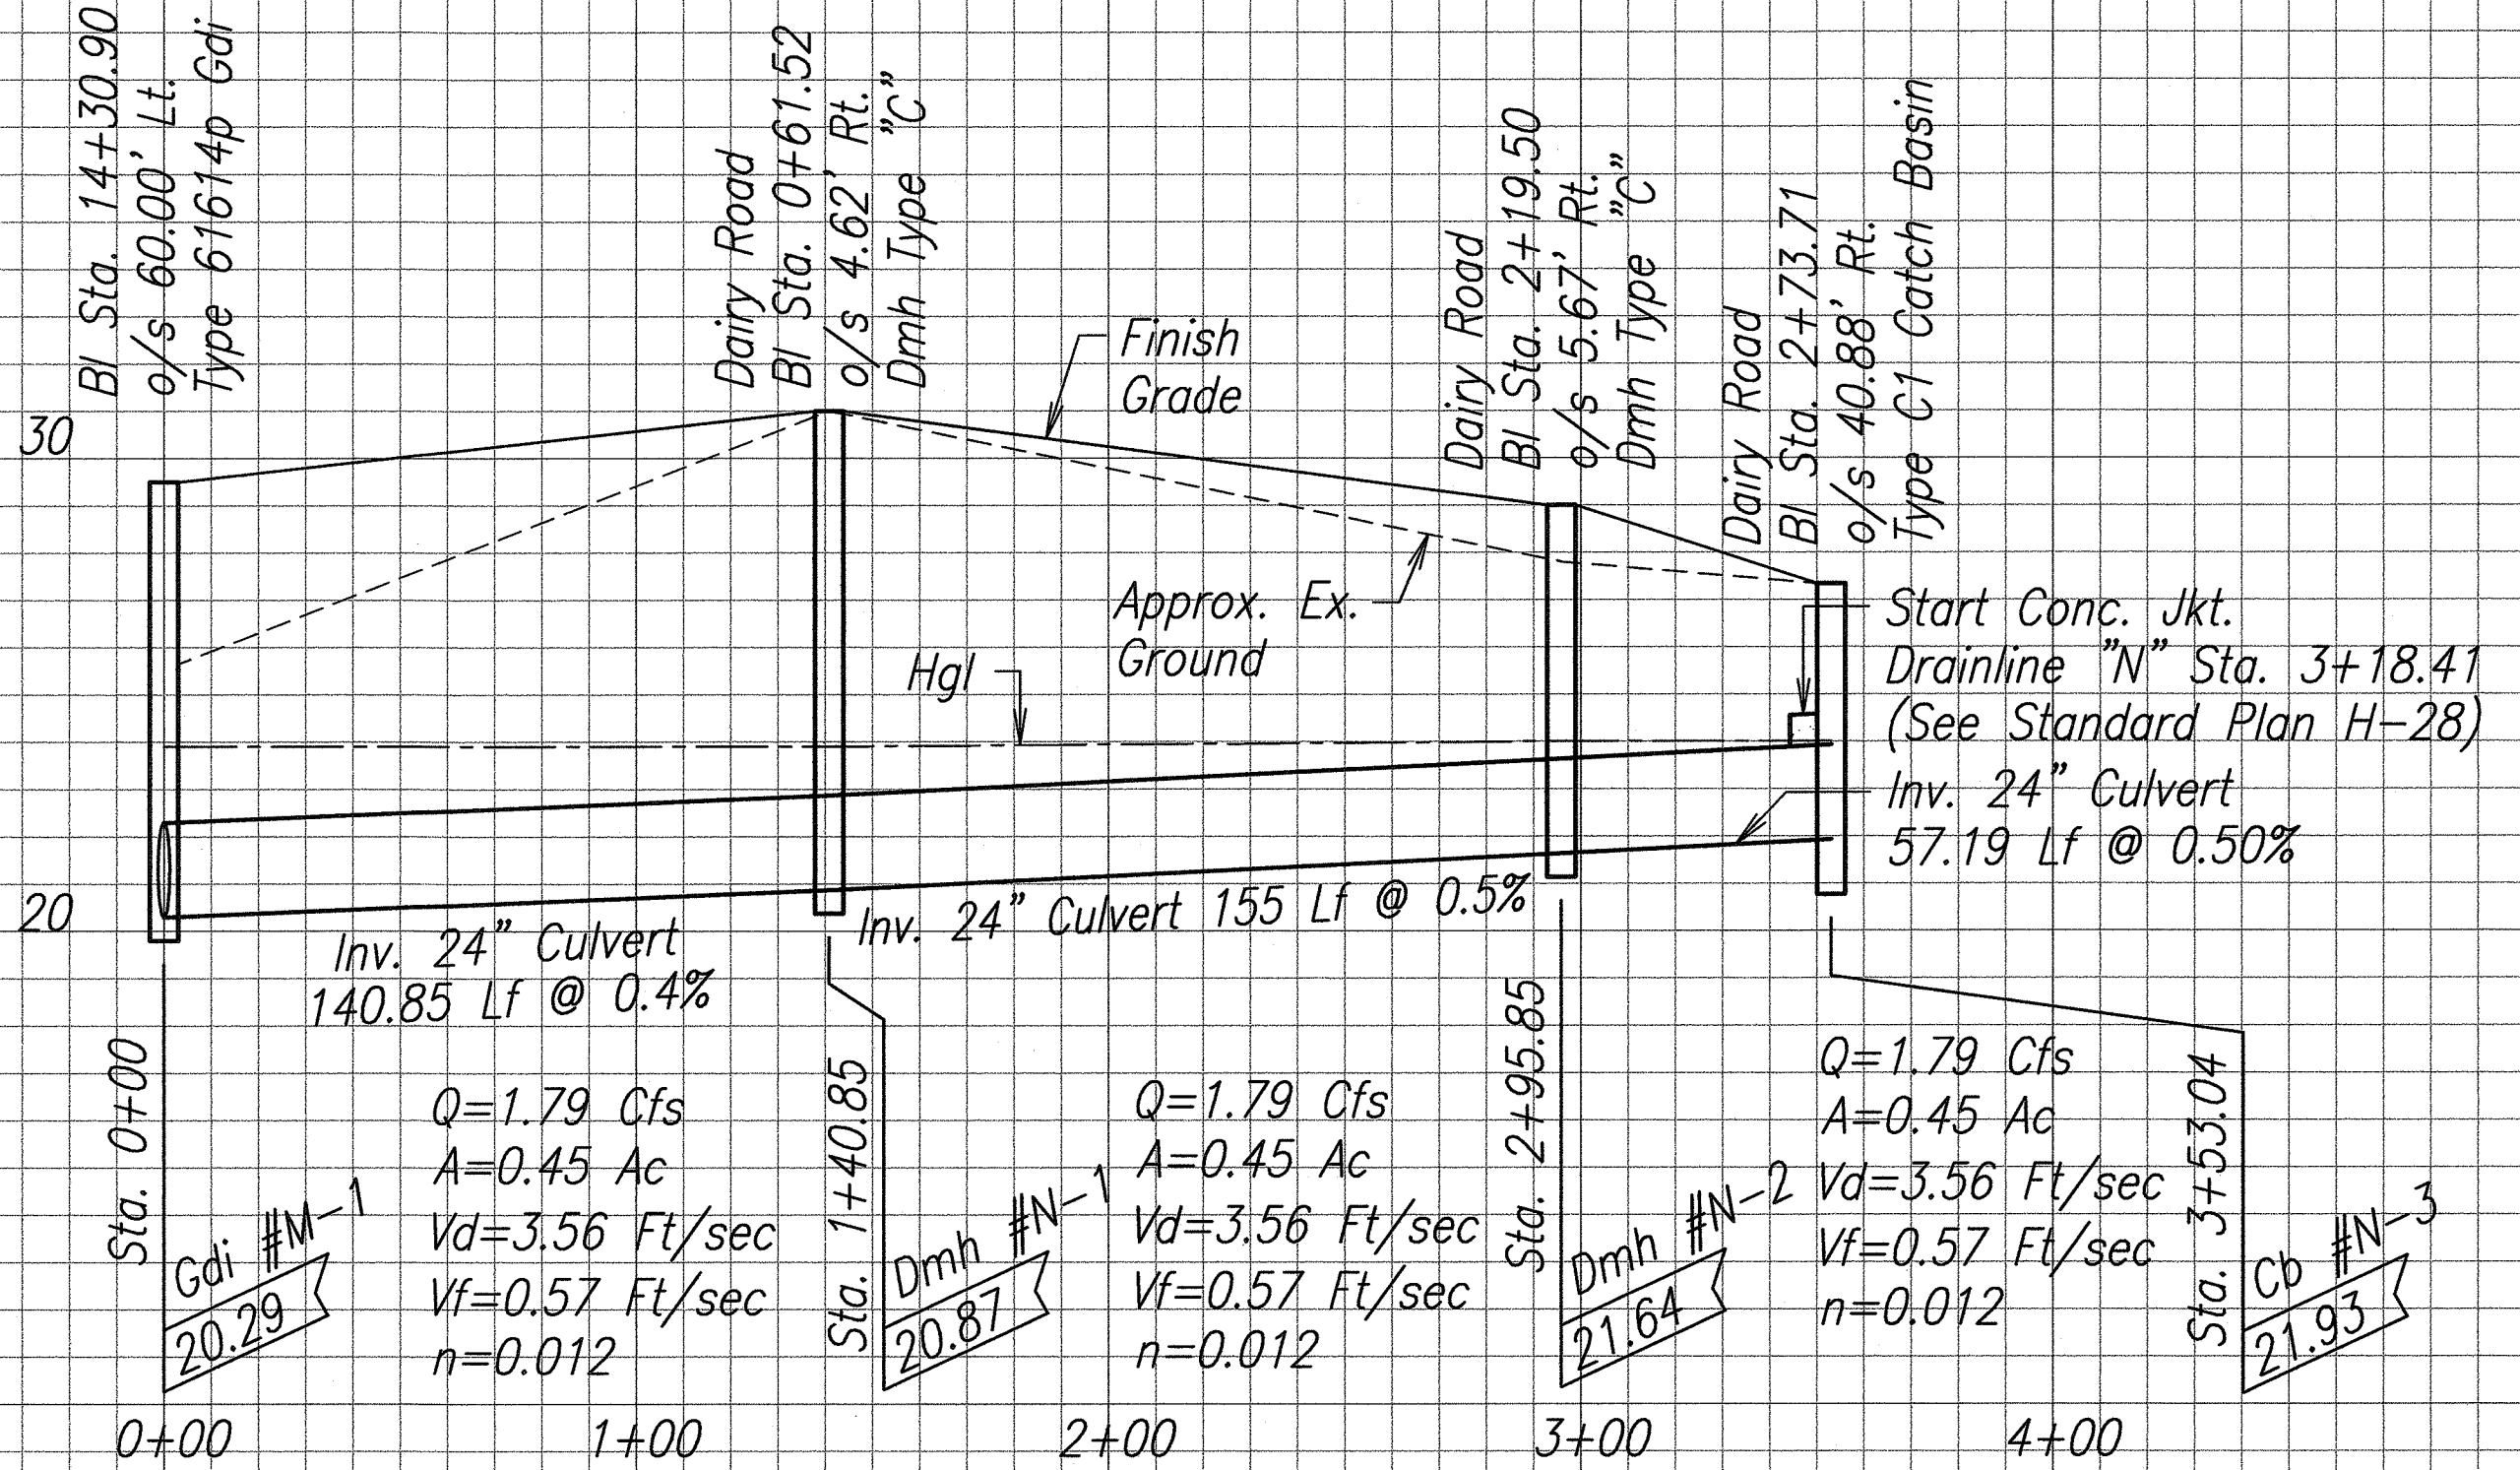

DRAINLINE "N"
SCALE: HORIZ. 1"=40'
VERT. 1"=4'

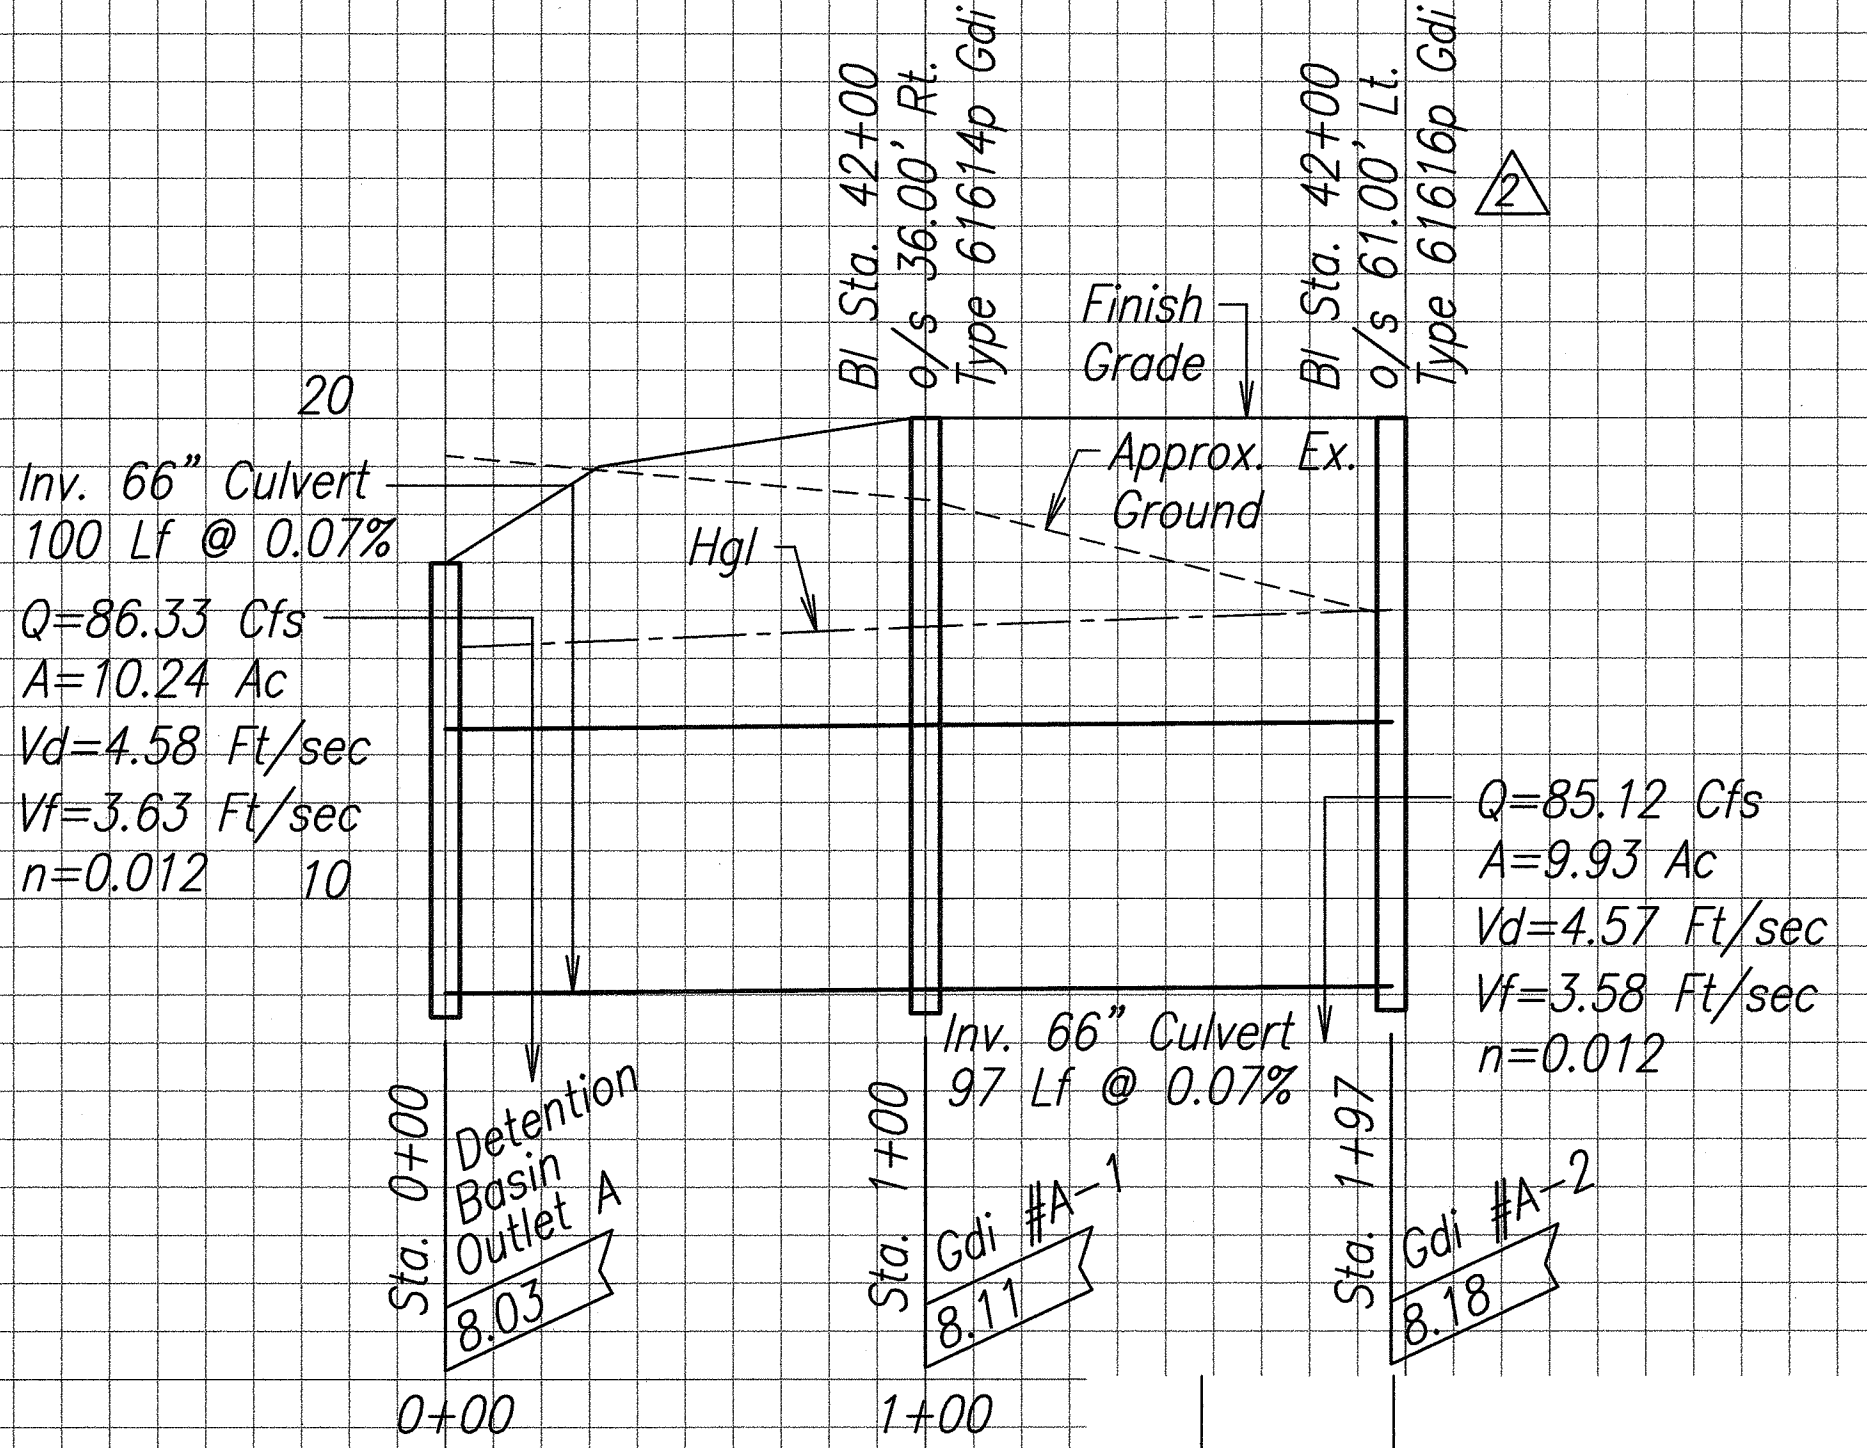

DRAINLINE "A1"
SCALE: HORIZ. 1"=40'
VERT. 1"=4'

ORIGINAL PLAN	DATE
DESIGNED BY	
TRACED BY	
NOTED BY	
QUANTITIES BY	
CHECKED BY	
No.	

DRAWING NAME: C:\PROJECTS\KAHULUI-2011\PLANS\20-DRAINLINE PROFILES\0-73.DWG PLOT TIME: 04-08-13, 11:57 AM



THIS WORK WAS PREPARED BY ME OR UNDER MY SUPERVISION.
APR 30, 2014
FURNAGA & ASSOCIATES, INC. LIC. EXP. DATE

STATE OF HAWAII
DEPARTMENT OF TRANSPORTATION
HIGHWAYS DIVISION

DRAINLINE PROFILES





KAHULUI AIRPORT
ACCESS ROAD, PHASE I
Federal Aid Project No. NH-0380(10)
Scale: As Shown Date: February 2013

SHEET No. C-73 OF 93 SHEETS

FED. ROAD DIST. NO.	STATE	FED. AID PROJ. NO.	FISCAL YEAR	SHEET NO.	TOTAL SHEETS
HAWAII	HAW.	NH-0380(10)	2013	87	166



DRAWING NAME: C:\PROJECTS\KAHULUI-2011\AS-BUILT OCTOBER 2017\CIVIL\G-74.DWG PLOT TIME: 10-25-18, 5:03 PM

ORIGINAL PLAN	SURVEY PLOTTED BY	DATE
NOTE BOOK	DRAWN BY	
QUANTITIES BY	DESIGNED BY	
CHECKED BY	CHECKED BY	
No.		

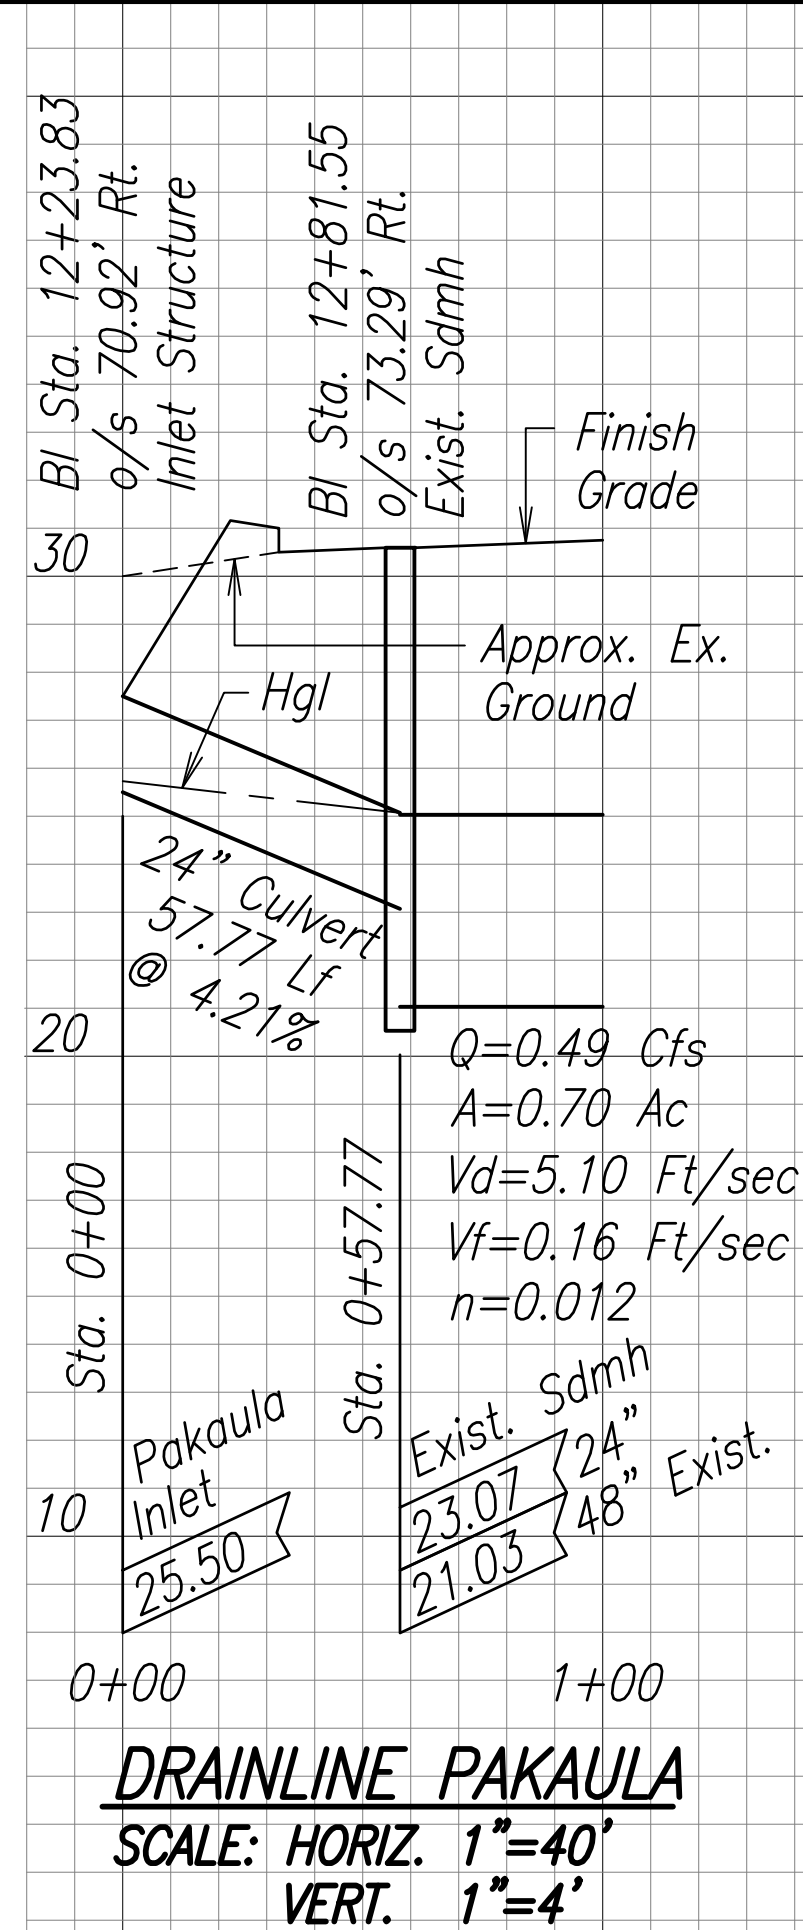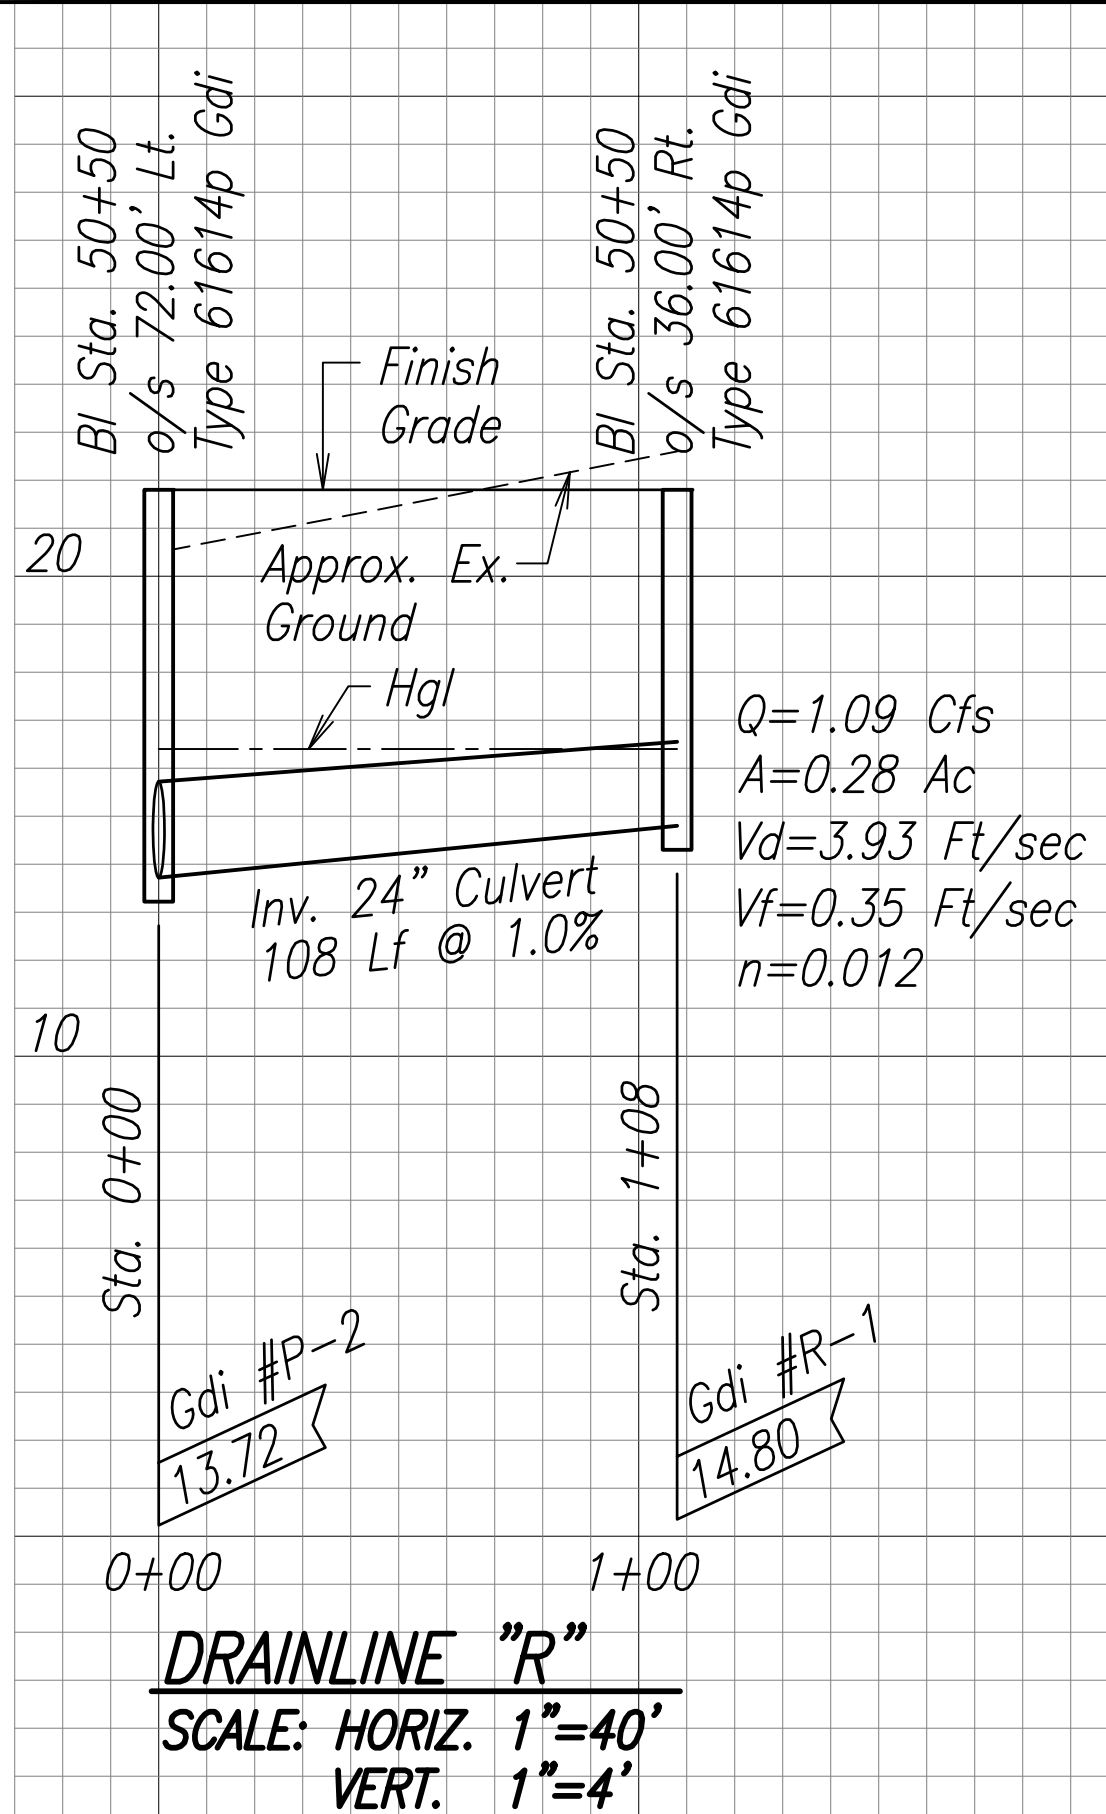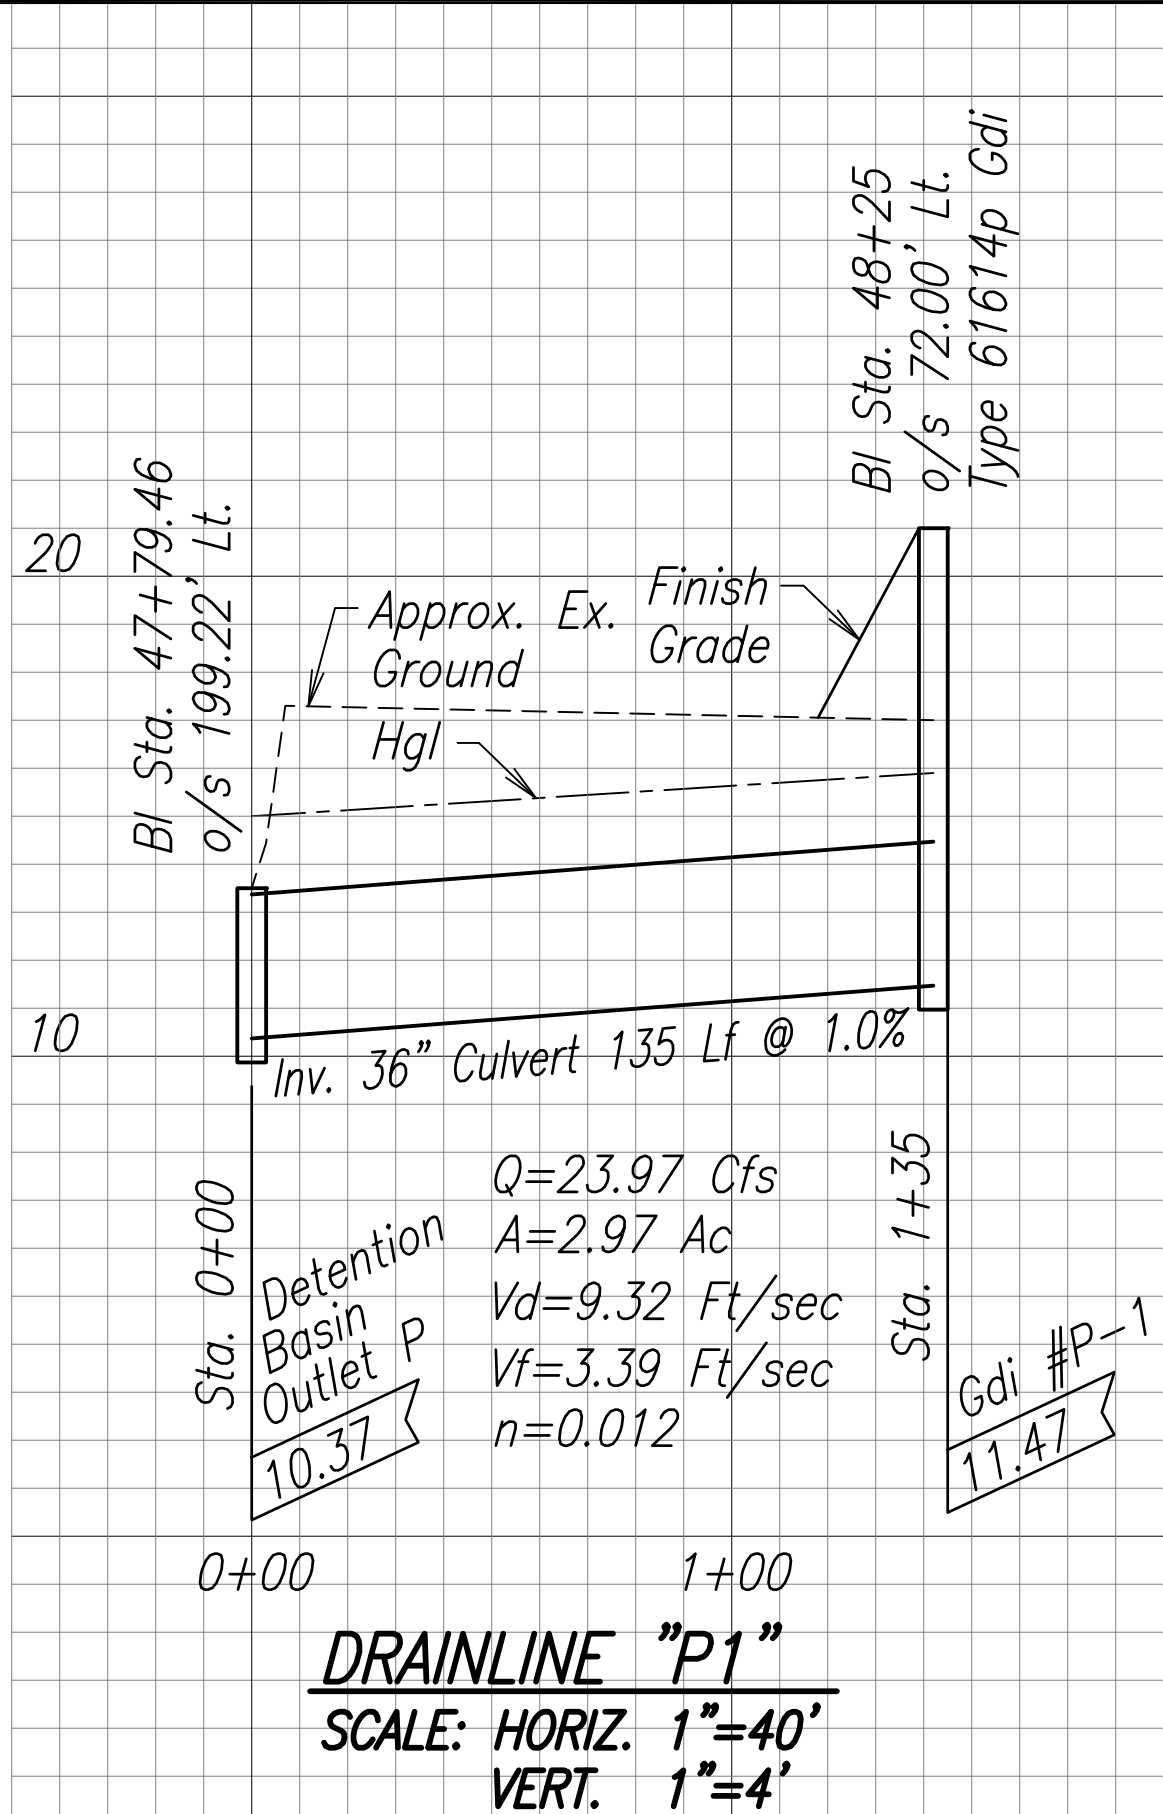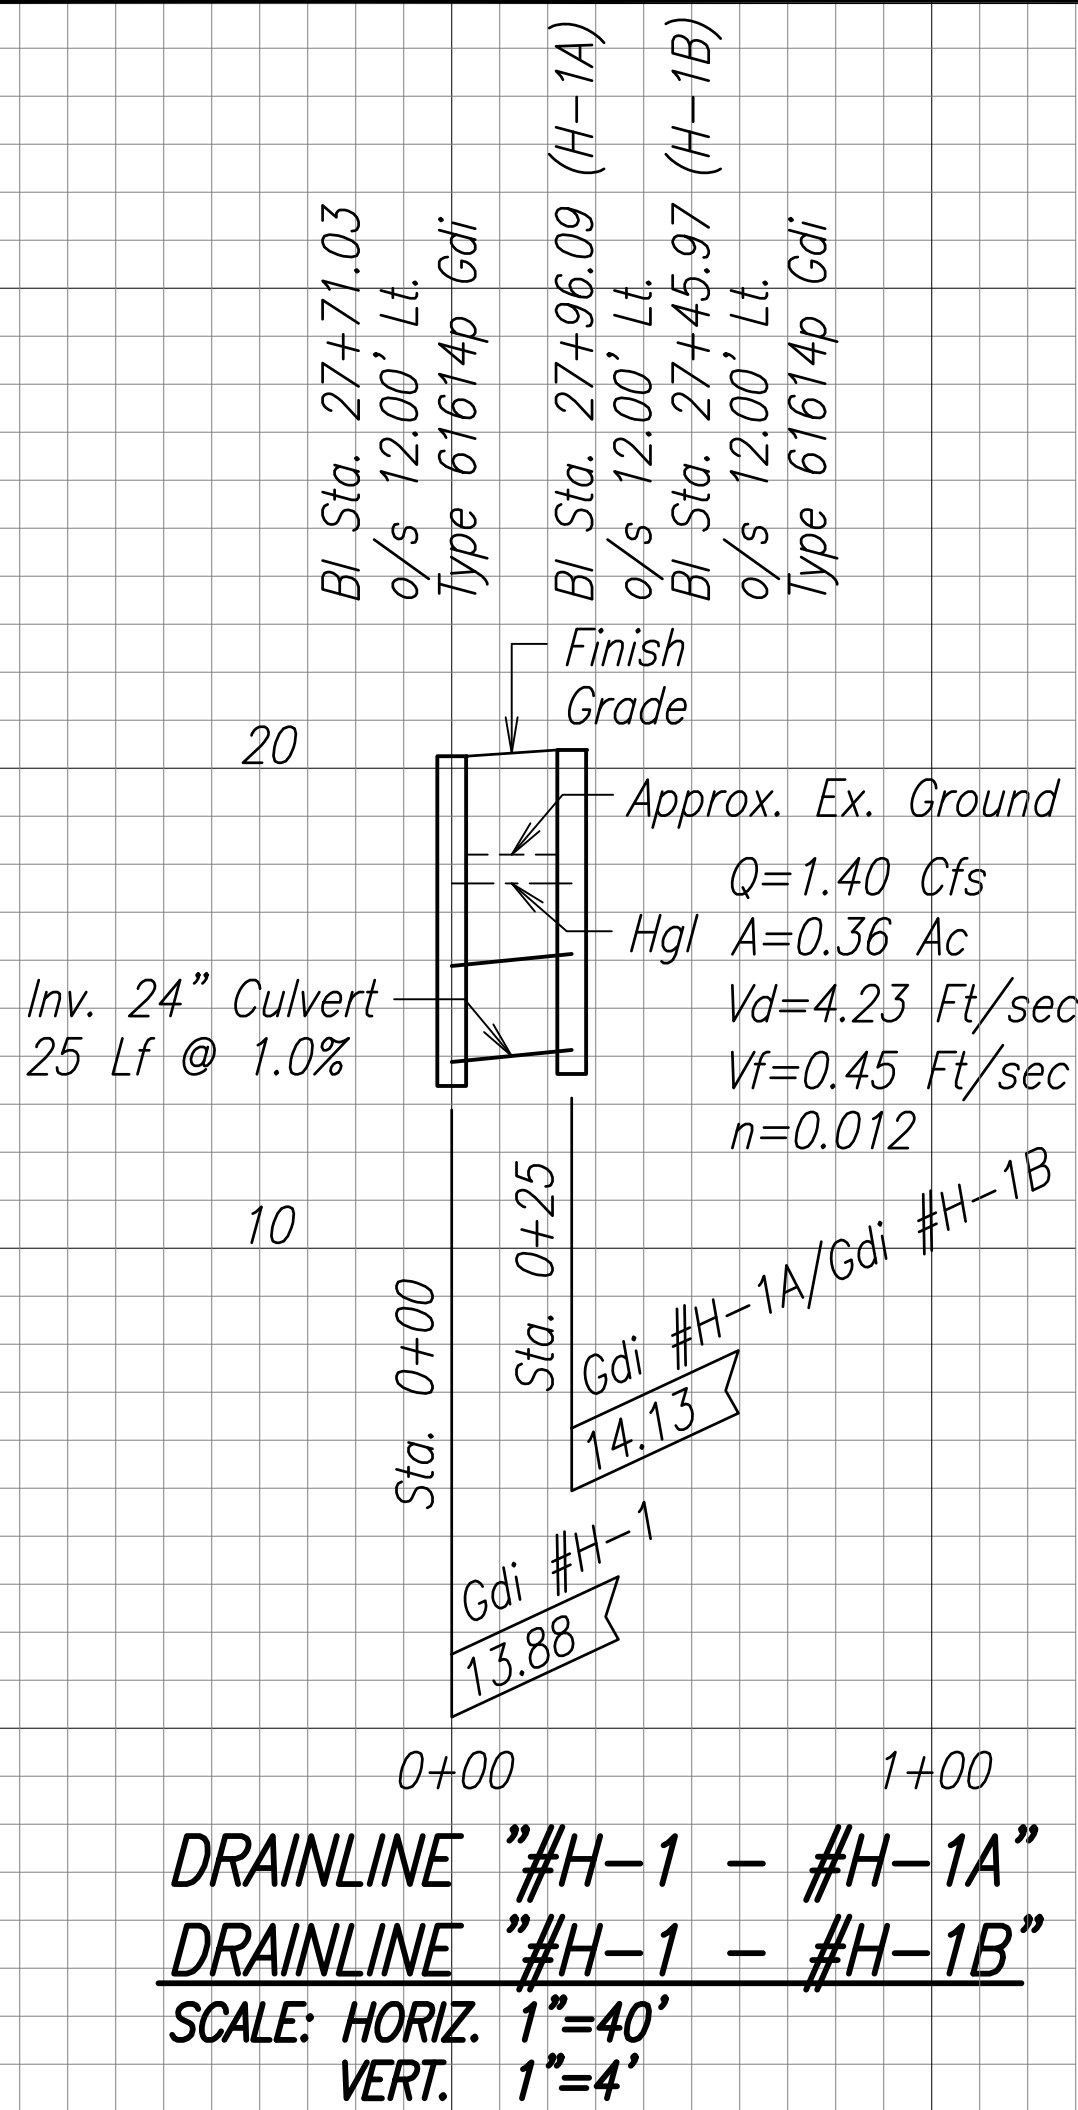

Notes:

- 6" Sewer Lateral Shall Be Pvc Sdr 26
- Smh 1 Loc. Bl Sta. 8+13.10, o/s 31.17' Rt.
- Smh 2 Loc. Bl Sta. 8+08.44, o/s 78.52' Rt.
- Connect Loc. Bl Sta. 7+34.17, o/s 99.51' Rt.
- New 6" Sewer Lateral Shall Be Inspected By Closed Circuit Television (CCTV) in Strict Accordance With Dpw CCTV Policy, Effective Date July 5, 2001. Final Acceptance of the System Shall Be Contingent Upon the Passing of All Requirements of This Policy.

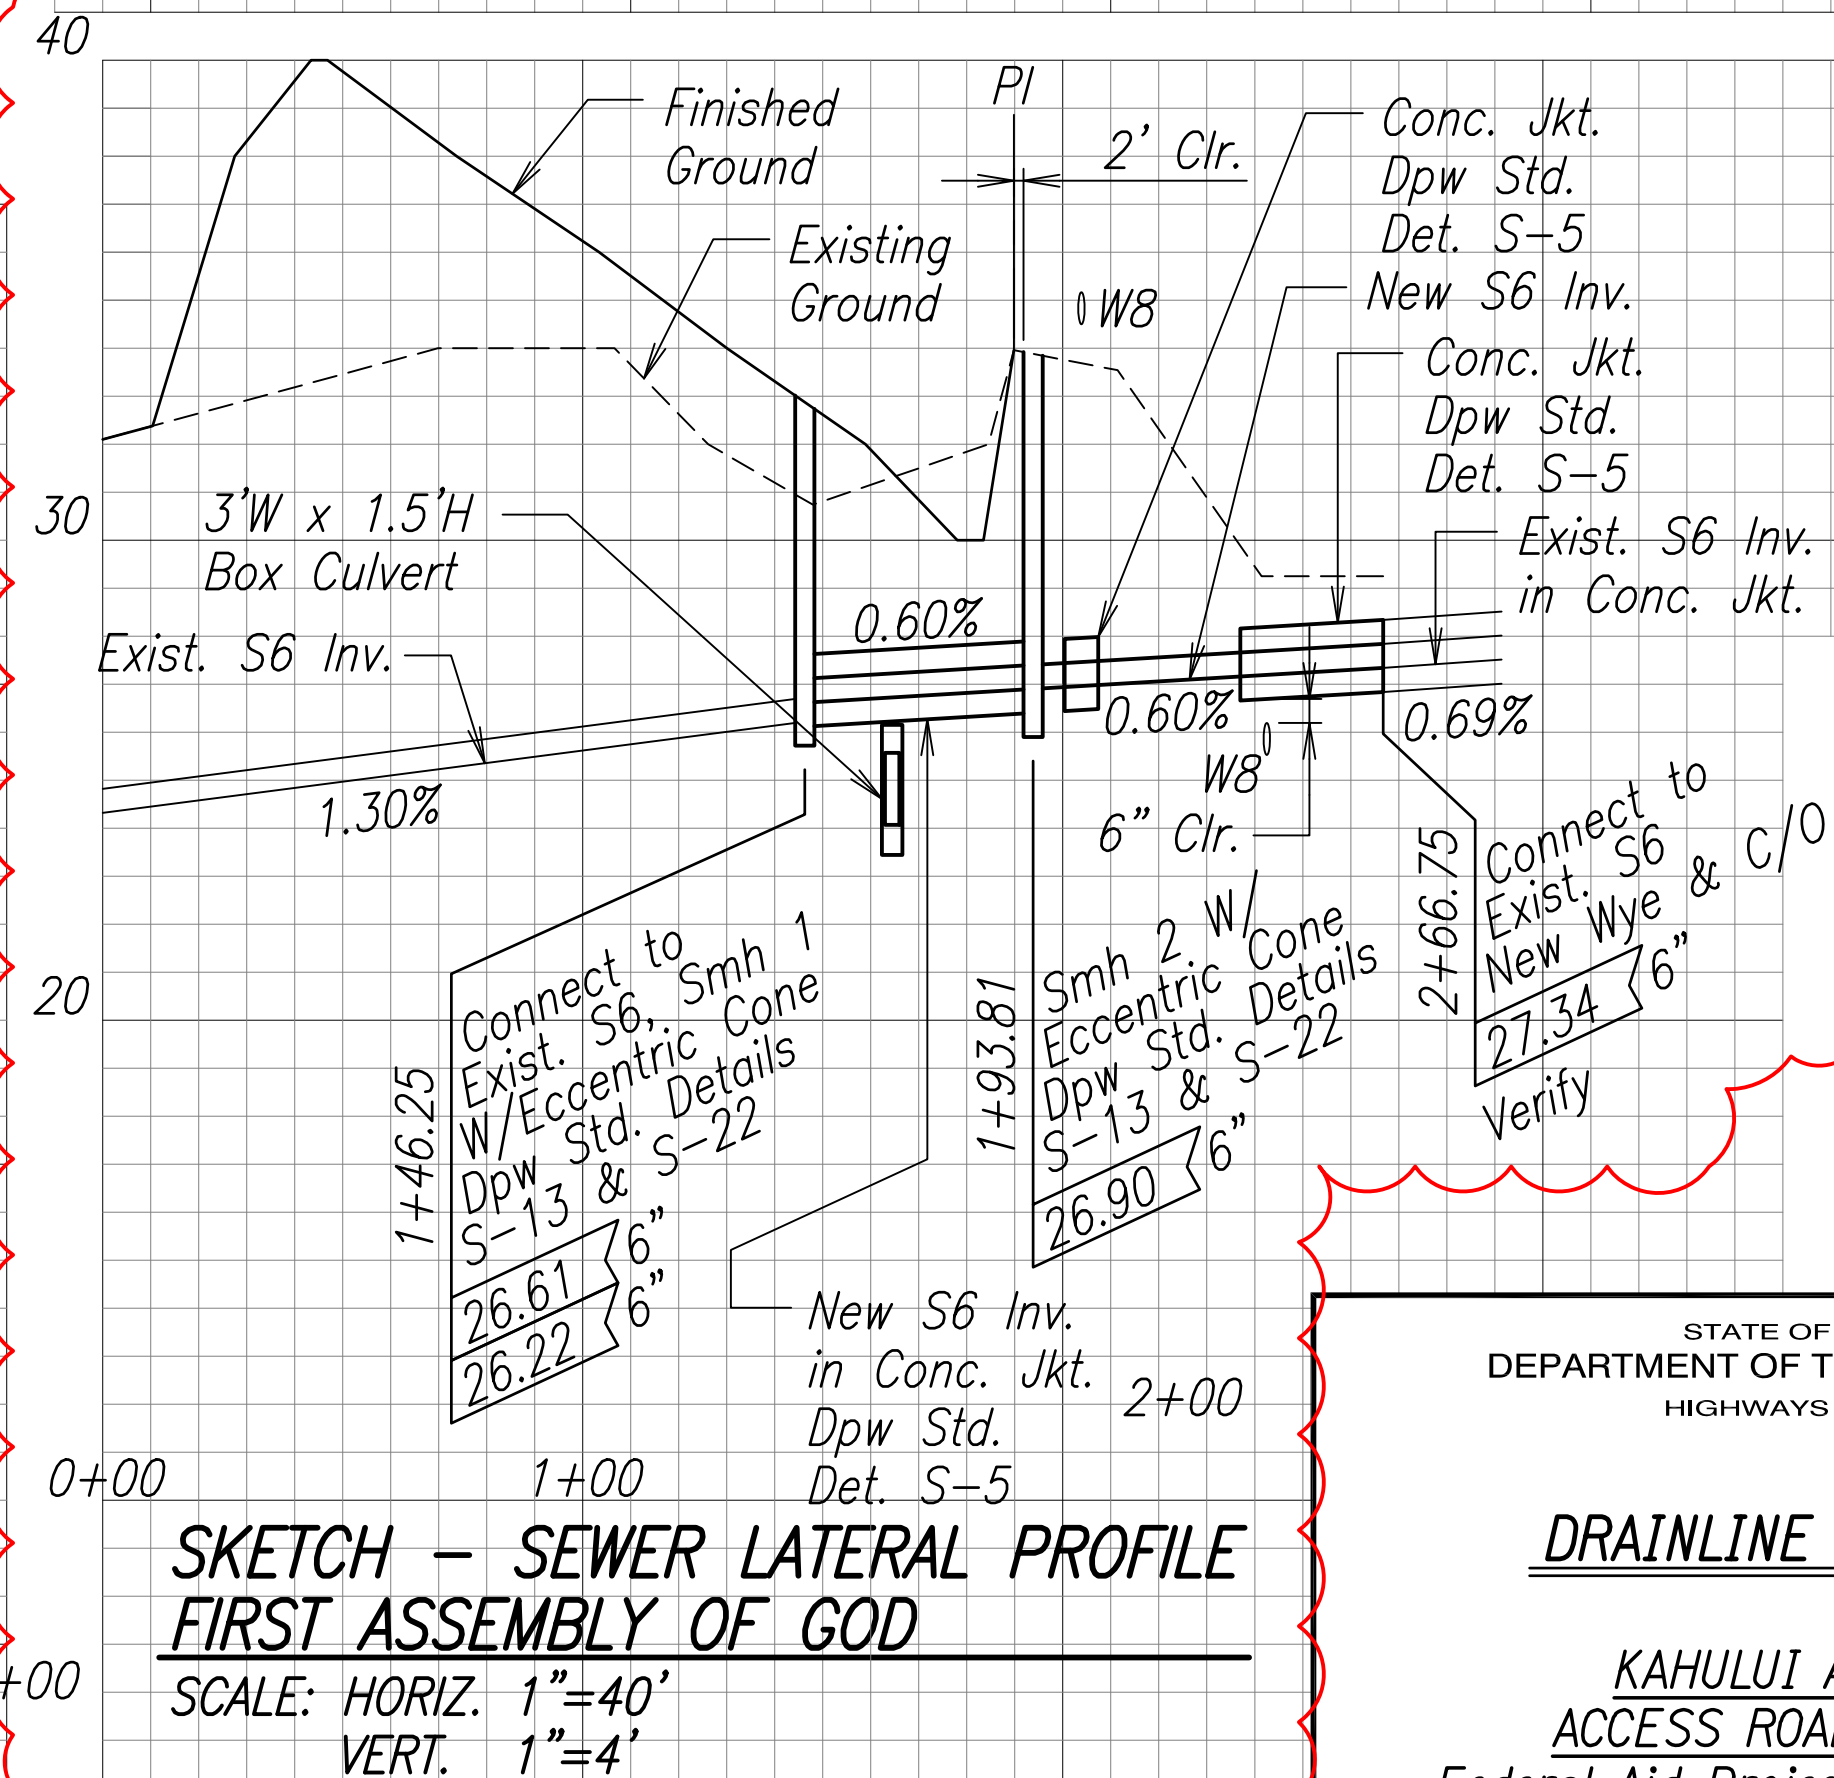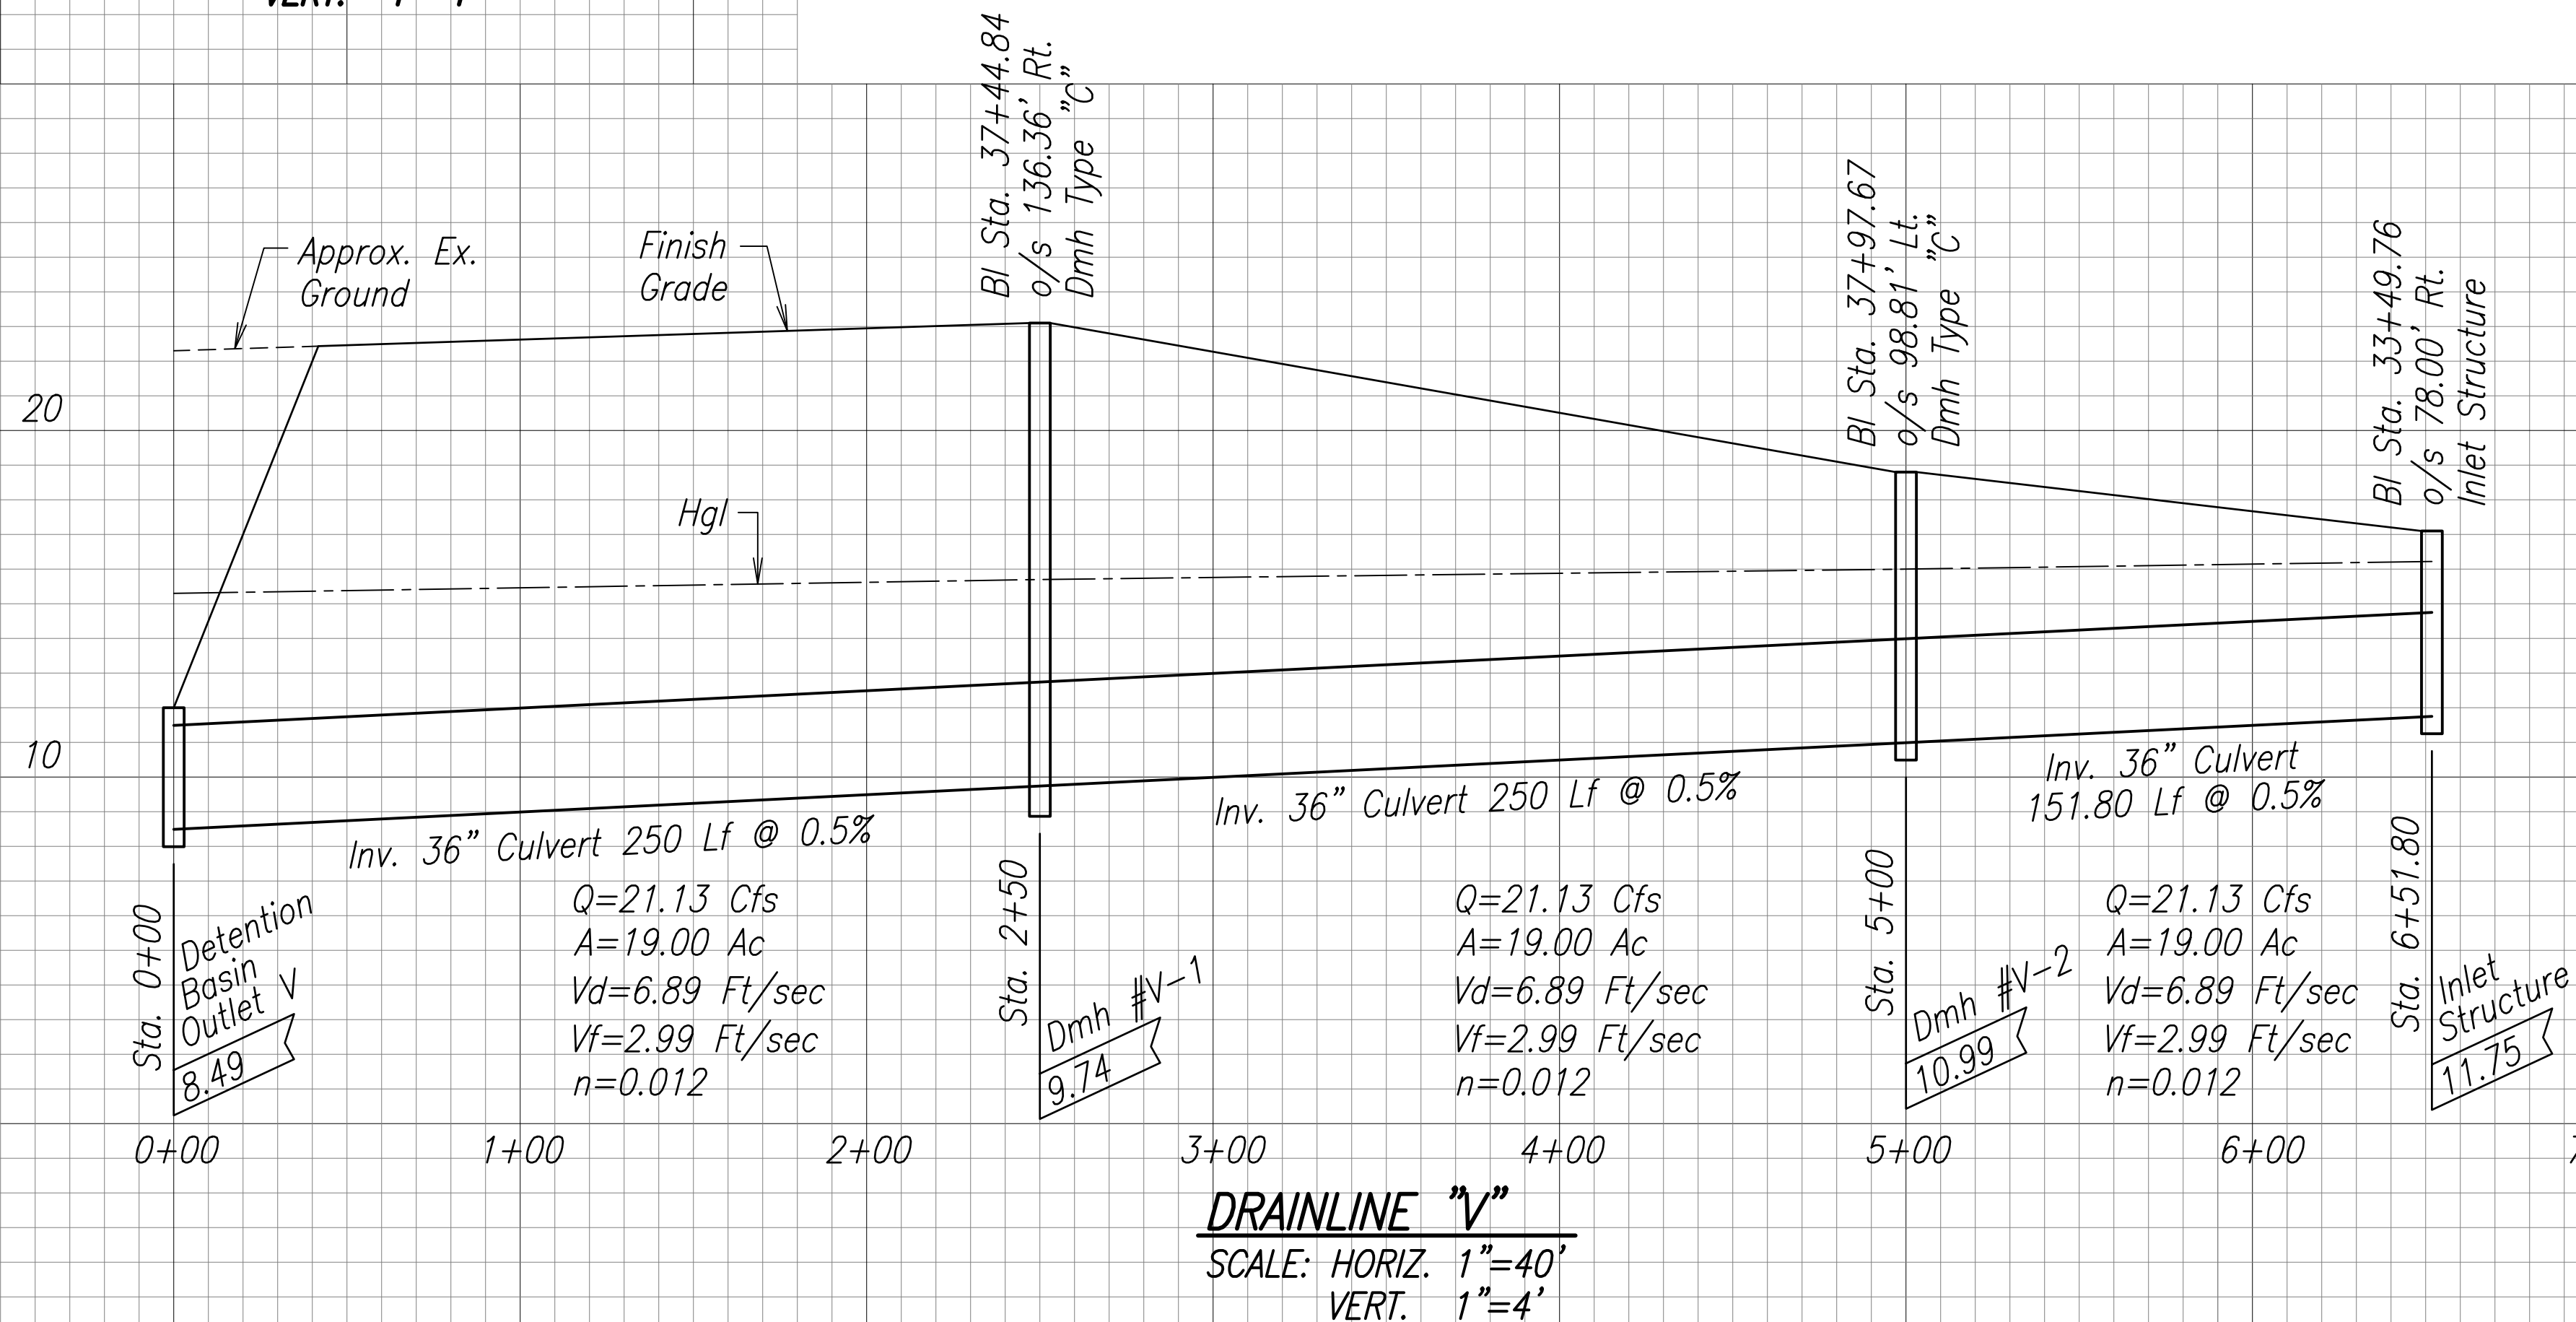

STATE OF HAWAII
 DEPARTMENT OF TRANSPORTATION
 HIGHWAYS DIVISION

DRAINLINE PROFILES

KAHULUI AIRPORT
 ACCESS ROAD, PHASE I
 Federal Aid Project No. NH-0380(10)
 Scale: As Shown Date: February 2013

SHEET No. C-74 OF 93 SHEETS

"AS-BUILT"