


FED. ROAD DIST. NO.	STATE	FED. AID PROJ. NO.	FISCAL YEAR	SHEET NO.	TOTAL SHEETS
HAWAII	HAW.	NH-0380(10)	2013	14	166

TRUE NORTH
SCALE: 1" = 200 Ft.

DRAWING NAME: C:\PROJECTS\KAHULUI-2011\PLANS\2-GENERAL PLAN\G-1.DWG PLOT TIME: 02-22-13, 11:27 AM

SURVEY PLOTTED BY	DATE
DRAWN BY	
TRACED BY	
DESIGNED BY	
CHECKED BY	
ORIGINAL PLAN	
NOTE BOOK	
No.	

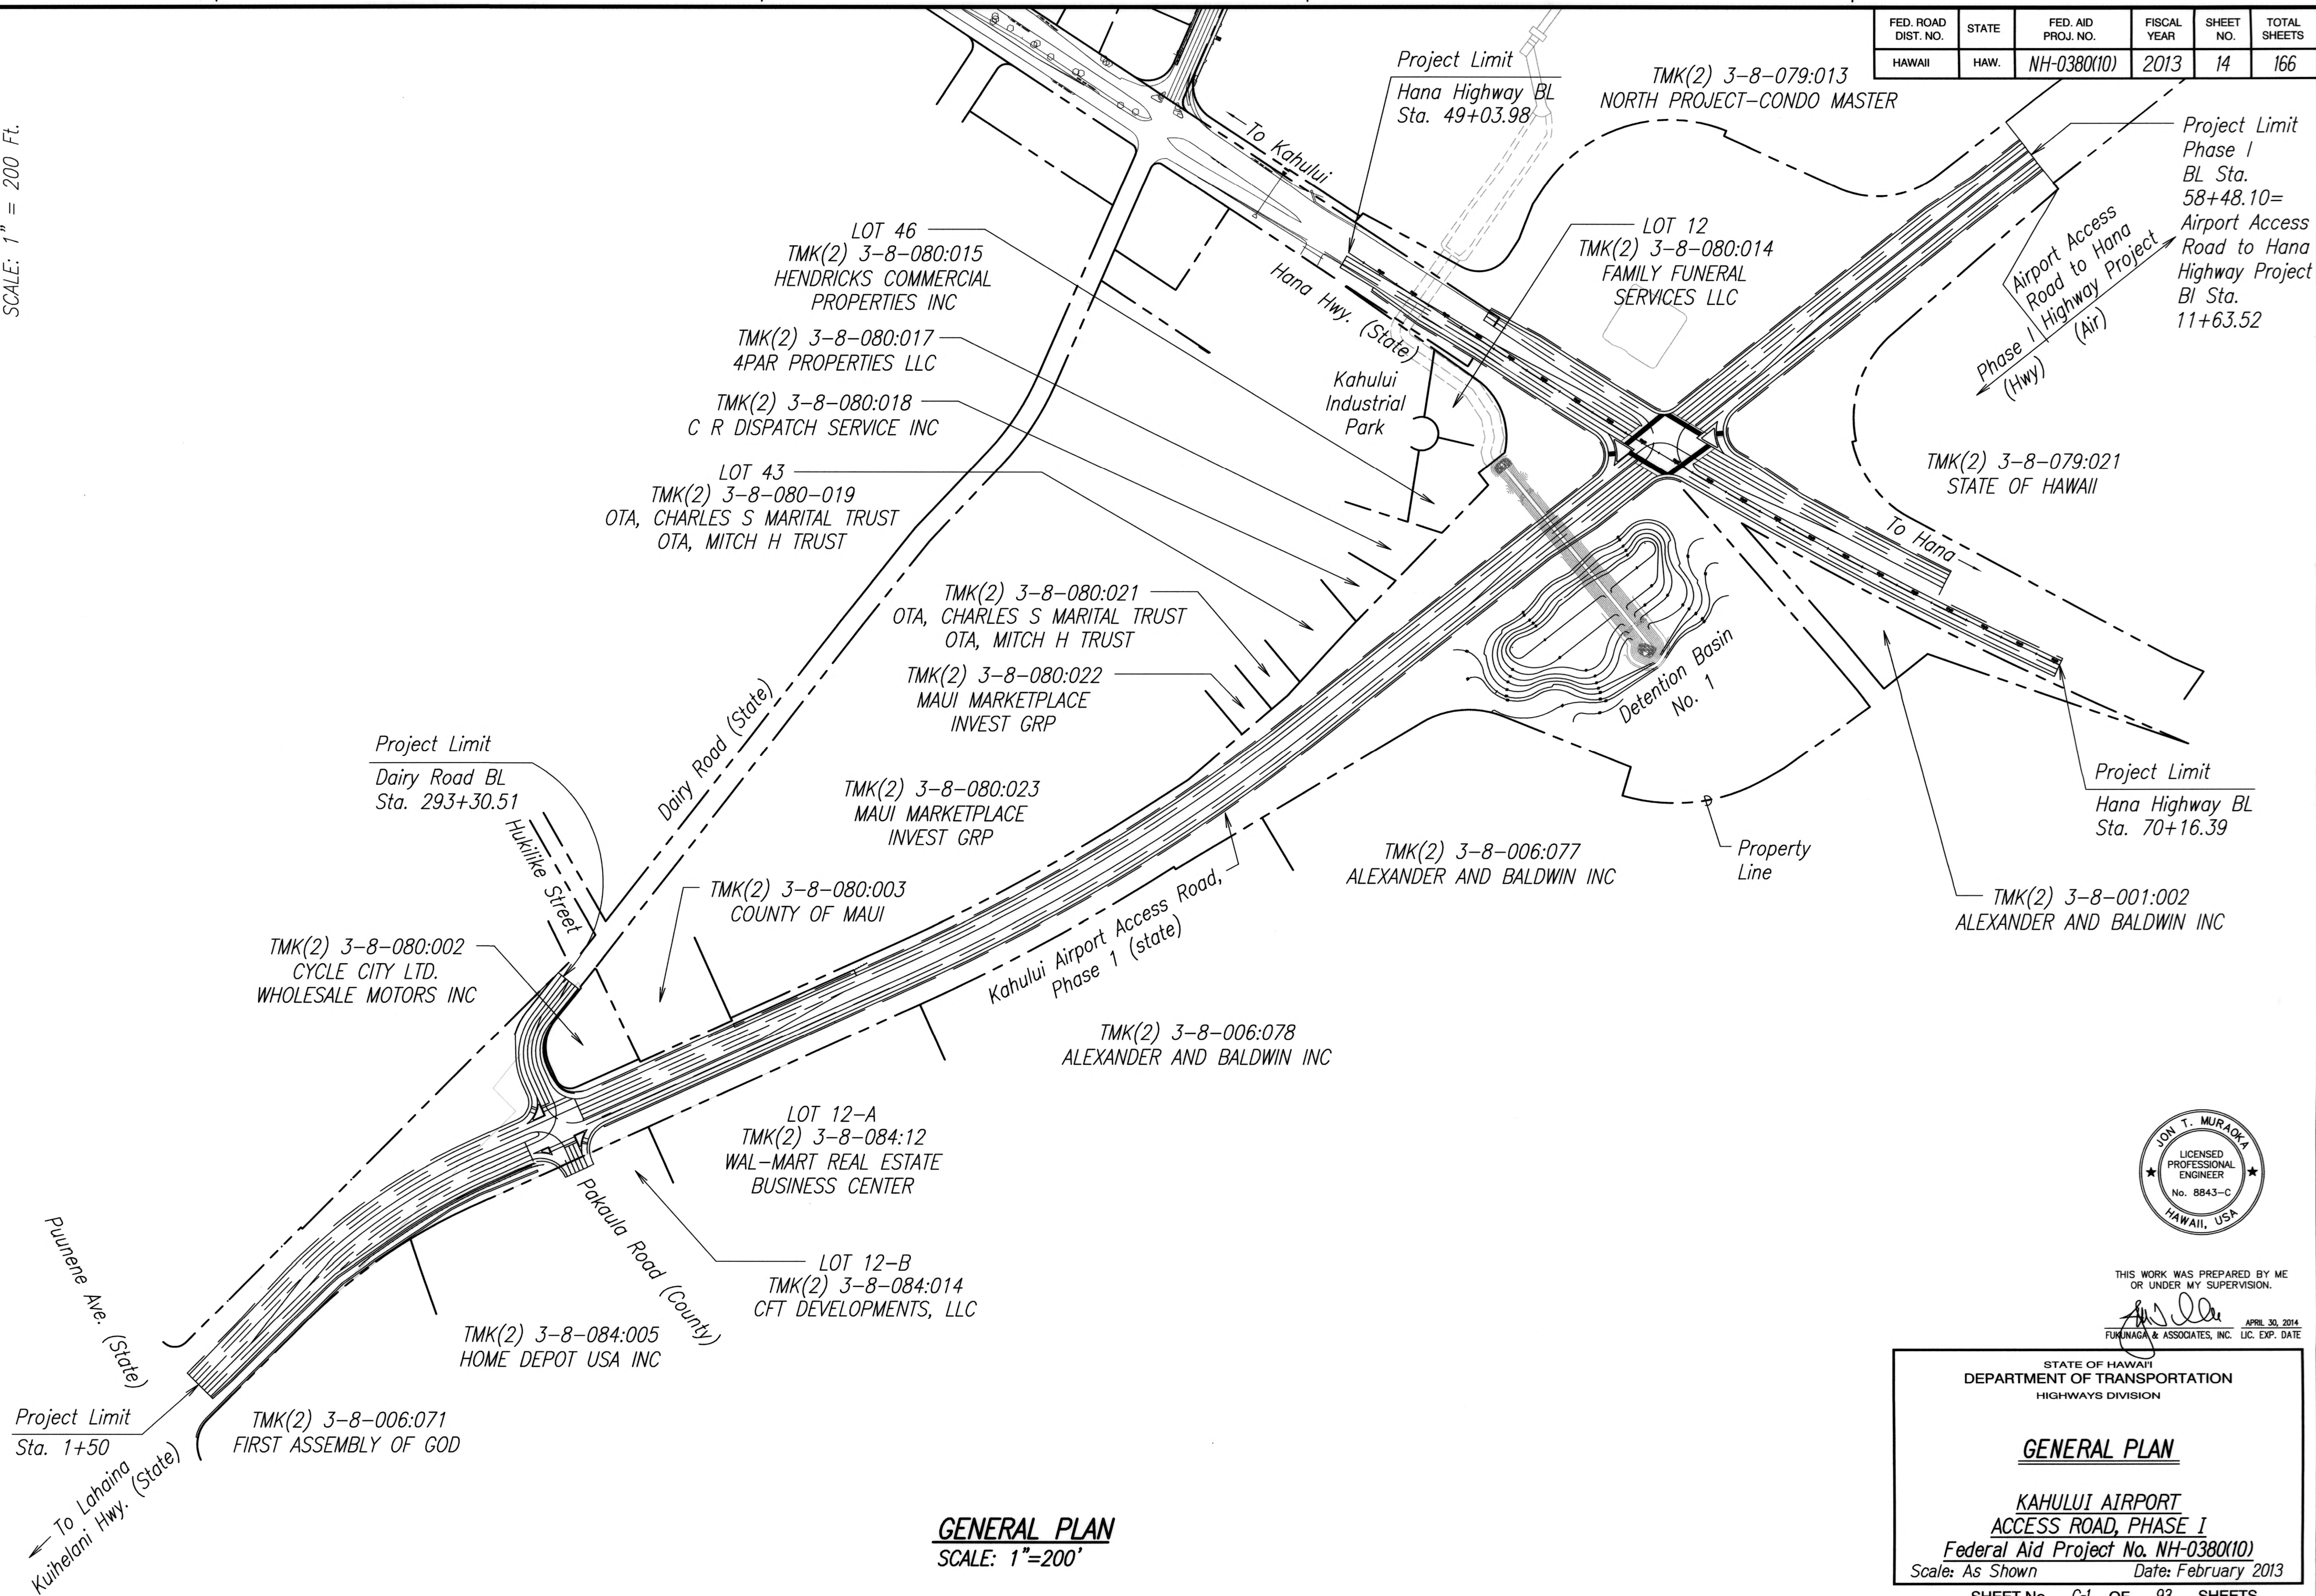

THIS WORK WAS PREPARED BY ME
OR UNDER MY SUPERVISION.
[Signature]
FUKUNAGA & ASSOCIATES, INC. APRIL 30, 2014
LIC. EXP. DATE

STATE OF HAWAII
DEPARTMENT OF TRANSPORTATION
HIGHWAYS DIVISION

GENERAL PLAN

**KAHULUI AIRPORT
ACCESS ROAD, PHASE I**
Federal Aid Project No. NH-0380(10)
Scale: As Shown Date: February 2013

SHEET No. C-1 OF 93 SHEETS

GENERAL PLAN
SCALE: 1"=200'