



| FED. ROAD DIST. NO. | STATE | FED. AID PROJ. NO. | FISCAL YEAR | SHEET NO. | TOTAL SHEETS |
|---------------------|-------|--------------------|-------------|-----------|--------------|
| HAWAII              | HAW.  | NH-0380(10)        | 2013        | 57        | 166          |



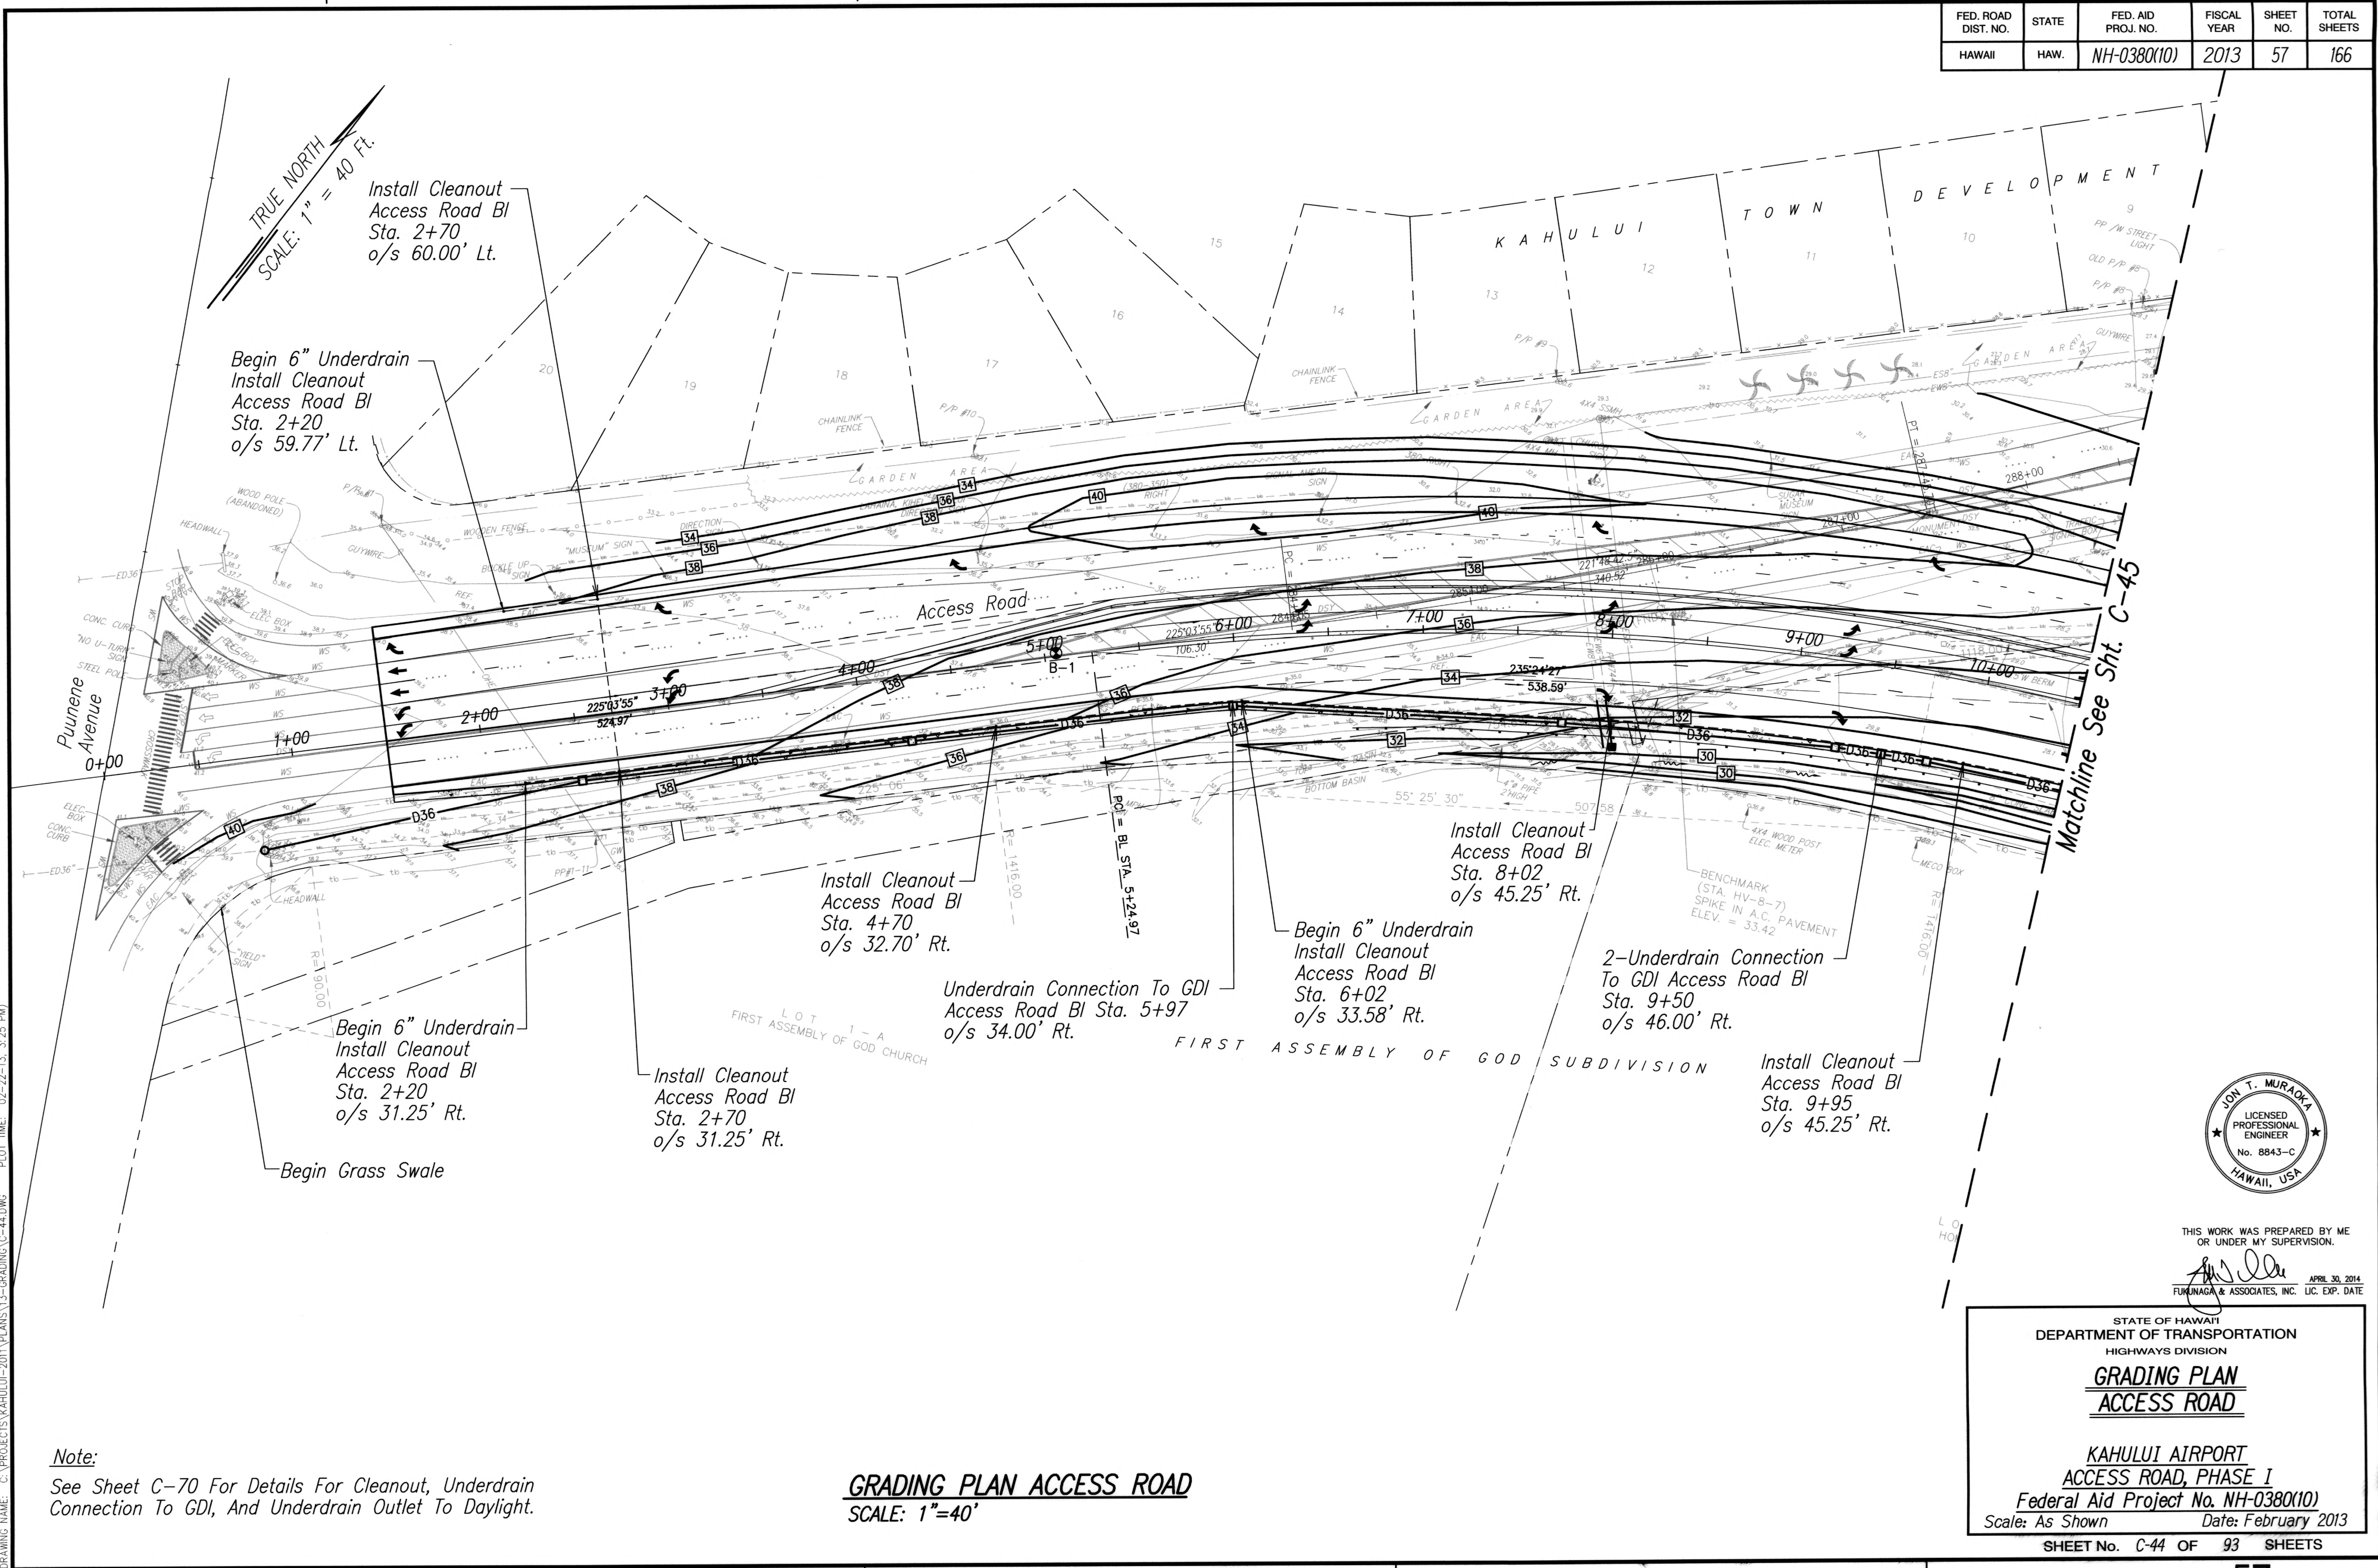

| FED. ROAD DIST. NO. | STATE | FED. AID PROJ. NO. | FISCAL YEAR | SHEET NO. | TOTAL SHEETS |
|---------------------|-------|--------------------|-------------|-----------|--------------|
| HAWAII              | HAW.  | NH-0380(10)        | 2013        | ADD. 58   | 166          |

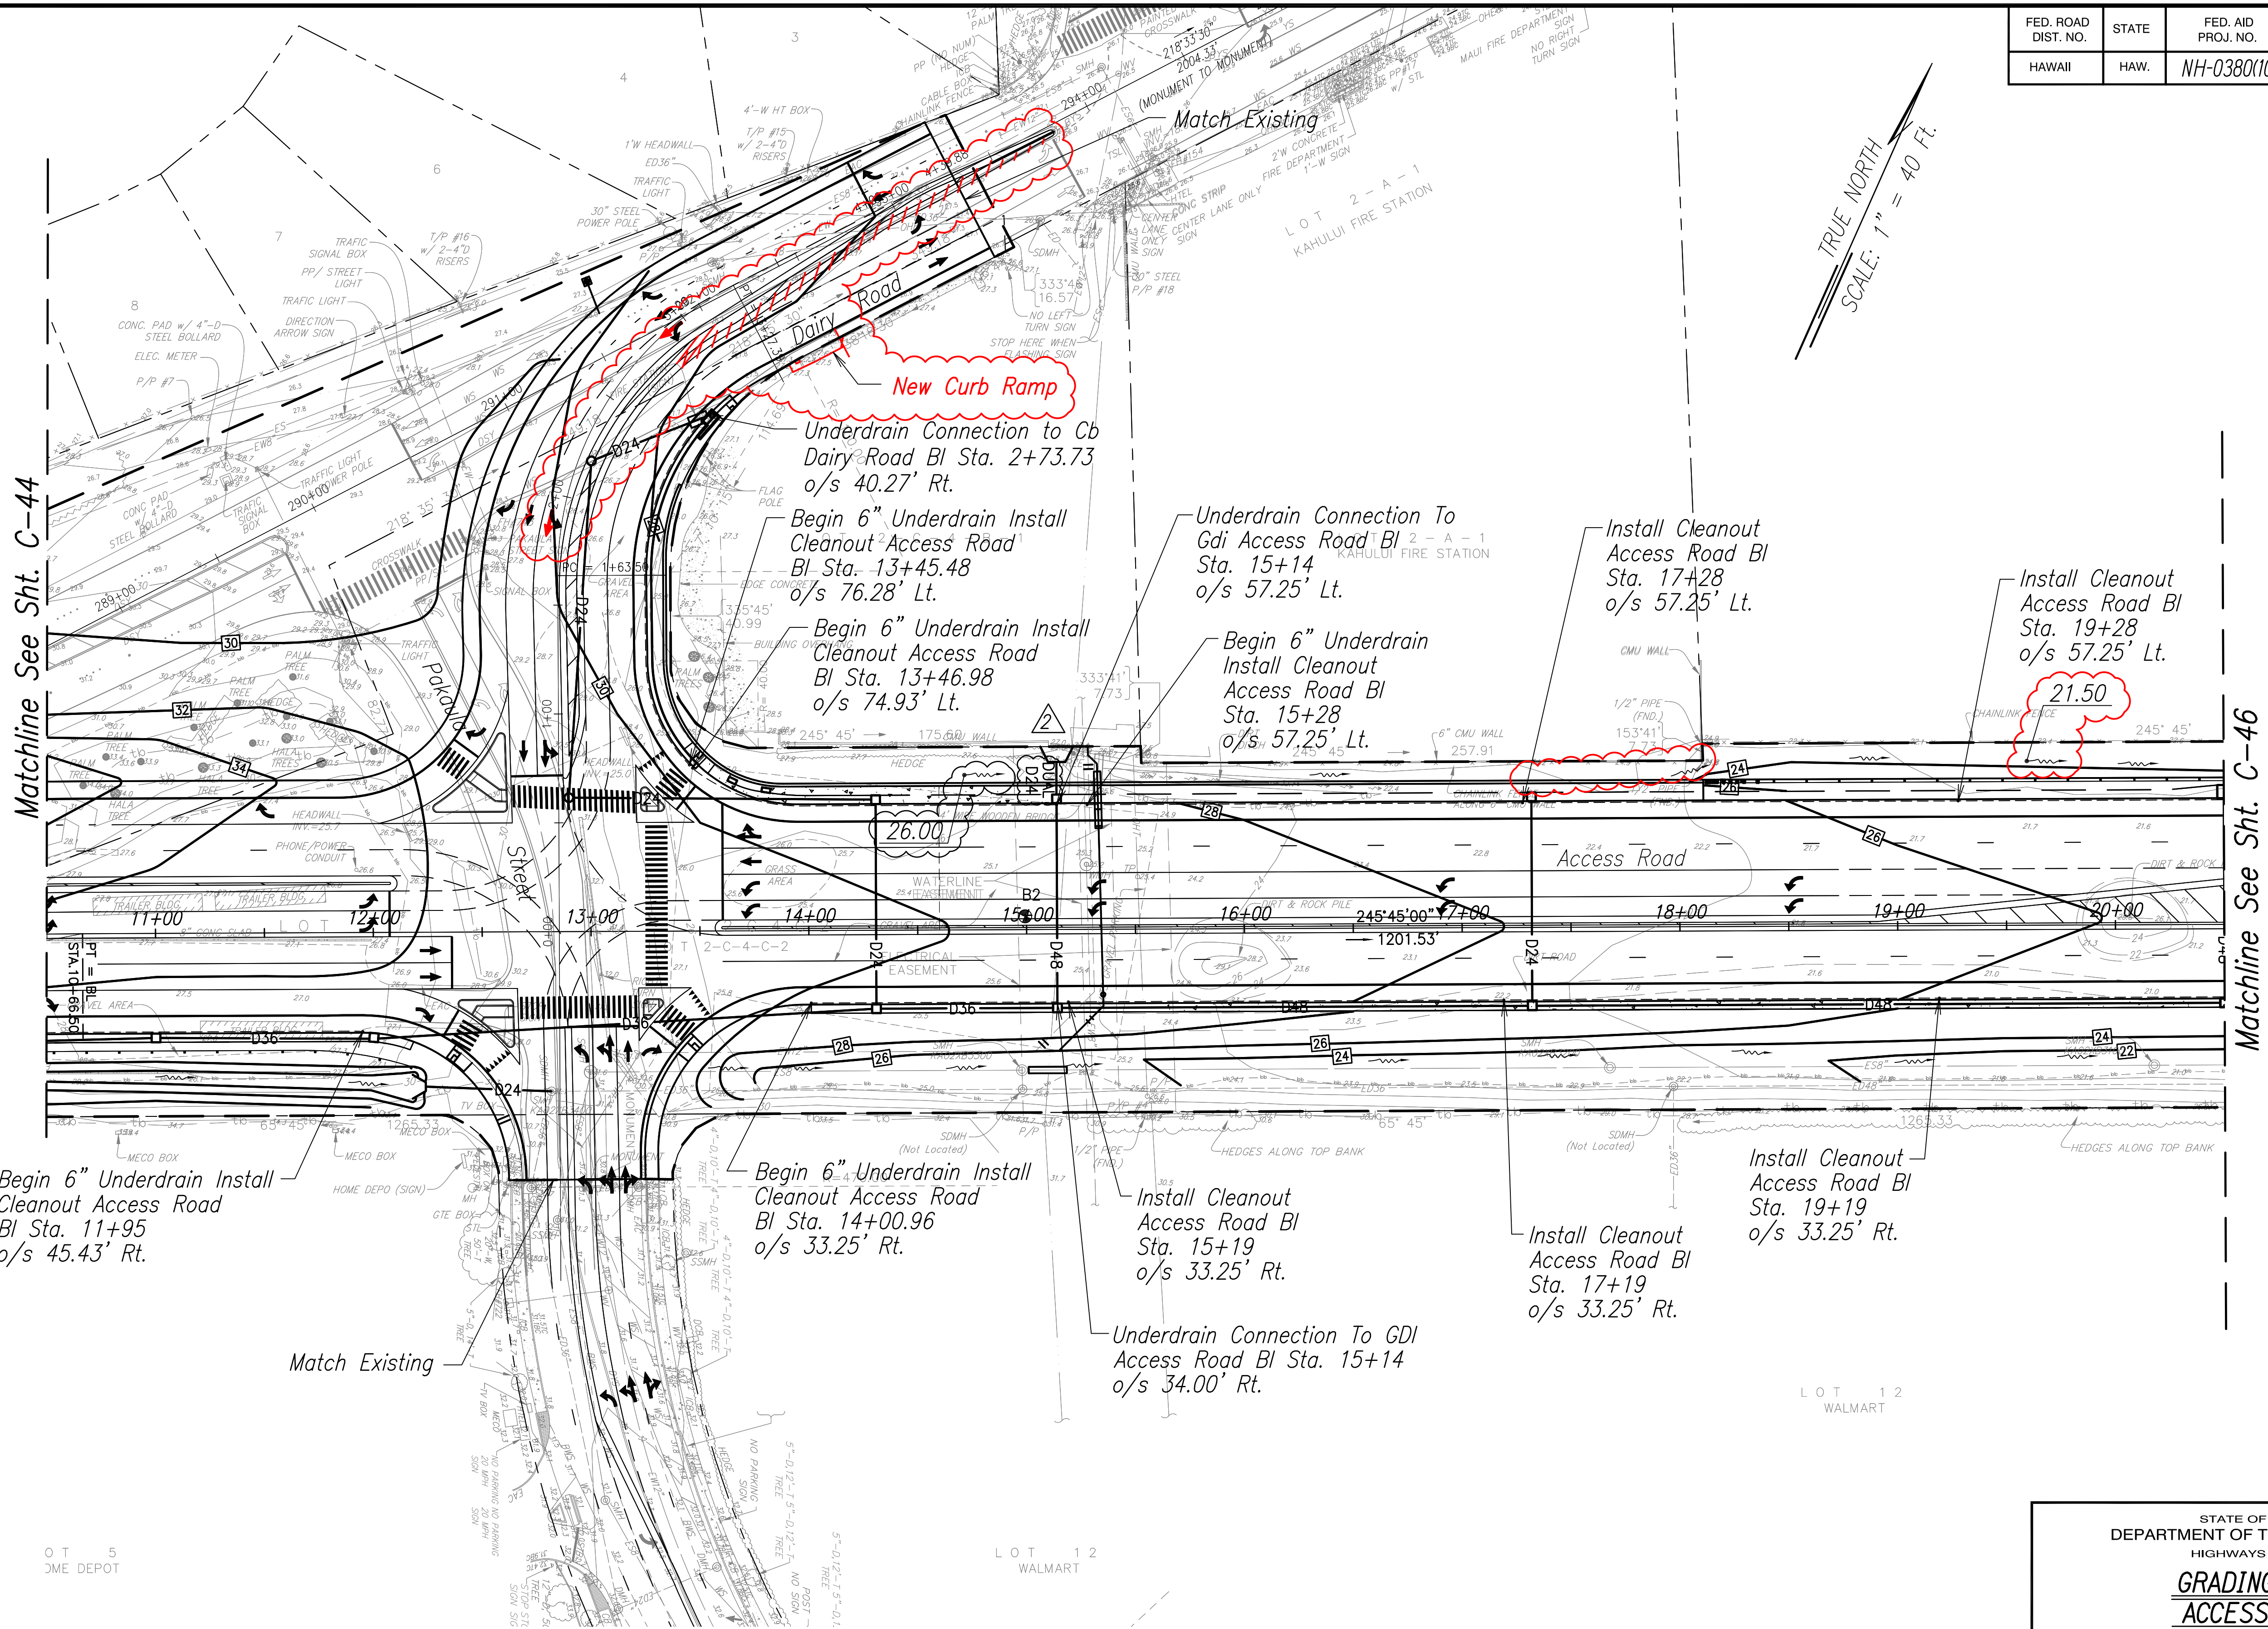

**Note:**  
See Sheet C-70 For Details For Cleanout, Underdrain Connection To GDI, And Underdrain Outlet To Daylight.

**GRADING PLAN ACCESS ROAD**  
SCALE: 1"=40'

|        |                                    |
|--------|------------------------------------|
| 4-1-13 | Delete Contours at Inlet Structure |
| DATE   | REVISION                           |

STATE OF HAWAII  
DEPARTMENT OF TRANSPORTATION  
HIGHWAYS DIVISION  
**GRADING PLAN  
ACCESS ROAD**  
  
KAHULUI AIRPORT  
ACCESS ROAD, PHASE I  
Federal Aid Project No. NH-0380(10)  
Scale: As Shown Date: February 2013  
SHEET No. C-45 OF 93 SHEETS

"AS-BUILT"

ADD. 58







| FED. ROAD DIST. NO. | STATE | FED. AID PROJ. NO. | FISCAL YEAR | SHEET NO. | TOTAL SHEETS |
|---------------------|-------|--------------------|-------------|-----------|--------------|
| HAWAII              | HAW.  | NH-0380(10)        | 2013        | 60        | 166          |


DRAWING NAME: C:\PROJECTS\KAHULUI-2011\AS-BUILT OCTOBER 2017\CIVIL\C-47.DWG PLOT TIME: 10-25-18, 3:02 PM

|               |                   |      |
|---------------|-------------------|------|
| ORIGINAL PLAN | SURVEY PLOTTED BY | DATE |
| NOTE BOOK     | DRAWN BY          |      |
| No.           | DESIGNED BY       |      |
|               | CHECKED BY        |      |

Note:

See Sheet C-70 For Details For Cleanout, Underdrain Connection To GDI, And Underdrain Outlet To Daylight.


**GRADING PLAN ACCESS ROAD**  
SCALE: 1"=40'

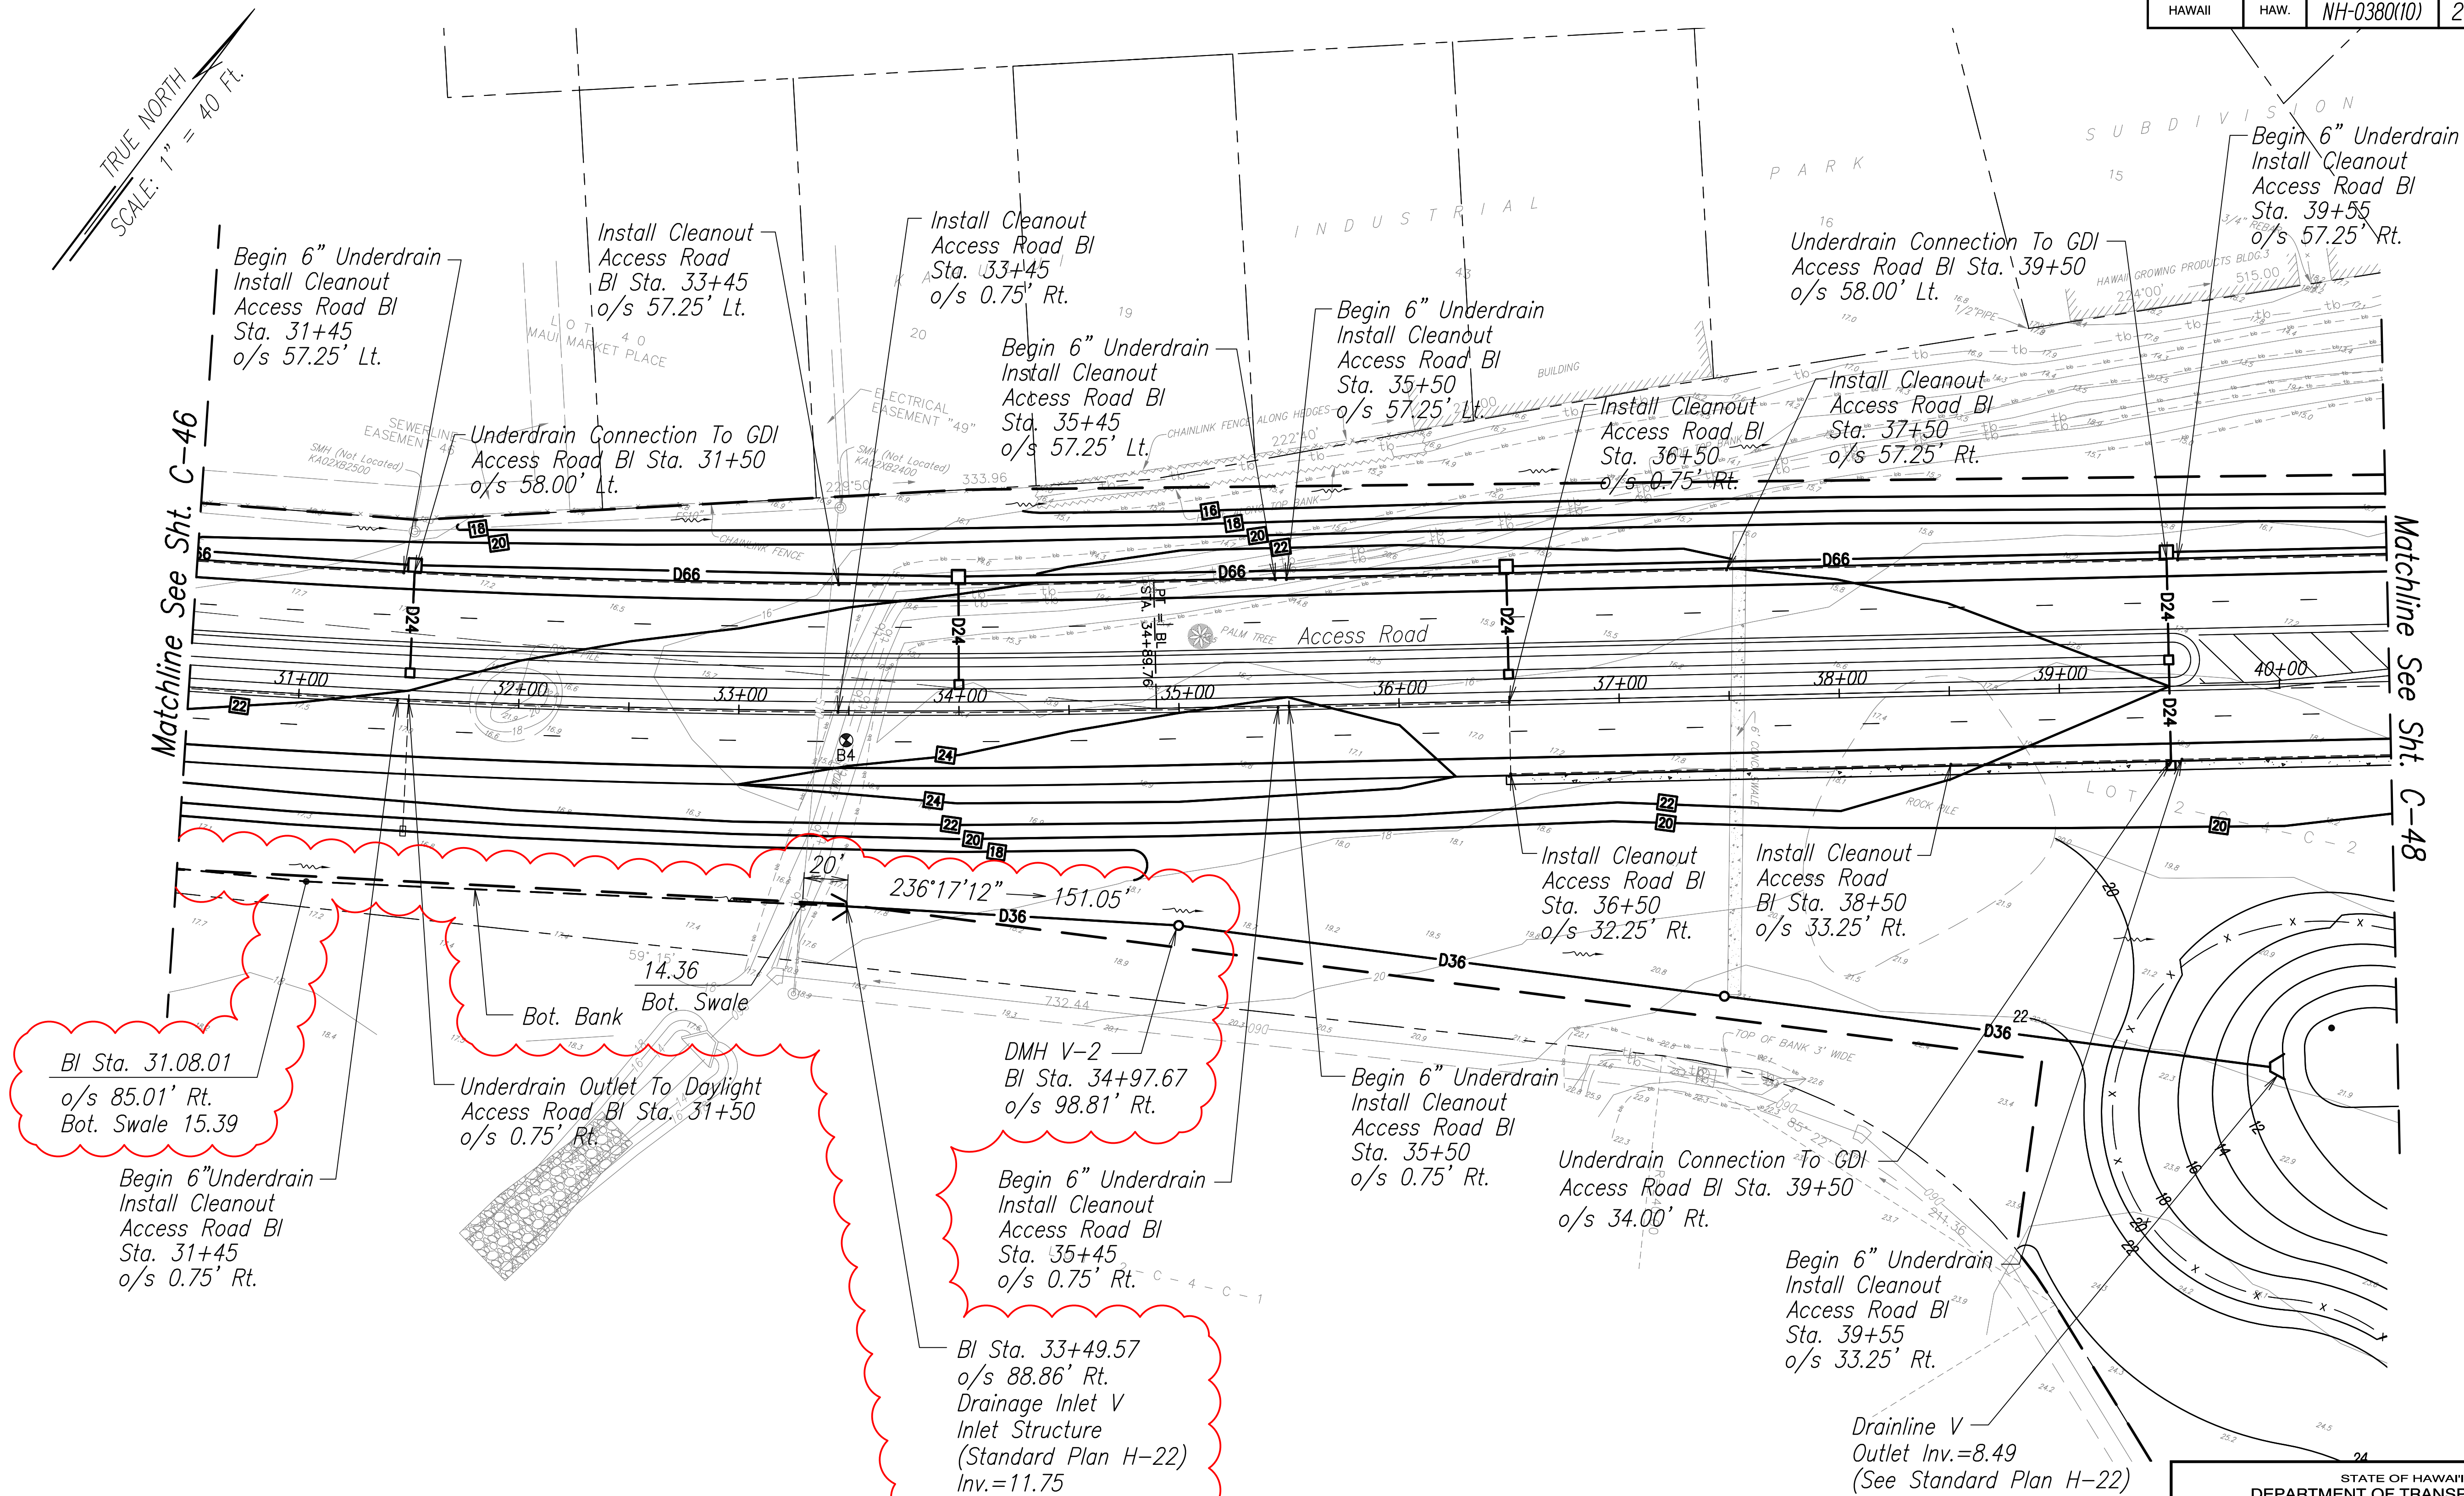

STATE OF HAWAII  
DEPARTMENT OF TRANSPORTATION  
HIGHWAYS DIVISION  
**GRADING PLAN**  
**ACCESS ROAD**  
  
KAHULUI AIRPORT  
ACCESS ROAD, PHASE I  
Federal Aid Project No. NH-0380(10)  
Scale: As Shown Date: February 2013  
SHEET No. C-47 OF 93 SHEETS



| FED. ROAD DIST. NO. | STATE | FED. AID PROJ. NO. | FISCAL YEAR | SHEET NO. | TOTAL SHEETS |
|---------------------|-------|--------------------|-------------|-----------|--------------|
| HAWAII              | HAW.  | NH-0380(10)        | 2013        | 61        | 166          |

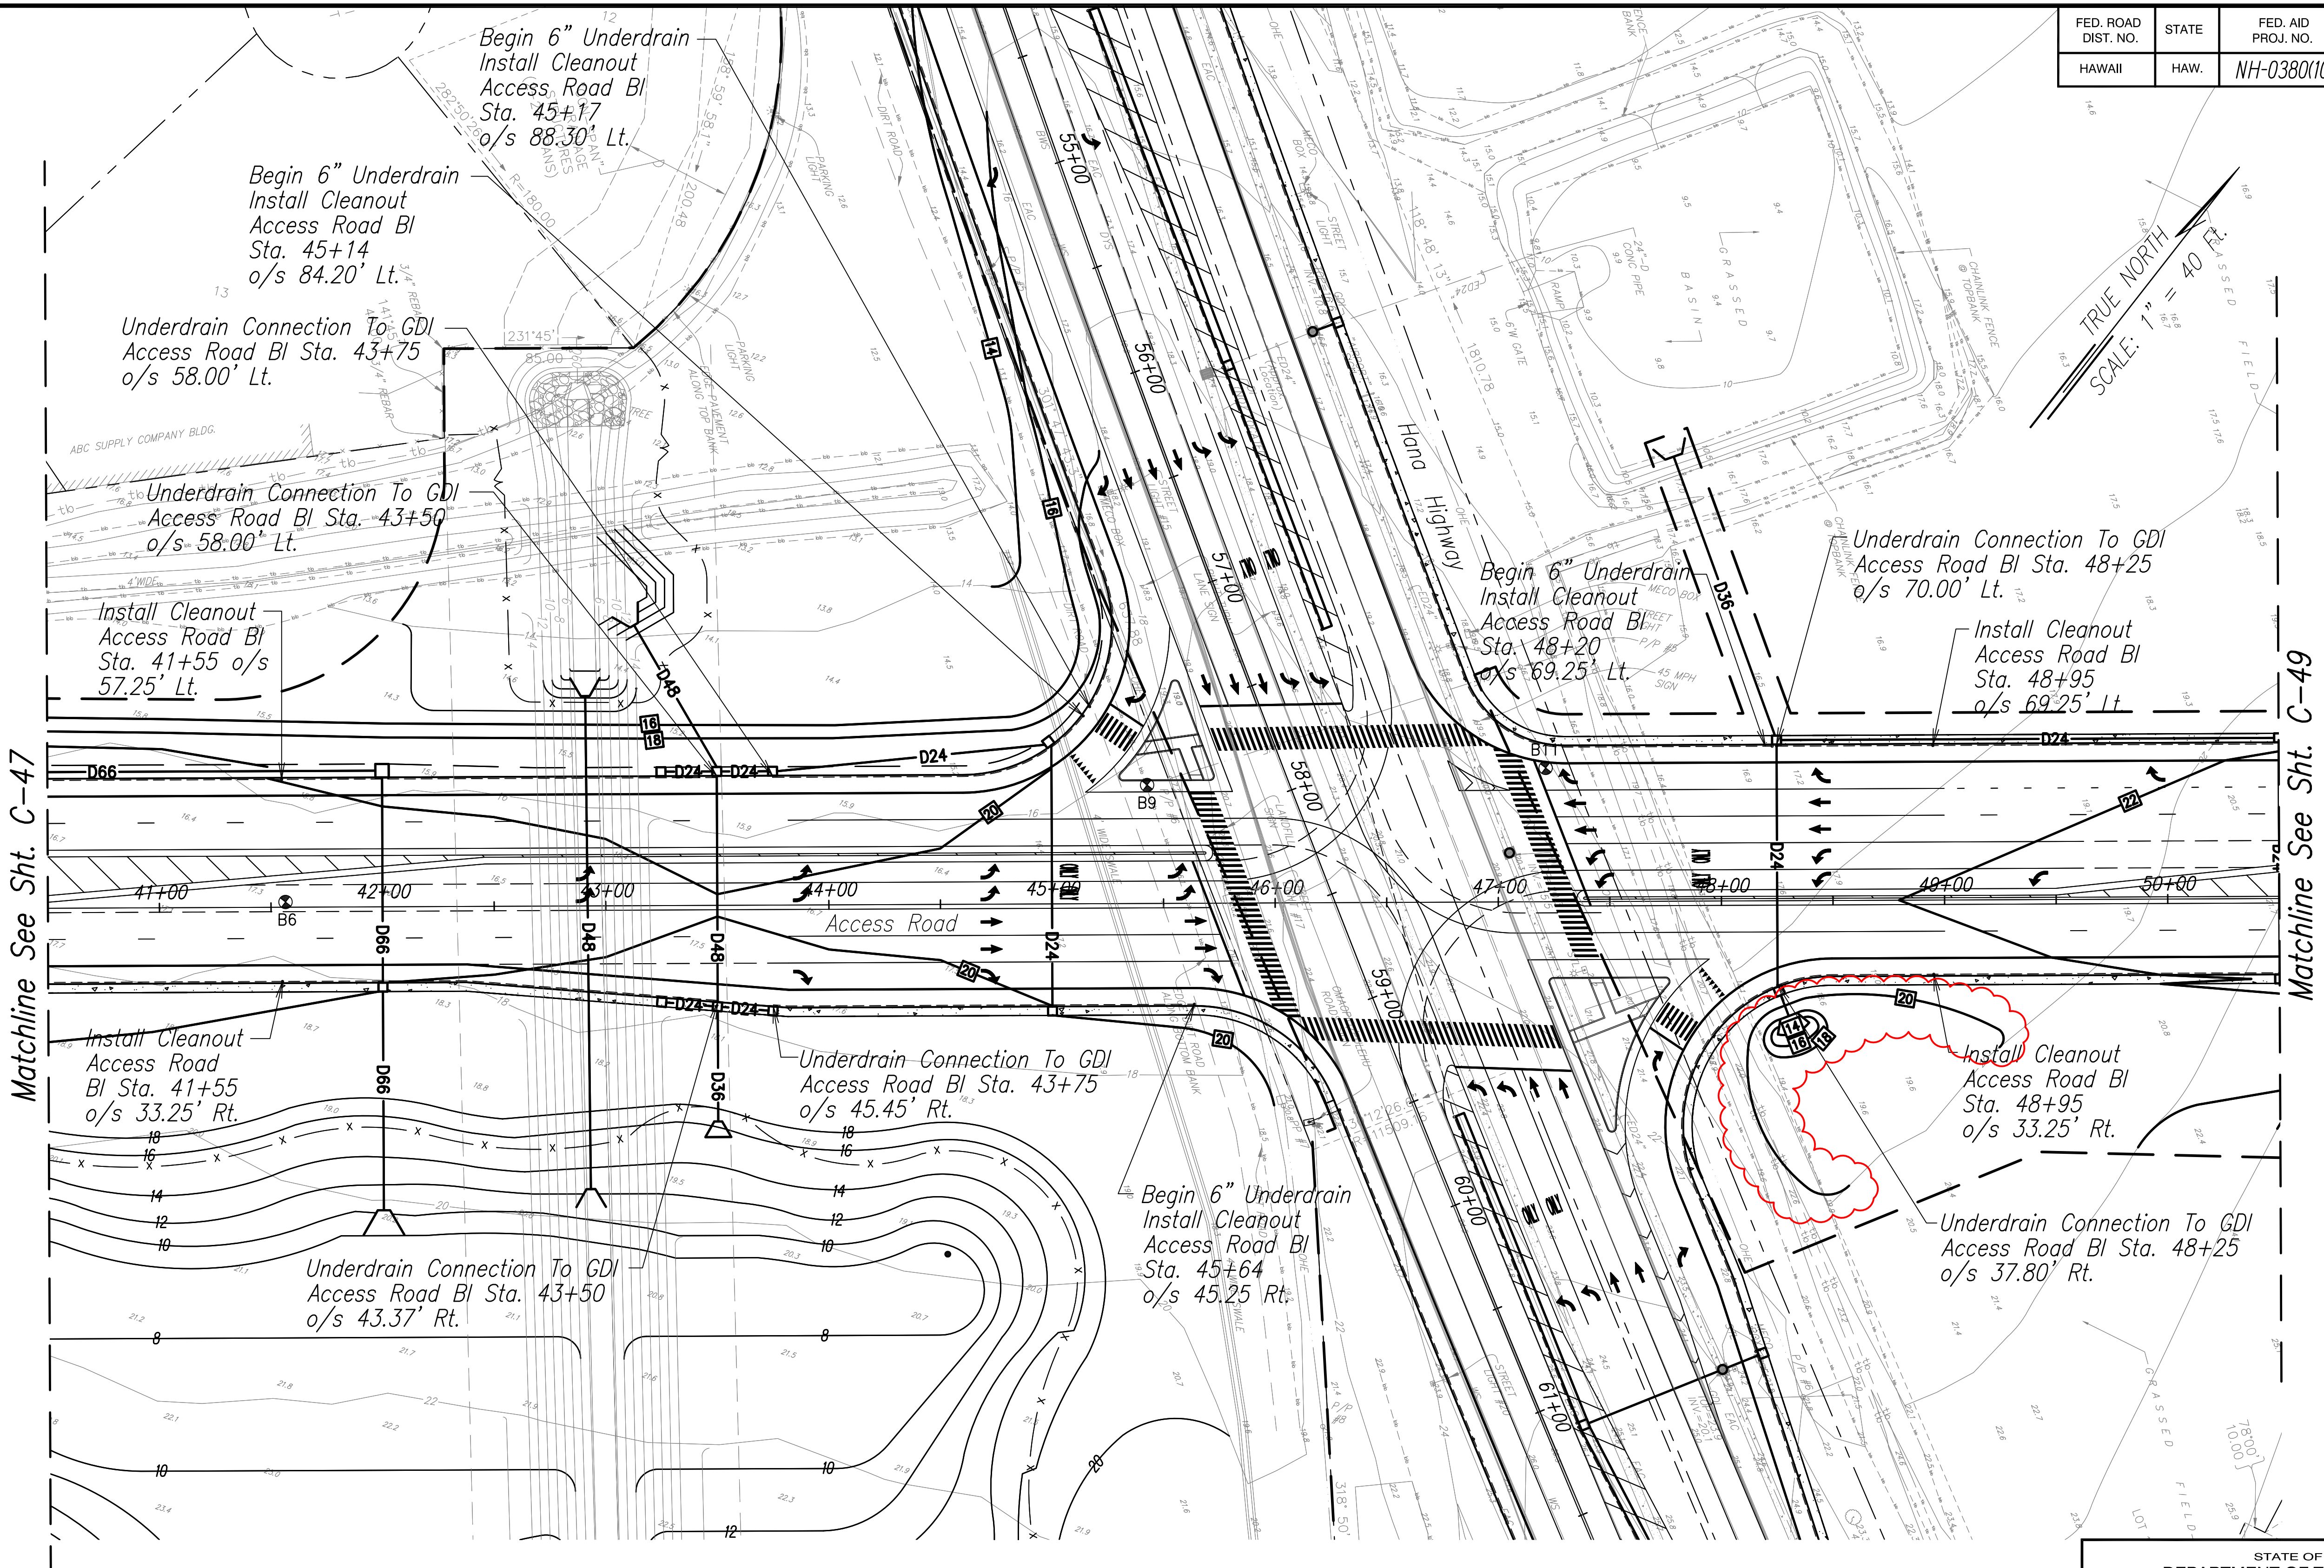

**Note:**  
See Sheet C-70 For Details For Cleanout, Underdrain Connection To GDI, And Underdrain Outlet To Daylight.

**GRADING PLAN ACCESS ROAD**  
SCALE: 1"=40'

STATE OF HAWAII  
DEPARTMENT OF TRANSPORTATION  
HIGHWAYS DIVISION

**GRADING PLAN  
ACCESS ROAD**

KAHULUI AIRPORT  
ACCESS ROAD, PHASE I  
Federal Aid Project No. NH-0380(10)  
Scale: As Shown Date: February 2013

SHEET No. C-48 OF 93 SHEETS


"AS-BUILT"







| FED. ROAD DIST. NO. | STATE | FED. AID PROJ. NO. | FISCAL YEAR | SHEET NO. | TOTAL SHEETS |
|---------------------|-------|--------------------|-------------|-----------|--------------|
| HAWAII              | HAW.  | NH-0380(10)        | 2013        | 63        | 166          |

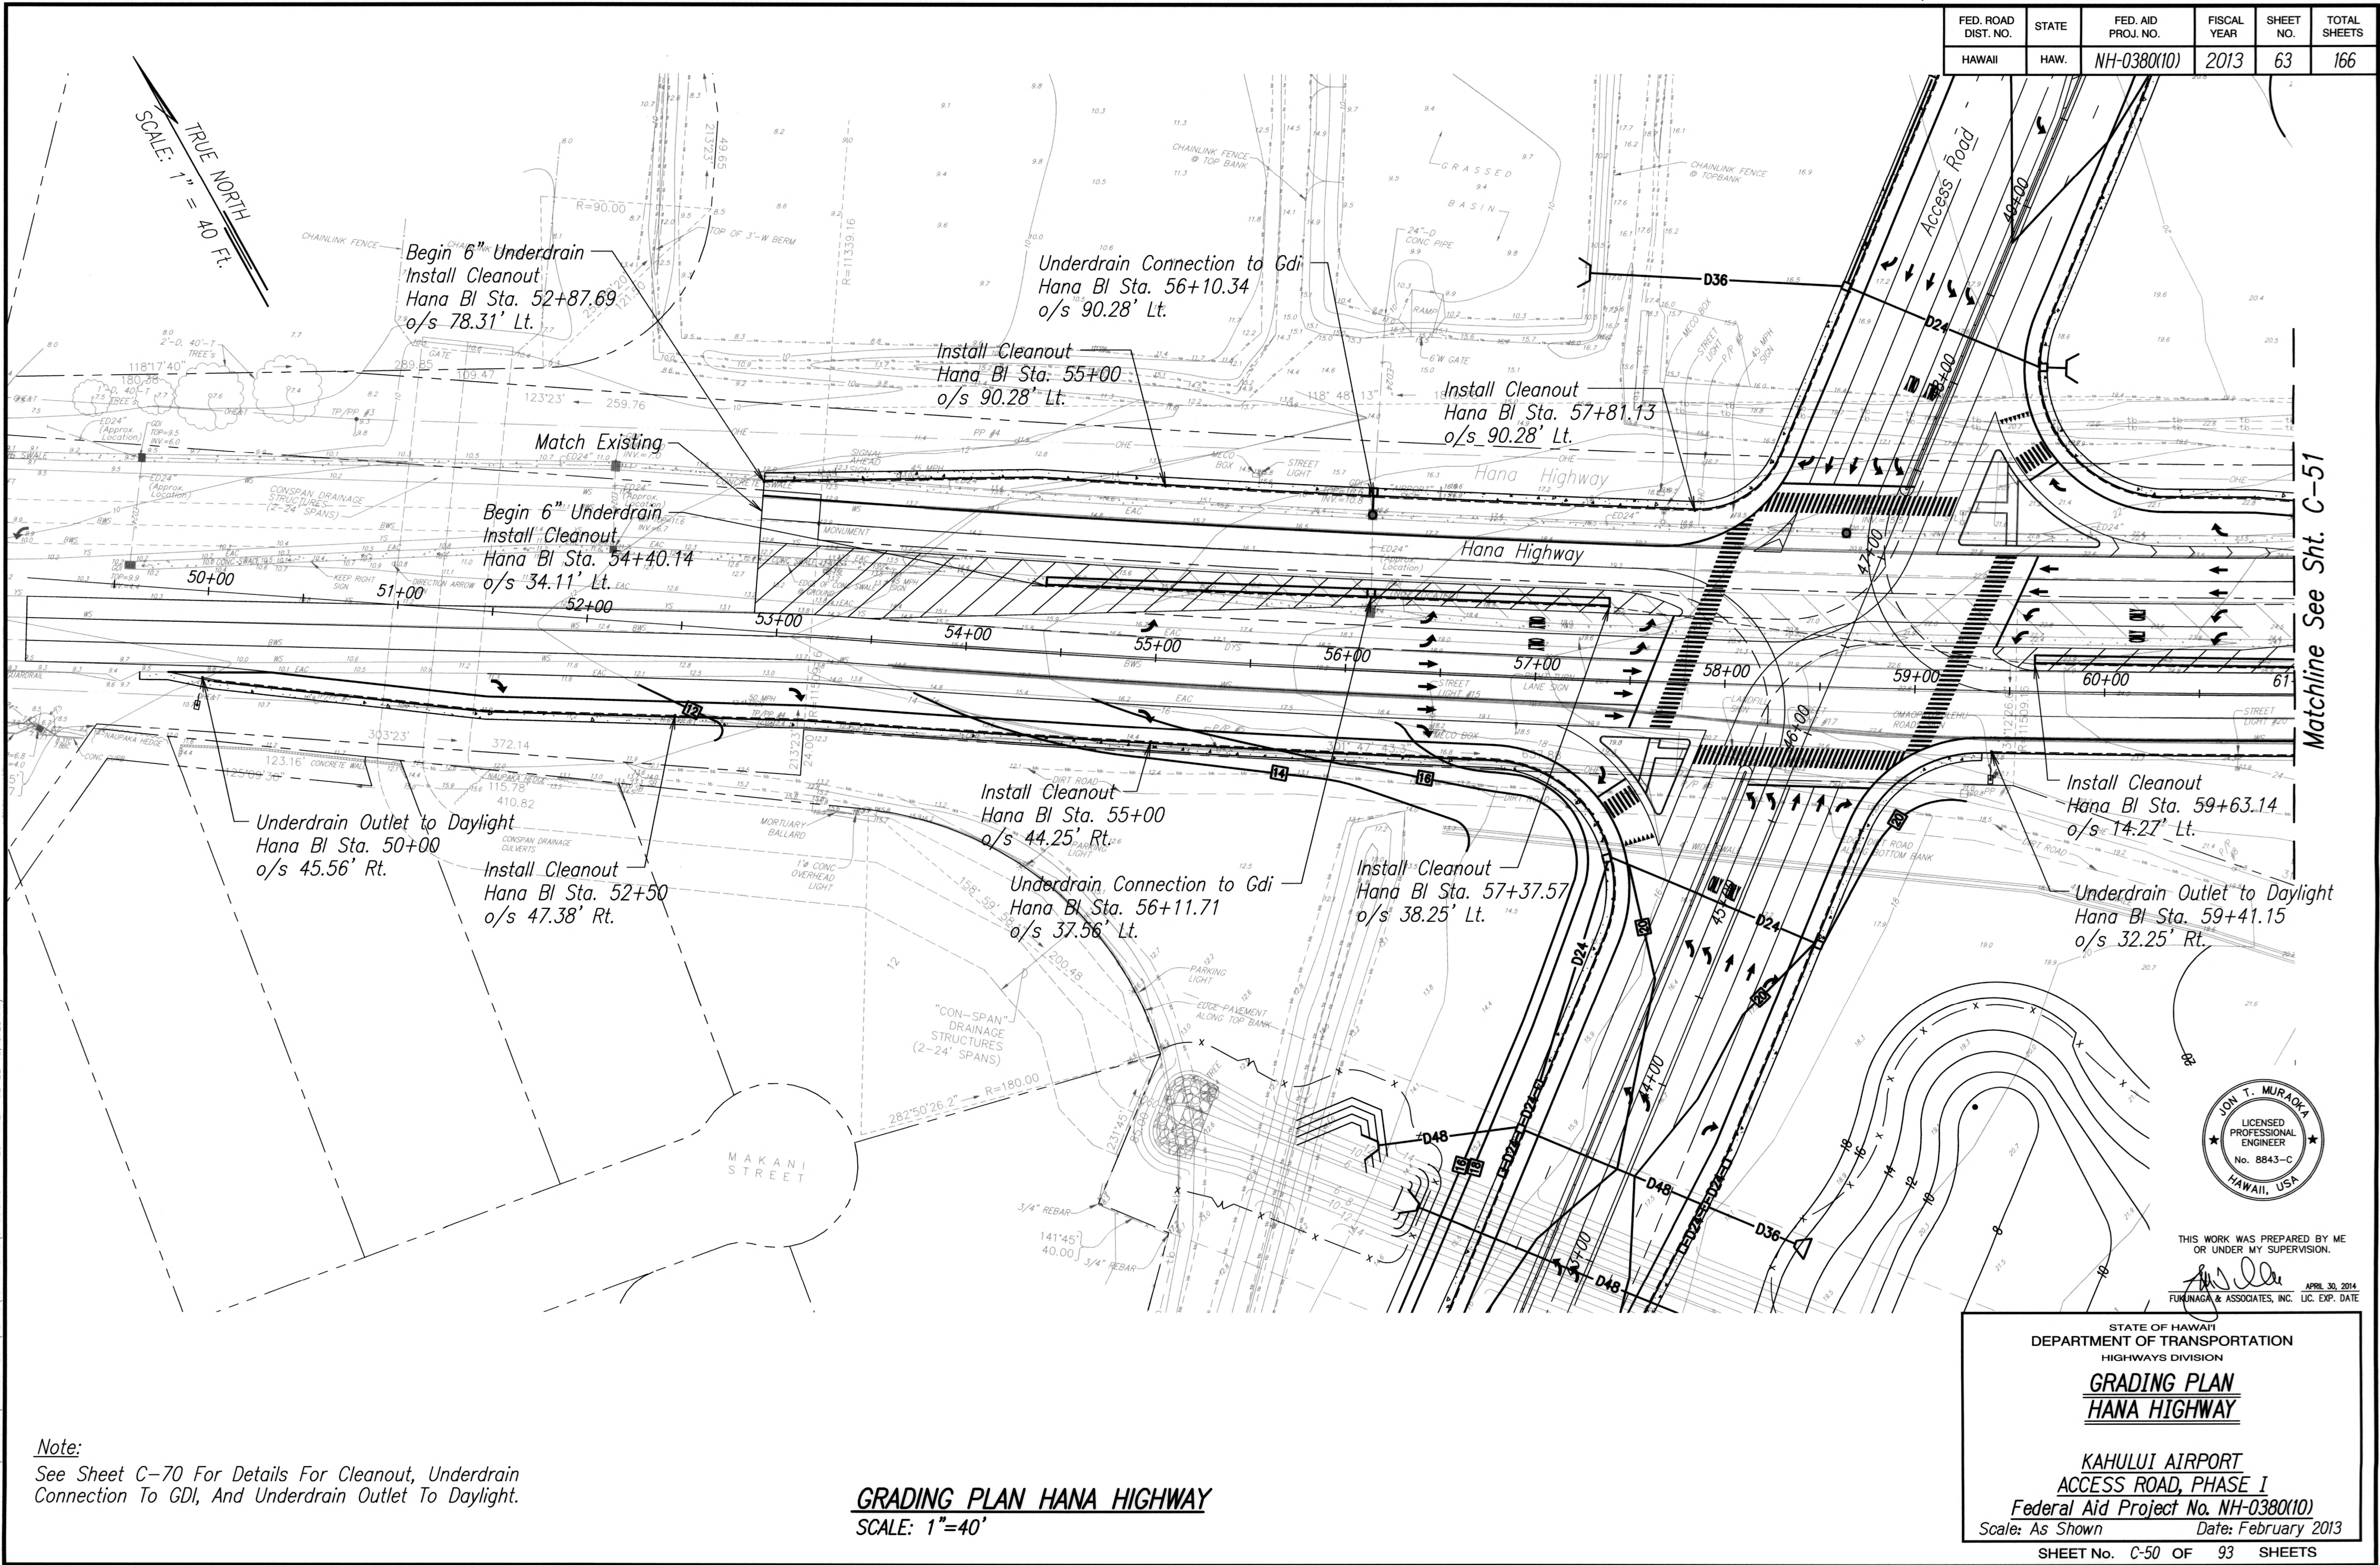


**Note:**  
See Sheet C-70 For Details For Cleanout, Underdrain Connection To GDI, And Underdrain Outlet To Daylight.

**GRADING PLAN HANA HIGHWAY**  
**SCALE: 1"=40'**



| FED. ROAD DIST. NO. | STATE | FED. AID PROJ. NO. | FISCAL YEAR | SHEET NO. | TOTAL SHEETS |
|---------------------|-------|--------------------|-------------|-----------|--------------|
| HAWAII              | HAW.  | NH-0380(10)        | 2013        | 64        | 166          |

Matchline See Sht. C-50

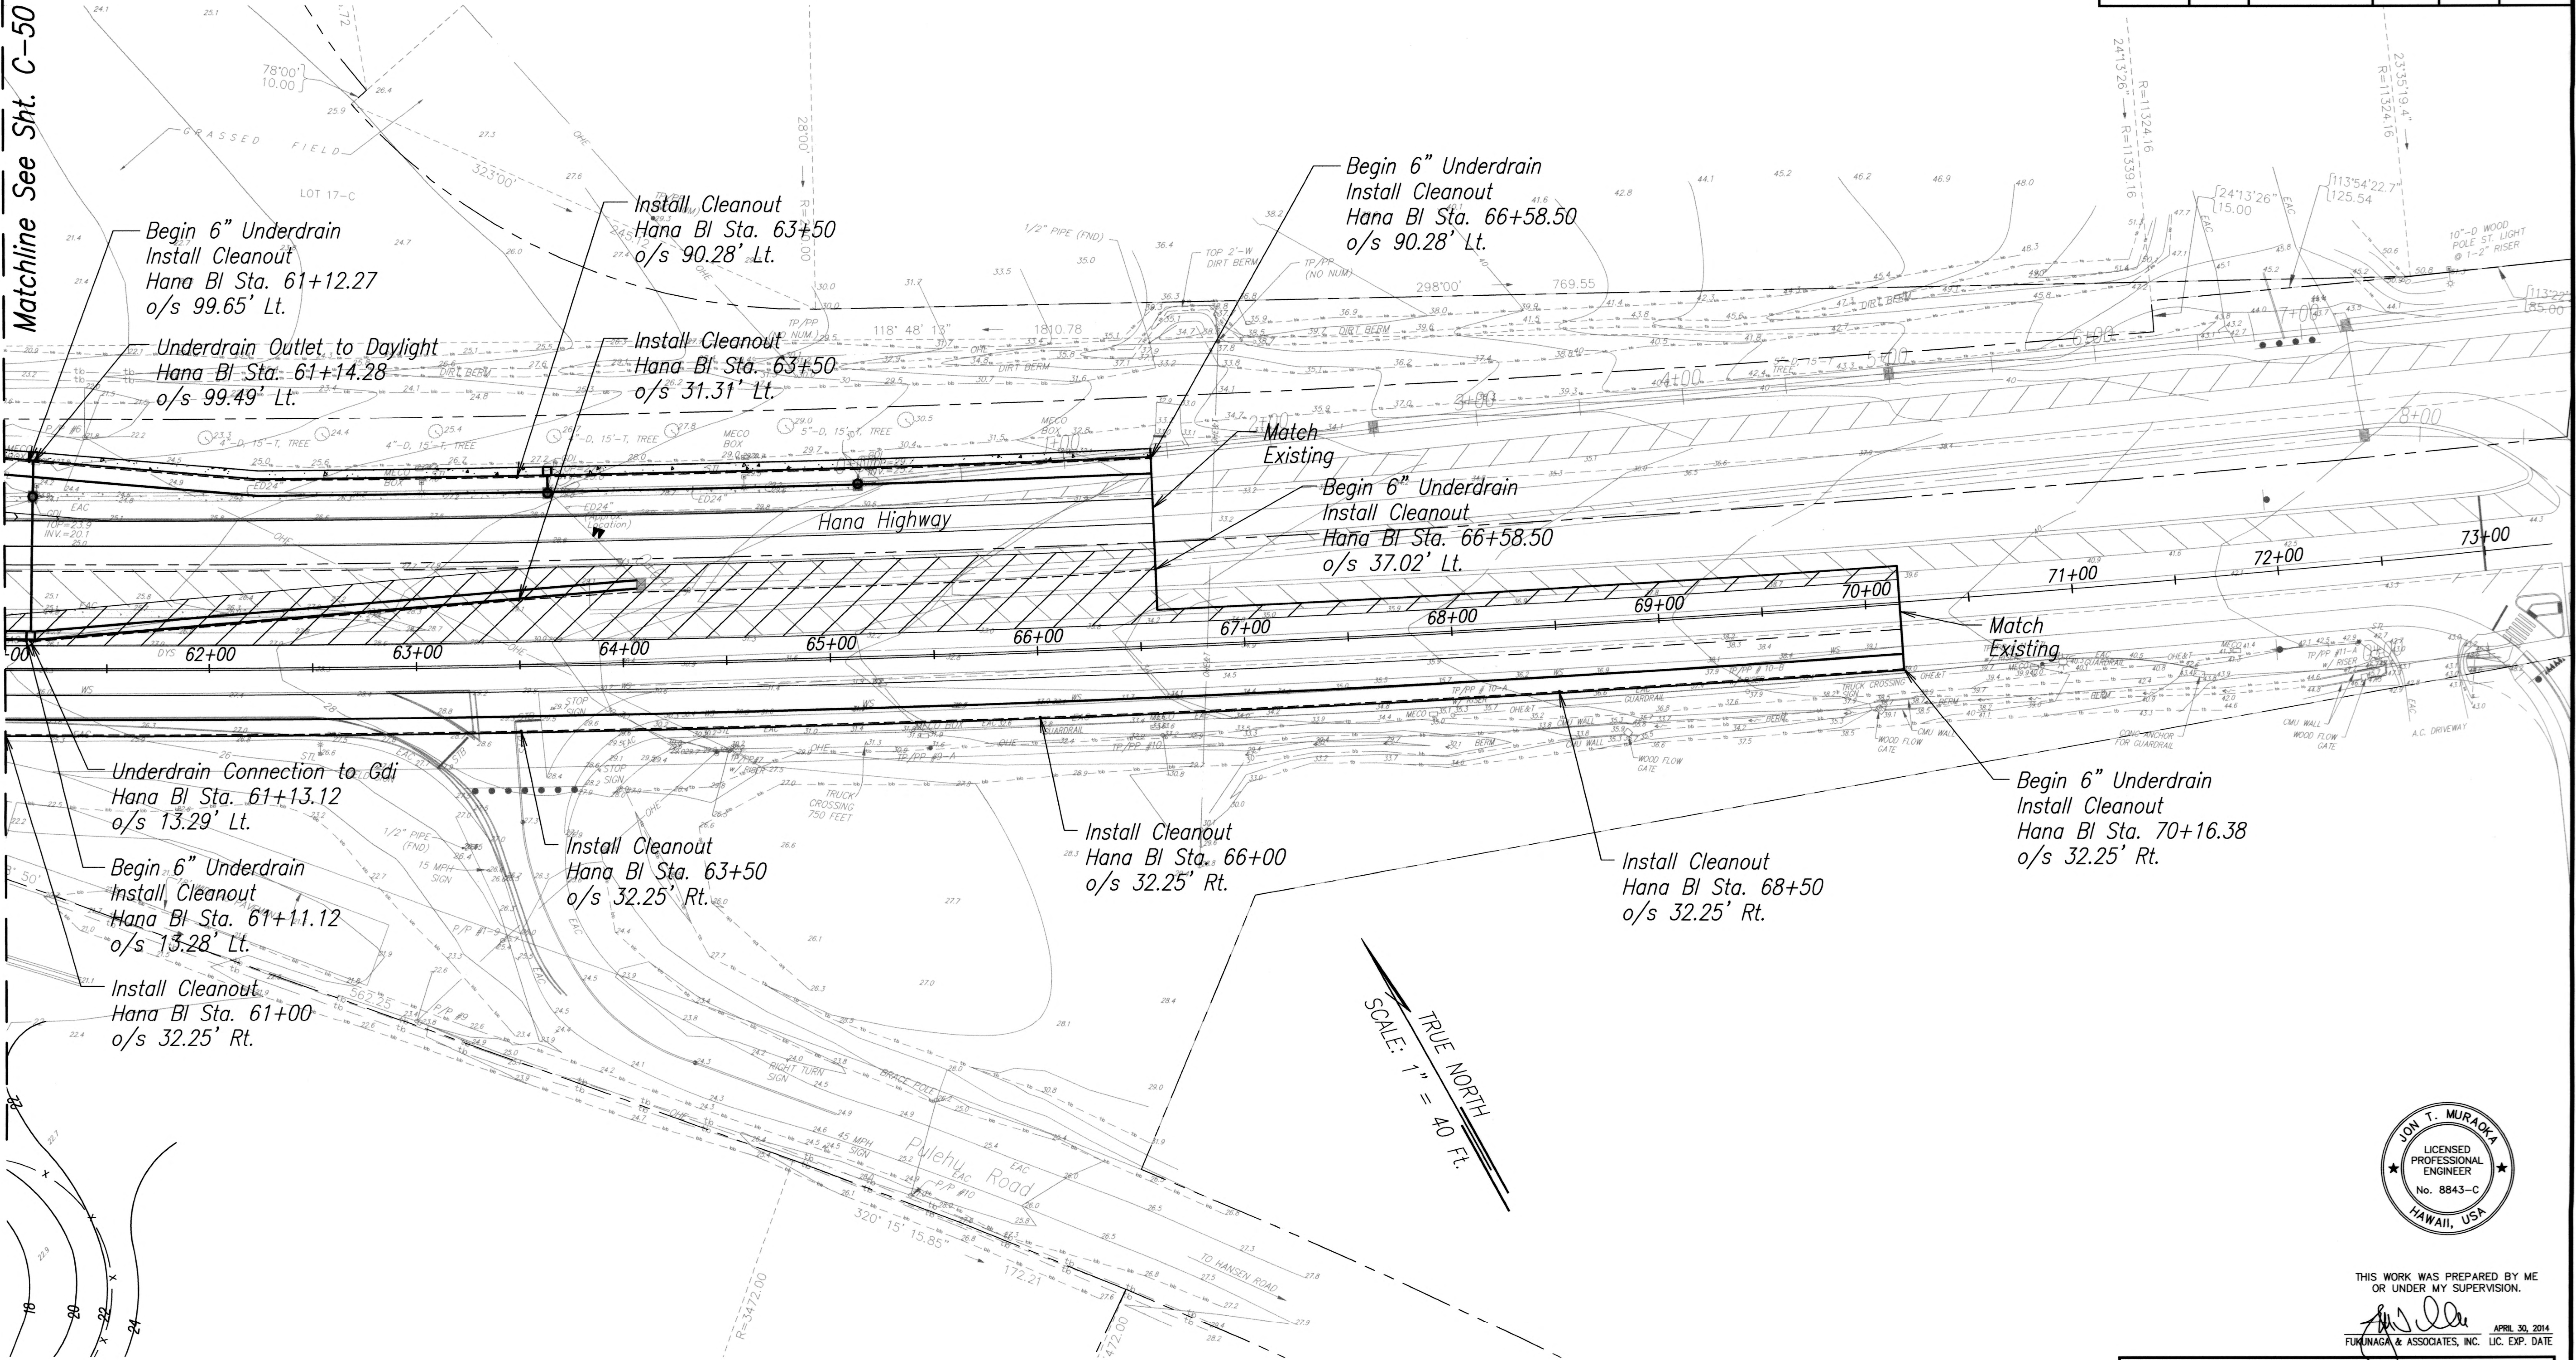

Note:  
See Sheet C-70 For Details For Cleanout, Underdrain  
Connection To Gdi, And Underdrain Outlet To Daylight.

**GRADING PLAN HANA HIGHWAY**  
SCALE: 1"=40'



THIS WORK WAS PREPARED BY ME  
OR UNDER MY SUPERVISION.  
*[Signature]*  
FUMINAGA & ASSOCIATES, INC. APRIL 30, 2014  
LIC. EXP. DATE

STATE OF HAWAII  
DEPARTMENT OF TRANSPORTATION  
HIGHWAYS DIVISION  
**GRADING PLAN**  
**HANA HIGHWAY**  
  
KAHULUI AIRPORT  
ACCESS ROAD, PHASE I  
Federal Aid Project No. NH-0380(10)  
Scale: As Shown Date: February 2013  
SHEET No. C-51 OF 93 SHEETS