

INDEX TO DRAWINGS	
SHEET NO.	DESCRIPTION
1	TITLE SHEET, INDEX TO DRAWINGS
2	STANDARD PLANS SUMMARY
3	GENERAL NOTES AND LEGEND
4	GENERAL NOTES
5	WATER POLLUTION AND EROSION CONTROL NOTES
6	WATER POLLUTION, EROSION CONTROL AND CONSTRUCTION NOTES
7	CONSTRUCTION NOTES
8-12	UTILITY NOTES
13	BEST MANAGEMENT PRACTICES NOTES & DETAILS
14	GENERAL PLAN
15	PAVEMENT SECTIONS
16	PAVEMENT GENERAL PLAN
17-26	TYPICAL SECTIONS
27	EROSION CONTROL PLAN
28-35	DEMOLITION PLANS
36-41	PLAN AND PROFILE
42	PLAN - DAIRY ROAD
43	PLAN - HANA HIGHWAY
44	DETENTION BASIN SITE AND GRADING PLAN
45-48	SUPERELEVATION DIAGRAMS
49-56	DRAINAGE PLANS
57-64	GRADING PLANS
65-68	INTERSECTION PLANS
69	PAVEMENT MARKING, LEGEND, DETAILS, & NOTES
70-78	SIGNING AND STRIPING PLANS
79-81	SIGN PANEL DETAILS
82-84	MISCELLANEOUS DETAILS
85-87	DRAINLINE PROFILES
88	UTILITY PROFILES
89	CONSTRUCTION PHASING NOTES, LEGEND, AND DETAILS
90-96	CONSTRUCTION PHASING PLANS (1), (2), (3)
97-103	CROSS SECTIONS
104	TRAFFIC ISLAND SITE PLAN
105-106	BORING LOGS
107-116	GUARD RAIL DETAILS
117-140	STRUCTURAL SHEETS (4), (5)
141-150	ELECTRICAL SHEETS
151-161	LANDSCAPE SHEETS
162-166	TRAFFIC SIGNAL SHEETS

SHEET NOS. (1) 94.1 TO 94.4; (2) 95.1 - 95.2; (3) 96.1 - 96.2; (4) C.O. 121 S-1 TO C.O. 122 S-1; AND (5) C.O. 140 S-1 TO C.O. 140 S-5 ARE SUPPLEMENTARY SHEETS TO THIS PROJECT. TOTAL SHEET COUNT AFTER "AS-BUILT" POSTING 181 SHEETS.

DRAWING NAME: C:\PROJECTS\KAHULUI-2011\AS-BUILT OCTOBER 2017\CIVIL\T-1.DWG
PLOT TIME: 10-24-18 3:35 PM
FEB 2013
DATE
873-3535
PHONE
FERDINAND CAJIGAL
MANAGED BY
FUKUNAGA AND ASSOCIATES, INC.
DESIGNED BY

ORIGINAL PLAN	SURVEY PLOTTED BY	DATE
NOTE BOOK	DRAWN BY	
QUANTITIES BY	TRACED BY	
CHECKED BY	DESIGNED BY	

STATE OF HAWAII

DEPARTMENT OF TRANSPORTATION

HIGHWAYS DIVISION

HONOLULU, HAWAII

"AS-BUILT"

PLANS FOR

KAHULUI AIRPORT

ACCESS ROAD, PHASE I

FEDERAL-AID PROJECT NO. NH-0380(10)

DISTRICT OF WAILUKU


ISLAND OF MAUI

380


STATE OF HAWAII

MAUI

PROJECT LOCATION

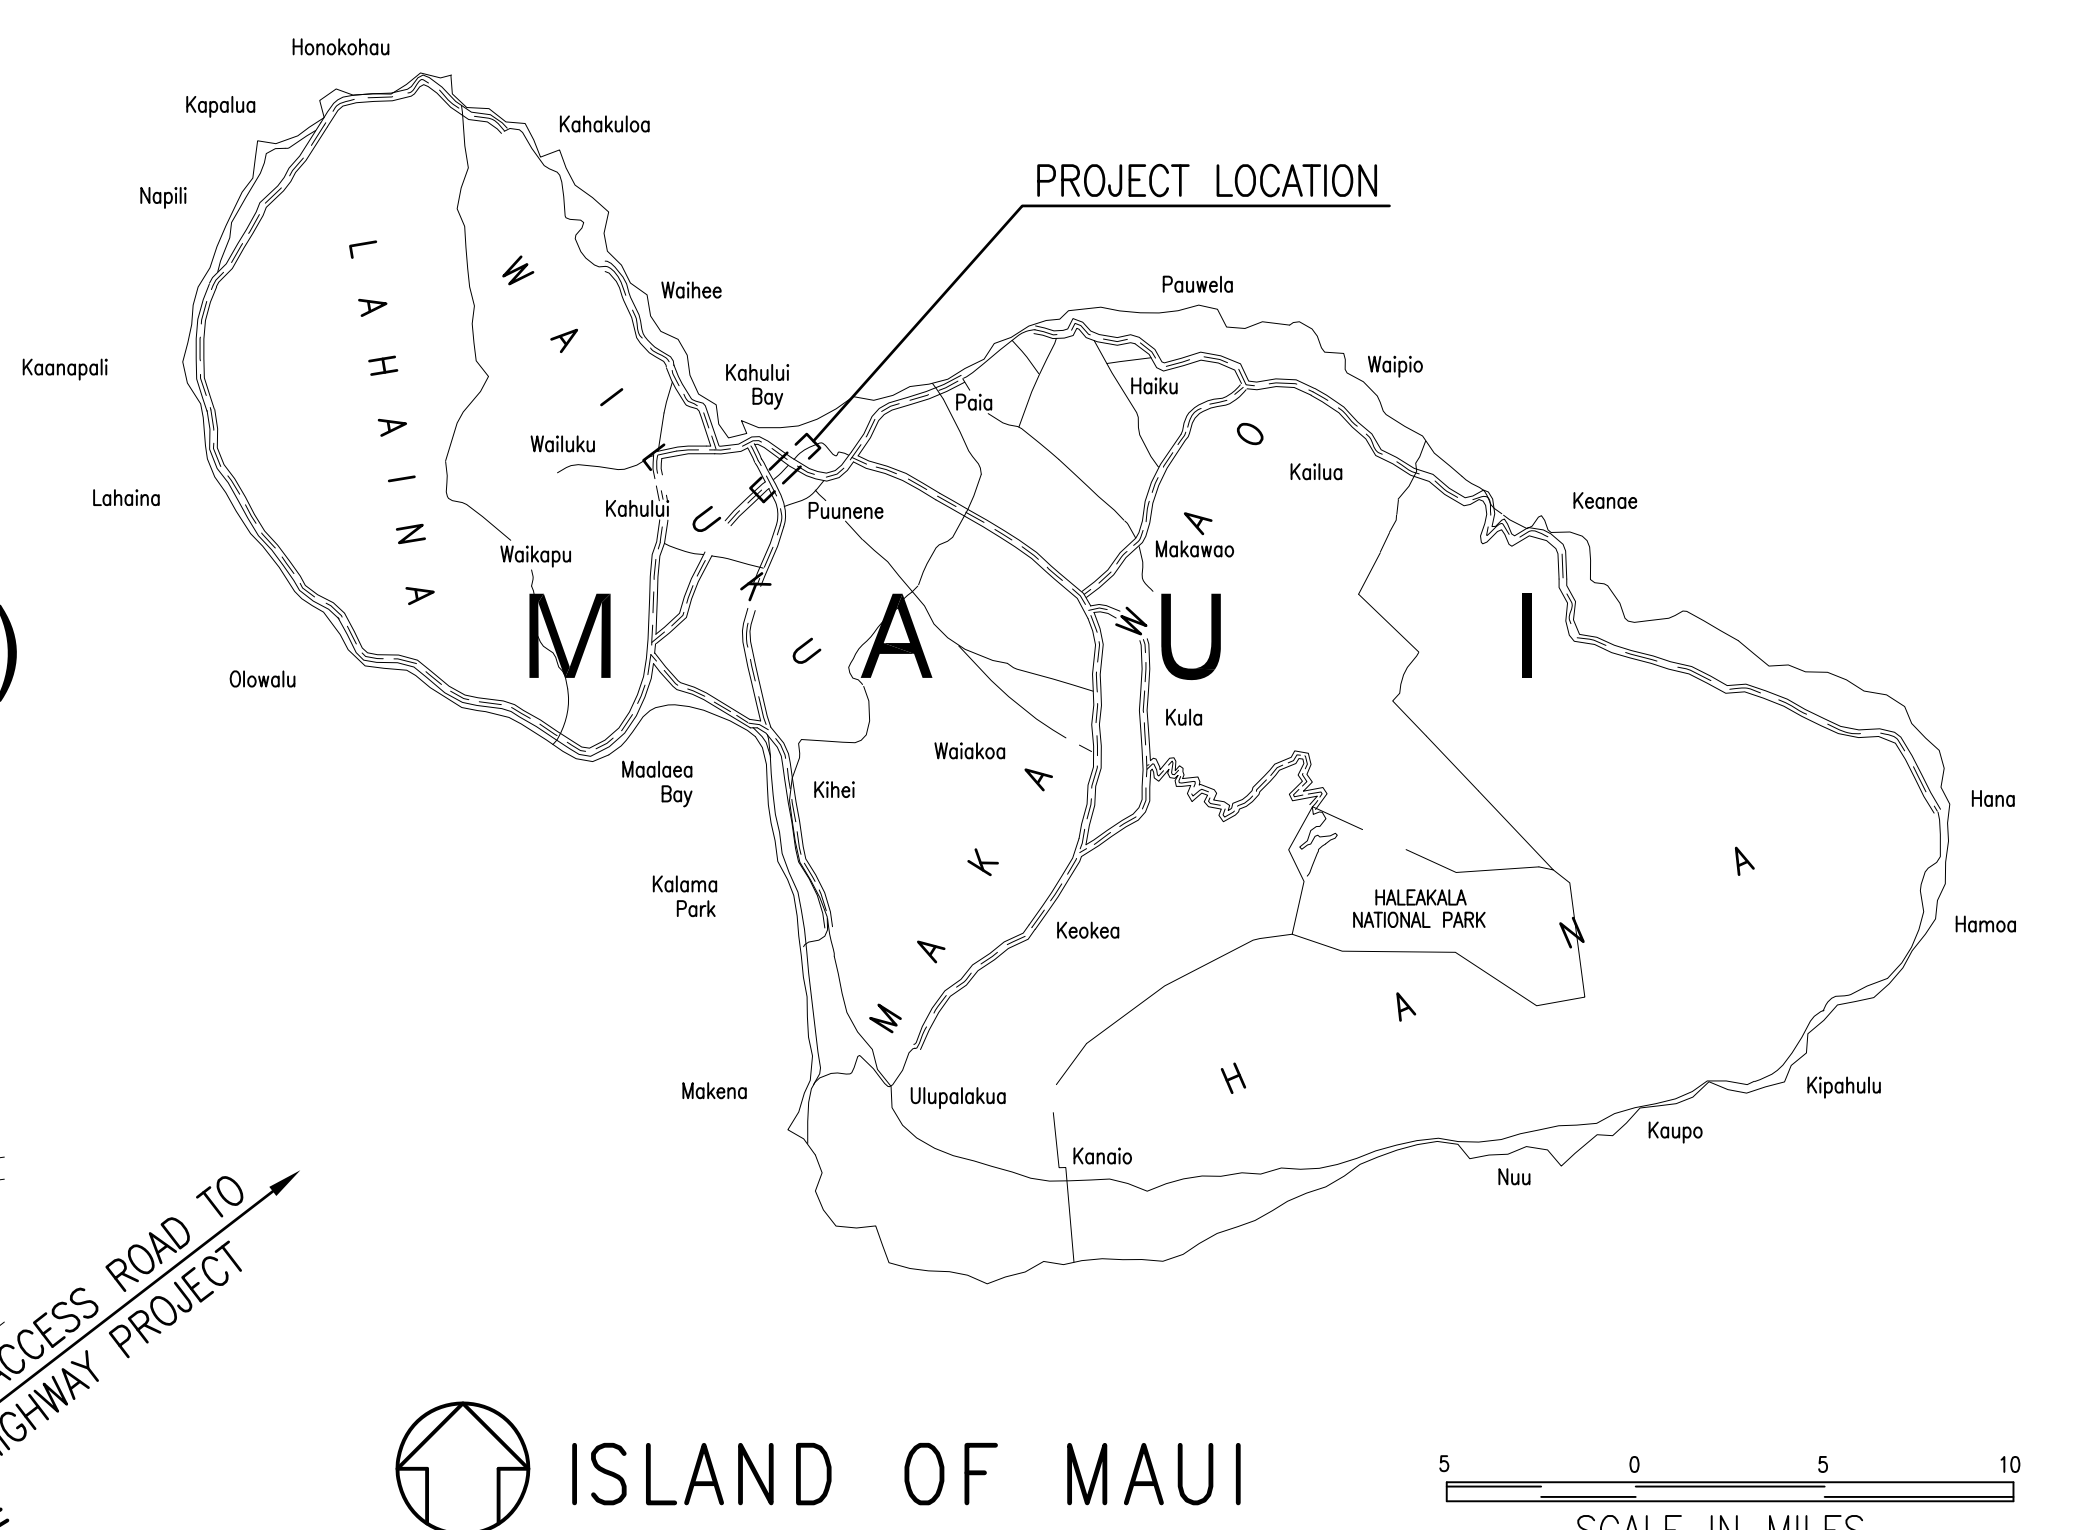

ISLAND OF MAUI



PROJECT LIMIT
HANA HWY. BL
STA. 49+03.98

PROJECT LIMIT
DAIRY ROAD BL
STA. 293+83.27

PROJECT LIMIT
HANA HWY. BL
STA. 70+16.38

PROJECT LIMIT
DAIRY ROAD BL
STA. 293+83.27

PH 1 ACCESS ROAD TO
KAHULUI AIRPORT
HANA HWY. BL STA. 11+53.52

END PROJECT
PH 1 ACCESS ROAD TO
KAHULUI AIRPORT
HANA HWY. BL STA. 58+48.10

PROJECT LIMITS

ACCESS ROAD BL STA. 1+30

BEGIN PROJECT
ACCESS ROAD BL STA. 1+30

CHANGES MADE DURING CONSTRUCTION HAVE BEEN INCORPORATED ON THESE PLANS EXCEPT CHANGES IN THE ORIGINAL THEORETICAL QUANTITIES. FOR ACTUAL QUANTITIES, REFER TO PROJECT LEDGER AND/OR COMPUTATION BOOK.

Amatunda

RESIDENT ENGINEER

2/27/2024

DATE

APPROVED:

for Robert Chan

DIRECTOR, DEPARTMENT OF WATER SUPPLY

COUNTY OF MAUI

(APPROVAL IS LIMITED TO WATER SYSTEM IMPROVEMENTS WHICH WILL BE DEDICATED TO THE DEPARTMENT OF WATER SUPPLY)

4/22/2024

DATE

DEPARTMENT OF TRANSPORTATION

STATE OF HAWAII

APPROVED:

for DIR. OF TRANSPORTATION

2/22/13

DATE

LAYOUT PLAN

NOT TO SCALE

LENGTH OF PROJECT...1.11 MILE

AS-BUILT DRAWINGS

1