


[illegible]

PLAN
SCALE: 1"=40'

THIS WORK WAS PREPARED BY ME
OR UNDER MY SUPERVISION.

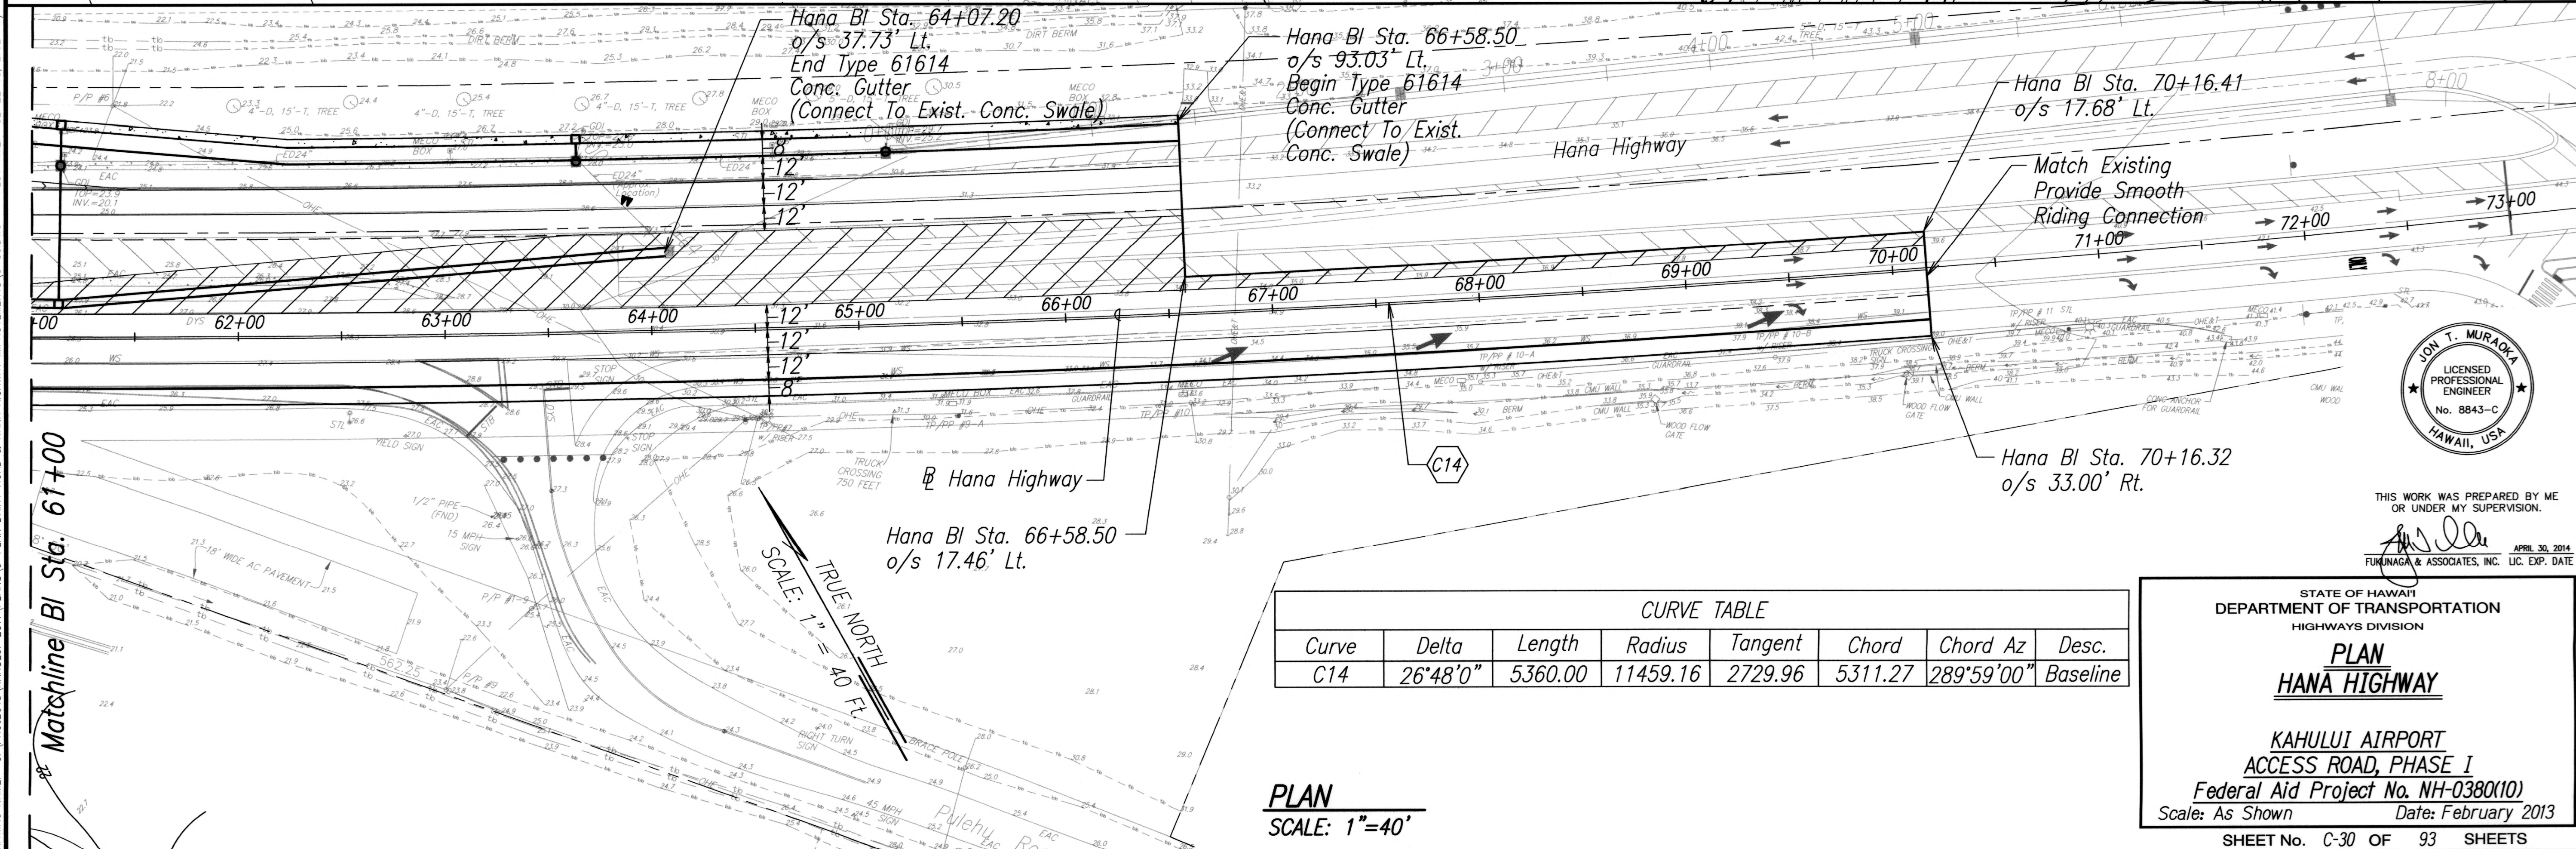

APRIL 30, 2014
UC. EXP. DATE

YUKUNAGA & ASSOCIATES, INC.