




CURVE TABLE							
Curve	Delta	Length	Radius	Tangent	Chord	Chord Az	Desc.
C13	14°0'0"	1221.73	5000.00	613.92	1218.69	238°45'00"	Baseline

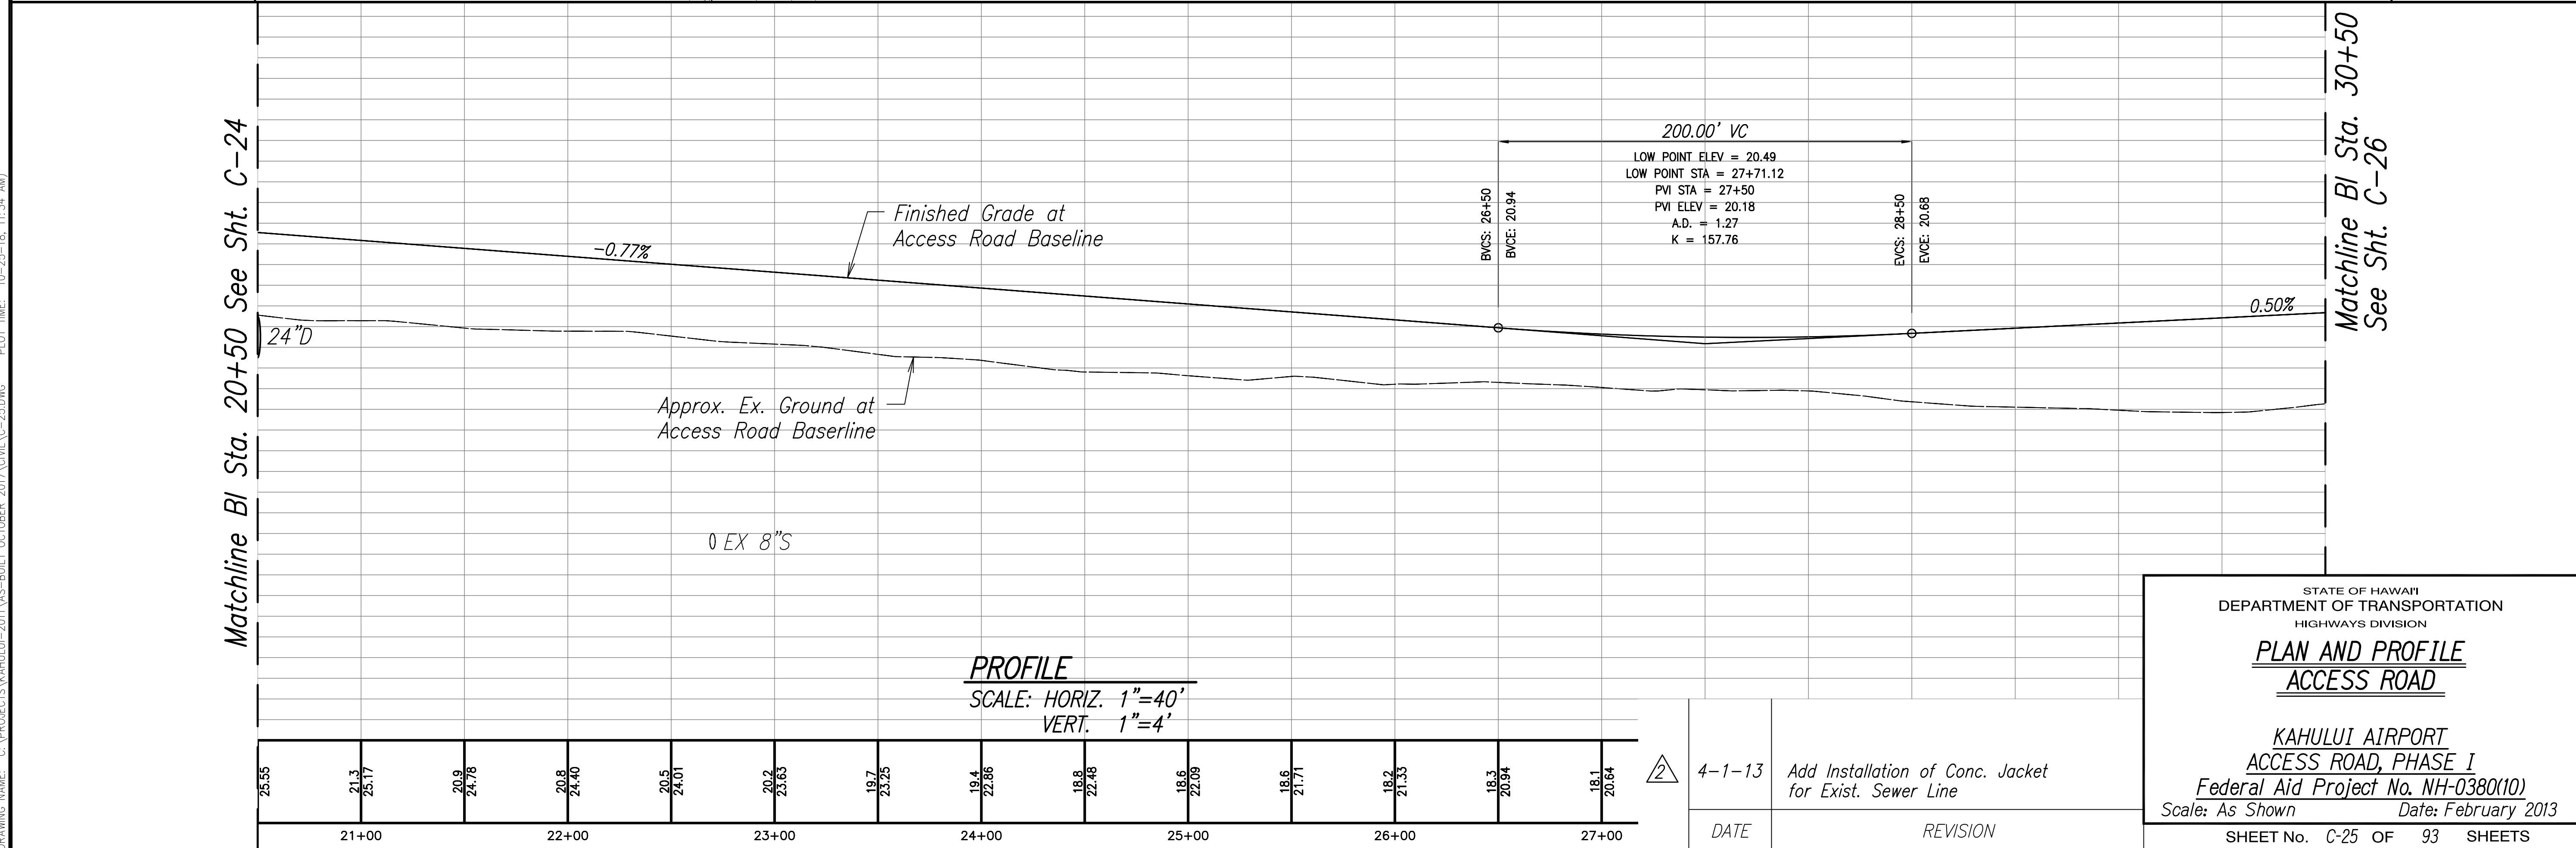

ADD. 38

AS-BUILT DRAWINGS

FED. ROAD DIST. NO.	STATE	FED. AID PROJ. NO.	FISCAL YEAR	SHEET NO.	TOTAL SHEETS
HAWAII	HAW.	NH-0380(10)	2013	40	166

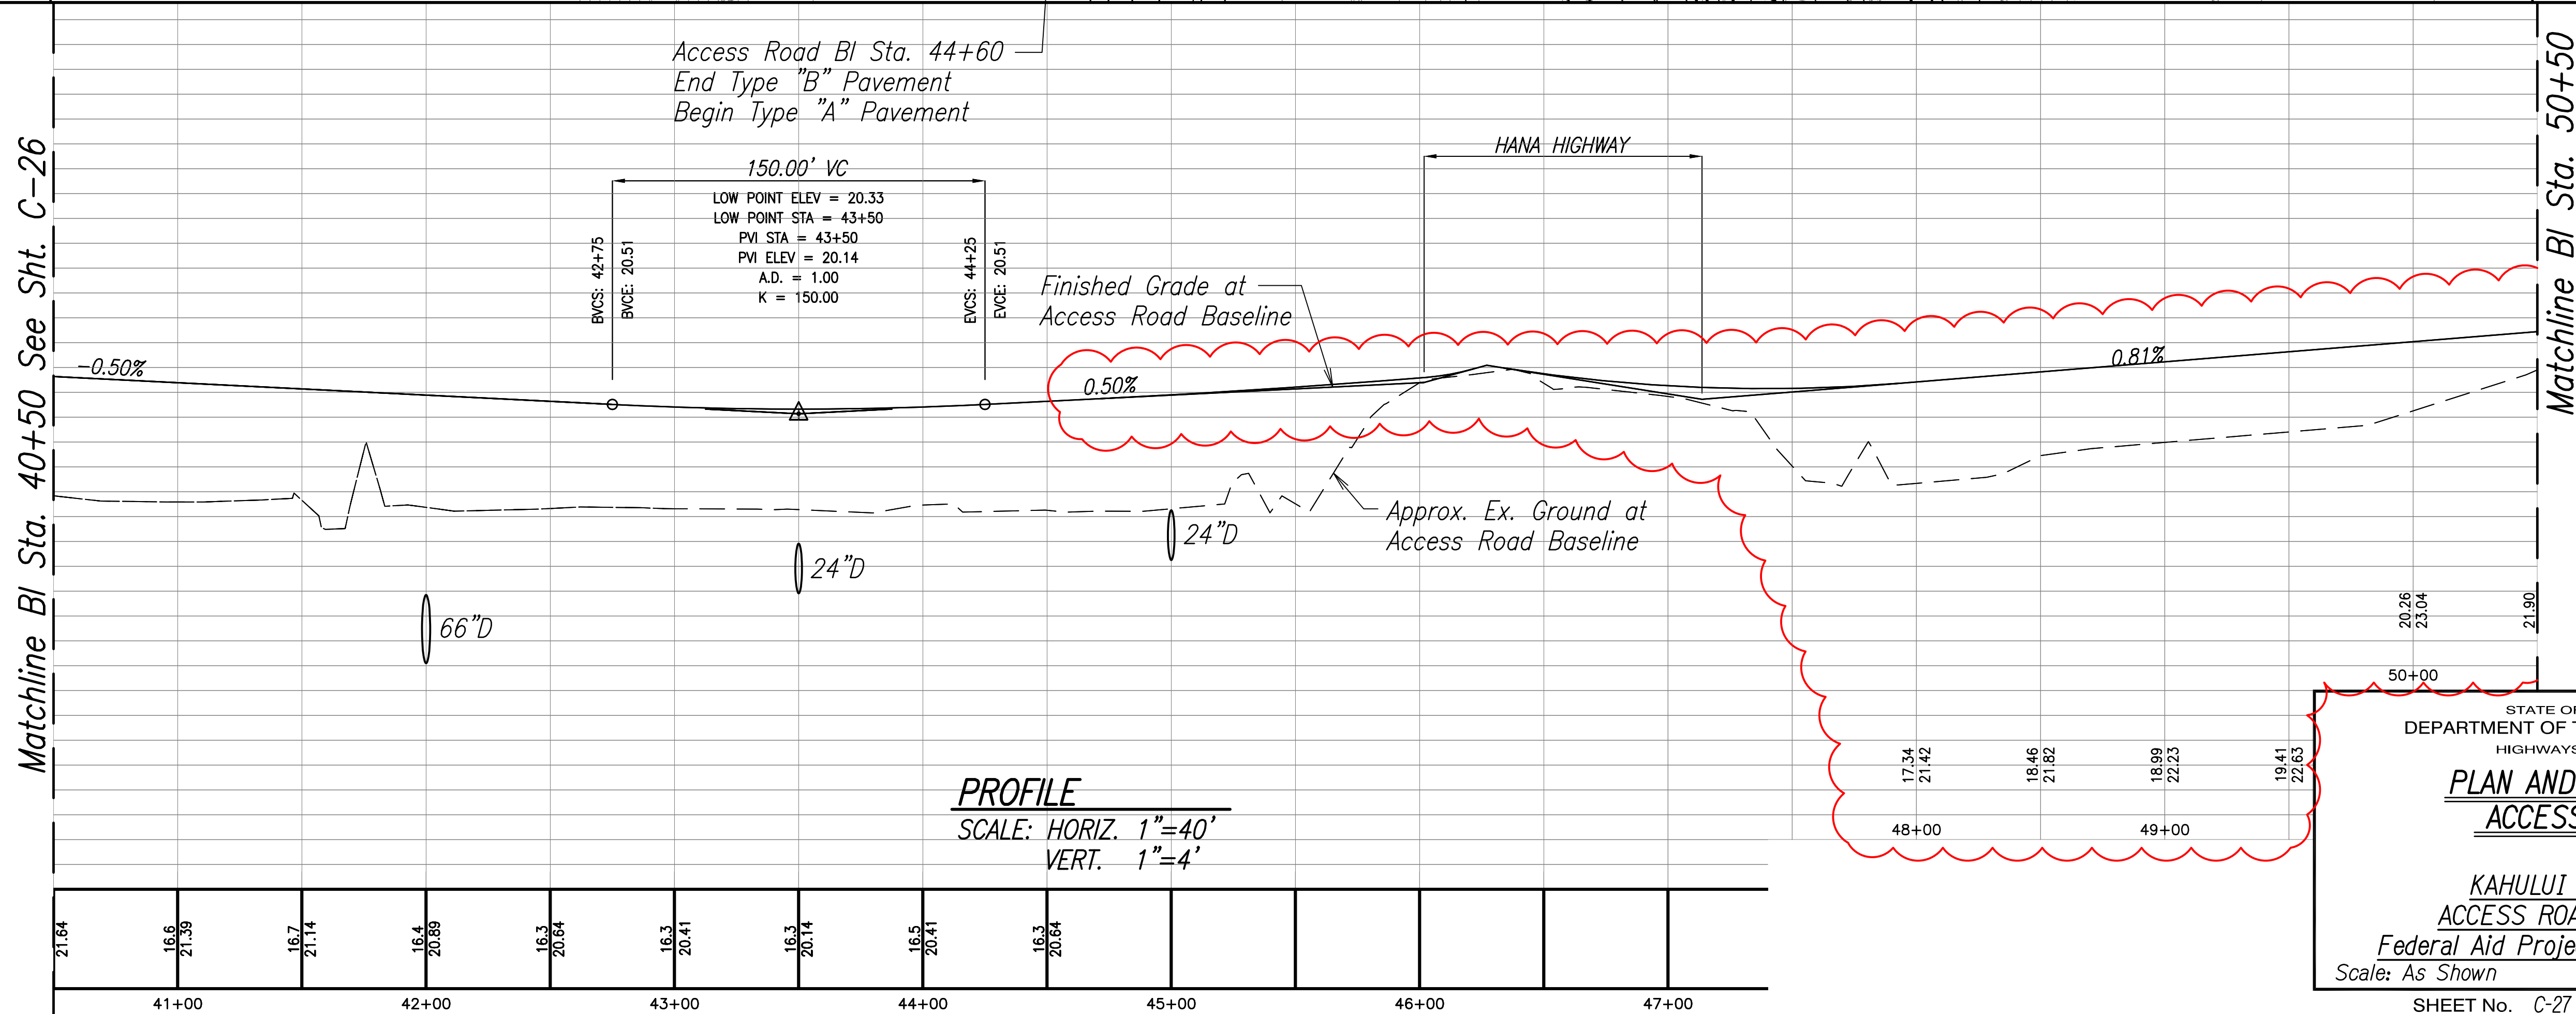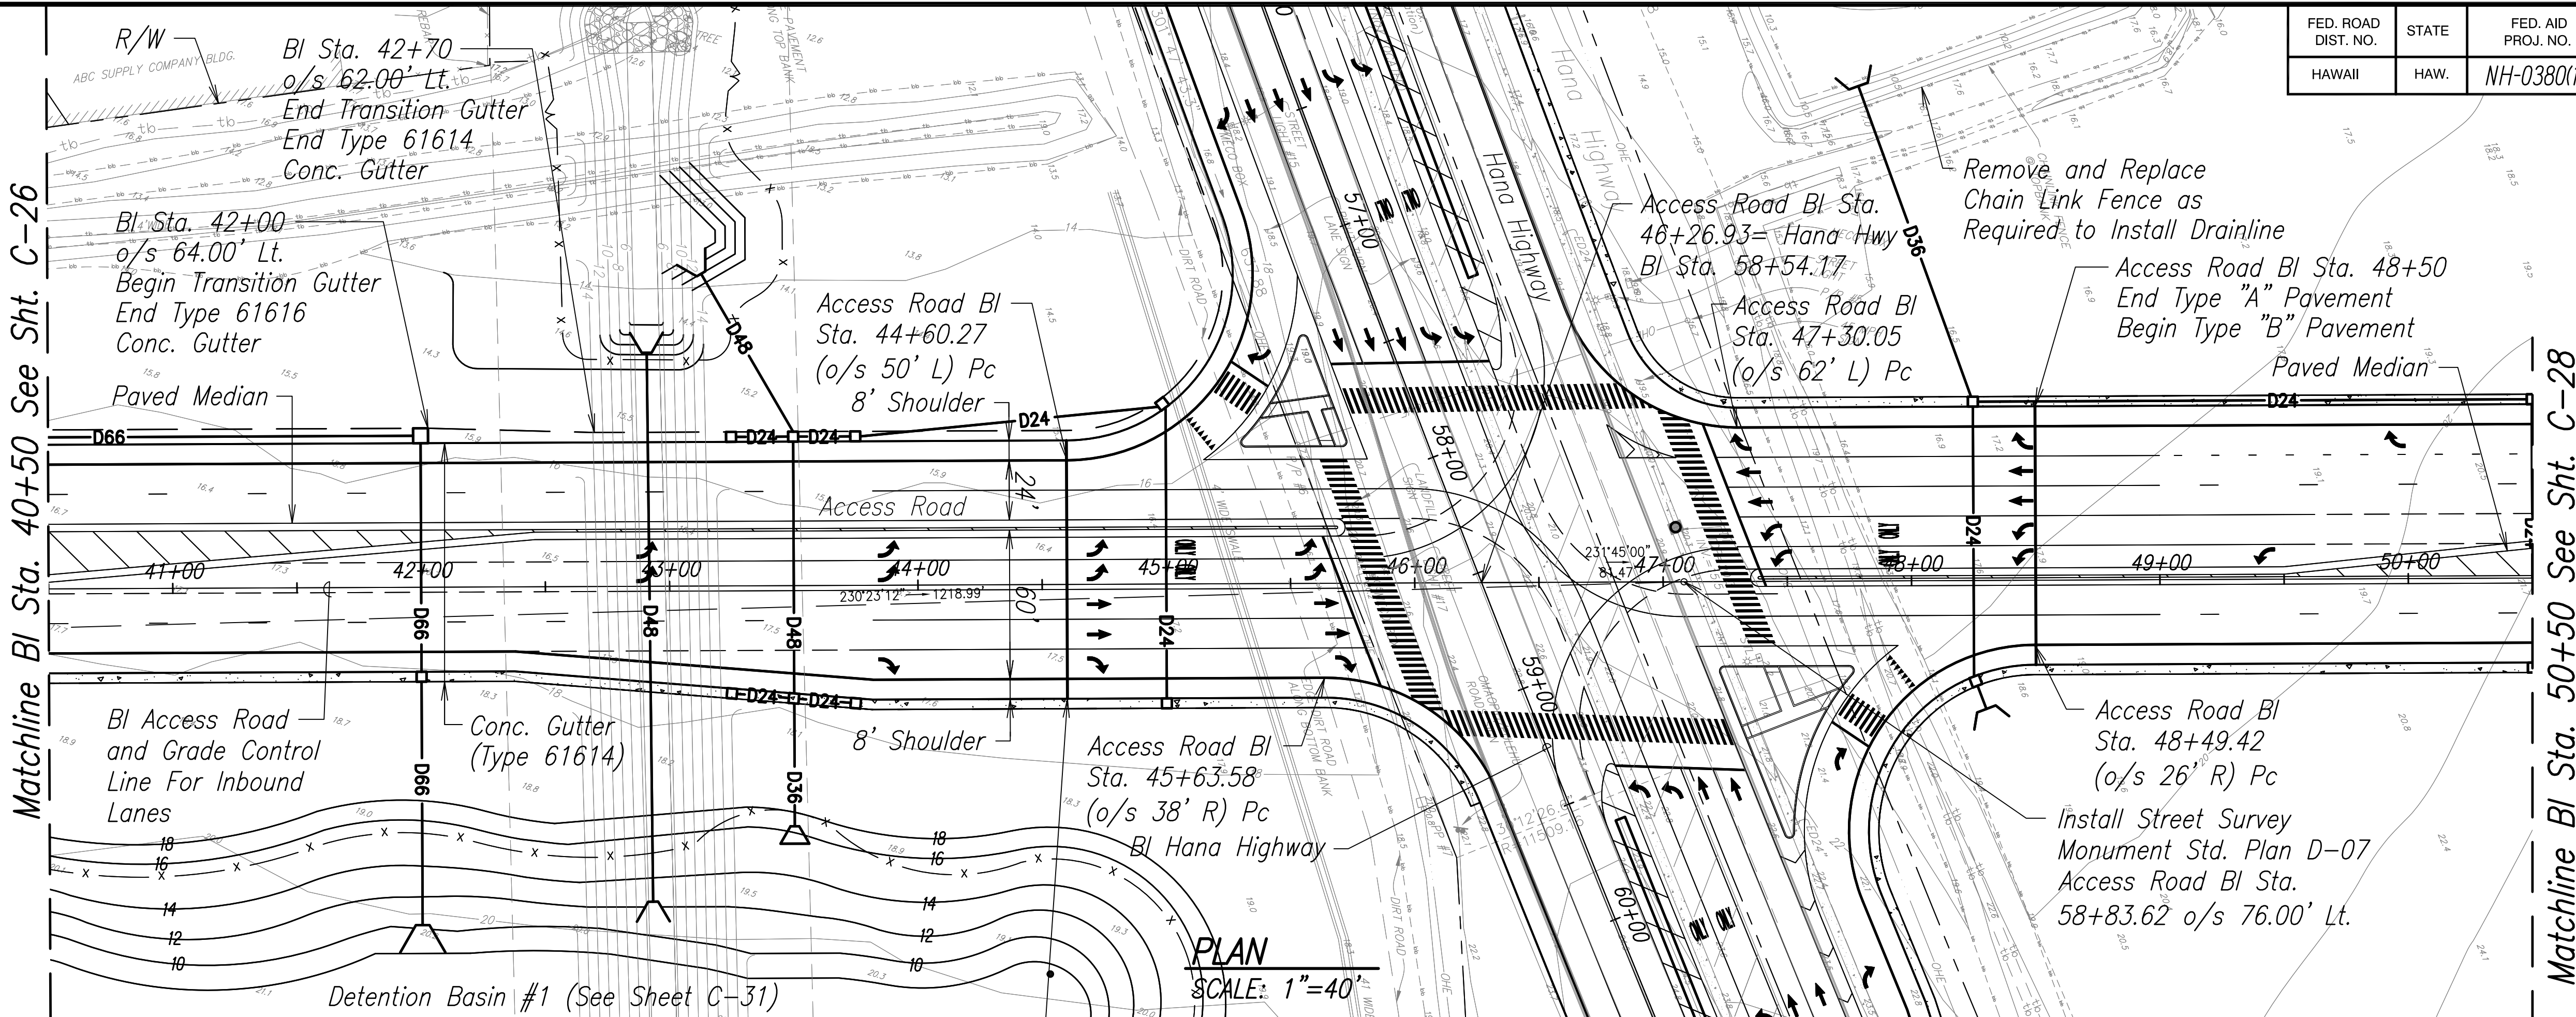


ORIGINAL PLAN	SURVEY PLOTTED BY	DATE
NOTE BOOK	DRAWN BY	
QUANTITIES BY	DESIGNED BY	
CHECKED BY	CHECKED BY	

DRAWING NAME: C:\PROJECTS\KAHULUI-2011\AS-BUILT OCTOBER 2017\CIVIL\G-27.DWG PLOT TIME: 10-25-18, 11:38 AM


"AS-BUILT"

FED. ROAD DIST. NO.	STATE	FED. AID PROJ. NO.	FISCAL YEAR	SHEET NO.	TOTAL SHEETS
HAWAII	HAW.	NH-0380(10)	2013	41	166

Matchline BI Sta. 50+50 See Sht. C-27

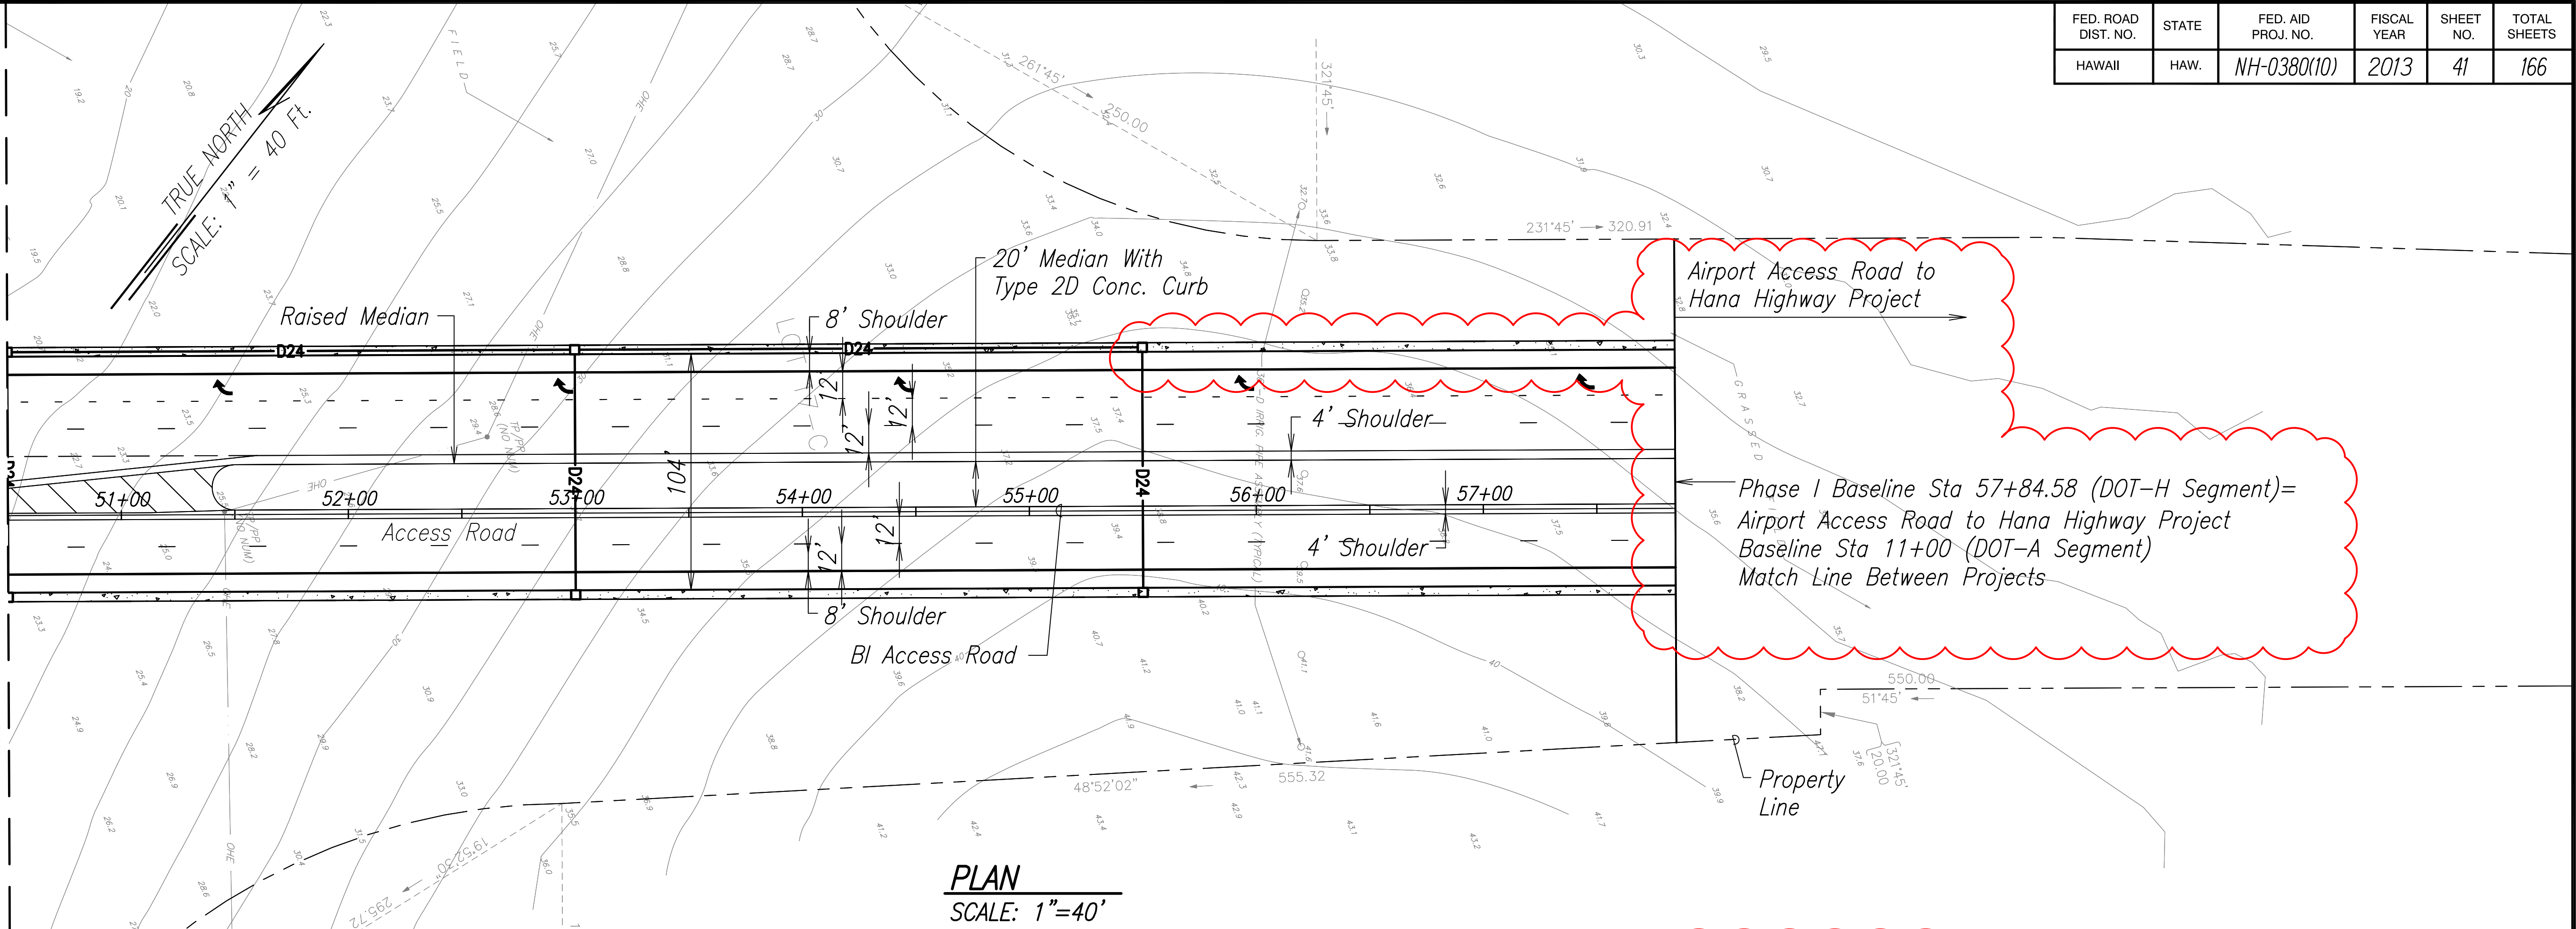

Matchline BI Sta. 50+50 See Sht. C-27

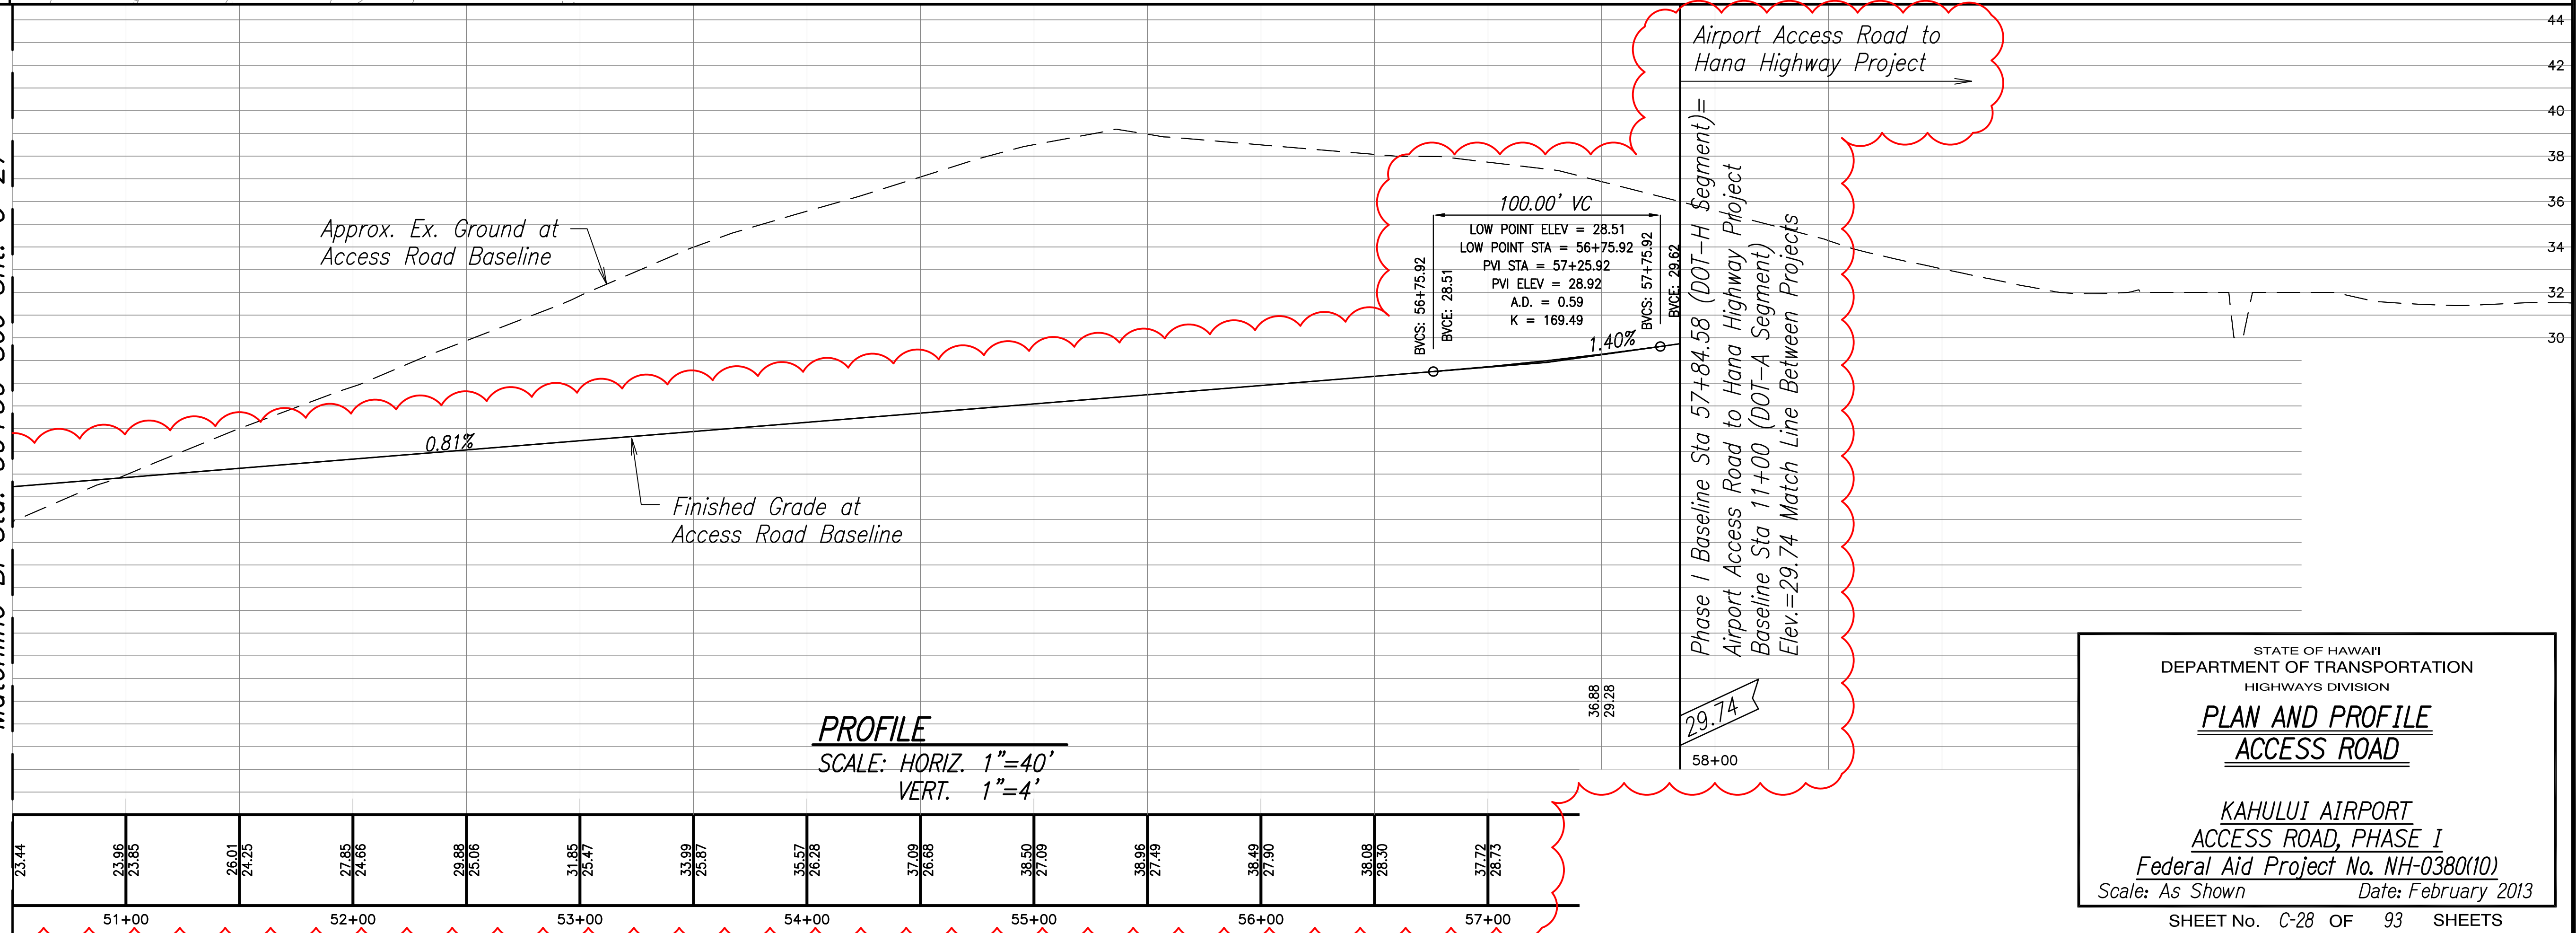

STATE OF HAWAII
DEPARTMENT OF TRANSPORTATION
HIGHWAYS DIVISION

**PLAN AND PROFILE
ACCESS ROAD**

KAHULUI AIRPORT
ACCESS ROAD, PHASE I
Federal Aid Project No. NH-0380(10)
Scale: As Shown Date: February 2013

SHEET No. C-28 OF 93 SHEETS

"AS-BUILT"