

FED. ROAD DIST. NO.	STATE	FED. AID PROJ. NO.	FISCAL YEAR	SHEET NO.	TOTAL SHEETS
HAWAII	HAW.	NH-0380(10)	2013	117	166

STRUCTURAL INDEX TO DRAWINGS

SHEET	DESCRIPTION	SHEET	DESCRIPTION
S0.1	Structural Index to Drawings	S4.1	Existing Precast GDI A-21 Demo Elevation
S0.2	Structural General Notes	S4.2	Precast GDI A-21 Elevation and Section
S0.3	Symbols and Abbreviations	S4.3	Precast GDI A-21 Sections
S1.1	Retaining Wall "A" Elevation	S5.1	Precast GDI A-21a Elevation and Section
S1.2	Retaining Wall Section and Schedule	S5.2	Precast GDI A-21a Sections
S1.2A	Typical Light Pole at Retaining Wall Sections		
S1.3	Typical Details		
S1.4	Added Reinforcing at Pipe Opening		
S2.1	Railing Plan and Section		
S2.2	Railing Section and Details		
S2.3	Railing Section and Details		
S2.4	Pedestrian Rail Elevations, Sections and Details		
S2.5	Type "A" End Post and Type "B" End Post		
S2.6	End Post Sections and Detail		
S3.1	Plan - Sta. 14+00 to 19+50		
S3.2	Plan - Sta. 19+50 to 24+00		
S3.3	Plan - Sta. 24+00 to 29+50		
S3.4	Plan - Sta. 29+50 to 33+50		
S3.5	Plan - Sta. 33+50 to 38+50		
S3.6	Plan - Sta. 38+50 to 42+50		
S3.7	Plan - Sta. 42+50 to 47+50		
S3.8	Plan - Sta. 47+50 to 55+50		
S3.9	Plan - Sta. 55+50 to 58+50		
S3.10	Pavement Jointing Details		
S3.11	Pavement Jointing Details		
S3.12	Pavement Jointing Details		

THIS WORK WAS PREPARED BY ME  
OR UNDER MY SUPERVISION.

APRIL 30, 2016  
LIC. EXP. DATE

KSF, INC.

STATE OF HAWAII  
DEPARTMENT OF TRANSPORTATION  
HIGHWAYS DIVISION

STRUCTURAL INDEX TO DRAWINGS

KAHULUI AIRPORT  
ACCESS ROAD, PHASE I  
Federal Aid Project No. NH-0380(10)  
Scale: None      Date: February 2013

SHEET No.  S01  OF  24  SHEETS

ORIGINAL PLAN	SURVEY PLOTTED BY	DATE
	DRAWN BY	
	TRACED BY	
	NOTE BOOK	
No.	DESIGNED BY	
	QUANTITIES BY	
	CHECKED BY	

DRAWING NAME: C:\PROJECTS\KAHULUI-2011\AS-BUILT OCTOBER 2017\STRUCTURAL\KAH-S001.DWG      PLOT TIME: 10-18-18, 11:47 AM)

"AS-BUILT"

AS-BUILT DRAWINGS



FED. ROAD DIST. NO.	STATE	FED. AID PROJ. NO.	FISCAL YEAR	SHEET NO.	TOTAL SHEETS
HAWAII	HAW.	NH-0380(10)	2013	118	166

STRUCTURAL GENERAL NOTES

1. General Specifications: Hawaii Department of Transportation, Standard Specifications for Road and Bridge Construction, 2005, together with Special Provisions prepared for this contract.
2. Design Specifications:
- (A) AASHTO 2010 LRFD Bridge Design Specifications (Fifth Edition) and its subsequent interim specifications with interim supplements and modifications by the Highways Division, Department of Transportation, State of Hawaii.
- (B) HDOT Memorandum dated October 20, 2010 with subject title "Design Criteria for Bridges and Structures".
- (C) Temporary shoring and falsework shall follow the AASHTO Guide Design Specification for Bridge Temporary Works.
3. Loads:
- (A) Live Load: AASHTO HL-93 Truck Loading
- (B) Railing Load: AASHTO TL-3 Loading
- (C) Seismic Loads: Acceleration coefficient - 0.28  
Seismic Performance Zone - 3  
Site Coefficient - Soil Profile Type II

4. Materials:
- (A) All concrete strengths shall be as noted below:

Item No.	Structural Parts	Classes of Concrete	Specified Compressive Strength, f'c (28 Days)
(1)	Retaining Walls	-	4000 PSI
(2)	Retaining Wall Foundations	-	4000 PSI
(3)	Railing	-	4000 PSI
(4)	Except as noted otherwise all others	A	3000 PSI

All concrete with the exception of Class A concrete shall have a maximum W/C Ratio of 0.45. The W/C Ratio for Class A Concrete shall follow the standard specifications.

- (B) All reinforcing steel shall be ASTM A 615 Grade 60 unless otherwise noted.
- (C) Reinforcing steel shall be ASTM A 706 where welded connections are required.
- (D) All structural steel shall be ASTM A 36 hot dip galvanized after fabrication, unless otherwise noted.
- (E) All bolts, anchor bolts, washers and nuts shall be ASTM A307 hot dip galvanized, unless otherwise specified.
- (F) A migrating corrosion inhibitor amine carboxylate water-based admixture shall be added to the concrete mix for concrete material 4 (A)(3). The minimum dosage shall be 1.5 pints per cubic yard of concrete. The admixture shall not affect the set time of the concrete.
- (G) All concrete in Items 4.(A)(1) and 4.(A)(3) shall a 128 ounces of BASF Master Life AS20 or Grace Eclipse Shrinkage Reducing Admixture per cubic yard of concrete.

4. Materials (Cont.):
- (H) All welding shall conform to AWS D1.5 Bridge Welding Code. Unless noted otherwise, all welding shall be shielded arc welding with E70 electrodes.
5. Reinforcement:
- (A) The minimum covering measured from the surface of the concrete to the face of any reinforcing bars shall be as follows, except as otherwise shown:
- (1) Retaining walls = 2"
- (2) Retaining Wall Footings  
A. Top bars = 2"  
B. Bottom bars = 3"
- (3) Concrete cast against and permanently exposed to earth = 3"
- (4) All others unless otherwise noted = 2".
- (B) Reinforcing bars shall be detailed in accordance with the latest edition of the A.C.I. Detailing Manual unless otherwise noted.
- (C) Minimum clear spacing between parallel bars shall be 1 1/2 times the diameter of bars (for non bundled bars). In no case shall the clear distance between the bars be less than 1 1/2 times the maximum size of the coarse aggregate.
- (D) All dimensions relating to reinforcing bars are to centers of bars unless otherwise noted.
- (E) Reinforcing bars shall be securely tied at all intersections and lap splices except where the spacing of intersections is less than one foot in each direction, in which case alternate intersections shall be tied.
6. Construction Notes:
- (A) See Standard Specifications and Special Provisions.
- (B) In general, railings shall be constructed to follow the roadway vertical and horizontal curves and superelevations.
- (C) Except as otherwise noted, all vertical dimensions are measured plumb.
- (D) The Contractor shall verify all site conditions. Conditions may differ from those shown.
- (E) The Contractor shall verify the location of all utility lines and notify the respective owners before commencing with excavation, and any temporary piling or sheeting.
- (F) The Contractor shall submit working drawings and calculations for the proposed bracing/falsework details needed to protect the existing structures from increases in the existing load due to equipment, cranes, vehicles and fresh concrete, etc. The drawings and calculations shall be stamped by a licensed Structural Engineer and a licensed Civil Engineer specializing in geotechnical engineering in the State of Hawai'i. The above work, including working drawings and calculations, shall be incidental to various Contract items. The drawings and calculations shall be found acceptable by the Engineer before any construction work is to proceed.
- (G) For concrete finish see Standard Specifications and Special Provisions.
- (H) Where specified that the concrete surface is to be roughened and cleaned the concrete shall be roughened to a full amplitude of 1/4 of an inch.

6. Construction Notes (Cont.):
- (J) Construction joints may be relocated or additional ones added subject to the approval of the Engineer.
- (K) Unless otherwise noted, all exposed concrete edges shall be Chamfered 3/4" x 3/4".
- (L) All footings shall bear on firm undisturbed soil.
7. General:
- (A) Items not specifically called out as a pay item shall not be paid for separately and shall be considered incidental to the various pay items.
- (B) Standard Plans refer to all structures in general, except for modifications as may be required for special conditions. For such modifications refer to the corresponding detailed drawings.
8. Foundation:
- (A) For Boring logs and other geotechnical information See foundation report by Hirata & Associates, Inc.
- (B) Design Soil / Rock Parameters:
- (1) Bearing pressure  
A. Extreme event limit state = 9000 psf  
B. Strength limit state = 5400 psf  
C. Service limit state = 3000 psf
- (2) Passive resistance  
A. Extreme event limit state = 450 pcf  
B. Strength limit state = 225 pcf
- (3) Coefficient of friction  
A. Extreme event limit state = 0.5  
B. Strength limit state = 0.4
- (4) Lateral earth pressure  
A. Active condition, level backfill = 40 pcf  
B. Active sloping backfill = 50 pcf  
C. At rest condition, level backfill = 55 pcf



THIS WORK WAS PREPARED BY ME OR UNDER MY SUPERVISION.  
APRIL 30, 2014  
LIC. EXP. DATE

STATE OF HAWAII DEPARTMENT OF TRANSPORTATION HIGHWAYS DIVISION	
<b>STRUCTURAL GENERAL NOTES</b>	
KAHULUI AIRPORT ACCESS ROAD, PHASE I Federal Aid Project No. NH-0380(10)	
Scale: None	Date: February 2013
SHEET No. 502 OF 24 SHEETS	



## SYMBOLS AND ABBREVIATIONS

FED. ROAD DIST. NO.	STATE	FED. AID PROJ. NO.	FISCAL YEAR	SHEET NO.	TOTAL SHEETS
HAWAII	HAW.	NH-0380(10)	2013	119	166

		HAWAII	HAW.	NH-0380(10)	2013	119	166		
&	And	Dim.	Dimension	GRP	Grouted Rubble Pavement	PCC	Portland Cement Concrete	Struct.	Structure
@	At	Dist.	Distance			PC	Point of Curvature	SE	Super Elevation
∅	Diameter	DO	Ditto	Ht.	Height	PCF	Pounds per Cubic Foot	Symm.	Symmetrical
≥	Greater Than or Equal to	Dwls.	Dowels	(H)	Hinge	P(e)	Effective Prestress Force		
≤	Less Than or Equal to	Dn.	Down	Horiz., H	Horizontal		After All Losses		
#	Number	DbI.	Double	HDOT	State of Hawaii Department of Transportation	PPM	Parts Per Million	Tan.	Tangent
		DI	Drain Inlet, Ductile Iron			PSF	Pounds per Square Foot	TC	Continuity Tendons
Abut.	Abutment	Dwg., Dwgs.	Drawing, Drawings	HDPE	High Density Polyethylene	PSI, psi	Pounds per Square Inch	Temp.	Temporary
Abbr.	Abbreviation	DS	Drilled Shaft	HS	High strength	PLF	Pounds per Linear Foot	TD	Deck Tendon
Add.	Additional			HECO	Hawaiian Electric Company	PI	Point of Intersection	Thk.	Thick
Alt.	Alternate	E	East				of Tangents	T	Top
AB	Anchor Bolt	EA, Ea., ea.	Each	IB	Inbound	PIVC	Point of Intersection of Vertical Curve	T&B	Top and Bottom
AC	Asphaltic Concrete	EF	Each Face	In.	Inch			TCE	Top of Column
Approx.	Approximate	EFH	Each Face Horizontal	ID	Inside Diameter	PT	Point of Tangency		(and Bent Cap Soffit) Elevation
Az.	Azimuth	EFV	Each Face Vertical	IF	Inside Face	Pt., Pts.	Point, Points	TOD	Top of Deck
		EW	Each Way	Int.	Interior	PRC	Point of Reverse Curvature	TOP	Top of Pier
		EPE	Existing Edge of Pavement	Inv.	Invert	PVC	Polyvinyl Chloride	TFE	Top of Footing Elevation
Bk.	Back	EPS	Expanded Polystyrene			Prestr.	Prestressed	Tot.	Total
Bal.	Balance	ES	Edge of Shoulder	Jt.	Joint	P/S	Prestressed Strands	Transv.	Transverse
ℙ	Baseline	Elec.	Electrical			PB	Pull Box	TS	Structural Tubing
Bm.	Beam	EMH	Electrical Manhole	K	Kips			TSS	Tendon For Girder in Simply Supported Condition
Brg., Brgs.	Bearing, Bearings	El., Elev.	Elevation	KF	Kip Foot	Rad., R	Radius	Typ.	Typical
BVC	Beginning of Vertical Curve	Emb.	Embankment	KSF	Kips Per Square Foot	RF	Rear Face		
Bet.	Between	EVC	End of Vertical Curve	KSI	Kips Per Square Inch	Rebar	Reinforcing Bar		
BF	Both Faces	Eq.	Equal	KLF	Kips Per Linear Foot	Ref.	Reference	Undergrd.	Underground
BW	Both Ways	Est.	Estimated			Reinf.	Reinforced, Reinforcing, Reinforcement	Var.	Varies
BFE	Bottom of Footing Elevation	Exc.	Excavation	L	Length			Vert., V	Vertical
Bot., Bott., B	Bottom	Excl.	Excluding	lb., lbs., LBS.	Pound, Pounds	Req'd.	Required	VC	Vertical Curve
BOF	Bottom of Footing	Exist., Ex.	Existing	Ltg. Std.	Lighting Standard	Ret.	Retaining		
Br.	Bridge	Exp., (E)	Expansion	LF, Lin. Ft.	Linear Feet/Foot	ROW	Right of Way		
Bit.	Bolt	EJ	Expansion Joint	LS	Lump Sum	Rdwy.	Roadway	W/C	Water/Cement
		Ext.	Exterior	Longit.	Longitudinal			w/	With
						Sect.	Section	W	West
Cant.	Cantilever	(F)	Fixed	M	Modified	SRW	Segmental Retaining Wall	WWF	Welded Wire Fabric
CIP	Cast Iron Pipe	FA	Force account	MH	Manhole	Sht.	Sheet	WW	Wingwall
℄	Center line	FB	Flat Bar	Max.	Maximum	Sim.	Similar	WP	Work Point, Working Point
CG	Center of Gravity	FC	Compression Stresses	Mech.	Mechanical	Sl.	Slope	WS	Water Surface
cc	Center to Center	f'c	Specified Compressive Strength	Min.	Minimum	S	South		
Cl.	Class		of Concrete at 28 days	Misc.	Miscellaneous	Sp., Spg.	Spaces, Spacing	Yr.	Year
Clr.	Clearance	f'ci	Specified Compressive Strength of Concrete at Time of Initial	MPH	Miles Per Hour	Sprd.	Spread		
CO	Clean Out					Spec.	Specification		
Col.	Column	FF	Prestress Far Face. Front Face	NF	Near Face	SF	Square Feet		
Conc.	Concrete	Fig.	Figure	N	North	SY	Square Yard		
CBW	Concrete Barrier Wall	Fin. Gr.	Finish Grade	NIC	Not in Contract	SS	Stainless Steel		
CMU	Concrete Masonry Unit	FRP	Fiberglass Reinforced Plastic	No.	Number	Std.	Standard		
Conn.	Connection	FT	Tensile Stresses	NTS	Not to Scale	Sta.	Station		
Const.	Construction	Ftg.	Footing			Stiff.	Stiffener		
CJ	Construction Joint	Ft.	Feet, Foot	O/S	Offset	Stirr.	Stirrup		
Cntl. Jt.	Control Joint			oc	On Center	Stl.	Steel		
CLSM	Controlled Low Strength Material	Ga.	Gage, Gauge	Opn'g	Opening	Str.	Straight		
		Galv.	Galvanized	OB	Outbound				
Cont.	Continuous	G, Gir.	Girder	OD	Outside Diameter				
CSL	Cross Hole Sonic Loggin	GDI	Grated Drain Inlet	OG	Outside Girder,				
CF	Cubic Feet	GFRP	Glass Fiber Reinforced		Outbound Girder				
CY, Cu. Yd.	Cubic Yard		Polymer Rebar						
		Gr.	Grade	Perf.	Perforated				
Det.	Detail	Grd.	Ground	PL	Plate				
Dia.	Diameter								
Diaph.	Diaphragm								

Calvin T. Miyahara

LICENSED PROFESSIONAL ENGINEER

NO. 8133-S

HAWAII, U.S.A.

</div>

THIS WORK WAS PREPARED BY ME OR UNDER MY SUPERVISION.

APRIL 30, 2014

LIC. EXP. DATE

Chen My

KSF, INC.

STATE OF HAWAII

DEPARTMENT OF TRANSPORTATION

HIGHWAYS DIVISION

**SYMBOLS AND ABBREVIATIONS**

KAHULUI AIRPORT

ACCESS ROAD, PHASE I


Federal Aid Project No. NH-0380(10)

Scale: None

Date: February 2013



THIS WORK WAS PREPARED BY ME  
OR UNDER MY SUPERVISION.

  
\_\_\_\_\_  
KSF, INC.

APRIL 30, 2014  
LIC. EXP. DATE

STATE OF HAWAII  
DEPARTMENT OF TRANSPORTATION  
HIGHWAYS DIVISION

**SYMBOLS AND ABBREVIATIONS**

KAHULUI AIRPORT  
ACCESS ROAD, PHASE I  
Federal Aid Project No. NH-0380(10)


Scale: None Date: February 2013

SHEET No. 503 OF 24 SHEETS



FED. ROAD DIST. NO.	STATE	FED. AID PROJ. NO.	FISCAL YEAR	SHEET NO.	TOTAL SHEETS
HAWAII	HAW.	NH-0380(10)	2013	C.O. 120	166

- NOTES:
- See sheet S1.2 for retaining wall details.
  - Wall and railing control joints shall be located a maximum at 25'-0" oc unless otherwise noted.
  - Retaining wall joints and railing expansion joints shall be located between the same two adjacent railing posts. Submit joint layout to Engineer for approval.
  - Steps in footing shall be located at a wall control joint.

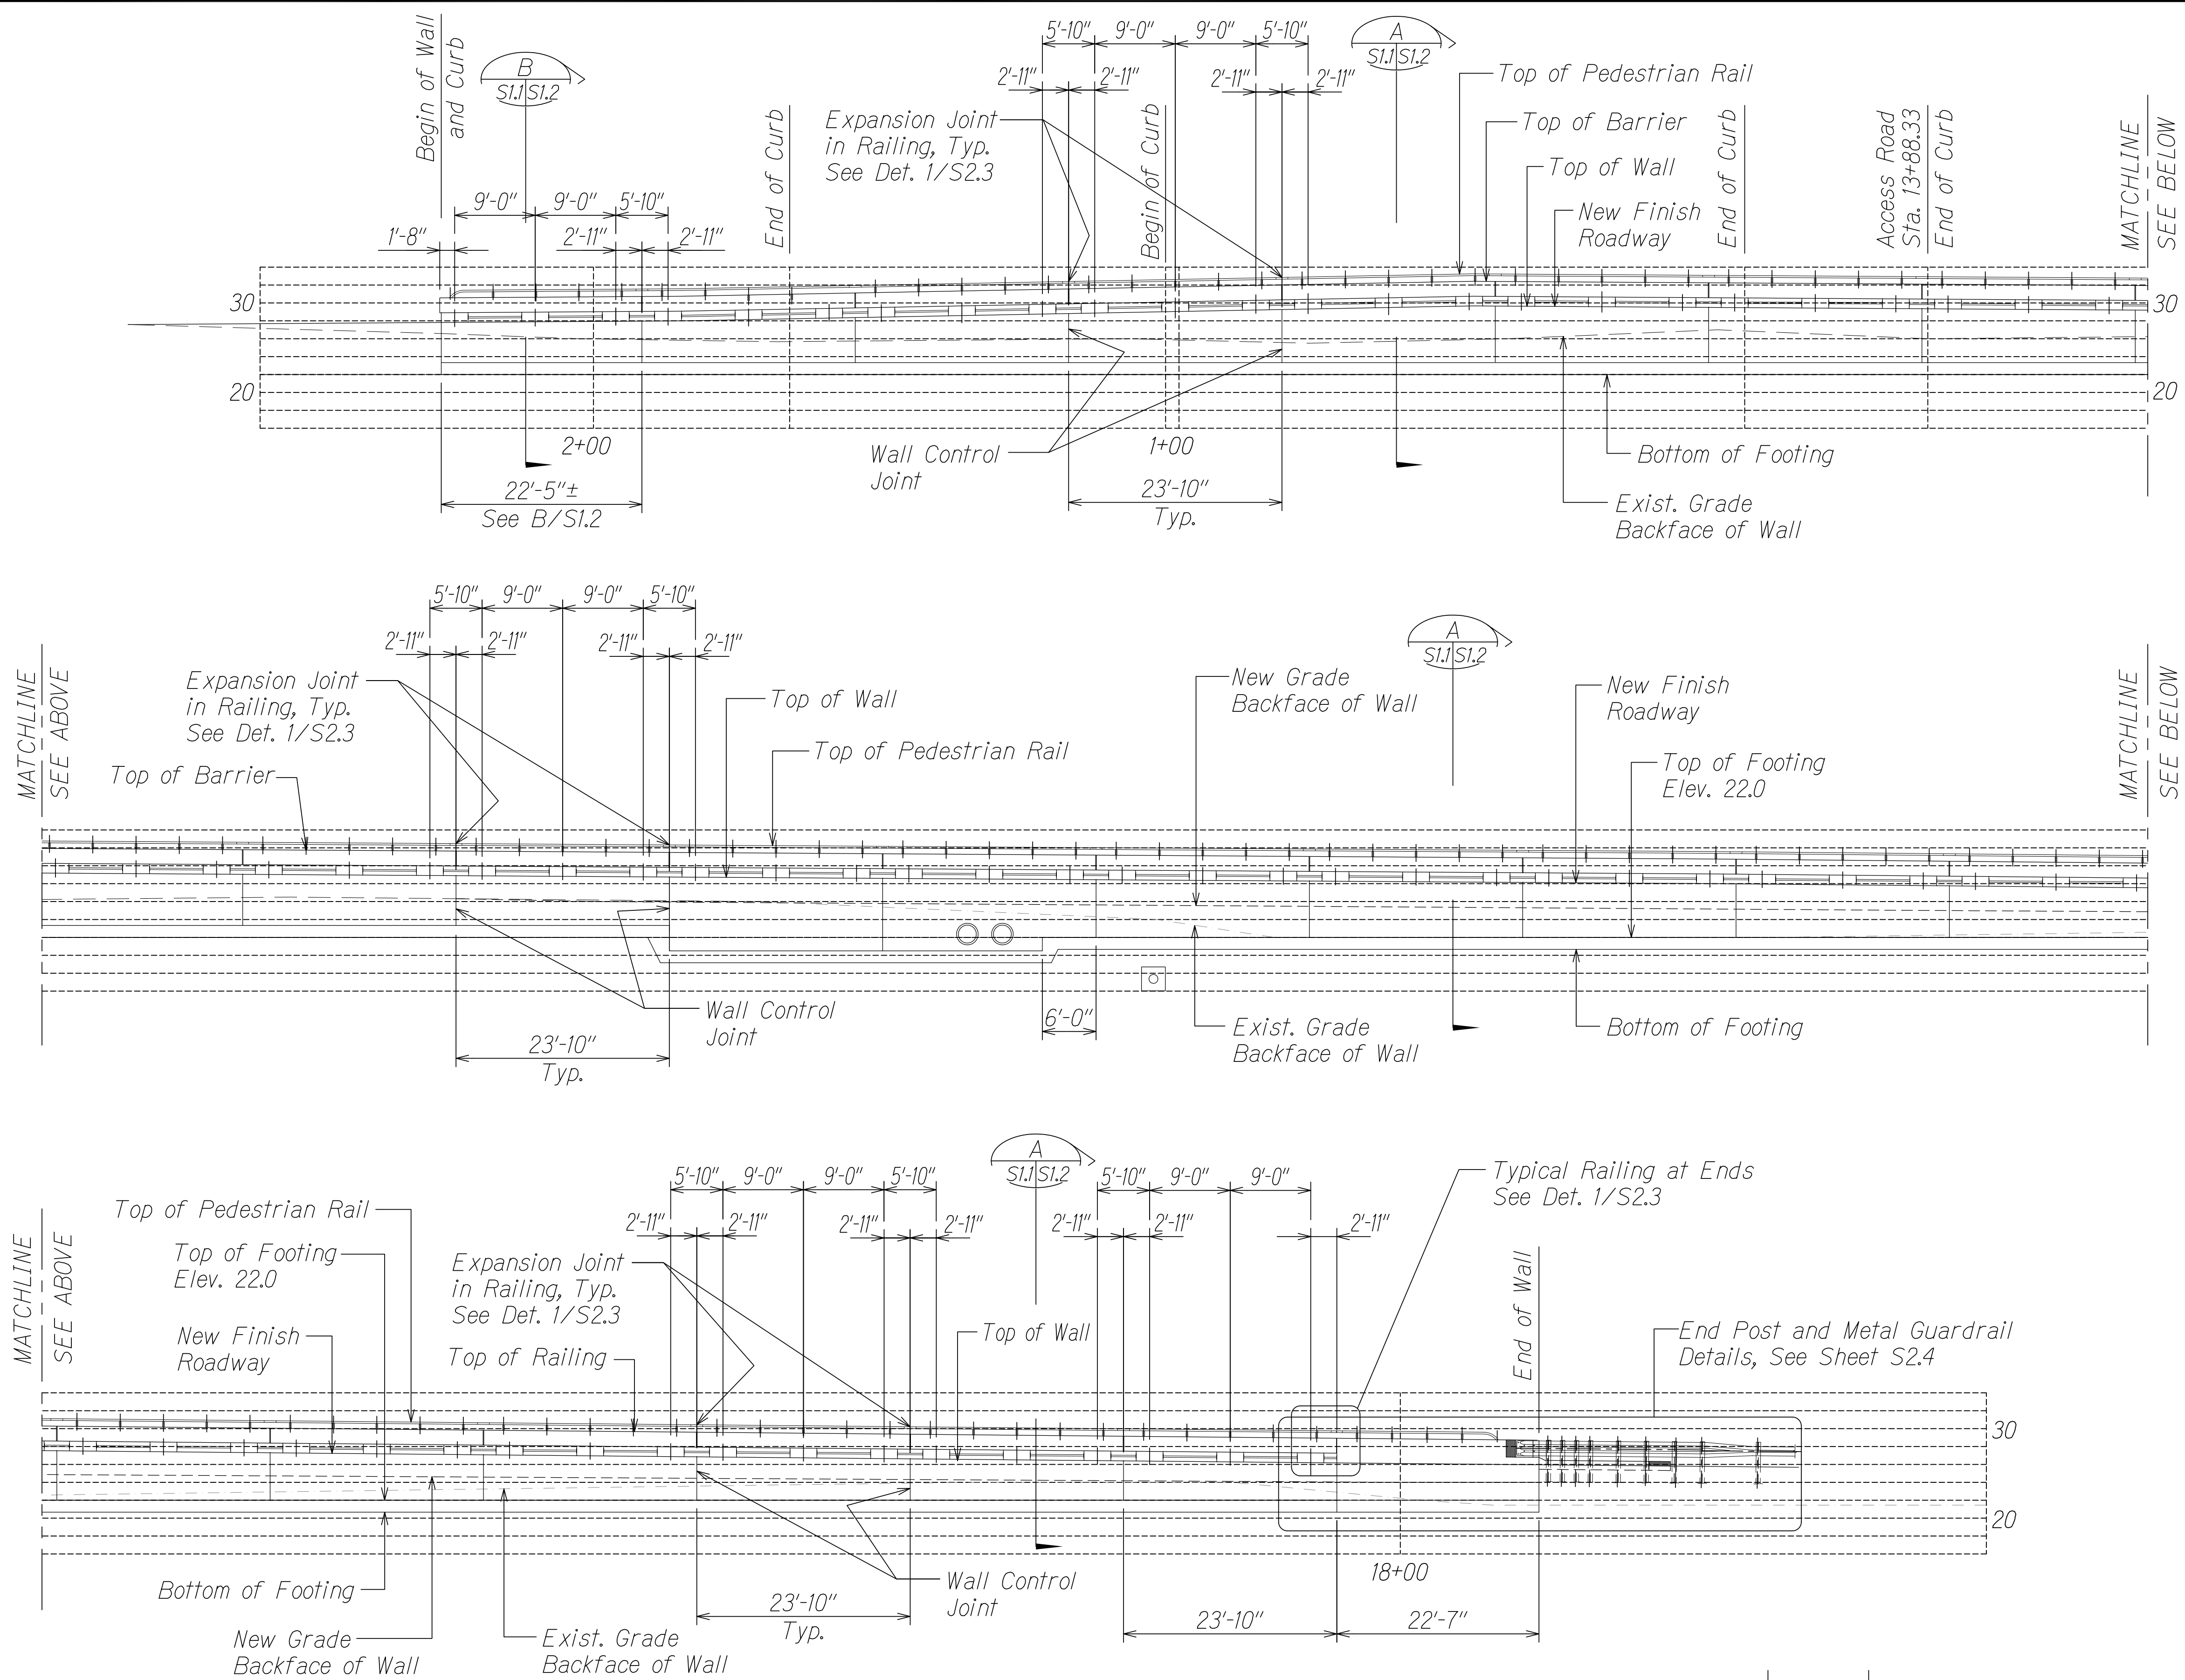

RETAINING WALL "A" ELEVATION  
Scale: 1" = 10'-0"

DATE	REVISION
8/11/14	Revised Elevation
6/26/14	Revised Elevation

STATE OF HAWAII  
DEPARTMENT OF TRANSPORTATION  
HIGHWAYS DIVISION


RETAINING WALL "A" ELEVATION

KAHULUI AIRPORT  
ACCESS ROAD, PHASE I  
Federal Aid Project No. NH-0380(10)  
Scale: As Shown Date: February 2013


SHEET No. S1.1 OF 24 SHEETS



FED. ROAD DIST. NO.	STATE	FED. AID PROJ. NO.	FISCAL YEAR	SHEET NO.	TOTAL SHEETS
HAWAII	HAW.	NH-0380(10)	2013	121	166

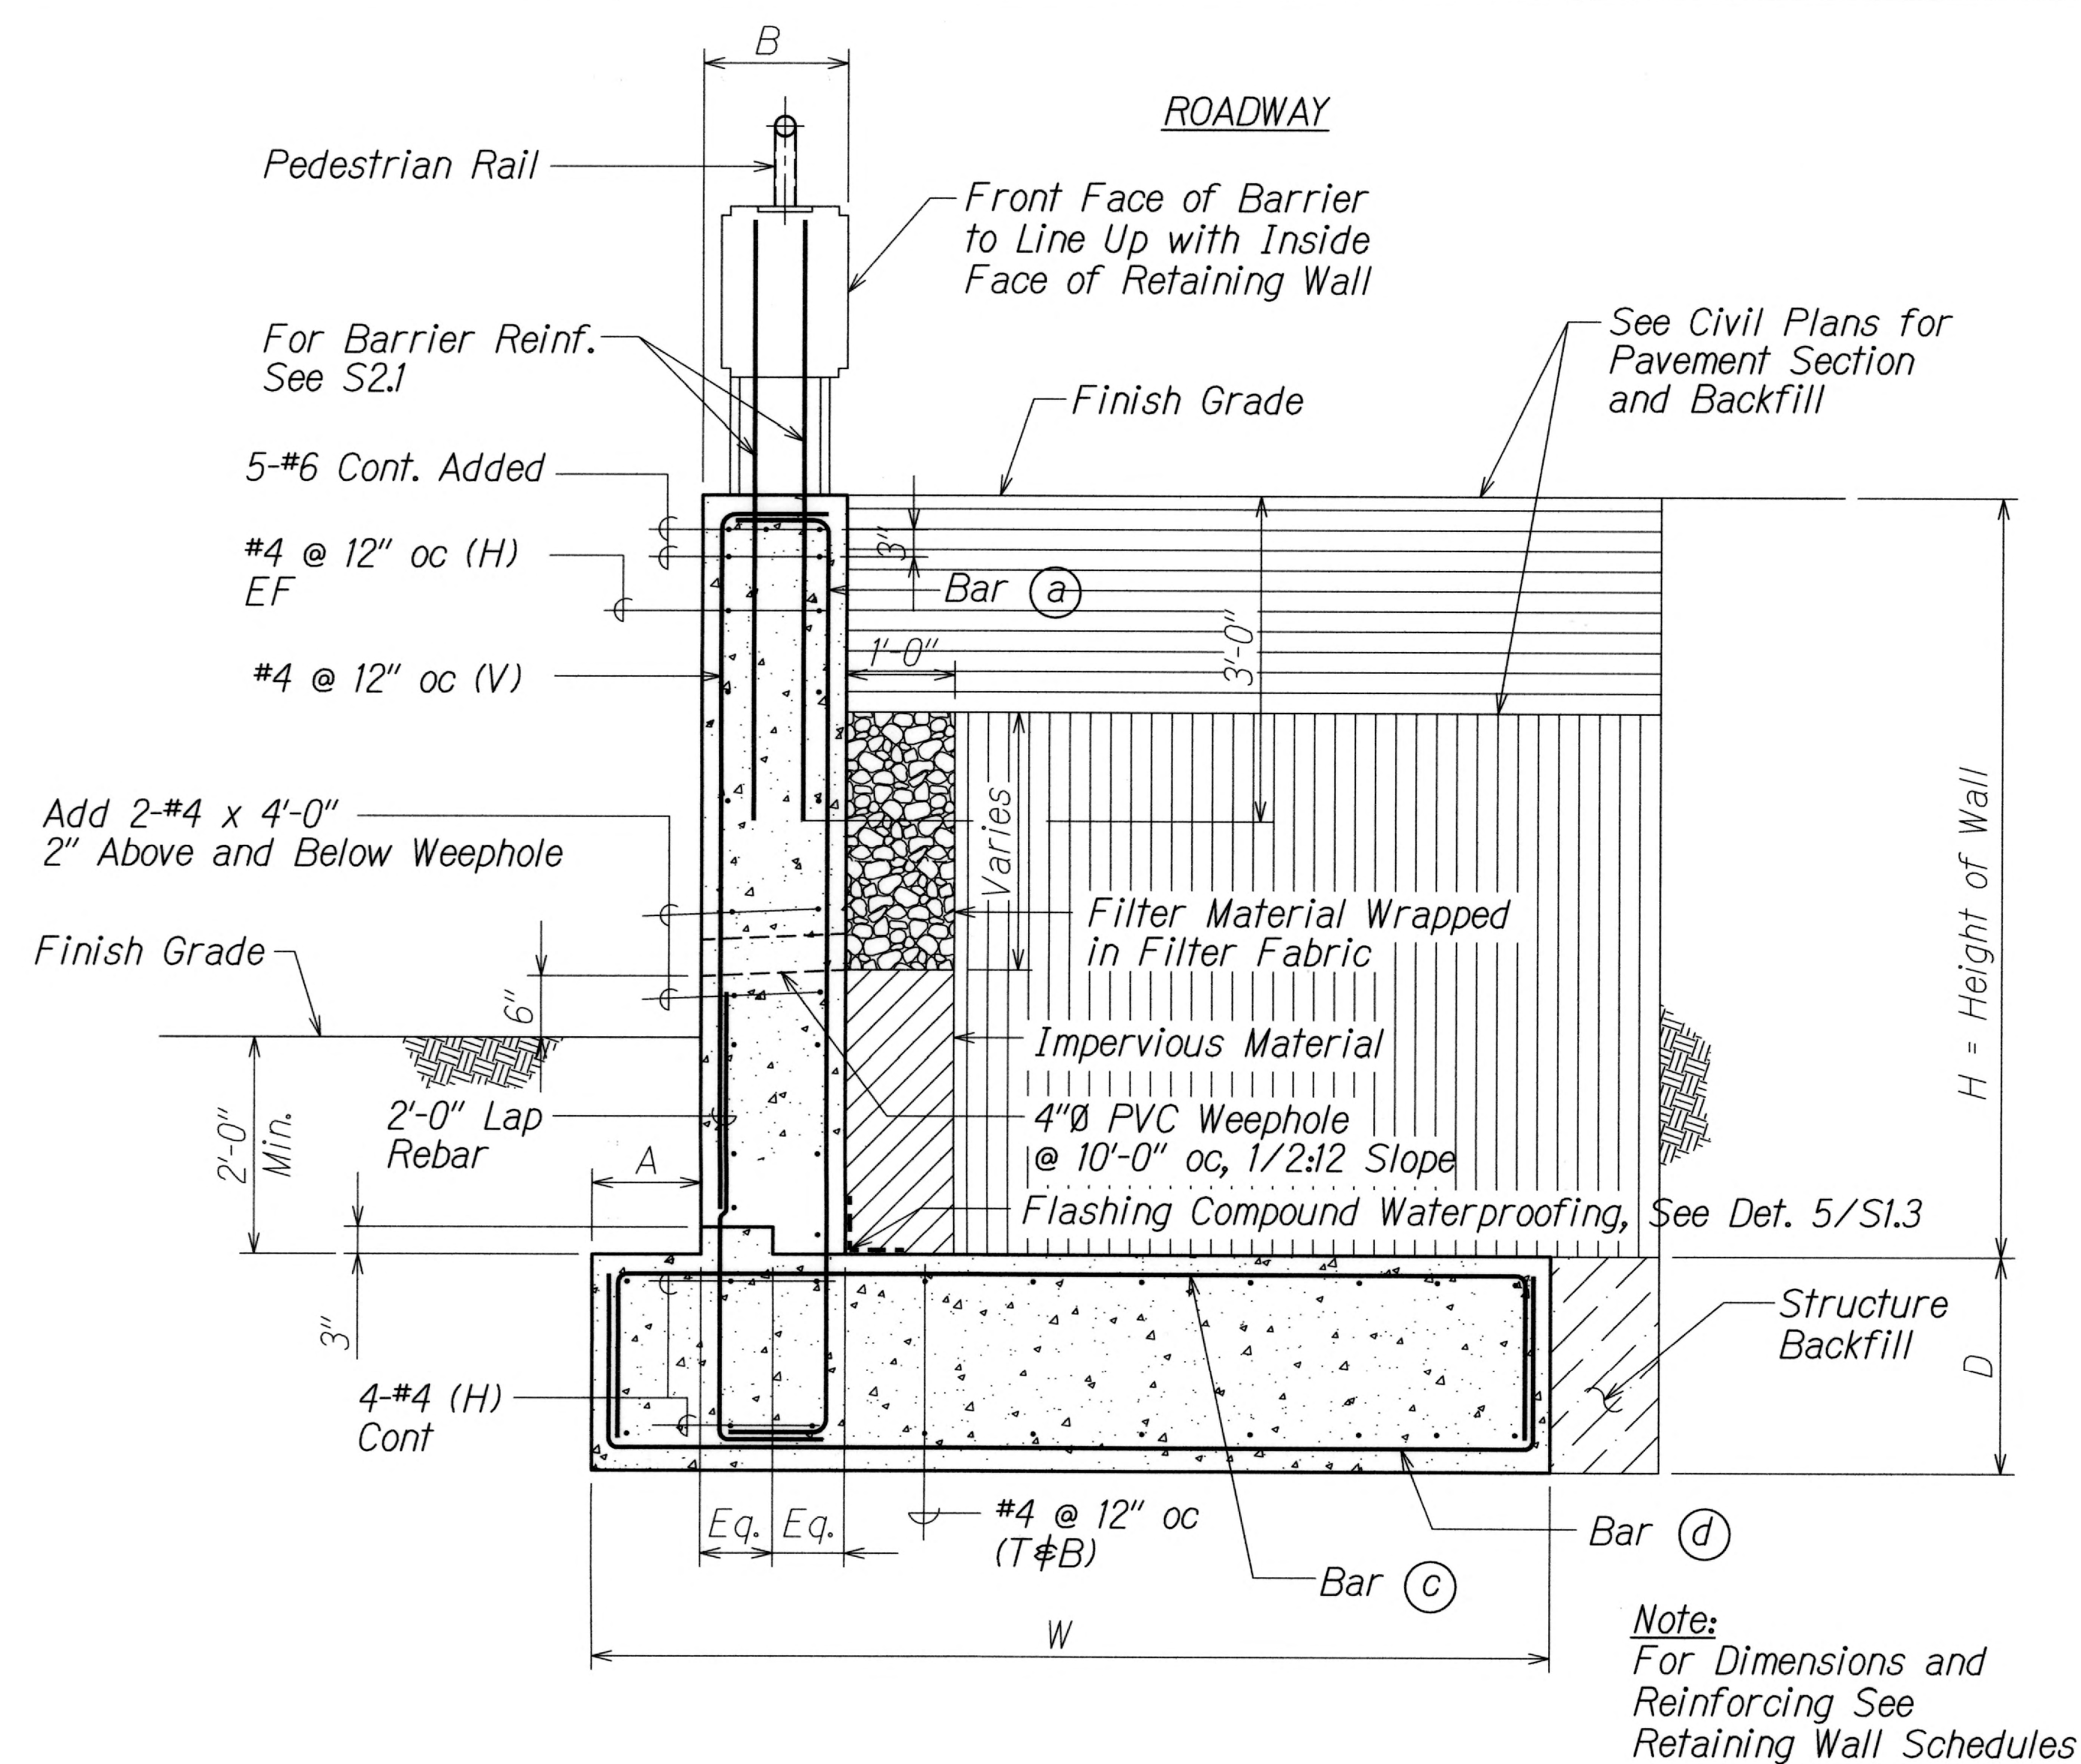

**TYPICAL RETAINING WALL DETAIL** A  
 Scale: 3/4" = 1'-0"

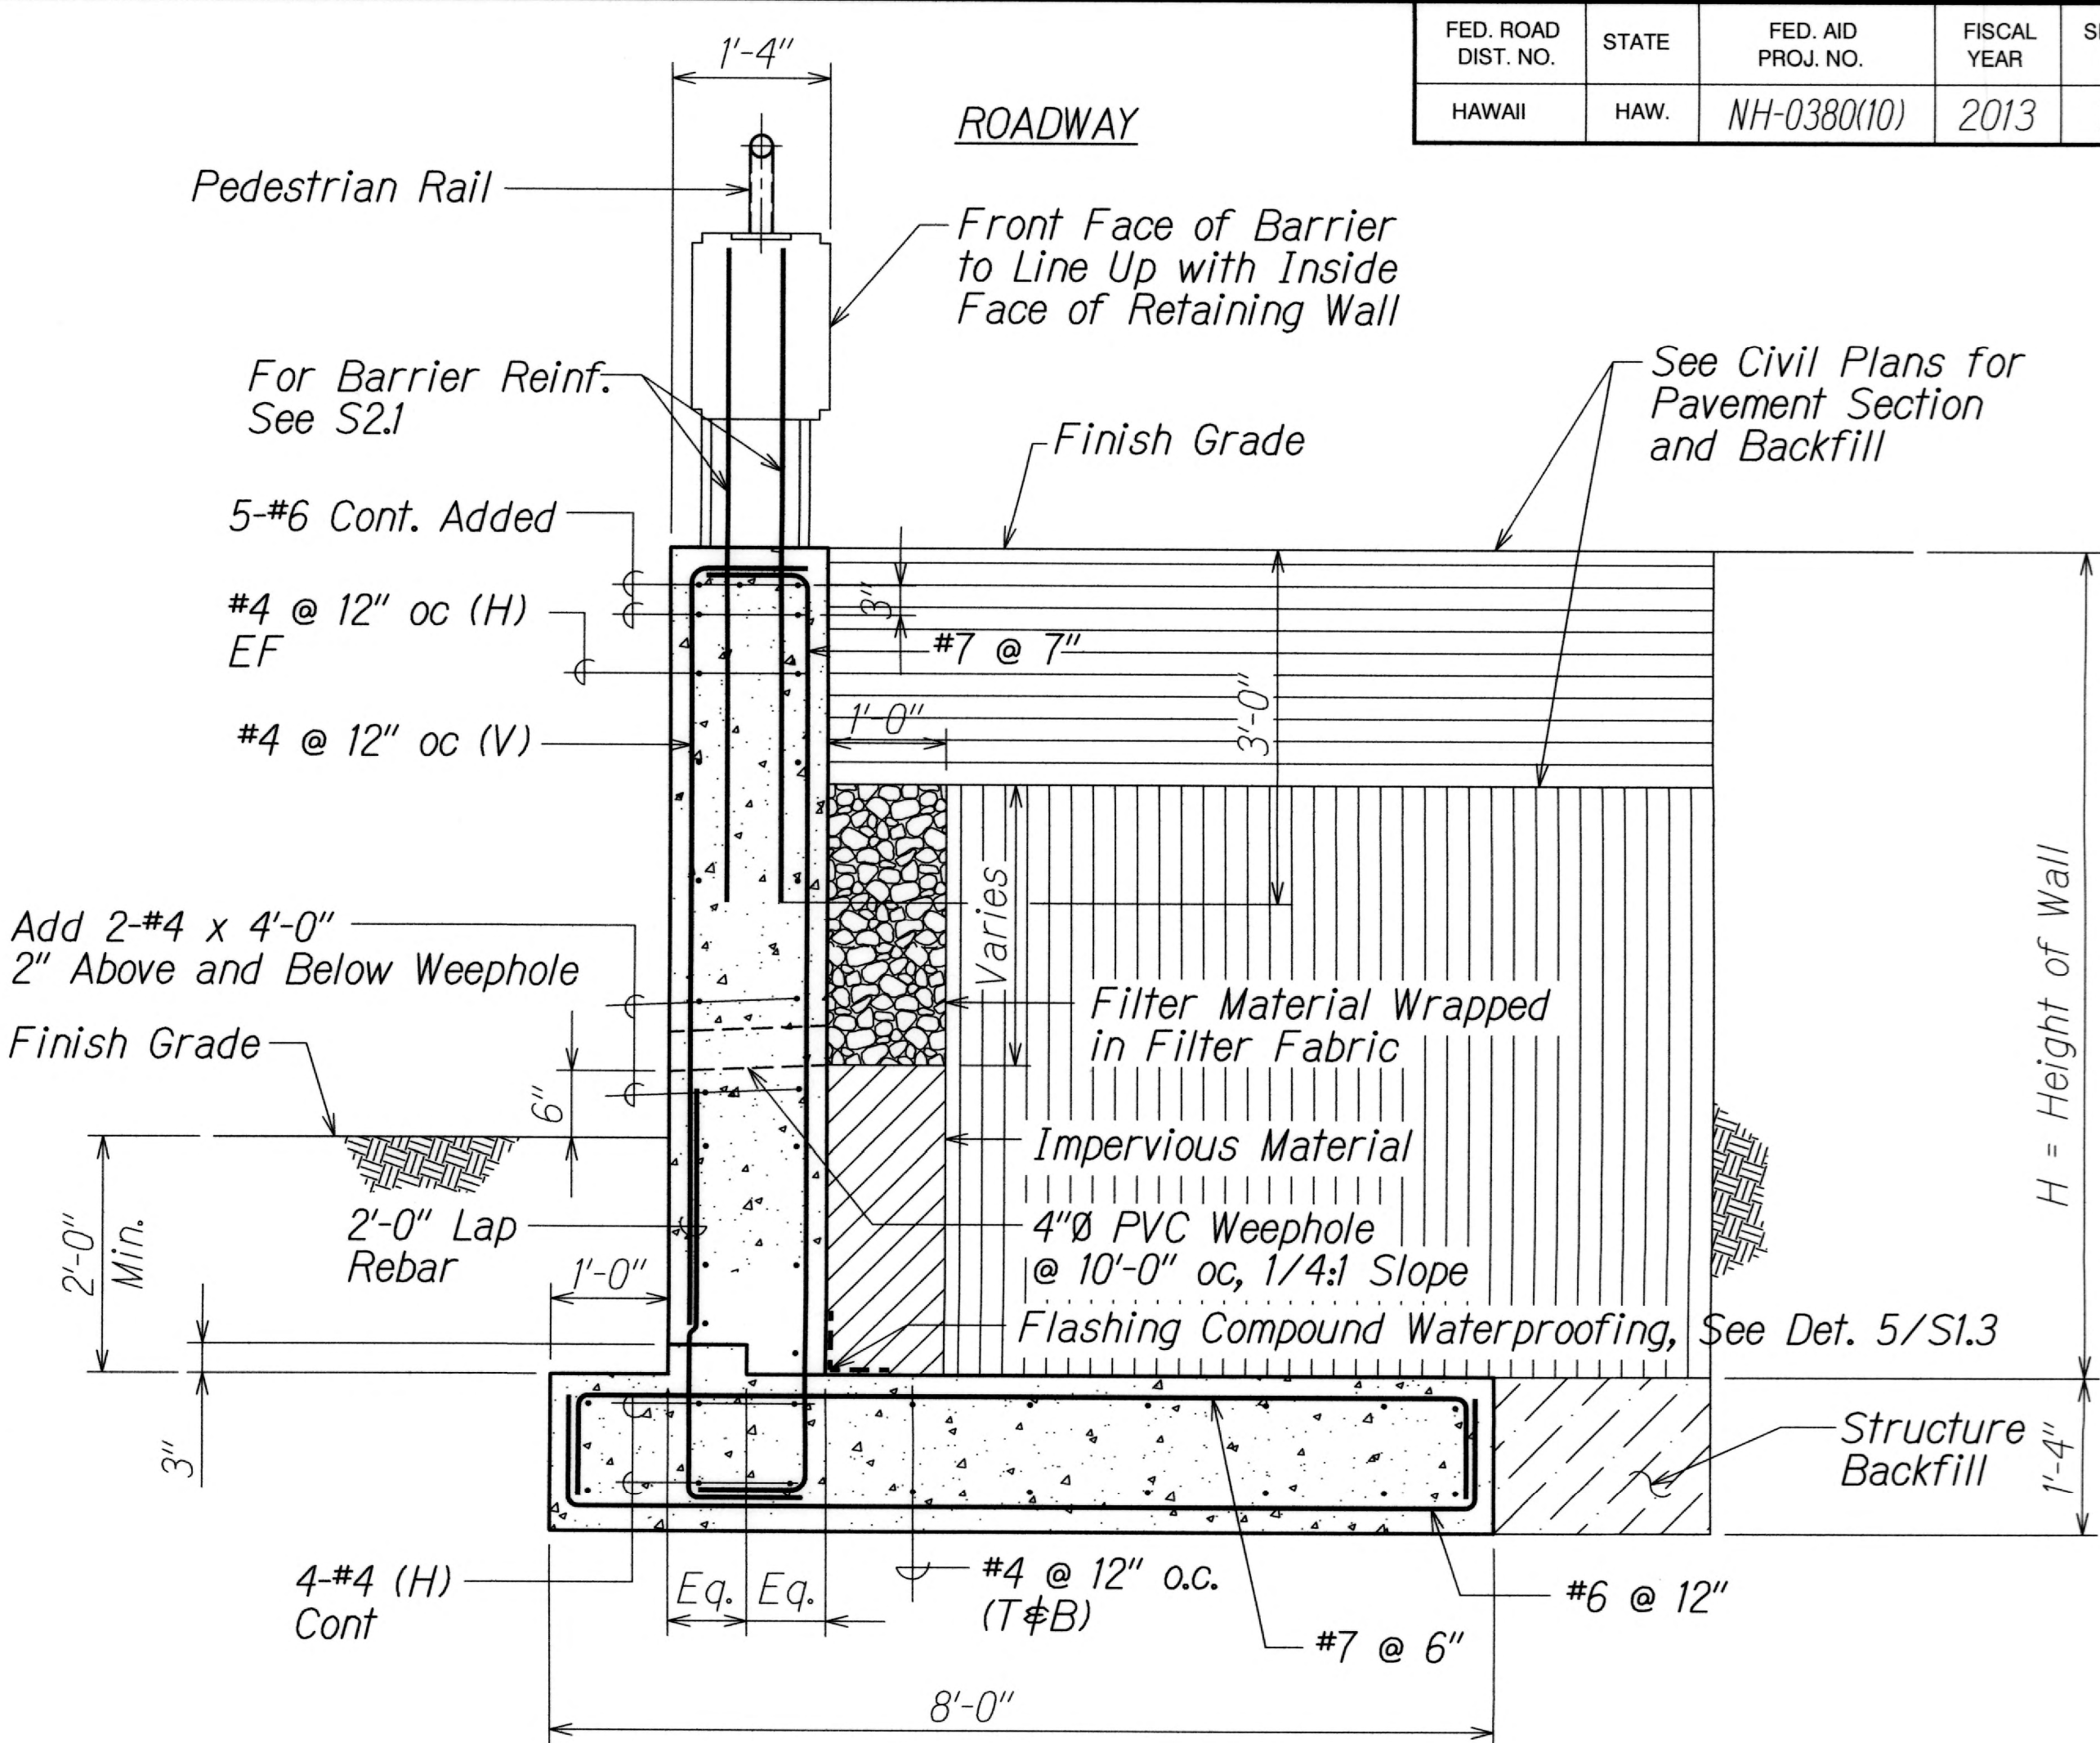

**RETAINING WALL DETAIL AT END** B  
 Scale: 3/4" = 1'-0"

RETAINING WALL SCHEDULE									
DIMENSIONS							REINFORCING		
STEM		BASE		KEY			STEM	BASE	
H	B	W	D	A	E	F	(a)	(c)	(d)
< 8'-0"	16"	7'-0"	1'-4"	1'-0"	-	-	#6 @ 8"	#6 @ 8"	#5 @ 12"
< 6'-0"	16"	6'-6"	1'-4"	1'-0"	-	-	#6 @ 12"	#6 @ 12"	#5 @ 12"
< 4'-0"	16"	6'-3"	1'-4"	1'-0"	-	-	#6 @ 12"	#6 @ 12"	#5 @ 12"
< 2'-0"	16"	6'-0"	1'-4"	1'-0"	-	-	#5 @ 12"	#5 @ 12"	#5 @ 12"

DATE	_____
SURVEY PLOTTED BY	_____
DRAWN BY	_____
TRACED BY	_____
CHECKED BY	_____
ORIGINAL PLAN	_____
NOTE BOOK	_____
QUANTITIES BY	_____
CHECKED BY	_____

DRAWING NAME: Z:\00 ONGONG\11-006-KAAR-KAHULUI AIRPORT ACCESS RD-PHI\FA\CAD\02-22-13 BID\KAH-S102.DWG PLOT TIME: 02-22-13, 2:51 PM



THIS WORK WAS PREPARED BY ME  
 OR UNDER MY SUPERVISION.  
*Calvin T. Miyahara*  
 KSF, INC. APRIL 30, 2014  
 LIC. EXP. DATE


STATE OF HAWAII  
 DEPARTMENT OF TRANSPORTATION  
 HIGHWAYS DIVISION  
**RETAINING WALL**  
**SECTION AND SCHEDULE**

KAHULUI AIRPORT  
 ACCESS ROAD, PHASE I  
 Federal Aid Project No. NH-0380(10)  
 Scale: As Shown Date: February 2013

SHEET No. S1.2 OF 24 SHEETS




FED. ROAD DIST. NO.	STATE	FED. AID PROJ. NO.	FISCAL YEAR	SHEET NO.	TOTAL SHEETS
HAWAII	HAW.	NH-0380(10)	2013	C.O. 121S-1	166

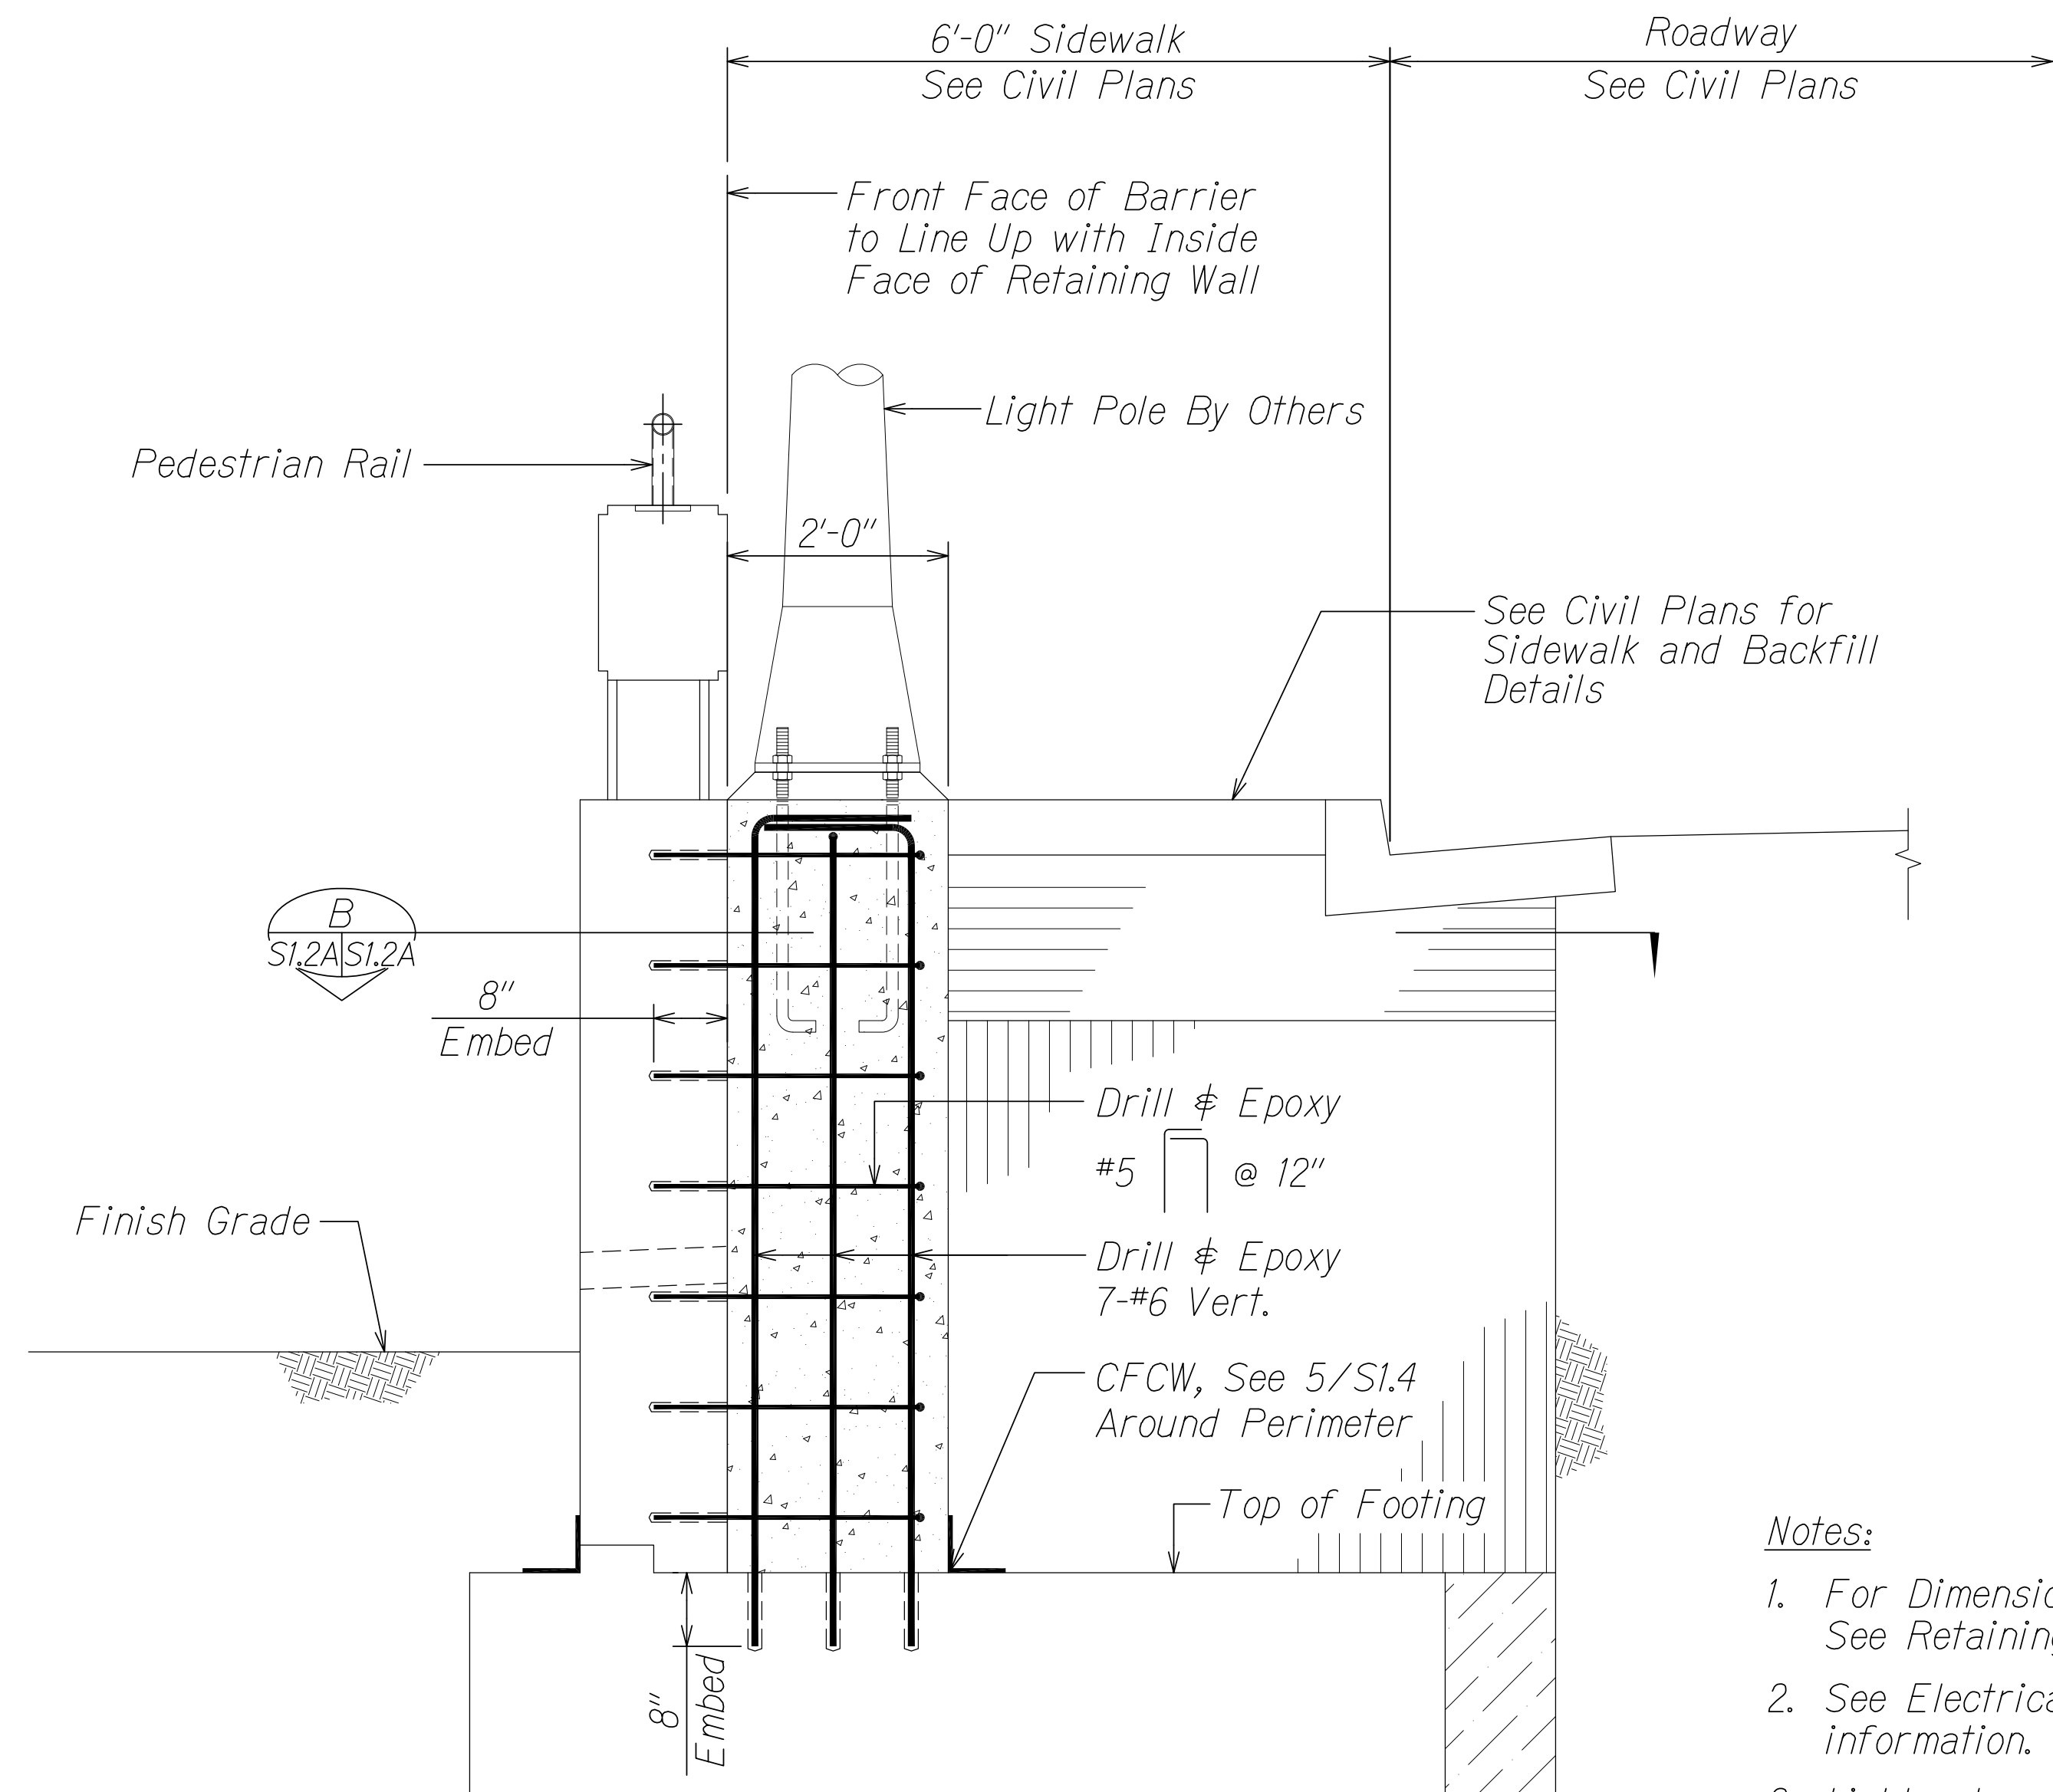

Edge of Footing  
(Below)

Retaining Wall  
See Sheet A/S1.2

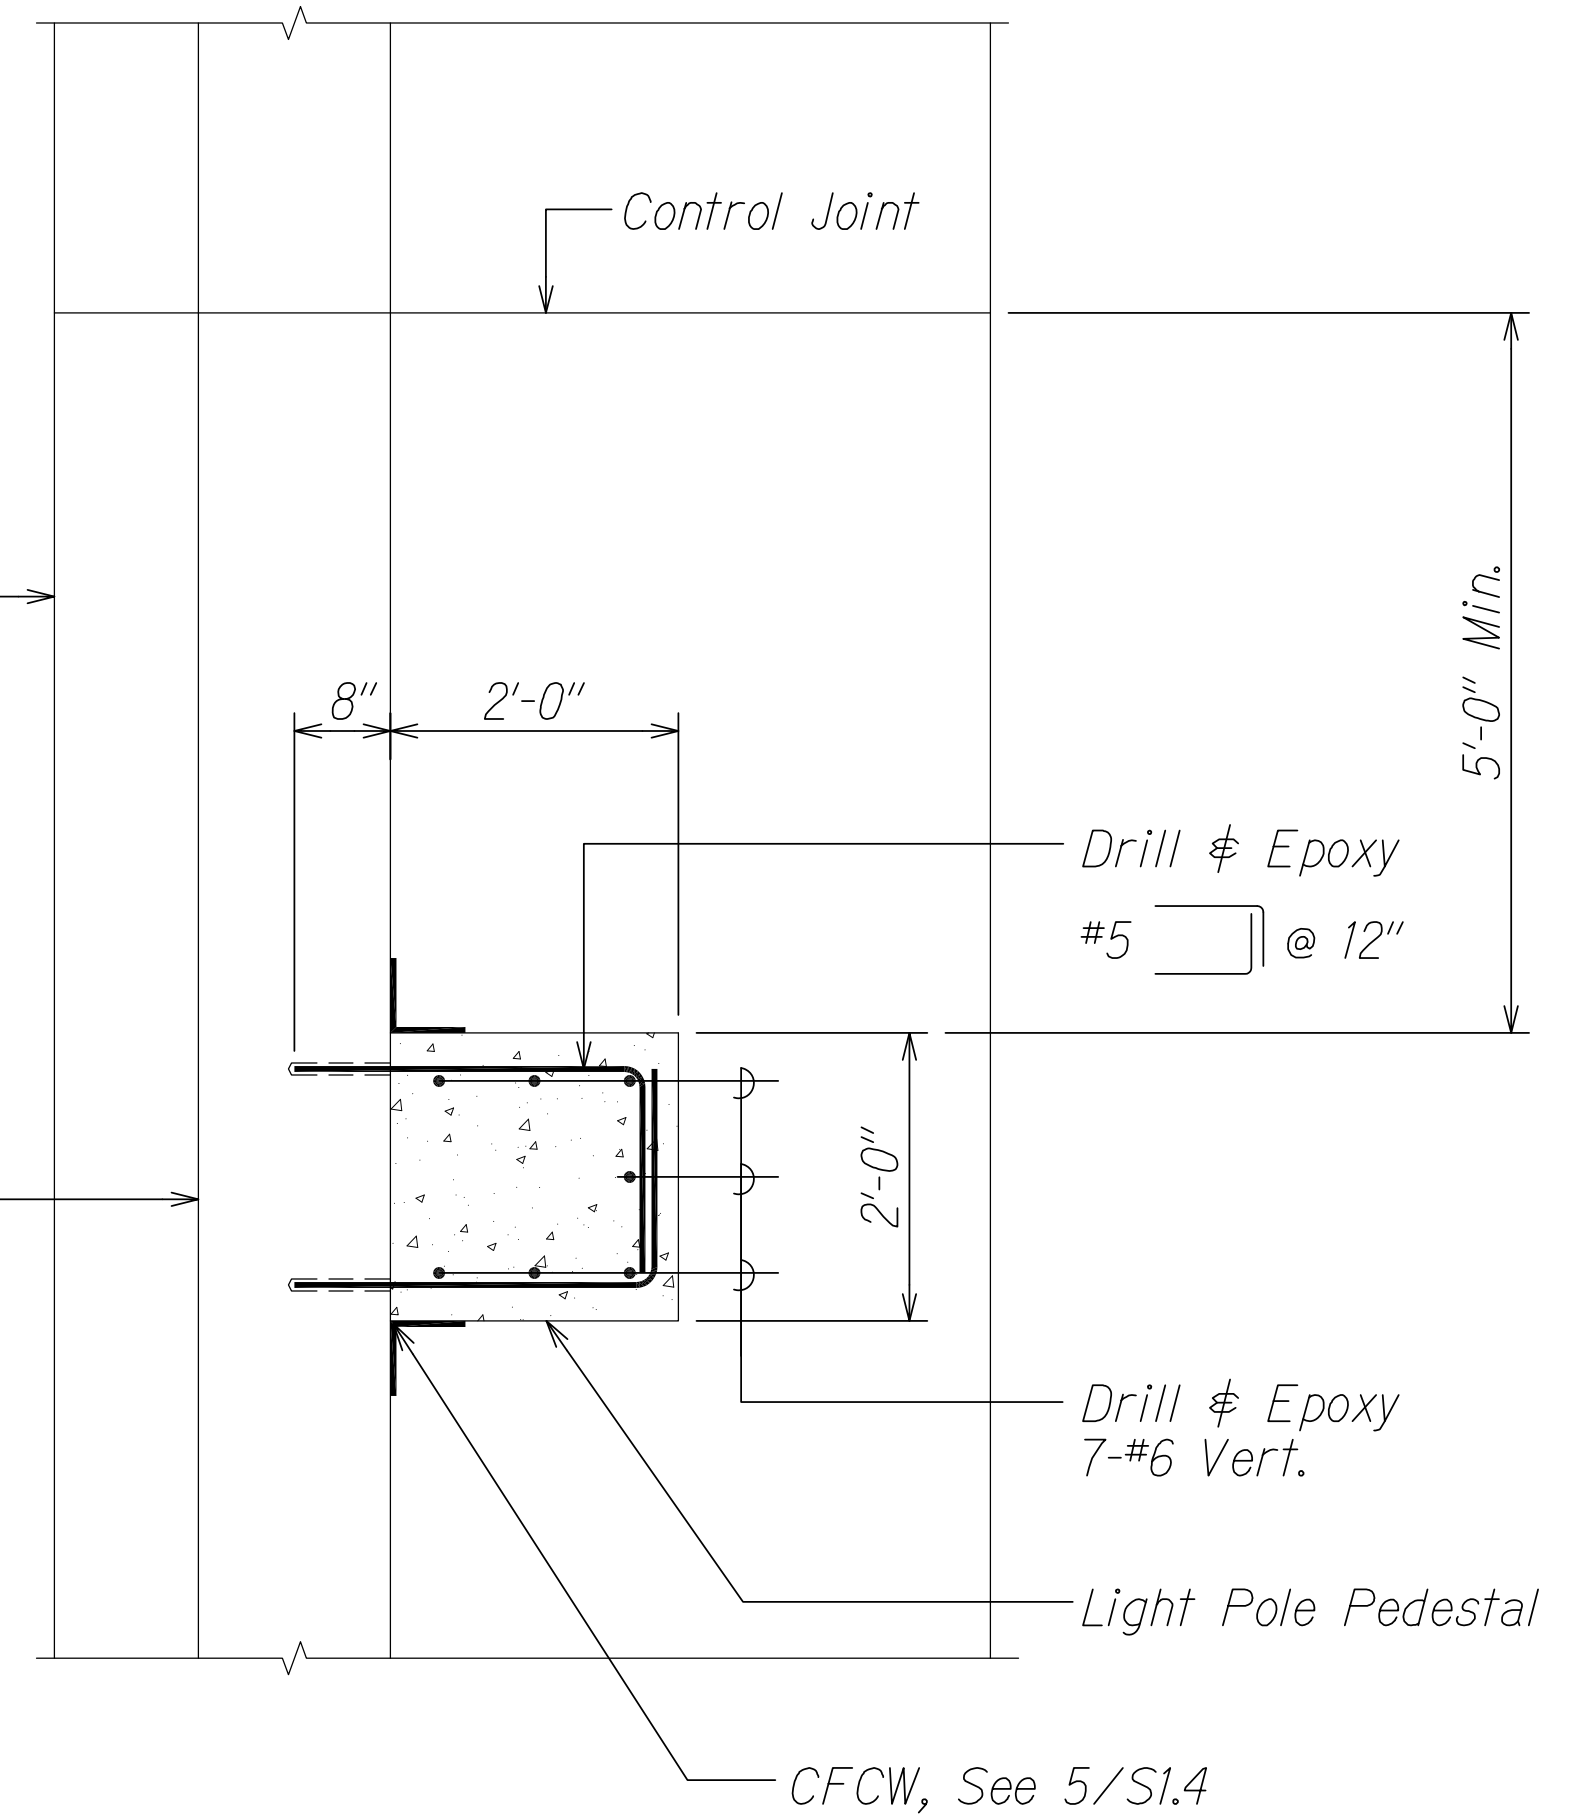

SECTION B  
Scale: 3/4" = 1'-0" S1.2A S1.2A

Notes:

1. For Dimensions and Reinforcing See Retaining Wall Schedules.
2. See Electrical Drawings for more information.
3. Light pole manufacturers shall be followed.

TYPICAL LIGHT POLE AT RETAINING WALL SECTION A  
Scale: 3/4" = 1'-0" S1.2A S1.2A

THIS WORK WAS PREPARED BY ME  
OR UNDER MY SUPERVISION.

KSF, INC. APRIL 30, 2016  
LIC. EXP. DATE

STATE OF HAWAII  
DEPARTMENT OF TRANSPORTATION  
HIGHWAYS DIVISION  
TYPICAL LIGHT POLE AT  
RETAINING WALL SECTIONS

KAHULUI AIRPORT  
ACCESS ROAD, PHASE I  
Federal Aid Project No. NH-0380(10)  
Scale: As Shown Date: February 2013

SHEET No. S1.2A OF 24 SHEETS

11/25/14	<span style="border: 1px solid black; border-radius: 50%; padding: 2px;">-</span>	New Sheet
DATE		REVISION

"AS-BUILT"

C.O. 121S-1


AS-BUILT DRAWINGS

ORIGINAL PLAN	SURVEY PLOTTED BY	DATE
NOTE BOOK	DRAWN BY	
No.	DESIGNED BY	
	QUANTITIES BY	
	CHECKED BY	


DRAWING NAME: C:\PROJECTS\KAHULUI-2011\AS-BUILT OCTOBER 2017\STRUCTURAL\KAH-S102A.COLDWG PLOT TIME: 10-30-18, 9:56 AM




FED. ROAD DIST. NO.	STATE	FED. AID PROJ. NO.	FISCAL YEAR	SHEET NO.	TOTAL SHEETS
HAWAII	HAW.	NH-0380(10)	2013	122	166

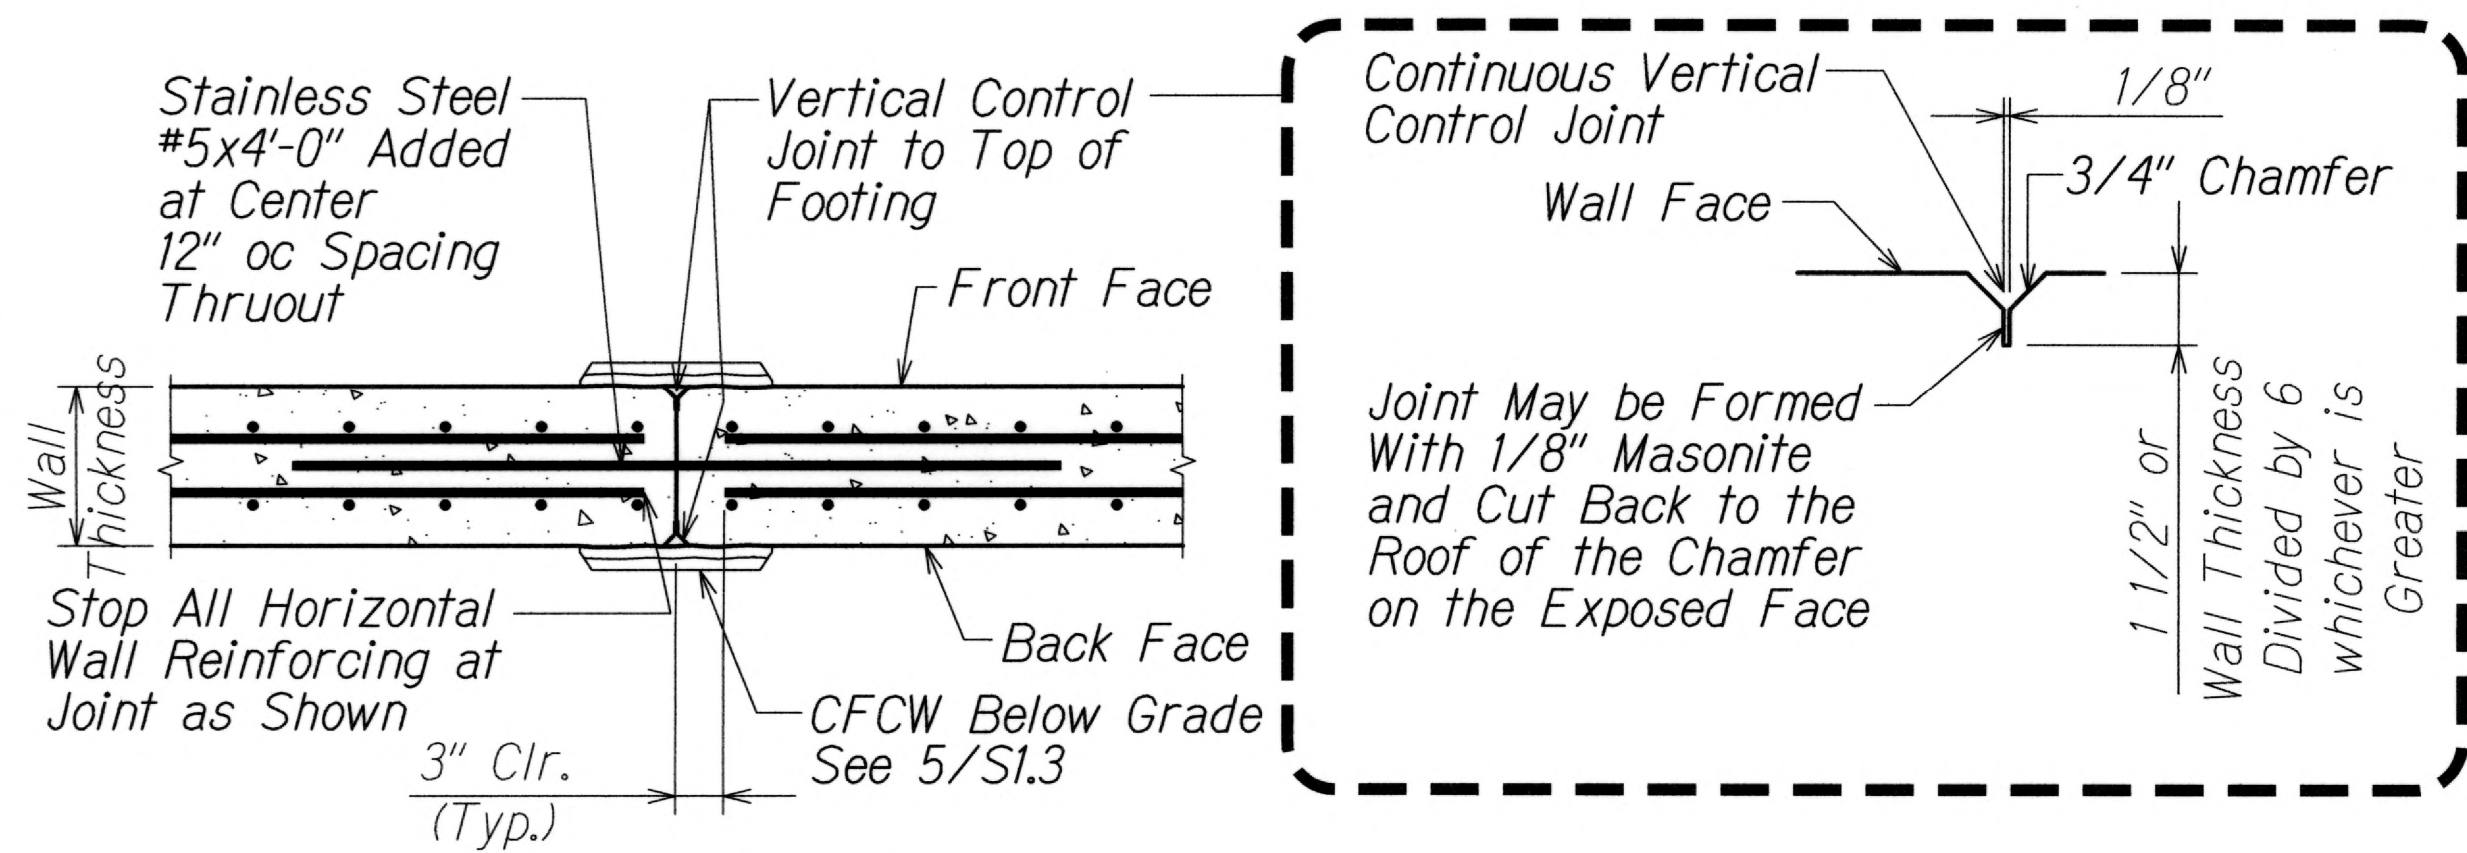


**DOUBLE CURTAIN  
CONSTRUCTION JOINT AT  
CONTROL JOINT LOCATION** 1  
SI.3 SI.3  
Scale: 1" = 1'-0"

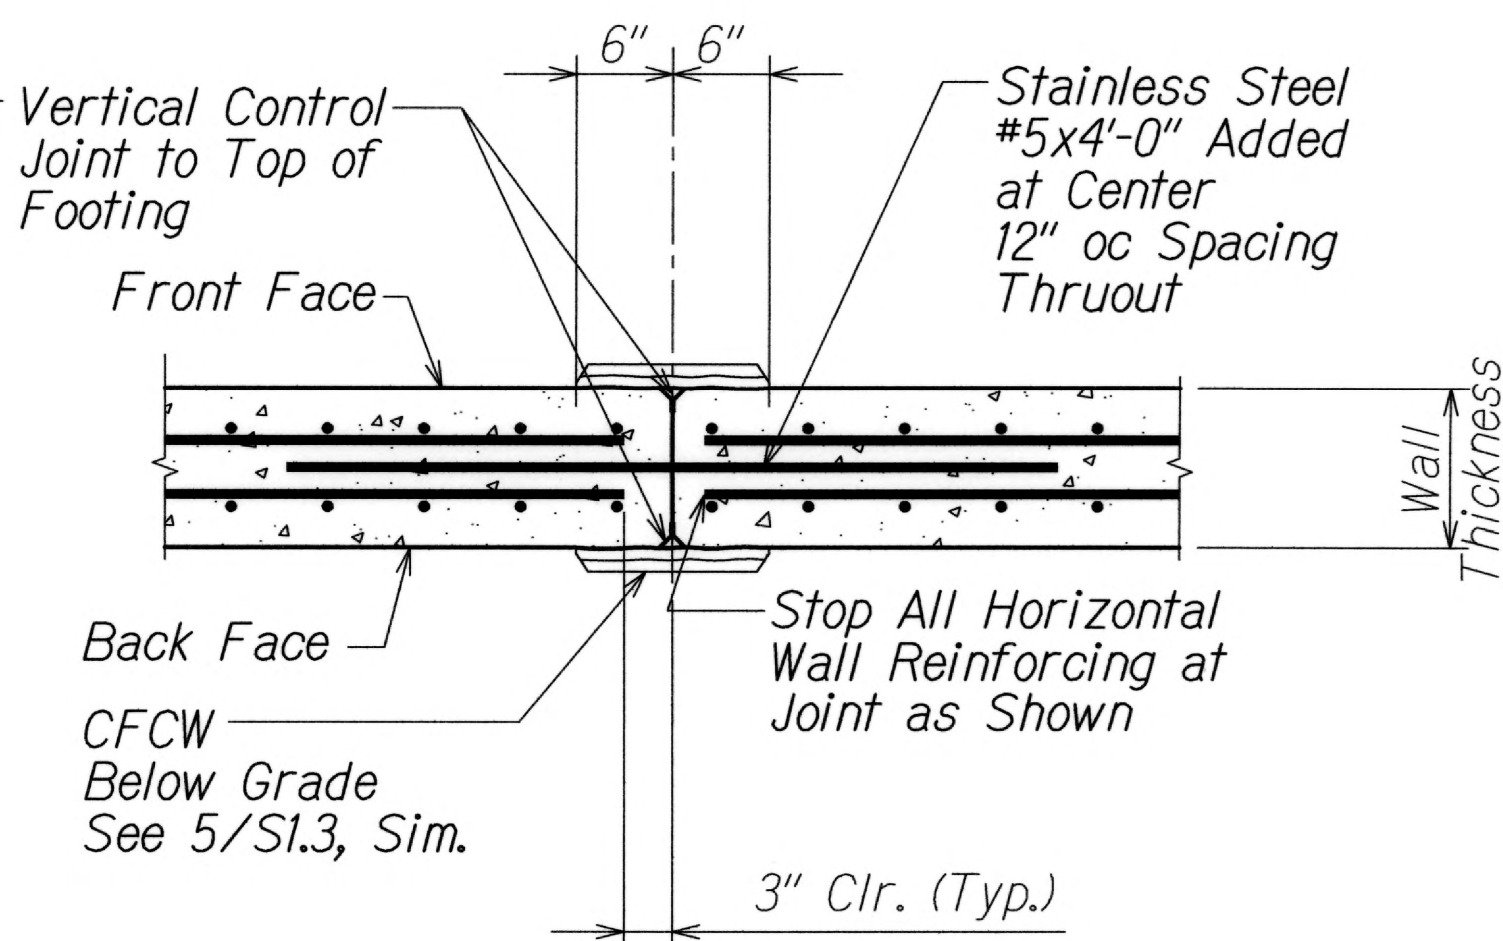


**DOUBLE CURTAIN  
TYPICAL WALL VERTICAL  
CONTROL JOINT DETAIL** 2  
SI.3 SI.3  
Scale: 1" = 1'-0"

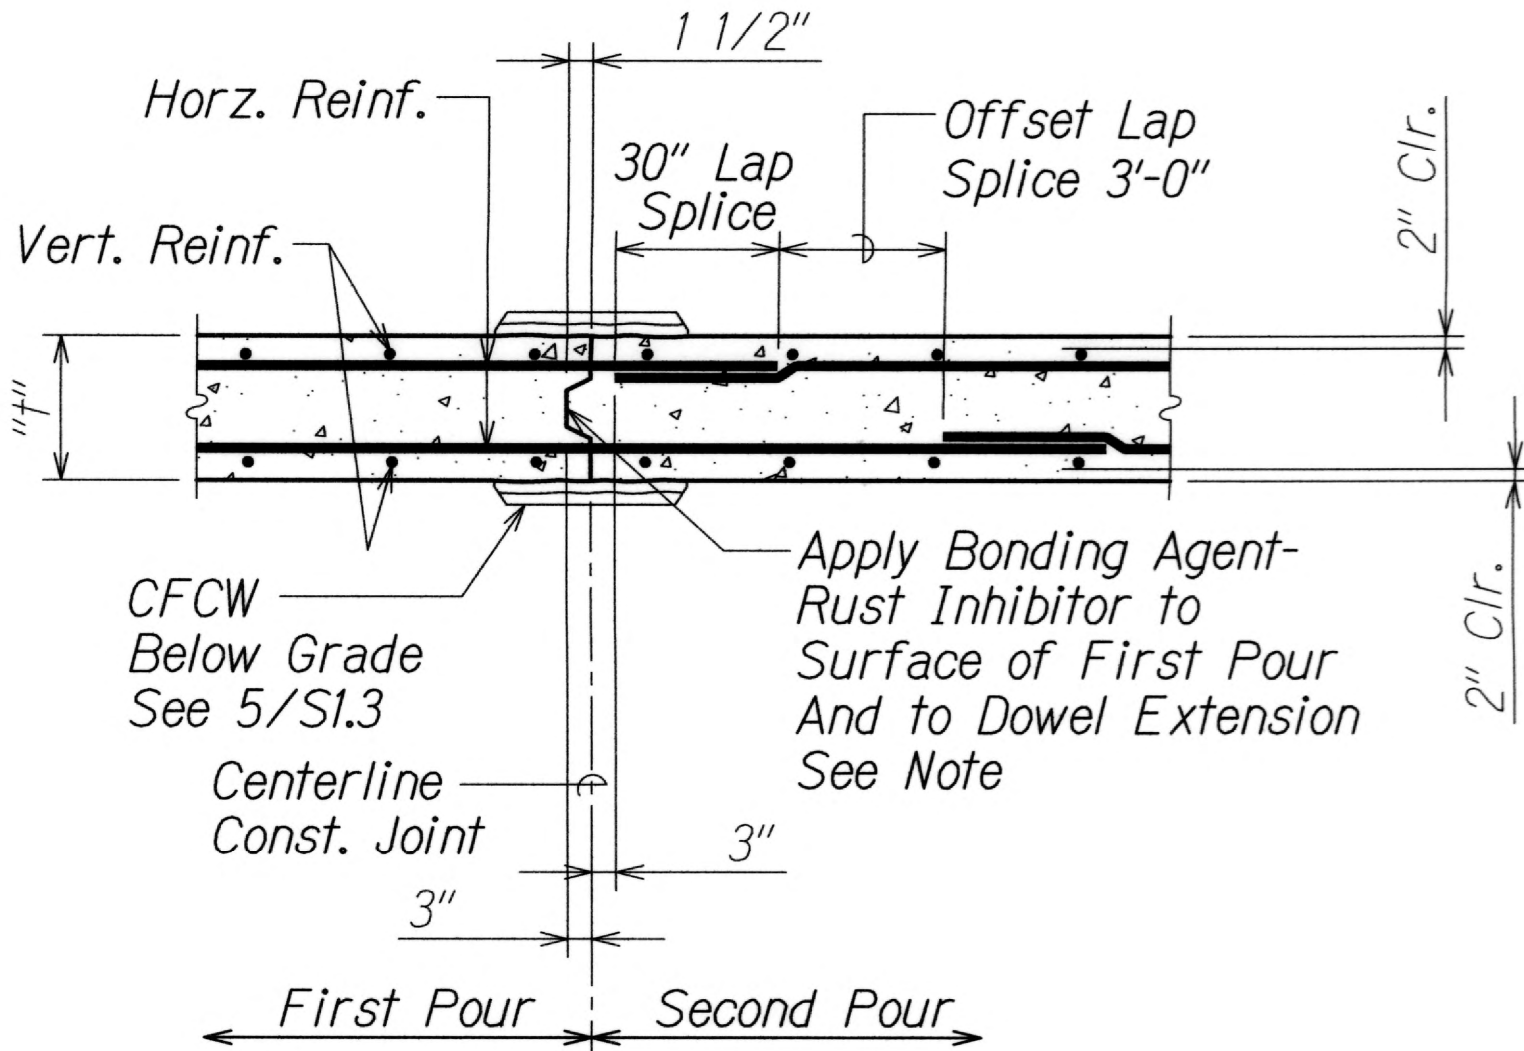


**DOUBLE CURTAIN**  
*Note:* Use 1 1/2" Deep X "t"/3 Keys.  
**TYPICAL WALL VERTICAL  
CONSTRUCTION JOINT DETAIL** 3  
SI.3 SI.3  
Scale: 1" = 1'-0"

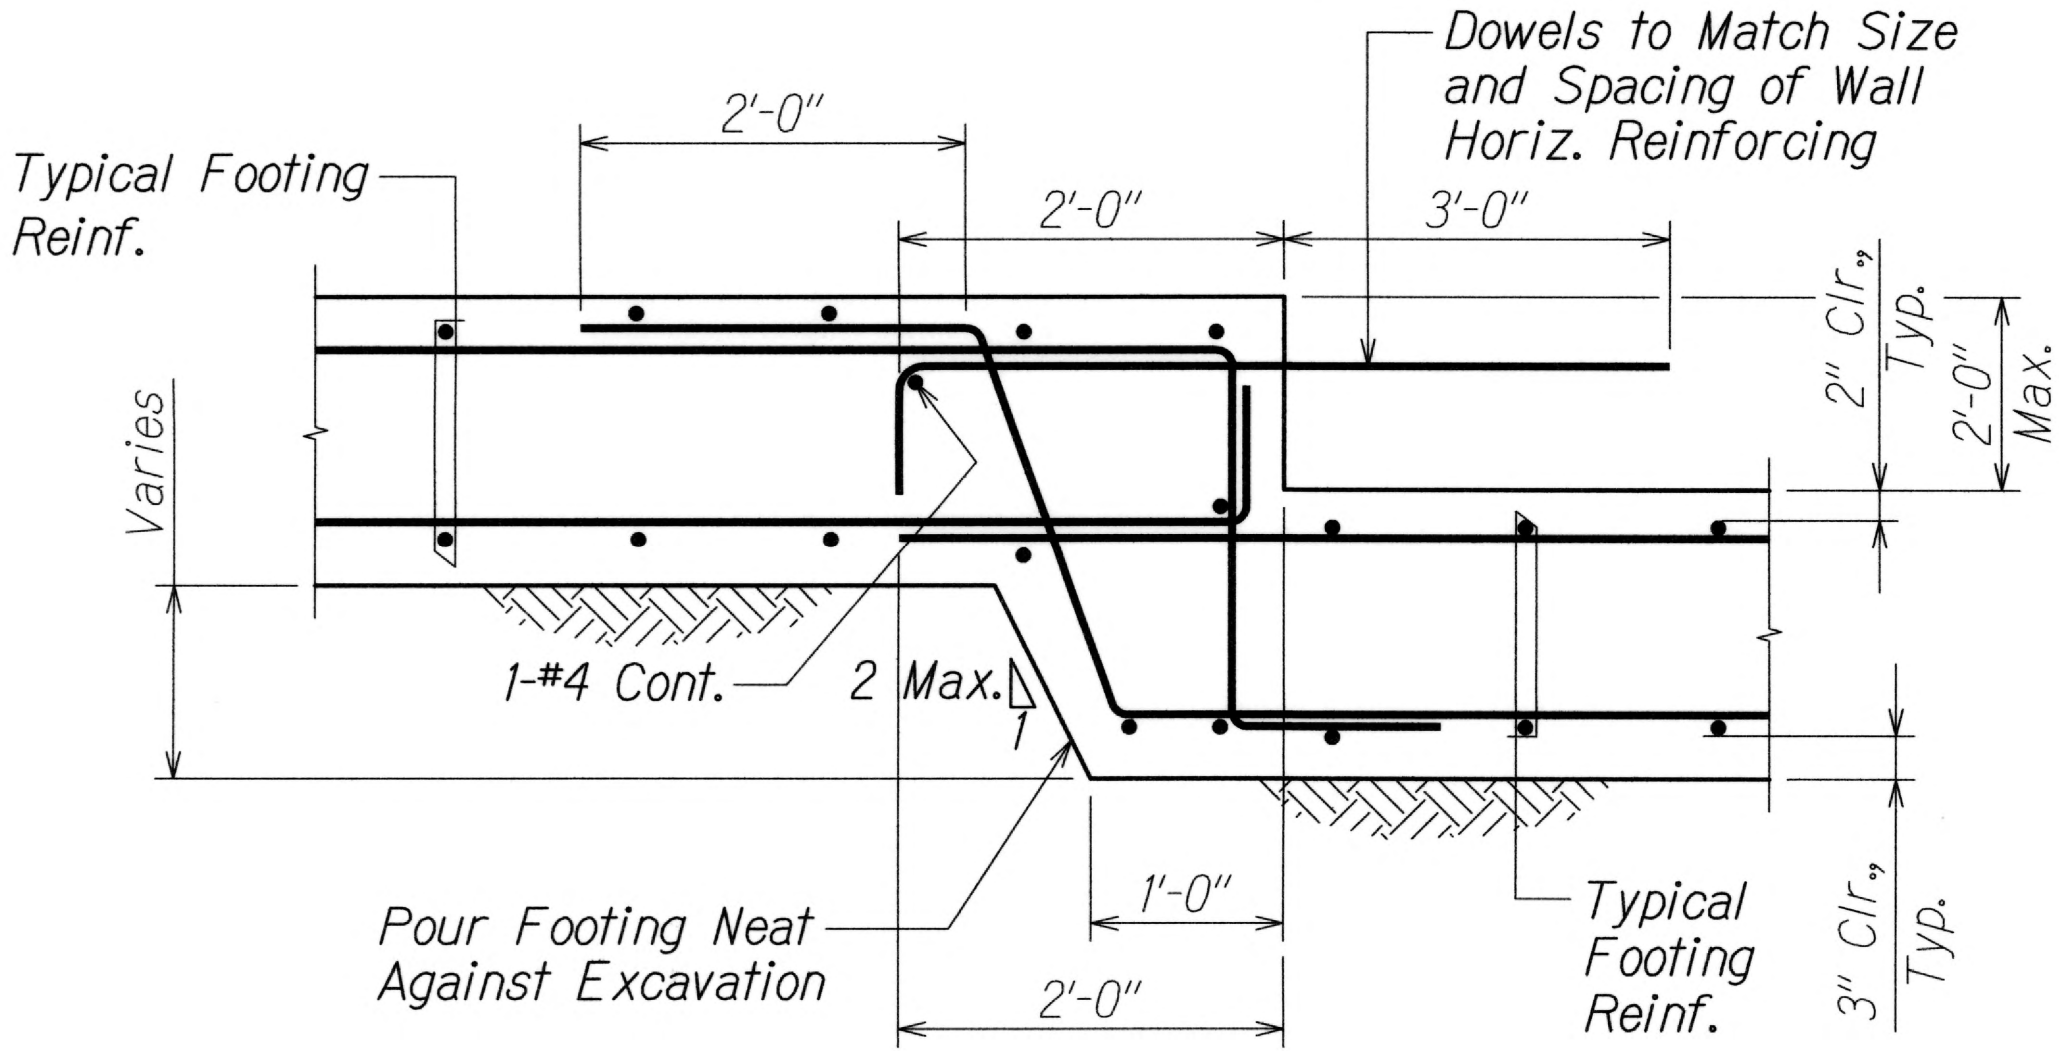


**TYPICAL WALL STEP FOOTING DETAIL** 4  
SI.3 SI.3  
Scale: 1" = 1'-0"

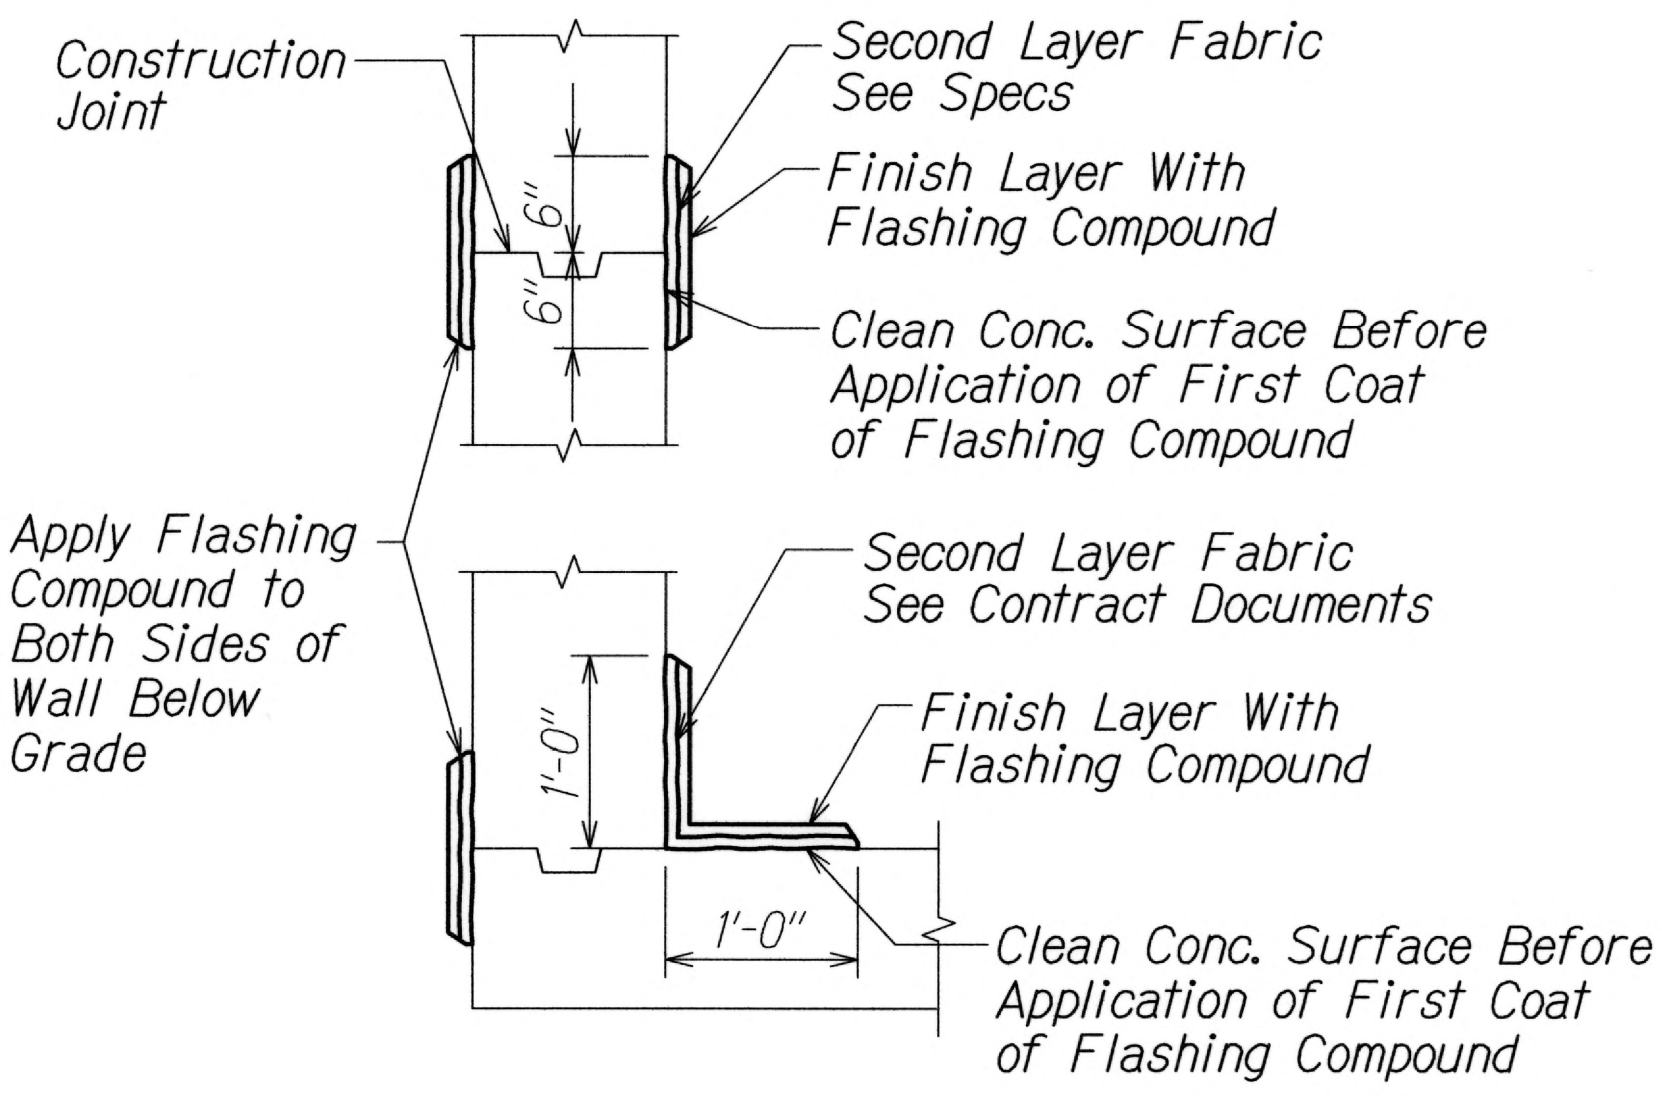


**TYP. CONTINUOUS FLASHING COMPOUND  
WATERPROOFING (CFCW DETAILS)** 5  
SI.3 SI.3  
Scale: 1" = 1'-0"

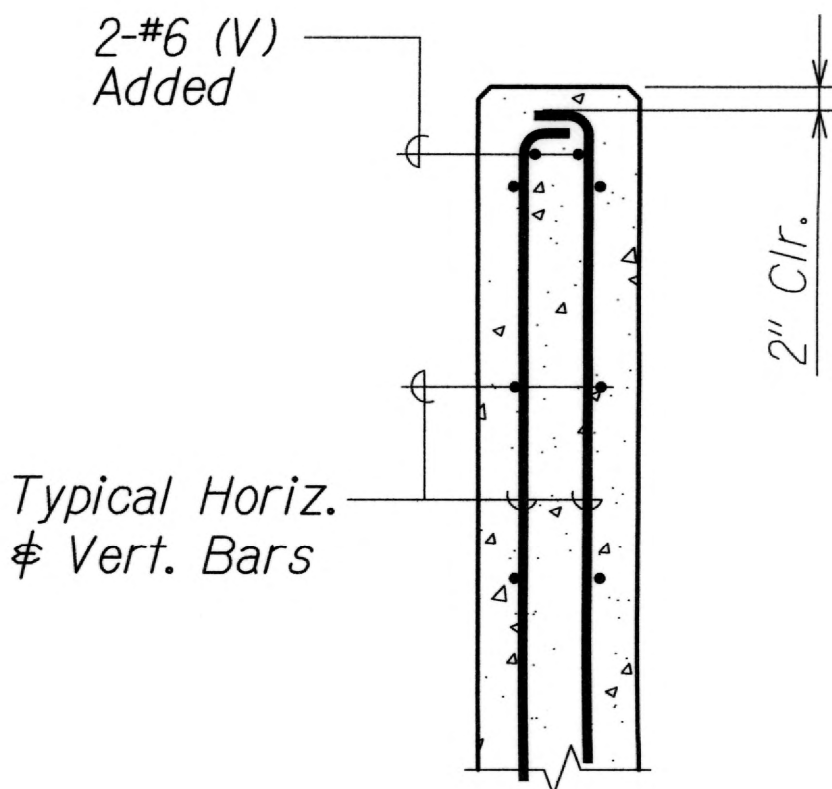

**DOUBLE CURTAIN  
CONCRETE  
WALL ENDS** 6  
SI.3 SI.3  
Scale: 1" = 1'-0"

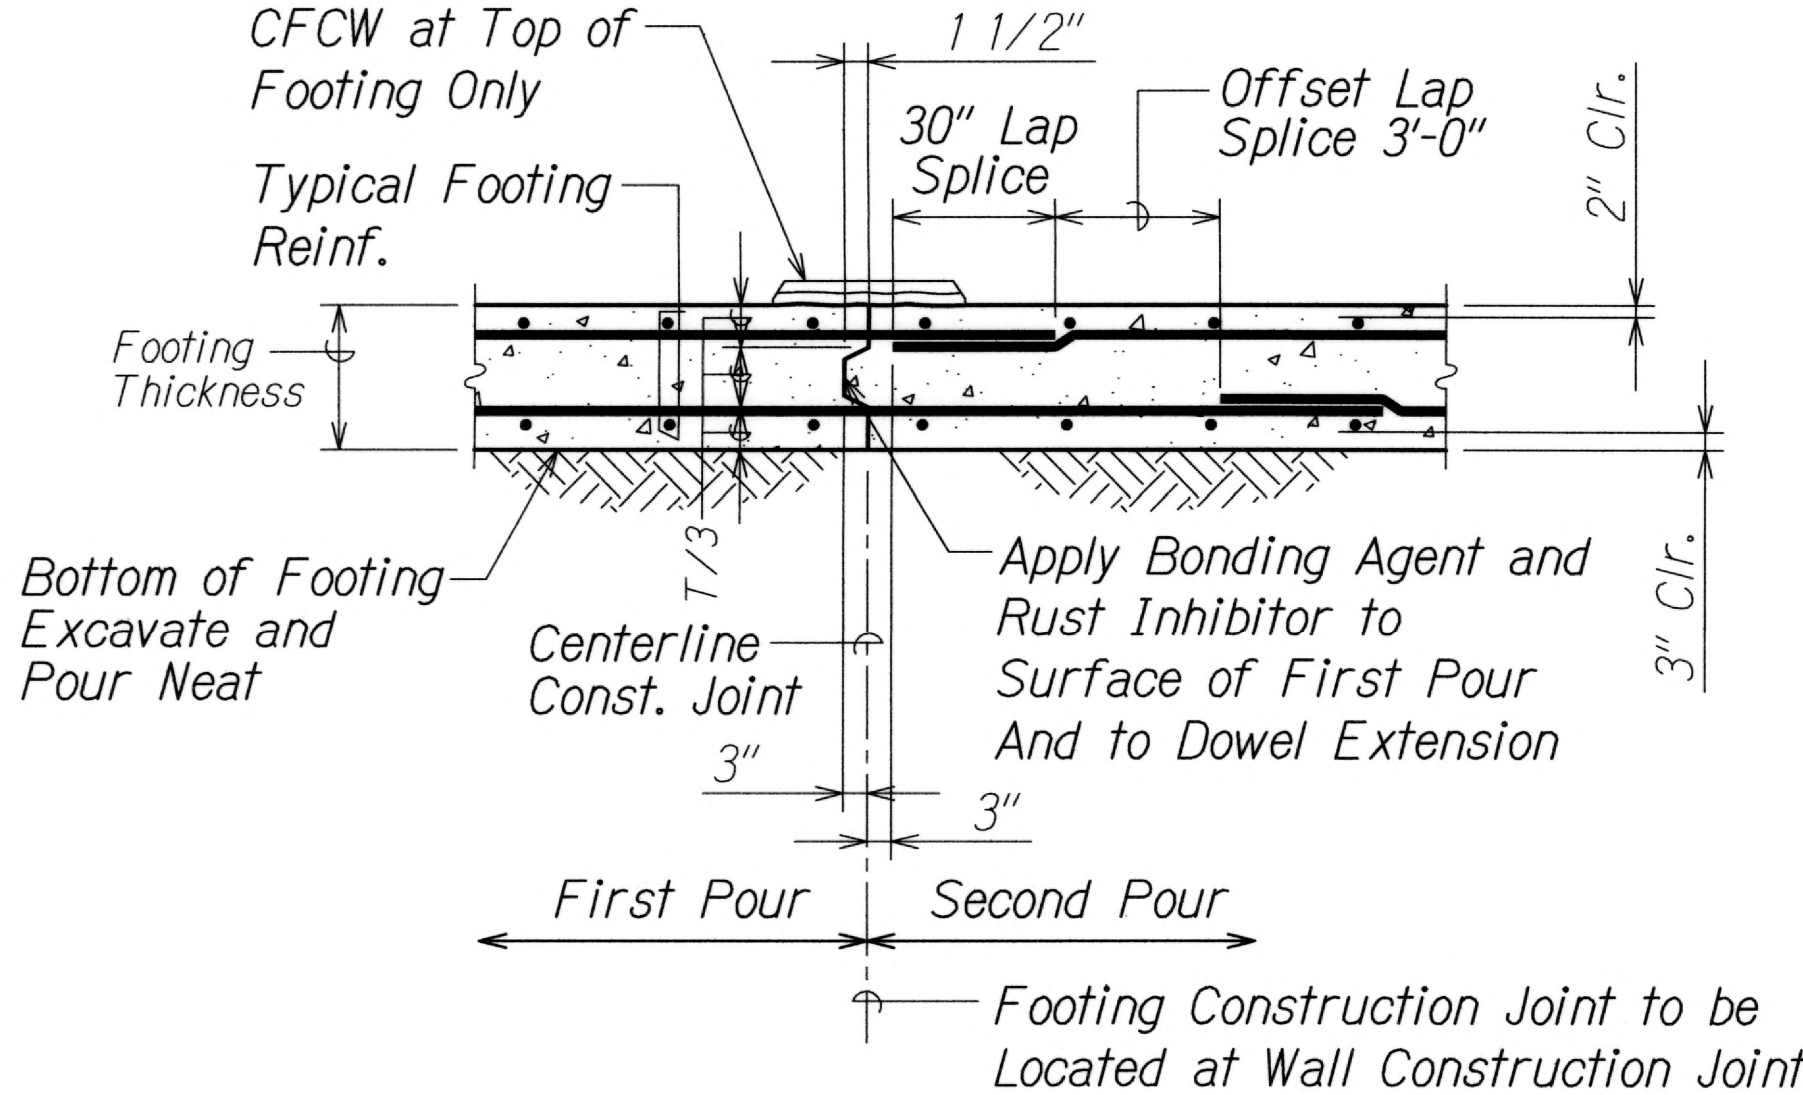

**TYPICAL FOOTING CONSTRUCTION JOINT DETAIL** 7  
SI.3 SI.3  
Scale: 1" = 1'-0"

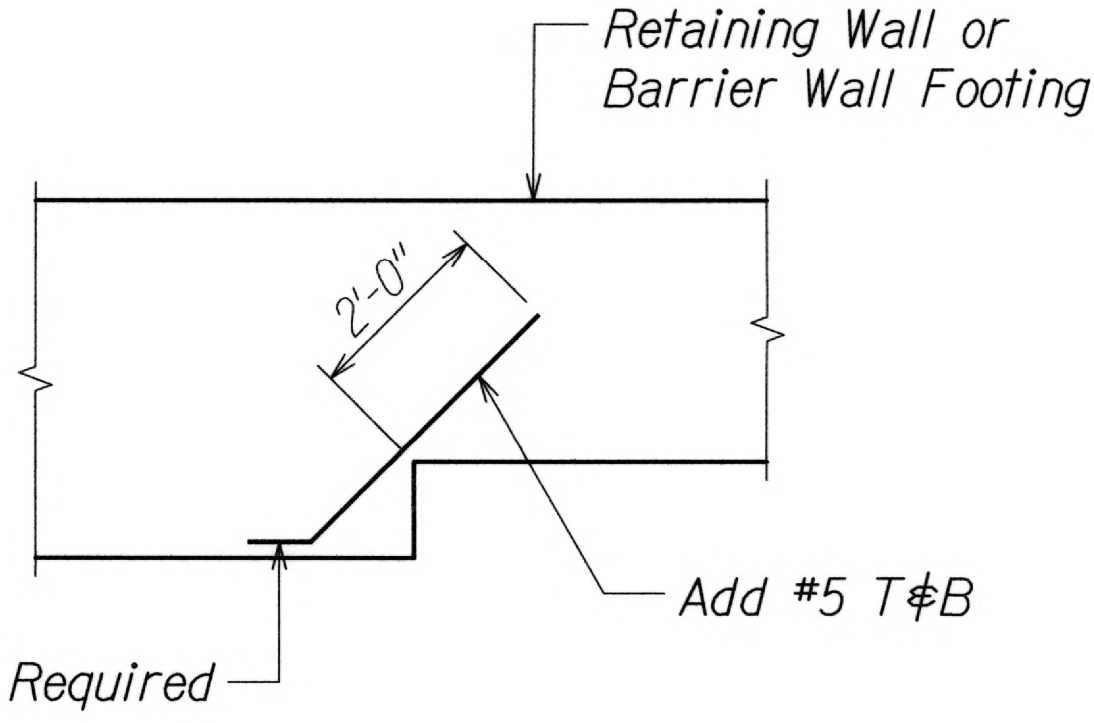

**TYPICAL FOOTING CORNER PLAN DETAIL** 8  
SI.3 SI.3  
Scale: 1/2" = 1'-0"

DATE	_____
SURVEY PLOTTED BY	_____
DRAWN BY	_____
DESIGNED BY	_____
QUANTITIES BY	_____
CHECKED BY	_____
ORIGINAL PLAN	_____
NOTE BOOK	_____
No.	_____

DRAWING NAME: Z:\00 ONGOING\11-006-KAAR-KAHULUI AIRPORT ACCESS RD-PH1 FA\CAD\02-22-13 BID\KAH-SI03.DWG PLOT TIME: 02-22-13, 2:52 PM




THIS WORK WAS PREPARED BY ME  
OR UNDER MY SUPERVISION.  
*Calvin T. Miyahara*  
KSF, INC. APRIL 30, 2014  
LIC. EXP. DATE

STATE OF HAWAII  
DEPARTMENT OF TRANSPORTATION  
HIGHWAYS DIVISION  
**TYPICAL DETAILS**  
  
KAHULUI AIRPORT  
ACCESS ROAD, PHASE I  
Federal Aid Project No. NH-0380(10)  
Scale: As Shown Date: February 2013  
SHEET No. SI.3 OF 24 SHEETS

122



FED. ROAD DIST. NO.	STATE	FED. AID PROJ. NO.	FISCAL YEAR	SHEET NO.	TOTAL SHEETS
HAWAII	HAW.	NH-0380(10)	2013	C.O. 122S-1	166

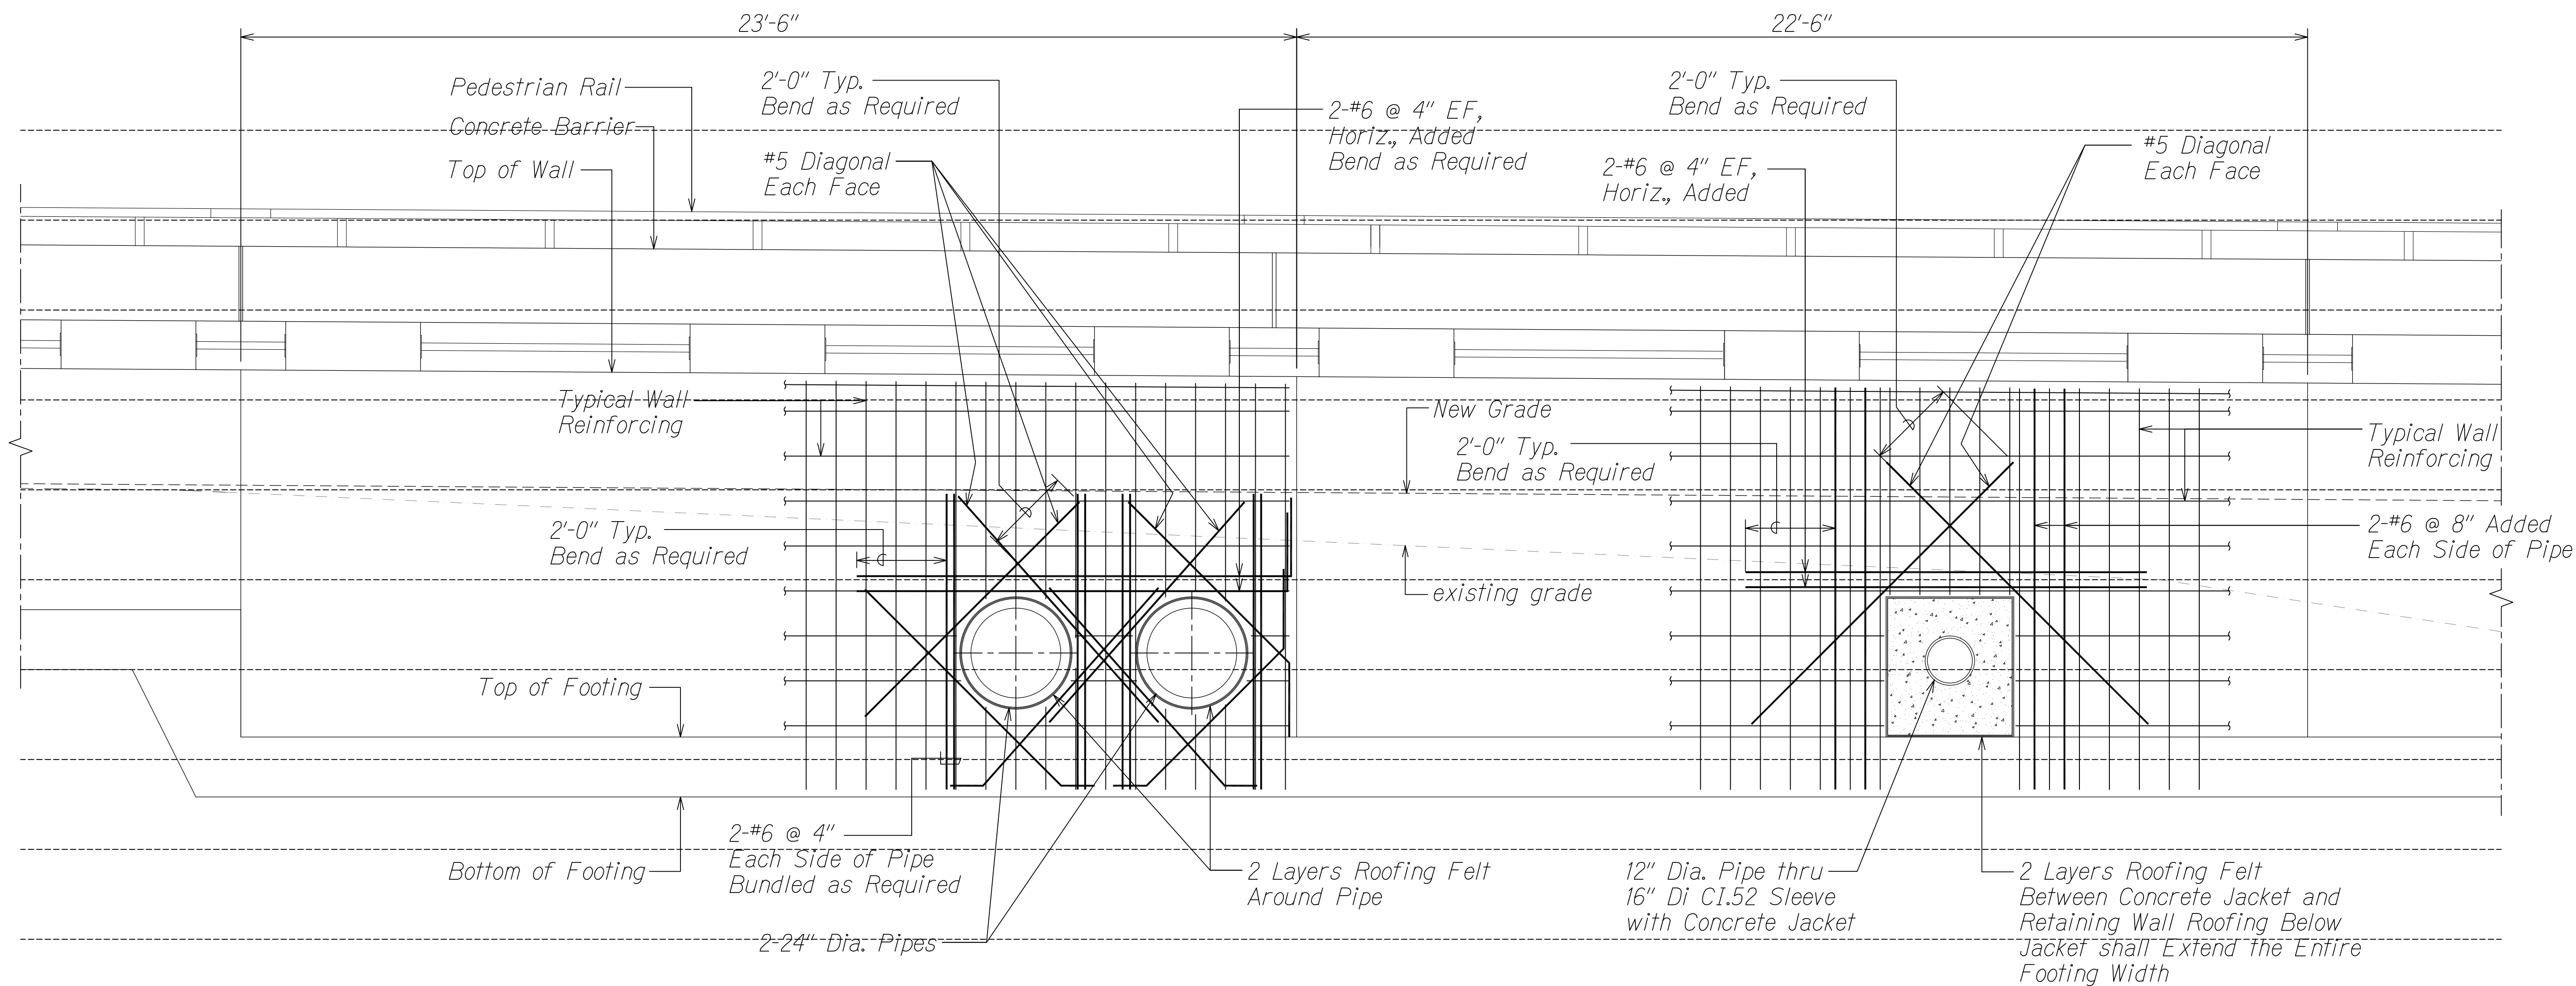

ADDED REINFORCING AT PIPE OPENING  
Scale: 1/2" = 1'-0"

A  
S1.4 S1.4

ORIGINAL PLAN	SURVEY PLOTTED BY	DATE
NOTE BOOK	DRAWN BY	
No.	DESIGNED BY	
	QUANTITIES BY	
	CHECKED BY	

DRAWING NAME: C:\PROJECTS\KAHULUI-2011\AS-BUILT OCTOBER 2017\STRUCTURAL\KAH-S104 C01.DWG PLOT TIME: 10-18-18, 2:18 PM

THIS WORK WAS PREPARED BY ME  
OR UNDER MY SUPERVISION.

KSF, INC. APRIL 30, 2016  
LIC. EXP. DATE

STATE OF HAWAII  
DEPARTMENT OF TRANSPORTATION  
HIGHWAYS DIVISION  
**ADDED REINFORCING AT  
PIPE OPENING**

KAHULUI AIRPORT  
ACCESS ROAD, PHASE I  
Federal Aid Project No. NH-0380(10)  
Scale: As Shown Date: February 2013

SHEET No. S1.4 OF 24 SHEETS

4/10/14	New Sheet
DATE	REVISION

"AS-BUILT"

C.O. 122S-1

AS-BUILT DRAWINGS












FED. ROAD DIST. NO.	STATE	FED. AID PROJ. NO.	FISCAL YEAR	SHEET NO.	TOTAL SHEETS
HAWAII	HAW.	NH-0380(10)	2013	C.O. 125	166

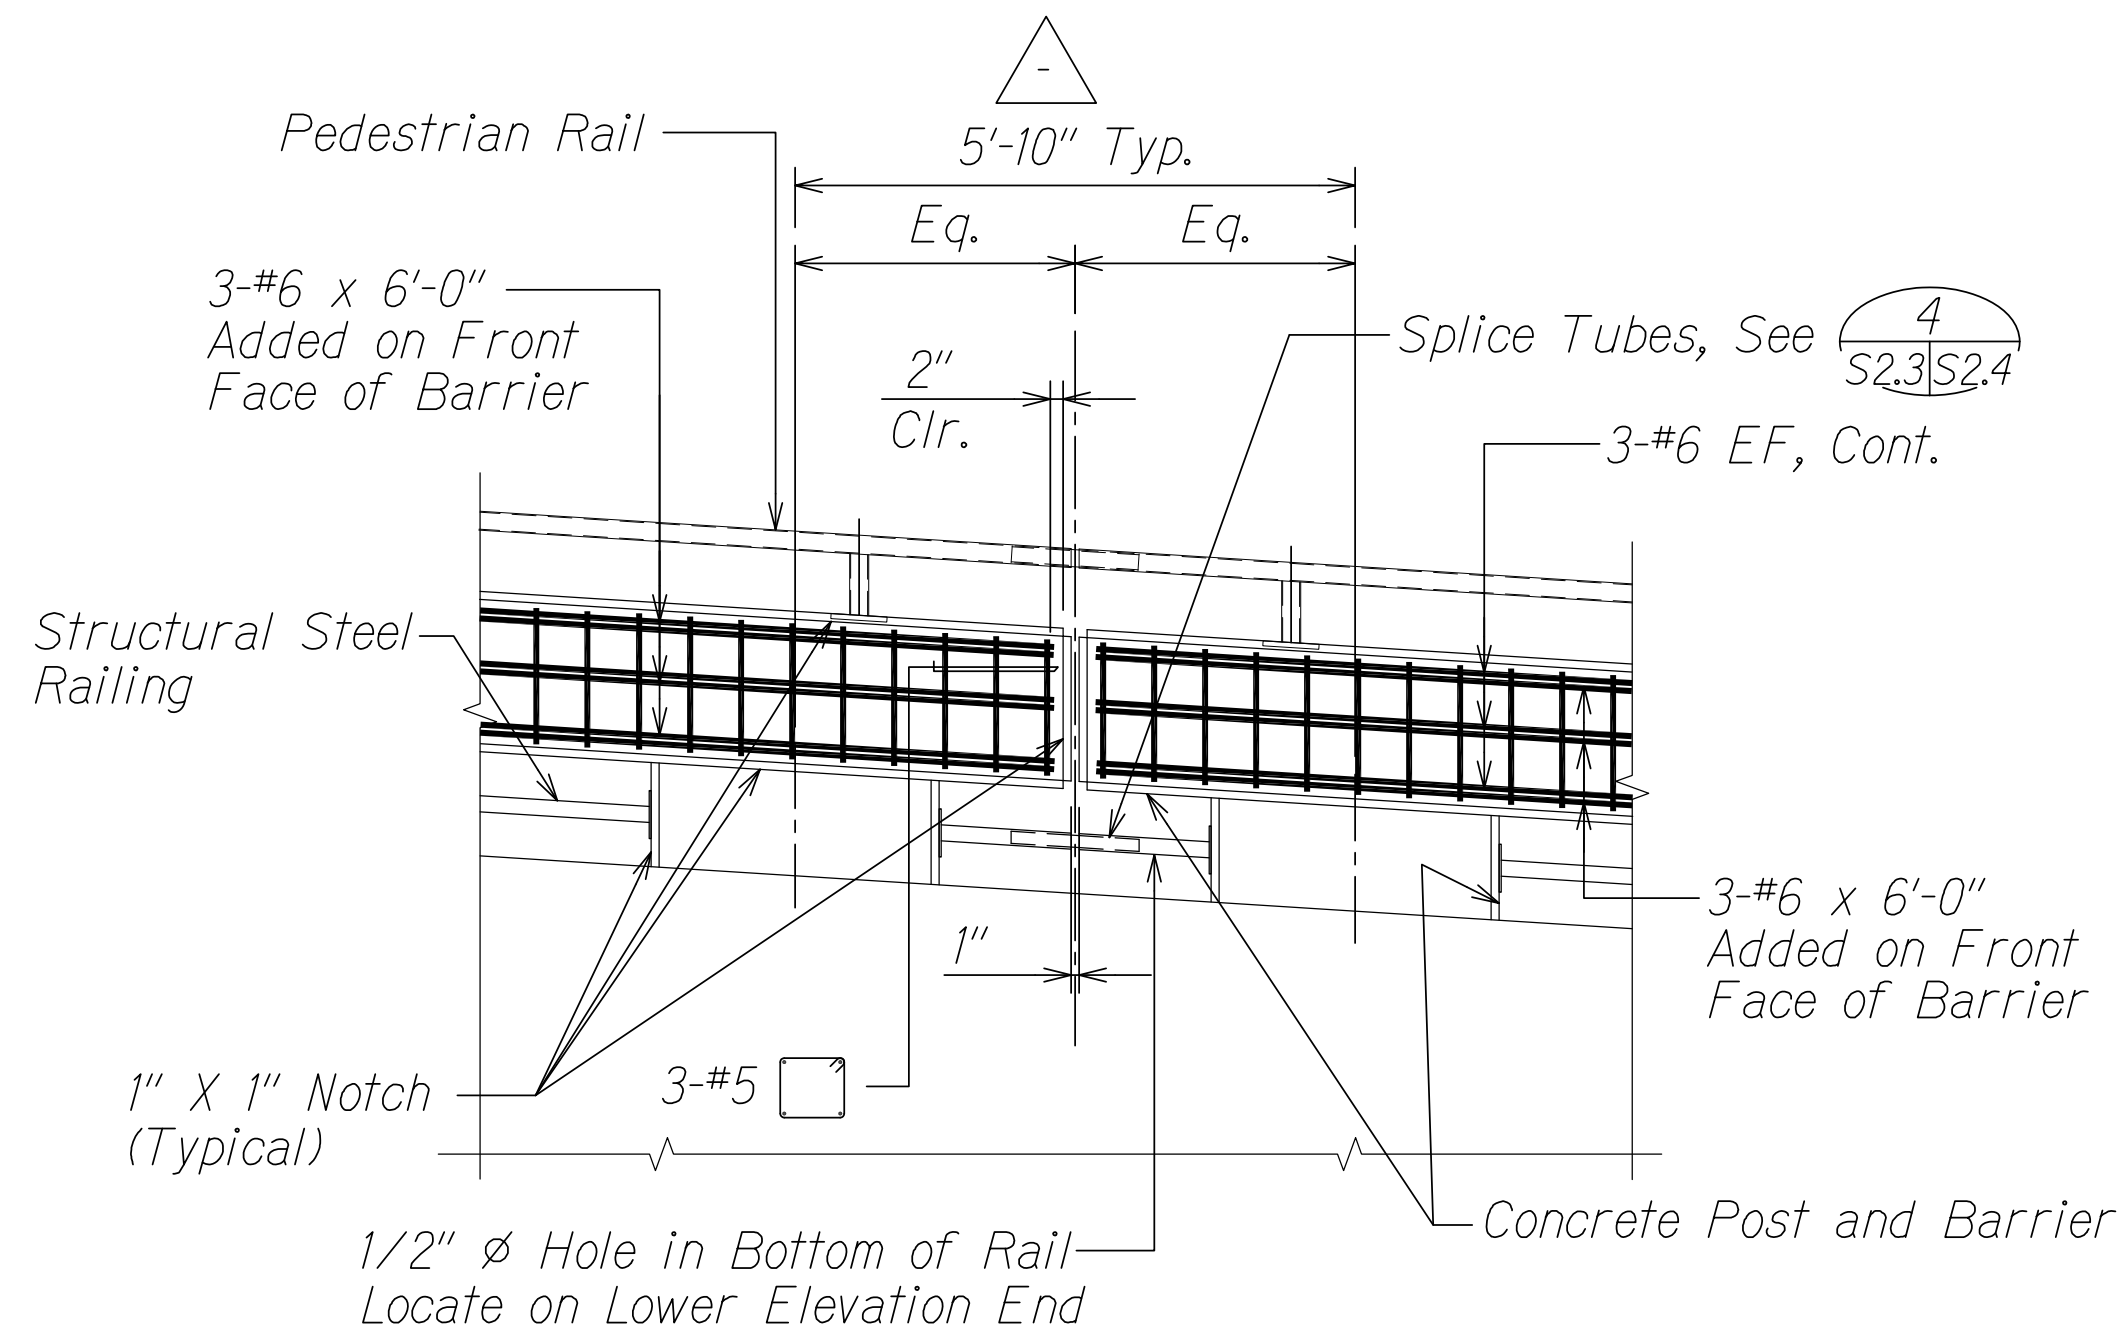


Note:  
See Sheets S2.1 and S2.2 for Additional Details

### TYPICAL RAILING EXPANSION JOINT

Scale: 1/2" = 1'-0"

1  
S2.3 S2.3

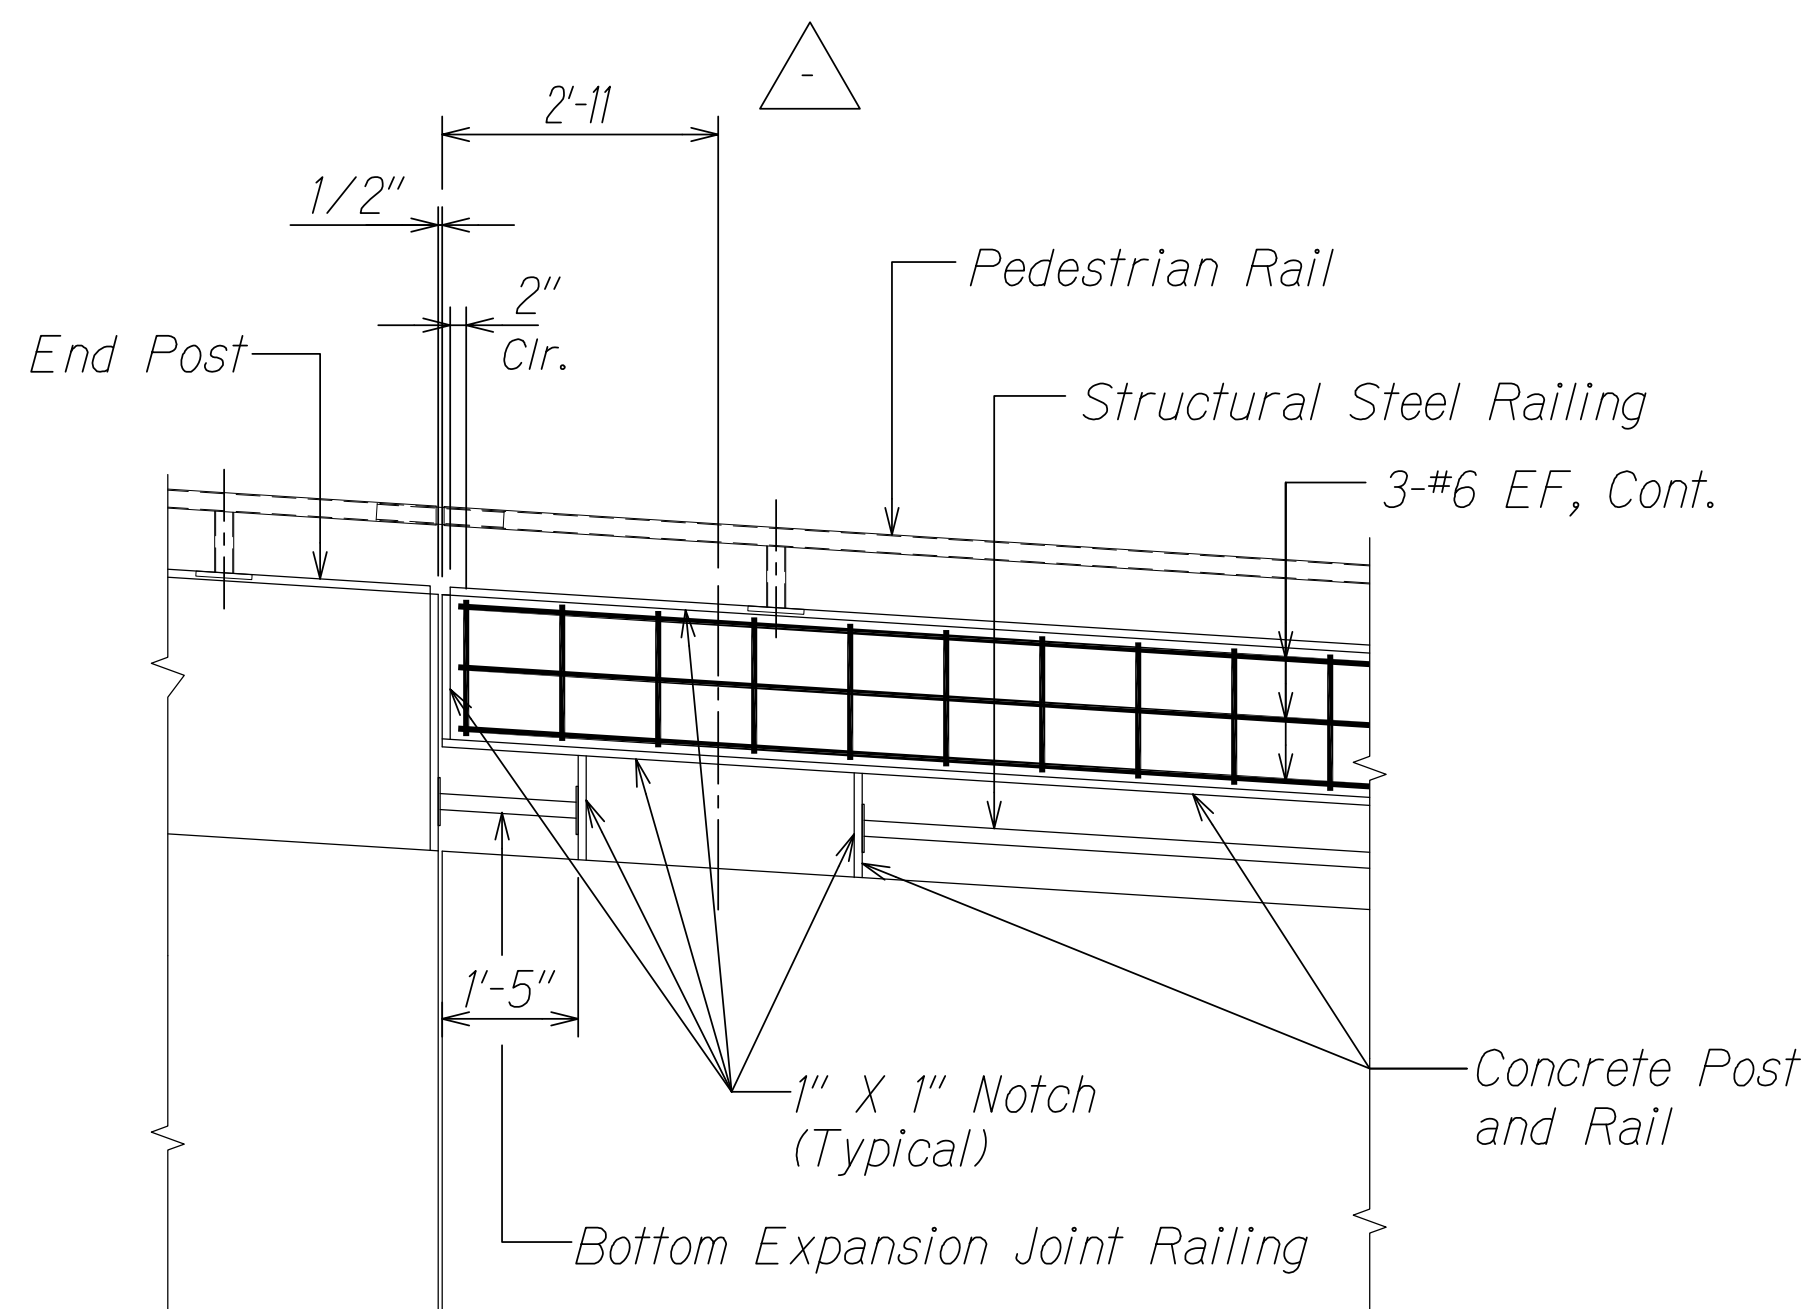

Note:  
See Sheet S2.1 and S2.2 for Additional Details

### TYPICAL RAILING DETAIL AT END POST

Scale: 1/2" = 1'-0"

2  
S2.3 S2.3

THIS WORK WAS PREPARED BY ME  
OR UNDER MY SUPERVISION.

KSF, INC. APRIL 30, 2016  
LIC. EXP. DATE

STATE OF HAWAII  
DEPARTMENT OF TRANSPORTATION  
HIGHWAYS DIVISION

### RAILING SECTION AND DETAILS

KAHULUI AIRPORT  
ACCESS ROAD, PHASE I  
Federal Aid Project No. NH-0380(10)  
Scale: As Shown Date: February 2013

SHEET No. S2.3 OF 24 SHEETS

DATE	REVISION
8/8/14	Revised Details
6/26/14	Revised Details

C.O. 125


ORIGINAL PLAN	SURVEY PLOTTED BY _____	DATE _____
NOTE BOOK	DRAWN BY _____	" _____
	TRACED BY _____	" _____
	DESIGNED BY _____	" _____
	QUANTITIES BY _____	" _____
	CHECKED BY _____	" _____
No. _____		

DRAWING NAME: C:\PROJECTS\KAHULUI-2011\AS-BUILT OCTOBER 2017\STRUCTURAL\KAH-S203 C02 C03.DWG PLOT TIME: 10-30-18, 10:00 AM


AS-BUILT DRAWINGS




FED. ROAD DIST. NO.	STATE	FED. AID PROJ. NO.	FISCAL YEAR	SHEET NO.	TOTAL SHEETS
HAWAII	HAW.	NH-0380(10)	2013	C.O. 126	166

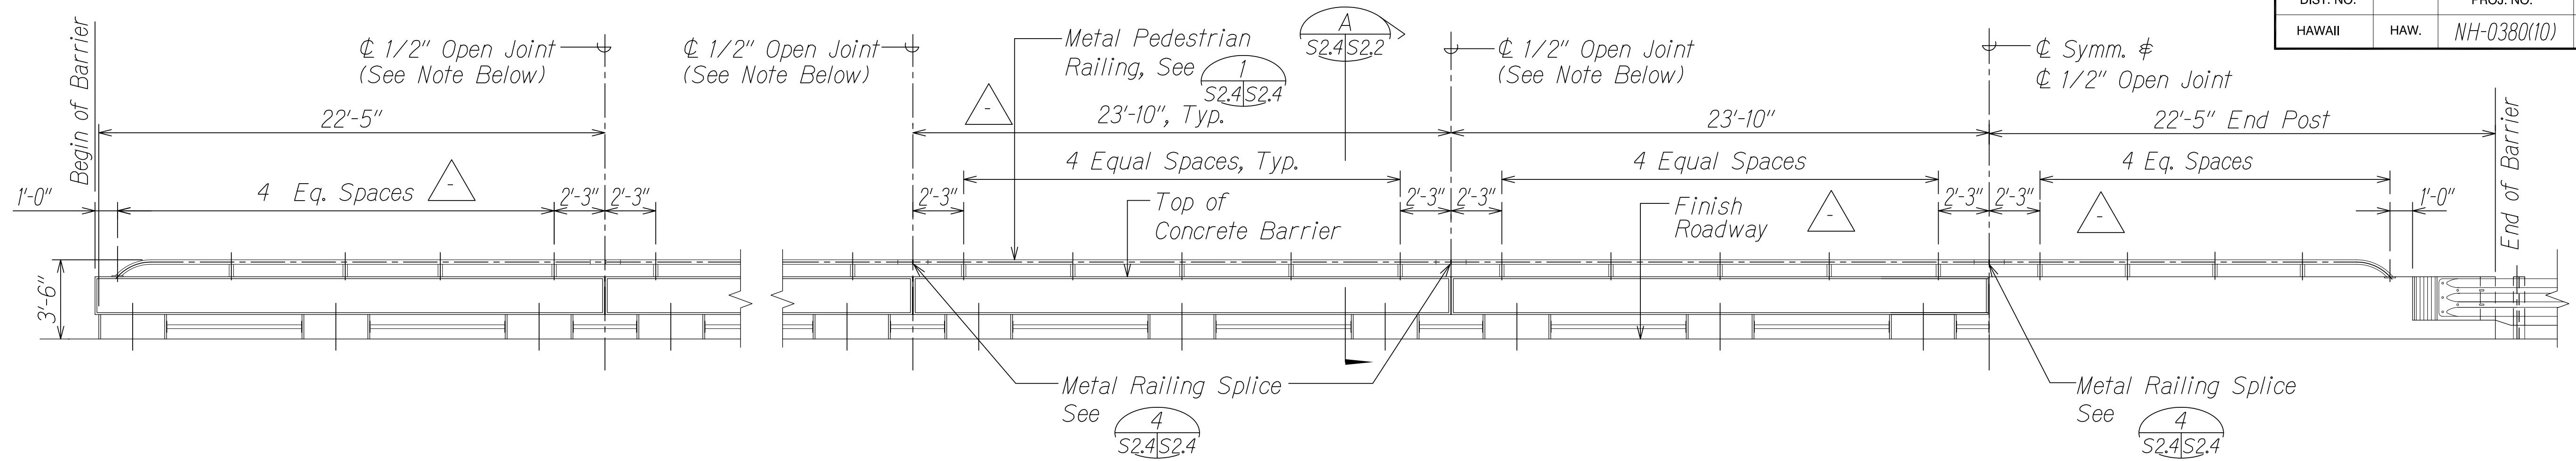


TYPICAL RAILING ELEVATION  
Scale: 1/4" = 1'-0"

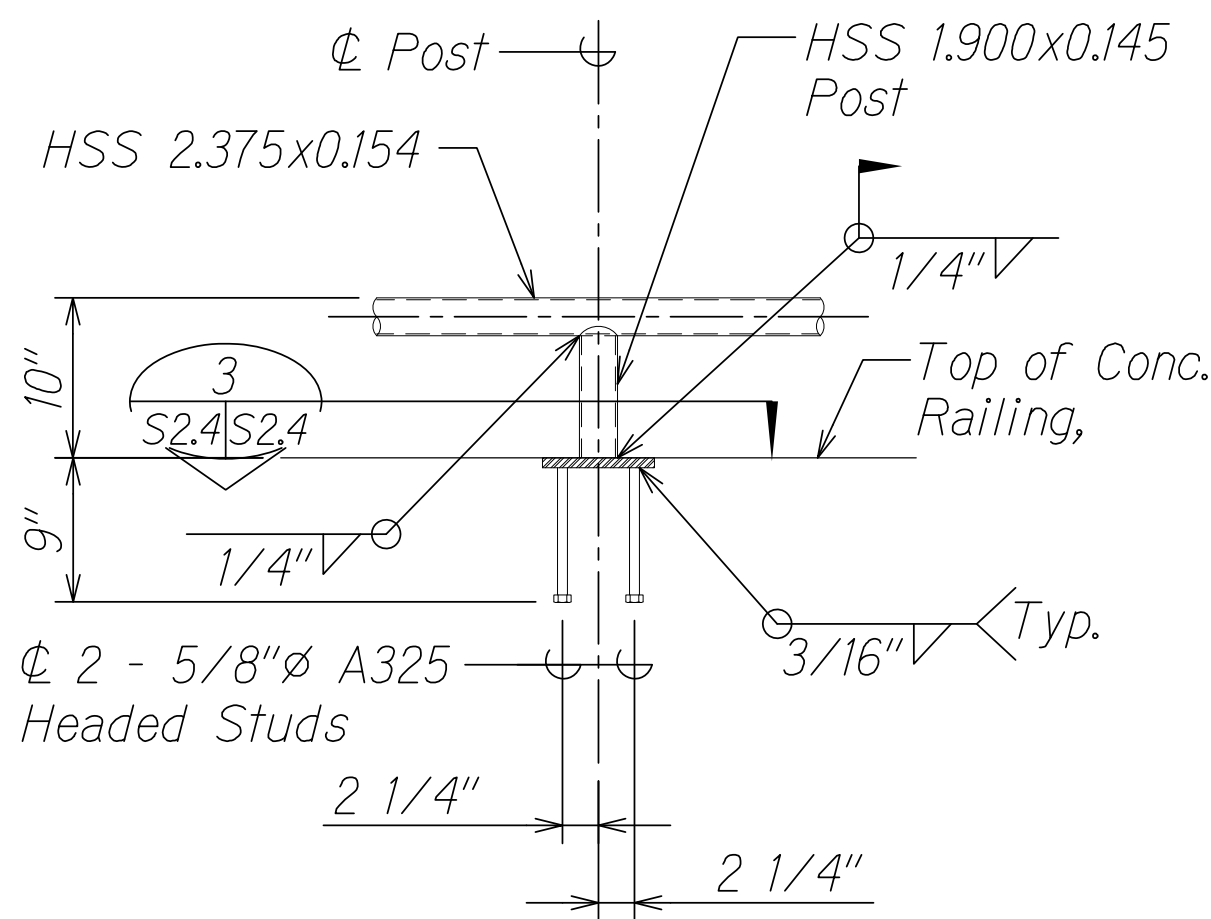


TYPICAL RAILING POST CONNECTION  
Scale: 1" = 1'-0"

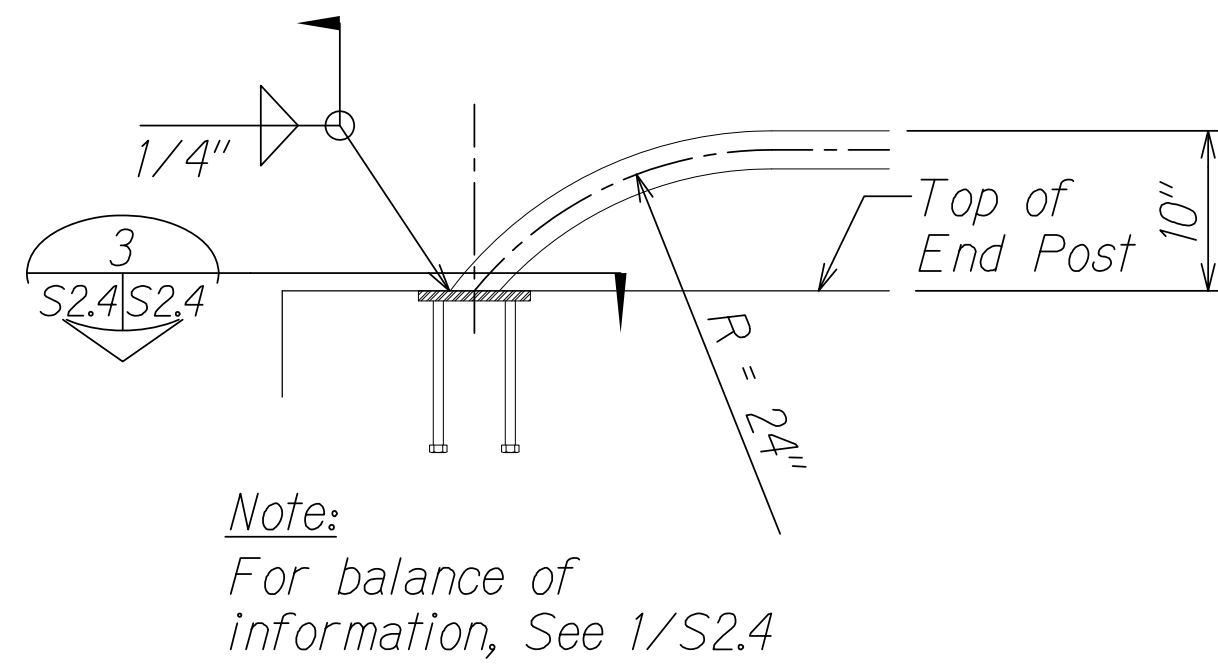

TYPICAL RAILING CONNECTION AT ENDS  
Scale: 1" = 1'-0"

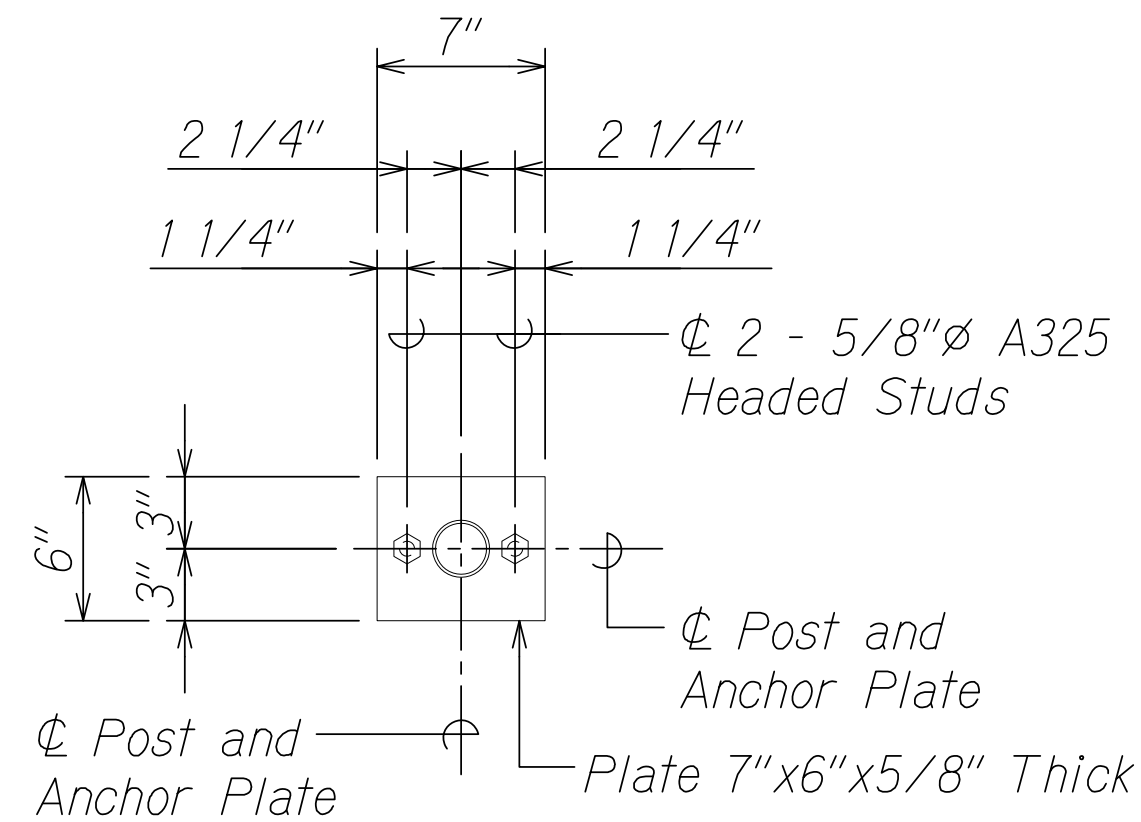

TYPICAL RAILING ANCHOR PLATE DETAIL  
Scale: 1 1/2" = 1'-0"

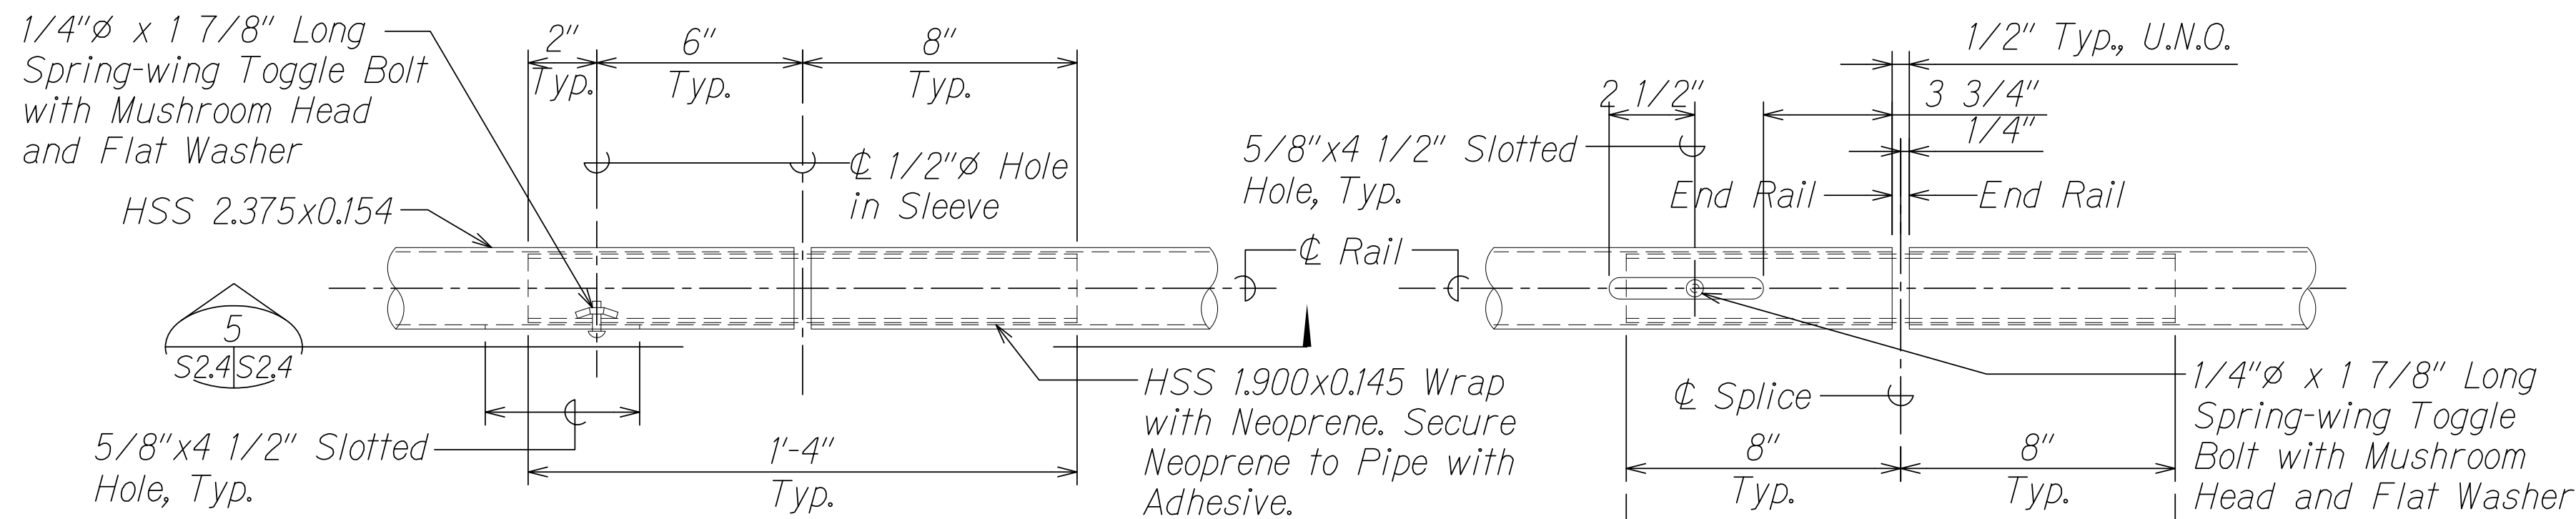

- Notes:
- Concrete railing expansion joint and metal railing expansion joint shall be located between the same two adjacent railing posts.
  - Slotted hole and toggle bolt shall be located on under side of pipe.
  - After field welding, clean and coat damaged galvanized coating according to Specs. Sect. 501.03 (GX2).

TYPICAL RAILING EXPANSION JOINT DETAIL  
Scale: 3" = 1'-0"


SECTION  
Scale: 3" = 1'-0"

8/8/14	Revised Details
6/26/14	Revised Details
DATE	REVISION


STATE OF HAWAII DEPARTMENT OF TRANSPORTATION HIGHWAYS DIVISION KAHULUI AIRPORT ACCESS ROAD, PHASE I Federal Aid Project No. NH-0380(10) Scale: As Shown Date: February 2013
SHEET No. S2.4 OF 24 SHEETS



FED. ROAD DIST. NO.	STATE	FED. AID PROJ. NO.	FISCAL YEAR	SHEET NO.	TOTAL SHEETS
HAWAII	HAW.	NH-0380(10)	2013	C.O. 127	166

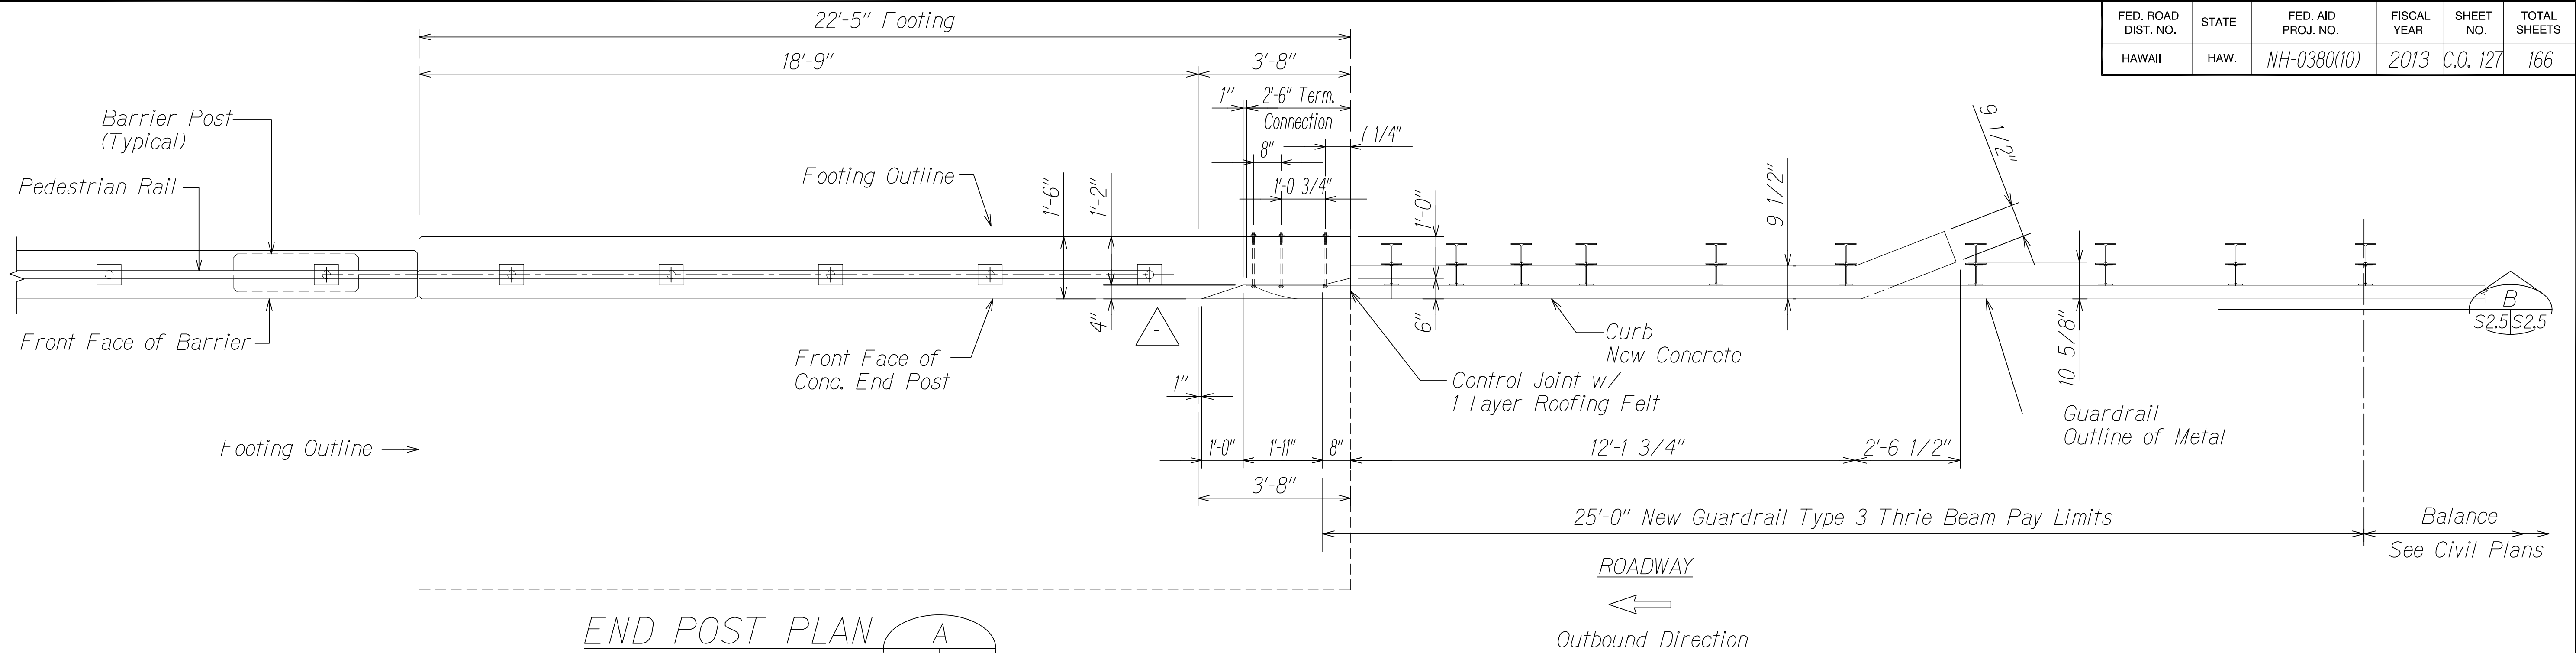


END POST PLAN  
Scale: 1/2" = 1'-0"

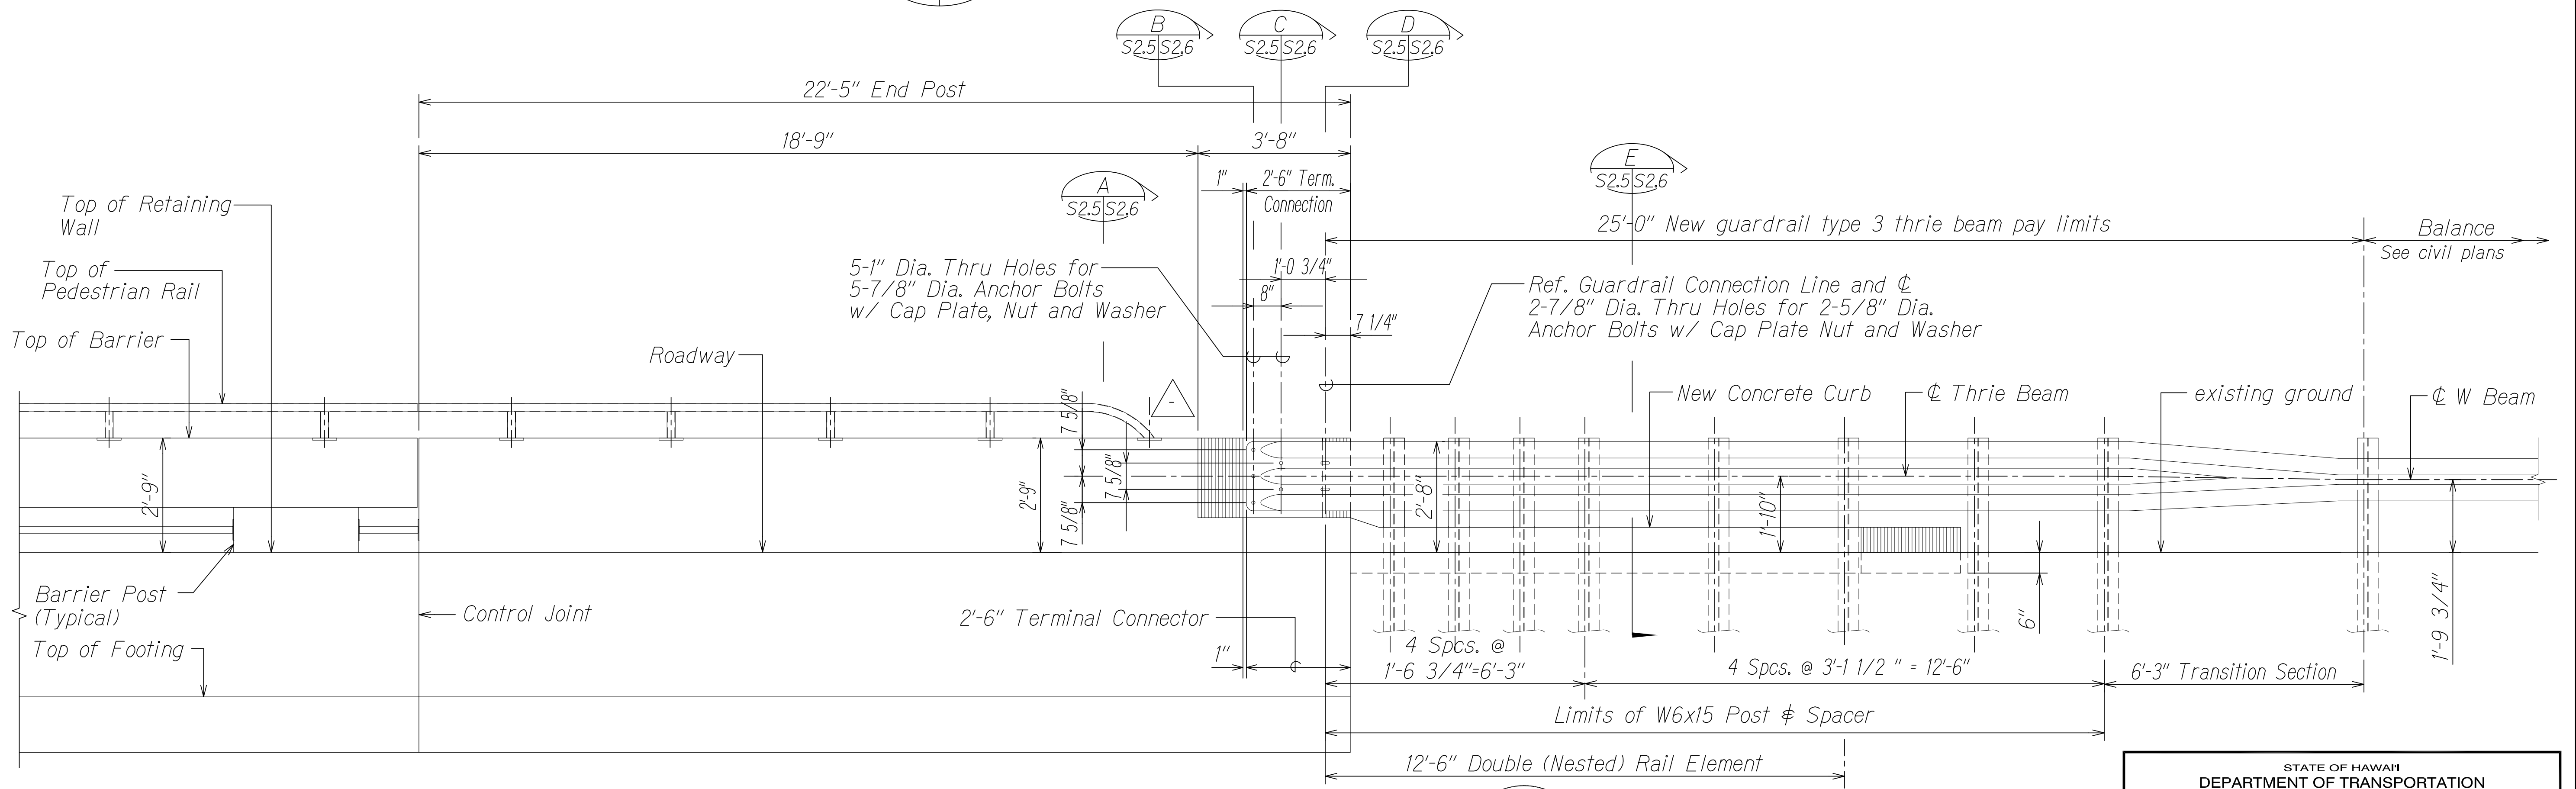

END POST ELEVATION  
Scale: 1/2" = 1'-0"

TYPE "A" AND TYPE "B" END POST UPGRADES

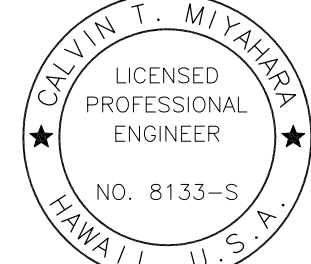

THIS WORK WAS PREPARED BY ME OR UNDER MY SUPERVISION.

KSF, INC. APRIL 30, 2016 LIC. EXP. DATE

DATE	REVISION
8/8/14	Revised Details
6/26/14	Revised Details

STATE OF HAWAII  
DEPARTMENT OF TRANSPORTATION  
HIGHWAYS DIVISION  
**TYPE "A" END POST AND  
TYPE "B" END POST**  
  
KAHULUI AIRPORT  
ACCESS ROAD, PHASE I  
Federal Aid Project No. NH-0380(10)  
Scale: As Shown Date: February 2013


SHEET No. S2.5 OF 24 SHEETS

ORIGINAL PLAN	DATE
NOTE BOOK	DESIGNED BY
No.	QUANTITIES BY
	CHECKED BY


DRAWING NAME: C:\PROJECTS\KAHULUI-2011\AS-BUILT OCTOBER 2017\STRUCTURAL\KAH-5205 C02 C03.DWG PLOT TIME: 10-30-18 10:05 AM




FED. ROAD DIST. NO.	STATE	FED. AID PROJ. NO.	FISCAL YEAR	SHEET NO.	TOTAL SHEETS
HAWAII	HAW.	NH-0380(10)	2013	C.O. 128	166

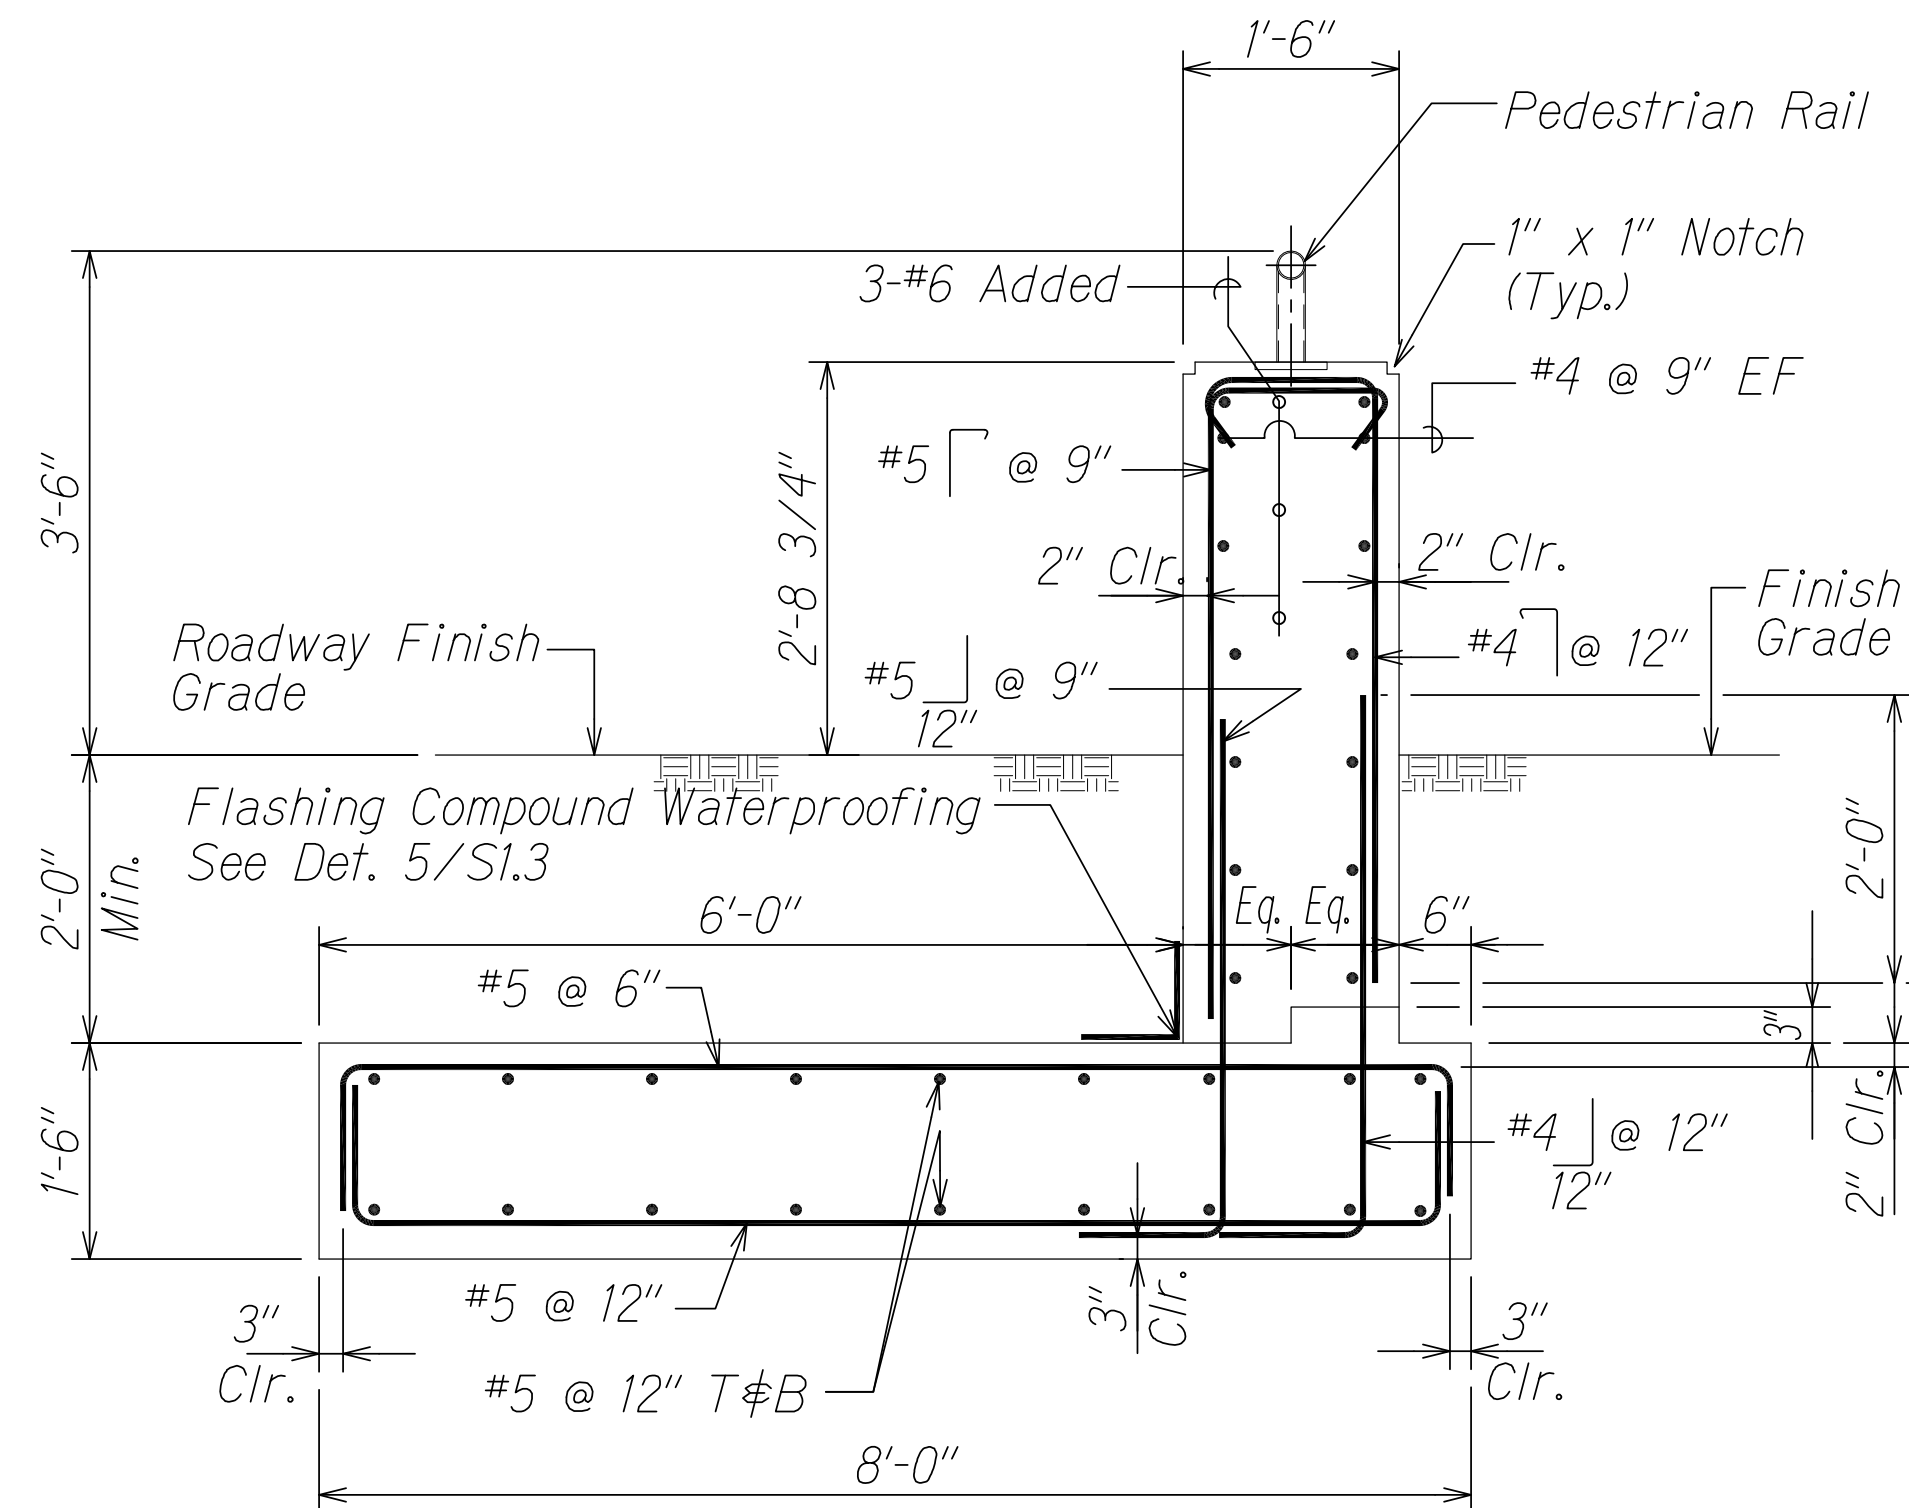


SECTION A  
Scale: 3/4" = 1'-0" S2.5 S2.6

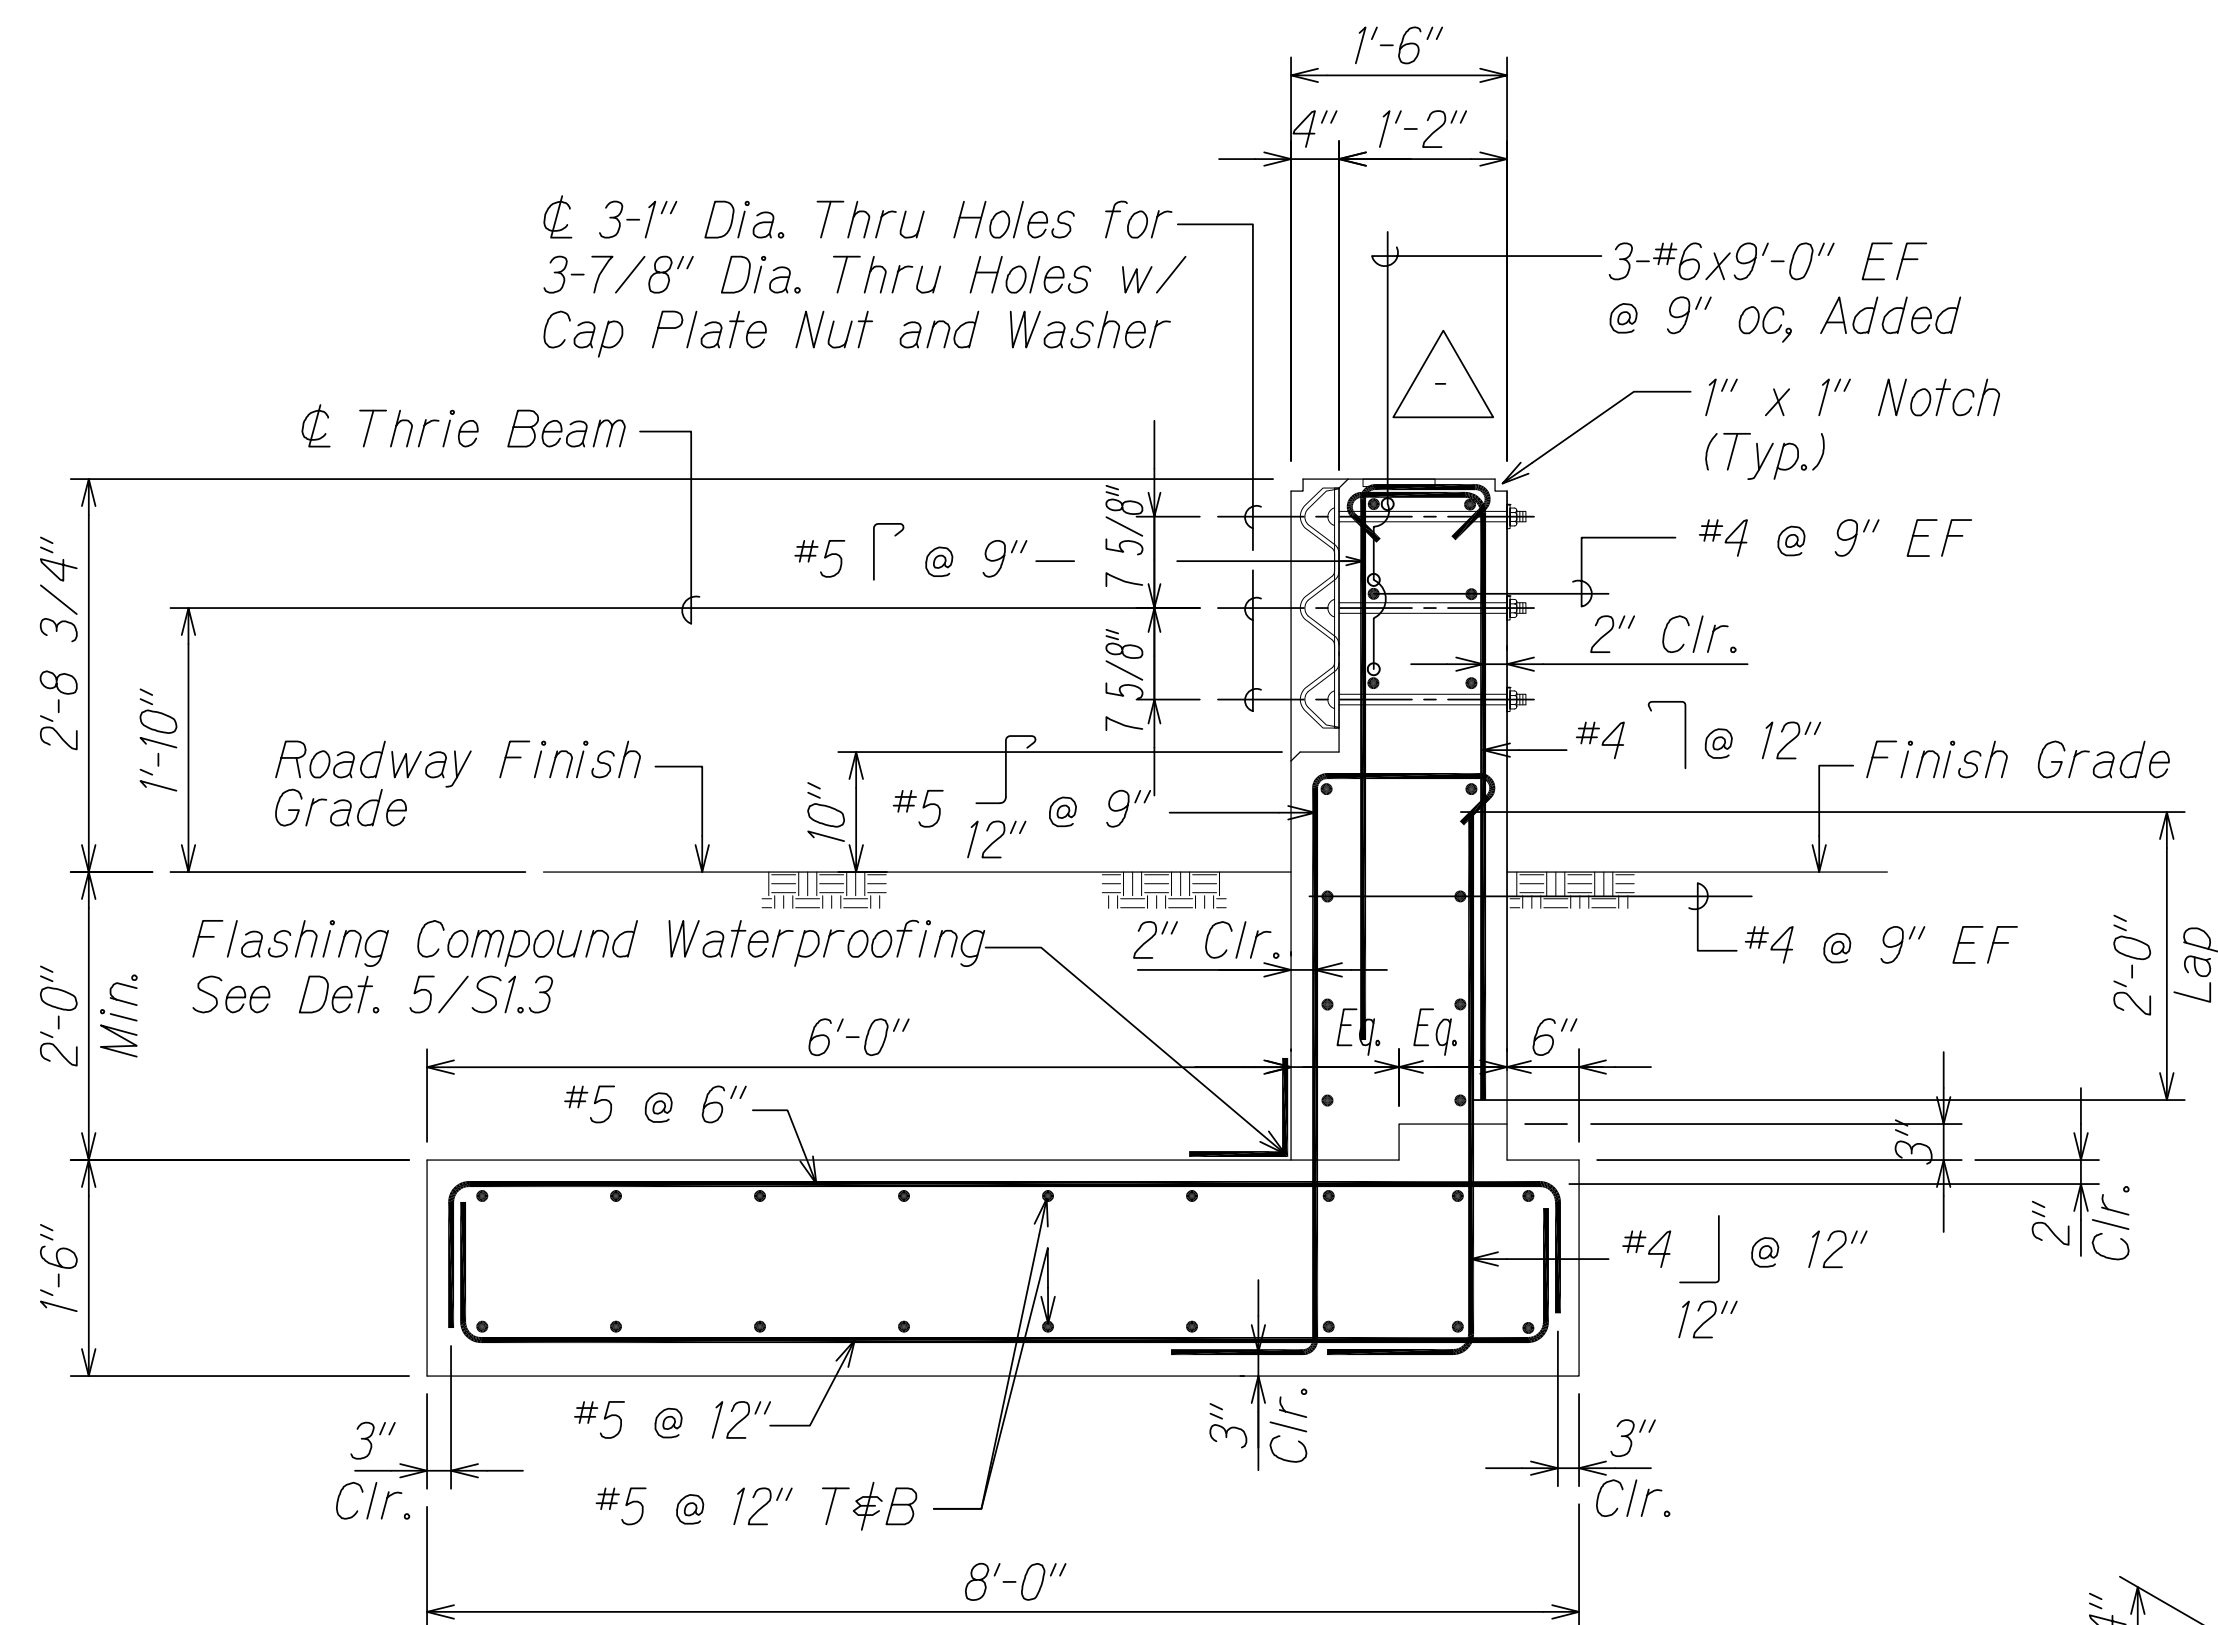


SECTION B  
Scale: 3/4" = 1'-0" S2.5 S2.6

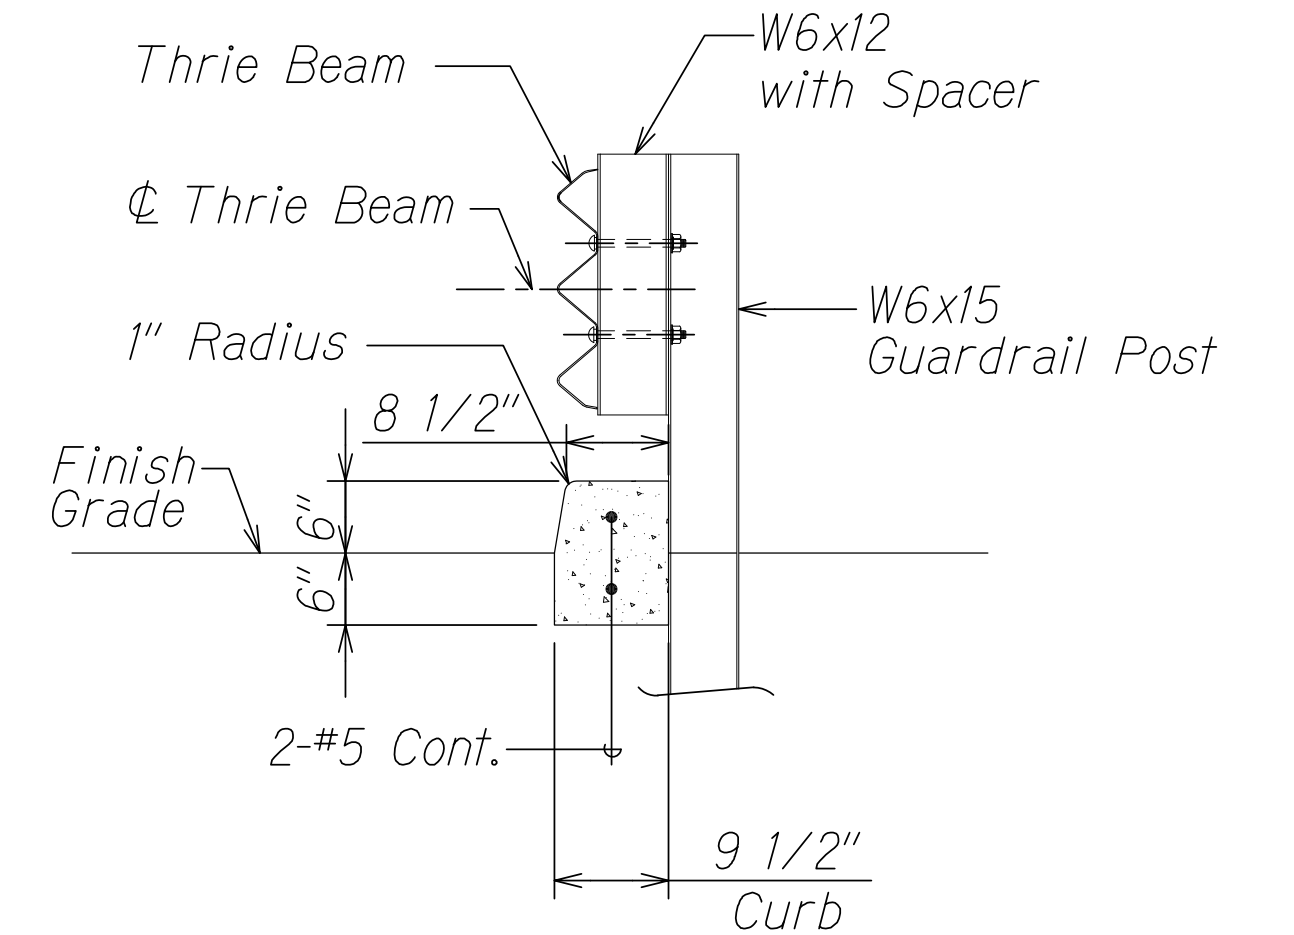


SECTION E  
Scale: 3/4" = 1'-0" S2.5 S2.6

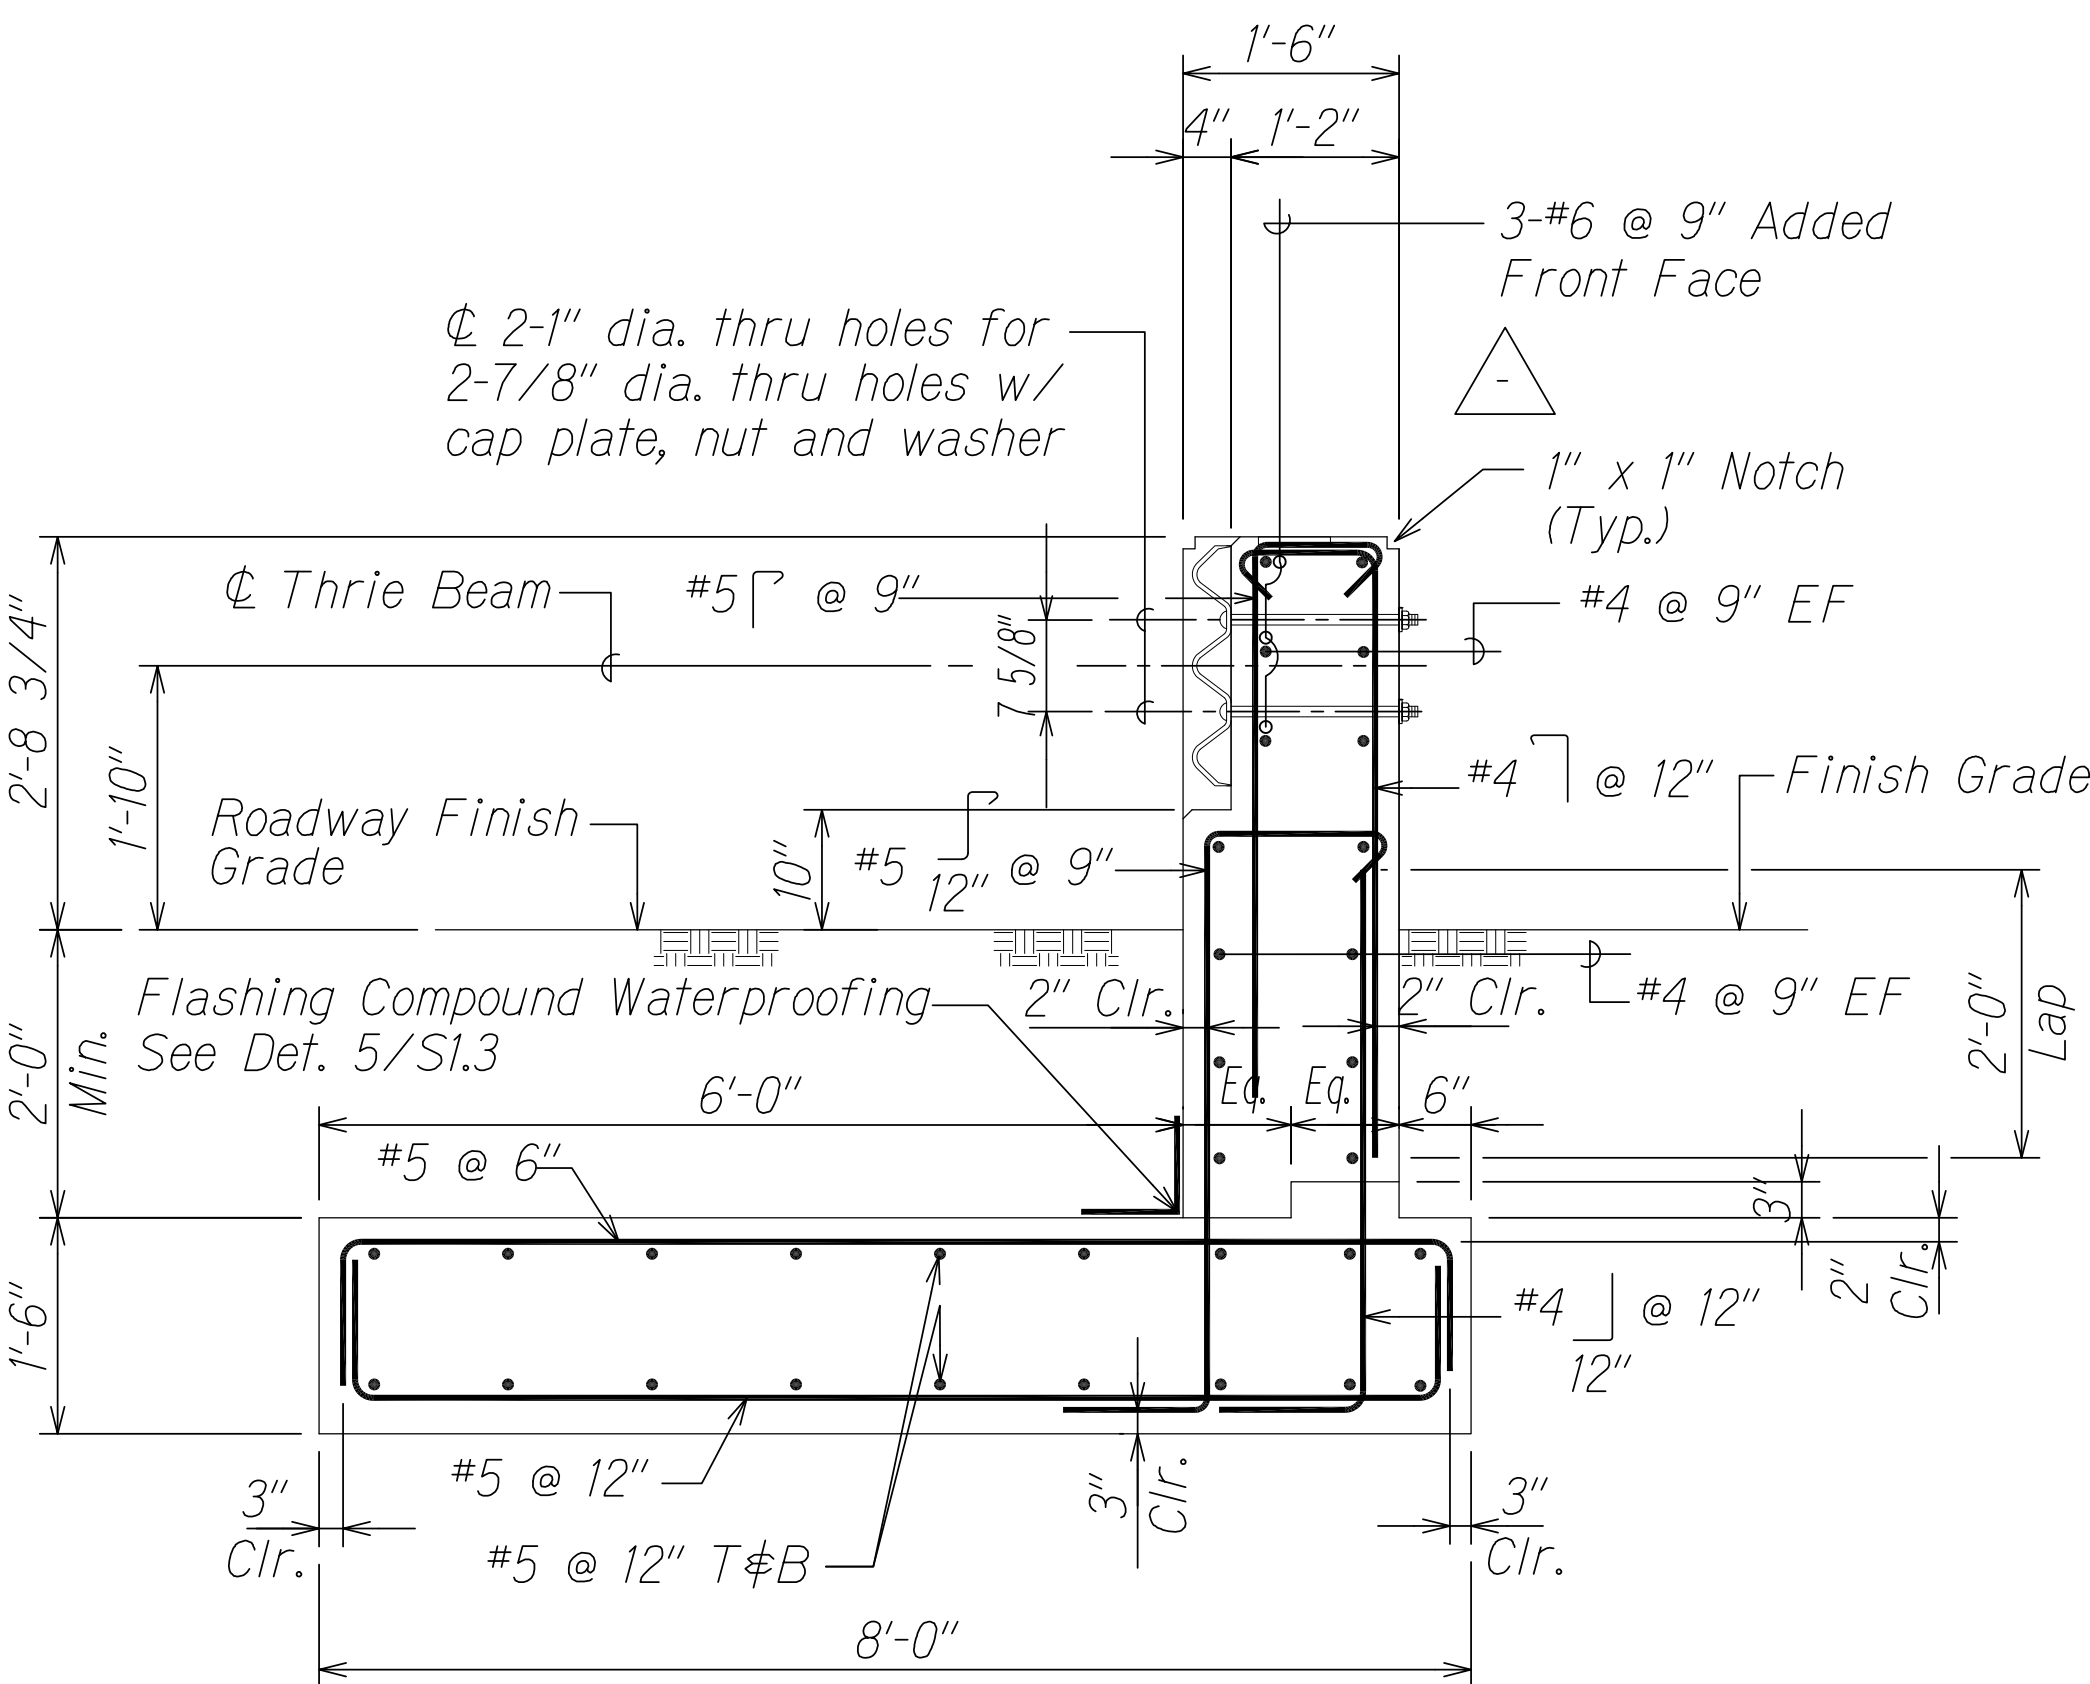

SECTION C  
Scale: 3/4" = 1'-0" S2.5 S2.6

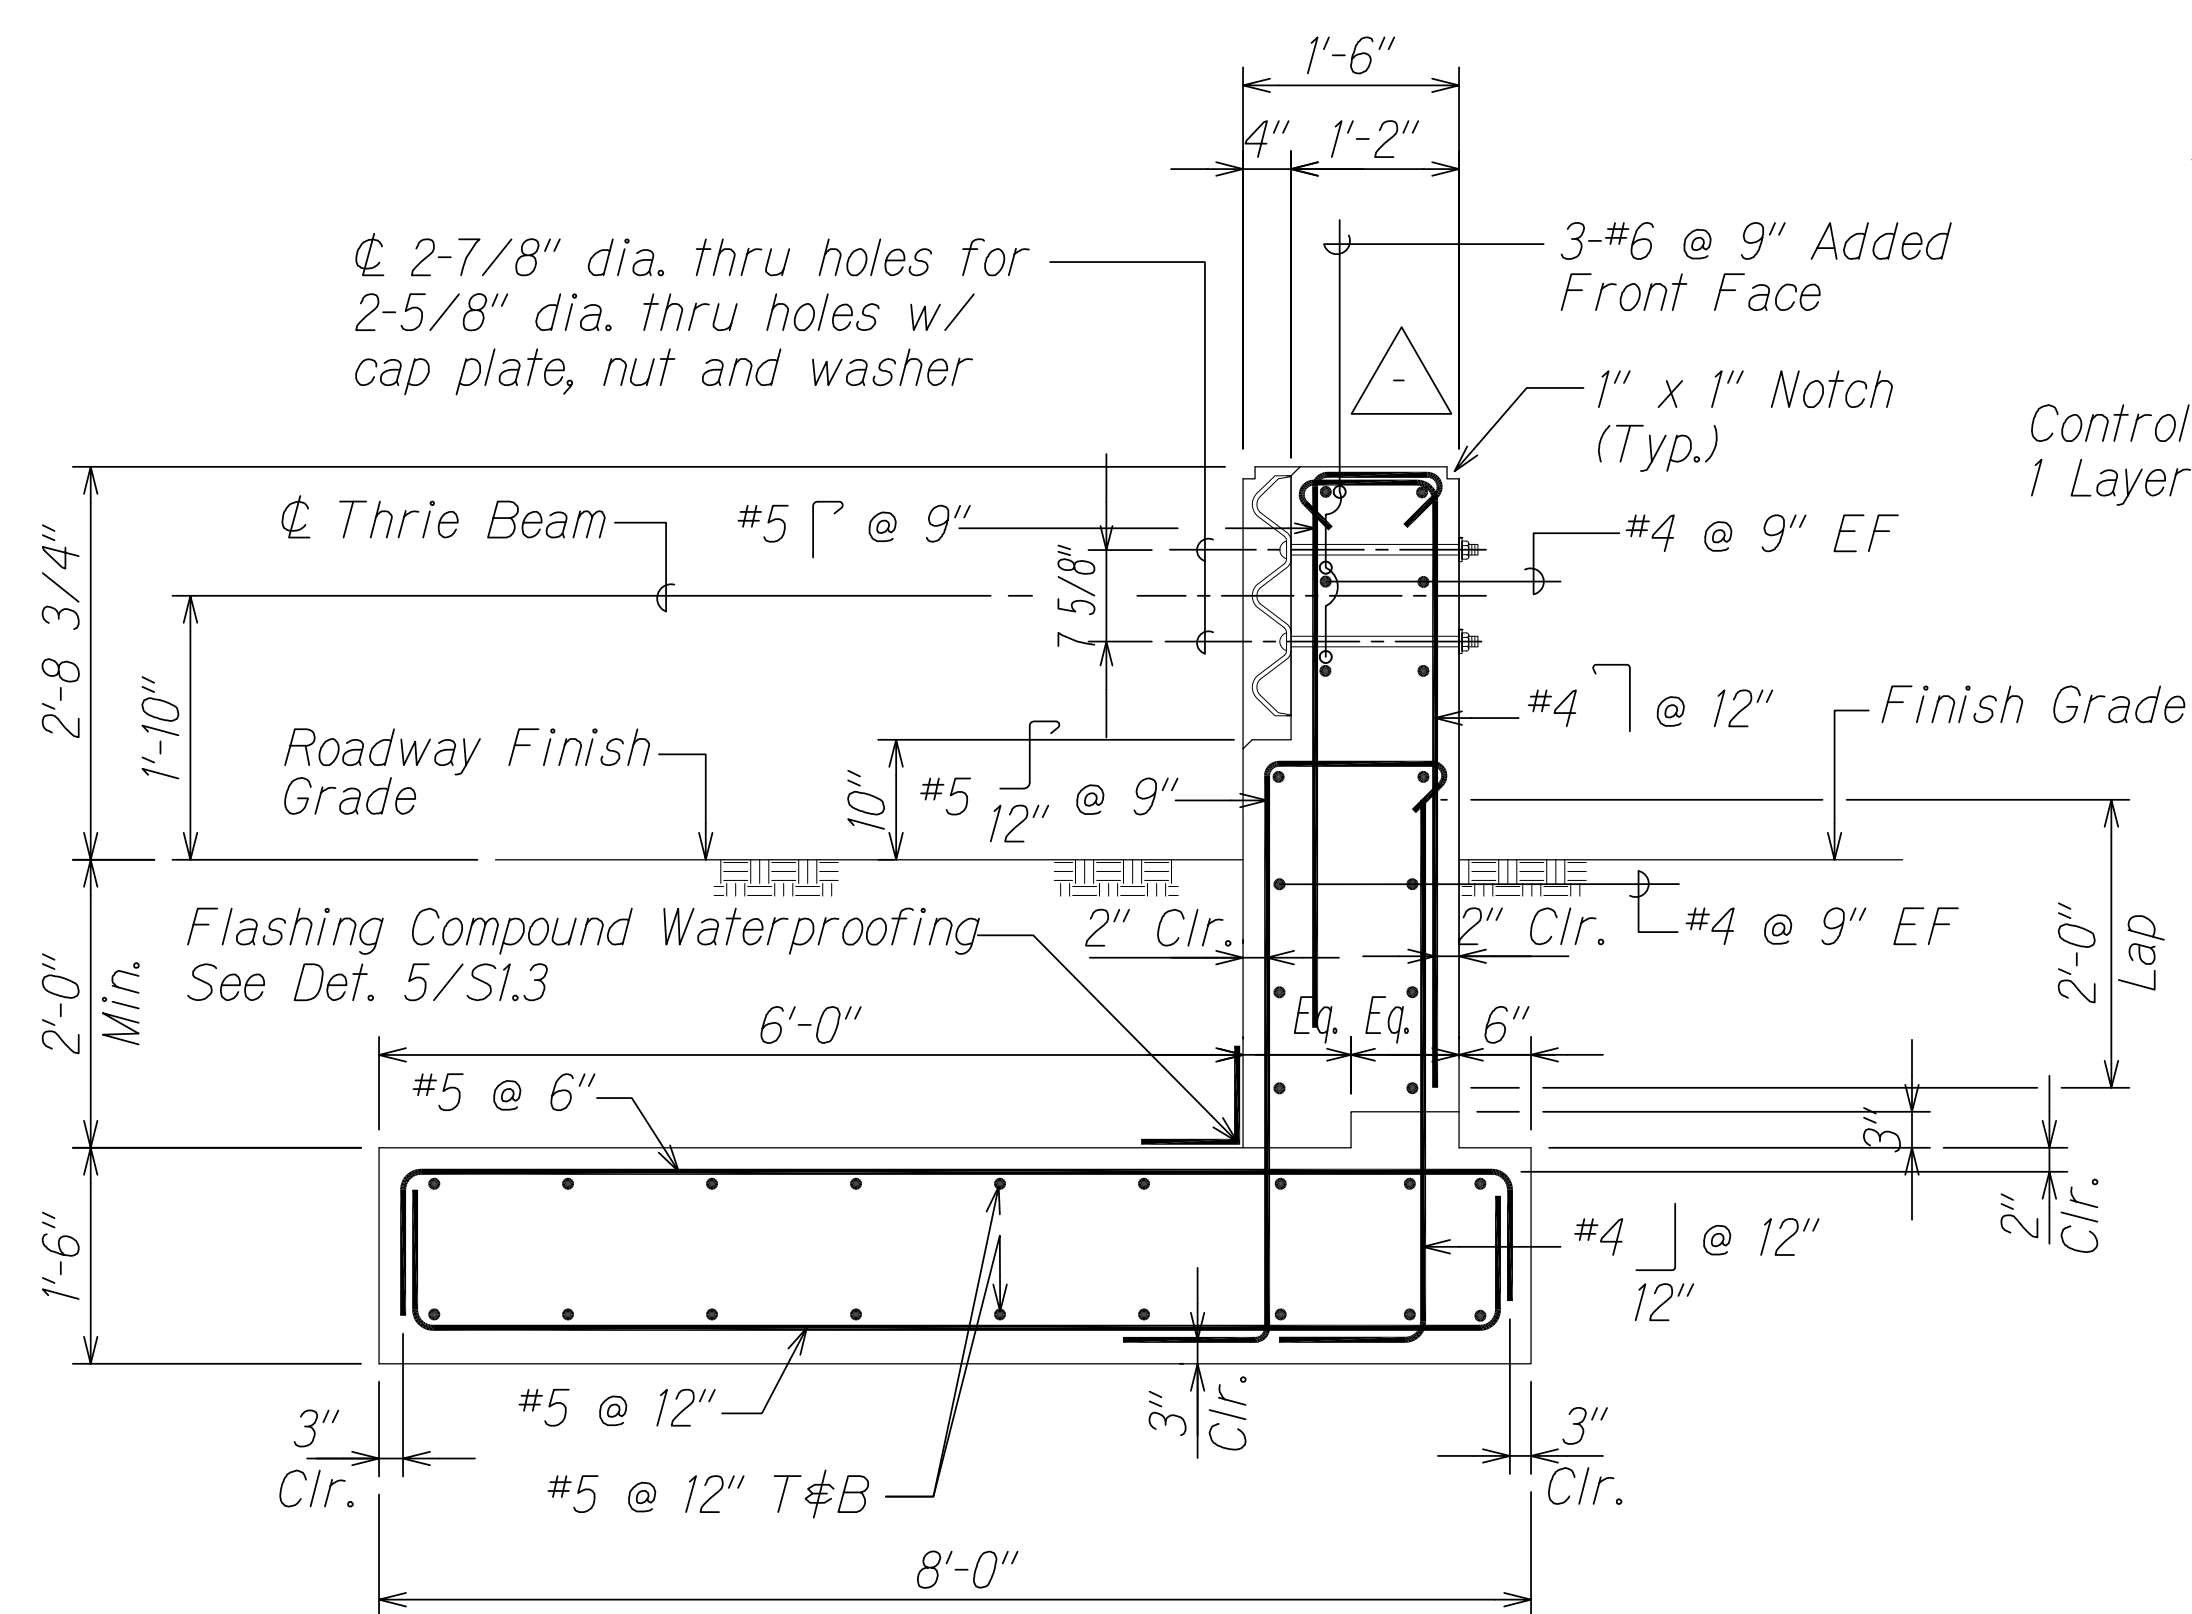

SECTION D  
Scale: 3/4" = 1'-0" S2.5 S2.6

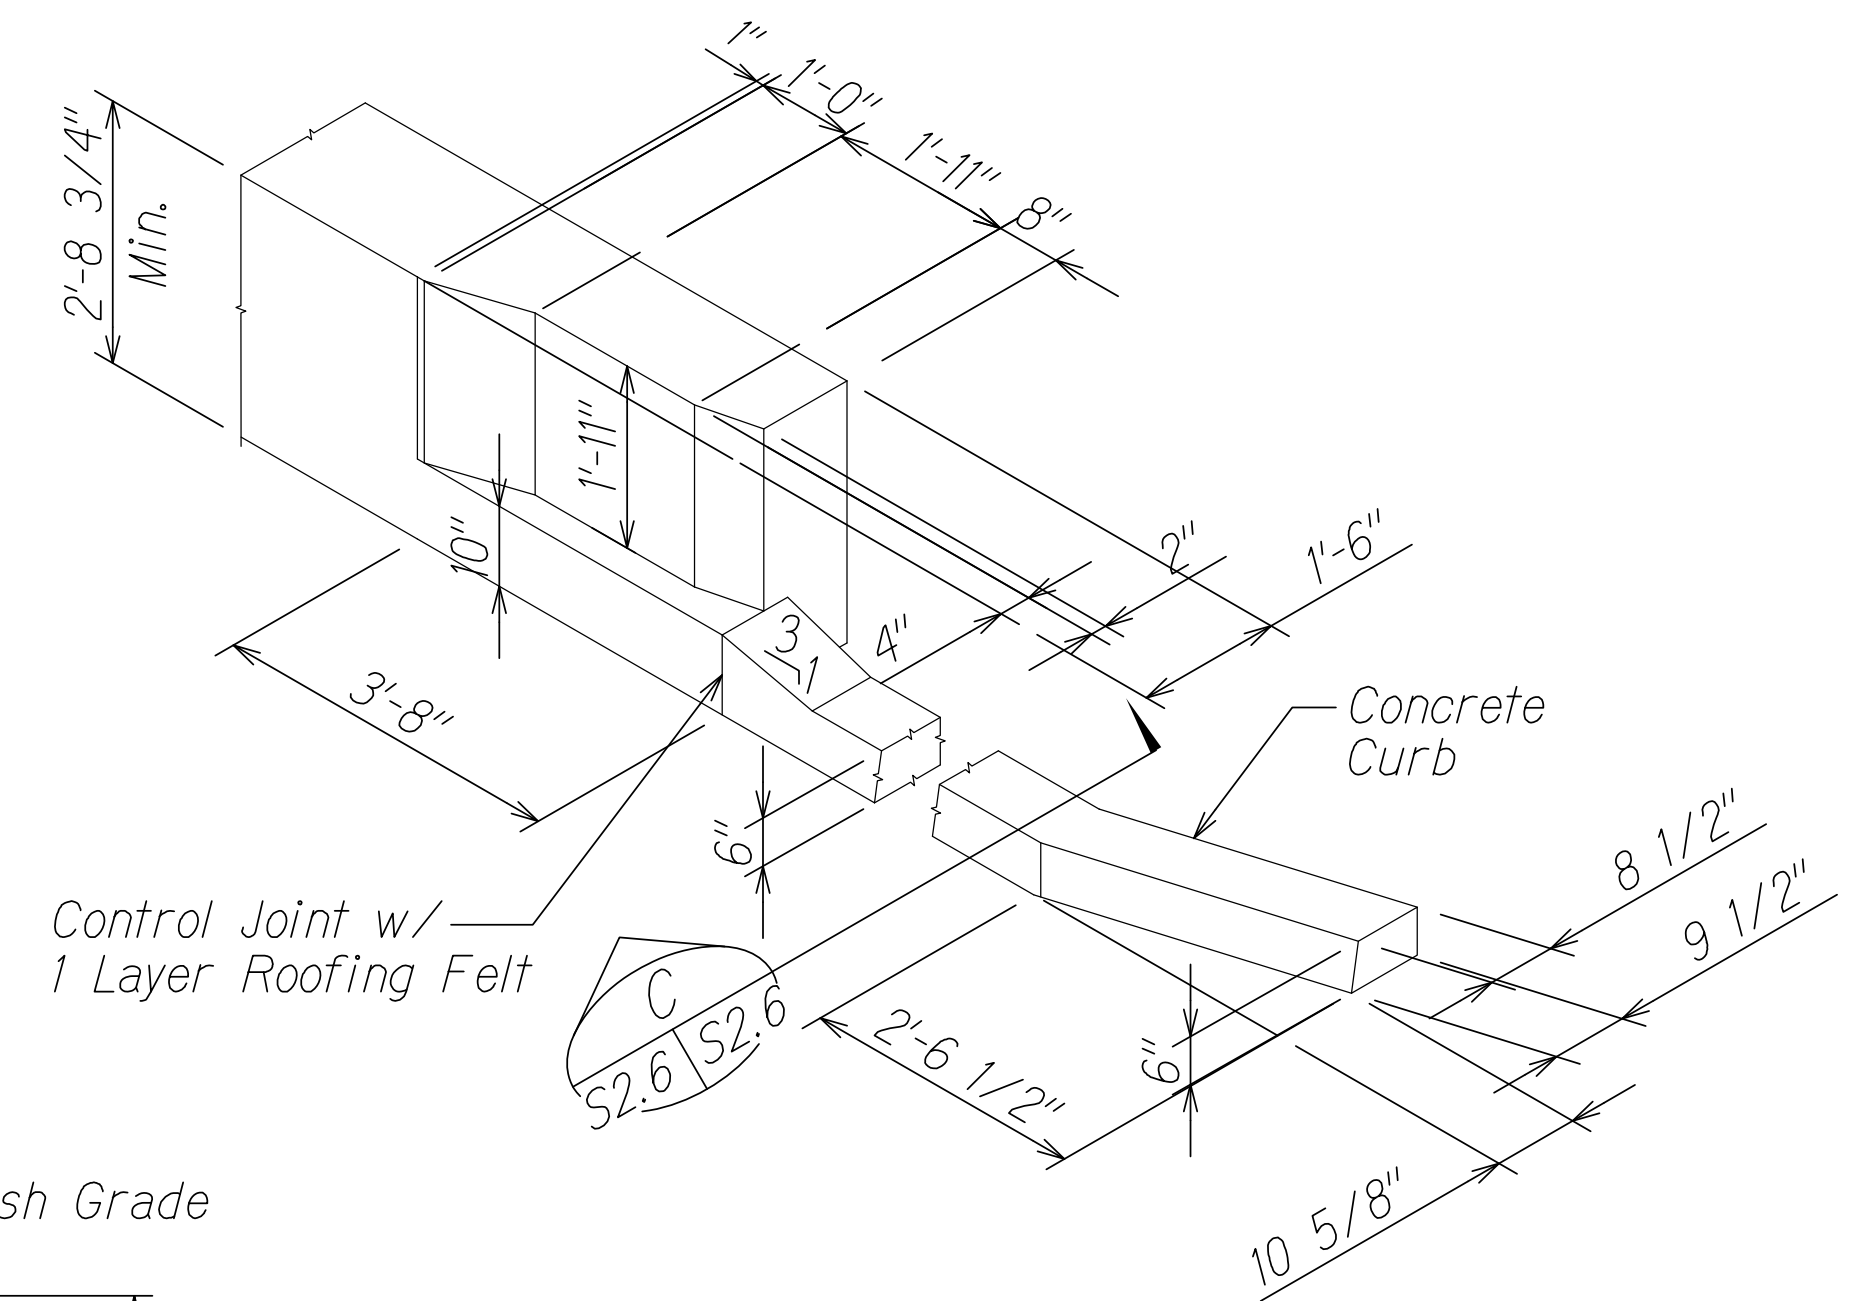

END POST DETAIL 1  
Scale: 1/2" = 1'-0" S2.6 S2.6

THIS WORK WAS PREPARED BY ME  
OR UNDER MY SUPERVISION.

APRIL 30, 2016  
LIC. EXP. DATE

STATE OF HAWAII  
DEPARTMENT OF TRANSPORTATION  
HIGHWAYS DIVISION

**END POST SECTIONS AND DETAIL**


KAHULUI AIRPORT  
ACCESS ROAD, PHASE I  
Federal Aid Project No. NH-0380(10)  
Scale: As Shown Date: February 2013

SHEET No. S26 OF 24 SHEETS

6/26/14	Revised Details
DATE	REVISION



FED. ROAD DIST. NO.	STATE	FED. AID PROJ. NO.	FISCAL YEAR	SHEET NO.	TOTAL SHEETS
HAWAII	HAW.	NH-0380(10)	2013	129	166

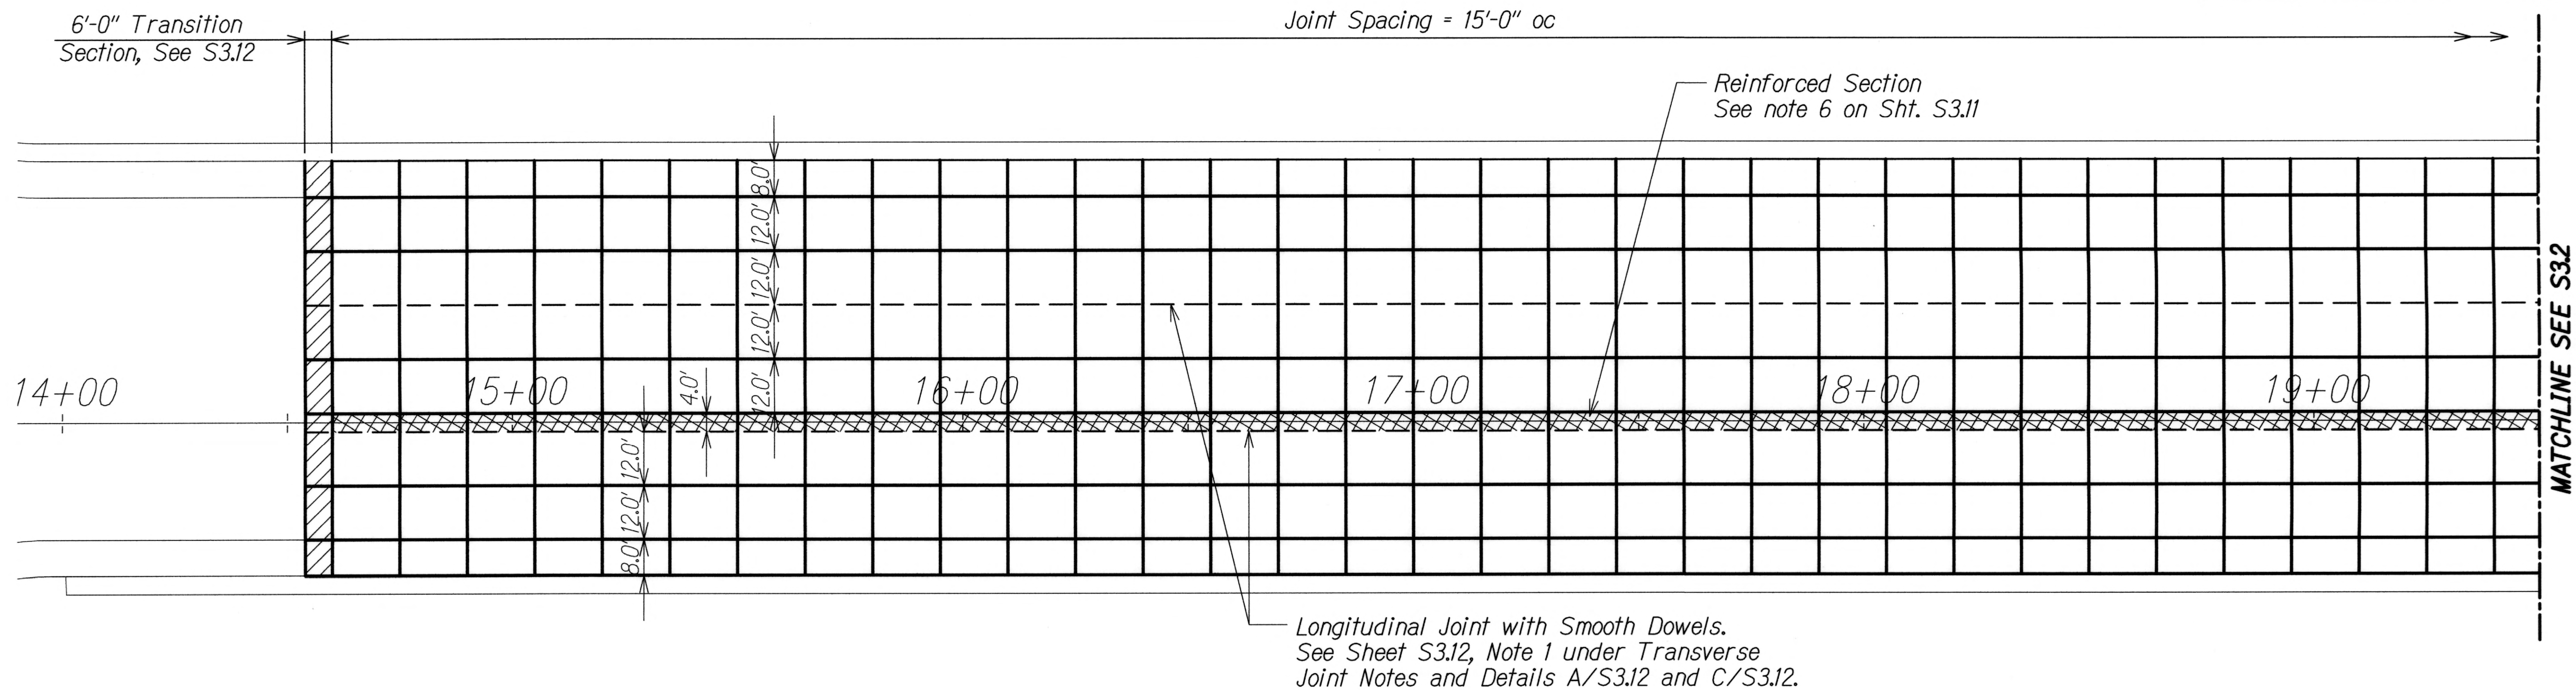

PLAN - STA. 14+00 TO 19+50 A  
Scale: 1" = 20'-0" S3.1 S3.1

ORIGINAL PLAN	SURVEY PLOTTED BY	DATE
NOTE BOOK	DRAWN BY	" "
No.	DESIGNED BY	" "
	CHECKED BY	" "

DRAWING NAME: Z:\00 ONGOING\11-006-KAAR-KAHULUI AIRPORT ACCESS RD-PH1 FA\CAD\02-22-13 BD\KAH-S301.DWG PLOT TIME: 02-22-13, 2:53 PM



THIS WORK WAS PREPARED BY ME  
OR UNDER MY SUPERVISION.  
*Calvin T. Miyahara*  
KSF, INC. APRIL 30, 2014  
LIC. EXP. DATE

STATE OF HAWAII  
DEPARTMENT OF TRANSPORTATION  
HIGHWAYS DIVISION


PLAN - STA. 14+00 TO 19+50

KAHULUI AIRPORT  
ACCESS ROAD, PHASE I  
Federal Aid Project No. NH-0380(10)  
Scale: As Shown Date: February 2013

SHEET No. S3.1 OF 24 SHEETS



FED. ROAD DIST. NO.	STATE	FED. AID PROJ. NO.	FISCAL YEAR	SHEET NO.	TOTAL SHEETS
HAWAII	HAW.	NH-0380(10)	2013	130	166

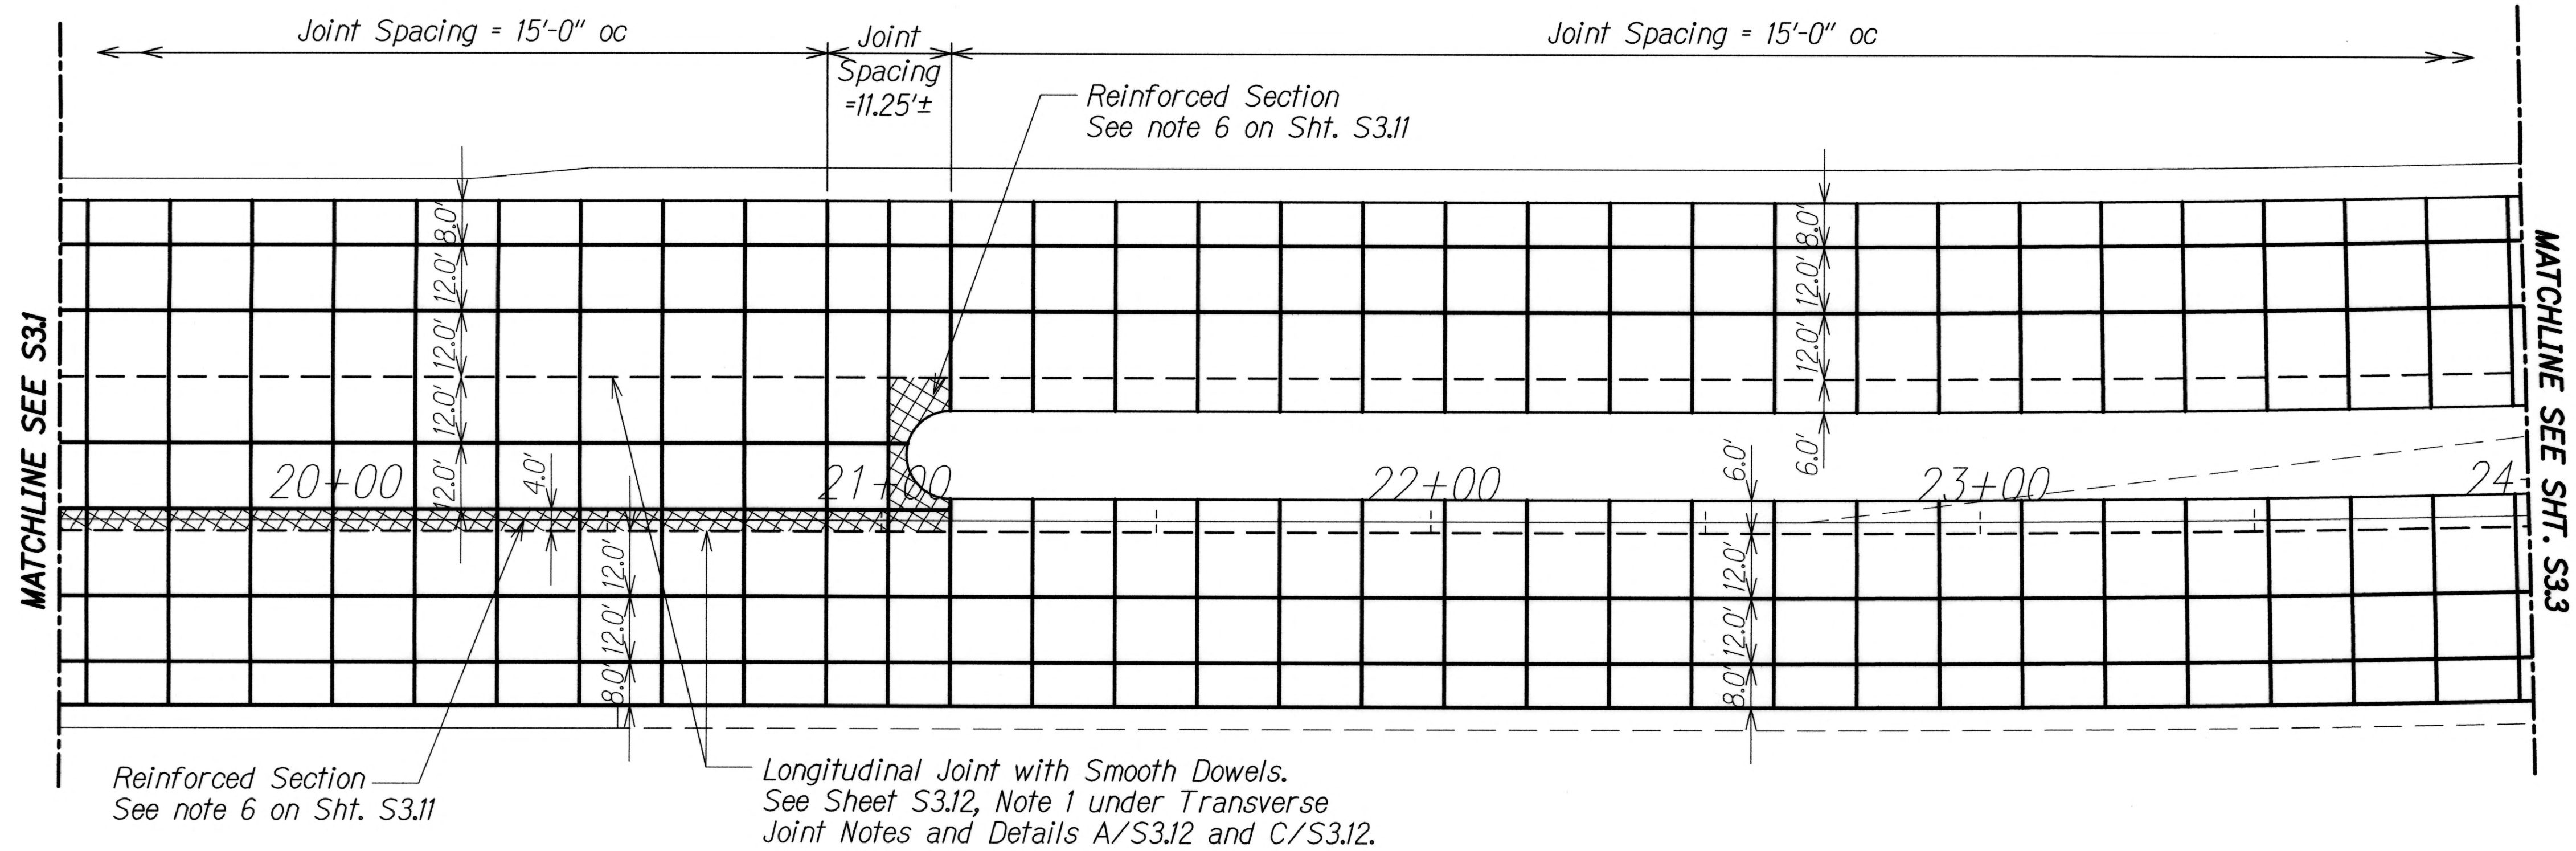

PLAN - STA. 19+50 TO 24+00
 

A  
 S32 | S33

 Scale: 1" = 20'-0"

ORIGINAL PLAN	SURVEY PLOTTED BY	DATE
NOTE BOOK	DRAWN BY	
No.	DESIGNED BY	
	CHECKED BY	

DRAWING NAME: Z:\00 ONGOING\11-006-KAAR-KAHULUI AIRPORT ACCESS RD-PH1 FA\CAD\02-22-13 BID\KAH-S301.DWG PLOT TIME: 02-22-13, 2:54 PM



THIS WORK WAS PREPARED BY ME  
OR UNDER MY SUPERVISION.

KSF, INC.

APRIL 30, 2014  
LIC. EXP. DATE

STATE OF HAWAII  
 DEPARTMENT OF TRANSPORTATION  
 HIGHWAYS DIVISION


**PLAN - STA. 19+50 TO 24+00**

KAHULUI AIRPORT  
 ACCESS ROAD, PHASE I  
 Federal Aid Project No. NH-0380(10)  
 Scale: As Shown      Date: February 2013

SHEET No. S32 OF 24 SHEETS



FED. ROAD DIST. NO.	STATE	FED. AID PROJ. NO.	FISCAL YEAR	SHEET NO.	TOTAL SHEETS
HAWAII	HAW.	NH-0380(10)	2013	131	166

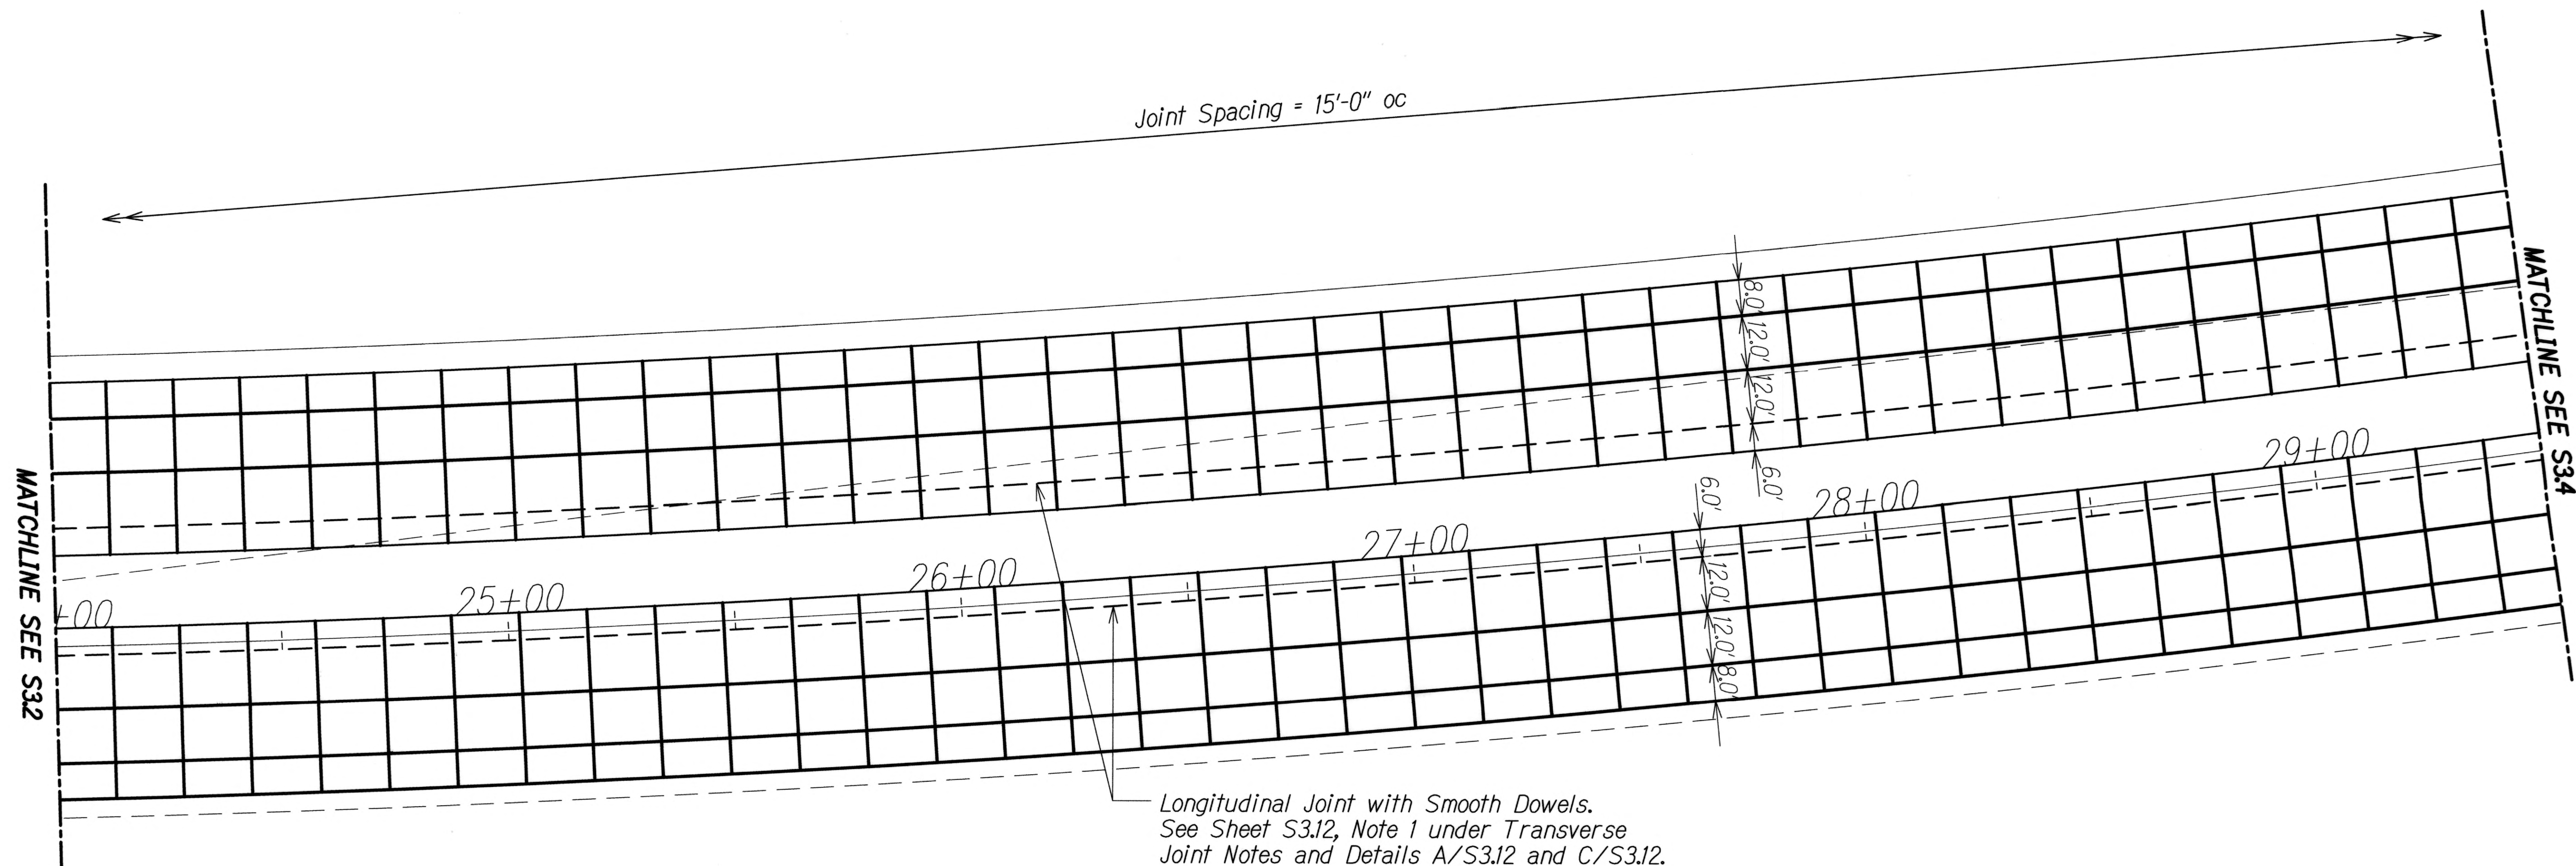

**PLAN - STA. 24+00 TO 29+50**  
Scale: 1" = 20'-0" A  
S3.3 | S3.3

DRAWING NAME: Z:\00 ONGOING\11-006-KAAR-KAHULUI AIRPORT ACCESS RD-PH1 FA\CAD\02-22-13 BID\KAH-S301.DWG PLOT TIME: 02-22-13, 2:54 PM

ORIGINAL PLAN	SURVEY PLOTTED BY	DATE
NOTE BOOK	DRAWN BY	
	DESIGNED BY	
	CHECKED BY	



THIS WORK WAS PREPARED BY ME  
OR UNDER MY SUPERVISION.  
*Calvin Miyahara*  
KSF, INC. APRIL 30, 2014  
LIC. EXP. DATE

STATE OF HAWAII  
DEPARTMENT OF TRANSPORTATION  
HIGHWAYS DIVISION


**PLAN - STA. 24+00 TO 29+50**

KAHULUI AIRPORT  
ACCESS ROAD, PHASE I  
Federal Aid Project No. NH-0380(10)  
Scale: As Shown Date: February 2013

SHEET No. S3.3 OF 24 SHEETS



FED. ROAD DIST. NO.	STATE	FED. AID PROJ. NO.	FISCAL YEAR	SHEET NO.	TOTAL SHEETS
HAWAII	HAW.	NH-0380(10)	2013	132	166

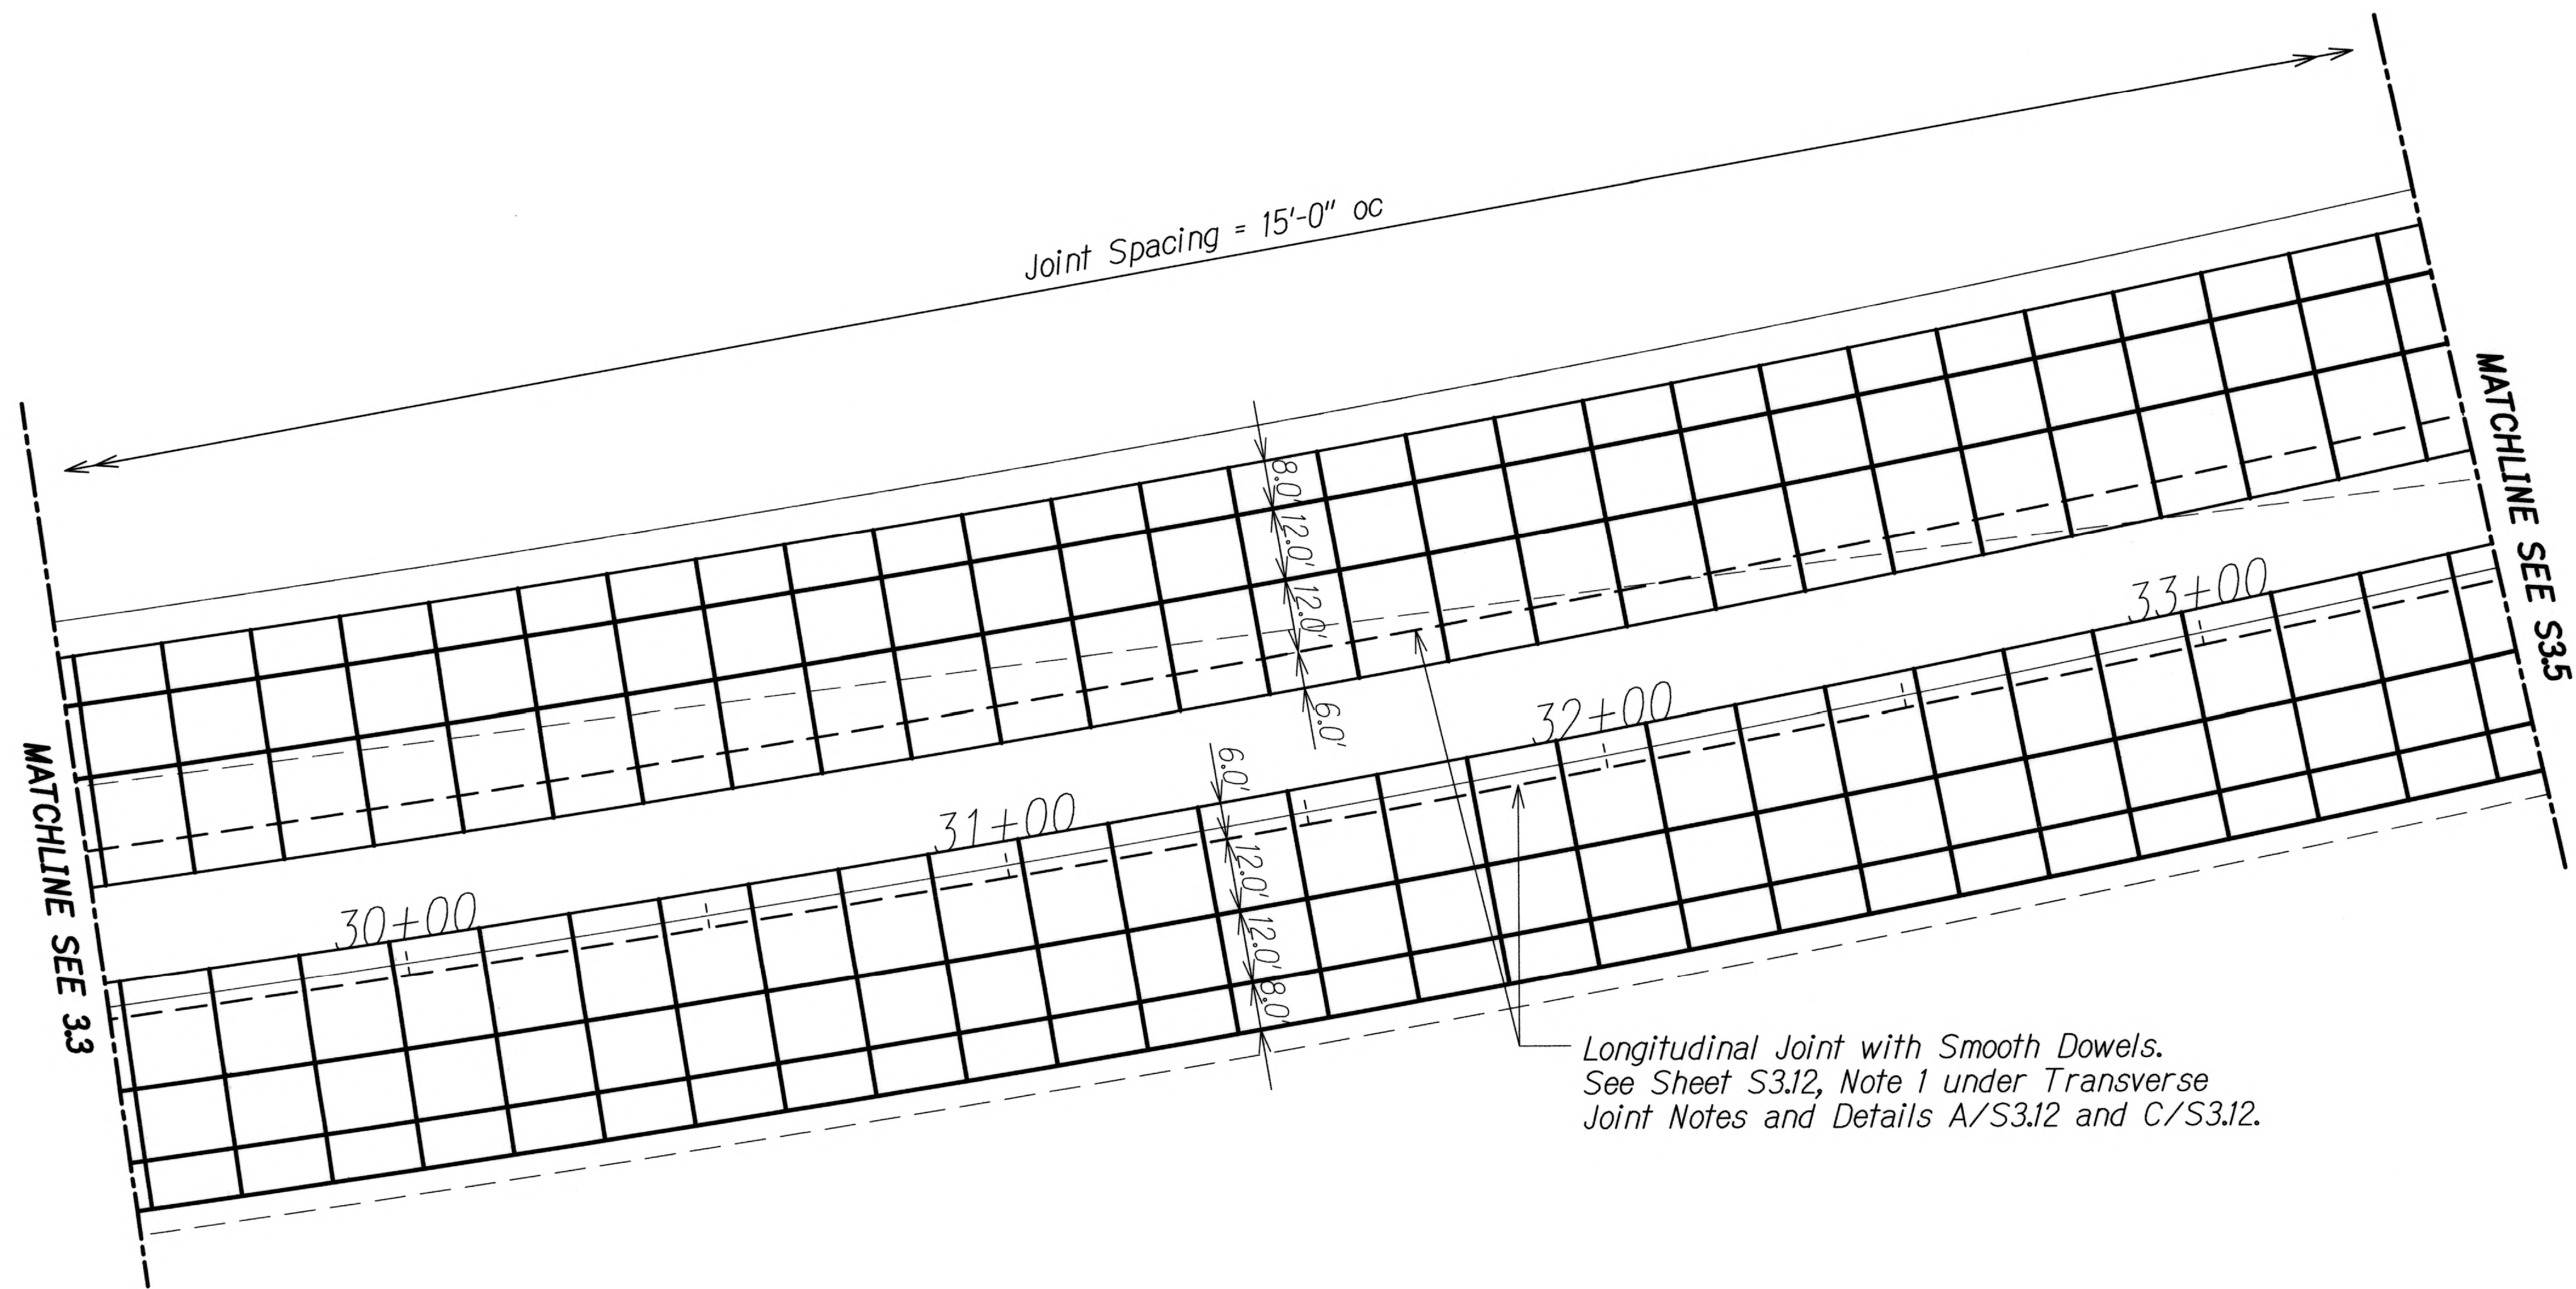

PLAN - STA. 29+50 TO 33+50 A  
S3.4 | S3.4  
 Scale: 1" = 20'-0"

ORIGINAL PLAN	SURVEY PLOTTED BY	DATE
NOTE BOOK	DRAWN BY	
No.	CHECKED BY	
	DESIGNED BY	
	QUANTITIES BY	

DRAWING NAME: Z:\00 ONGOING\11-006-KAAR-KAHULUI AIRPORT ACCESS RD-PHI FAX\CAD\02-22-13 BID\KAH-S301.DWG PLOT TIME: 02-22-13, 2:54 PM




THIS WORK WAS PREPARED BY ME  
OR UNDER MY SUPERVISION.

*Calvin Miyahara*  
KSF, INC. APRIL 30, 2014  
LIC. EXP. DATE

STATE OF HAWAII  
DEPARTMENT OF TRANSPORTATION  
HIGHWAYS DIVISION  
  
**PLAN - STA. 29+50 TO 33+50**  
  
**KAHULUI AIRPORT**  
**ACCESS ROAD, PHASE 1**  
**Federal Aid Project No. NH-0380(10)**  
Scale: As Shown Date: February 2013  
SHEET No. S3.4 OF 24 SHEETS



FED. ROAD DIST. NO.	STATE	FED. AID PROJ. NO.	FISCAL YEAR	SHEET NO.	TOTAL SHEETS
HAWAII	HAW.	NH-0380(10)	2013	133	166

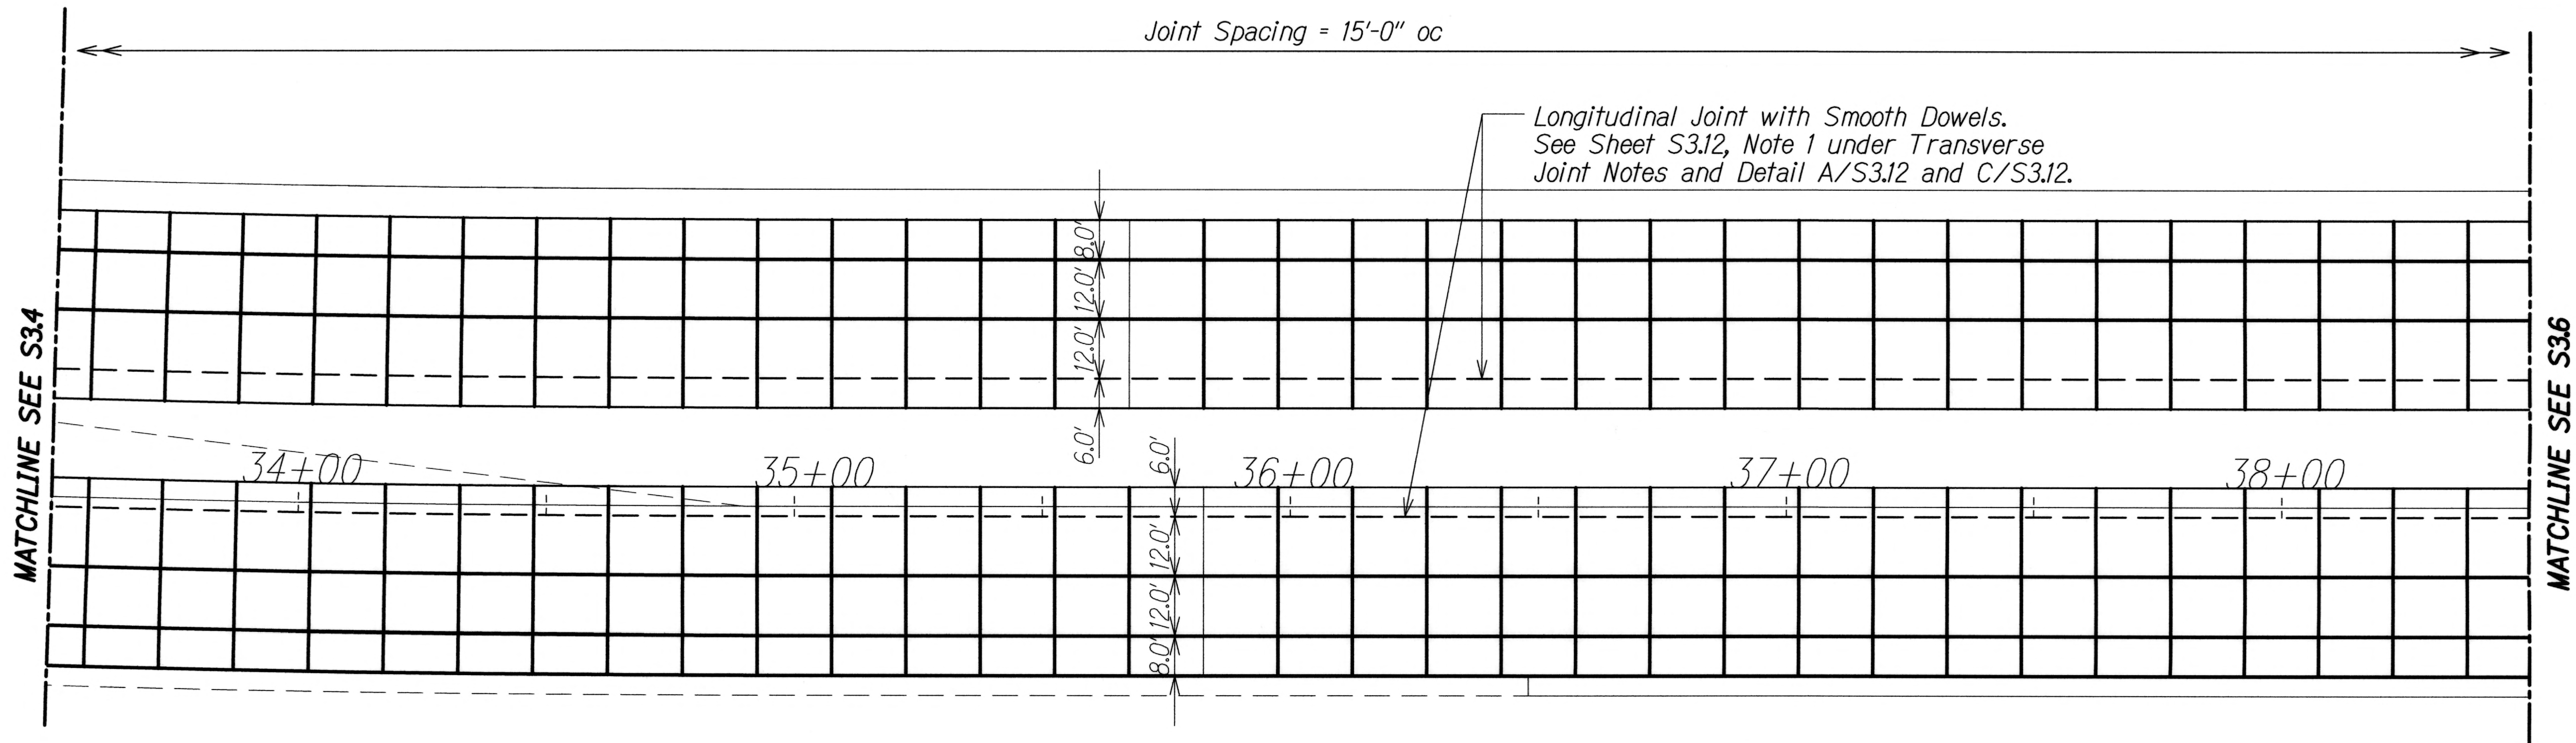

PLAN - STA. 33+50 TO 38+50 A  
Scale: 1" = 20'-0" S35 | S35

DRAWING NAME: Z:\00 ONGOING\11-006-KAAR-KAHULUI AIRPORT ACCESS RD-PHI FA\CAD\02-22-13 BID\KAH-S301.DWG PLOT TIME: 02-22-13, 2:54 PM

ORIGINAL PLAN	SURVEY PLOTTED BY	DATE
NOTE BOOK	DRAWN BY	" "
No.	DESIGNED BY	" "
	CHECKED BY	" "



THIS WORK WAS PREPARED BY ME  
OR UNDER MY SUPERVISION.  
*Calvin T. Miyahara*  
KSF, INC. APRIL 30, 2014  
LIC. EXP. DATE

STATE OF HAWAII  
DEPARTMENT OF TRANSPORTATION  
HIGHWAYS DIVISION


PLAN - STA. 33+50 TO 38+50

KAHULUI AIRPORT  
ACCESS ROAD, PHASE I  
Federal Aid Project No. NH-0380(10)  
Scale: As Shown Date: February 2013

SHEET No. S35 OF 24 SHEETS



FED. ROAD DIST. NO.	STATE	FED. AID PROJ. NO.	FISCAL YEAR	SHEET NO.	TOTAL SHEETS
HAWAII	HAW.	NH-0380(10)	2013	134	166

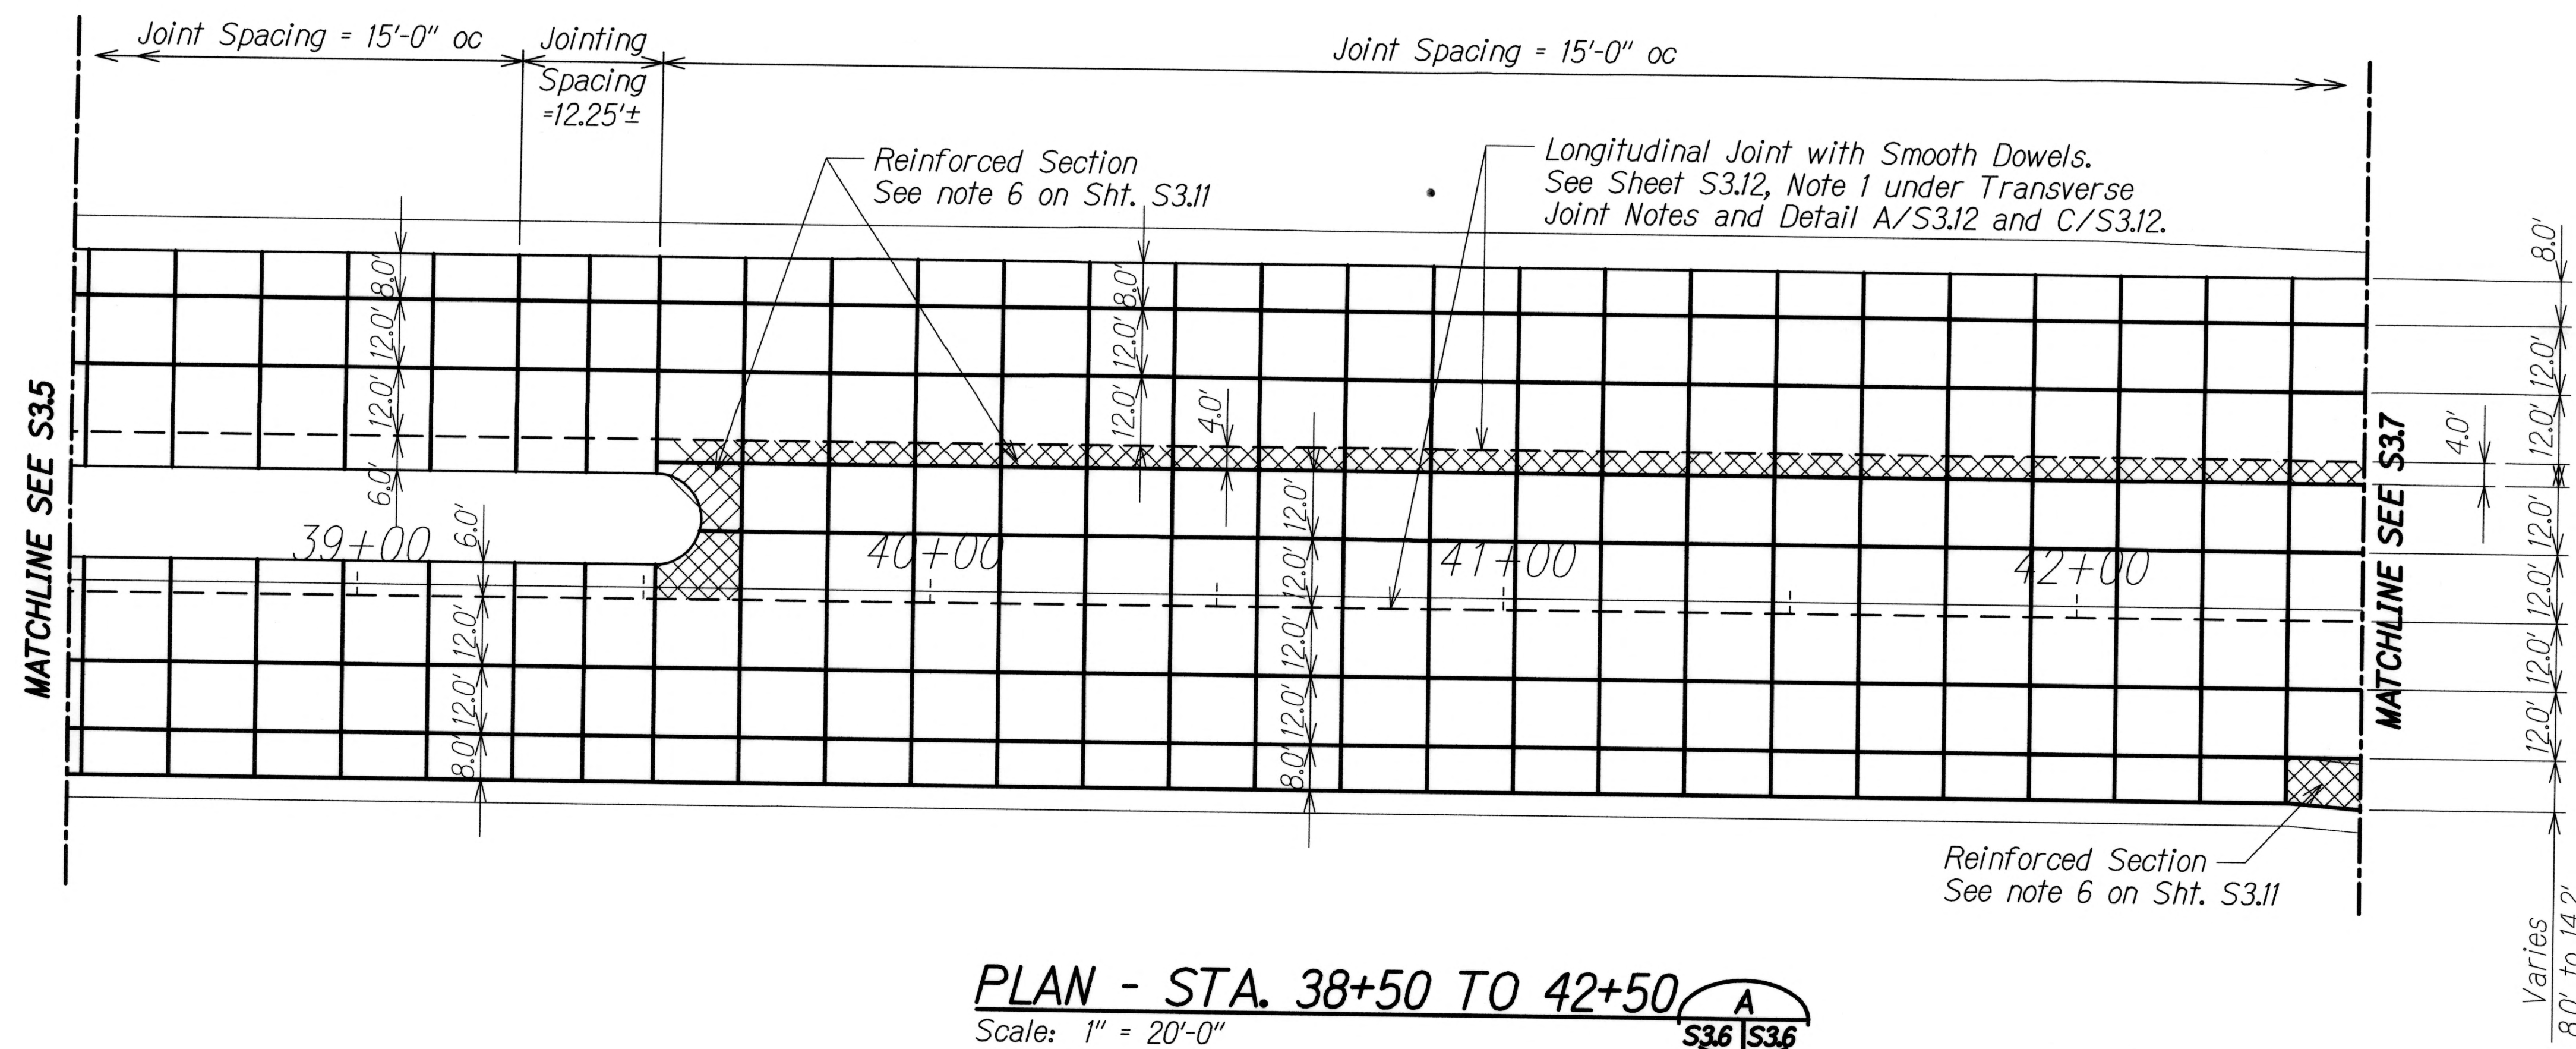

**PLAN - STA. 38+50 TO 42+50**  
 Scale: 1" = 20'-0"  
 A  
 S36 S36

ORIGINAL PLAN	SURVEY PLOTTED BY	DATE
NOTE BOOK	DRAWN BY	" "
No.	DESIGNED BY	" "
	CHECKED BY	" "

DRAWING NAME: Z:\00 ONGOING\11-006-KAAR-KAHULUI AIRPORT ACCESS RD-PH1 FAI\CAD\02-22-13 BID\KAH-S301.DWG PLOT TIME: 02-22-13, 2:54 PM




THIS WORK WAS PREPARED BY ME  
 OR UNDER MY SUPERVISION.  
*Calvin T. Miyahara*  
 KSF, INC. APRIL 30, 2014  
 LIC. EXP. DATE

STATE OF HAWAII  
 DEPARTMENT OF TRANSPORTATION  
 HIGHWAYS DIVISION  
**PLAN - STA. 38+50 TO 42+50**  
  
 KAHULUI AIRPORT  
 ACCESS ROAD, PHASE 1  
 Federal Aid Project No. NH-0380(10)  
 Scale: As Shown Date: February 2013  
 SHEET No. S36 OF 24 SHEETS



FED. ROAD DIST. NO.	STATE	FED. AID PROJ. NO.	FISCAL YEAR	SHEET NO.	TOTAL SHEETS
HAWAII	HAW.	NH-0380(10)	2013	135	166

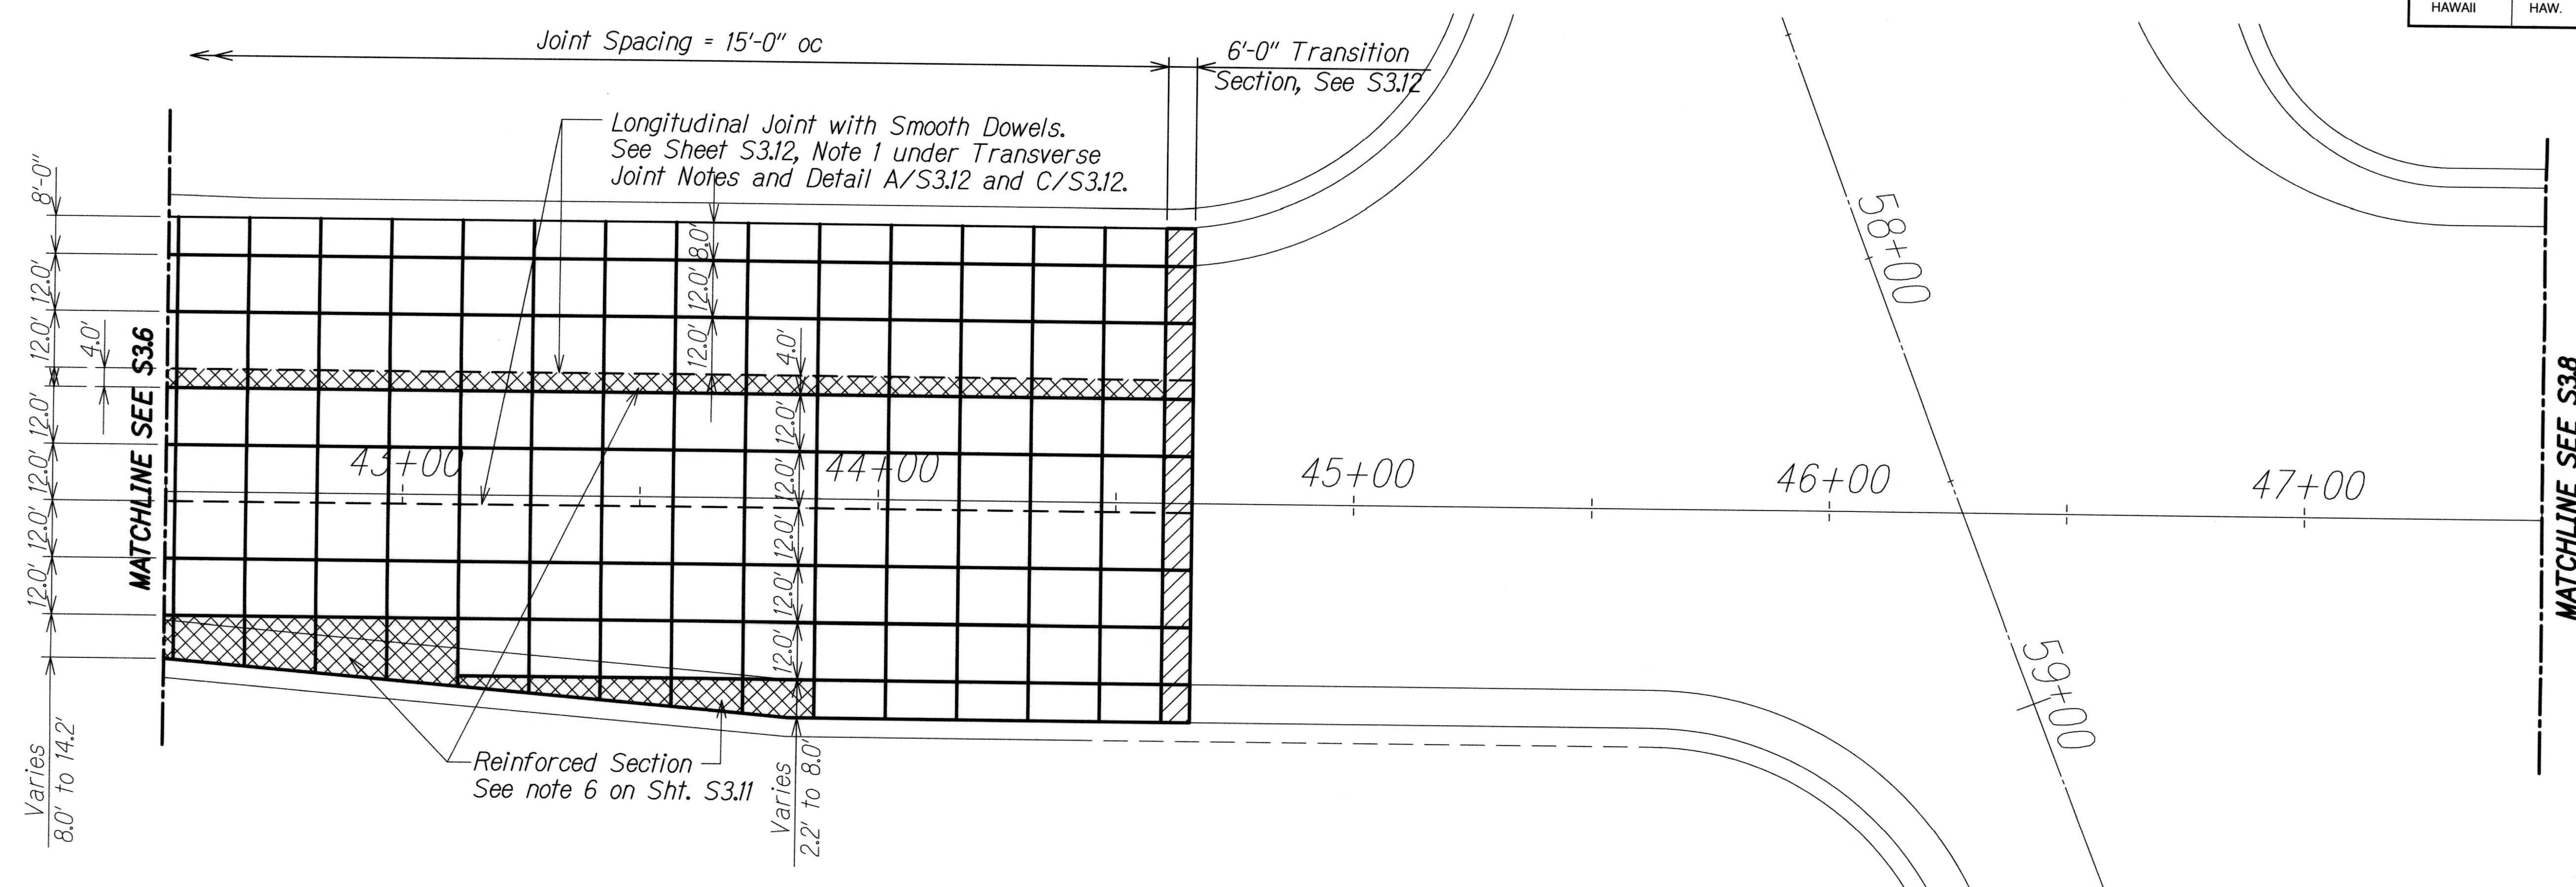

PLAN - STA. 42+50 TO 47+50 A  
Scale: 1" = 20'-0" S37 S37

ORIGINAL PLAN	SURVEY PLOTTED BY _____	DATE _____
NOTE BOOK	DRAWN BY _____	" _____
	TRACED BY _____	" _____
	DESIGNED BY _____	" _____
	QUANTITIES BY _____	" _____
No. _____	CHECKED BY _____	" _____

DRAWING NAME: Z:\00 ONGOING\1-006-KAAR-KAHULUI AIRPORT ACCESS RD-PHI FAL\CAD\02-22-13 BID\KAH-S001.DWG PLOT TIME: 02-22-13, 2:54 PM



THIS WORK WAS PREPARED BY ME  
OR UNDER MY SUPERVISION.

*Car Murr*

APRIL 30, 2006

KSF, INC. LIC. EXP. DA

STATE OF HAWAII  
DEPARTMENT OF TRANSPORTATION  
HIGHWAYS DIVISION

PLAN - STA. 42+50 TO 47+50


KAHULUI AIRPORT  
ACCESS ROAD, PHASE I  
Federal Aid Project No. NH-0380(10)

Scale: As Shown Date: February 2013


SHEET No. 53.7 OF 24 SHEETS



FED. ROAD DIST. NO.	STATE	FED. AID PROJ. NO.	FISCAL YEAR	SHEET NO.	TOTAL SHEETS
HAWAII	HAW.	NH-0380(10)	2013	136	166

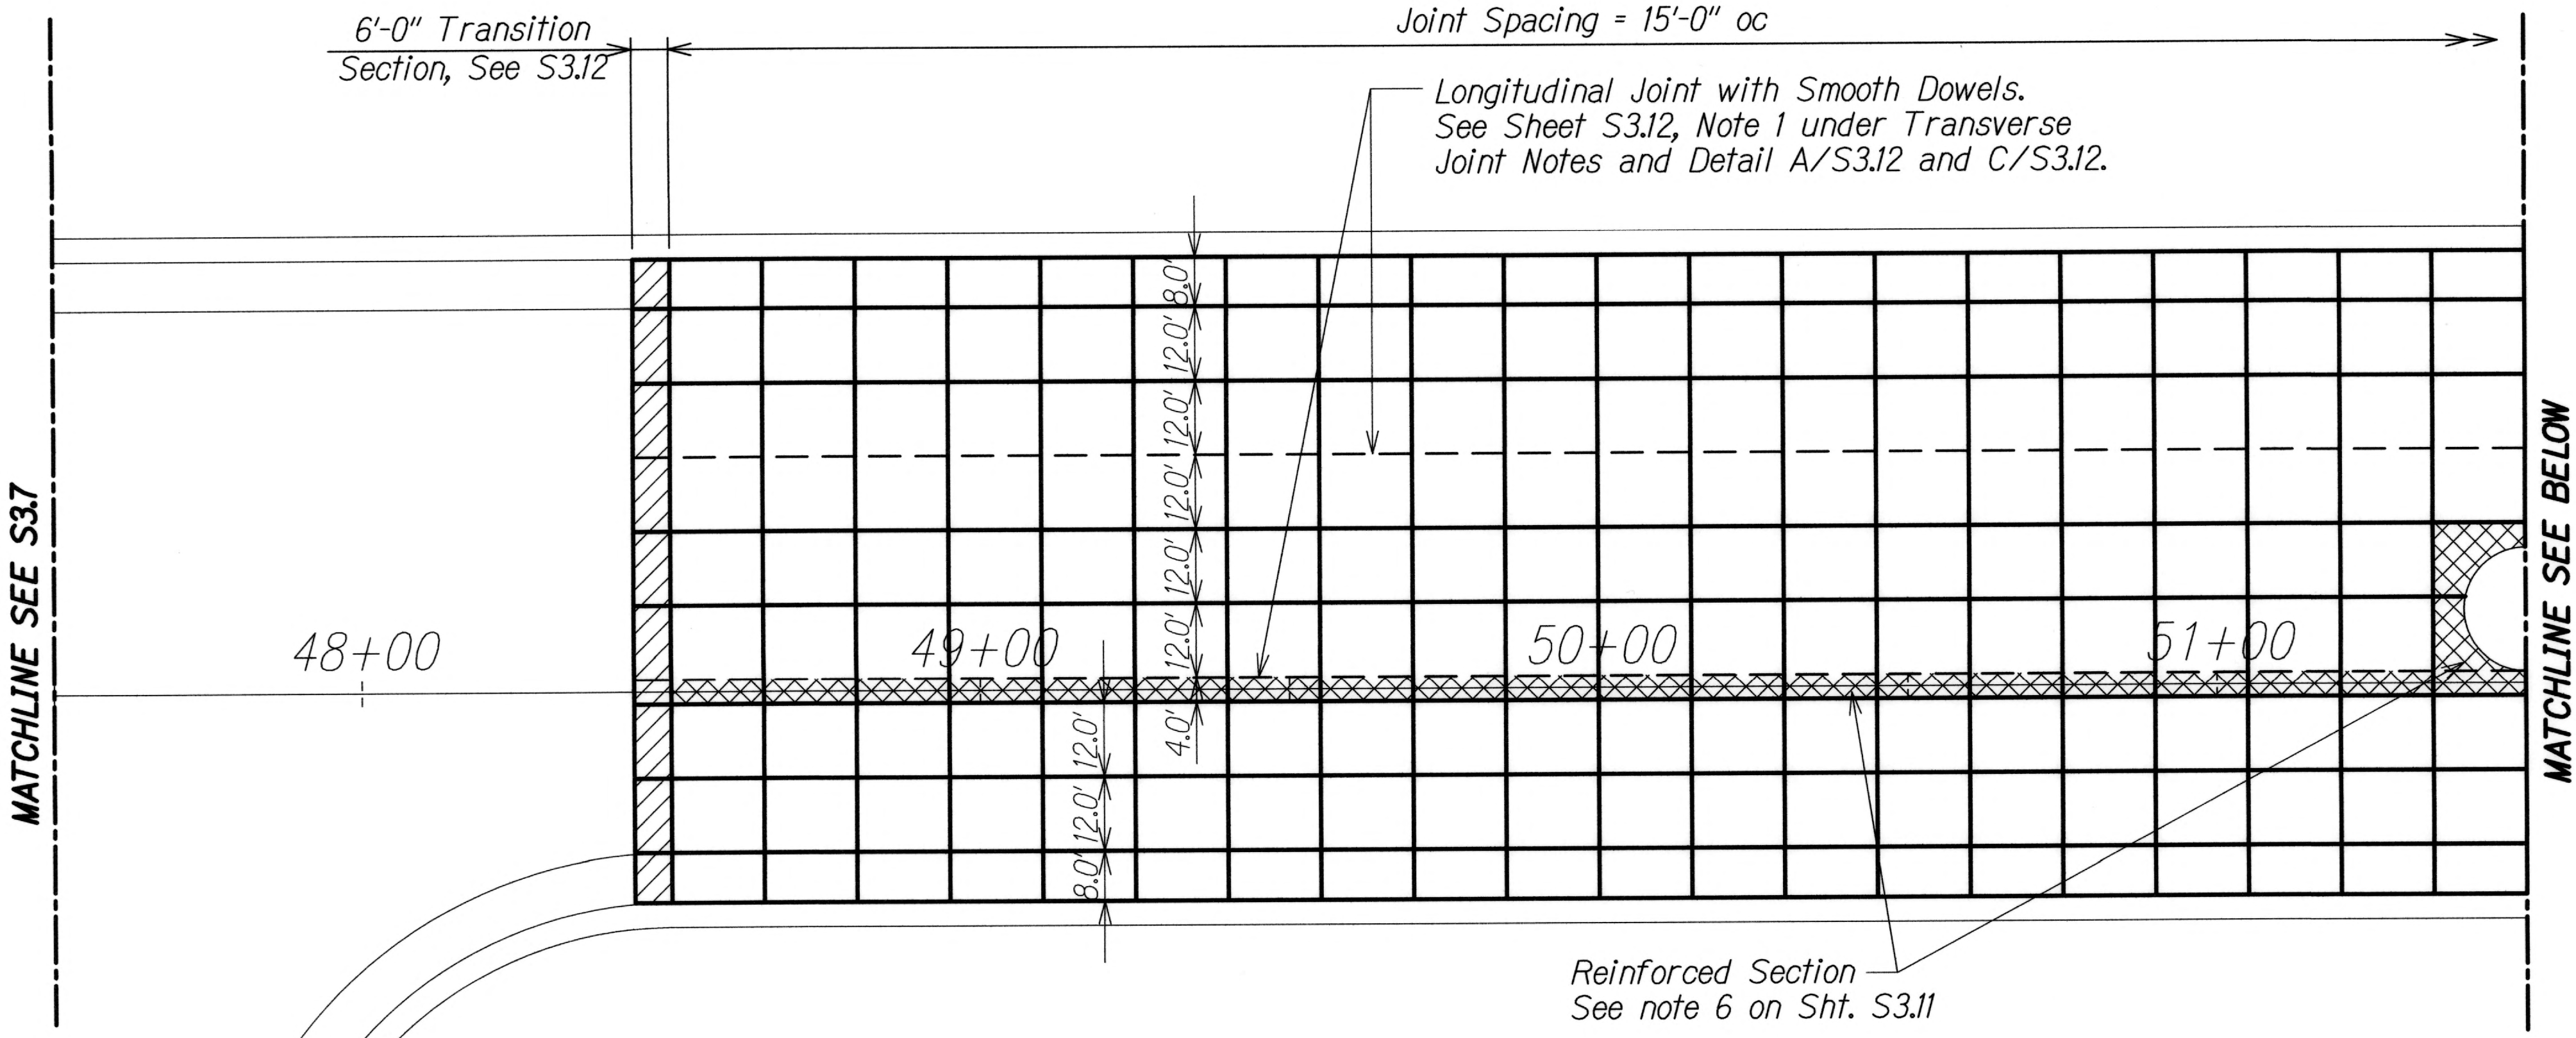

**PLAN - STA. 47+50 TO 51+50** A  
 Scale: 1" = 20'-0" S3.8 | S3.8

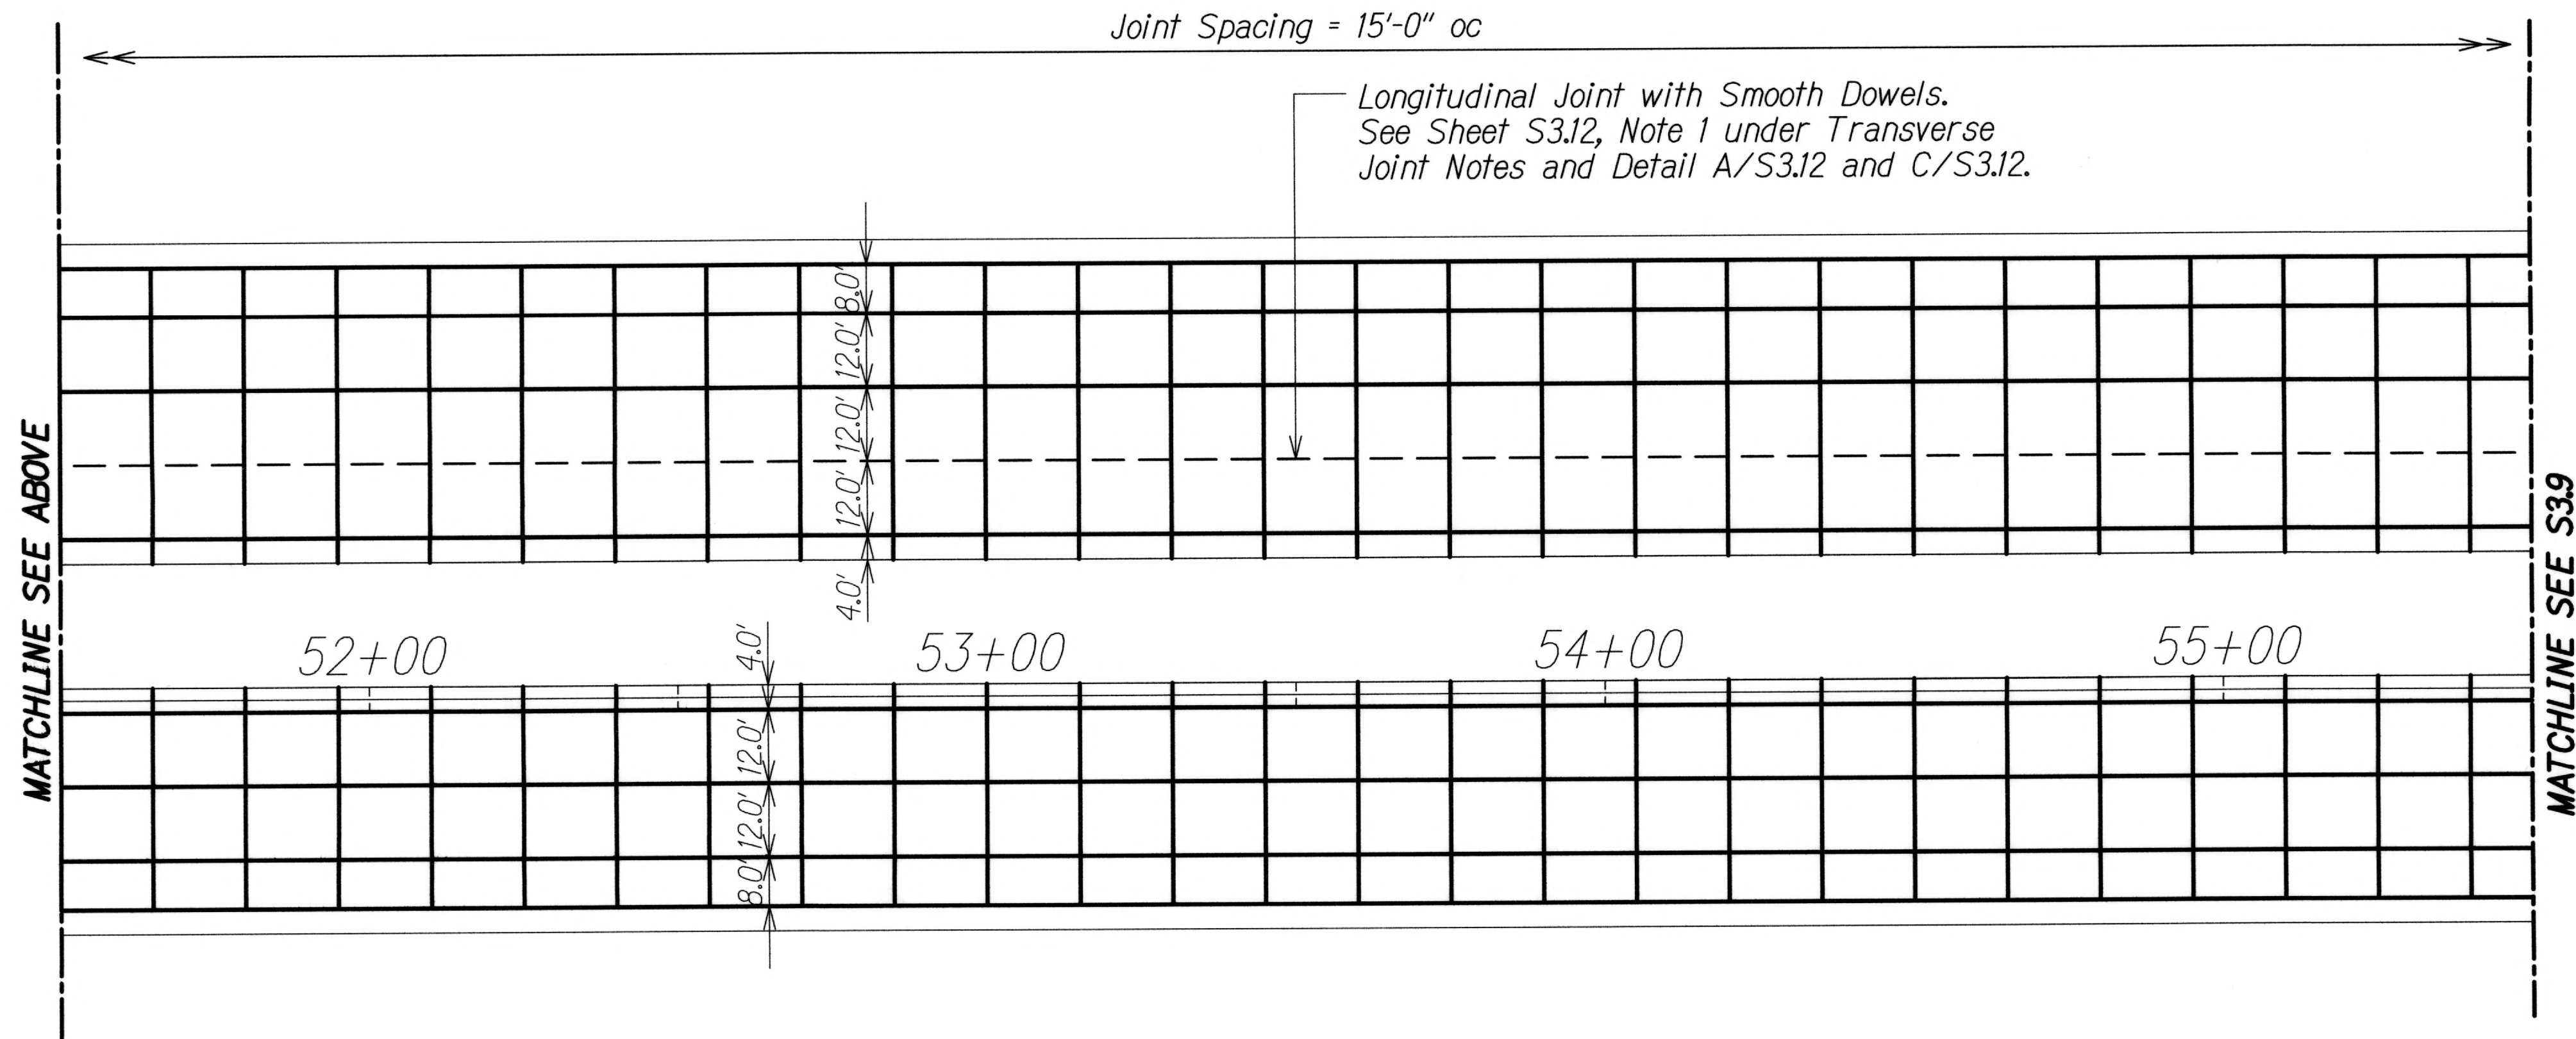

**PLAN - STA. 51+50 TO 55+50** B  
 Scale: 1" = 20'-0" S3.8 | S3.8

ORIGINAL PLAN	SURVEY PLOTTED BY	DATE
NOTE BOOK	DESIGNED BY	
No.	CHECKED BY	

DRAWING NAME: Z:\00 ONGOING\11-006-KAAR-KAHULUI AIRPORT ACCESS RD-PHI FAX CAD\02-22-13 BID\KAH-S301.DWG PLOT TIME: 02-22-13, 2:54 PM



THIS WORK WAS PREPARED BY ME  
 OR UNDER MY SUPERVISION.  
*Calvin T. Miyahara*  
 KSF, INC. APRIL 30, 2014  
 LIC. EXP. DATE


STATE OF HAWAII  
 DEPARTMENT OF TRANSPORTATION  
 HIGHWAYS DIVISION  
**PLAN - STA. 47+50 TO 55+50**  
  
 KAHULUI AIRPORT  
 ACCESS ROAD, PHASE I  
 Federal Aid Project No. NH-0380(10)  
 Scale: As Shown Date: February 2013  
 SHEET No. S3.8 OF 24 SHEETS







FED. ROAD DIST. NO.	STATE	FED. AID PROJ. NO.	FISCAL YEAR	SHEET NO.	TOTAL SHEETS
HAWAII	HAW.	NH-0380(10)	2013	138	166

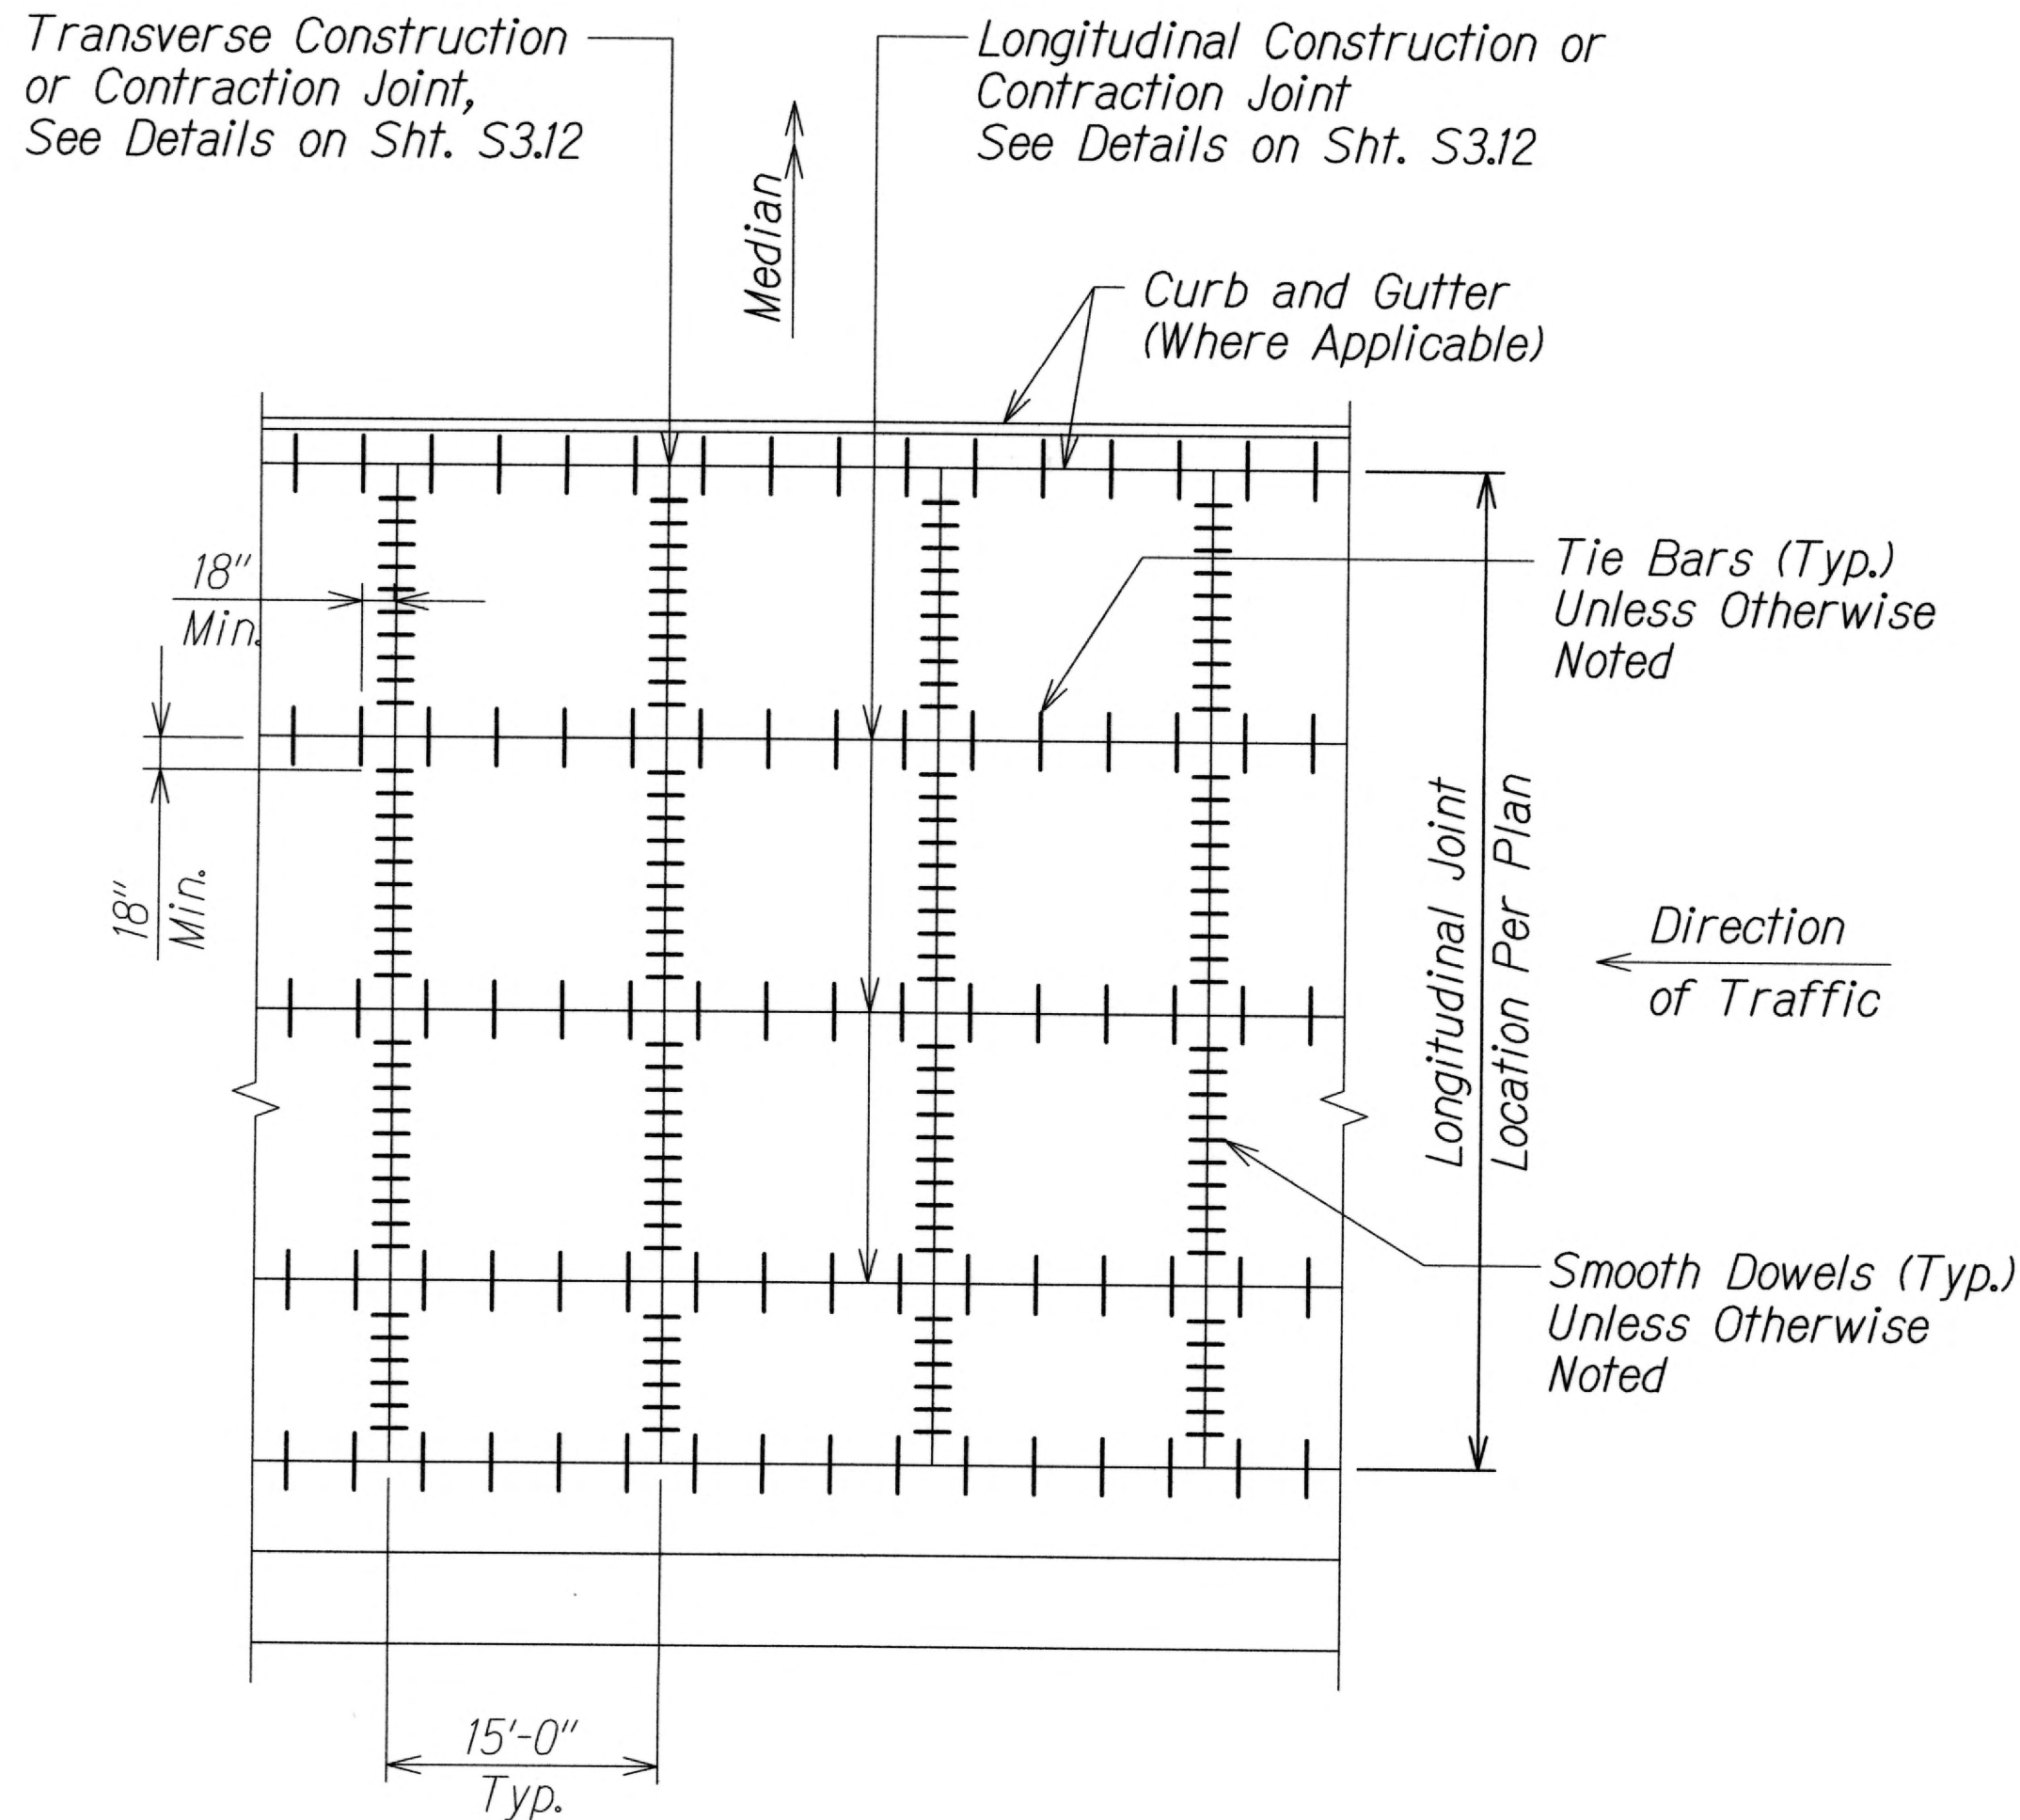

# **TYPICAL JOINT LOCATION AND LAYOUT PLAN FOR CONTANT PCC PAVEMENT**

Scale: 1/8" = 1'-0"



## **JOINTING NOTES:**

- All new PCC pavements shall be provided with permeable base course with longitudinal underdrains.
- Space transverse joint at successive intervals as shown on the plan.
- Locate transverse construction joints at the planned transverse contraction joint.
- Provide shop drawings for joint layout a minimum of 2-weeks prior to work where obstructions such as manholes are encountered, gore areas, termination of concrete with triangular or add-shaped slabs, and at intersections with other streets.
  - Longitudinal & transverse joints spacing shall have a ratio of no more than 1.25:1.
  - Reinforcement along longitudinal joints shall have be provided as shown in the details on sht S3.12 for longitudinal construction or longitudinal contraction joints and as specified in longitudinal joint notes on sheet S3.12.
  - Reinforcement along transverse joints shall be provided as shown in the details on sheet S3.12 for transverse construction or transverse contraction joints and as specified in transverse joint notes on sheet S3.12.
  - See sheet S3.11 for additional reinforcement details for odd-shaped PCC pours.
- For other joints requirements, See section 411 - Portland Cement Concrete Pavement.
- For locations of longitudinal joints, See Pavement Jointing Plans.

ORIGINAL PLAN	DATE
DESIGNED BY	
TRACED BY	
DESIGNED BY	
QUANTITIES BY	
CHECKED BY	
No.	

DRAWING NAME: Z:\00 ONCONG\11-006-KAAR-KAHULUI AIRPORT ACCESS RD-PHI FAI\CAD\02-22-13 BID\KAH-S310.DWG PLOT TIME: 02-22-13, 2:55 PM



THIS WORK WAS PREPARED BY ME  
OR UNDER MY SUPERVISION.  
*Calvin T. Miyahara*  
KSF, INC. APRIL 30, 2014  
LIC. EXP. DATE

STATE OF HAWAII  
DEPARTMENT OF TRANSPORTATION  
HIGHWAYS DIVISION

**PAVEMENT JOINTING DETAILS**

KAHULUI AIRPORT  
ACCESS ROAD, PHASE I  
Federal Aid Project No. NH-0380(10)  
Scale: As Shown Date: February 2013


SHEET No. S3.10 OF 24 SHEETS



FED. ROAD DIST. NO.	STATE	FED. AID PROJ. NO.	FISCAL YEAR	SHEET NO.	TOTAL SHEETS
HAWAII	HAW.	NH-0380(10)	2013	139	166

NOTES:


1. Install isolation joints to allow the slab to move independently of objects that will not move evenly with the slab.
2. Minimize the amount of openings within the slab to minimize the areas from which cracking occur. Listed below are considerations that can minimize cracking from openings in the slab.
  - a. Install reinforcing bars at the corners as shown below.
  - b. Use circular opening.
  - c. Install the openings along a joint.
3. Locate openings in the slab that require access in a manner that minimized the number of travelway lanes need to be shut down when accessing the openings.
4. Locate openings along joints and configured to minimized the amount of corners within the slab.
5. Avoid locating access openings along or near the longitudinal joints that separate two travelway lanes.
6. Concrete for odd-shapes PCC pours shall contain a minimum of 6 lbs./cy of synthetic structural fiber and 9 lbs/cy of 3mm length alkali-resistant glass fiber.
7. Top bar clear = 2"
8. Bottom of bar clear = 3"
9. Payment for reinforcement will be considered incidental to various contract items.

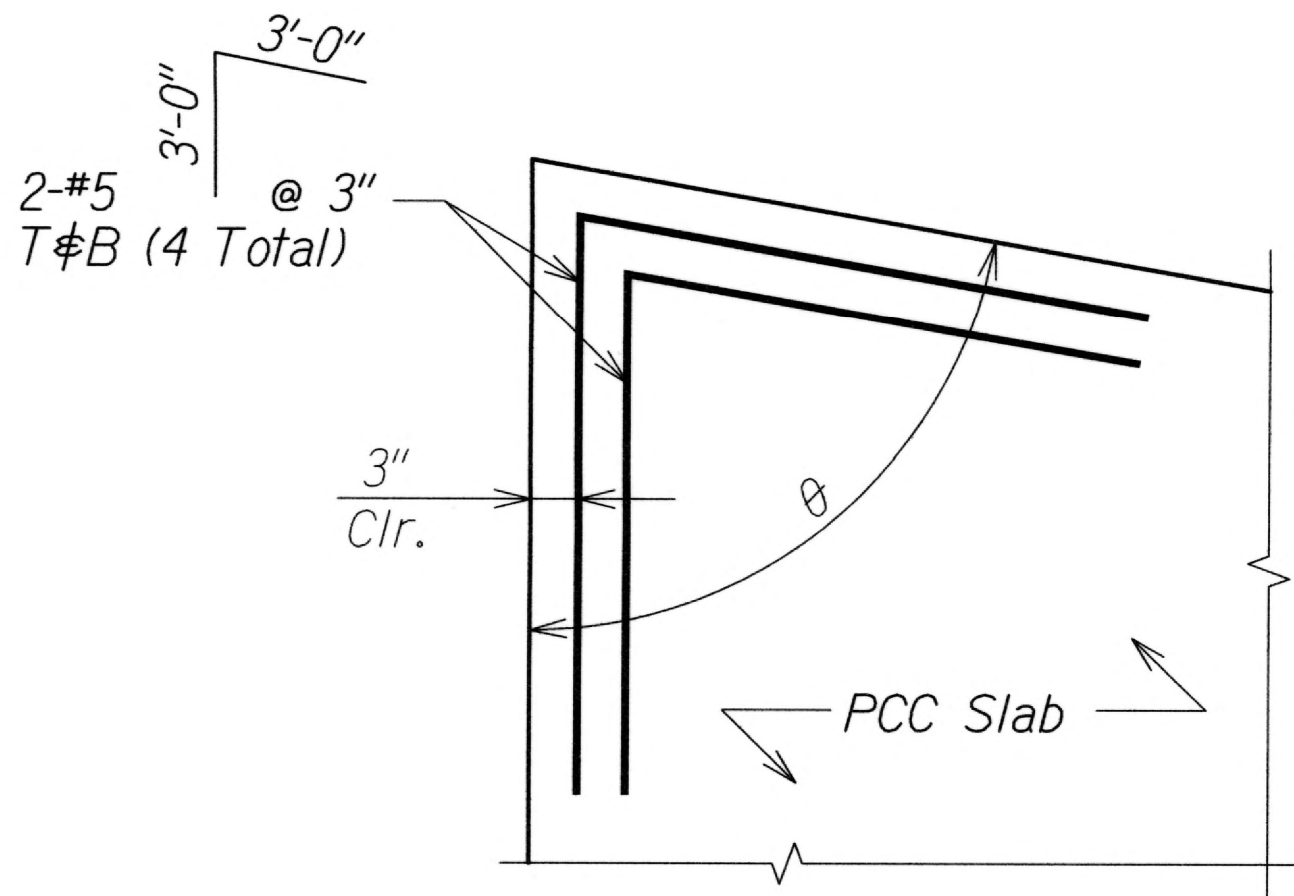

ADDED REINFORCEMENT AT ODD-SHAPED PCC POURS FOR 0° - 80° PCC EDGE

Not to Scale


A  
S3.11 S3.11

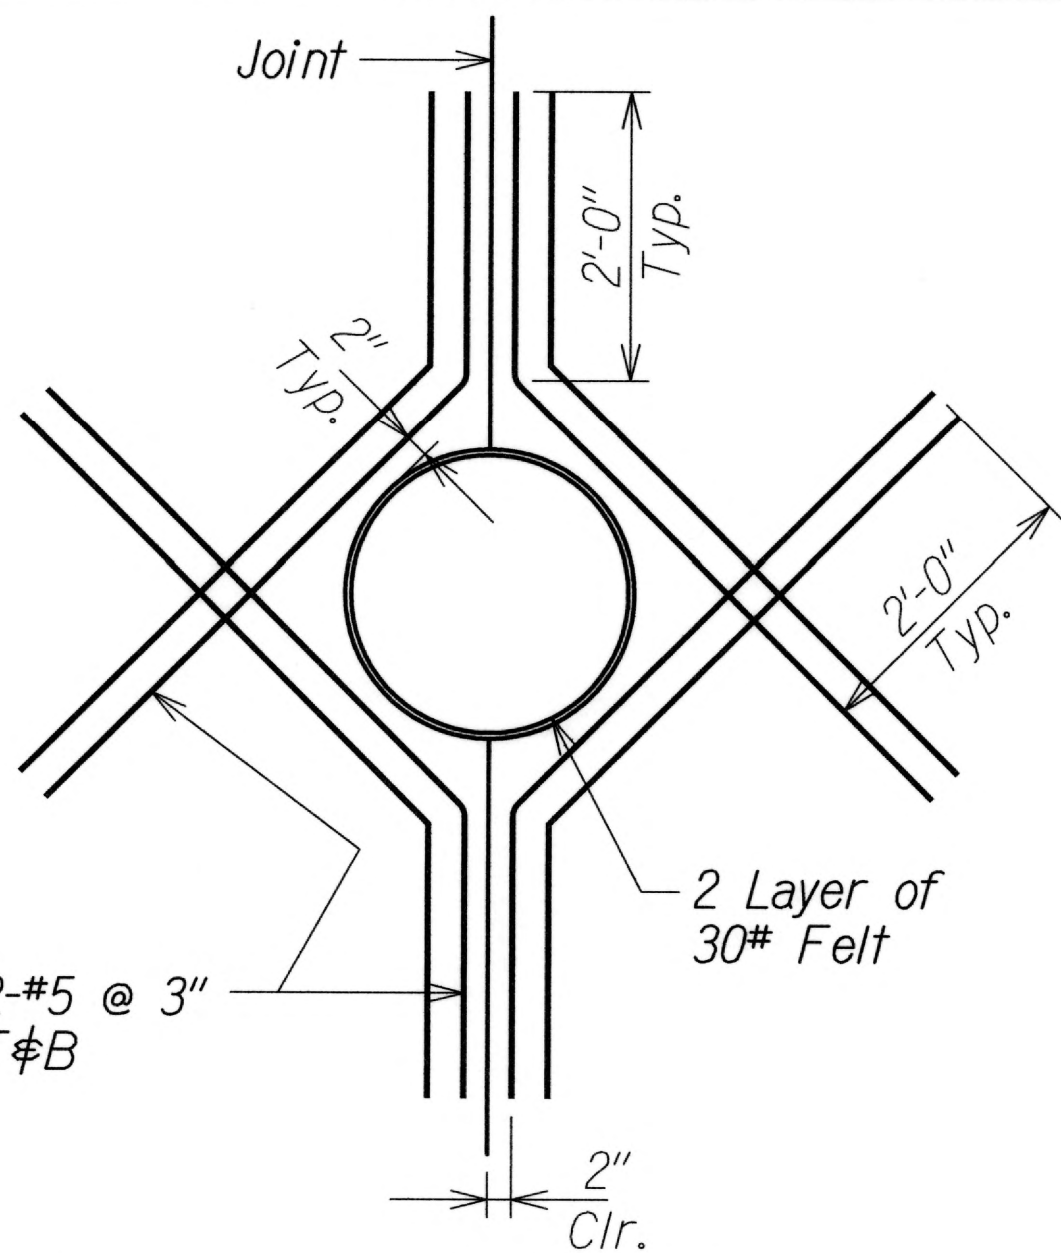

CIRCULAR OPENING DETAIL

Not to Scale


B  
S3.11 S3.11

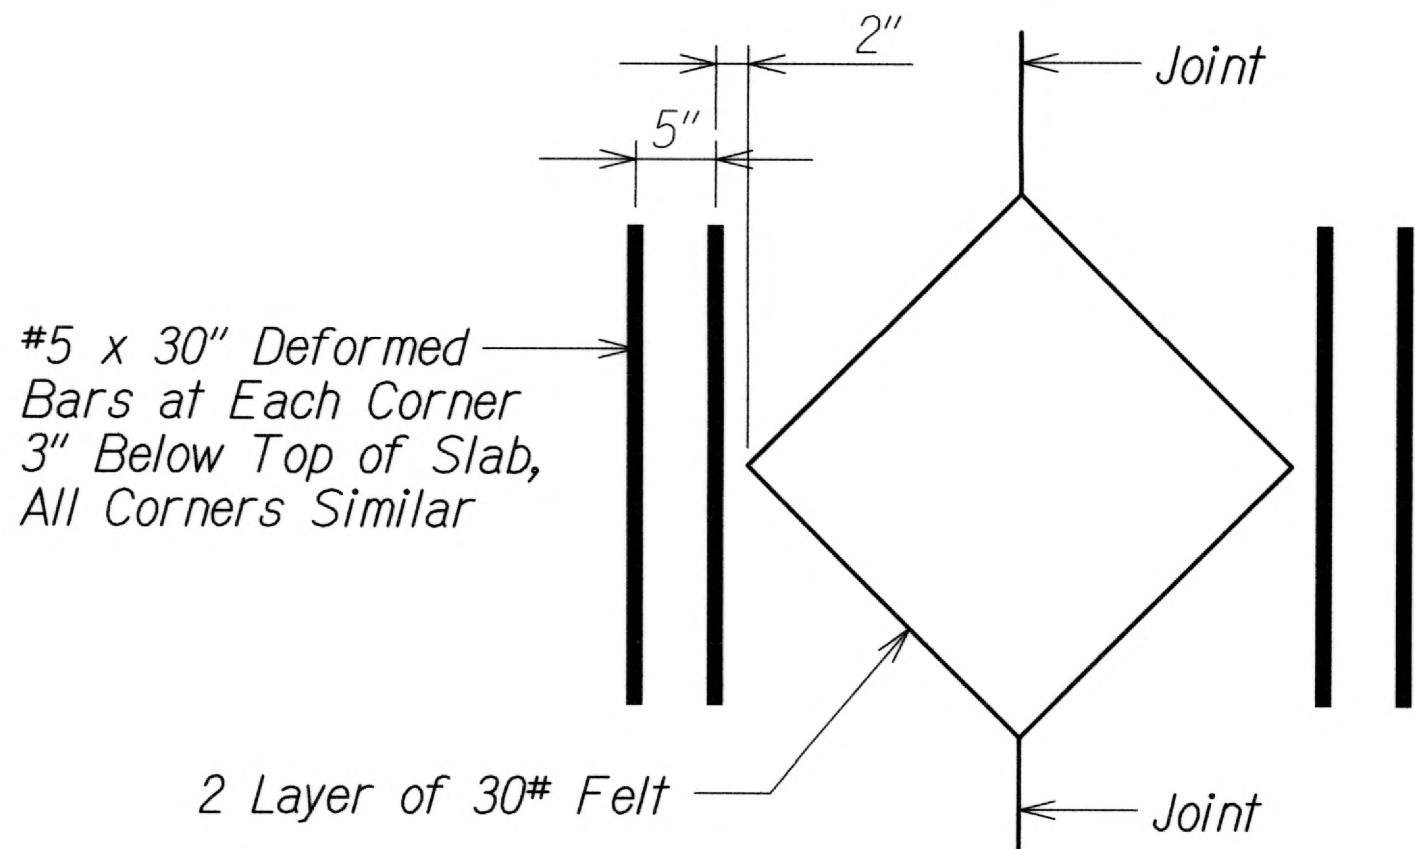

OPENING W/ CORNERS-CORNERS AT A JOINT DETAIL

Not to Scale


C  
S3.11 S3.11

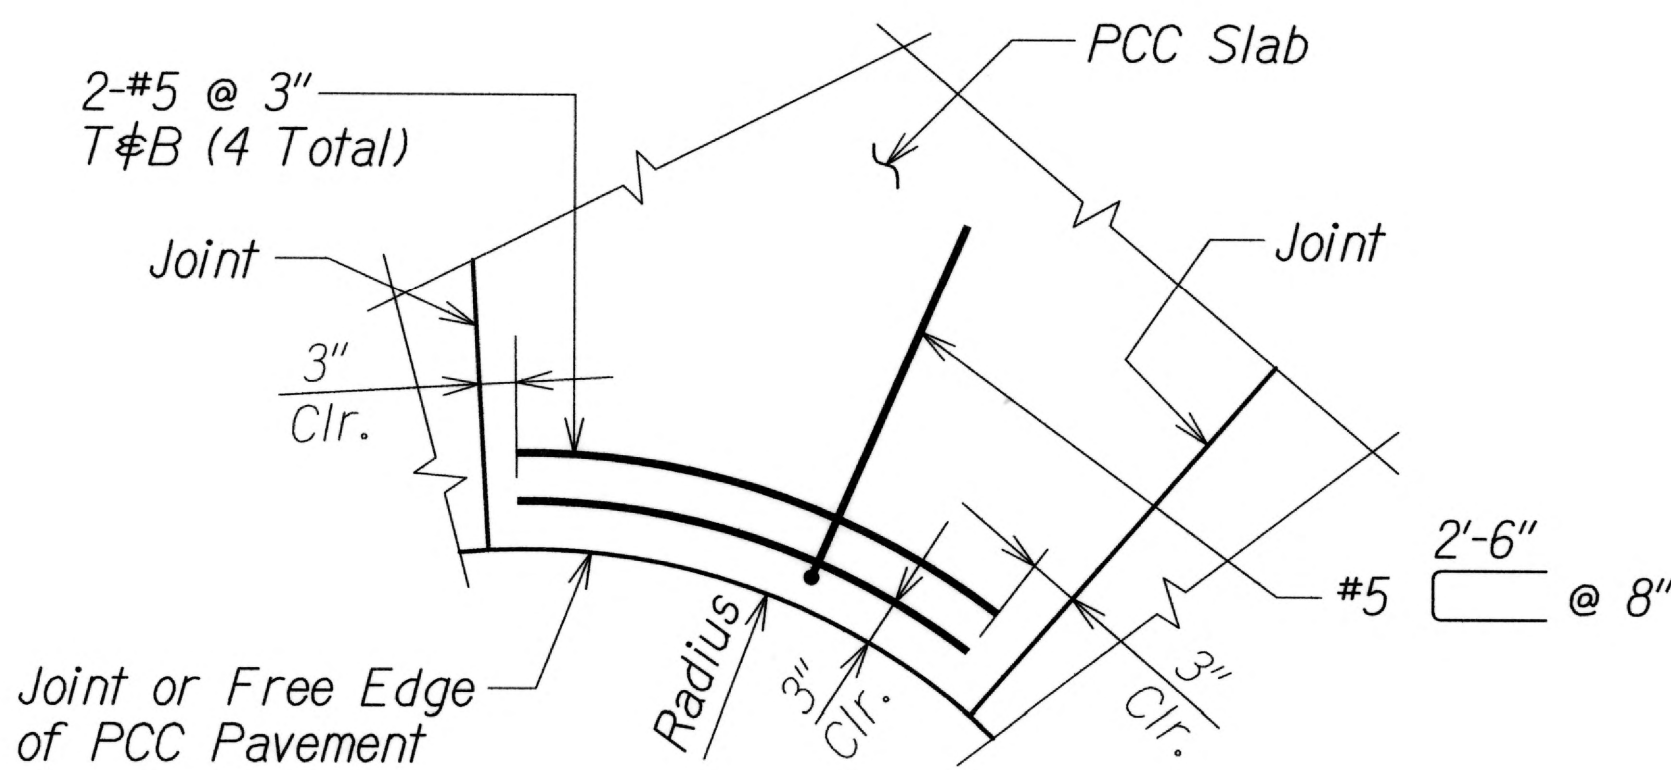

ADDED REINFORCEMENT AT ODD-SHAPED PCC POURS FOR CURVED PCC EDGE

Not to Scale


D  
S3.11 S3.11

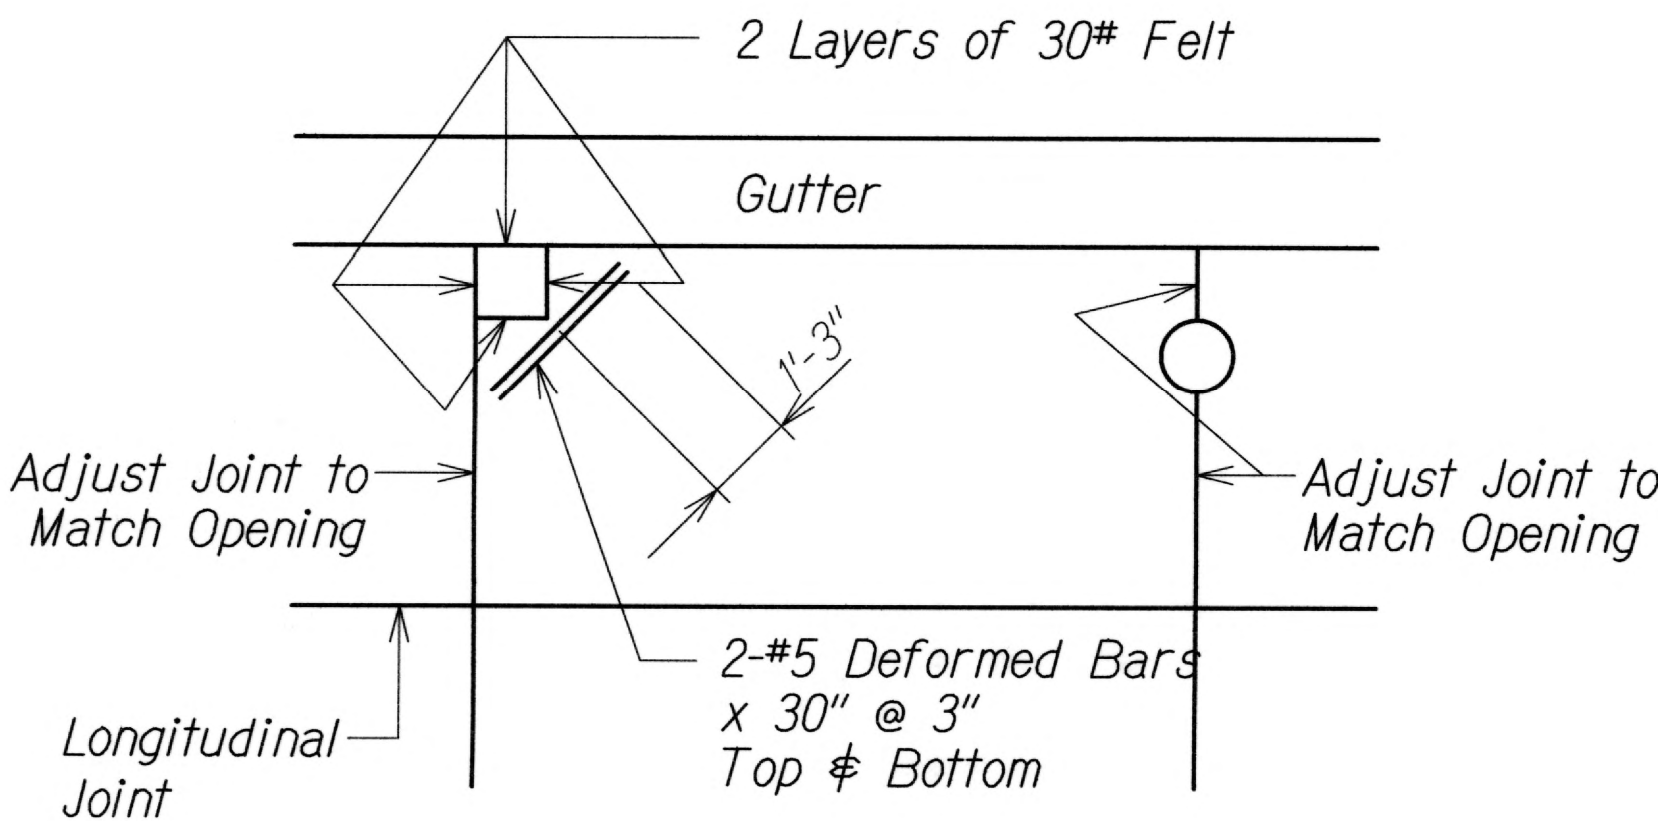

OPENING NEAR JOINTS DETAIL

Not to Scale


E  
S3.11 S3.11

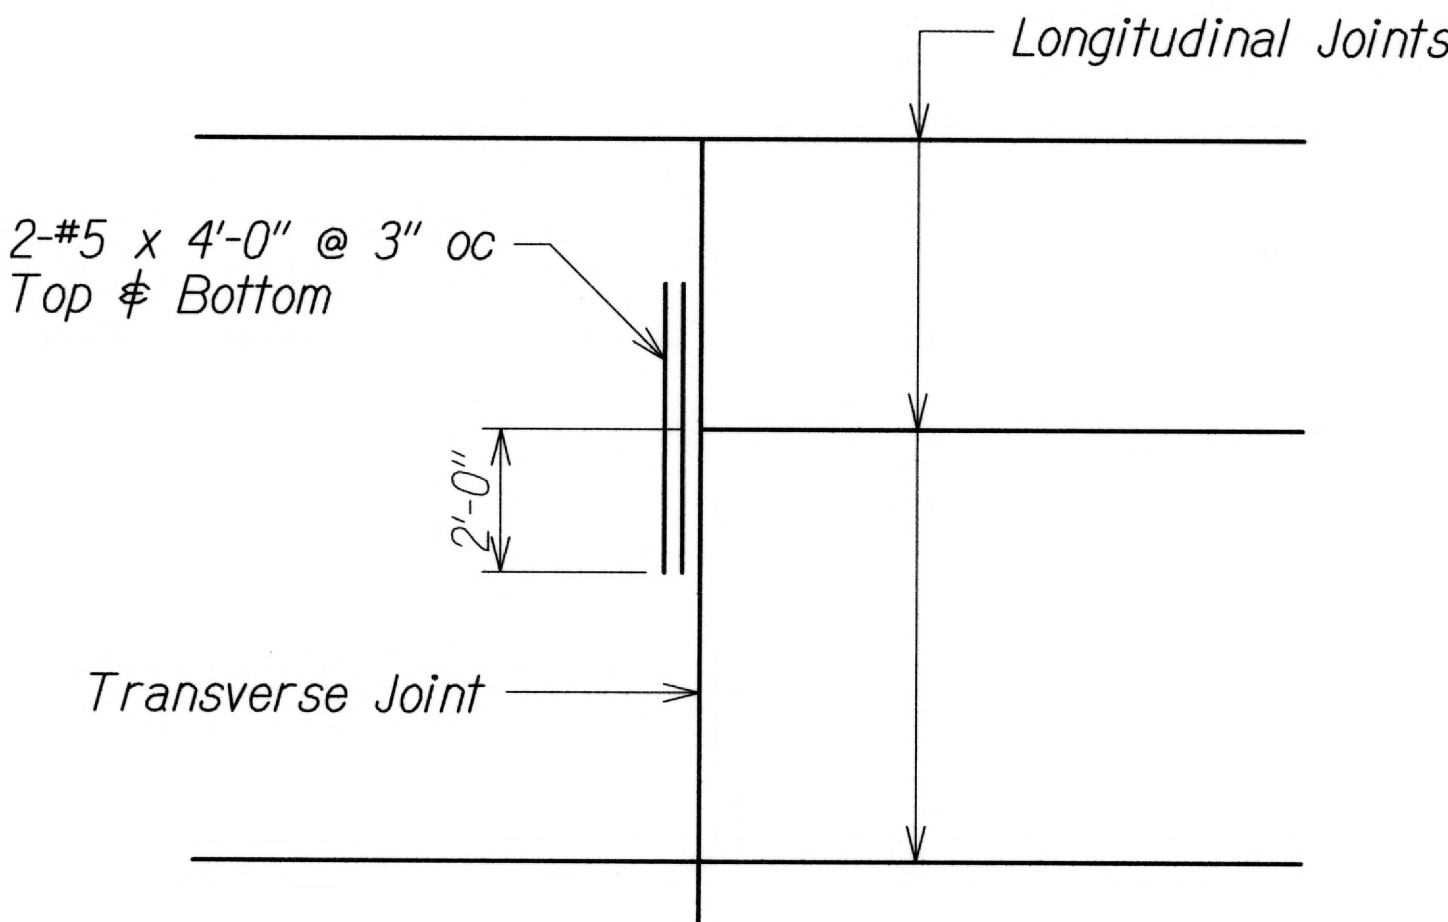

ADDED REINFORCEMENT AT MISMATCHED JOINT DETAIL

Not to Scale

F  
S3.11 S3.11

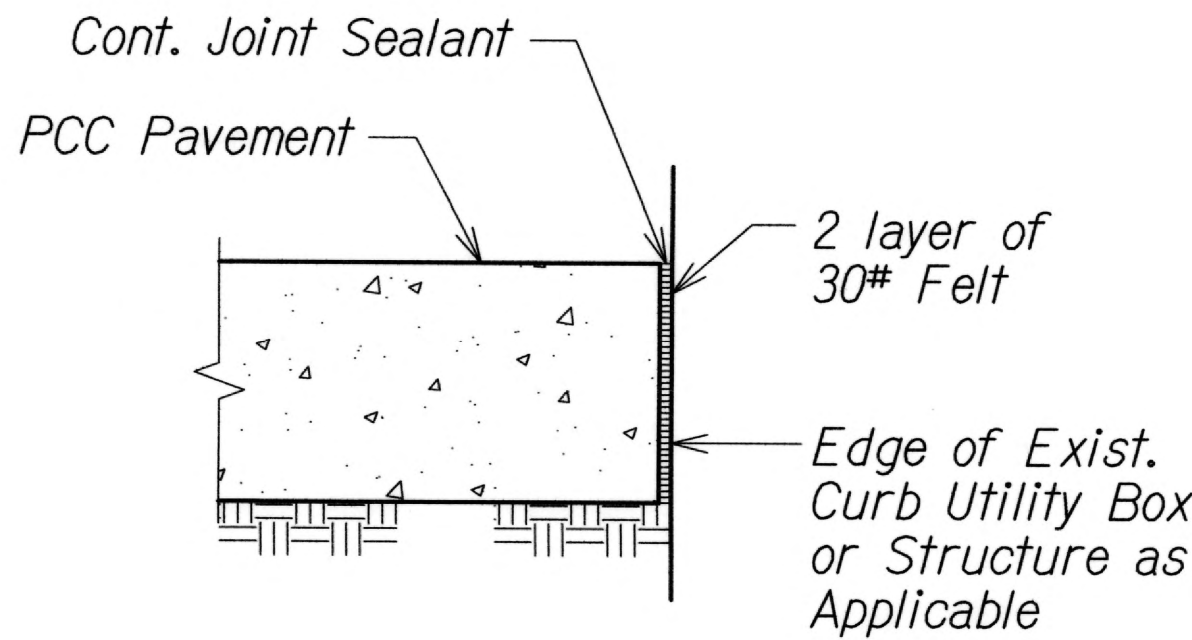

EXPANSION JOINT DETAIL

Not to Scale

G  
S3.11 S3.11



THIS WORK WAS PREPARED BY ME  
OR UNDER MY SUPERVISION.  
*Calvin T. Miyahara*  
KSF, INC. APRIL 30, 2014  
LIC. EXP. DATE


STATE OF HAWAII  
DEPARTMENT OF TRANSPORTATION  
HIGHWAYS DIVISION  
**PAVEMENT JOINTING DETAILS**

KAHULUI AIRPORT  
ACCESS ROAD, PHASE I  
Federal Aid Project No. NH-0380(10)  
Scale: As Shown Date: February 2013


SHEET No. S3.11 OF 24 SHEETS




FED. ROAD DIST. NO.	STATE	FED. AID PROJ. NO.	FISCAL YEAR	SHEET NO.	TOTAL SHEETS
HAWAII	HAW.	NH-0380(10)	2013	140	166

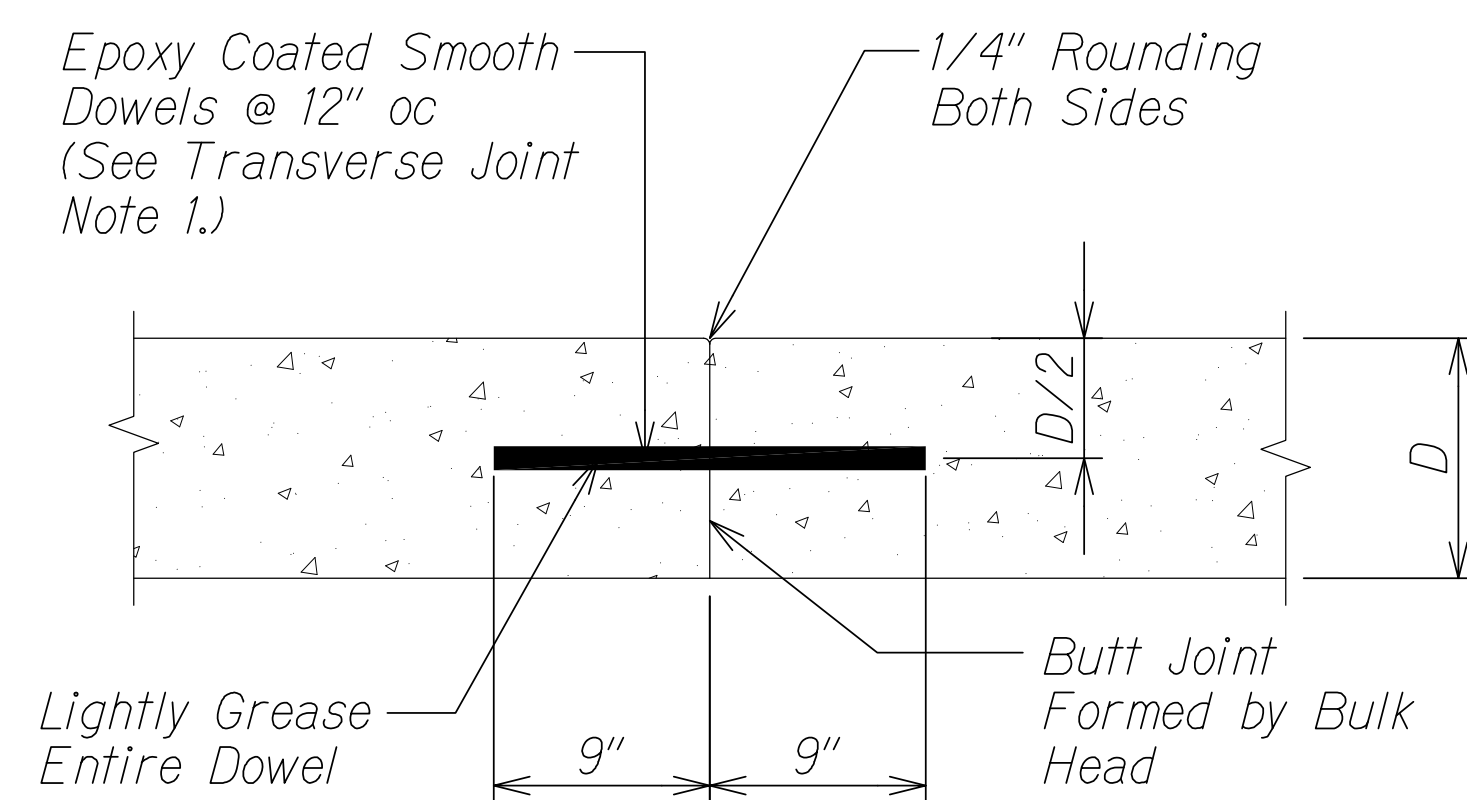


TRANSVERSE  
CONSTRUCTION JOINT **A**  
Not to Scale S3.12 S3.12

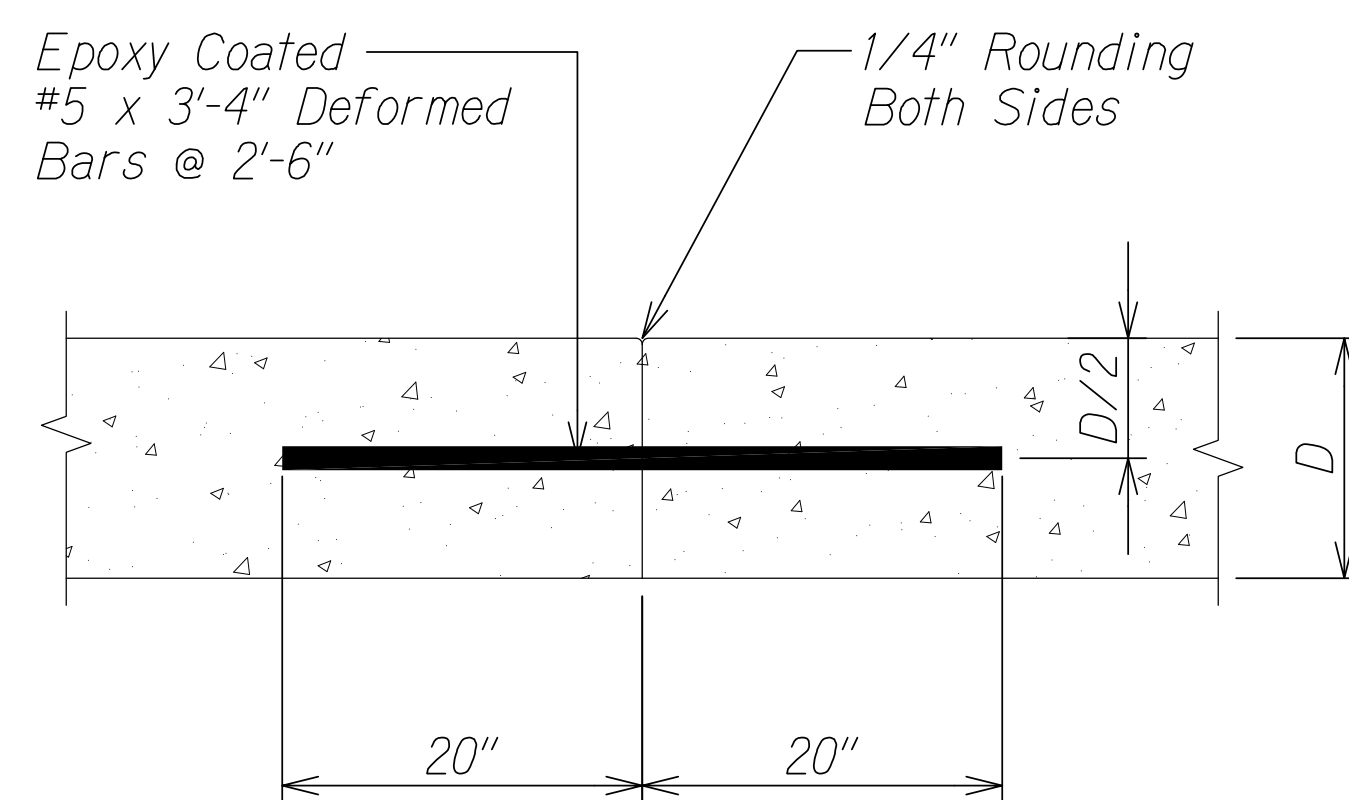


LONGITUDINAL  
CONSTRUCTION JOINT **B**  
Not to Scale S3.12 S3.12

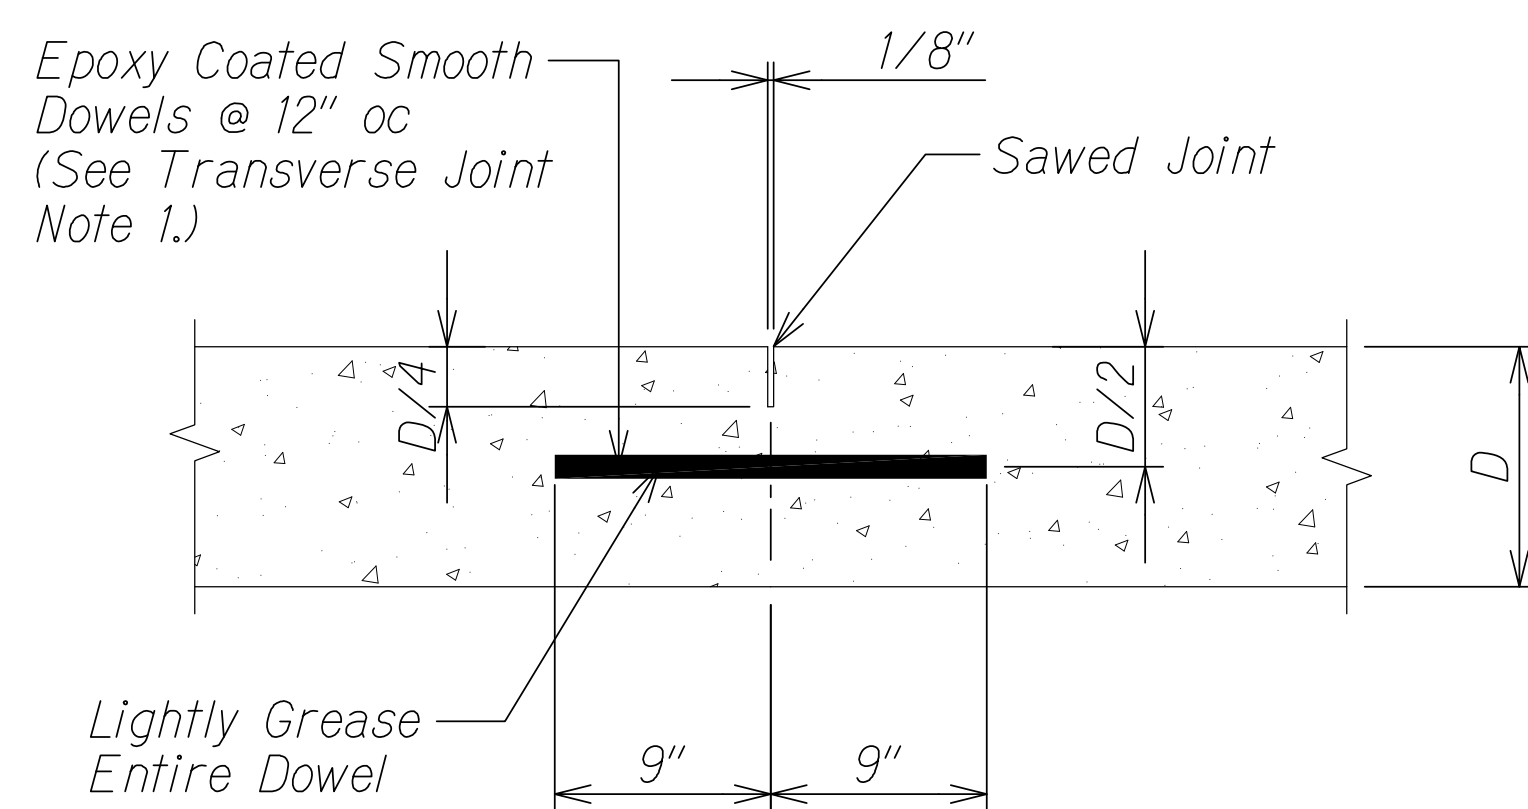


TRANSVERSE  
CONTRACTION JOINT **C**  
Not to Scale S3.12 S3.12

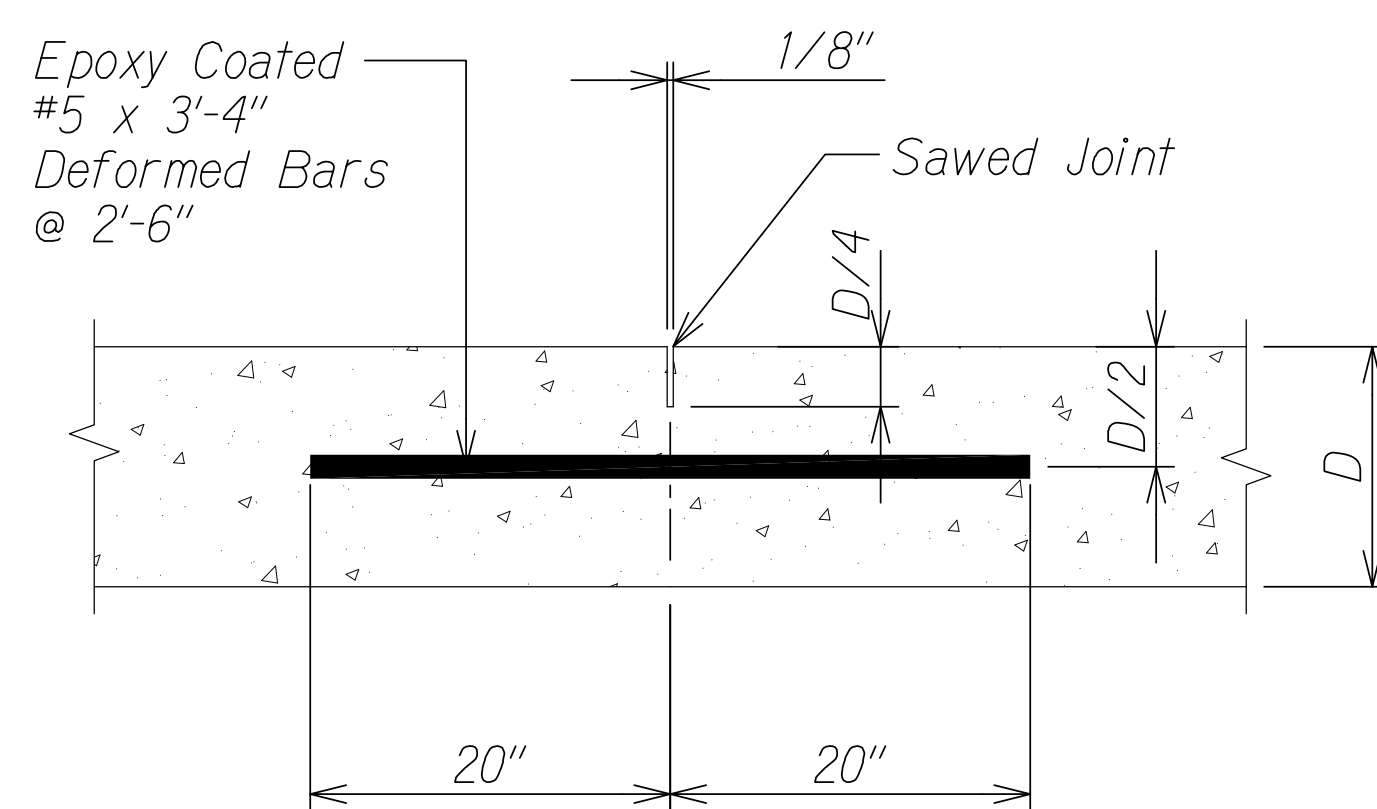


LONGITUDINAL  
CONTRACTION JOINT **D**  
Not to Scale S3.12 S3.12

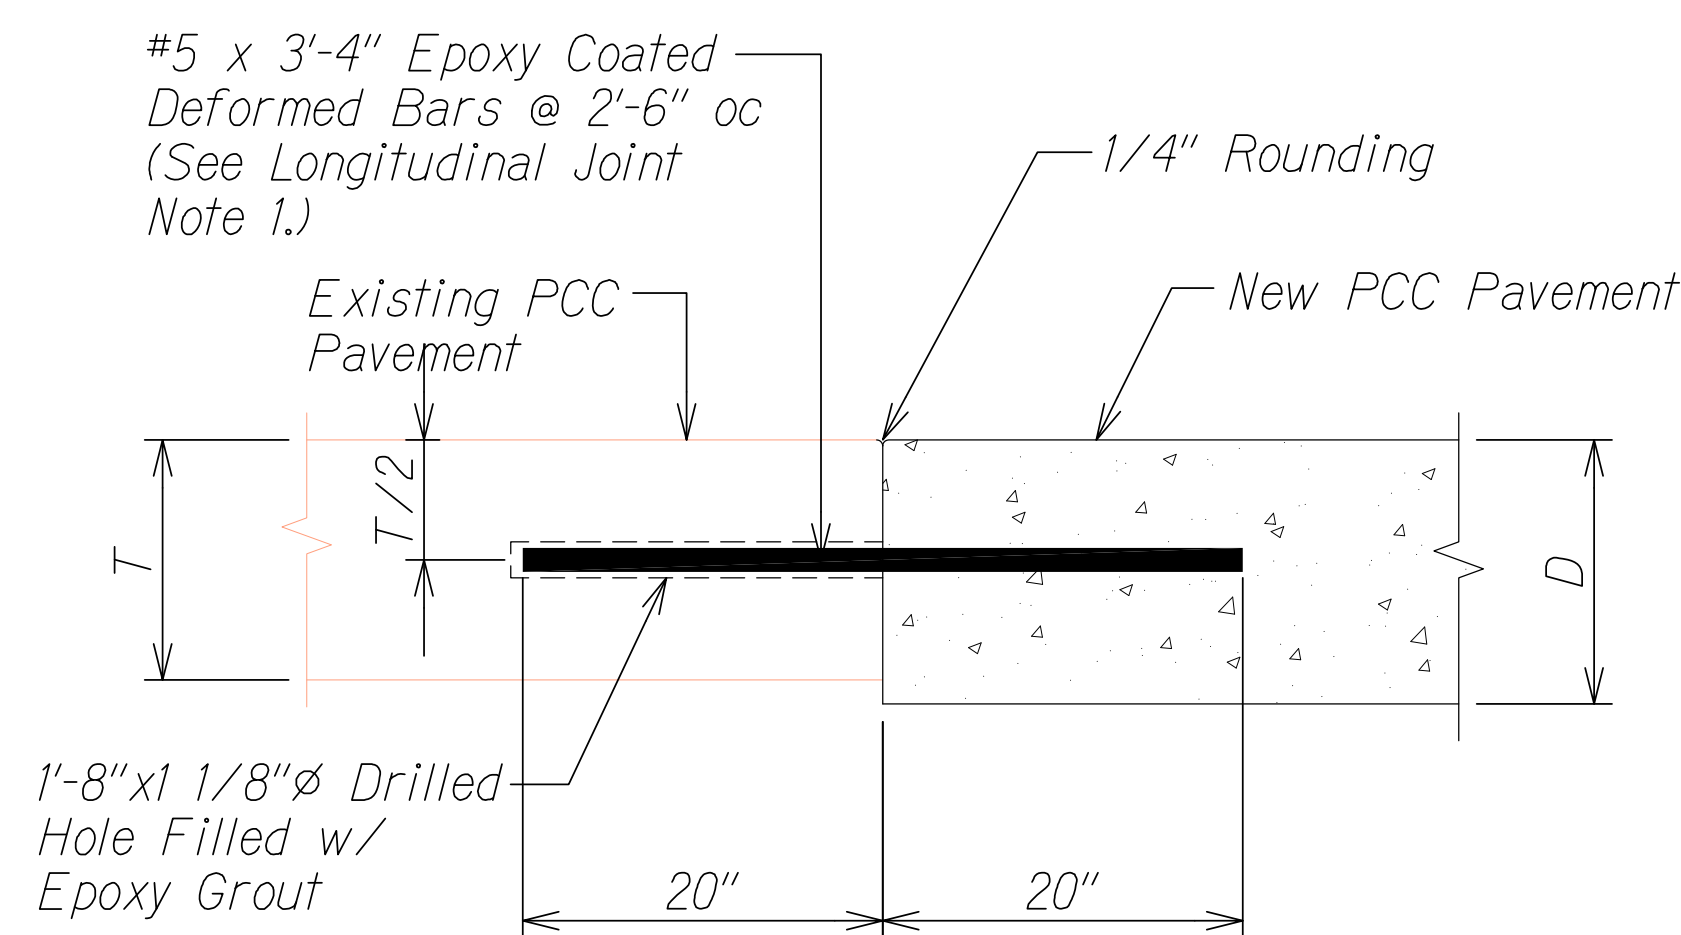

LONGITUDINAL CONSTRUCTION JOINT  
AT EXISTING PCC PAVEMENT **E**  
Not to Scale S3.12 S3.12

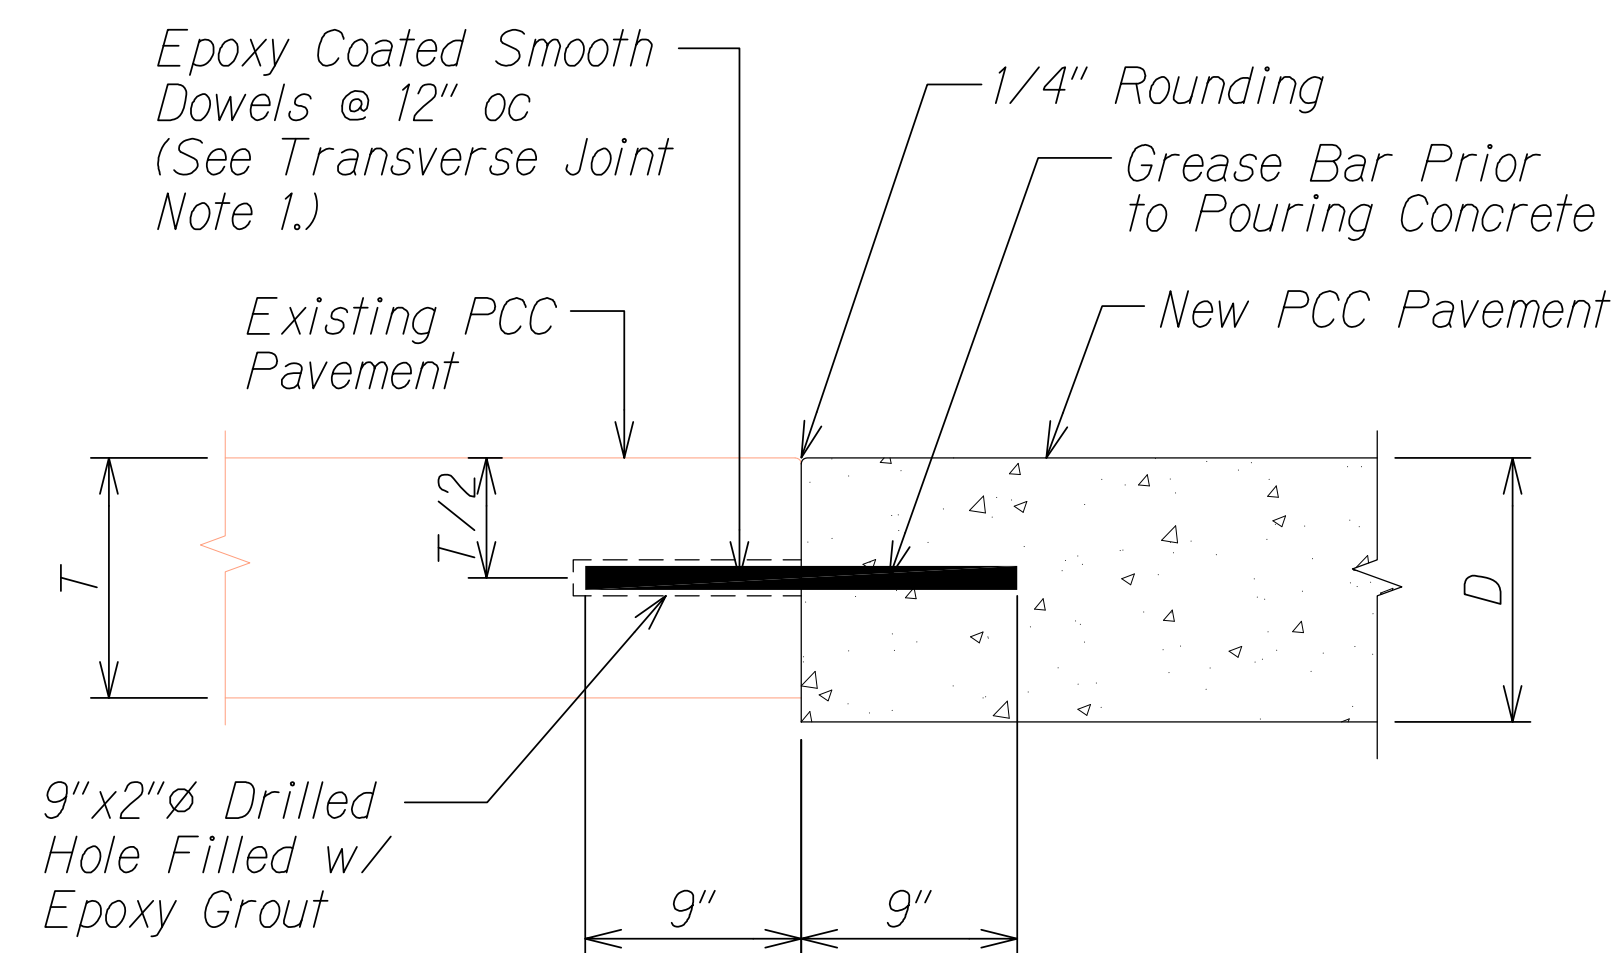

TRANSVERSE CONSTRUCTION JOINT  
AT EXISTING PCC PAVEMENT **F**  
Not to Scale S3.12 S3.12

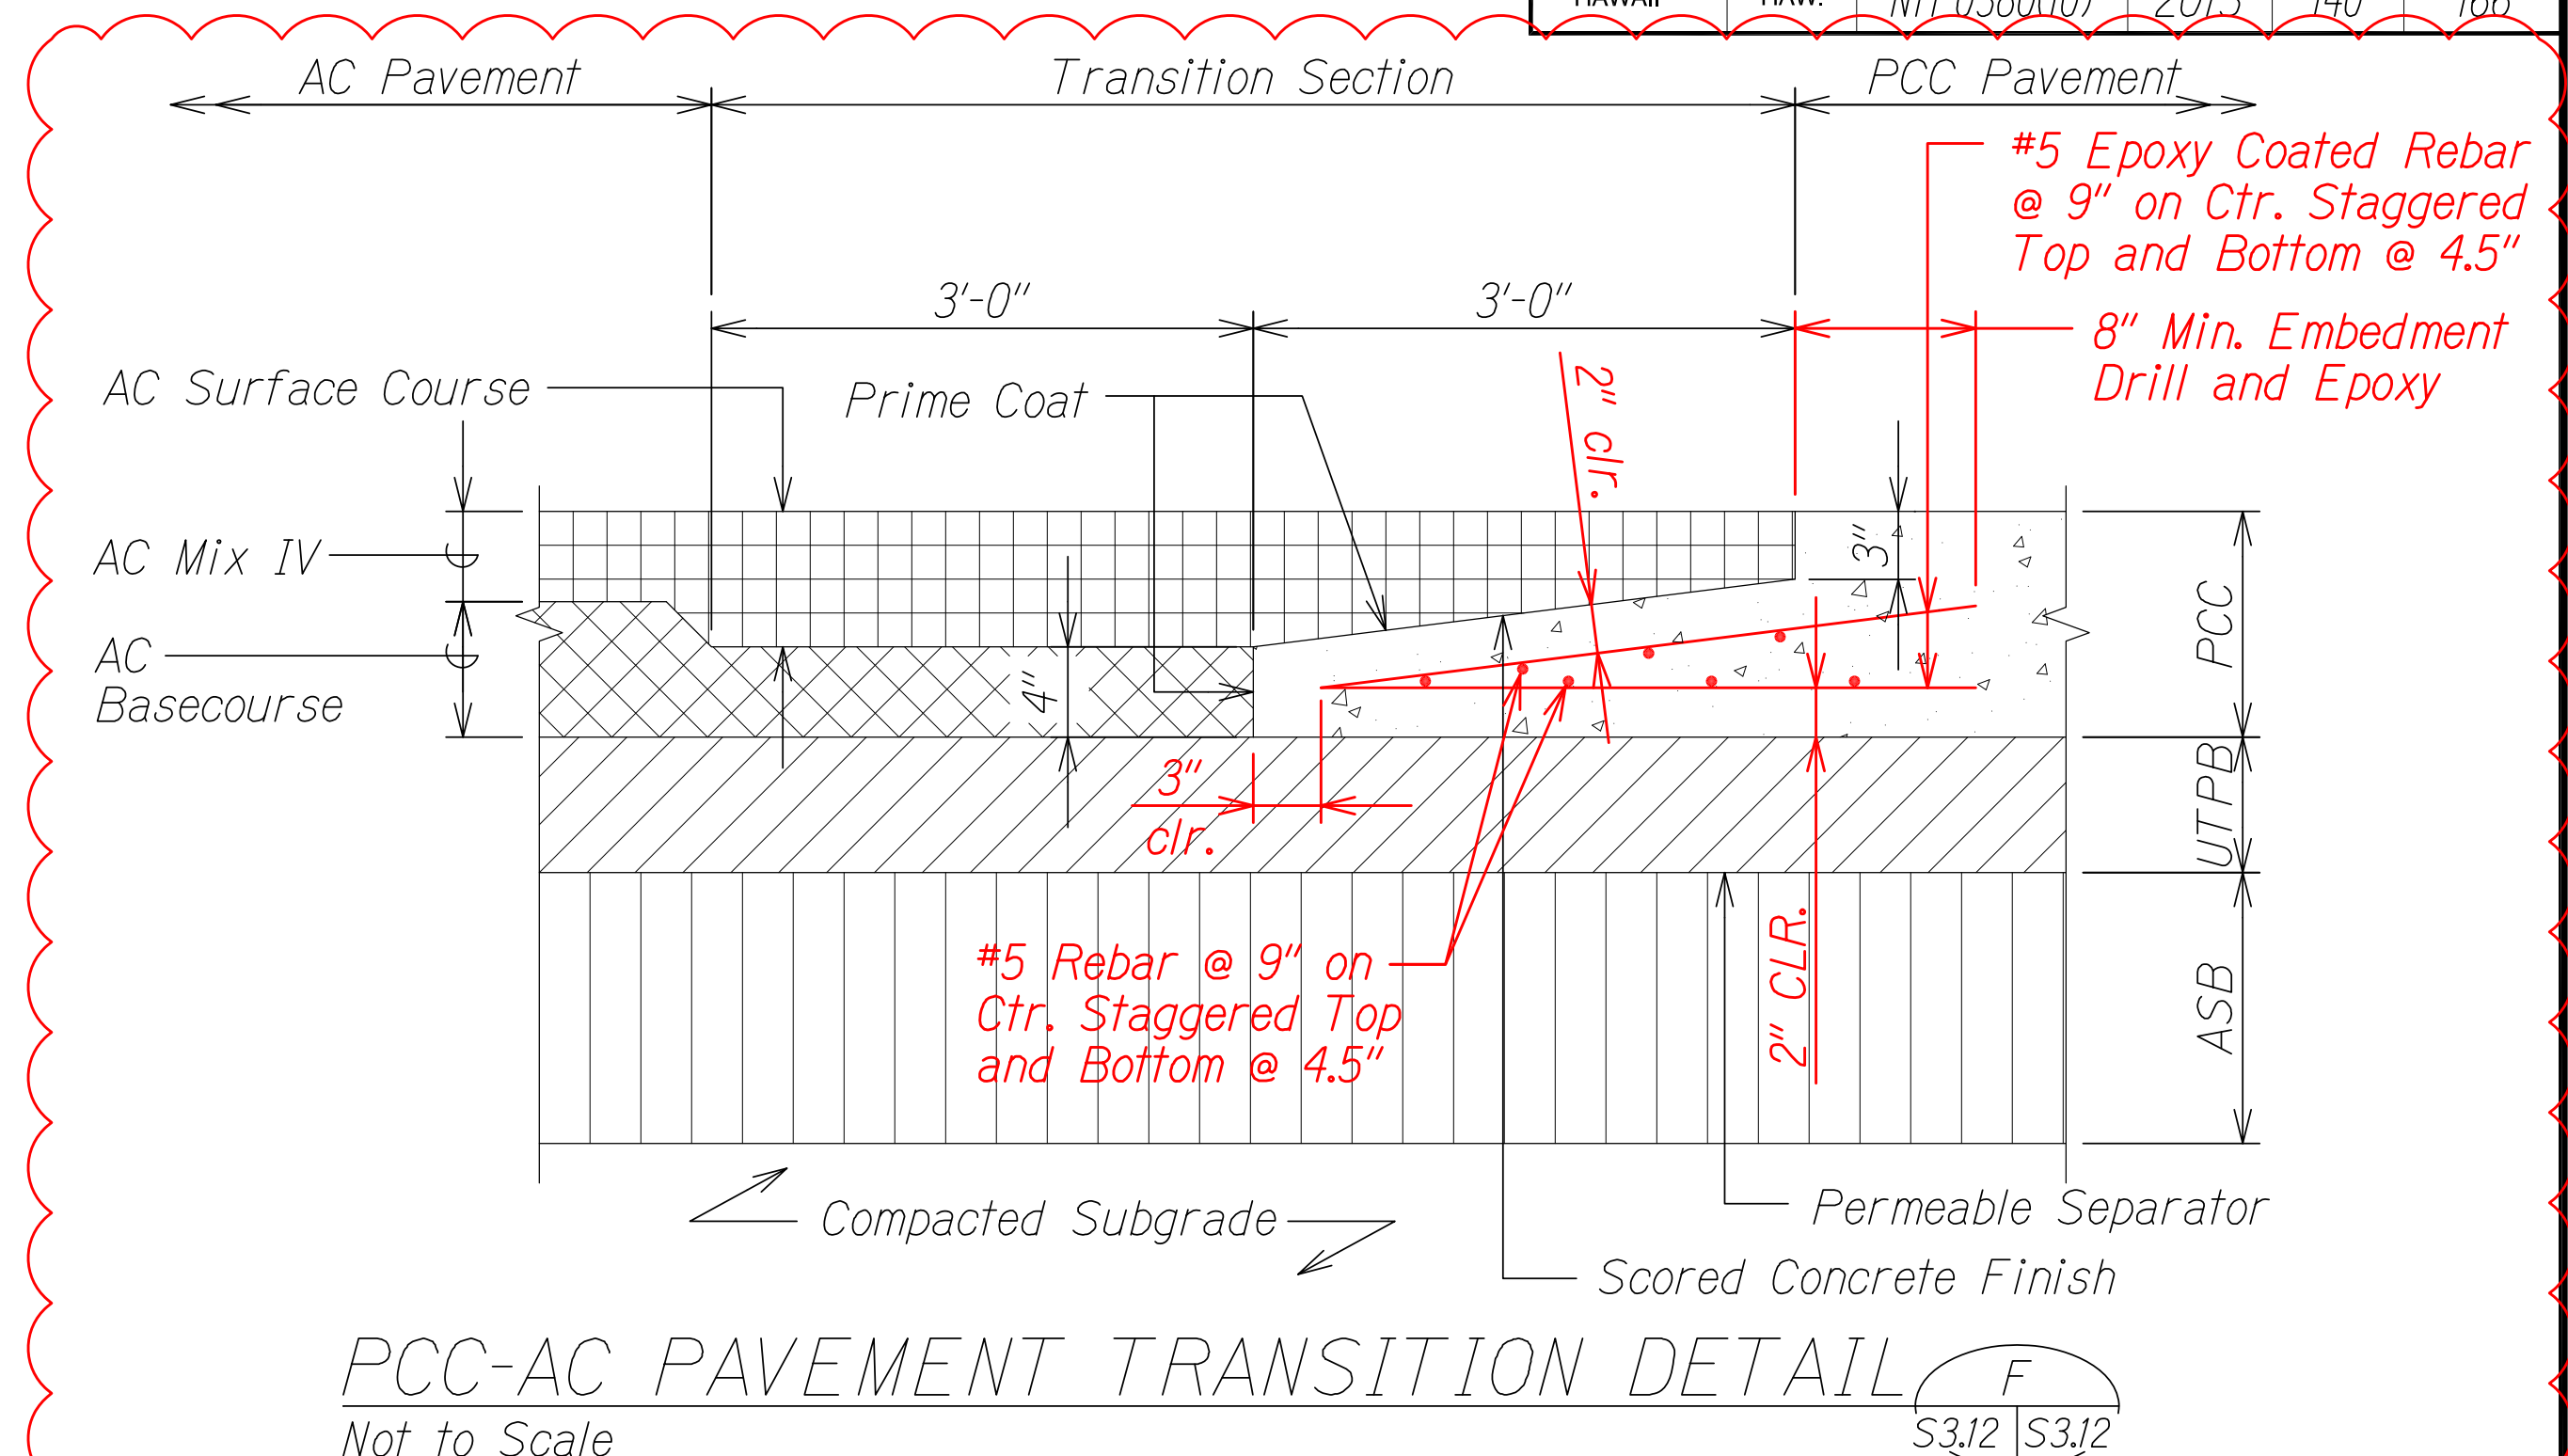

LONGITUDINAL JOINT NOTES:

1. Epoxy-Coated deformed bars shall conform to AASHTO M 284M/M284-03 and ASTM A 775/A775M-01 (Tie Bars).
2. Tiebars are to be located a minimum distance of 18 inches from a transverse joint.
3. The Contractor shall not damage the epoxy coating on the deformed bars in any way during shipment, handling, or placement. Damaged epoxy-coated deformed bars shall be replaced at no cost to the State.

TRANSVERSE JOINT NOTES:

1. Epoxy-Coated dowels shall conform to AASHTO M 284 (ASTM A 775). For pavements with  $D < 10"$ , use 1-1/4  $\phi$  x 1-6" long dowels. For pavements with  $D \geq 10"$ , use 1-1/2  $\phi$  x 1-6" long dowels (Smooth dowels).
2. Locate transverse construction joints at the nearest planned transverse contraction joint as shown on the jointing plans. Joint shall be perpendicular to paving lane.
3. It is critical the dowels be positioned in place parallel to the pavement surface and paving lane direction to avoid future cracks in the PCC pavement. The ends of the dowels shall not deviate more than 0.012' from the parallel in 9" length.
4. See sheets S3.1 to S3.9 for typical transverse joint spacing.
5. The contractor shall not damage the epoxy coating on the dowels in any way during shipment, handling or placement. Damaged epoxy-coated dowels or rebar shall be replaced at no cost to the State.

THIS WORK WAS PREPARED BY ME  
OR UNDER MY SUPERVISION.

APRIL 30, 2016  
LIC. EXP. DATE

STATE OF HAWAII  
DEPARTMENT OF TRANSPORTATION  
HIGHWAYS DIVISION  
**PAVEMENT JOINTING DETAILS**


KAHULUI AIRPORT  
ACCESS ROAD, PHASE I  
Federal Aid Project No. NH-0380(10)  
Scale: As Shown Date: February 2013

SHEET No. S3.12 OF 24 SHEETS

"AS-BUILT"



FED. ROAD DIST. NO.	STATE	FED. AID PROJ. NO.	FISCAL YEAR	SHEET NO.	TOTAL SHEETS
HAWAII	HAW.	NH-0380(10)	2013	C.O. 140S-1	166

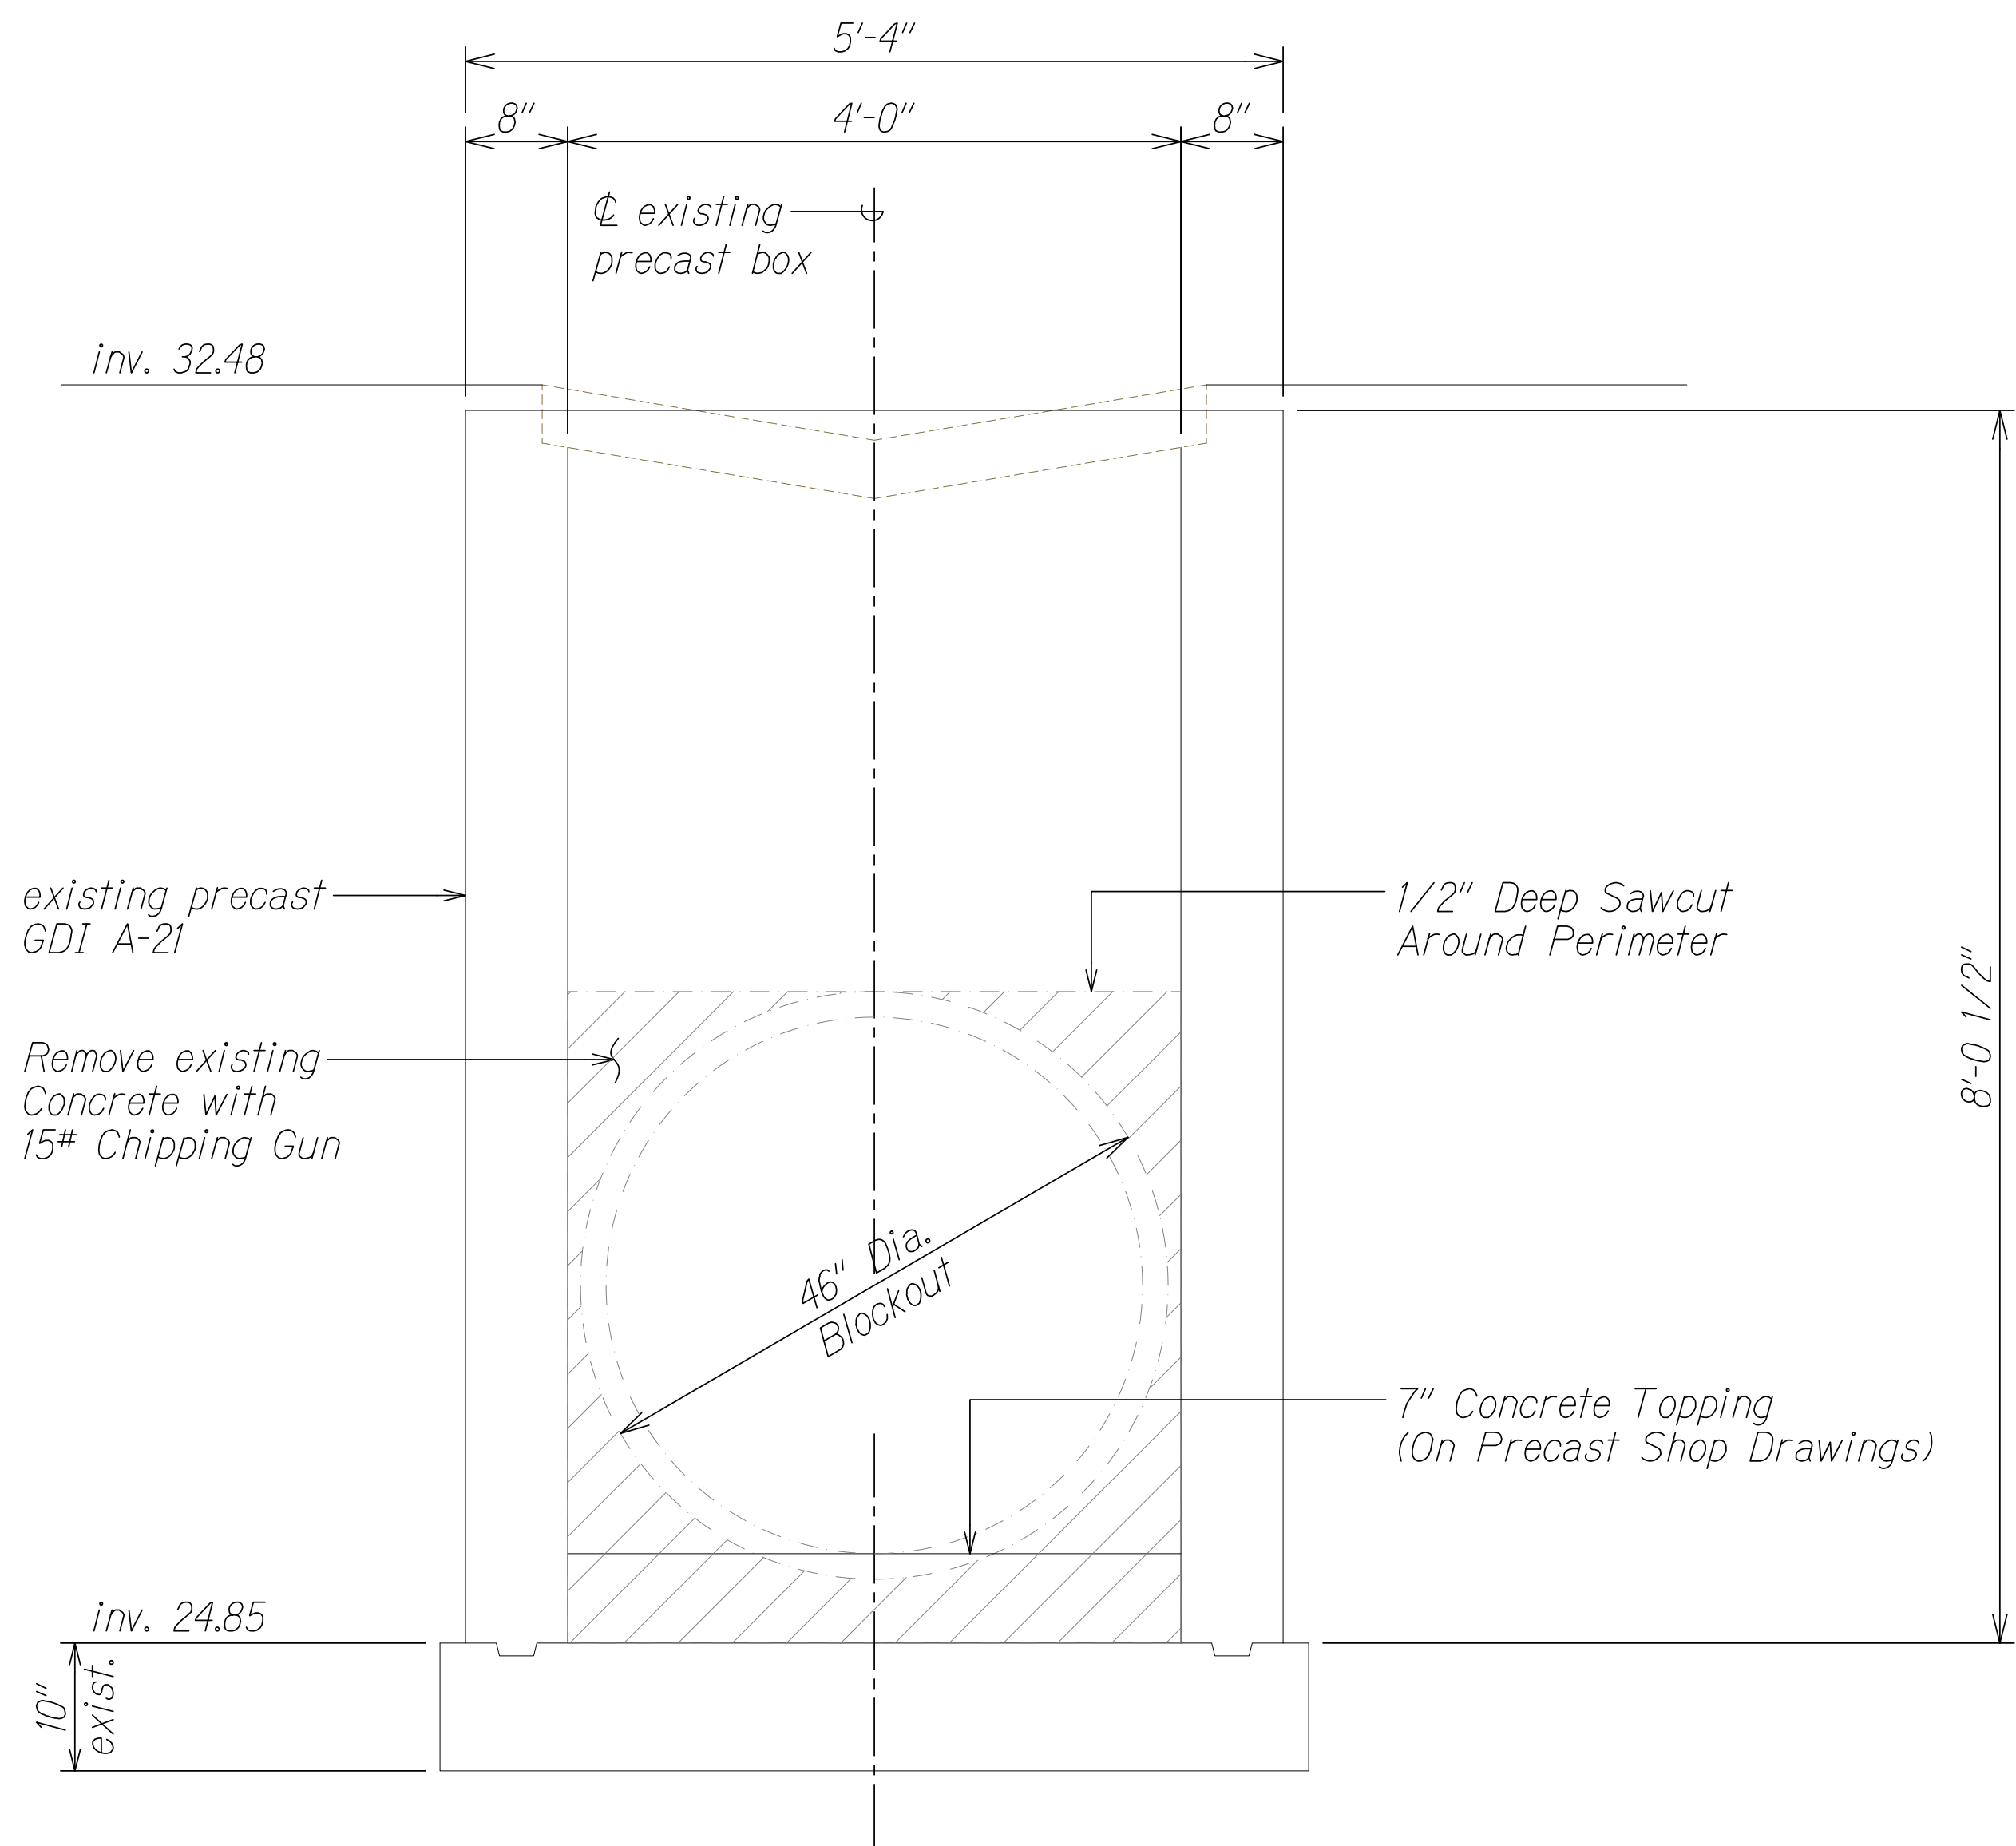

DEMO ELEVATION A  
Scale: 1" = 1'-0" S4.1 S4.1

ORIGINAL PLAN	SURVEY PLOTTED BY	DATE
NOTE BOOK	DRAWN BY	
No.	DESIGNED BY	
	QUANTITIES BY	
	CHECKED BY	

DRAWING NAME: C:\PROJECTS\KAHULUI-2011\AS-BUILT OCTOBER 2017\STRUCTURAL\KAH-S401.DWG PLOT TIME: 10-18-18, 2:57 PM

11/24/14	New Sheet
DATE	REVISION

STATE OF HAWAII  
DEPARTMENT OF TRANSPORTATION  
HIGHWAYS DIVISION  
**EXISTING PRECAST GDI A-21**  
**DEMO ELEVATION**  
  
KAHULUI AIRPORT  
ACCESS ROAD, PHASE I  
Federal Aid Project No. NH-0380(10)  
Scale: As Shown Date: February 2013  
  
SHEET No. S41 OF 24 SHEETS

THIS WORK WAS PREPARED BY ME  
OR UNDER MY SUPERVISION.  
  
KSF, INC. APRIL 30, 2016  
LIC. EXP. DATE


"AS-BUILT"

C.O. 140S-1

AS-BUILT DRAWINGS




FED. ROAD DIST. NO.	STATE	FED. AID PROJ. NO.	FISCAL YEAR	SHEET NO.	TOTAL SHEETS
HAWAII	HAW.	NH-0380(10)	2013	C.O. 140S-2	166

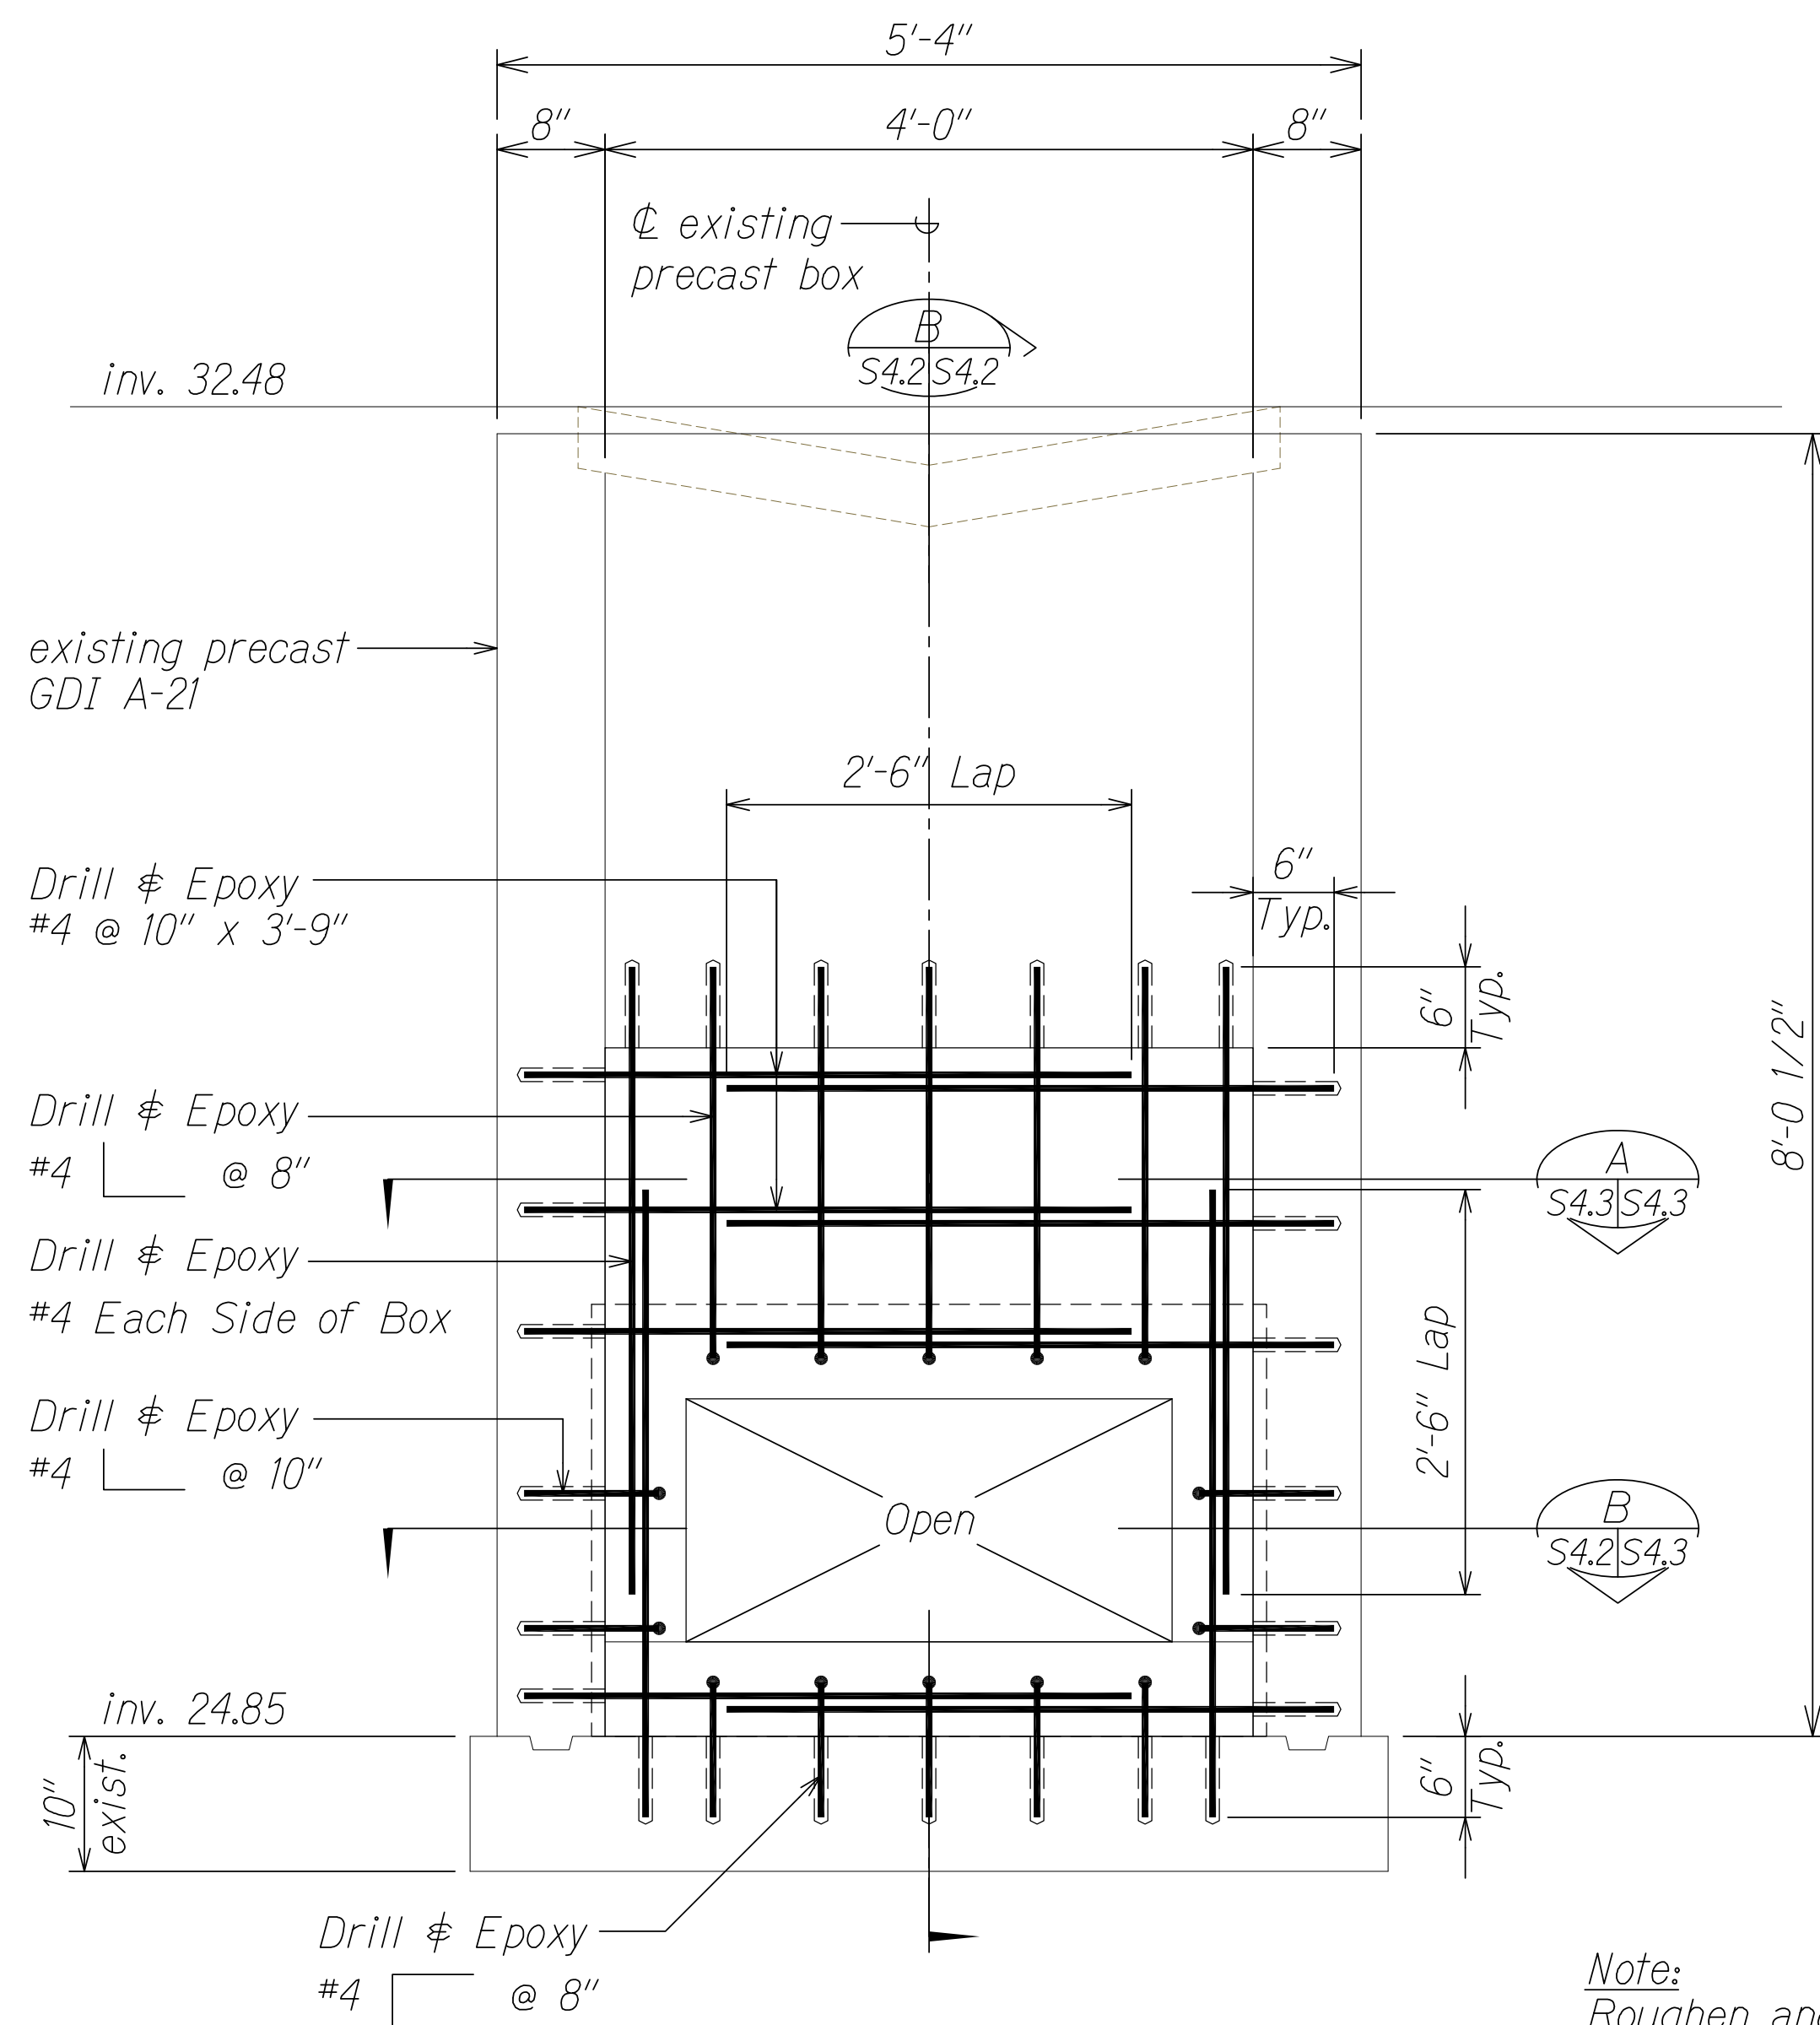

ELEVATION A  
Scale: 1" = 1'-0" S4.2 S4.2

Note:  
Roughen and clean all existing surface in which new concrete is poured against.

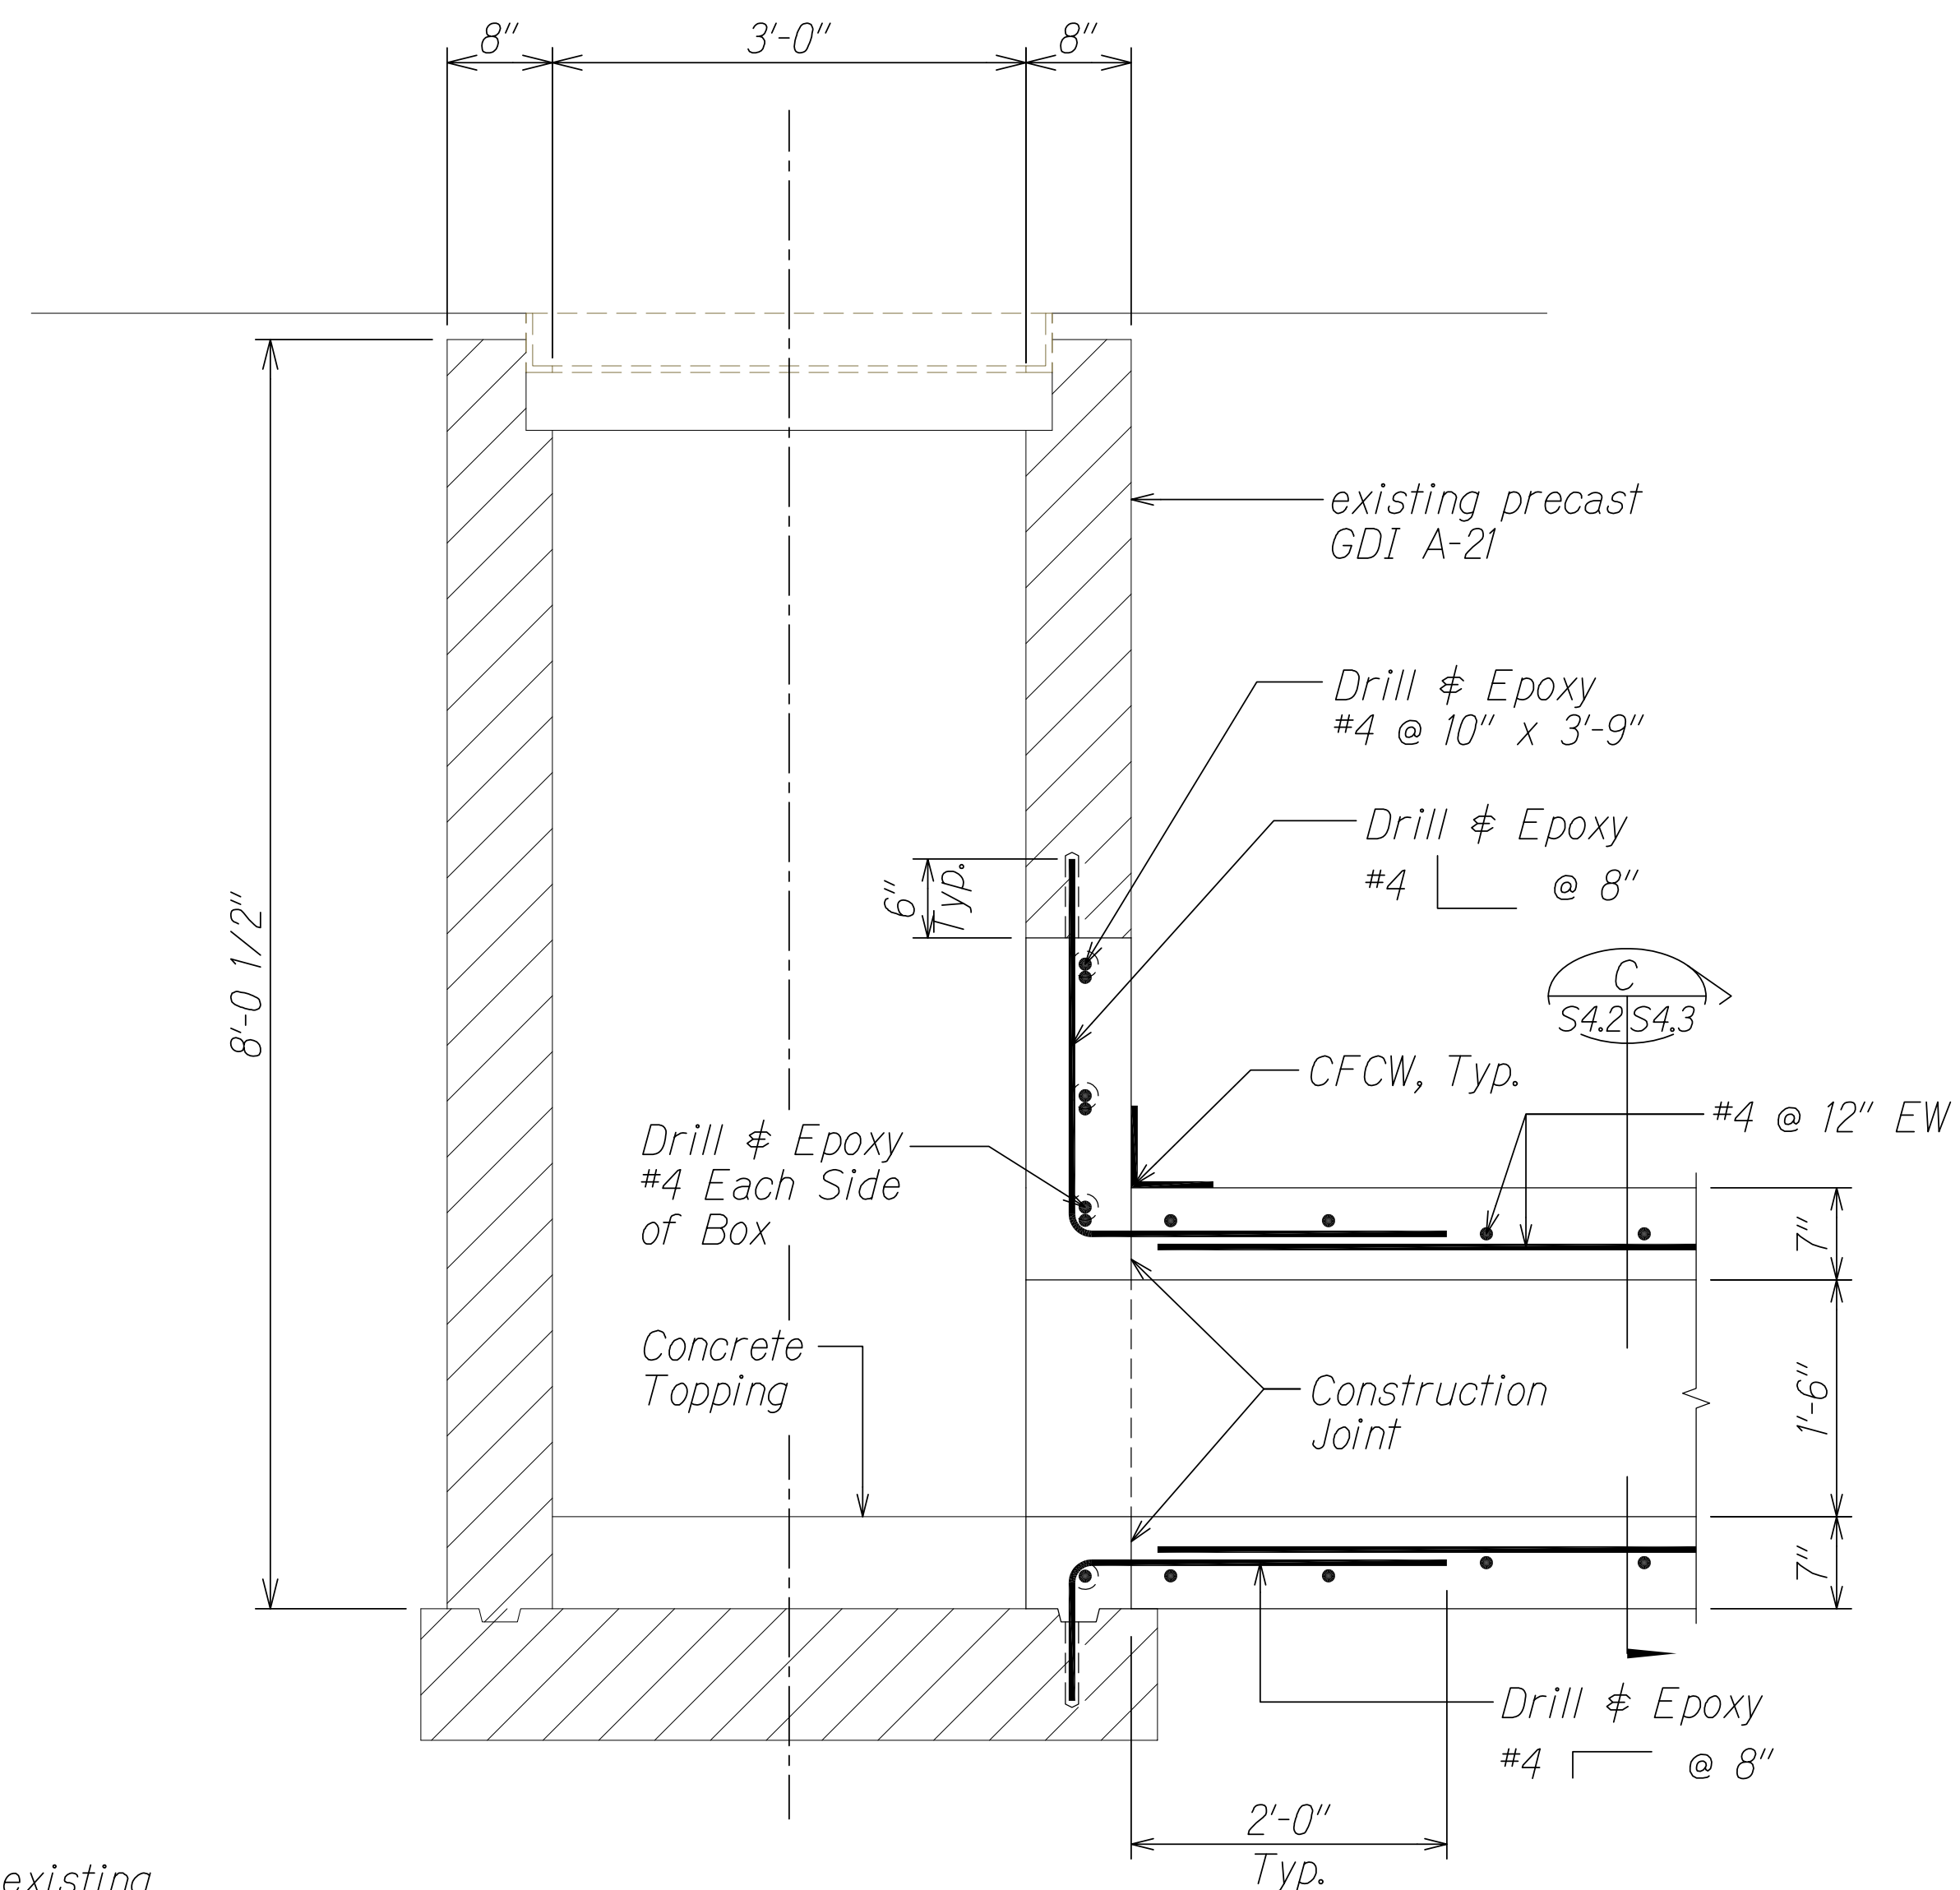

SECTION B  
Scale: 1" = 1'-0" S4.2 S4.2

THIS WORK WAS PREPARED BY ME  
OR UNDER MY SUPERVISION.

KSF, INC. APRIL 30, 2016  
LIC. EXP. DATE

STATE OF HAWAII  
DEPARTMENT OF TRANSPORTATION  
HIGHWAYS DIVISION  
**PRECAST GDI A-21**  
**ELEVATION AND SECTION**

KAHULUI AIRPORT  
ACCESS ROAD, PHASE I  
Federal Aid Project No. NH-0380(10)  
Scale: As Shown Date: February 2013

SHEET No. S4.2 OF 24 SHEETS

11/24/14	-	New Sheet
DATE	REVISION	


"AS-BUILT"

C.O. 140S-2


AS-BUILT DRAWINGS




FED. ROAD DIST. NO.	STATE	FED. AID PROJ. NO.	FISCAL YEAR	SHEET NO.	TOTAL SHEETS
HAWAII	HAW.	NH-0380(10)	2013	C.O. 140S-3	166

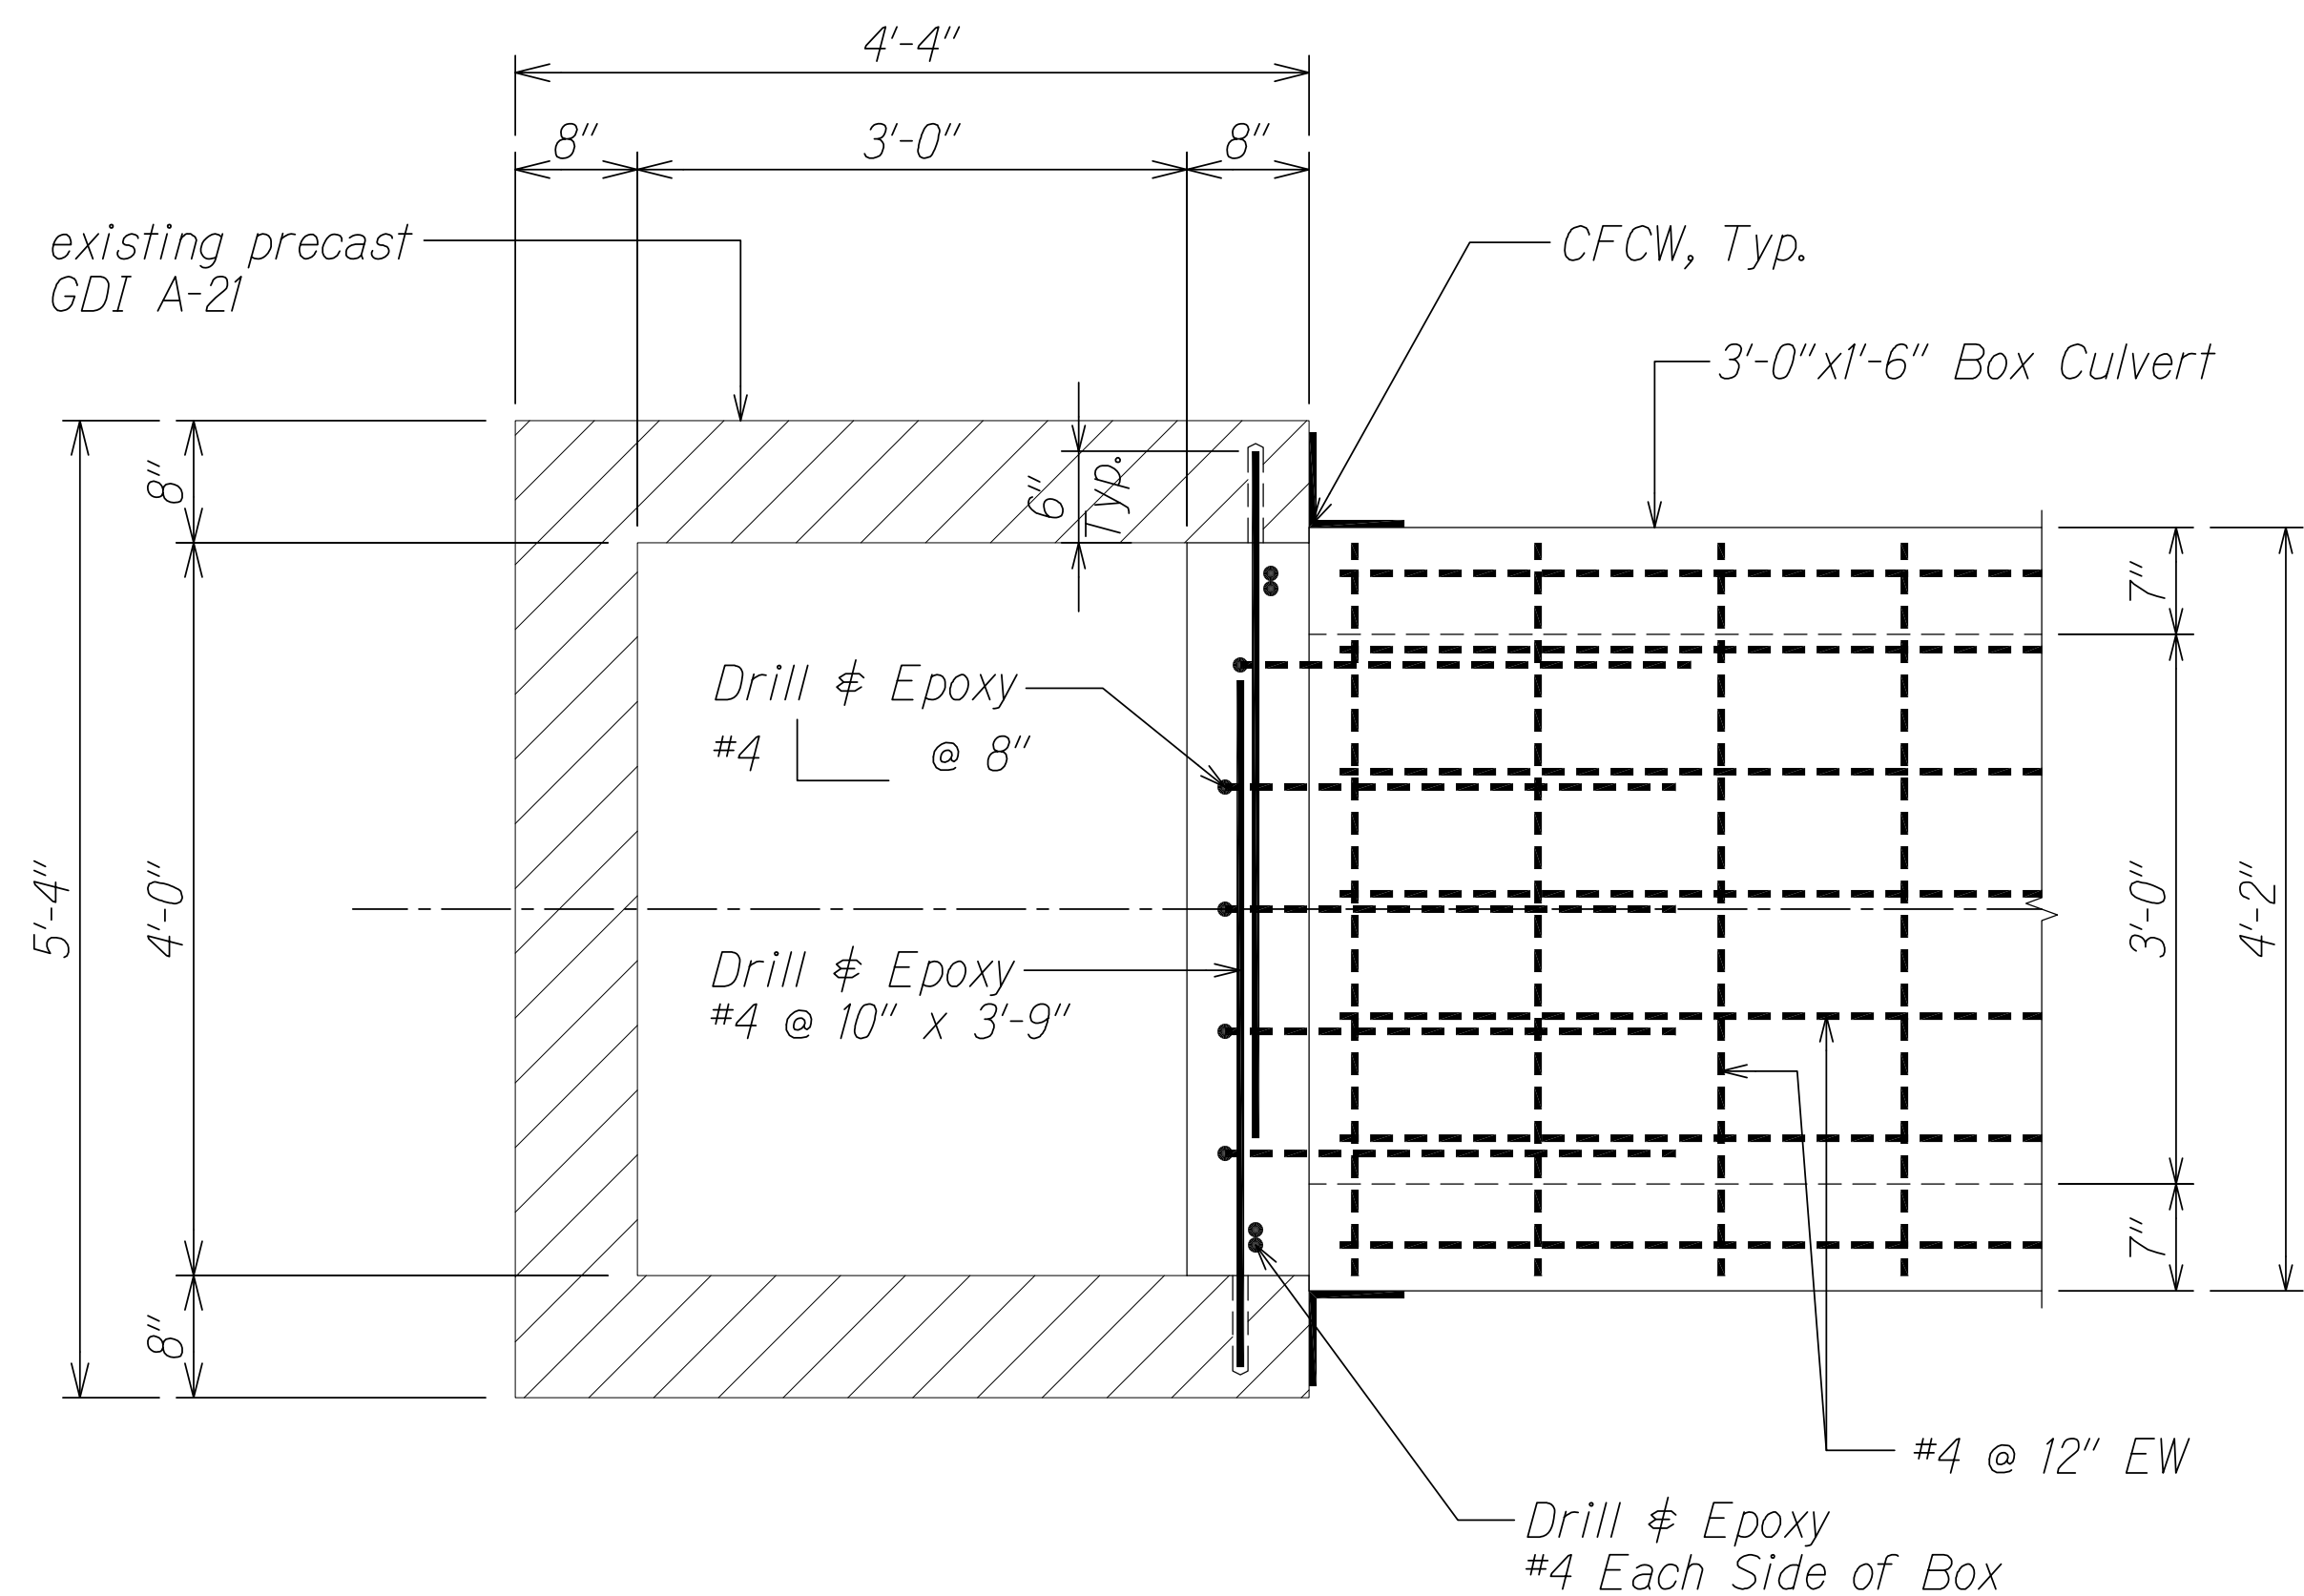

SECTION A  
Scale: 1" = 1'-0"

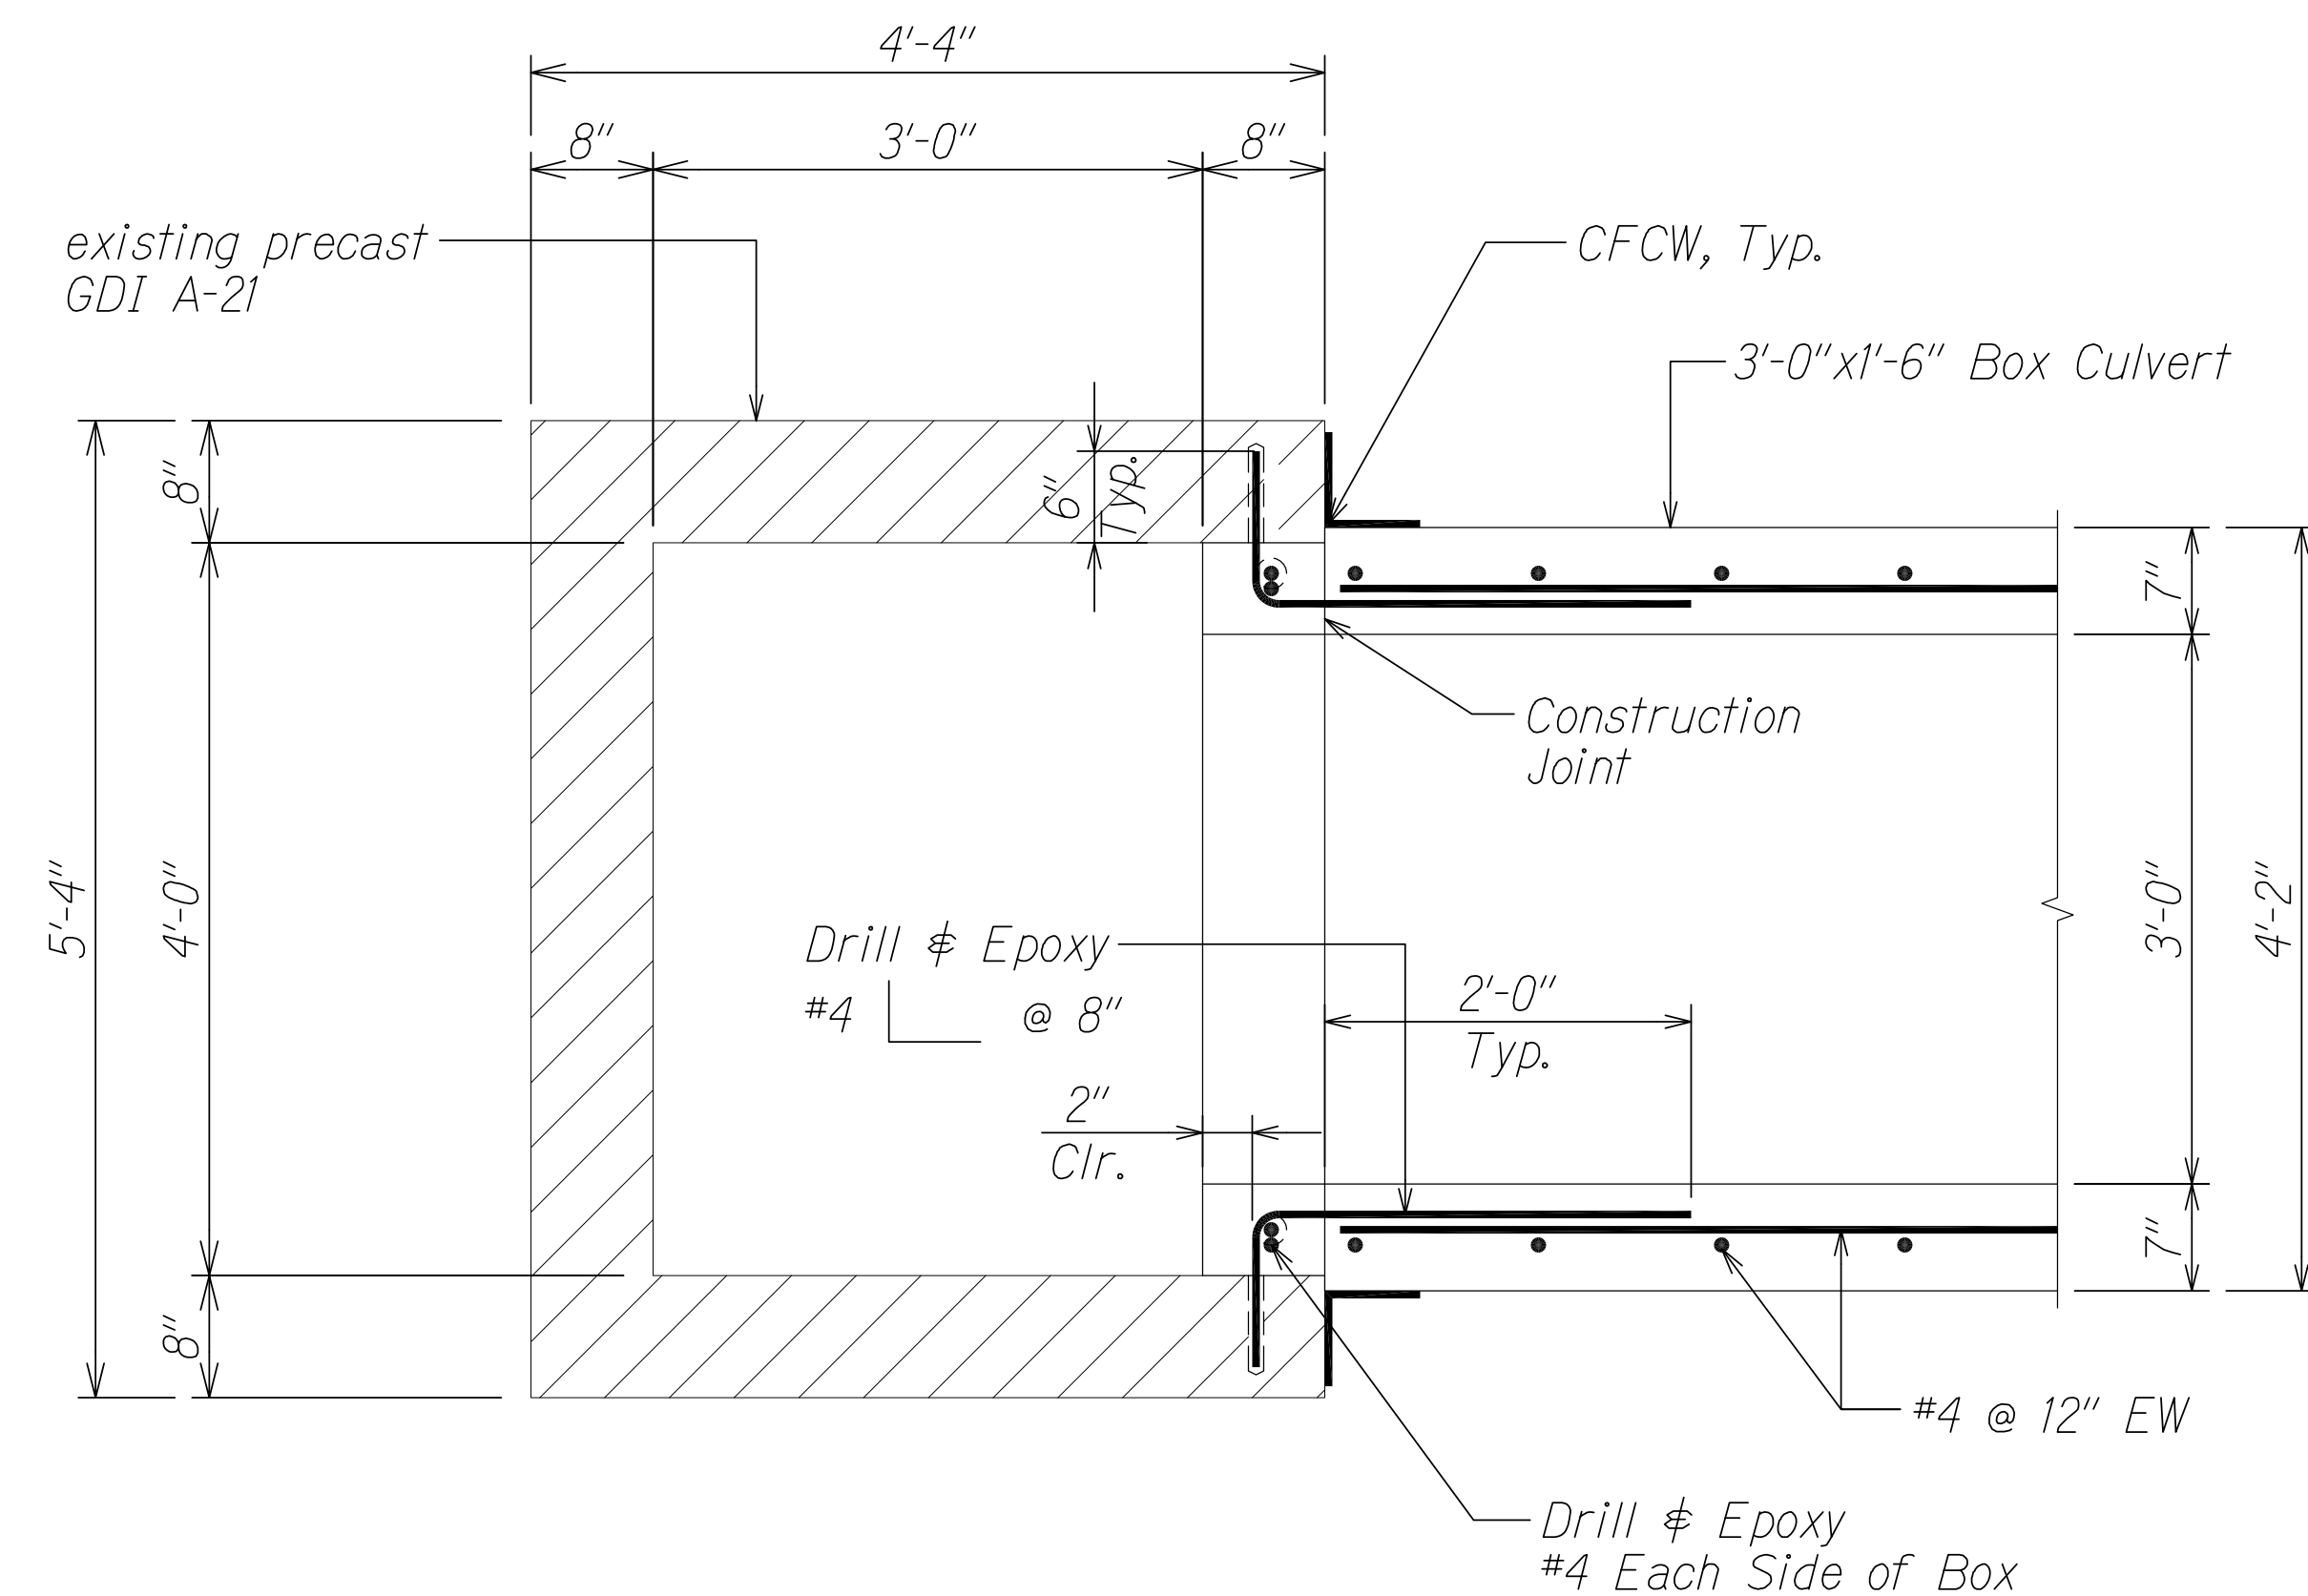

SECTION B  
Scale: 1" = 1'-0"

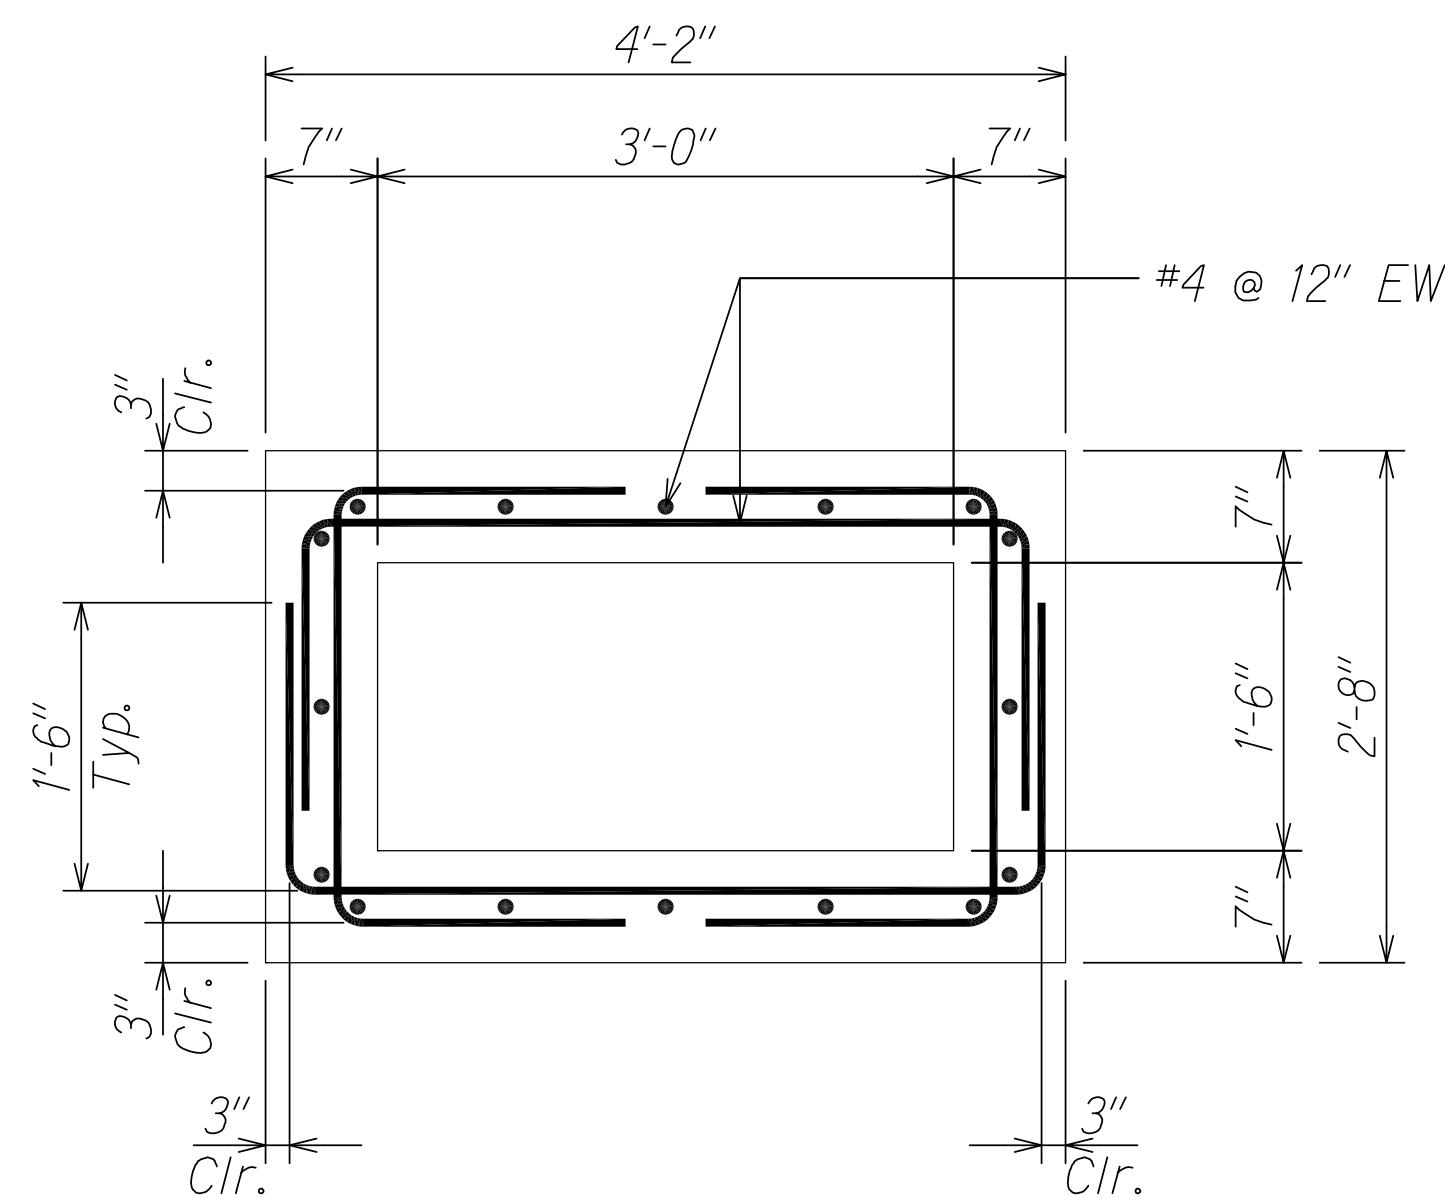

TYPICAL 3'-0" x 1'-6" BOX CULVERT SECTION C  
Scale: 1" = 1'-0"

THIS WORK WAS PREPARED BY ME  
OR UNDER MY SUPERVISION.

KSF, INC. APRIL 30, 2016  
LIC. EXP. DATE

STATE OF HAWAII  
DEPARTMENT OF TRANSPORTATION  
HIGHWAYS DIVISION  
**PRECAST GDI A-21**  
**SECTIONS**  
  
KAHULUI AIRPORT  
ACCESS ROAD, PHASE I  
Federal Aid Project No. NH-0380(10)  
Scale: As Shown Date: February 2013

DATE: 11/24/14  
REVISION: - New Sheet

SHEET No. S4.3 OF 24 SHEETS


"AS-BUILT"

C.O. 140S-3

AS-BUILT DRAWINGS




FED. ROAD DIST. NO.	STATE	FED. AID PROJ. NO.	FISCAL YEAR	SHEET NO.	TOTAL SHEETS
HAWAII	HAW.	NH-0380(10)	2013	C.O. 140S-4	166

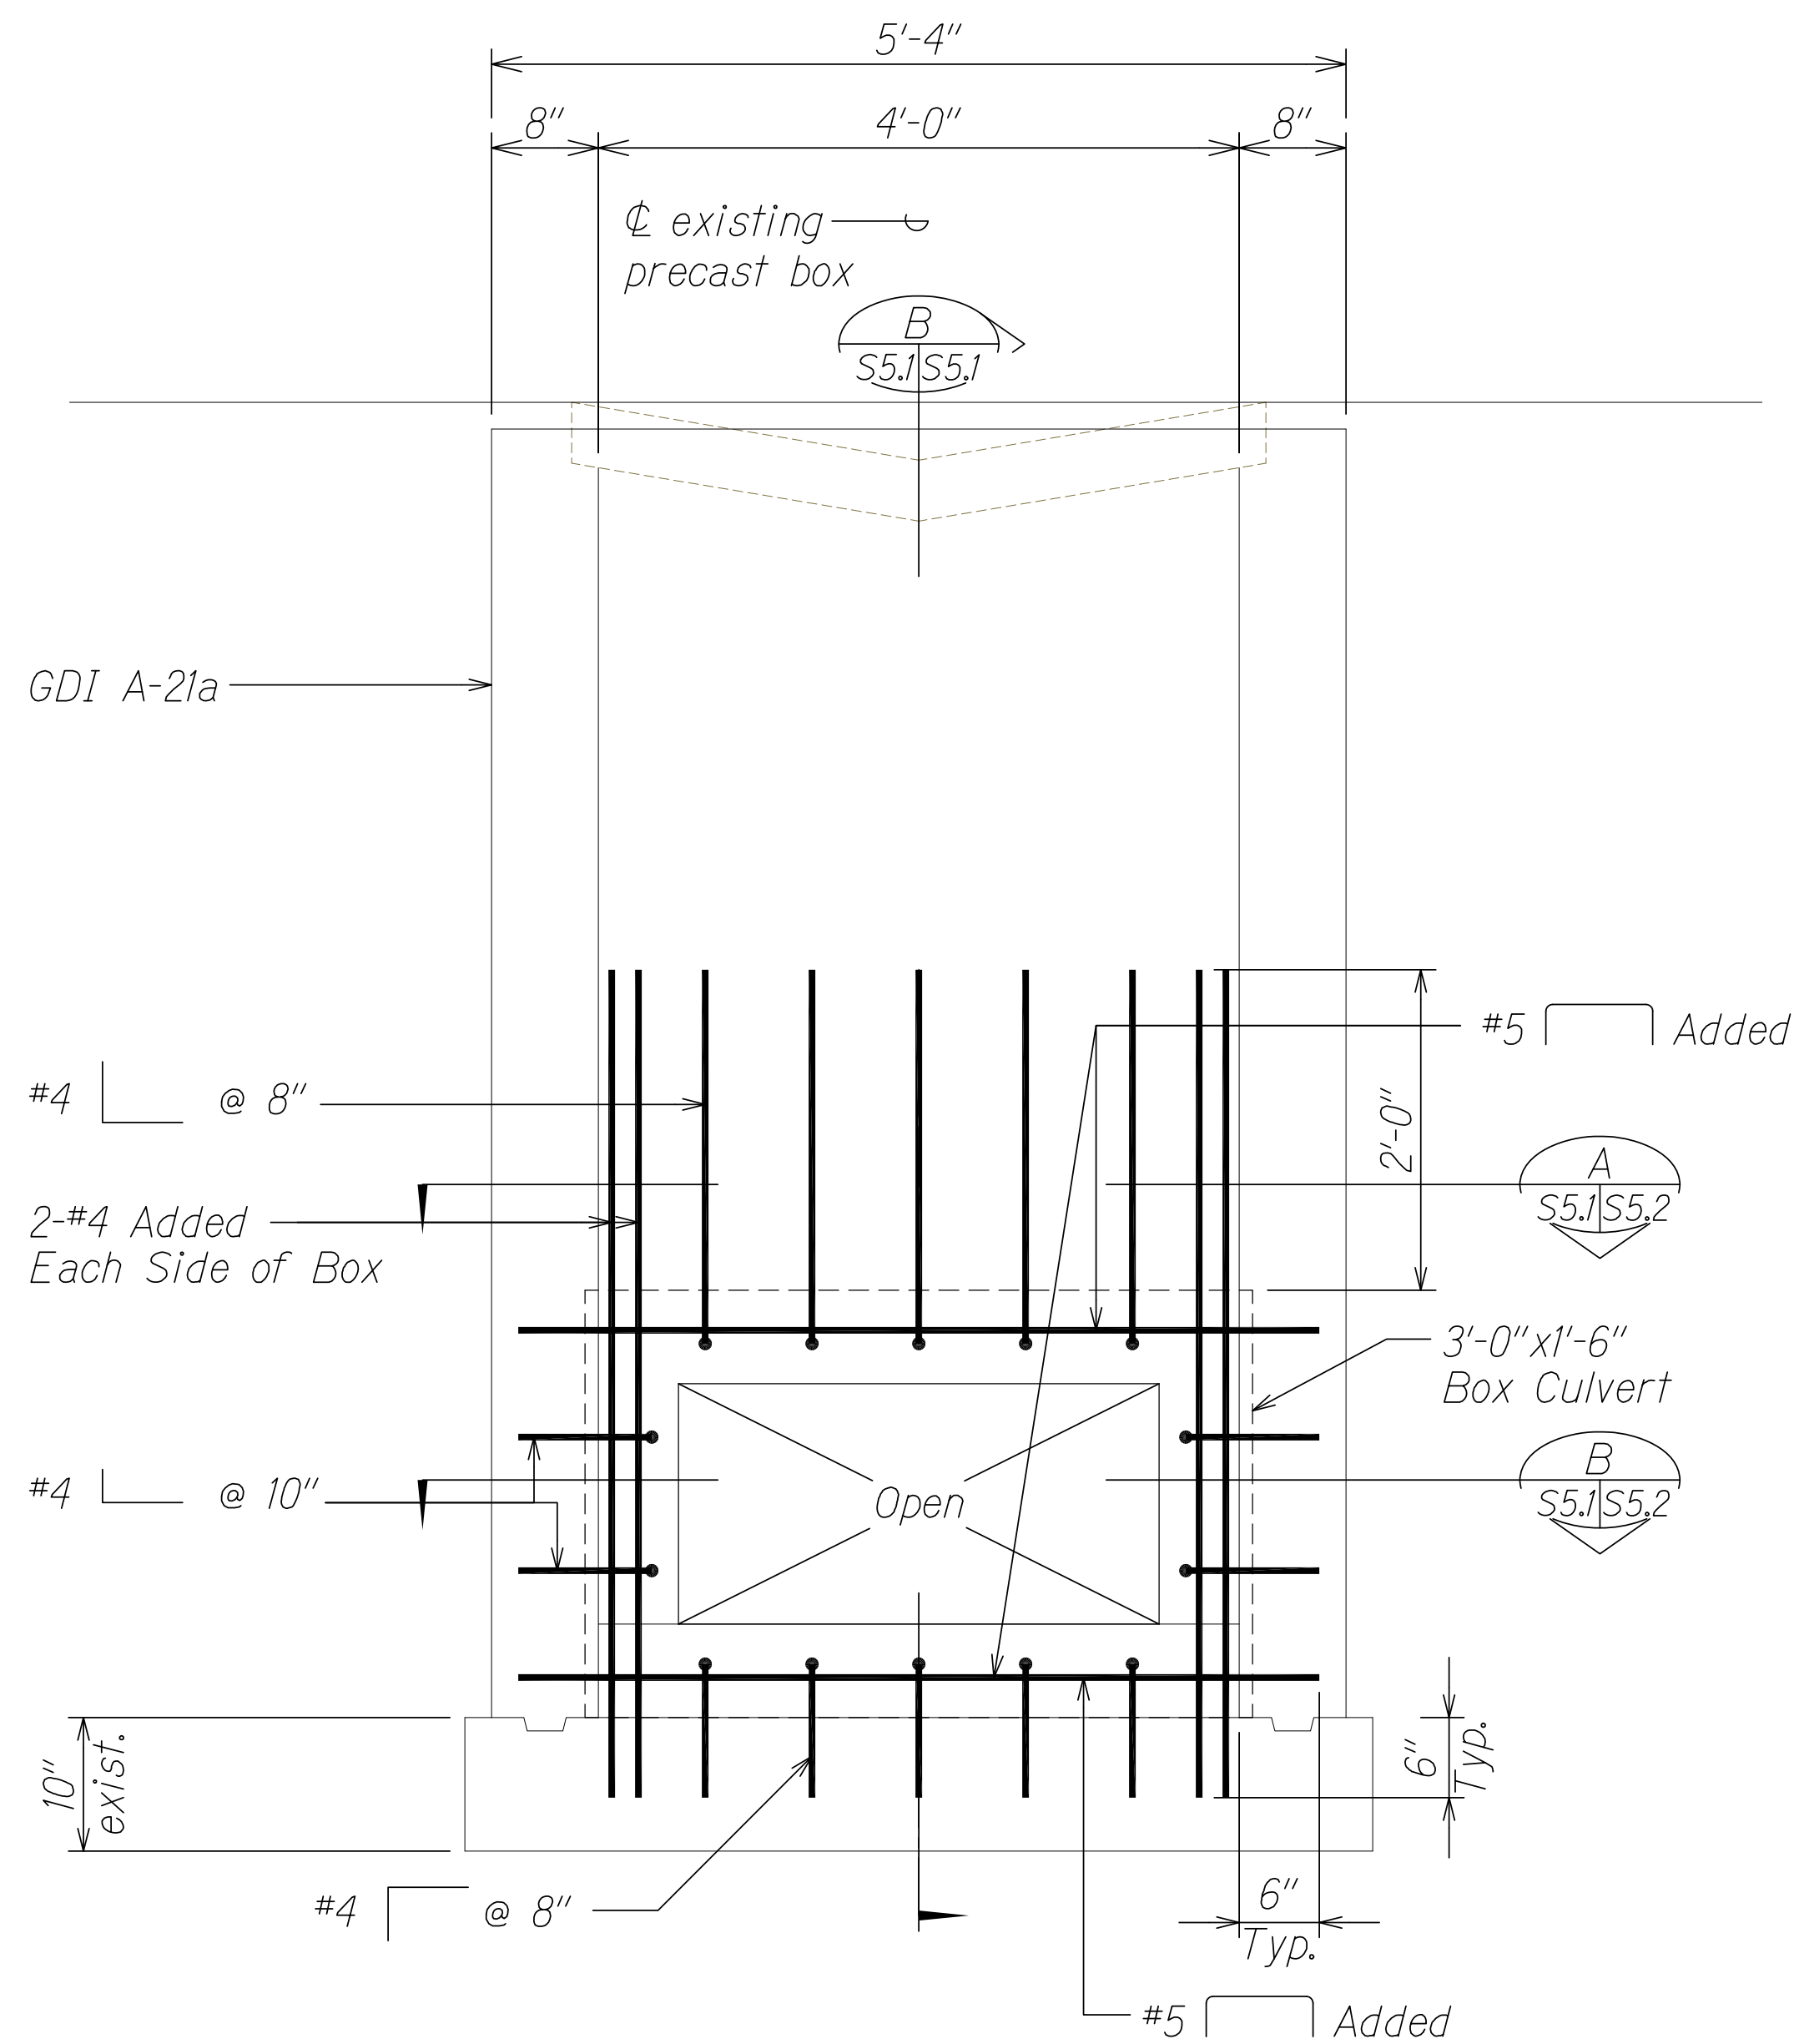

ELEVATION A  
Scale: 1" = 1'-0"

Note:  
All details and reinforcing for GDI shall follow the 2008 State of Hawaii Highways Division Standard Plans unless otherwise noted.

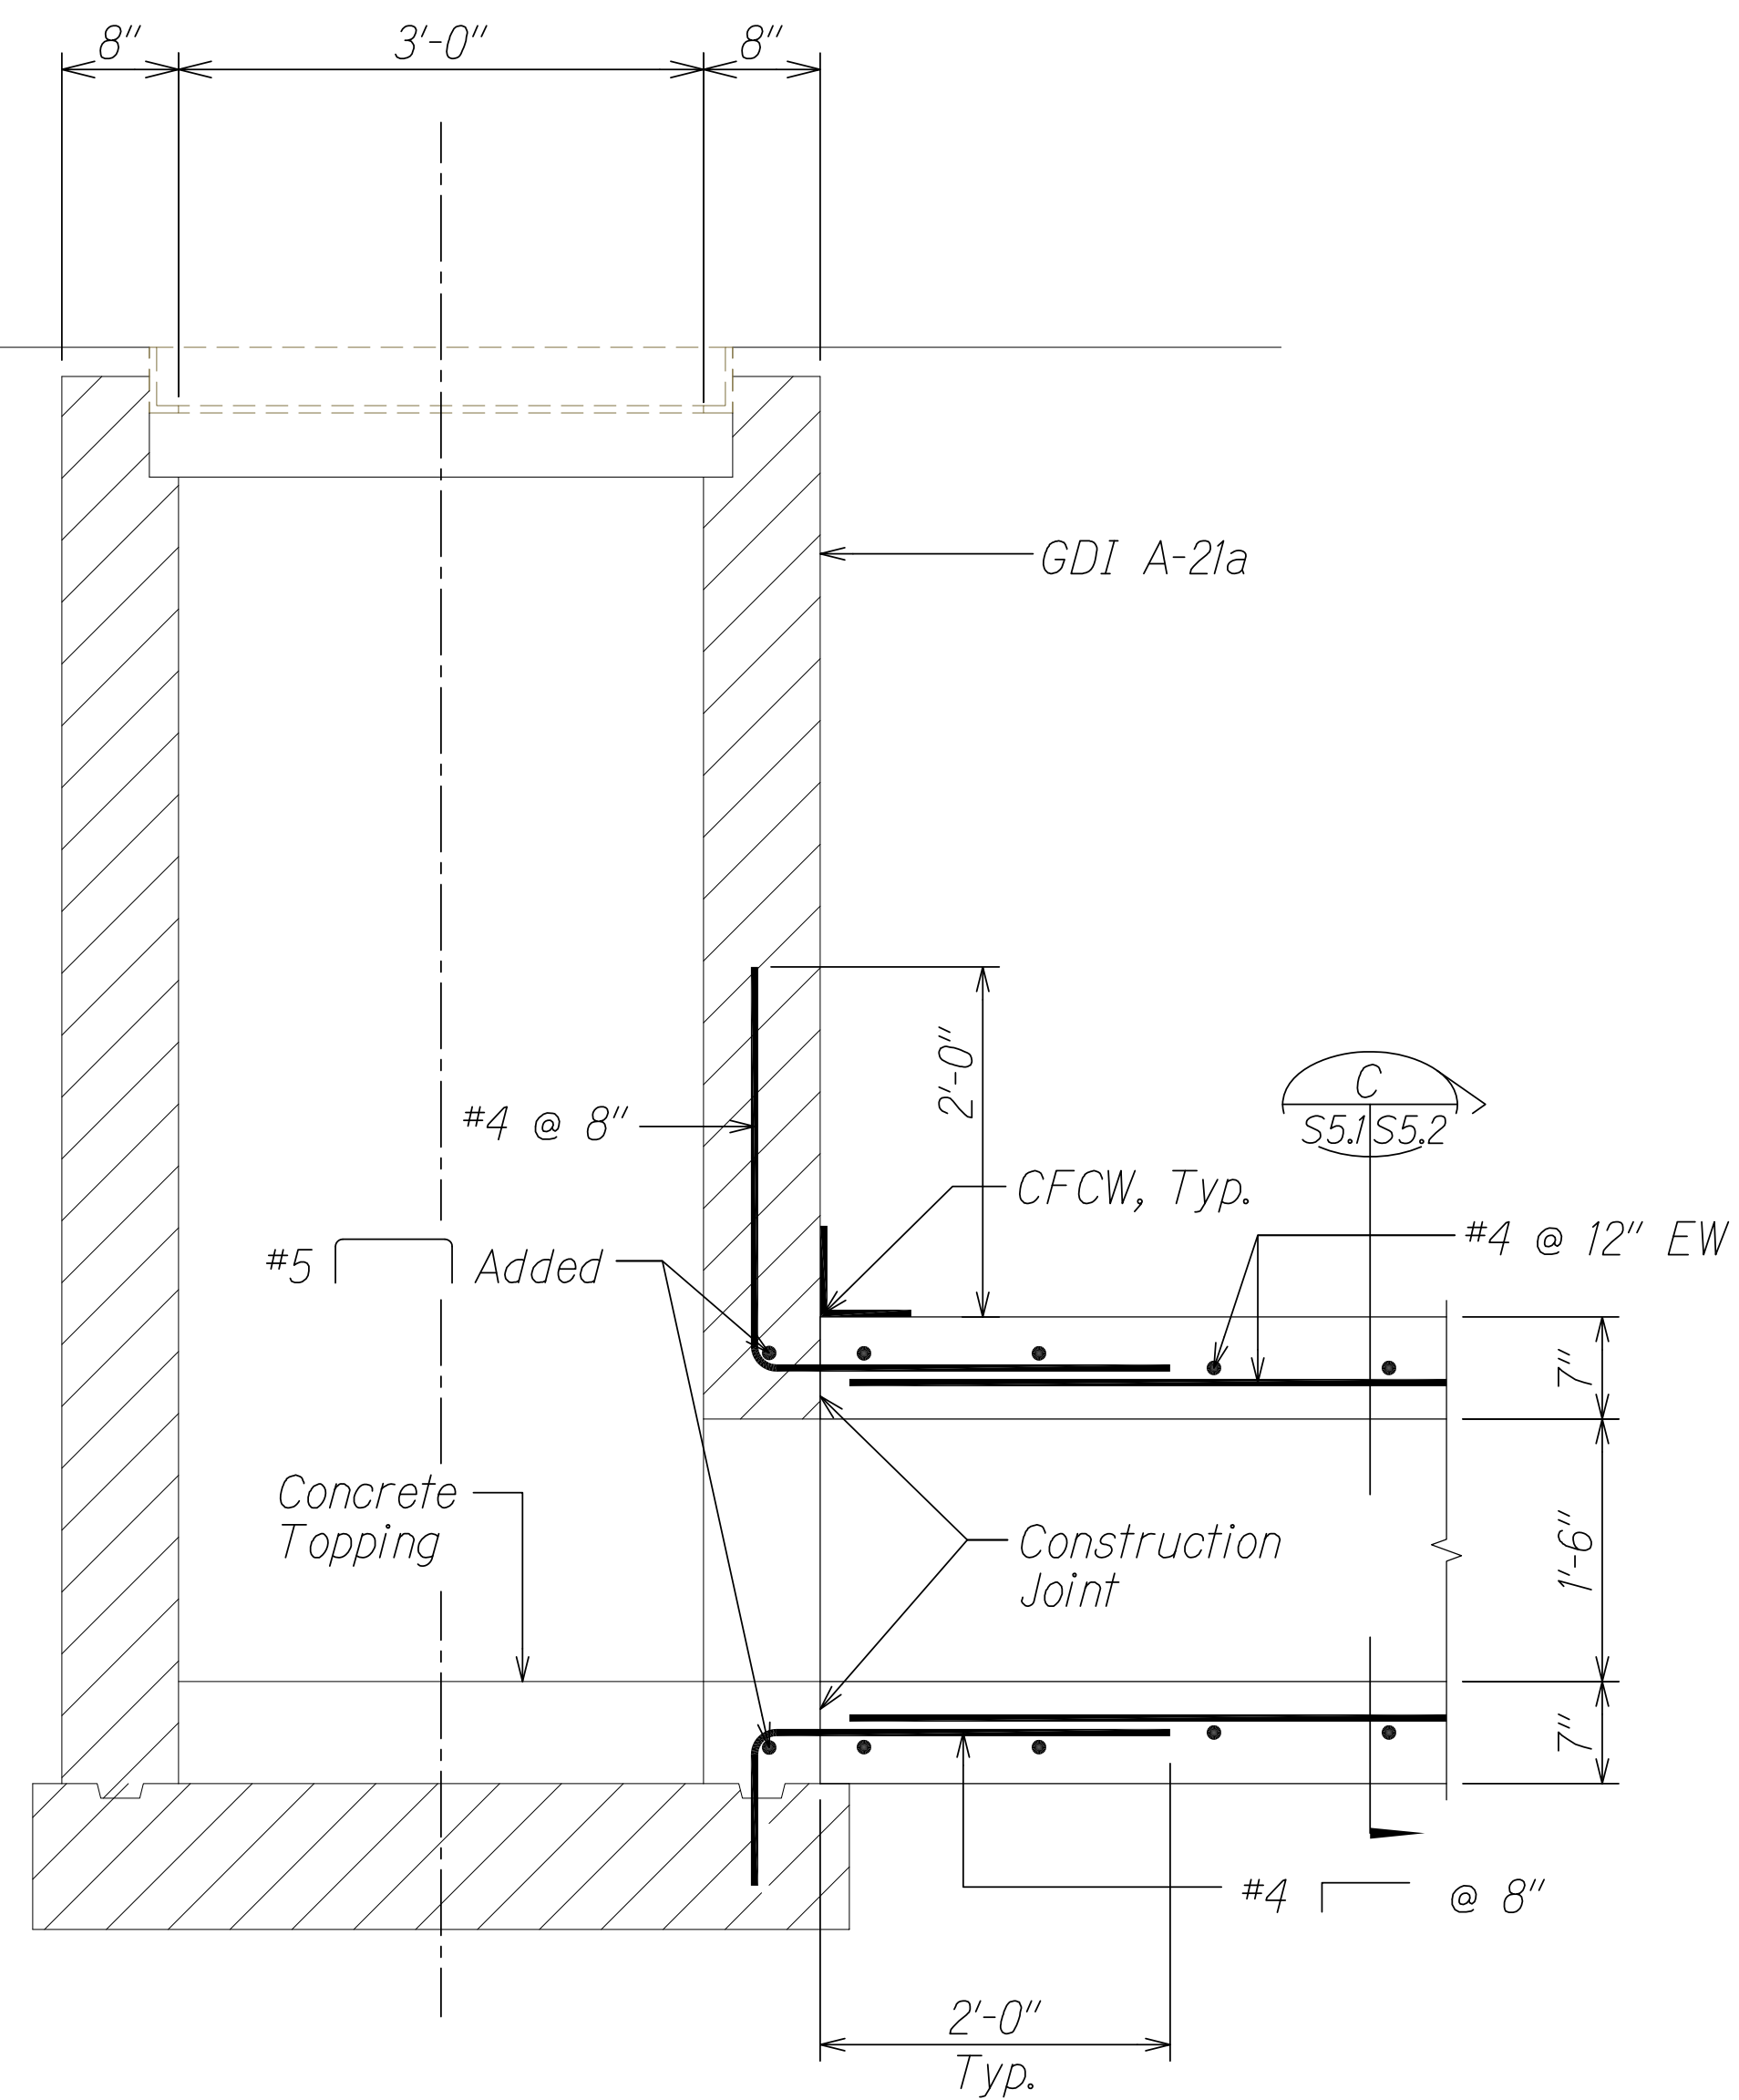

SECTION B  
Scale: 1" = 1'-0"

THIS WORK WAS PREPARED BY ME  
OR UNDER MY SUPERVISION.

KSF, INC. APRIL 30, 2016  
LIC. EXP. DATE

STATE OF HAWAII  
DEPARTMENT OF TRANSPORTATION  
HIGHWAYS DIVISION  
**PRECAST GDI A-21a**  
**ELEVATION AND SECTION**  
  
KAHULUI AIRPORT  
ACCESS ROAD, PHASE I  
Federal Aid Project No. NH-0380(10)  
Scale: As Shown Date: February 2013

11/24/14	-	New Sheet
DATE	REVISION	

SHEET No. S5.1 OF 24 SHEETS


"AS-BUILT"

C.O. 140S-4


AS-BUILT DRAWINGS




FED. ROAD DIST. NO.	STATE	FED. AID PROJ. NO.	FISCAL YEAR	SHEET NO.	TOTAL SHEETS
HAWAII	HAW.	NH-0380(10)	2013	C.O. 140S-5	166

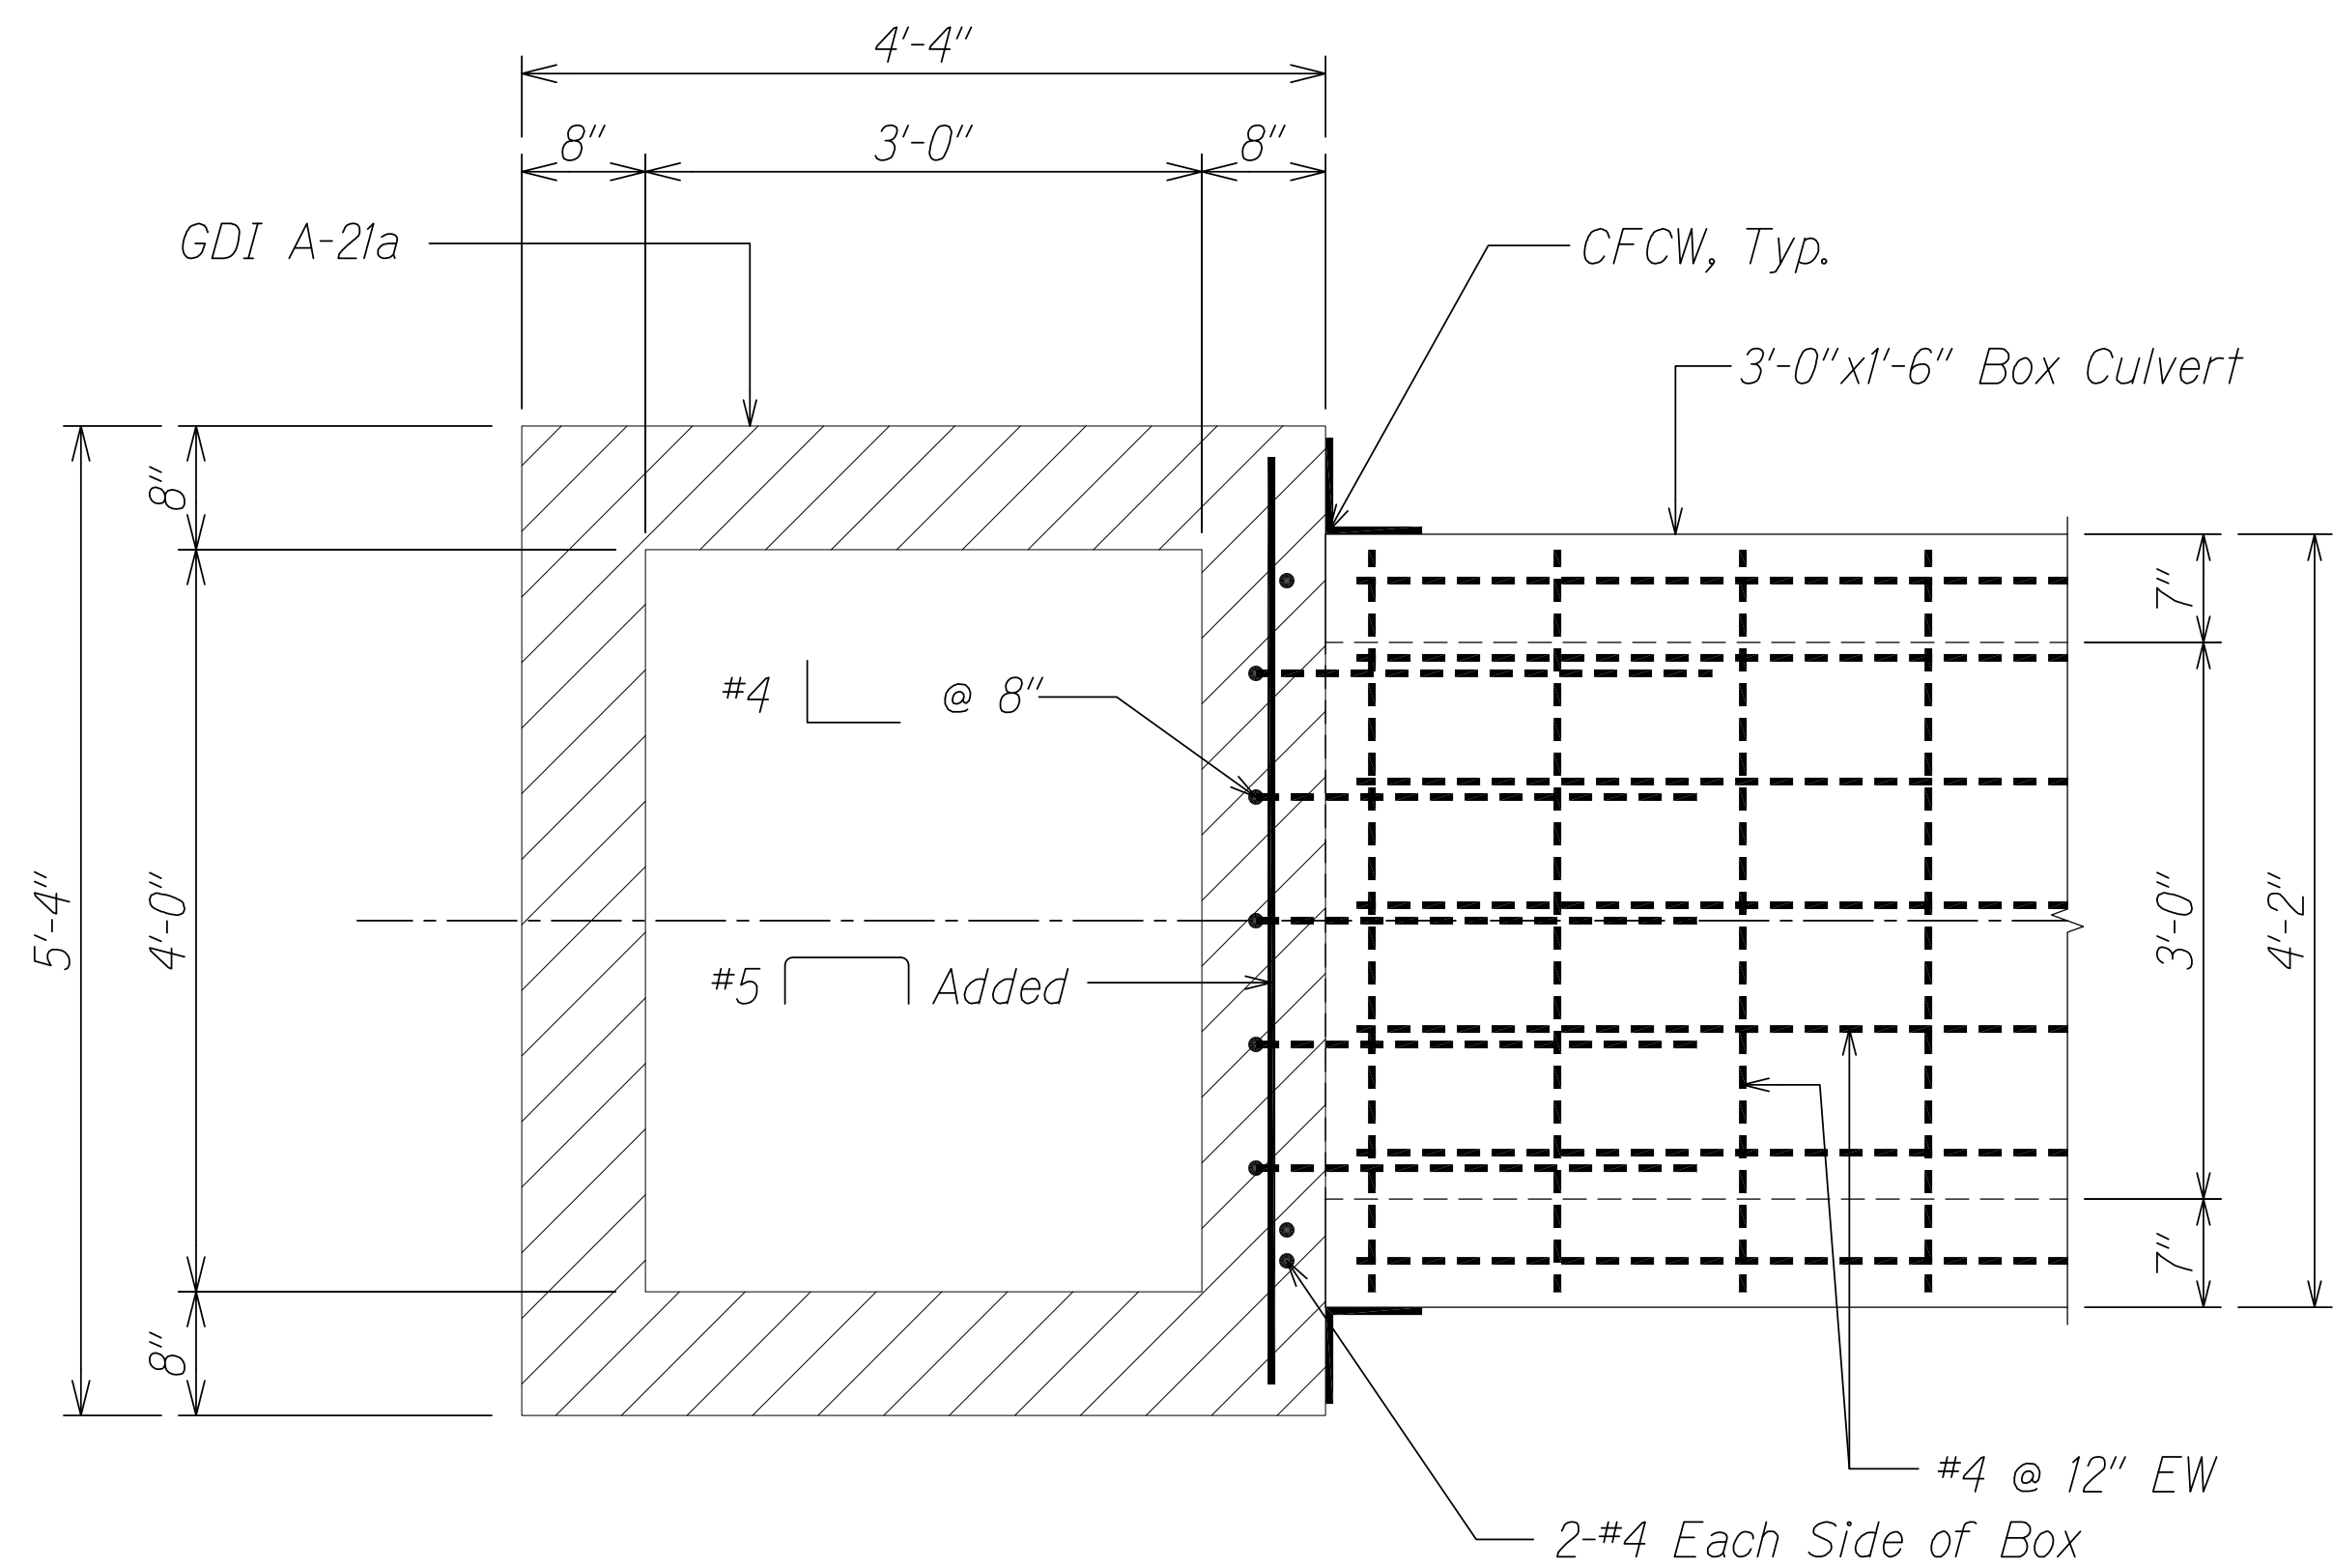

SECTION A  
Scale: 1" = 1'-0"

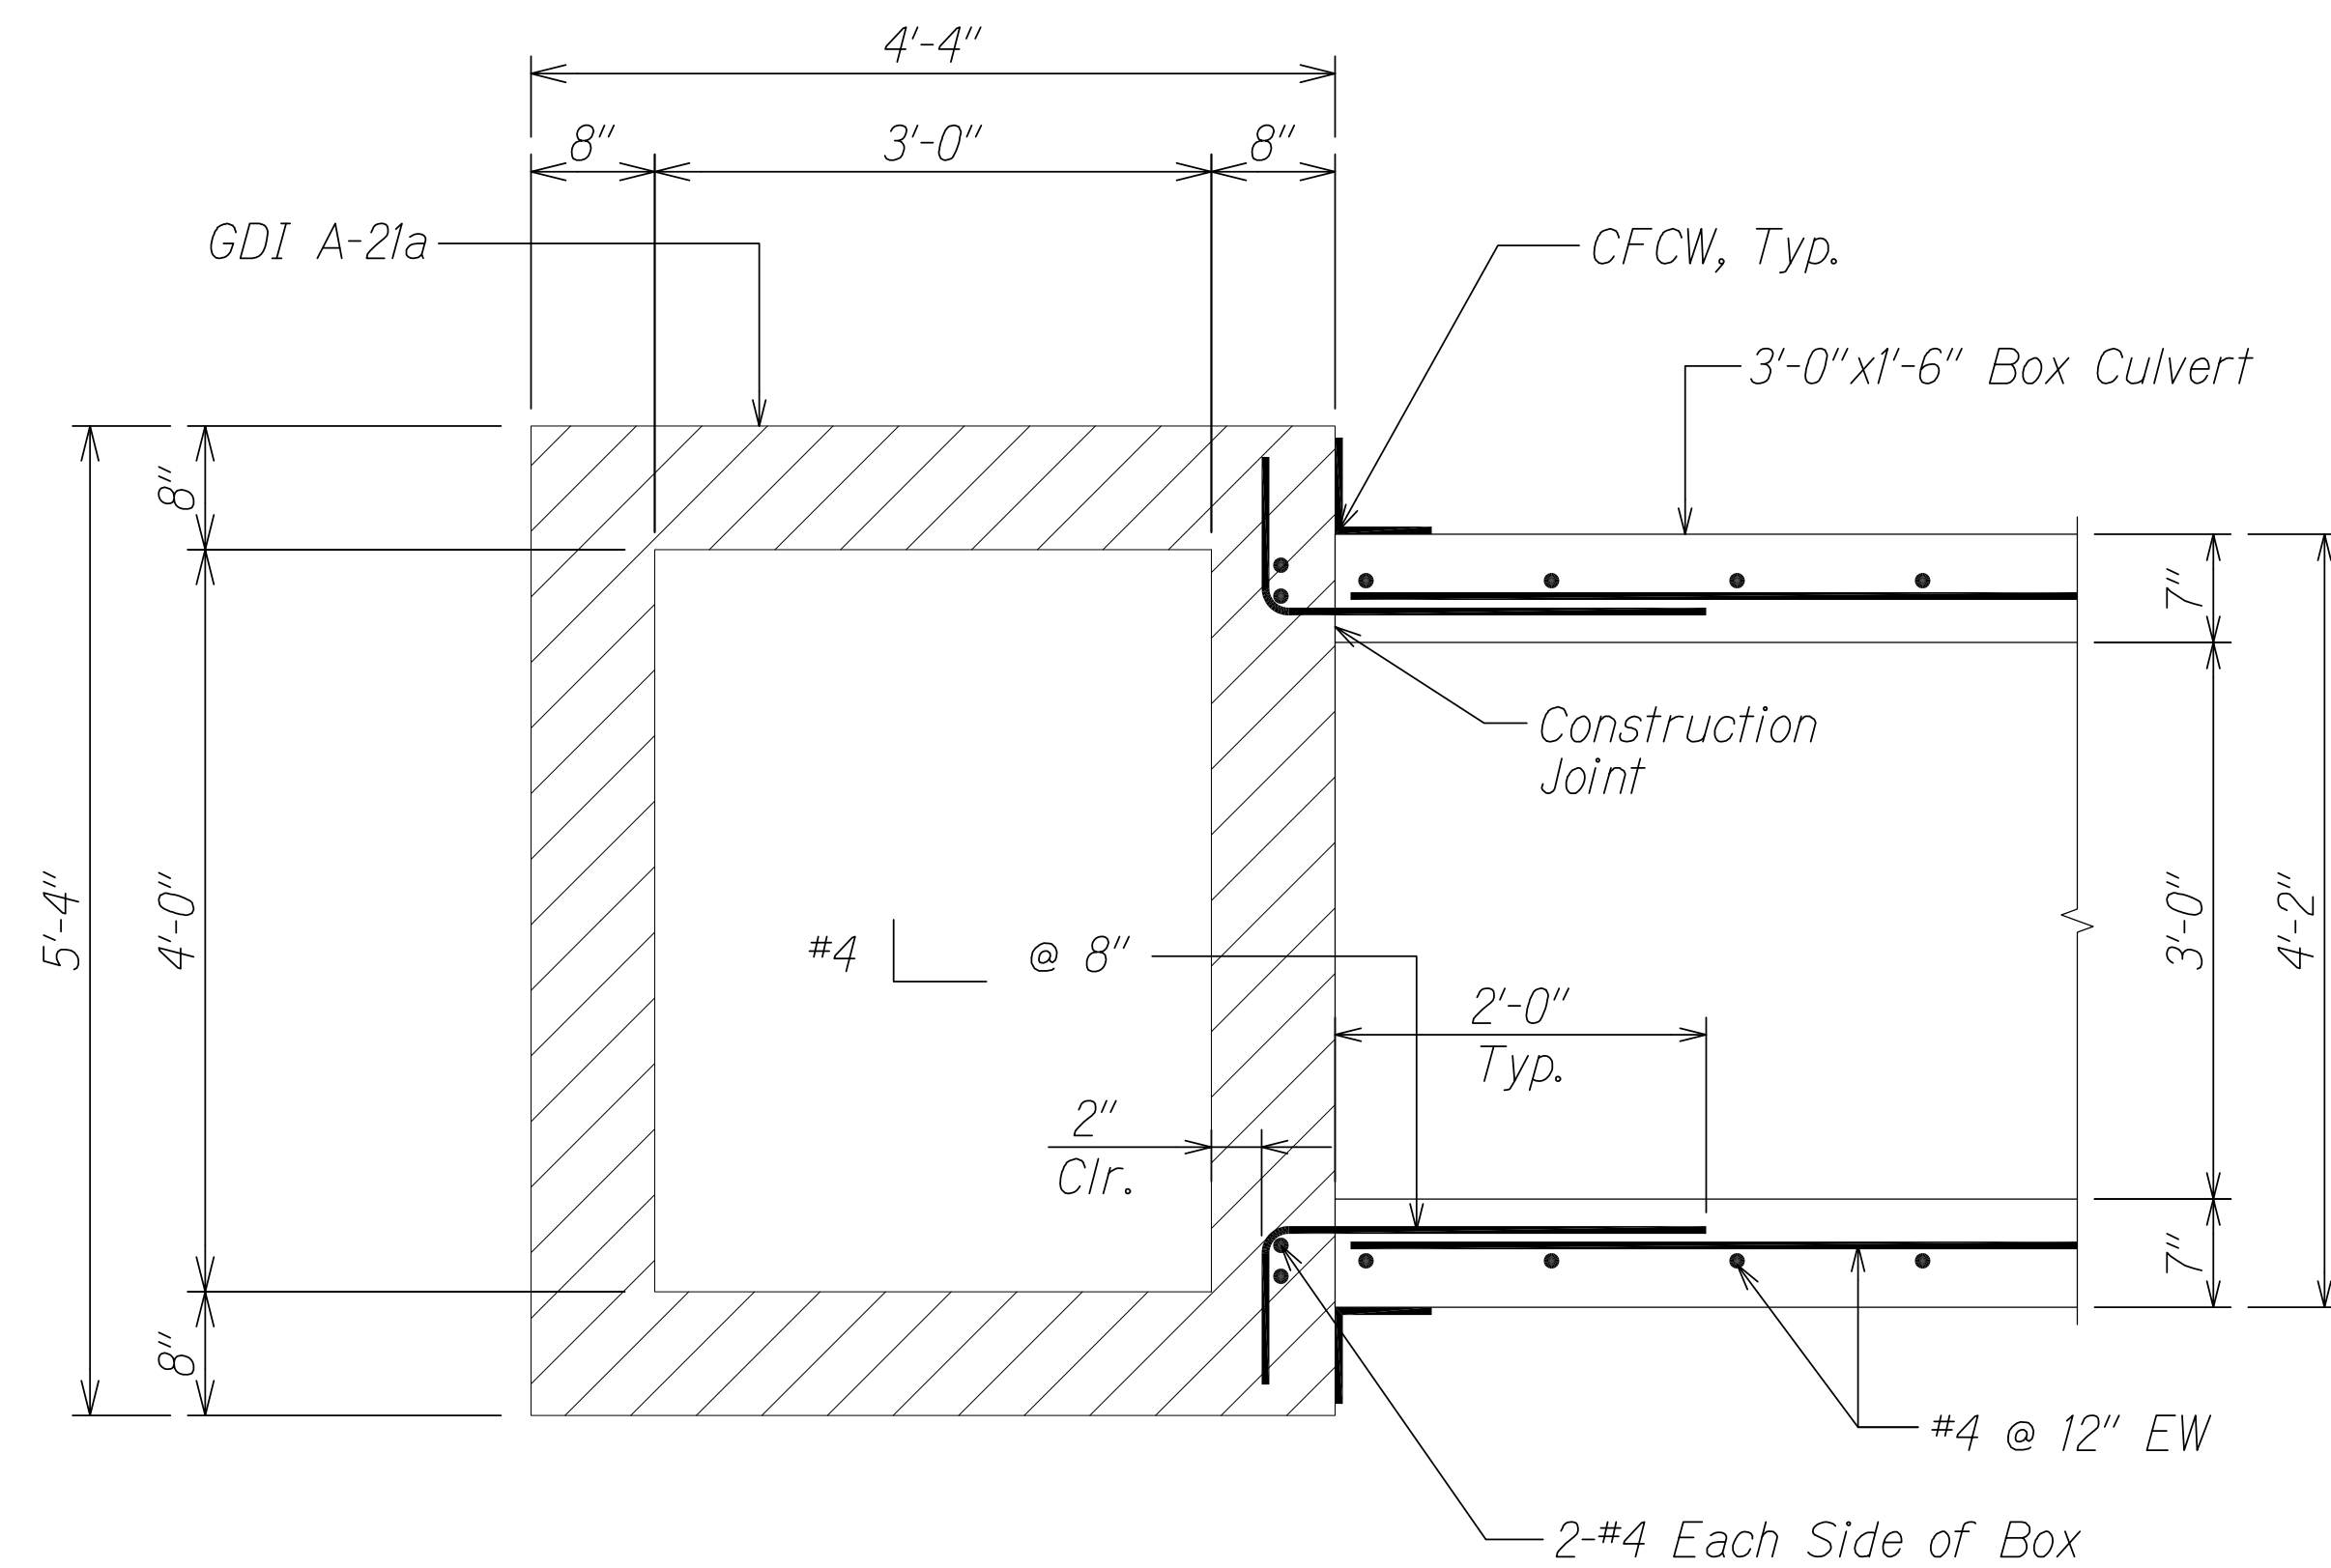

SECTION B  
Scale: 1" = 1'-0"

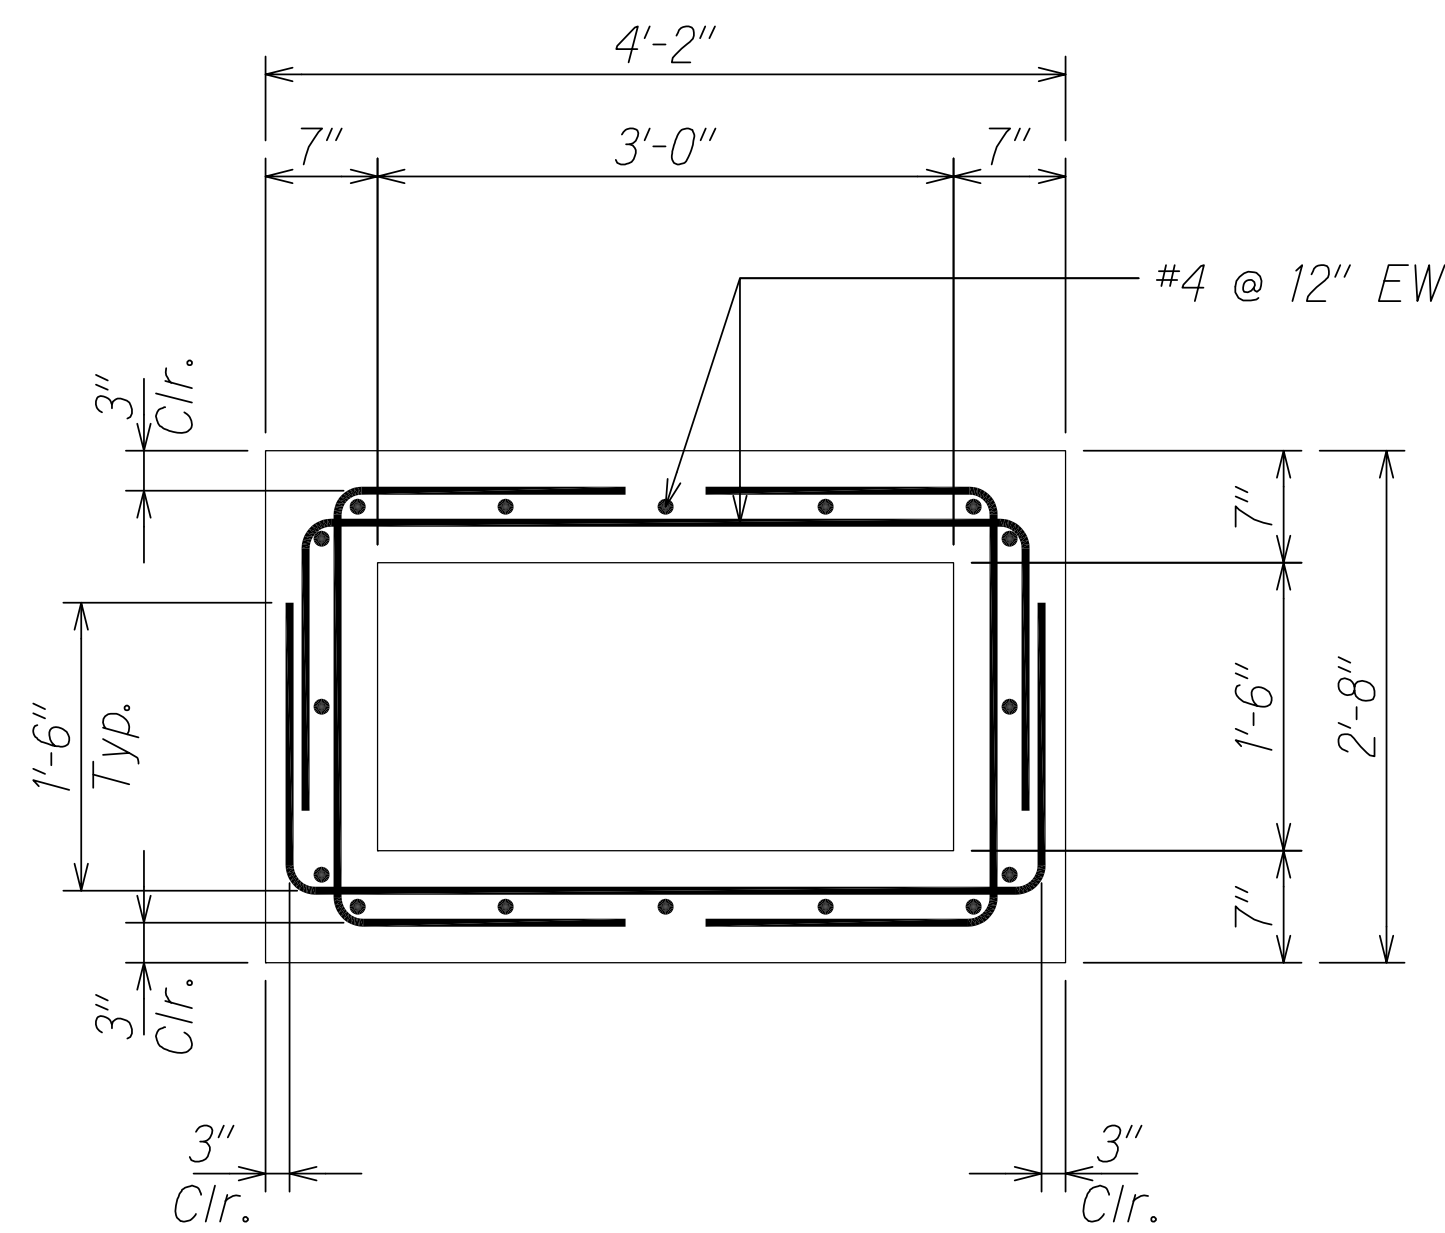

TYPICAL 3'-0"x1'-6" BOX CULVERT SECTION C  
Scale: 1" = 1'-0"

THIS WORK WAS PREPARED BY ME  
OR UNDER MY SUPERVISION.

KSF, INC. APRIL 30, 2016  
LIC. EXP. DATE

STATE OF HAWAII  
DEPARTMENT OF TRANSPORTATION  
HIGHWAYS DIVISION  
**PRECAST GDI A-21a**  
**SECTIONS**  
  
KAHULUI AIRPORT  
ACCESS ROAD, PHASE I  
Federal Aid Project No. NH-0380(10)  
Scale: As Shown Date: February 2013  
  
SHEET No. S5.2 OF 24 SHEETS

11/24/14	-	New Sheet
DATE		REVISION

"AS-BUILT"

C.O. 140S-5

AS-BUILT DRAWINGS