


FED. ROAD DIST. NO.	STATE	FED. AID PROJ. NO.	FISCAL YEAR	SHEET NO.	TOTAL SHEETS
HAWAII	HAW.	NH-0380(10)	2013	104	166

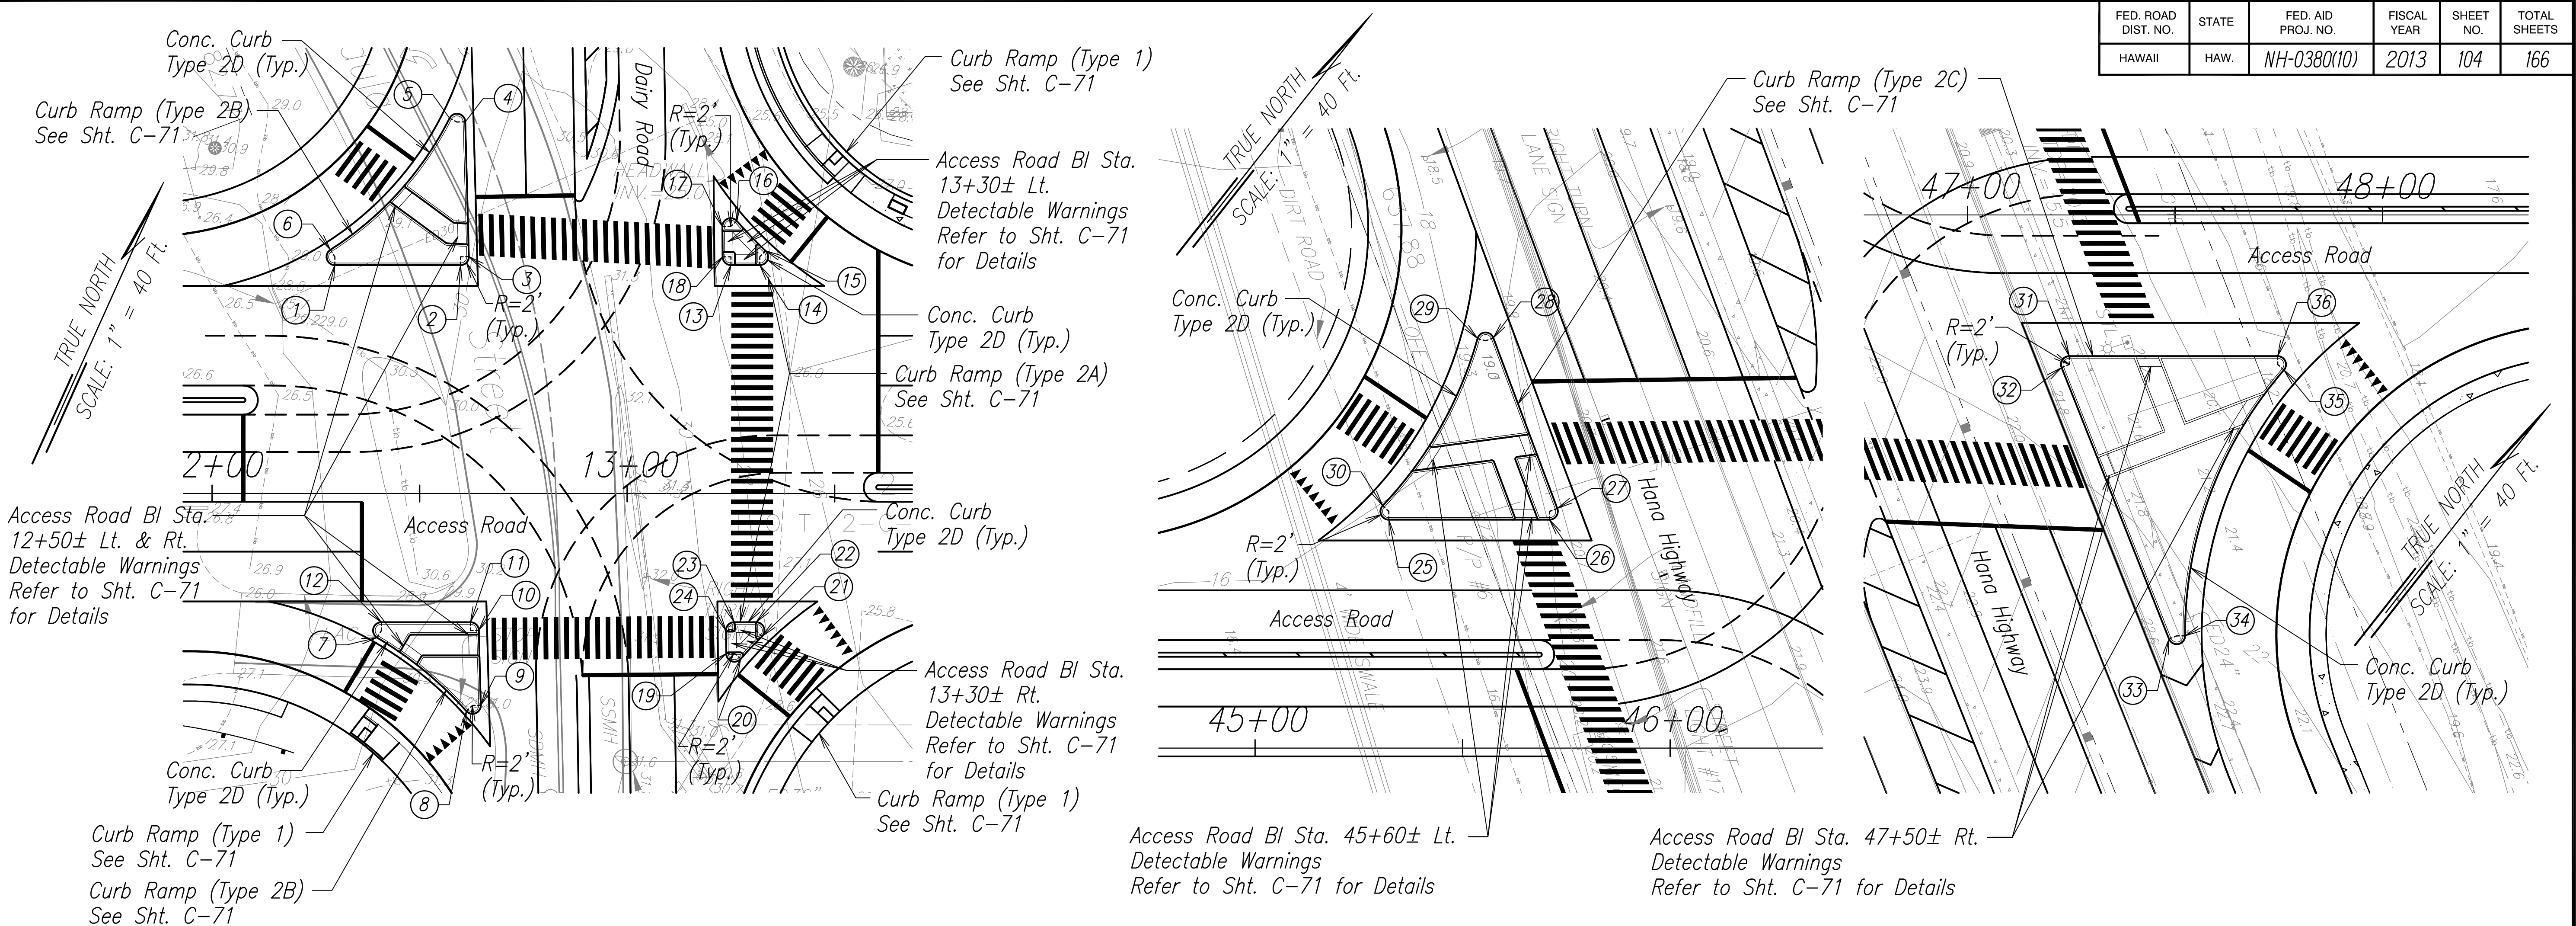

Access Road Baseline Station and Offset			Spot El. TC	Spot El. BC	Access Road Baseline Station and Offset			Spot El. TC	Spot El. BC
1	Bl Sta. 12+29.57 o/s 55.00' Lt.		32.80	32.30	13	Bl Sta. 13+25.00 o/s 55.00' Lt.		30.76	30.26
2	Bl Sta. 12+59.86 o/s 55.00' Lt.		32.20	31.70	14	Bl Sta. 13+31.95 o/s 55.00' Lt.		30.64	30.14
3	Bl Sta. 12+61.86 o/s 57.05' Lt.		32.18	31.68	15	Bl Sta. 13+36.62 o/s 55.53' Lt.		30.58	30.08
4	Bl Sta. 12+61 o/s 89.51' Lt.		31.76	31.26	16	Bl Sta. 13+26.45 o/s 65.51' Lt.		30.62	30.12
5	Bl Sta. 12+57.21 o/s 90.36' Lt.		31.83	31.33	17	Bl Sta. 13+22.94 o/s 64.28' Lt.		30.69	30.19
6	Bl Sta. 12+28.50 o/s 58.69' Lt.		32.83	32.33	18	Bl Sta. 13+23.00 o/s 56.98' Lt.		30.77	30.27
7	Bl Sta. 12+39.77 o/s 34.72' Rt.		31.59	31.09	19	Bl Sta. 13+23.86 o/s 38.53' Rt.		31.23	30.73
8	Bl Sta. 12+61.23 o/s 50.78' Rt.		31.29	30.79	20	Bl Sta. 13+27.36 o/s 39.83' Rt.		31.16	30.66
9	Bl Sta. 12+64.69 o/s 49.36' Rt.		31.33	30.83	21	Bl Sta. 13+32.47 o/s 34.43' Rt.		31.08	30.58
10	Bl Sta. 12+64.26 o/s 32.95' Rt.		31.42	30.92	22	Bl Sta. 13+31.08 o/s 31.00' Rt.		31.14	30.64
11	Bl Sta. 12+62.26 o/s 31.00' Rt.		31.48	30.98	23	Bl Sta. 13+25.81 o/s 31.00' Rt.		31.21	30.71
12	Bl Sta. 12+40.79 o/s 31.00' Rt.		31.66	31.16	24	Bl Sta. 13+23.81 o/s 33.02' Rt.		31.25	30.75

DAIRY ROAD TRAFFIC ISLAND SITE PLAN
SCALE: 1"=20'

Access Road Baseline Station and Offset			Spot El. TC	Spot El. BC
25	Bl Sta. 45+32.22 o/s 55.00' Lt.		21.15	20.65
26	Bl Sta. 45+70.96 o/s 55.00' Lt.		21.25	20.75
27	Bl Sta. 45+72.83 o/s 57.71' Lt.		21.24	20.74
28	Bl Sta. 45+56.94 o/s 98.61' Lt.		20.49	19.99
29	Bl Sta. 45+53.61 o/s 98.63' Lt.		20.43	19.93
30	Bl Sta. 45+30.76 o/s 58.37' Lt.		21.14	20.64
31	Bl Sta. 47+24.52 o/s 34.00' Rt.		22.07	21.57
32	Bl Sta. 47+22.66 o/s 36.74 Rt.		22.15	21.65
33	Bl Sta. 47+48.56 o/s 102.10' Rt.		23.25	22.75
34	Bl Sta. 47+52.42 o/s 101.36' Rt.		23.18	22.68
35	Bl Sta. 47+76.25 o/s 37.31' Rt.		22.17	21.67
36	Bl Sta. 47+74.75 o/s 34.00' Rt.		22.18	21.68

HANA HIGHWAY TRAFFIC ISLAND SITE PLAN
SCALE: 1"=20'

STATE OF HAWAII
DEPARTMENT OF TRANSPORTATION
HIGHWAYS DIVISION

DAIRY ROAD & HANA HIGHWAY
TRAFFIC ISLAND
SITE PLAN
KAHULUI AIRPORT
ACCESS ROAD, PHASE I
Federal Aid Project No. NH-0380(10)
Scale: As Shown Date: February 2013

SHEET No. C-91 OF 93 SHEETS

ORIGINAL PLAN	SURVEY PLOTTED BY	DATE
NOTE BOOK	DRAWN BY	
.....	DESIGNED BY	
.....	QUANTITIES BY	
.....	CHECKED BY	

DRAWING NAME: C:\PROJECTS\KAHULUI-2011\AS-BUILT OCTOBER 2017\CIVIL\G-91.DWG PLOT TIME: 10-29-18 9:20 AM

"AS-BUILT"

AS-BUILT DRAWINGS