


| FED. ROAD DIST. NO. | STATE | FED. AID PROJ. NO. | FISCAL YEAR | SHEET NO. | TOTAL SHEETS |
|---------------------|-------|--------------------|-------------|-----------|--------------|
| HAWAII              | HAW.  | NH-0380(10)        | 2013        | ADD. 88   | 166          |

DRAWING NAME: C:\PROJECTS\KAHULUI-2011\AS-BUILT OCTOBER 2017\CIVIL-C-75.DWG PLOT TIME: 10-25-18, 5:04 PM

|               |                   |      |
|---------------|-------------------|------|
| ORIGINAL PLAN | SURVEY PLOTTED BY | DATE |
| NOTE BOOK     | DRAWN BY          |      |
| QUANTITIES BY | DESIGNED BY       |      |
| NO.           | CHECKED BY        |      |

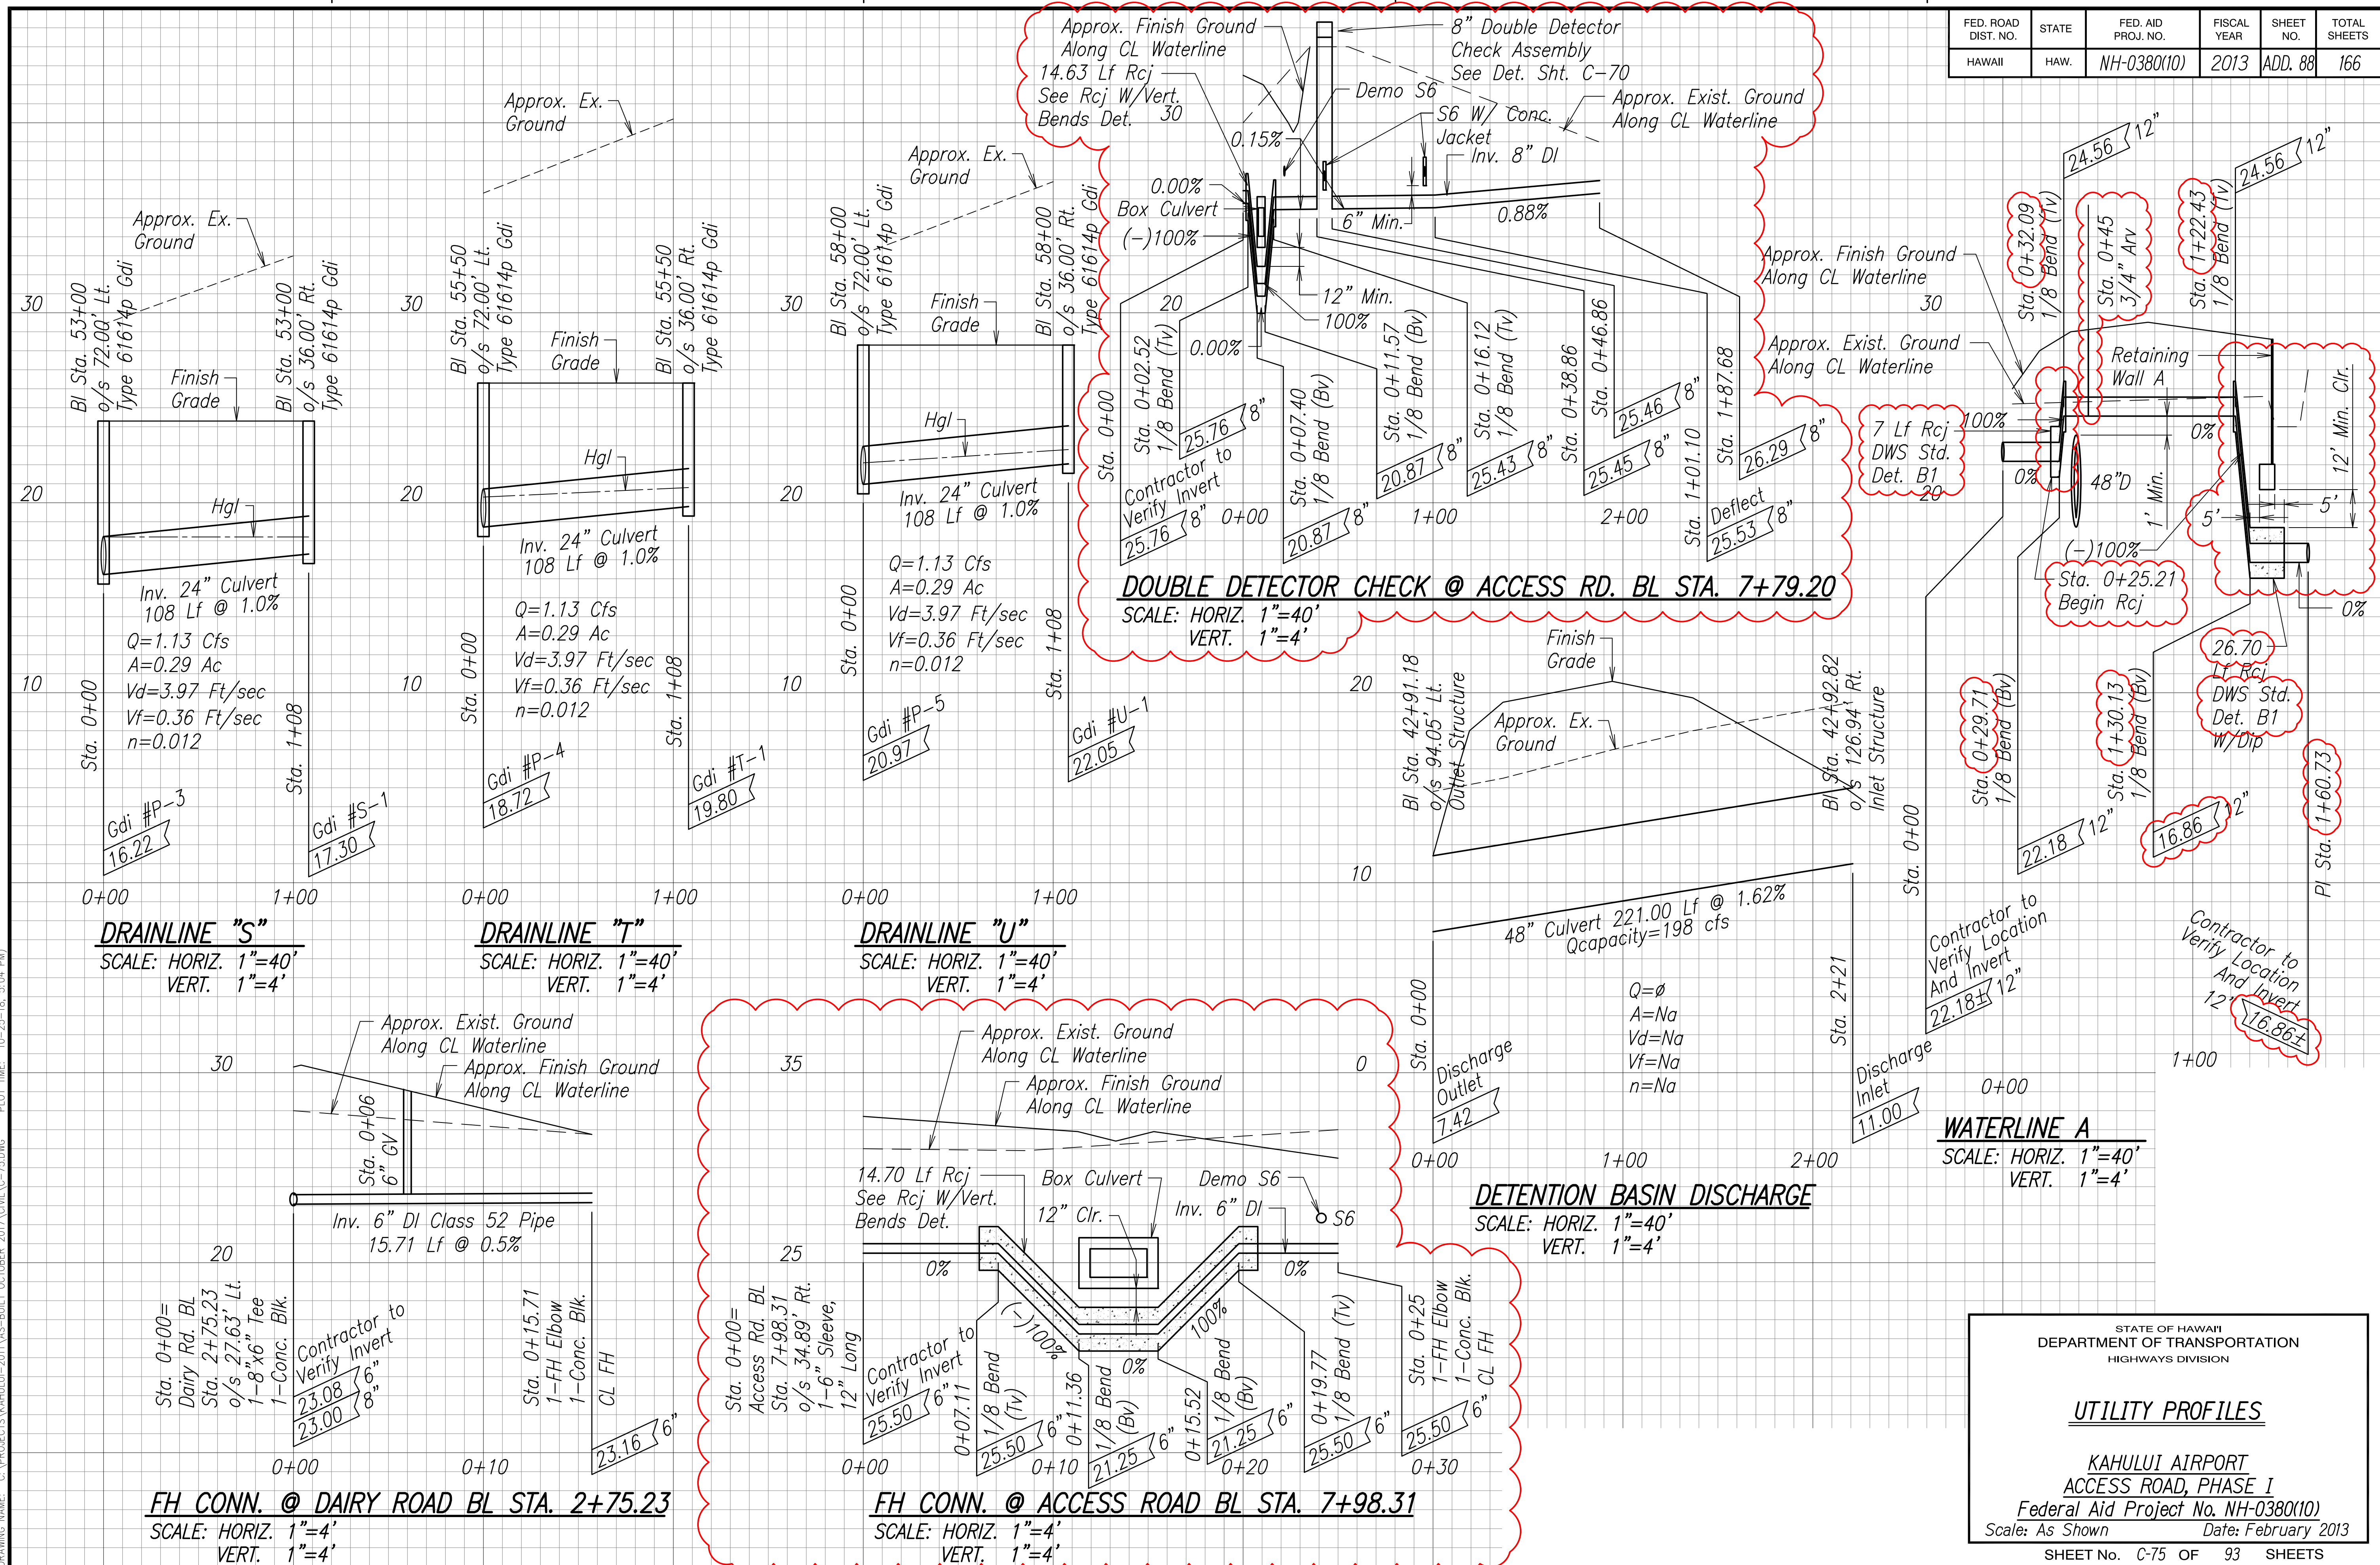

"AS-BUILT"

ADD. 88

AS-BUILT DRAWINGS