



| FED. ROAD DIST. NO. | STATE | FED. AID PROJ. NO. | FISCAL YEAR | SHEET NO. | TOTAL SHEETS |
|---------------------|-------|--------------------|-------------|-----------|--------------|
| HAWAII              | HAW.  |                    |             |           |              |

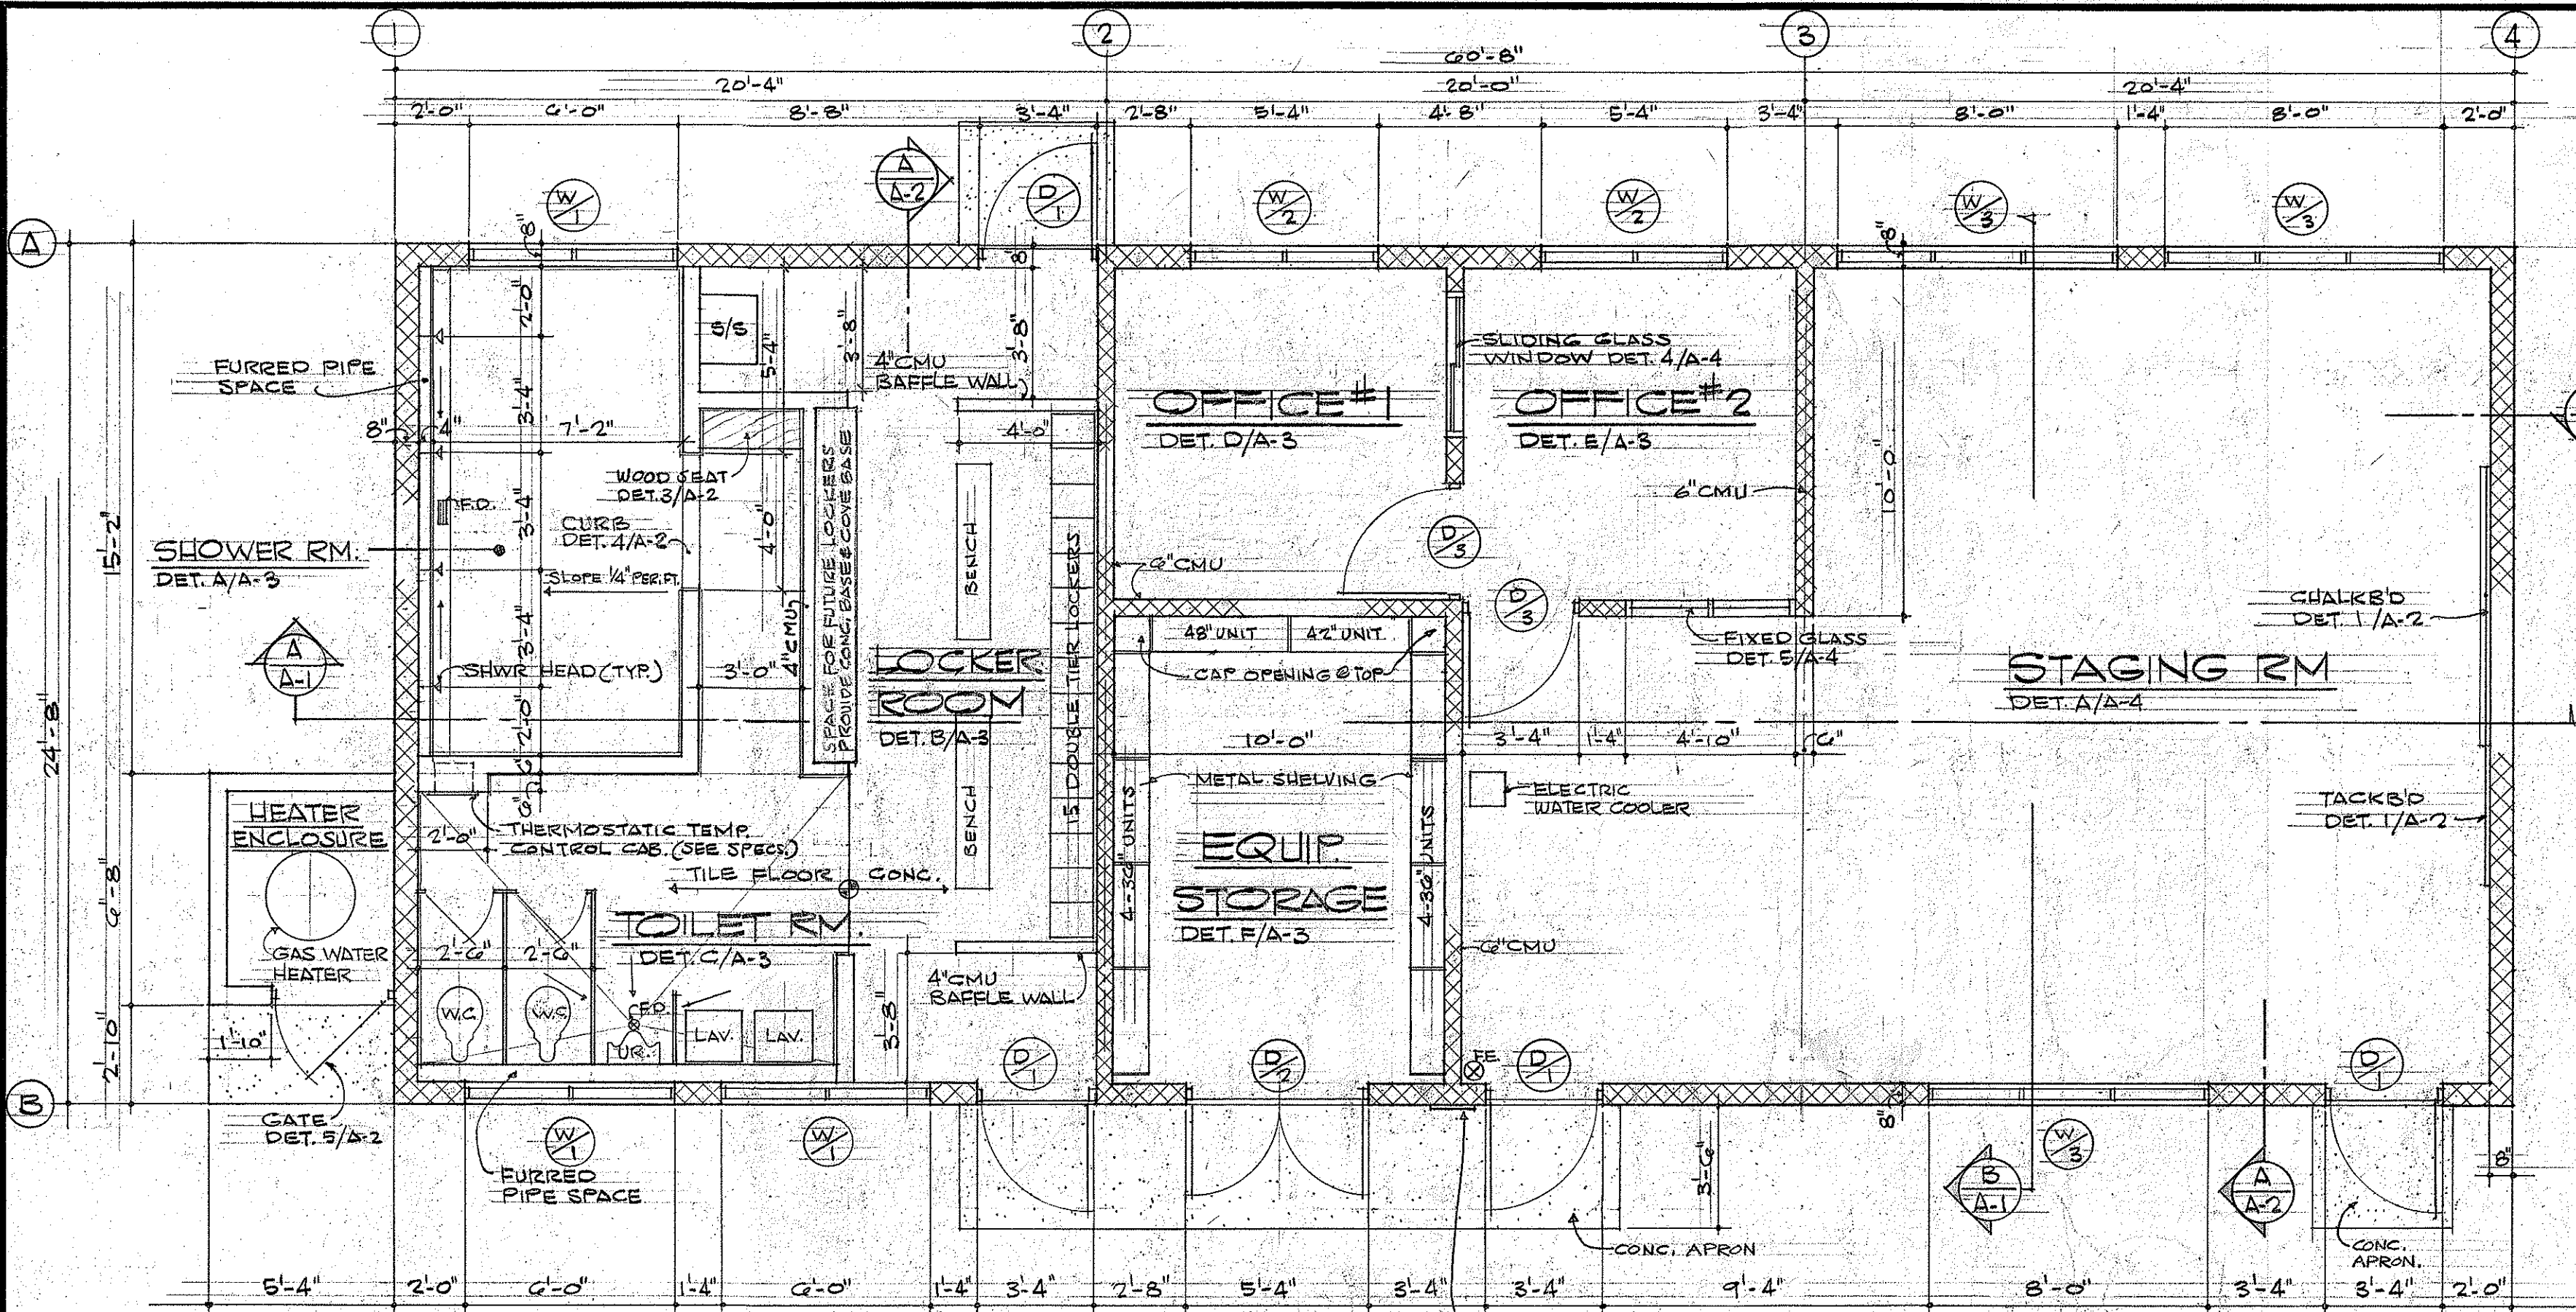

FLOOR PLAN

SCALE: 1/4"=1'-0"

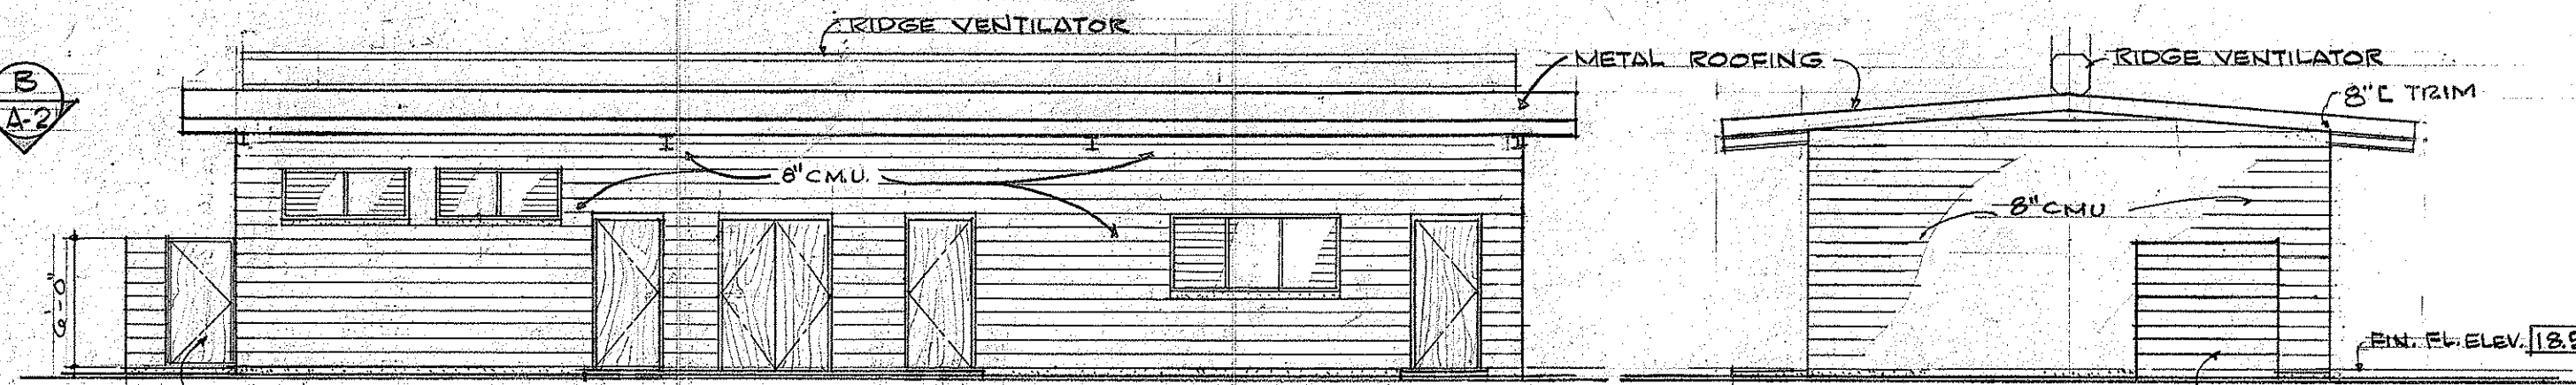


FRONT ELEVATION

SCALE: 1/8"=1'-0"

SIDE ELEV.

SCALE: 1/8"=1'-0"

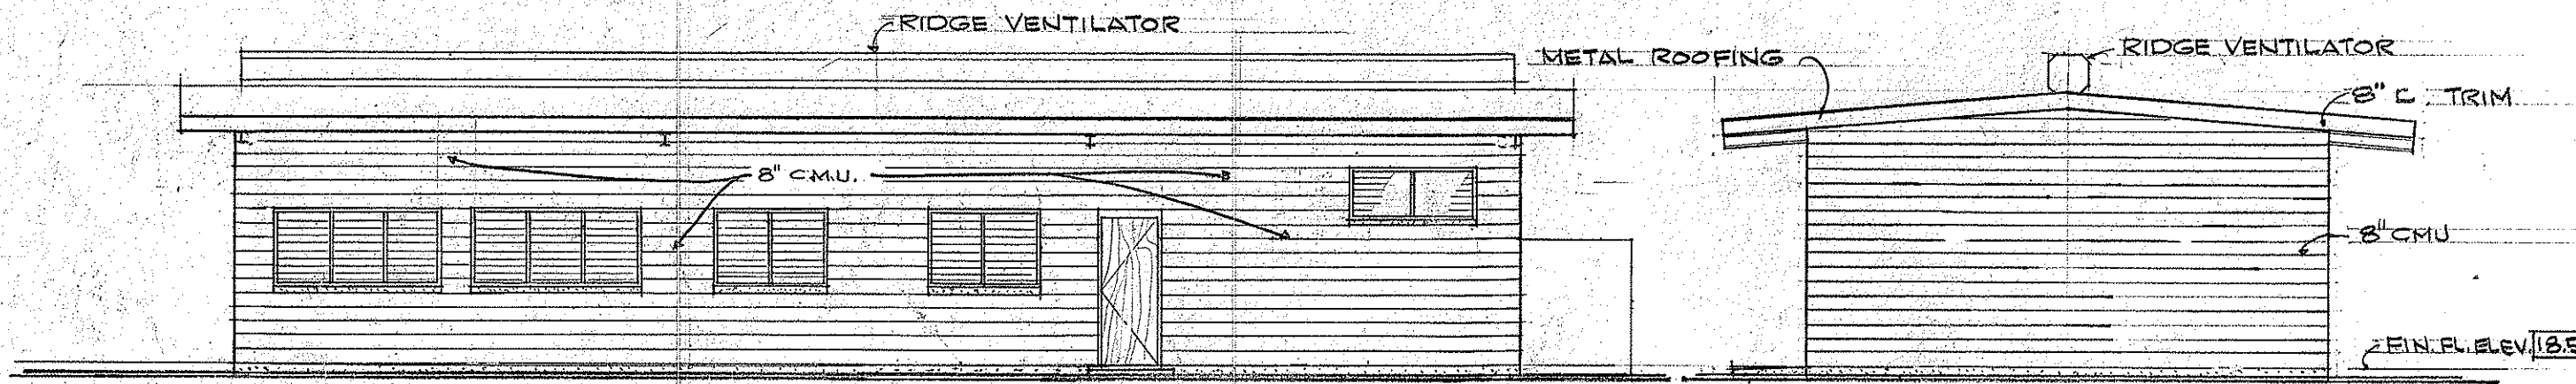


BACK ELEVATION

SCALE: 1/8"=1'-0"


SIDE ELEV.

SCALE: 1/8"=1'-0"

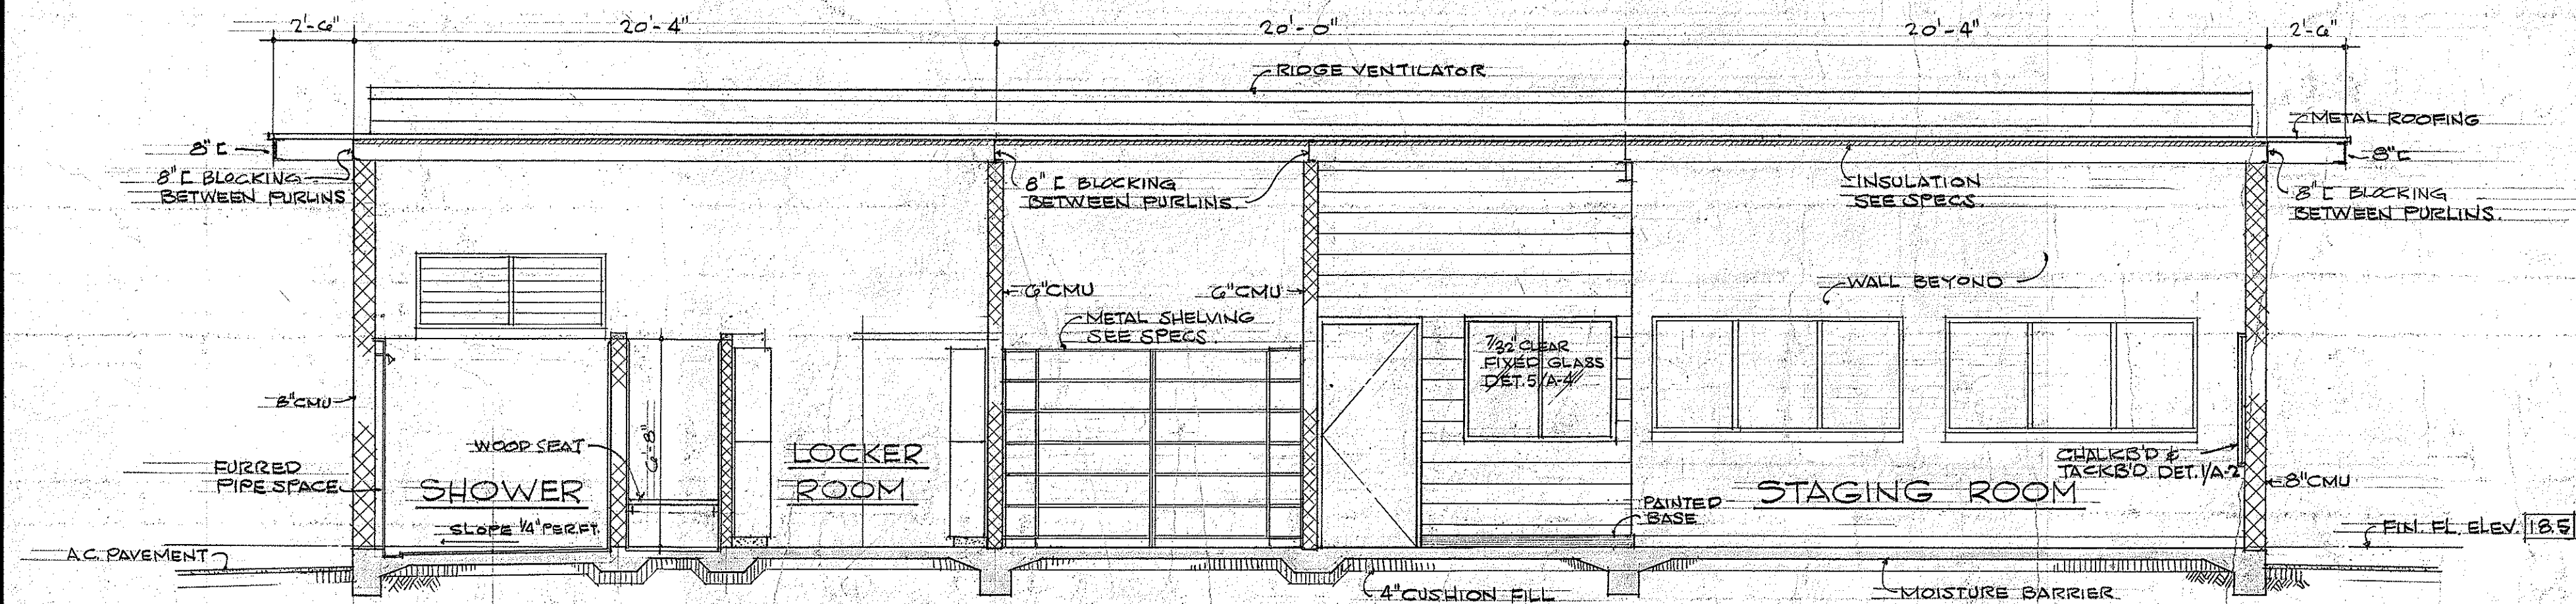

LONGITUDINAL SECTION

SCALE: 1/4"=1'-0"

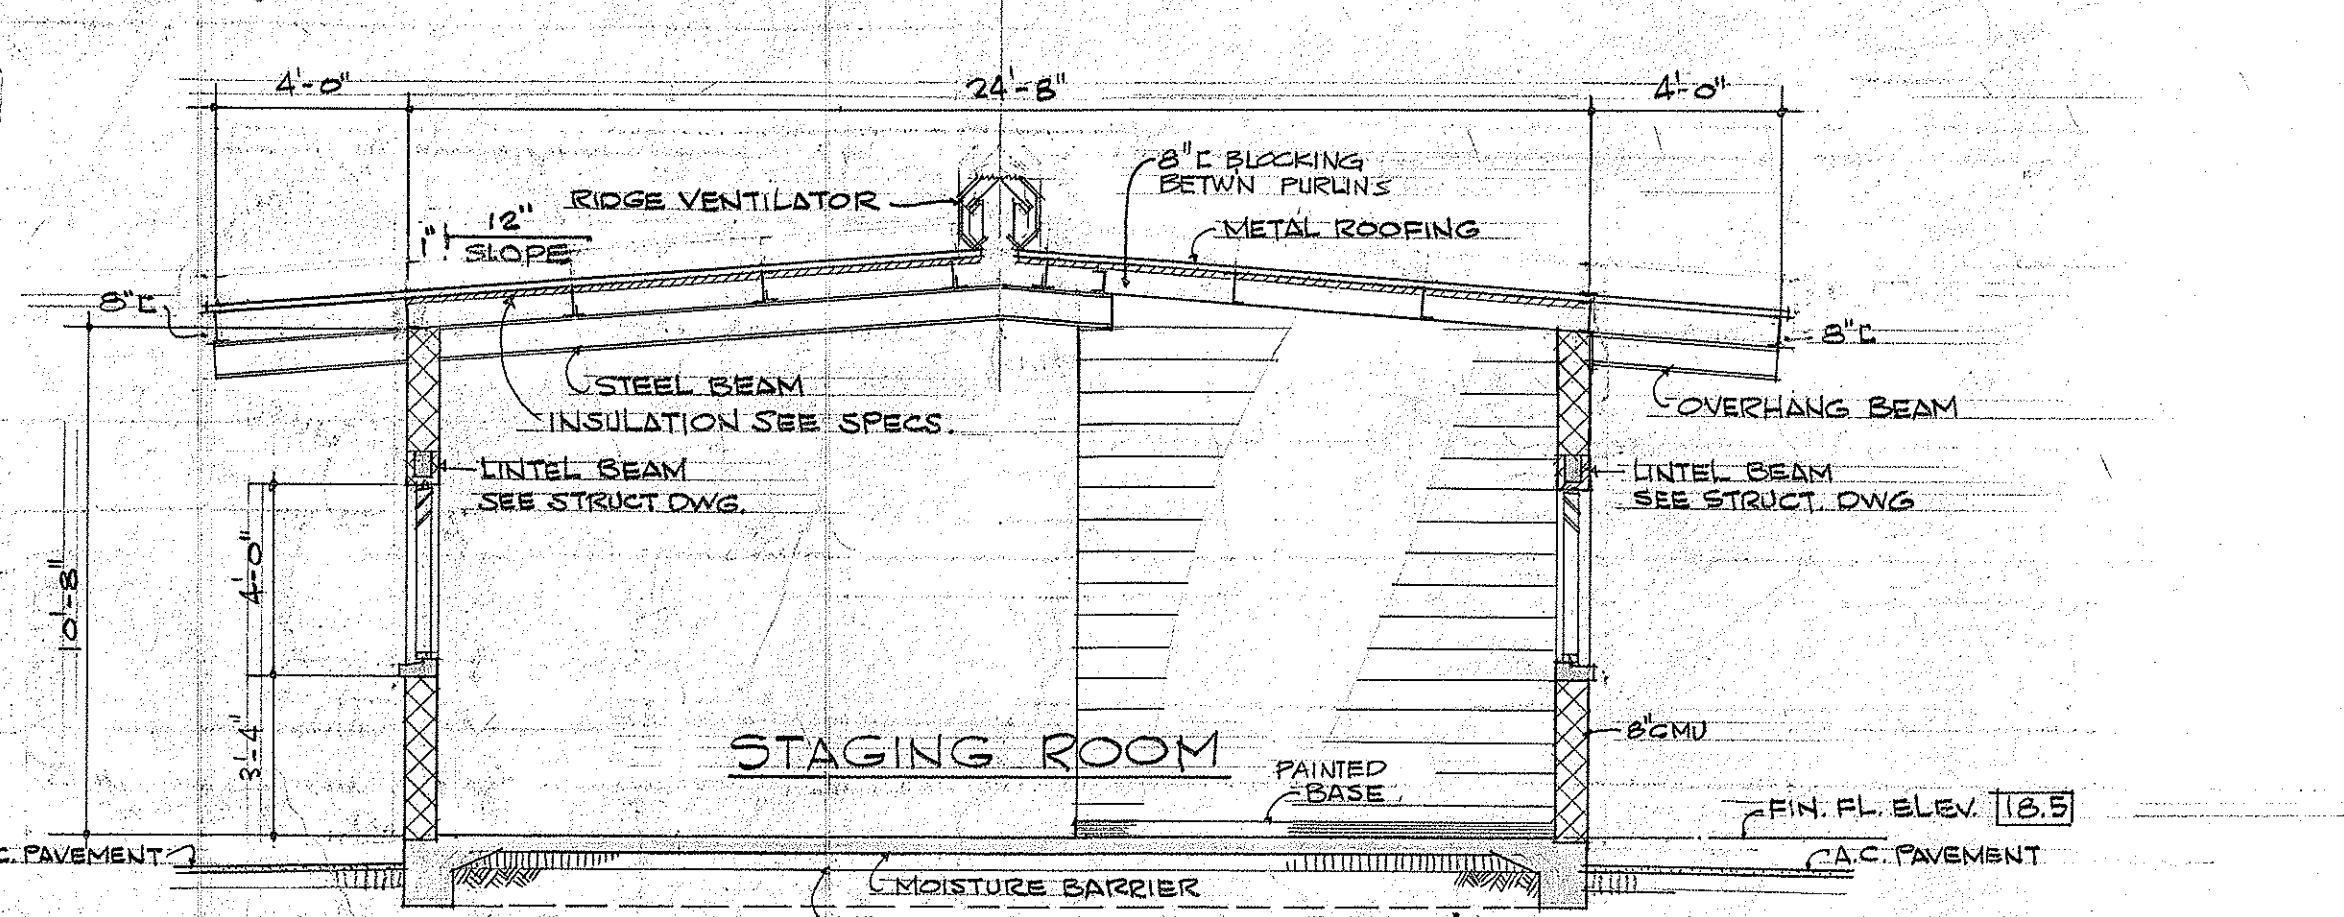

CROSS SECTION

SCALE: 1/4"=1'-0"

ROOM FINISH SCHEDULE

| ROOM NAME         | FLOOR | BASE | WALL | CEILING | ROOF | INSULATION | NO. REQ'D | LETTERS | REMARKS |
|-------------------|-------|------|------|---------|------|------------|-----------|---------|---------|
| SHOWER            | 0     | 0    | 0    | 0       | 0    | 0          | 0         |         |         |
| TOILET ROOM       | 0     | 0    | 0    | 0       | 0    | 0          | 0         |         |         |
| LOCKER ROOM       | 0     | 0    | 0    | 0       | 0    | 0          | 0         |         |         |
| OFFICE #1         | 0     | 0    | 0    | 0       | 0    | 0          | 0         |         |         |
| OFFICE #2         | 0     | 0    | 0    | 0       | 0    | 0          | 0         |         |         |
| EQUIPMENT STORAGE | 0     | 0    | 0    | 0       | 0    | 0          | 0         |         |         |
| STAGING ROOM      | 0     | 0    | 0    | 0       | 0    | 0          | 0         |         |         |



THIS WORK WAS PREPARED BY  
ME OR UNDER MY SUPERVISION.

Herbert Y. Matsumura

STATE OF HAWAII  
DEPARTMENT OF TRANSPORTATION  
HIGHWAYS DIVISION

PEARL CITY BASEYARD  
PEARL CITY OAHU, HAWAII











FLOOR PLAN, EXT. ELEVATIONS  
SECTIONS, & ROOM FINISH SCHED.

HERBERT Y. MATSUMURA & ASSOC., INC.  
871 KAPIOLANI BLVD. HONOLULU, HAWAII

SHEET No. A-1 OF 11 SHEETS



| FED. ROAD DIST. NO. | STATE | FED. AID PROJ. NO. | FISCAL YEAR | SHEET NO. | TOTAL SHEETS |
|---------------------|-------|--------------------|-------------|-----------|--------------|
| HAWAII              | HAW.  |                    |             |           |              |

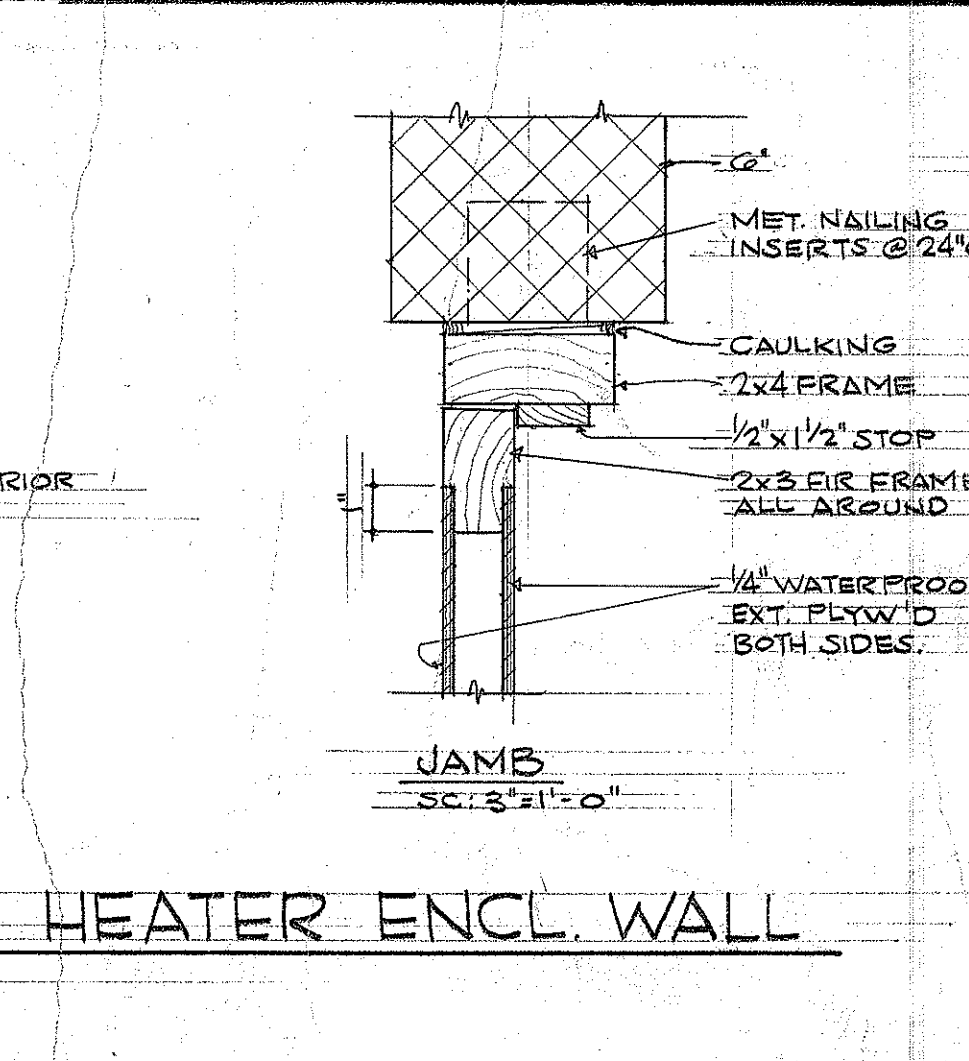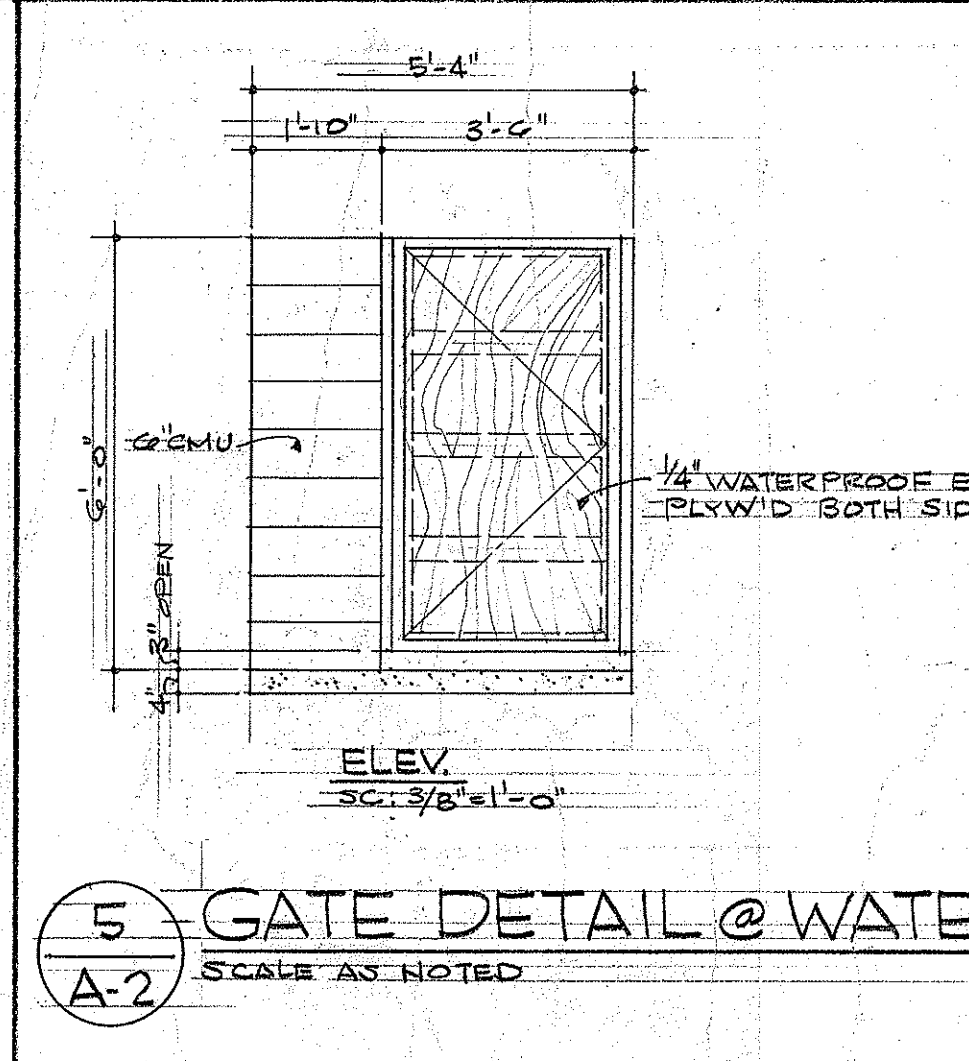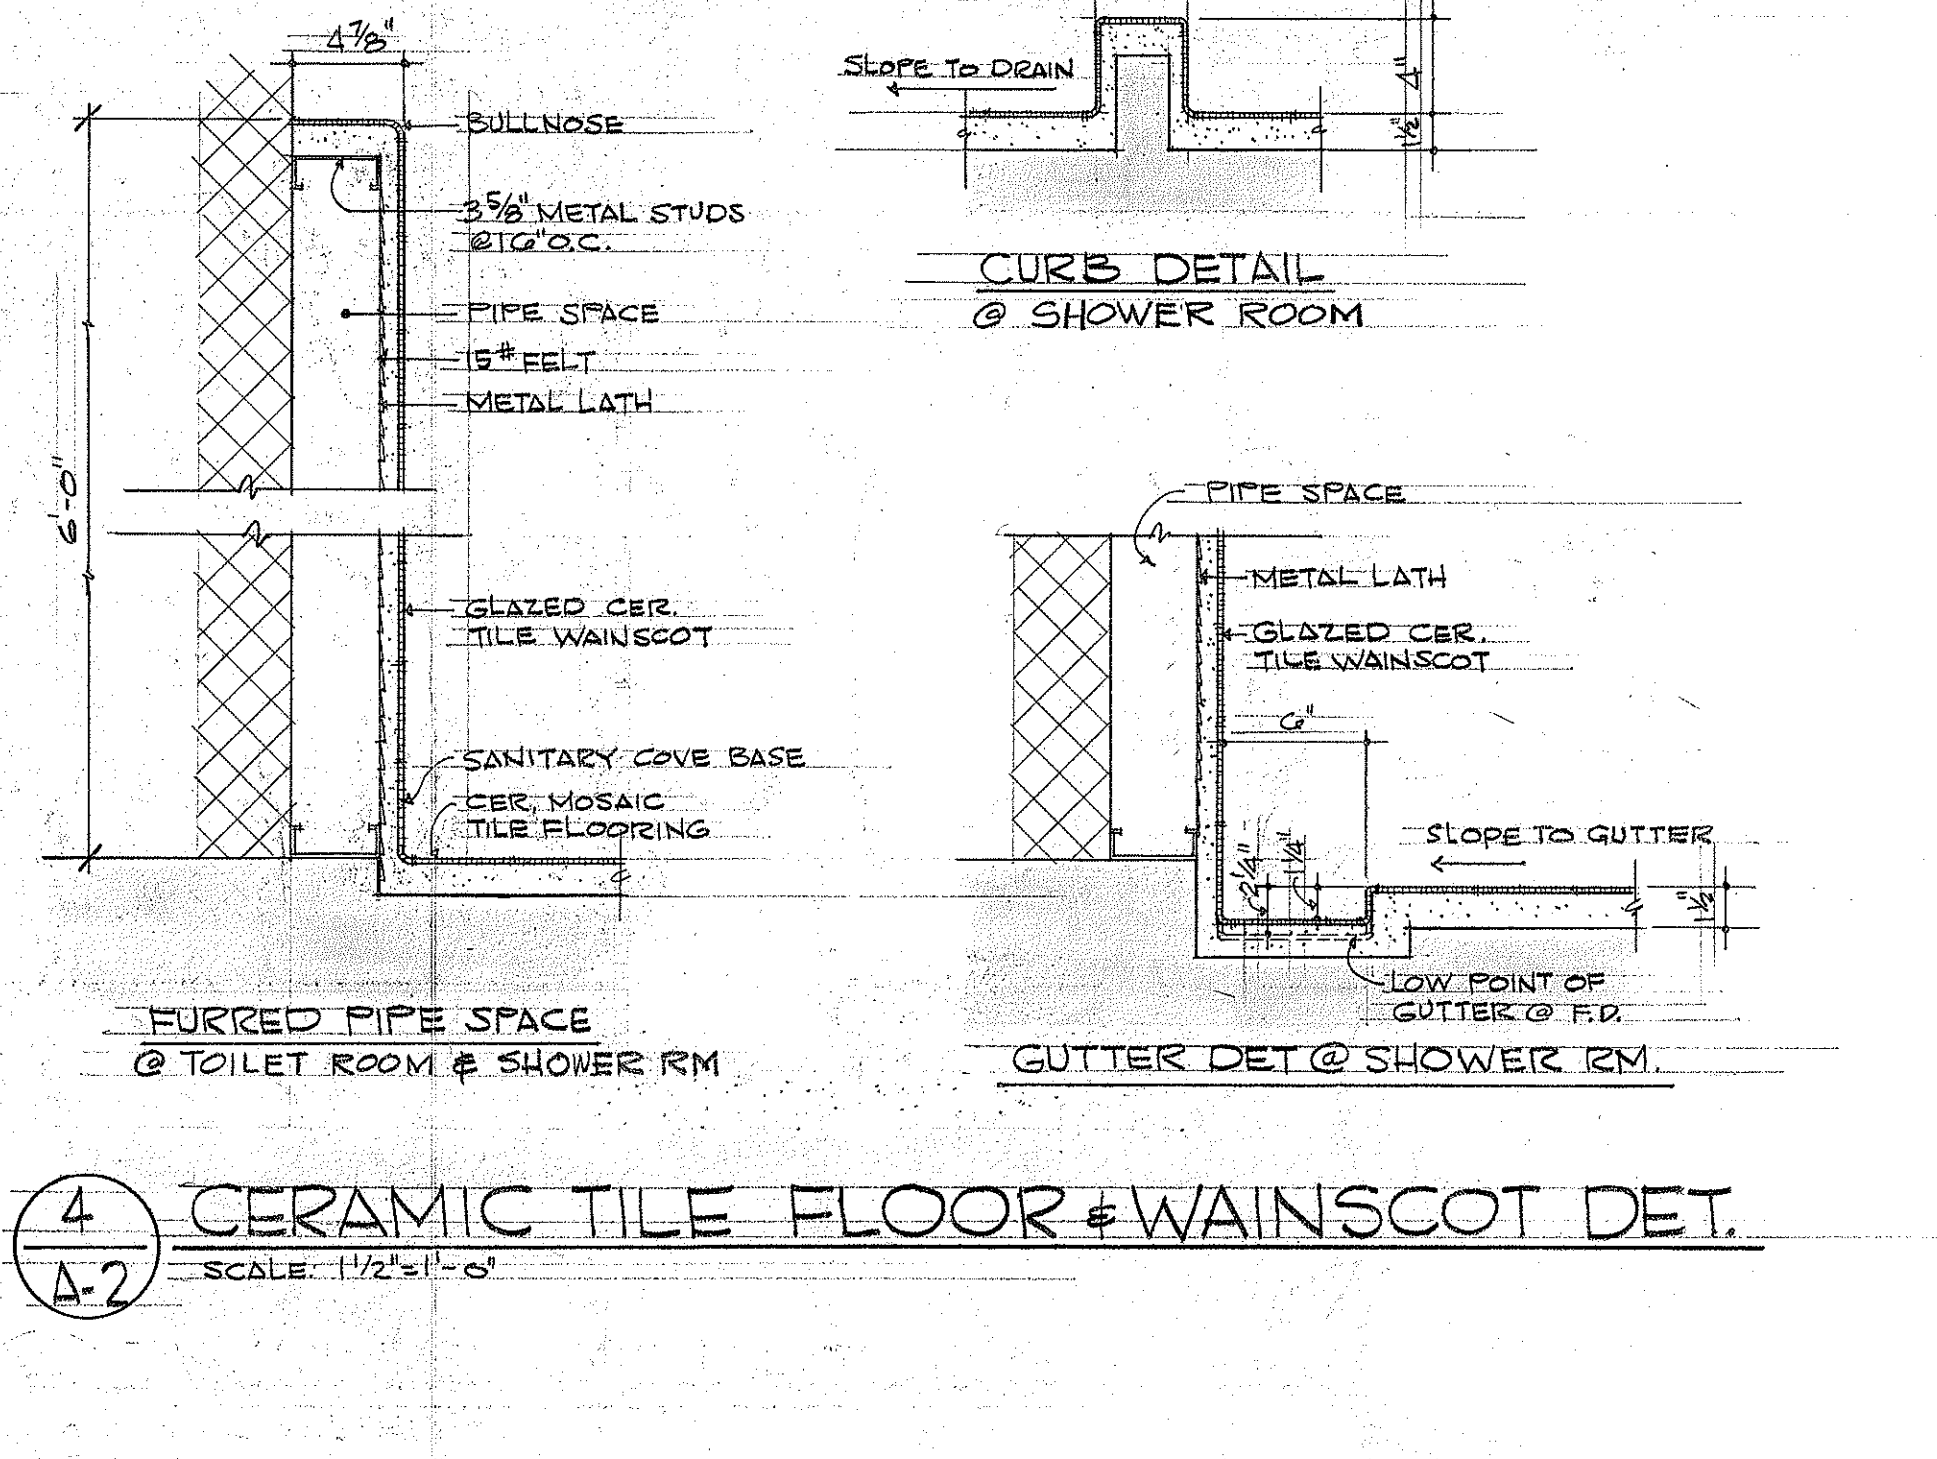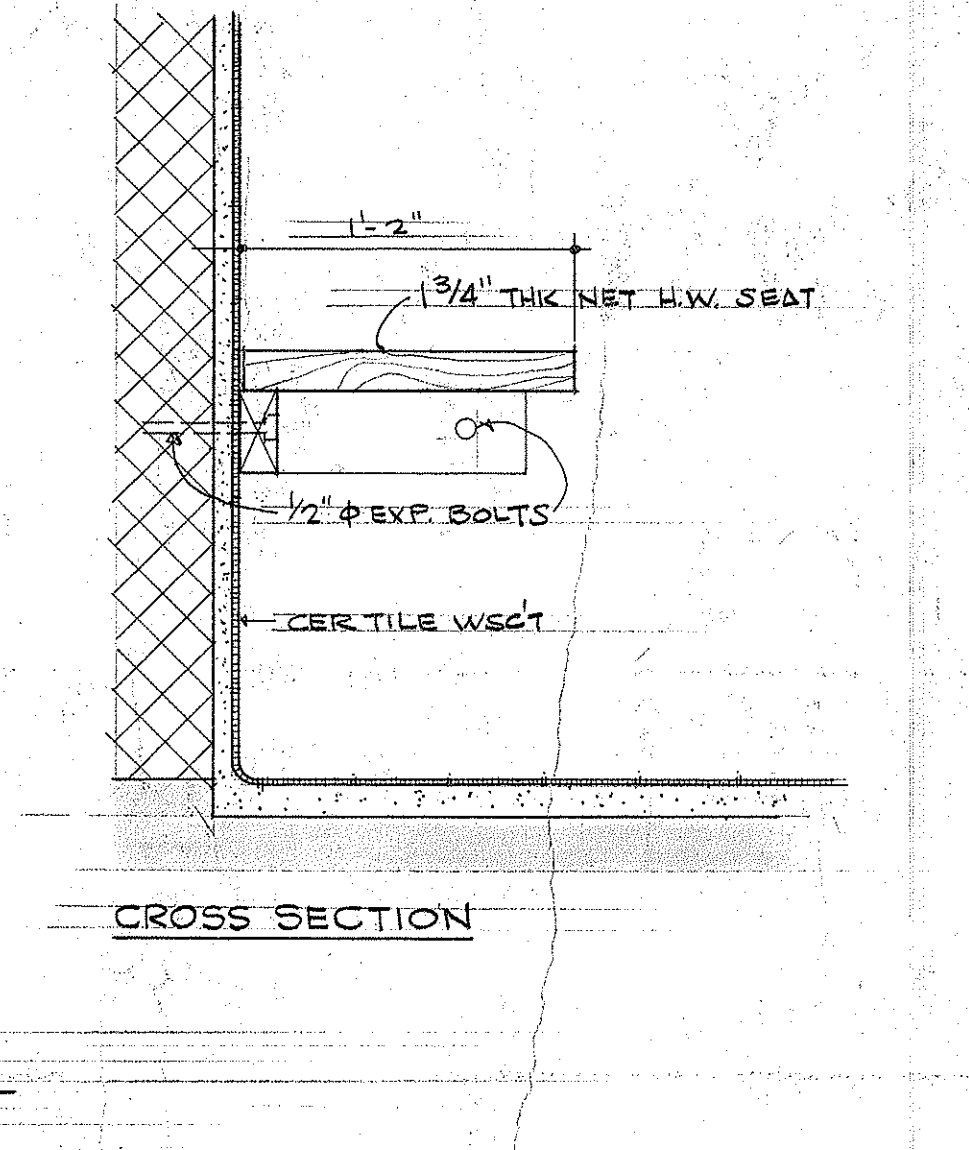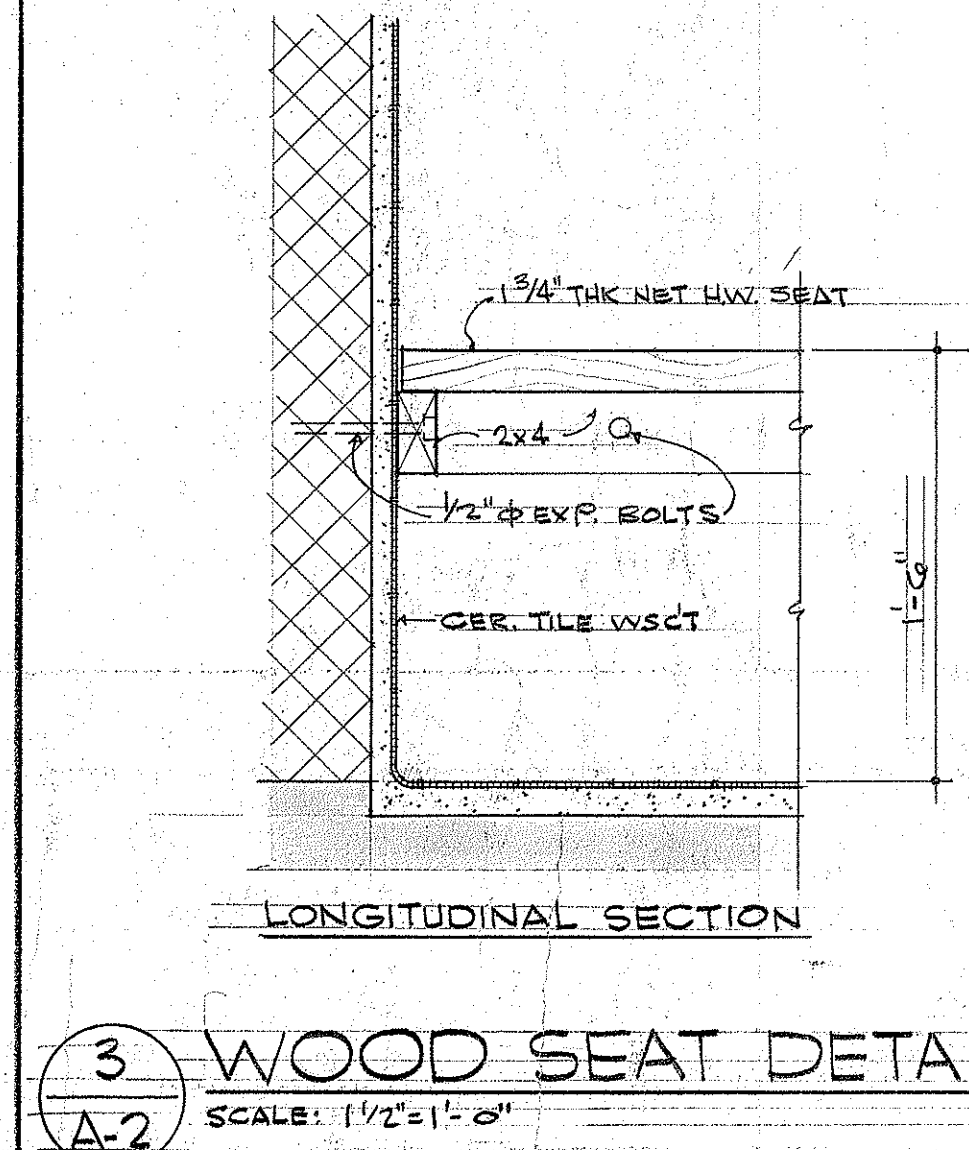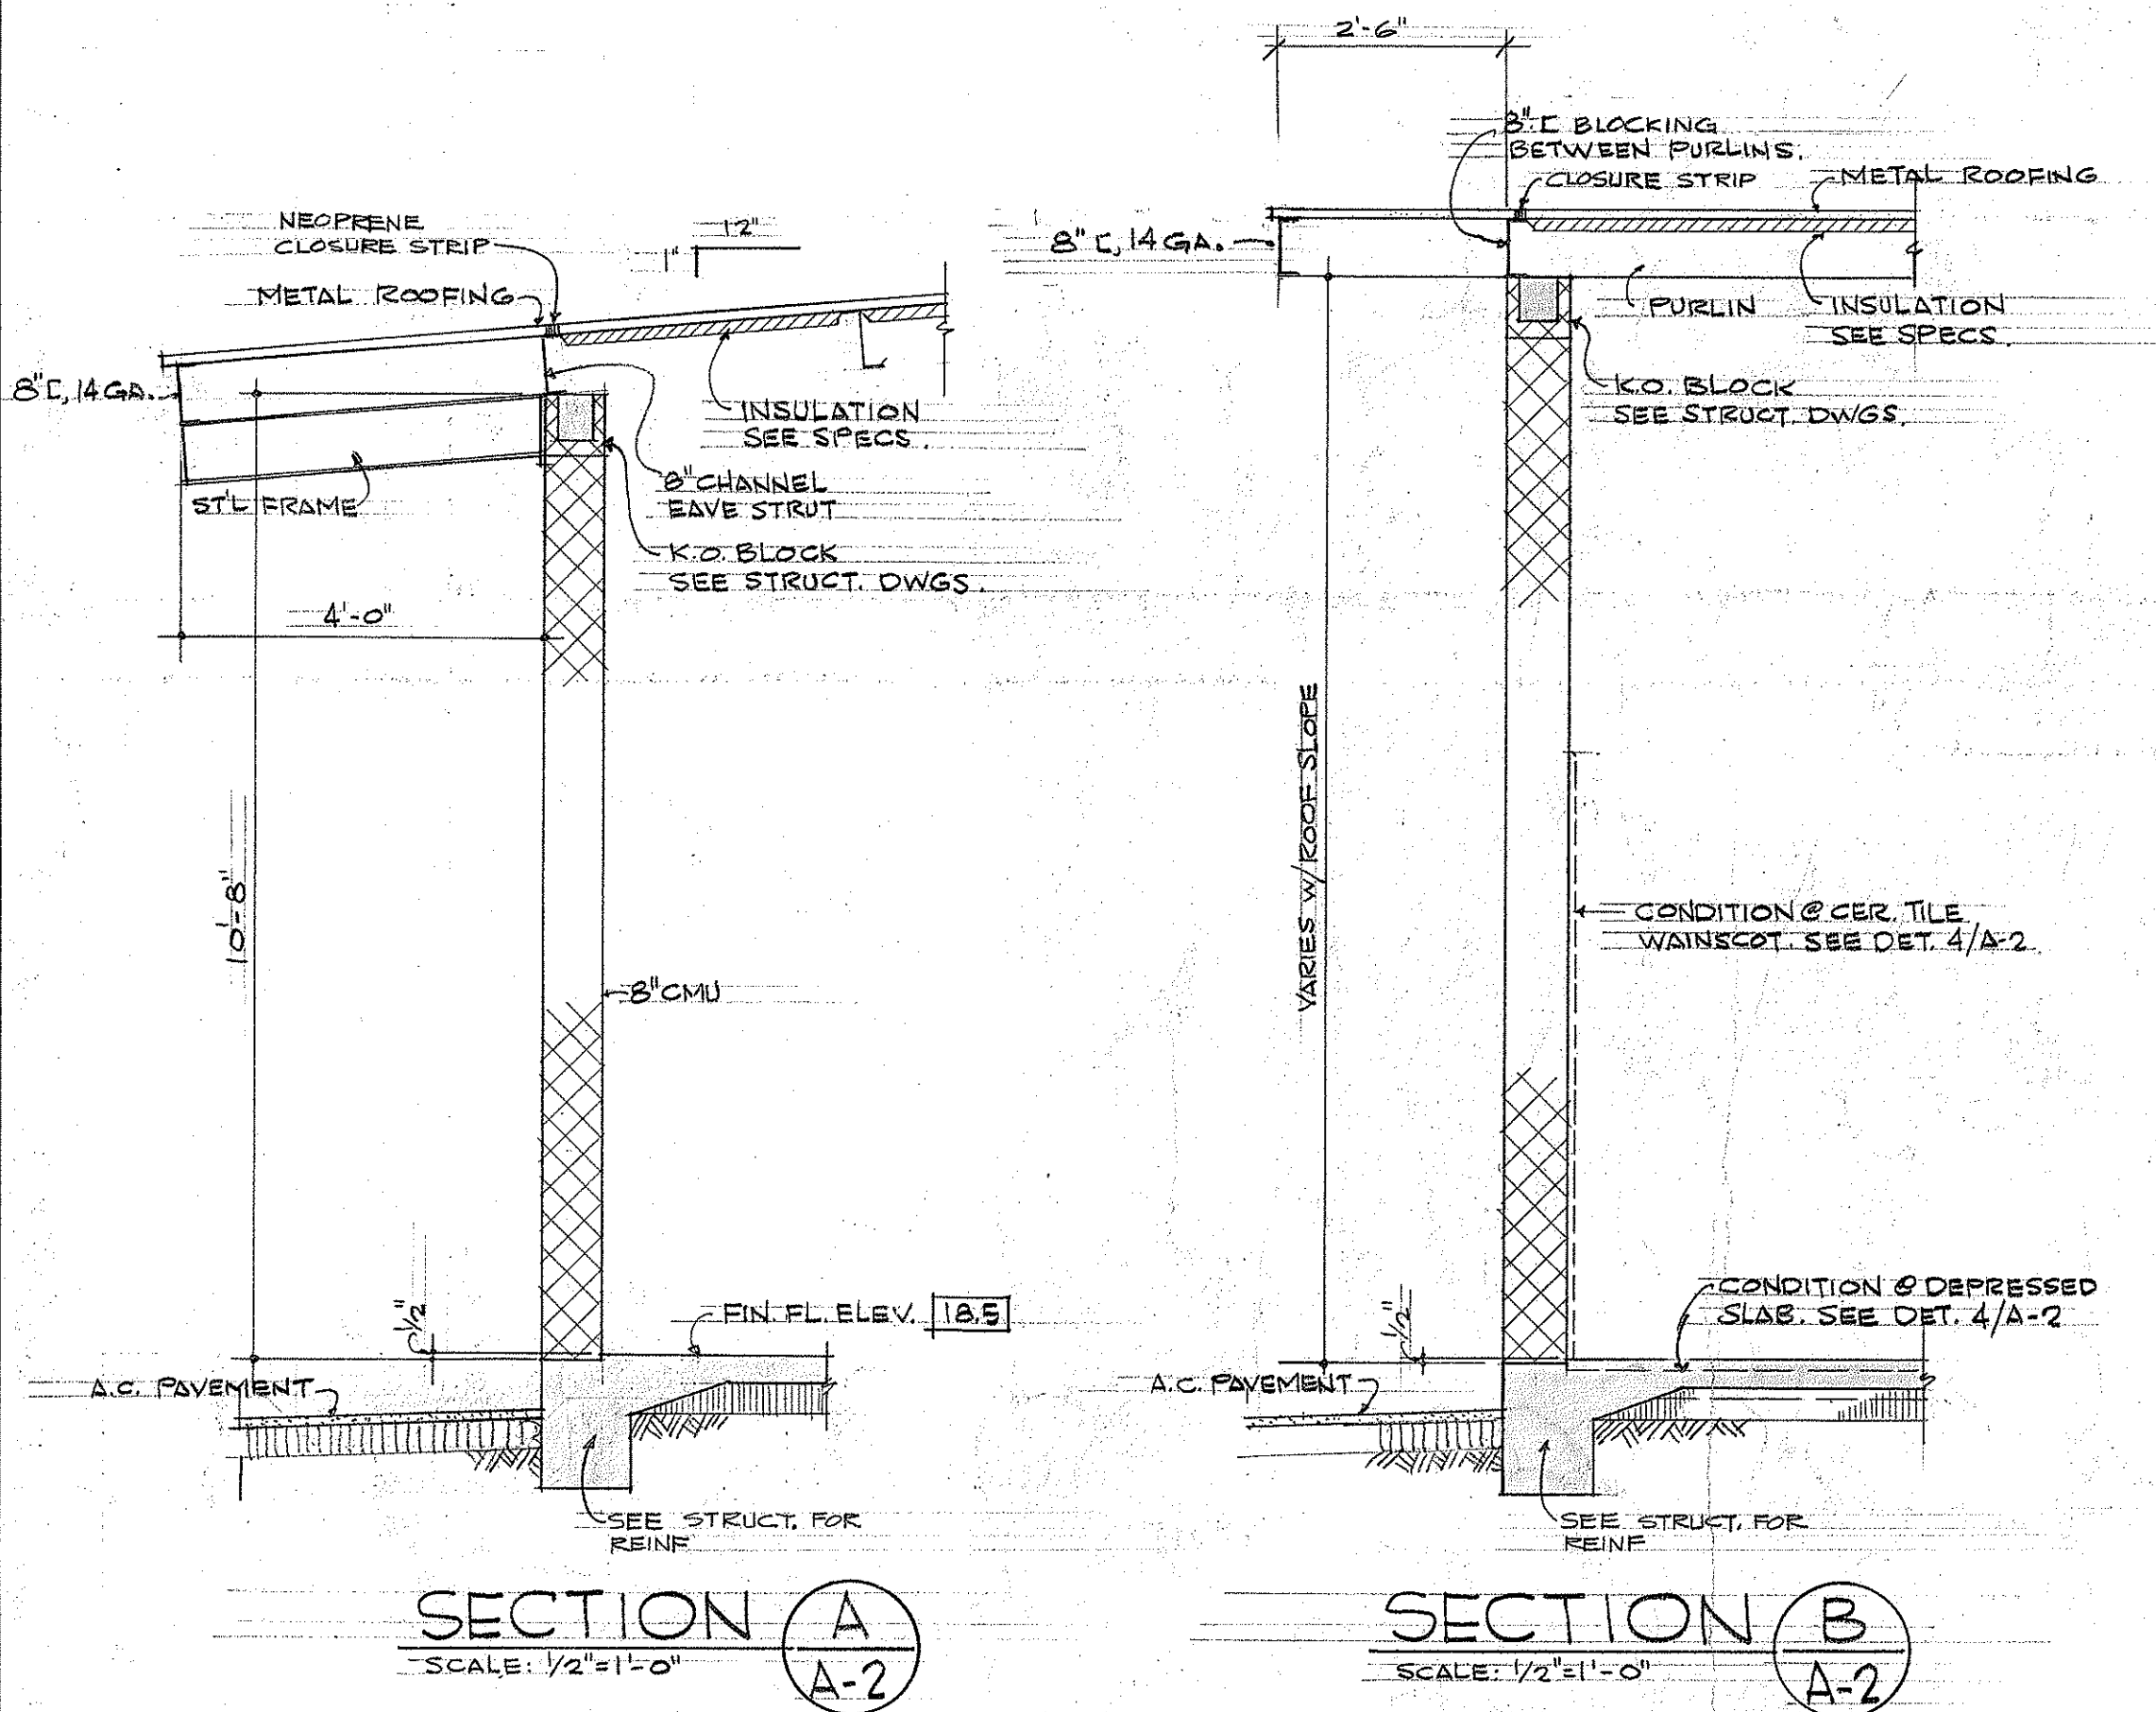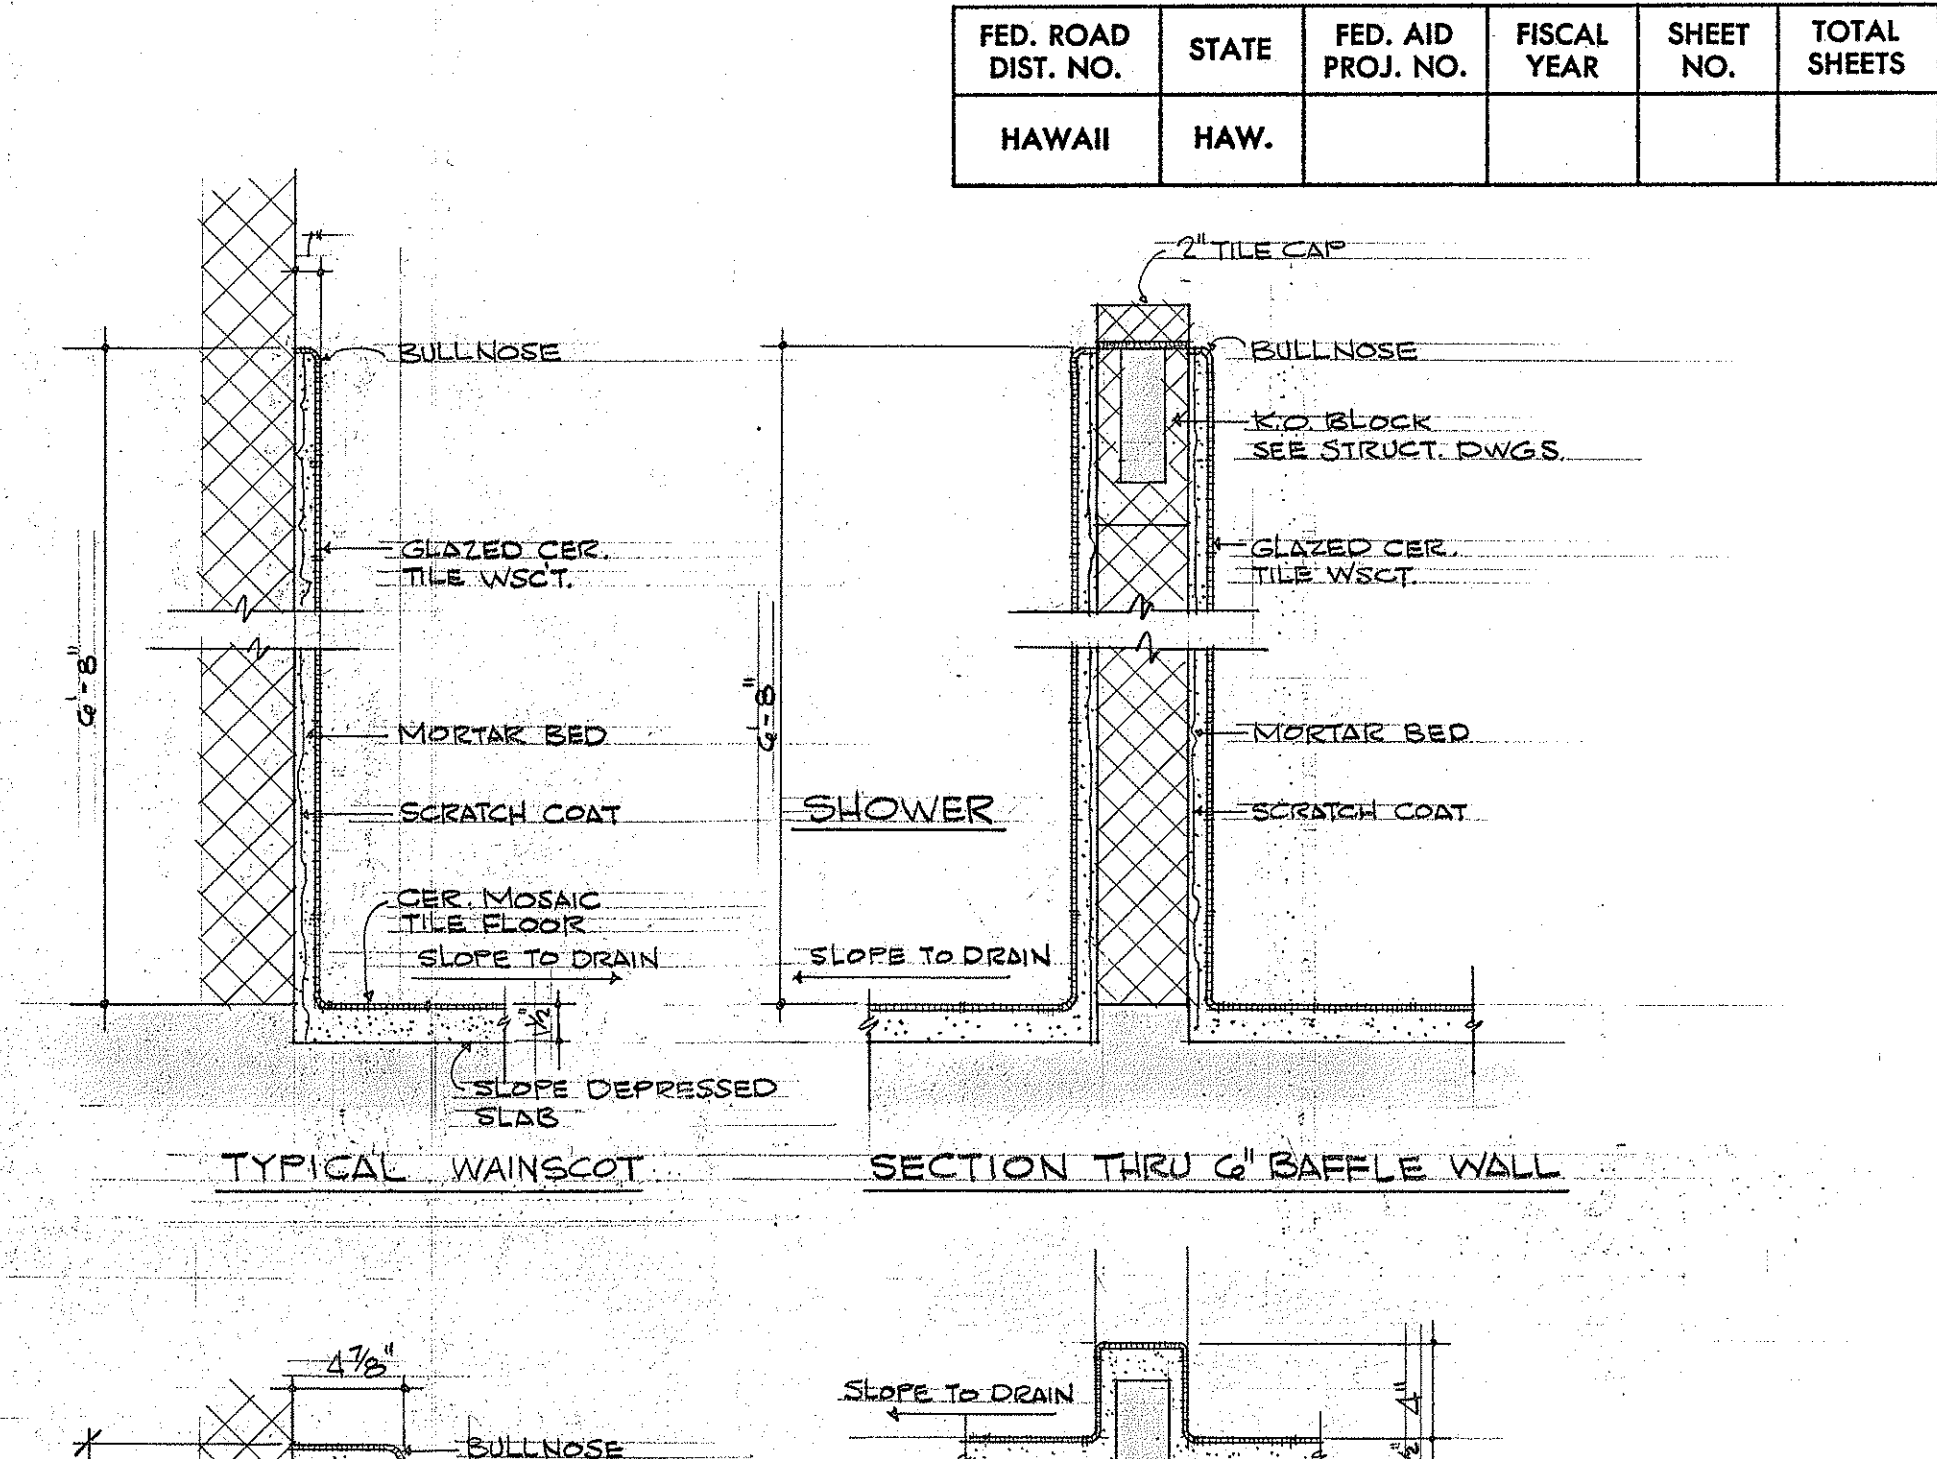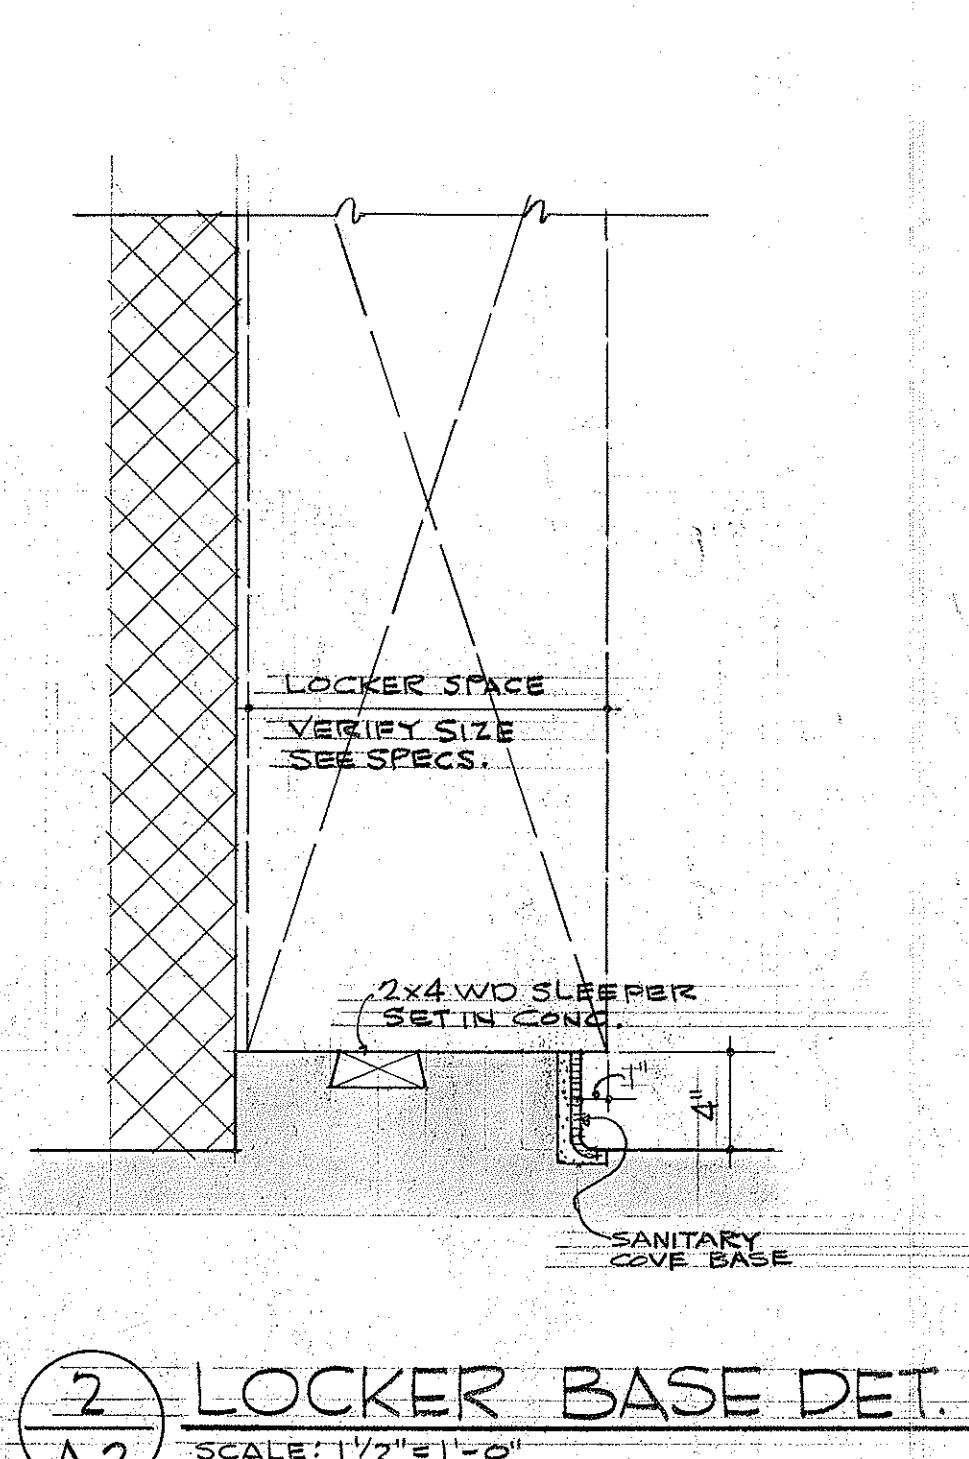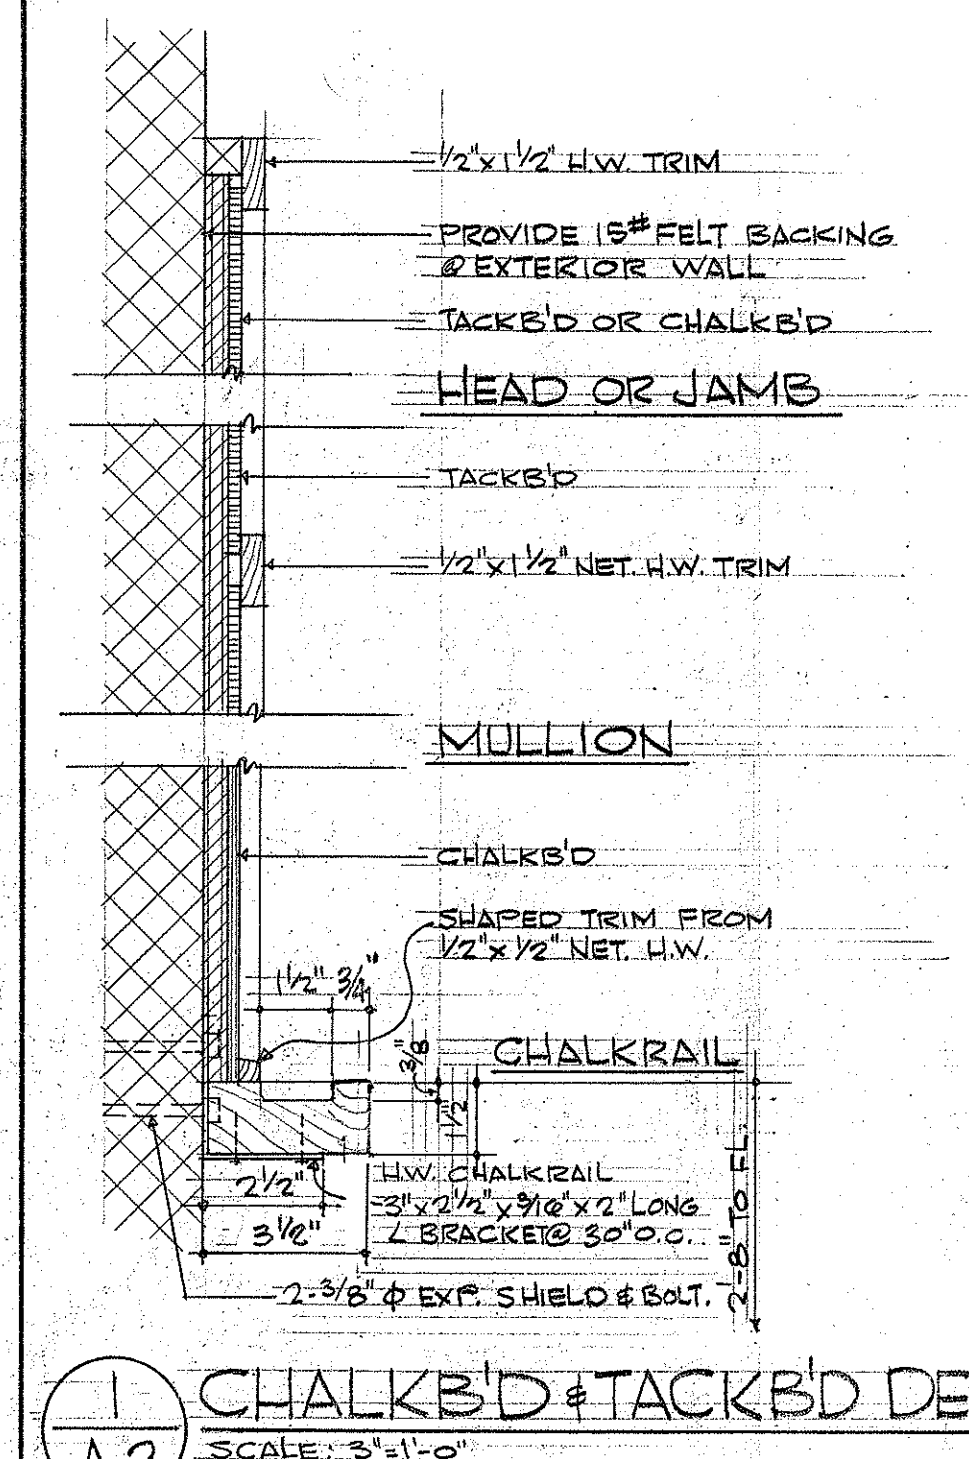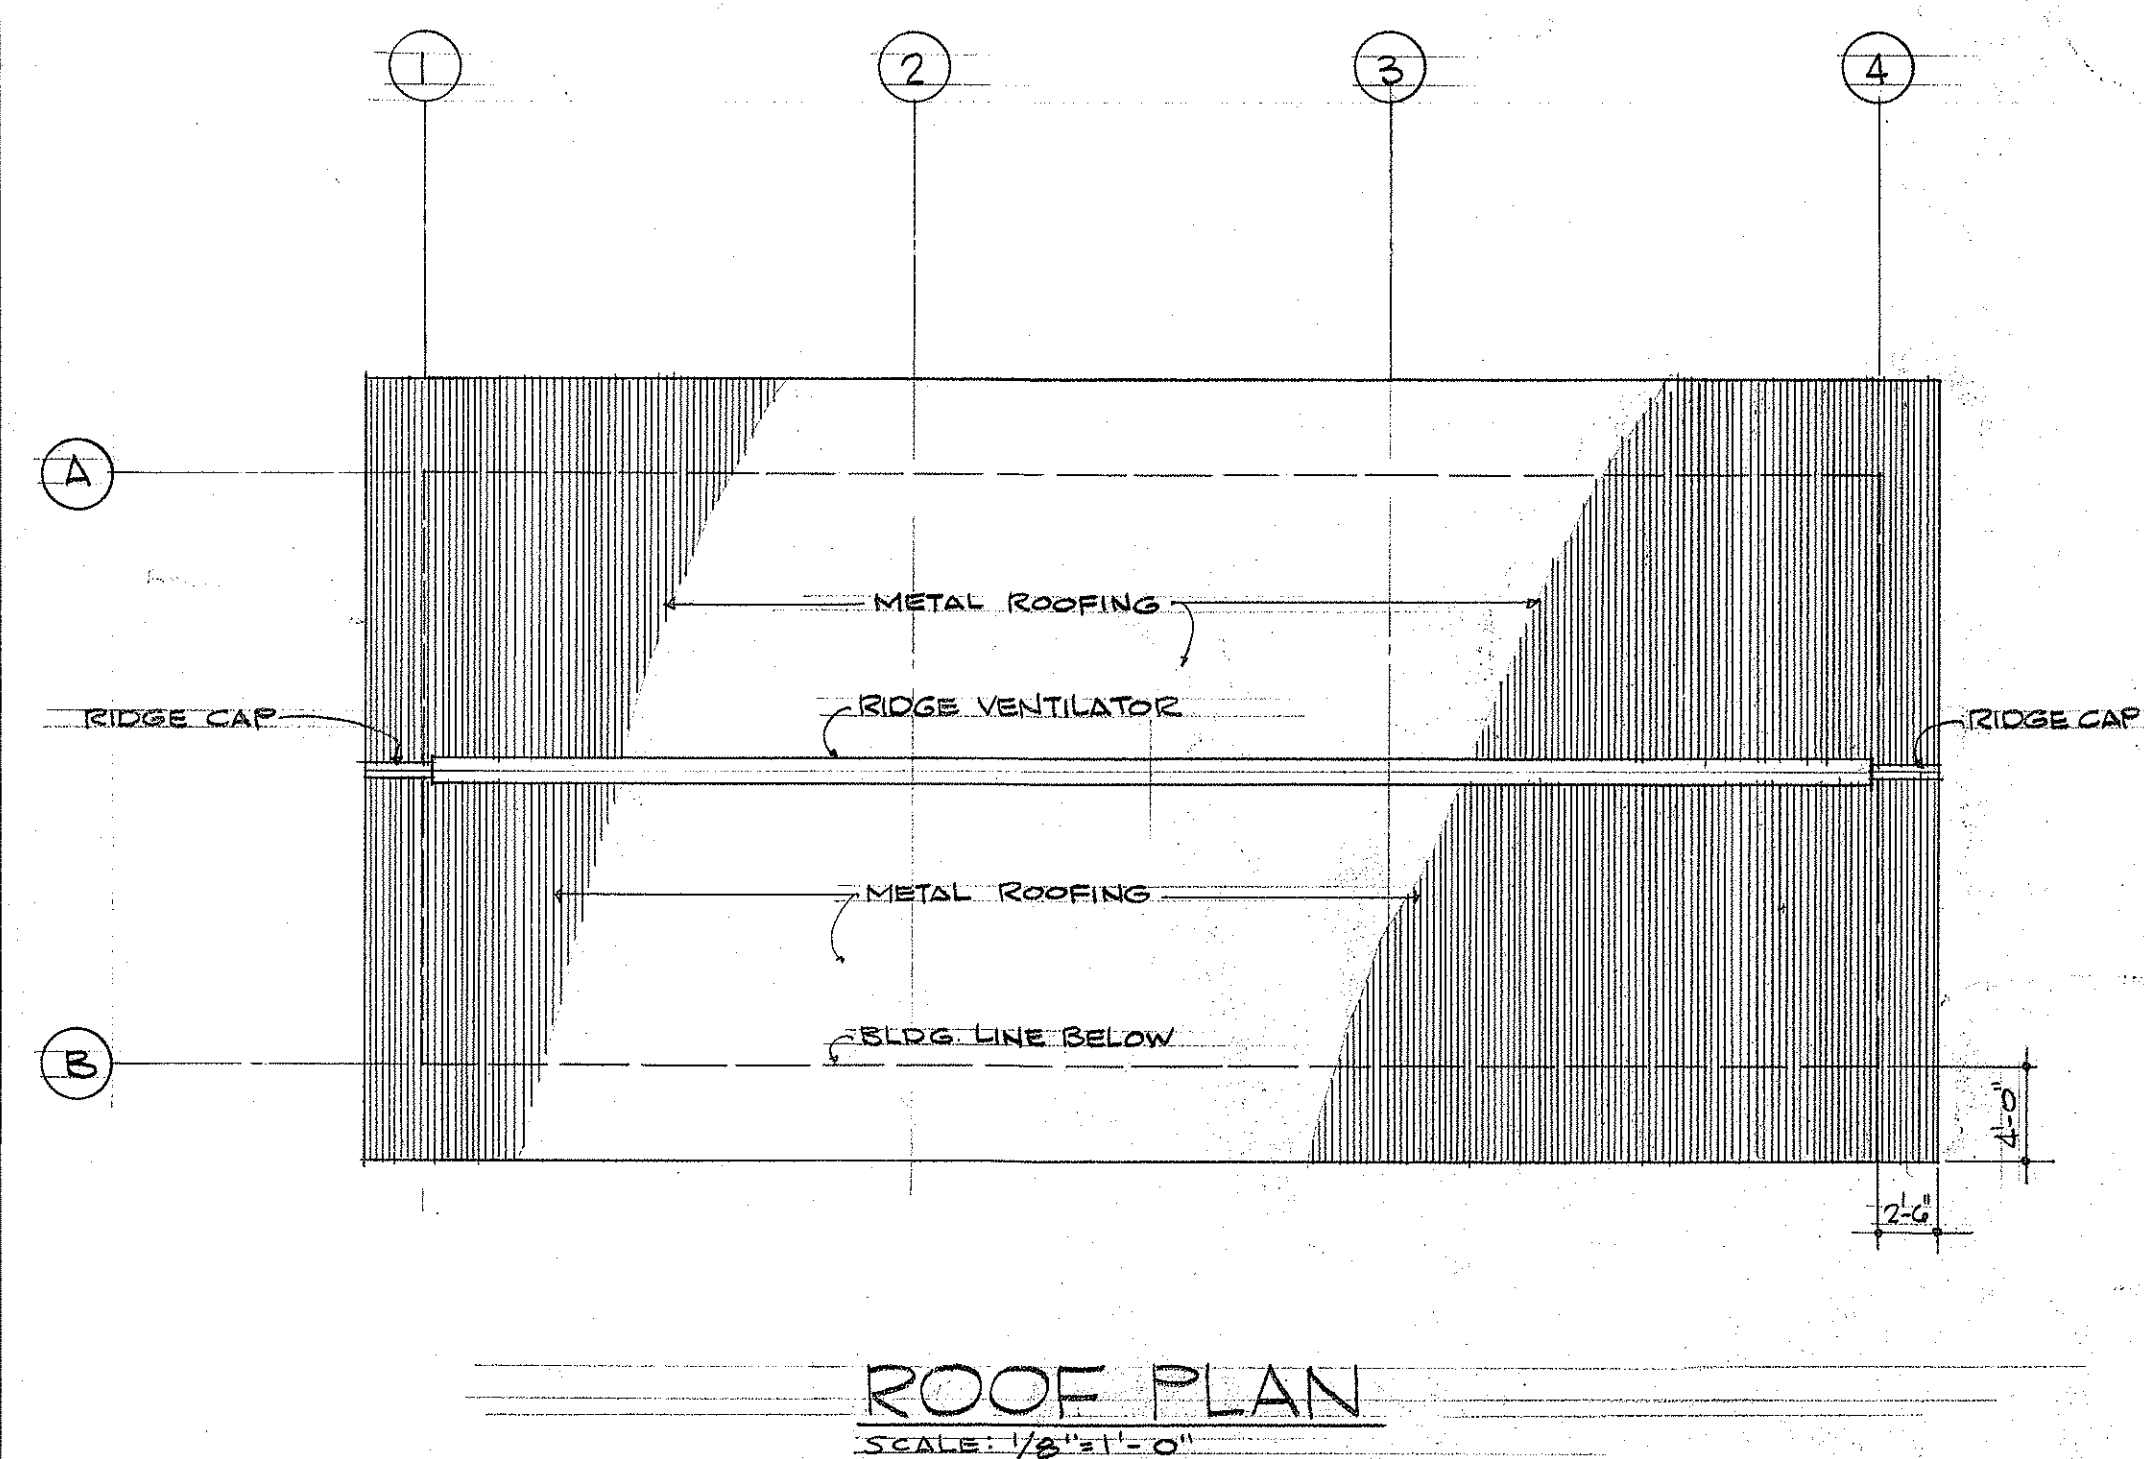

THIS WORK WAS PREPARED BY ME OR UNDER MY SUPERVISION.

*Herbert Y. Matsumura*

STATE OF HAWAII  
DEPARTMENT OF TRANSPORTATION  
HIGHWAYS DIVISION

PEARL CITY BASEYARD

PEARL CITY OAHU, HAWAII

ROOF PLAN, SECTION, & DETS.

HERBERT Y. MATSUMURA & ASSOC., INC.  
871 KAPIOLANI BLVD. HONOLULU, HAWAII

**SHEET No. A-2 OF 11 SHEETS**





|               |  |
|---------------|--|
| DATE          |  |
| DESIGNED BY   |  |
| TRACED BY     |  |
| NOTE BOOK     |  |
| QUANTITIES BY |  |
| CHECKED BY    |  |









| FED. ROAD DIST. NO. | STATE | FED. AID PROJ. NO. | FISCAL YEAR | SHEET NO. | TOTAL SHEETS |
|---------------------|-------|--------------------|-------------|-----------|--------------|
| HAWAII              | HAW.  |                    |             |           |              |

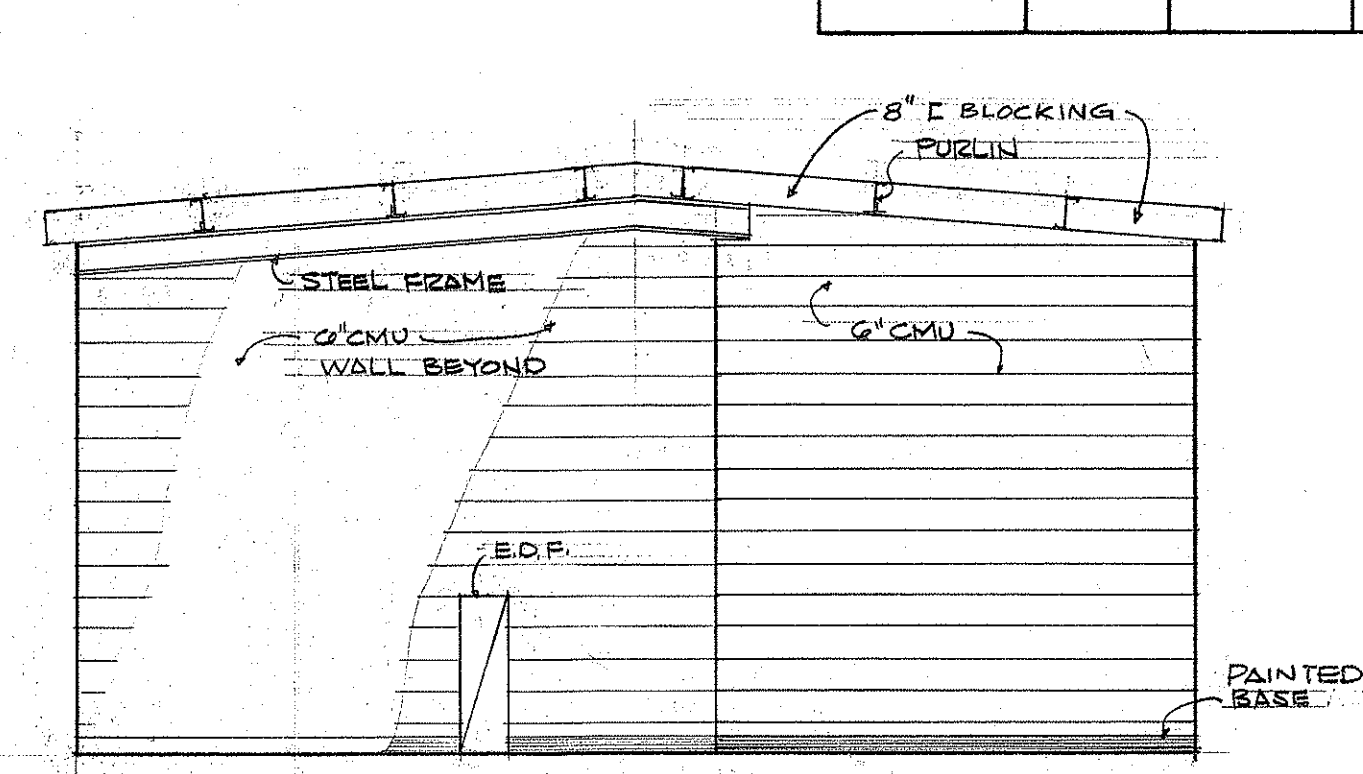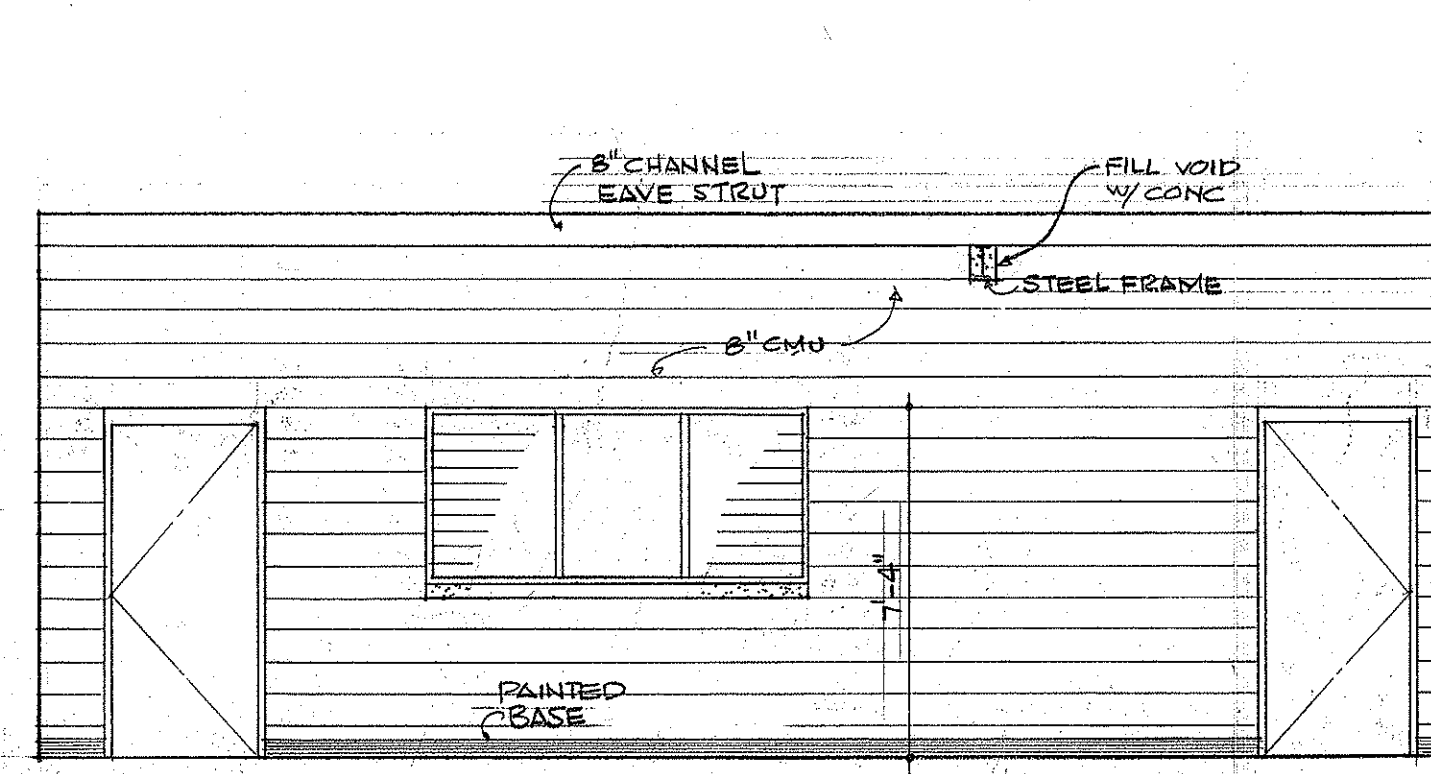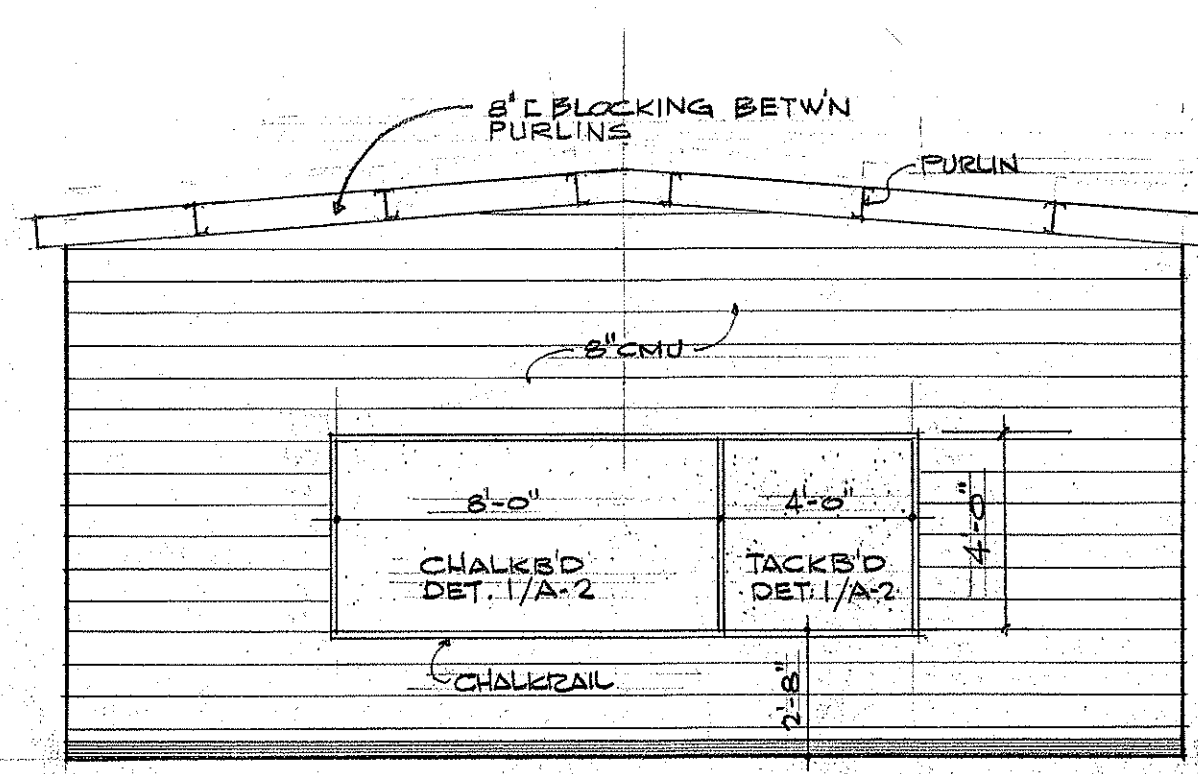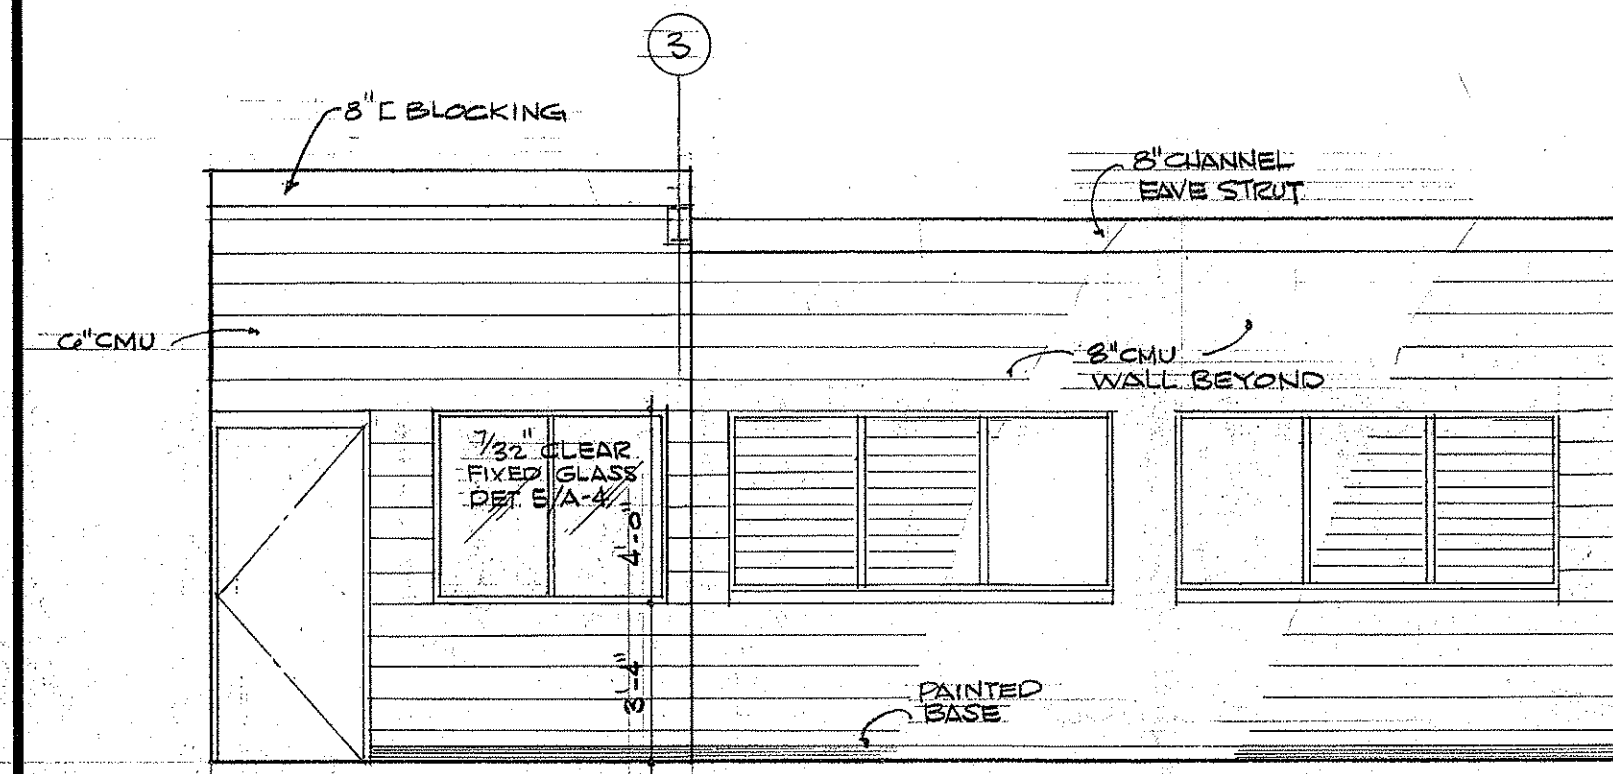


A-4 STAGING RM.  
SCALE: 1/4"=1'-0"

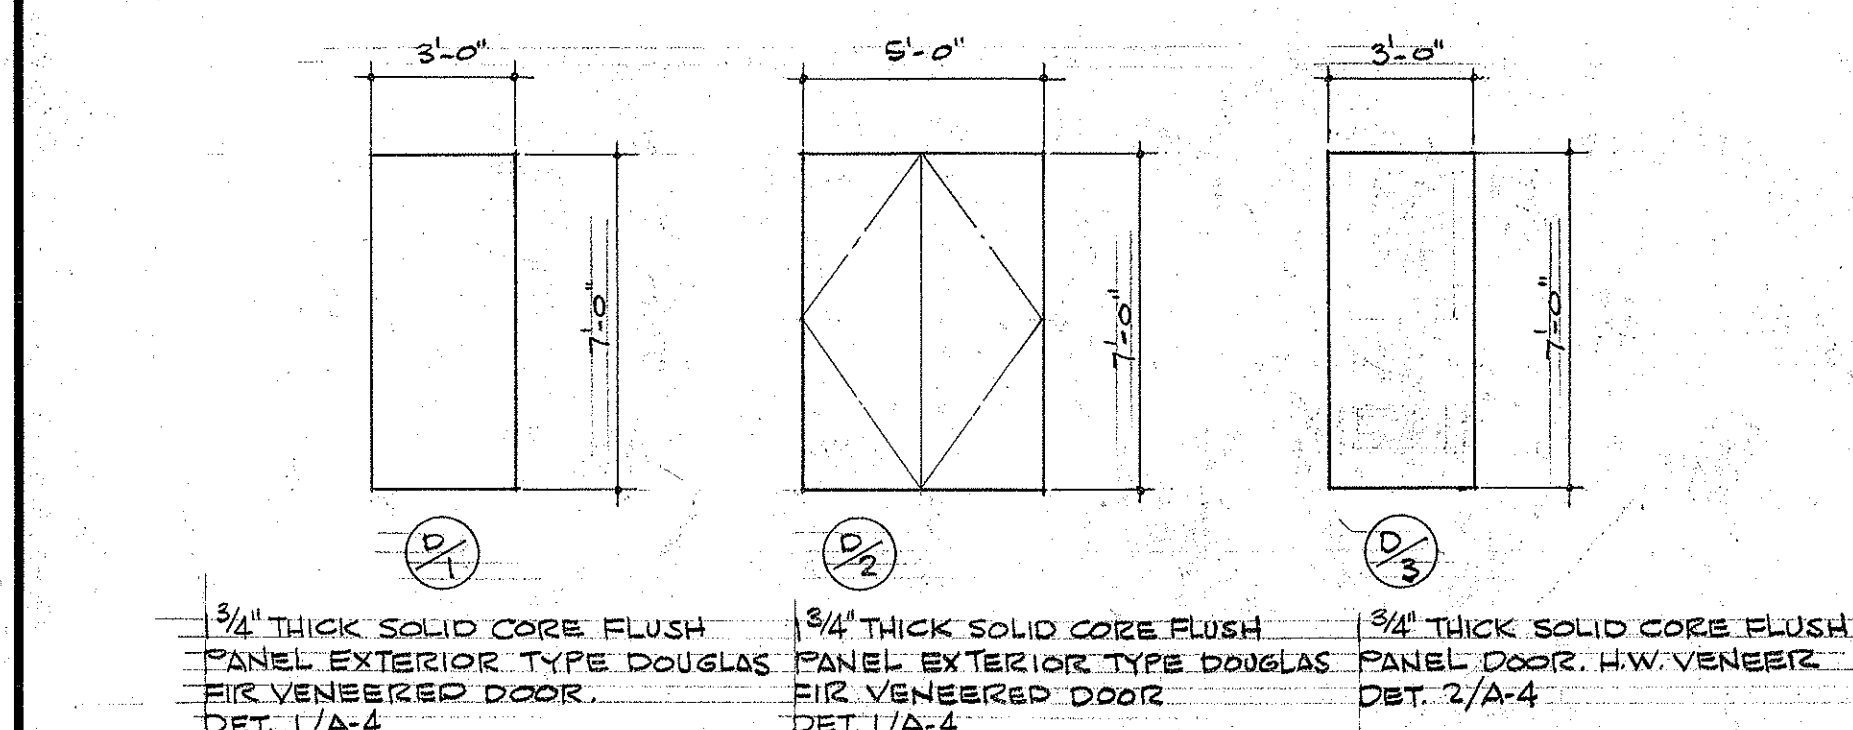


DOOR SCHEDULE  
SCALE: 1/4"=1'-0"

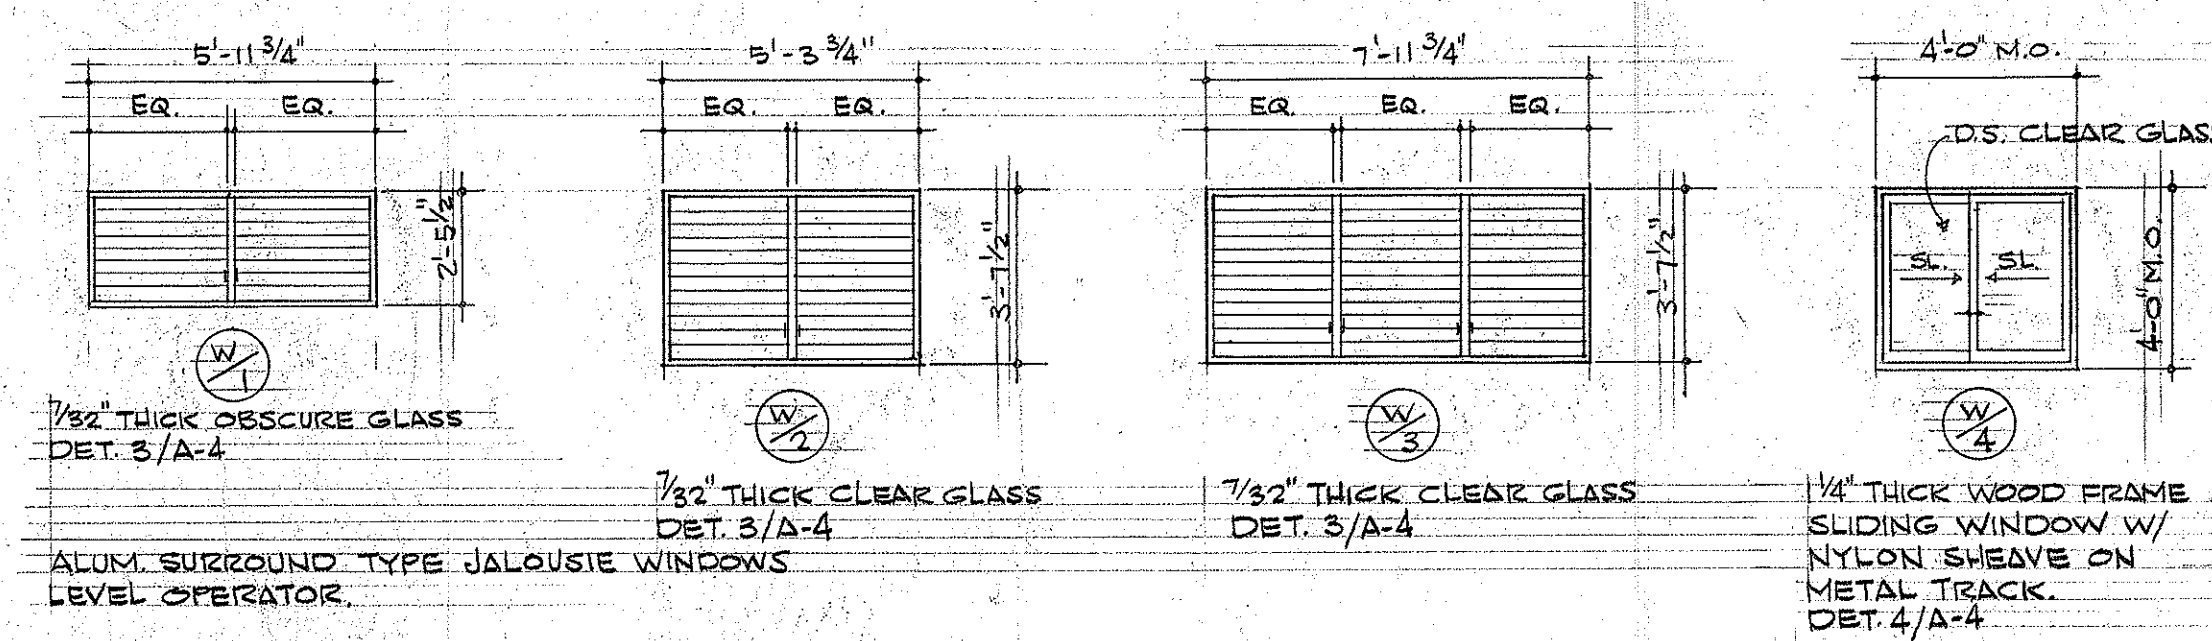


WINDOW SCHEDULE

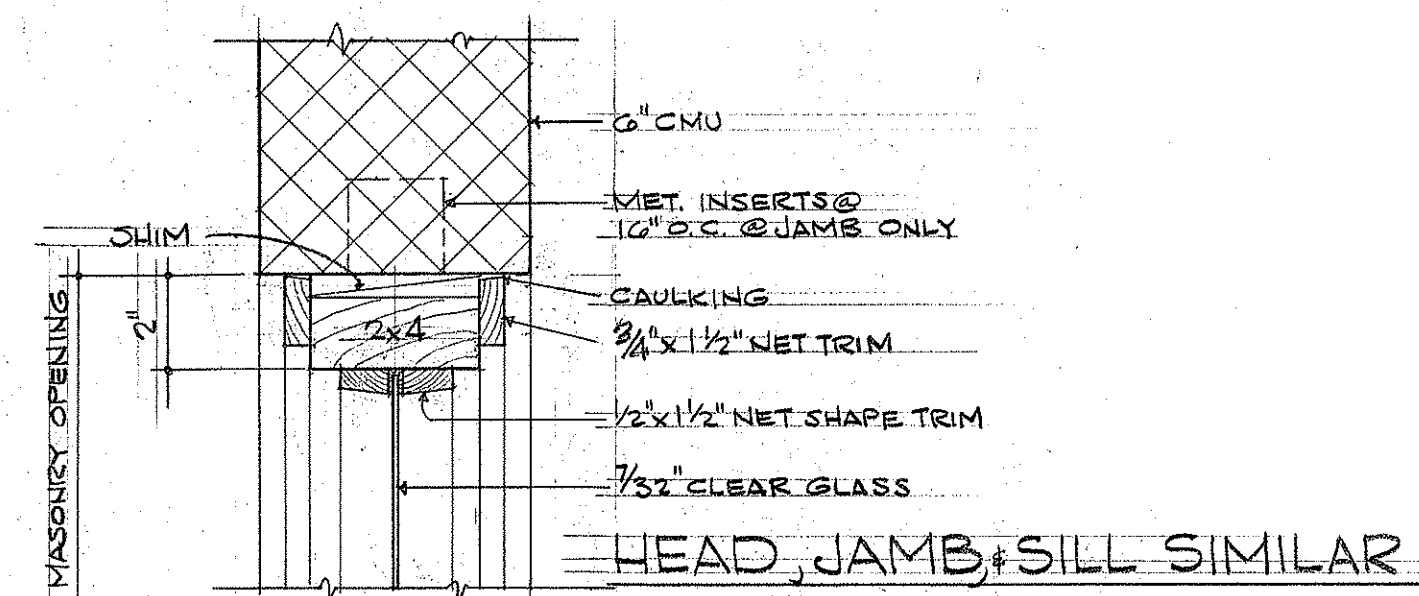


HEAD, JAMB, SILL SIMILAR

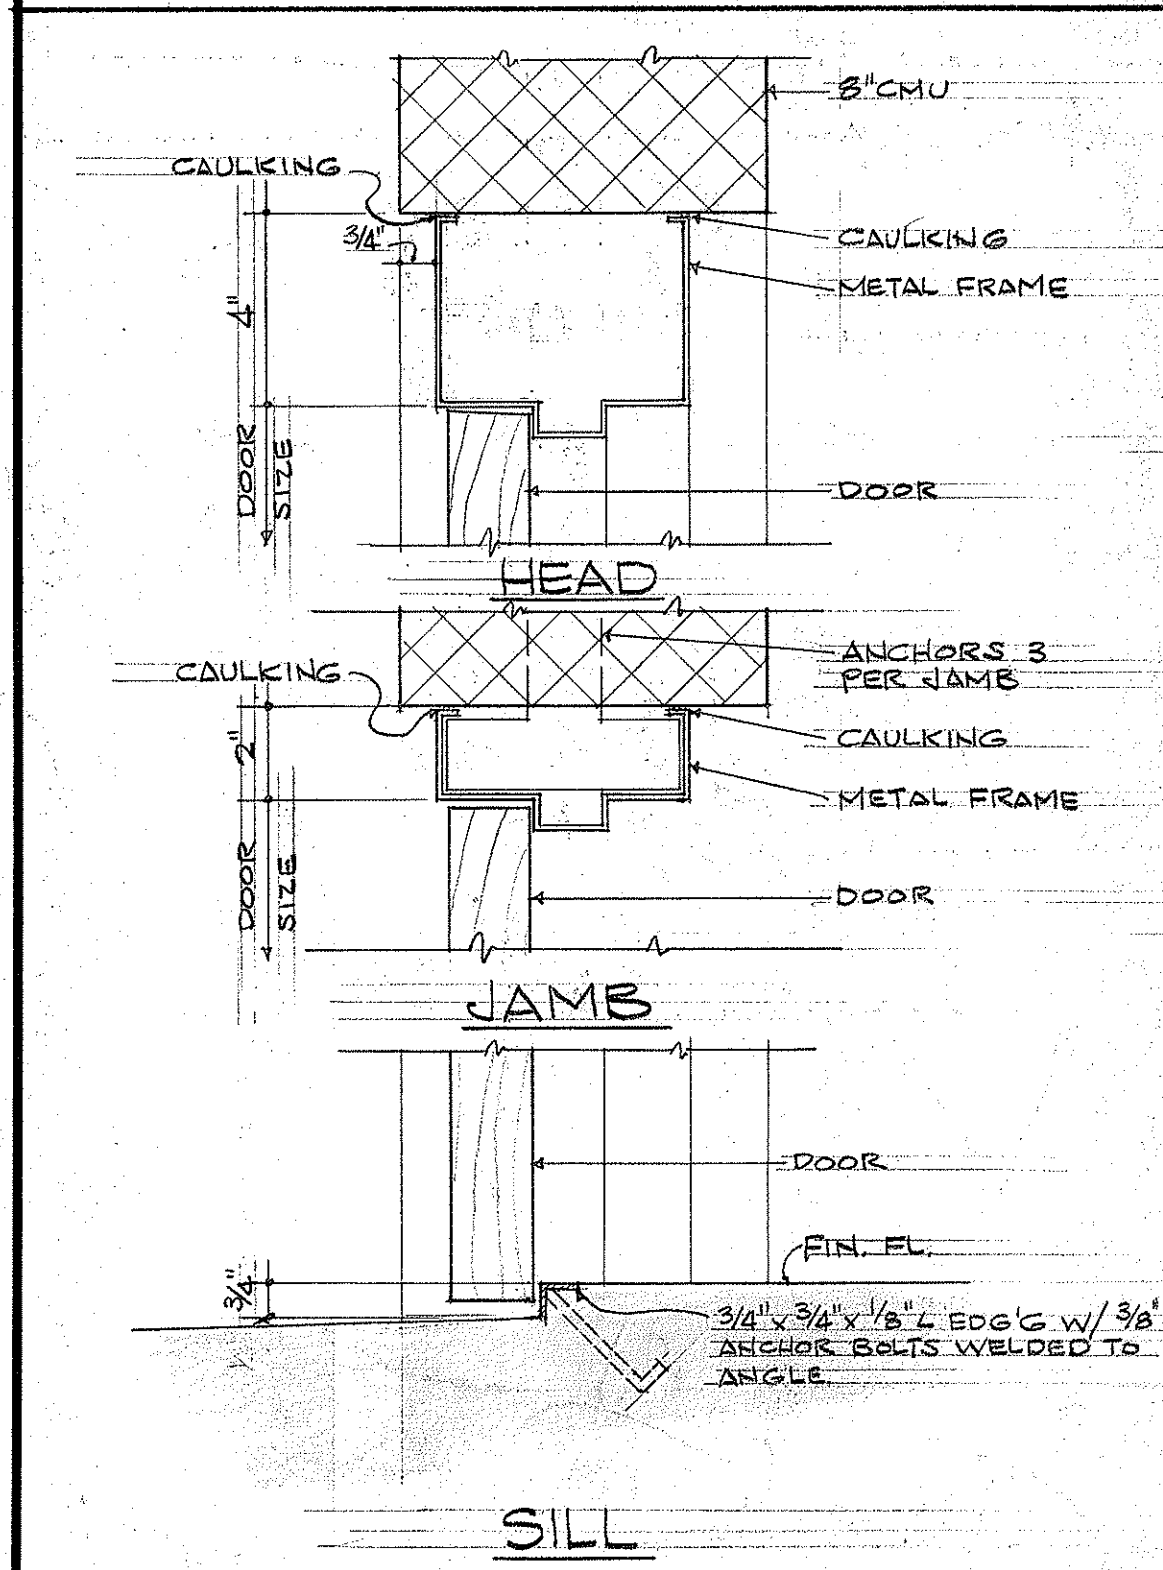


1 DOOR 2 FRAME DET.  
A-4 SCALE: 3/8"=1'-0"

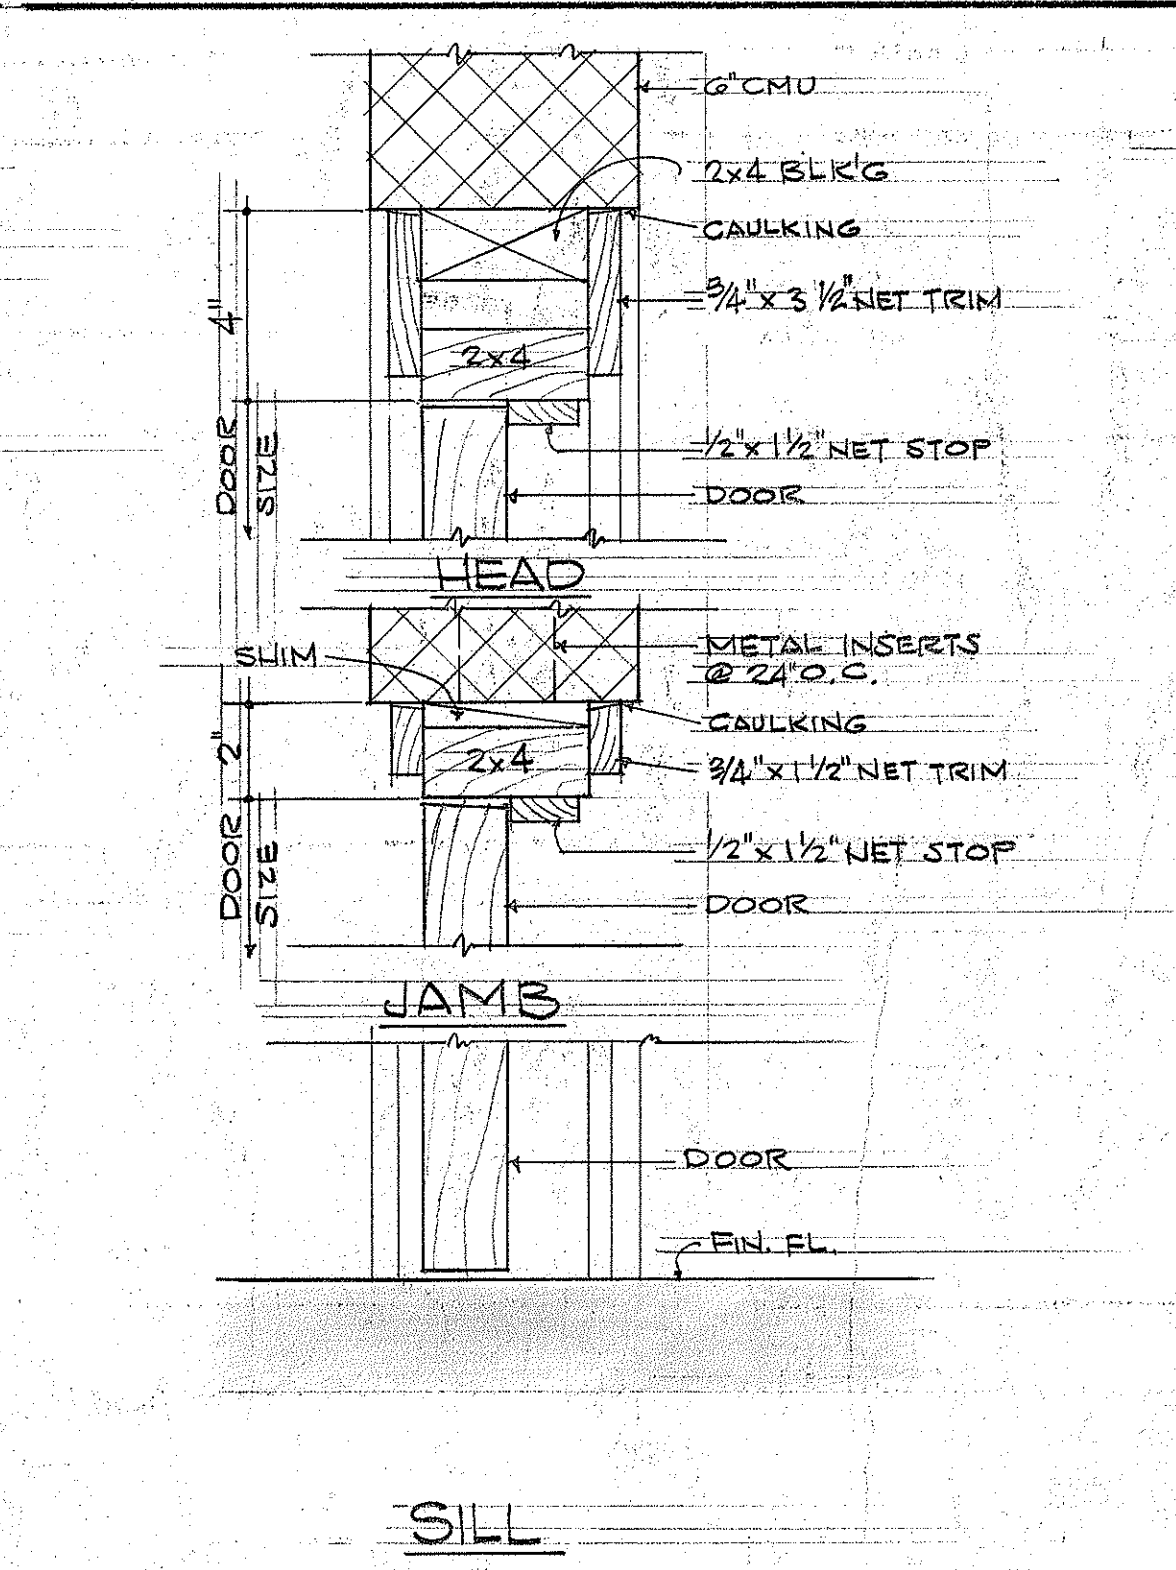


2 DOOR 3 FRAME DET.  
A-4 SCALE: 3/8"=1'-0"

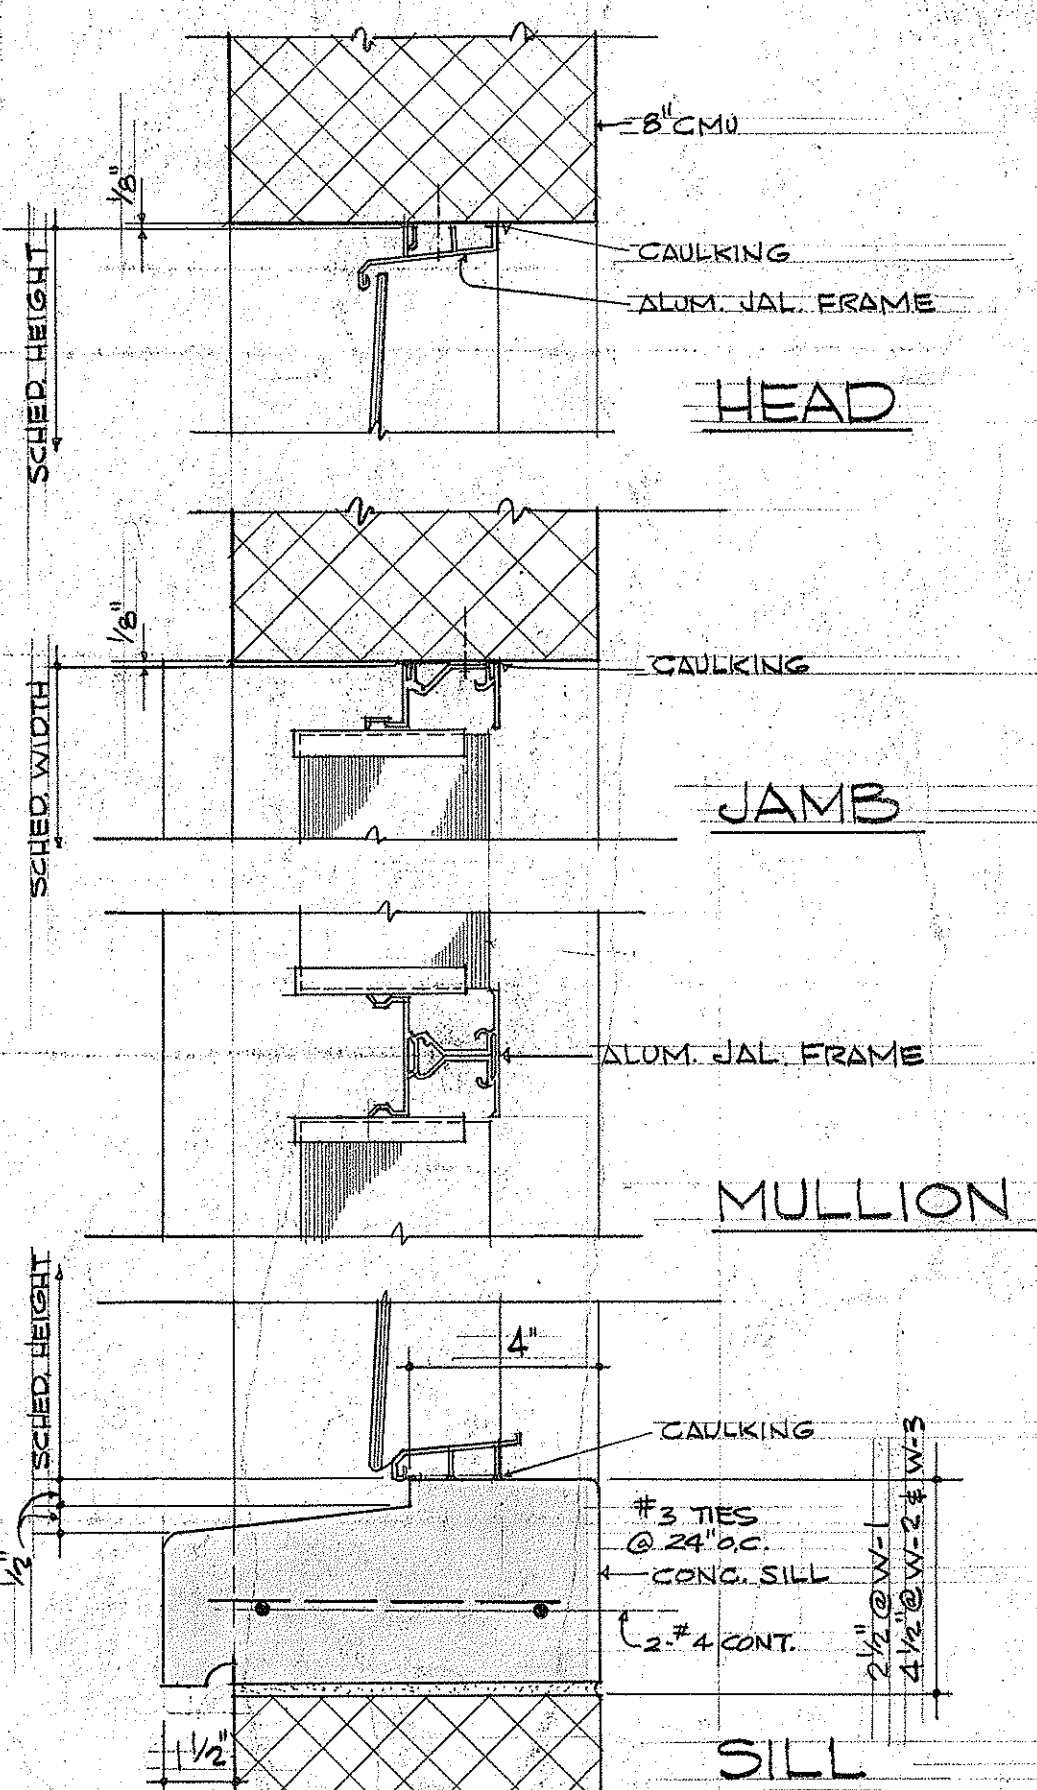

3 JAL WINDOW DET.  
A-4 SCALE: 3/8"=1'-0"

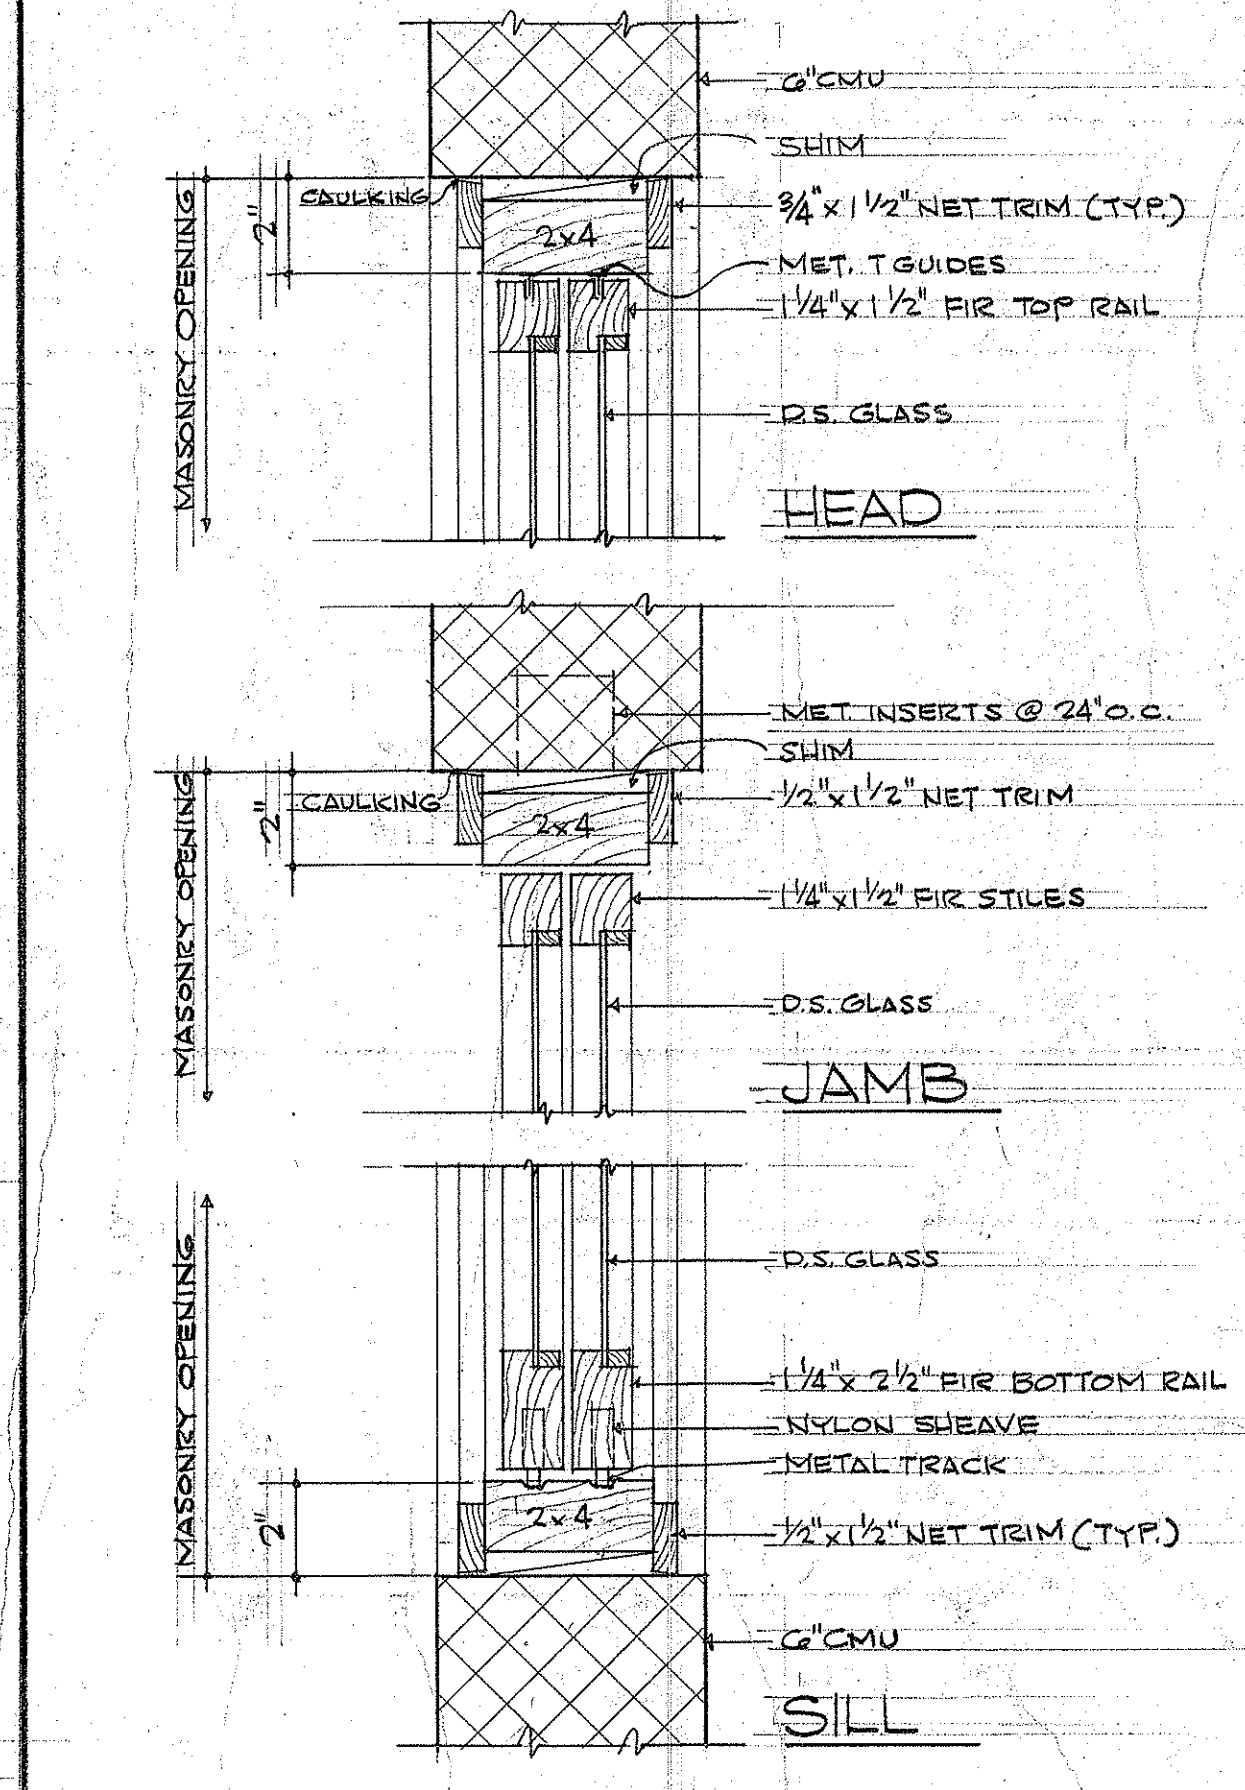

4 SLIDING WINDOW DET.  
A-4 SCALE: 3/8"=1'-0"

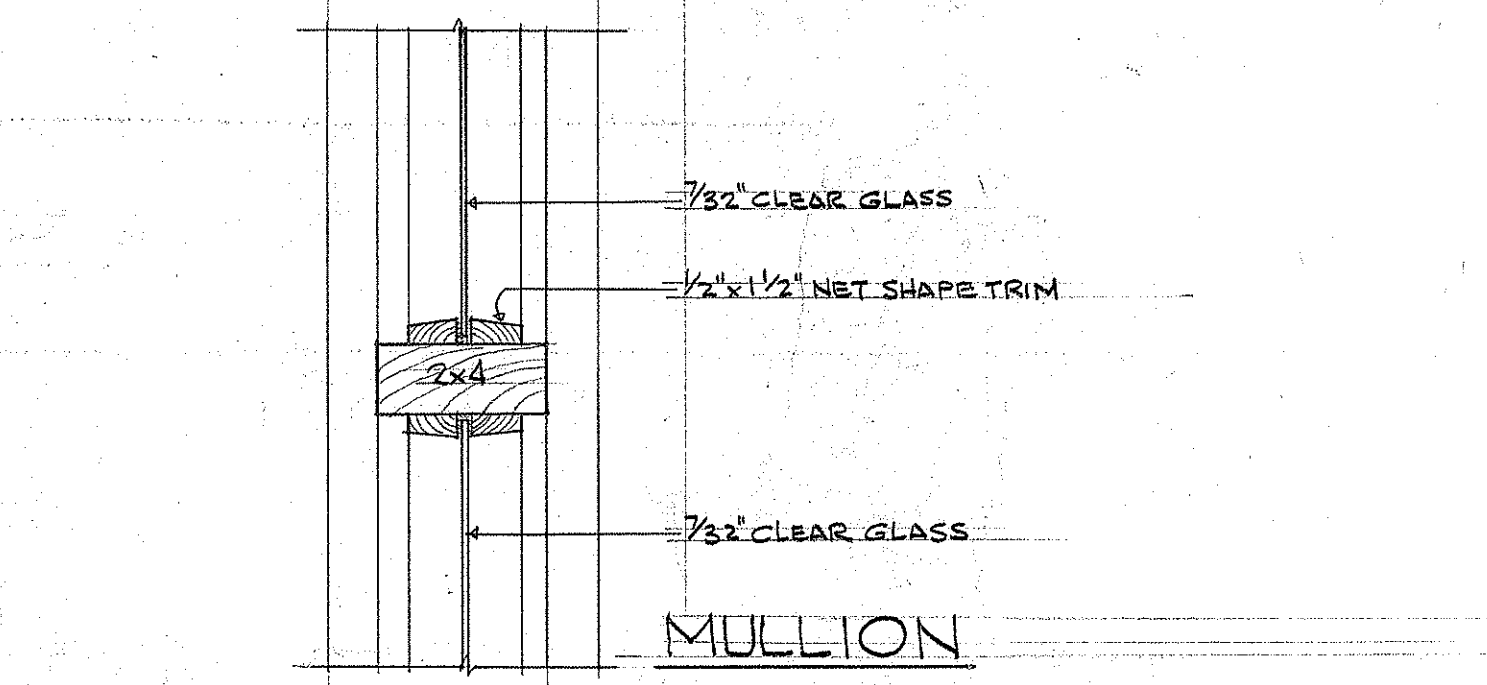

5 FIXED GLASS WINDOW  
A-4 SCALE: 3/8"=1'-0"

|               |  |
|---------------|--|
| DATE          |  |
| DESIGNED BY   |  |
| CHECKED BY    |  |
| NOTED BY      |  |
| QUANTITIES BY |  |
| NO.           |  |



THIS WORK WAS PREPARED BY ME OR UNDER MY SUPERVISION.  
Herbert Y. Matsumura

STATE OF HAWAII  
DEPARTMENT OF TRANSPORTATION  
HIGHWAYS DIVISION

PEARL CITY BASEYARD  
PEARL CITY OAHU, HAWAII

INTERIOR ELEVS., DOOR &  
WINDOW SCHEDULES & DETAILS.

HERBERT Y. MATSUMURA & ASSOC., INC.  
871 KAPOLANI BLVD. HONOLULU, HAWAII

SHEET No. A-4 OF 11 SHEETS