

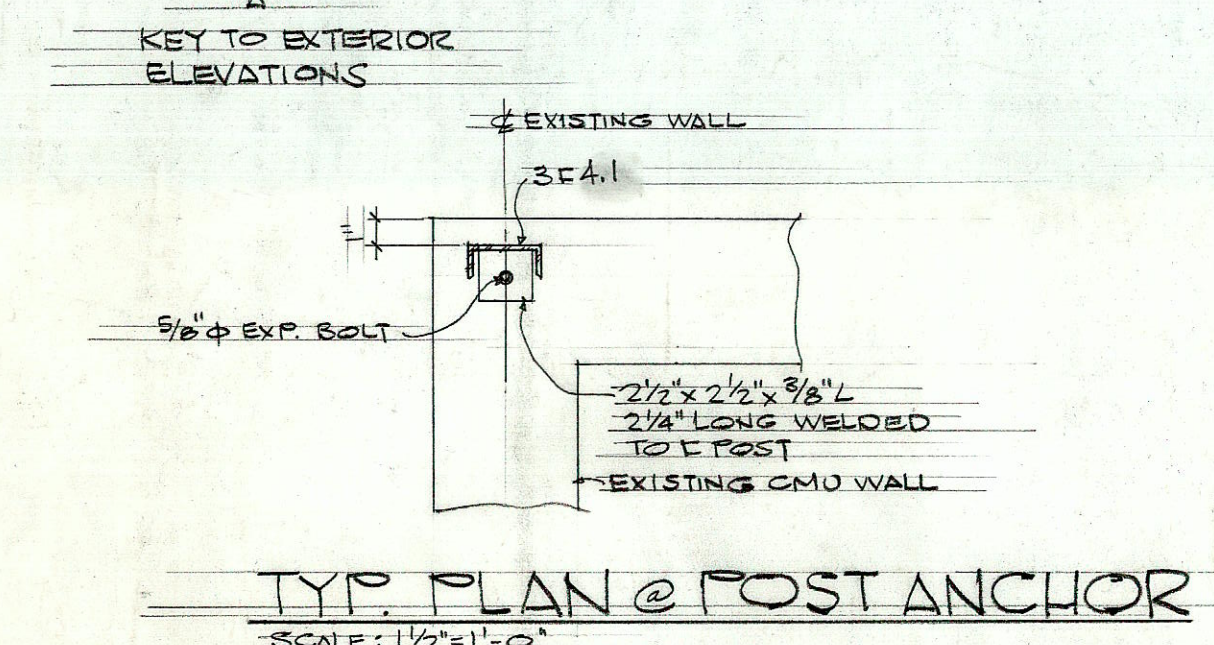
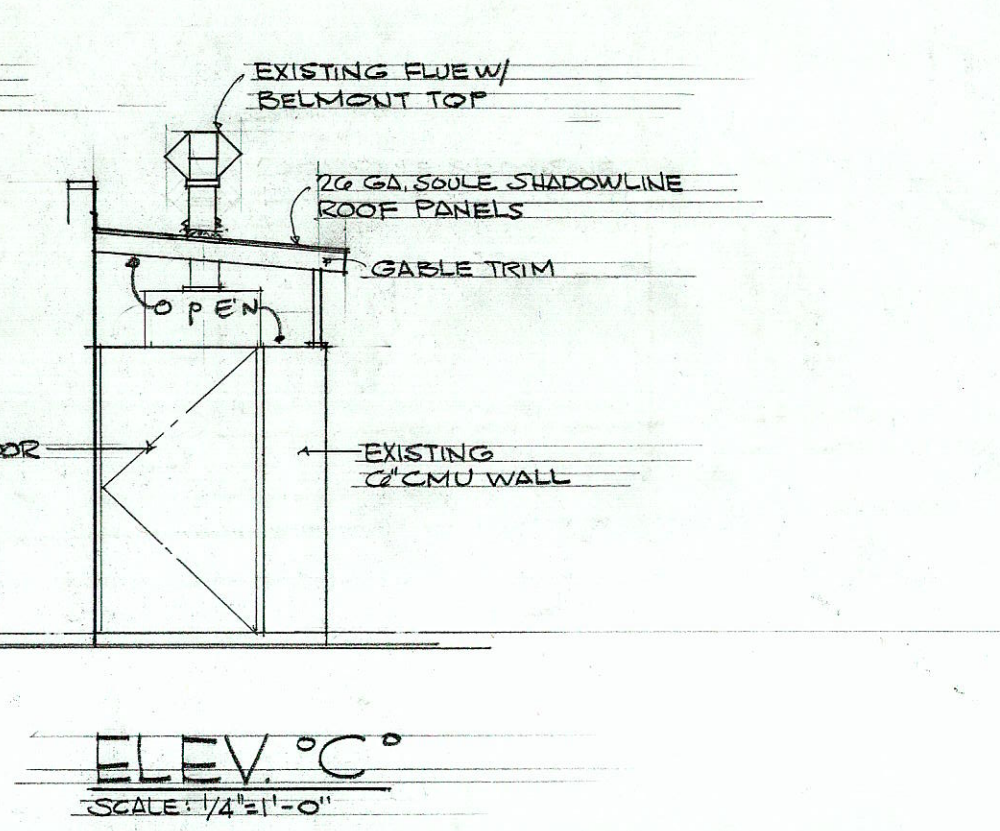
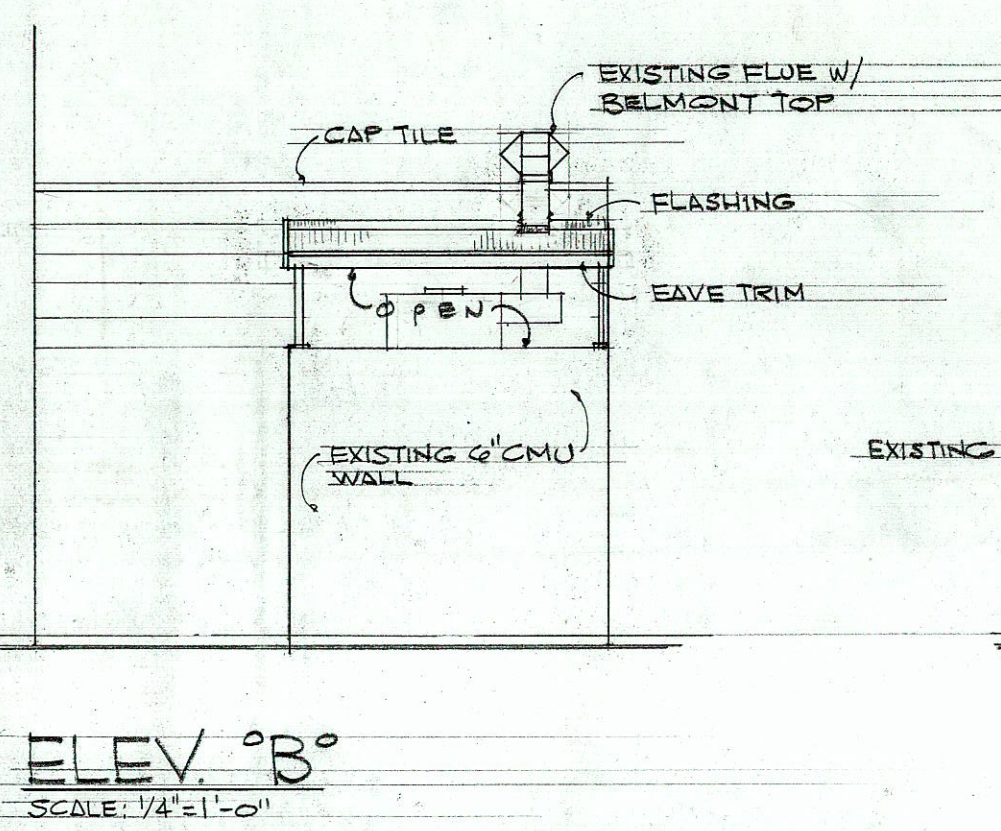
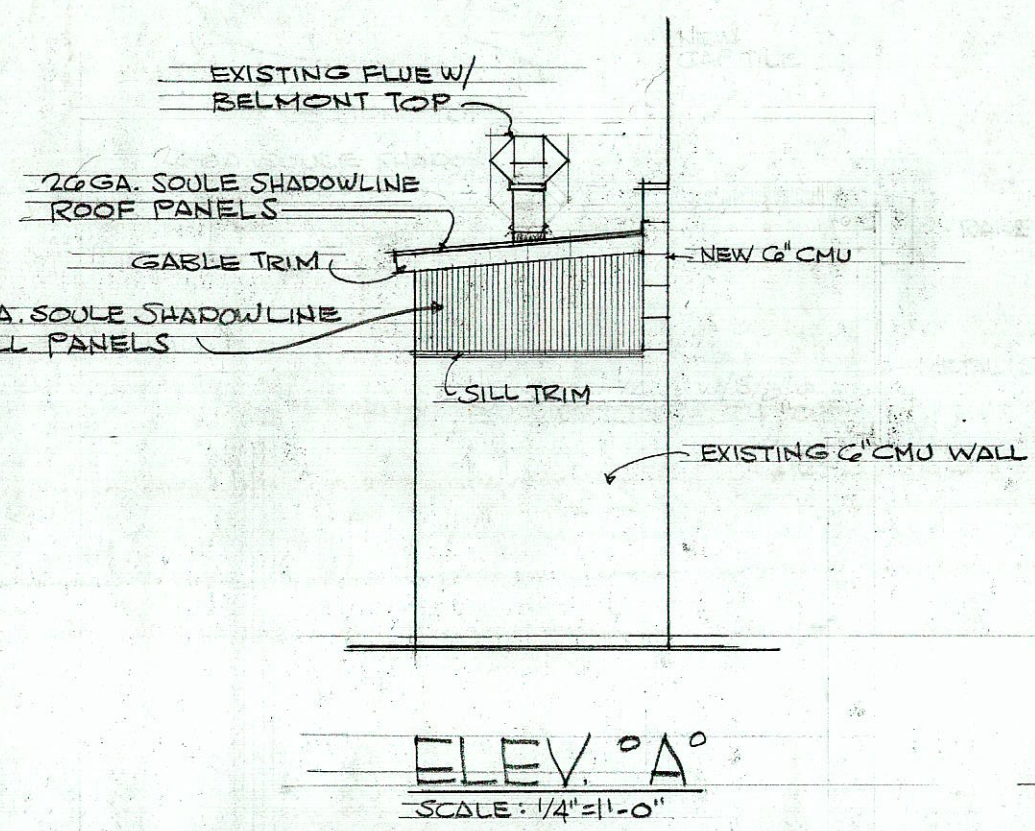
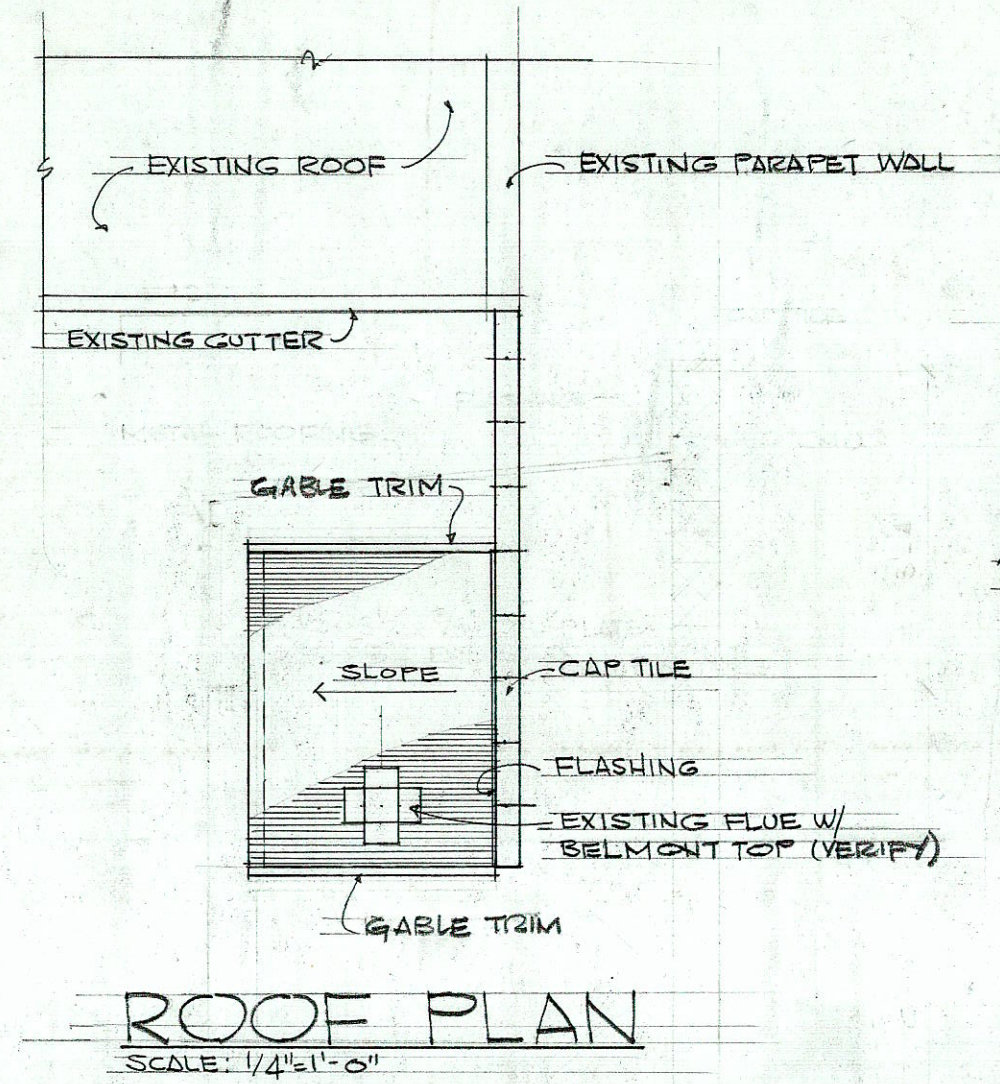
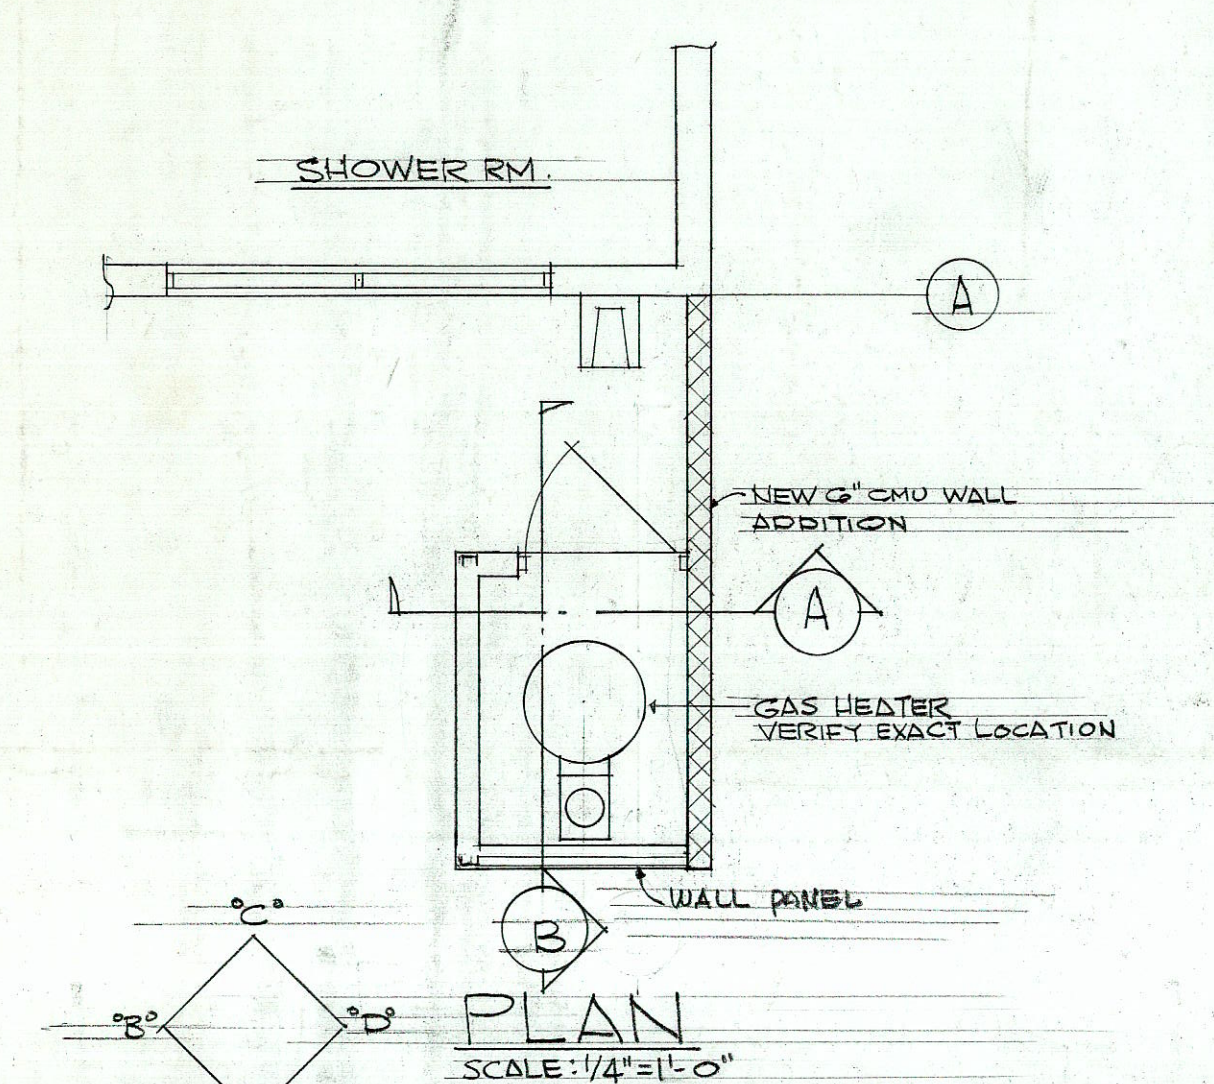


FED. ROAD DIST. NO.	STATE	FED. AID PROJ. NO.	FISCAL YEAR	SHEET NO.	TOTAL SHEETS
HAWAII	HAW.				

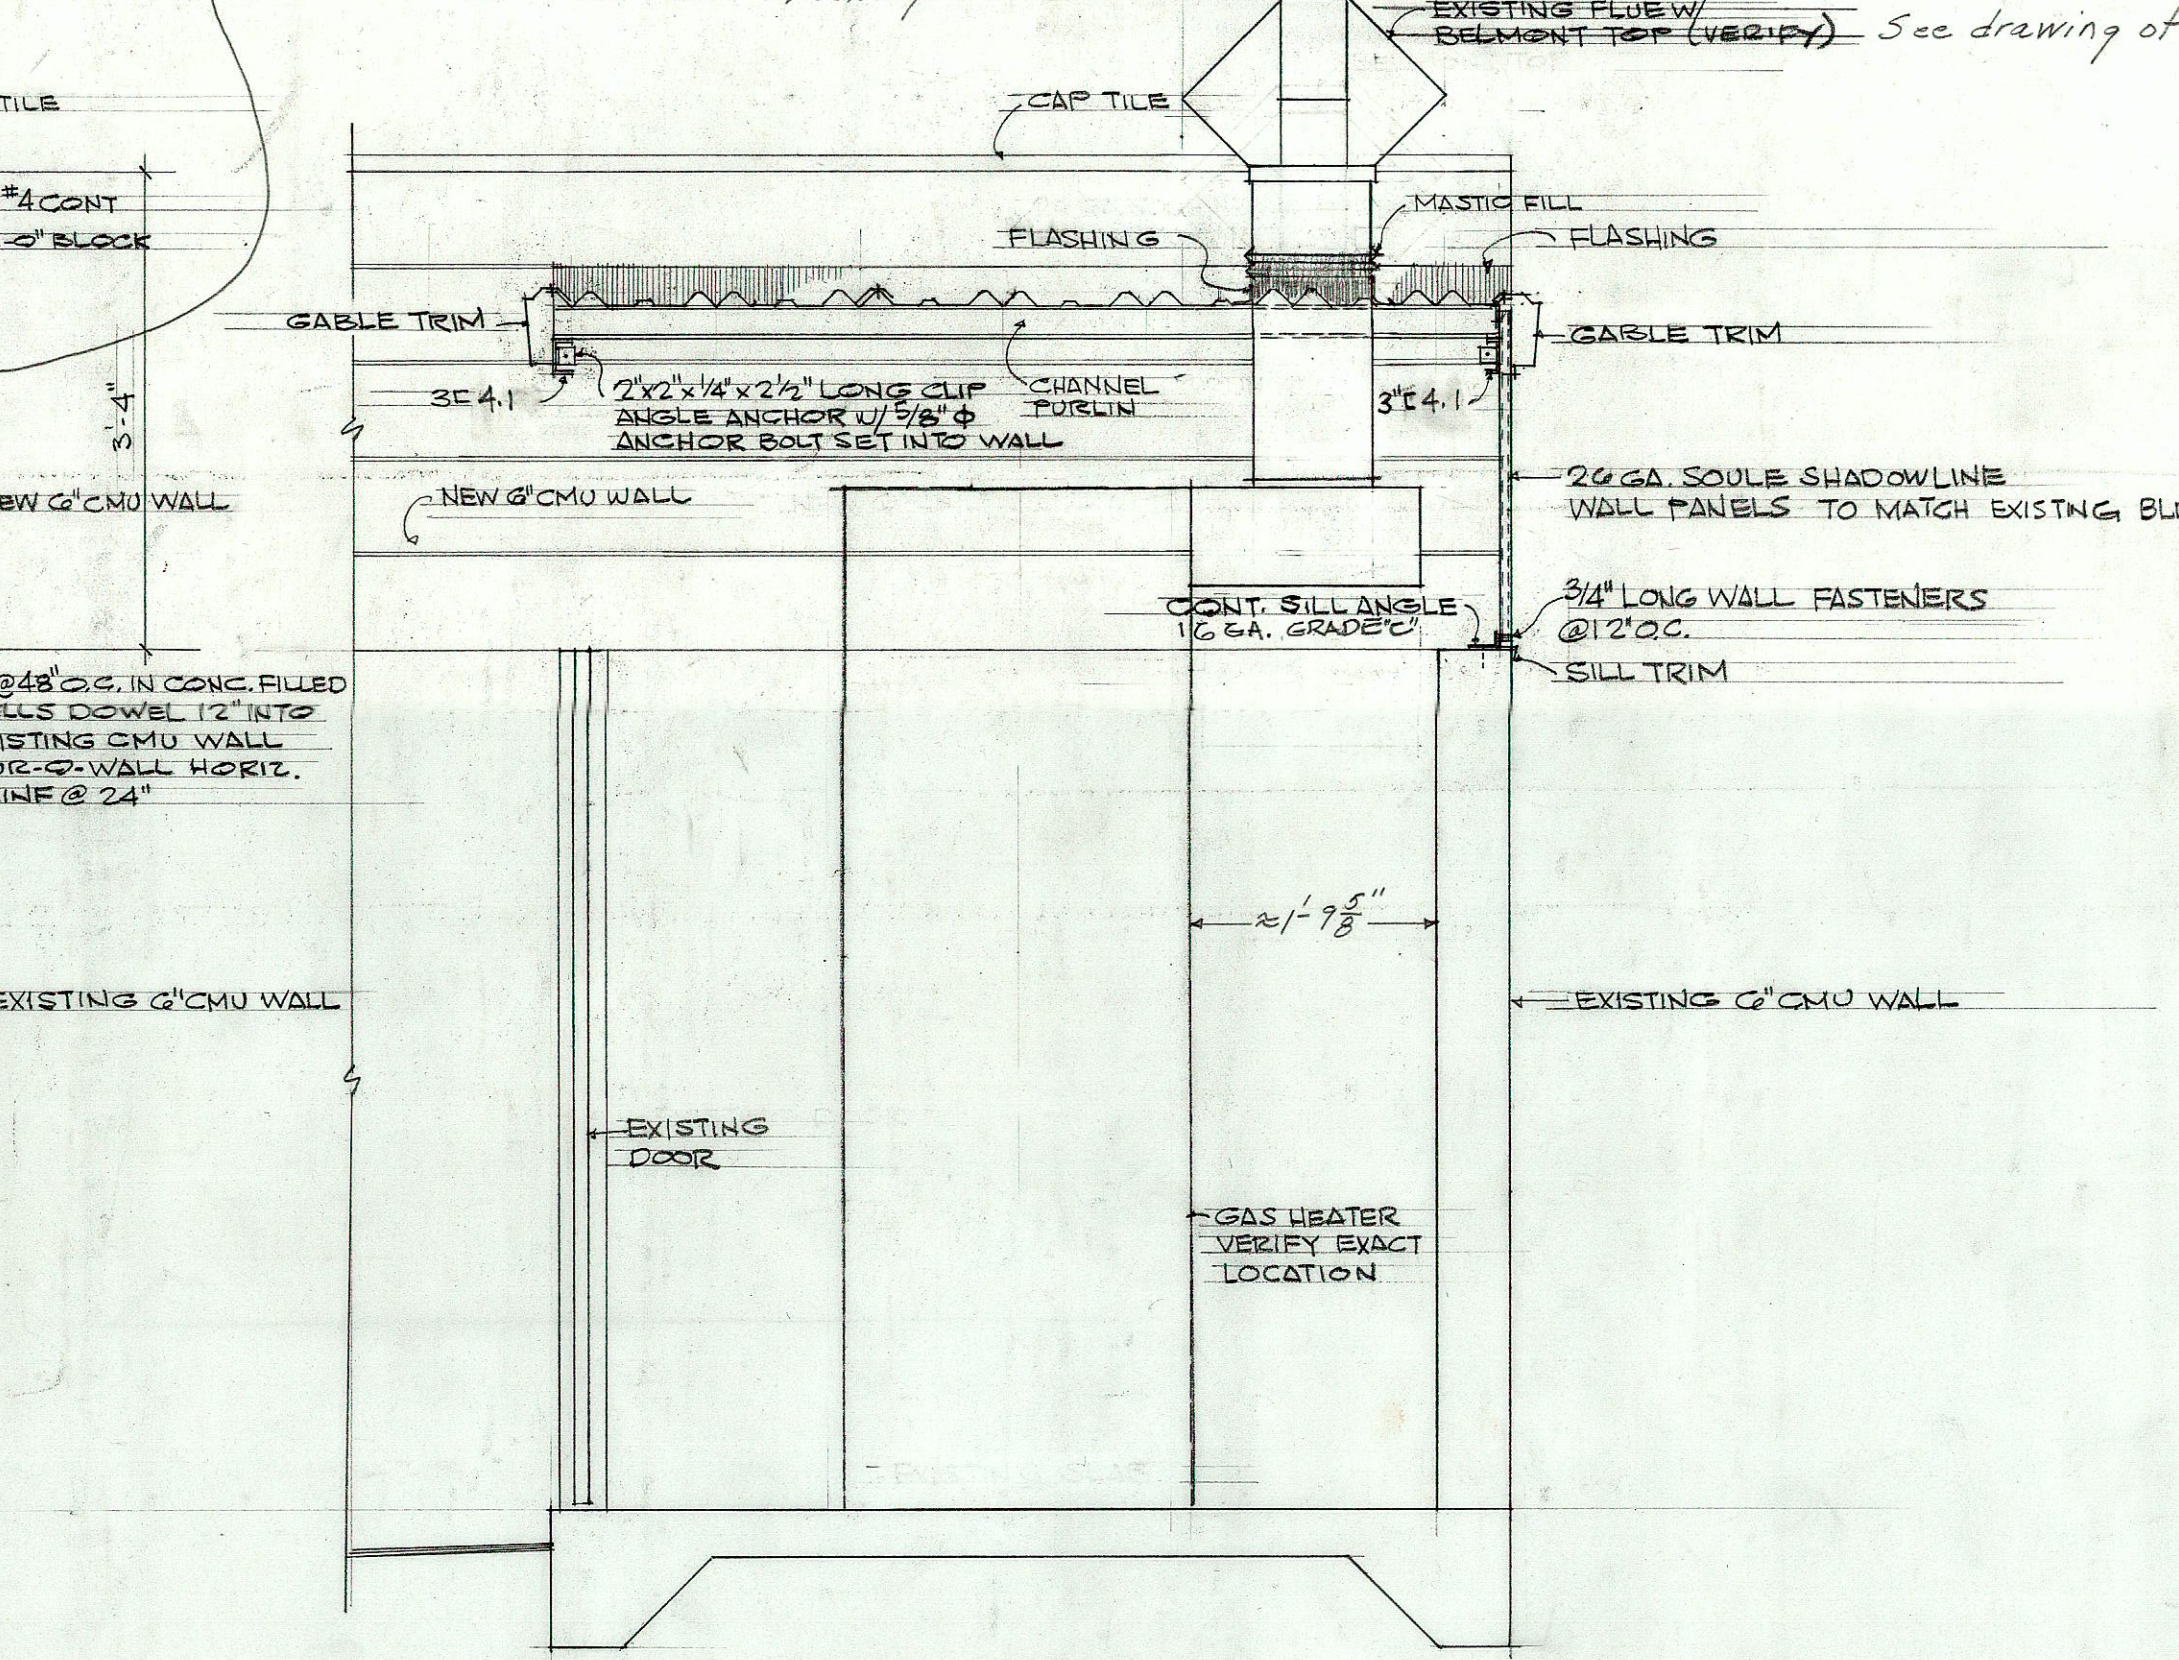

Note: Extend heater flue stack to fit roof and flashing. See drawing of existing heater.

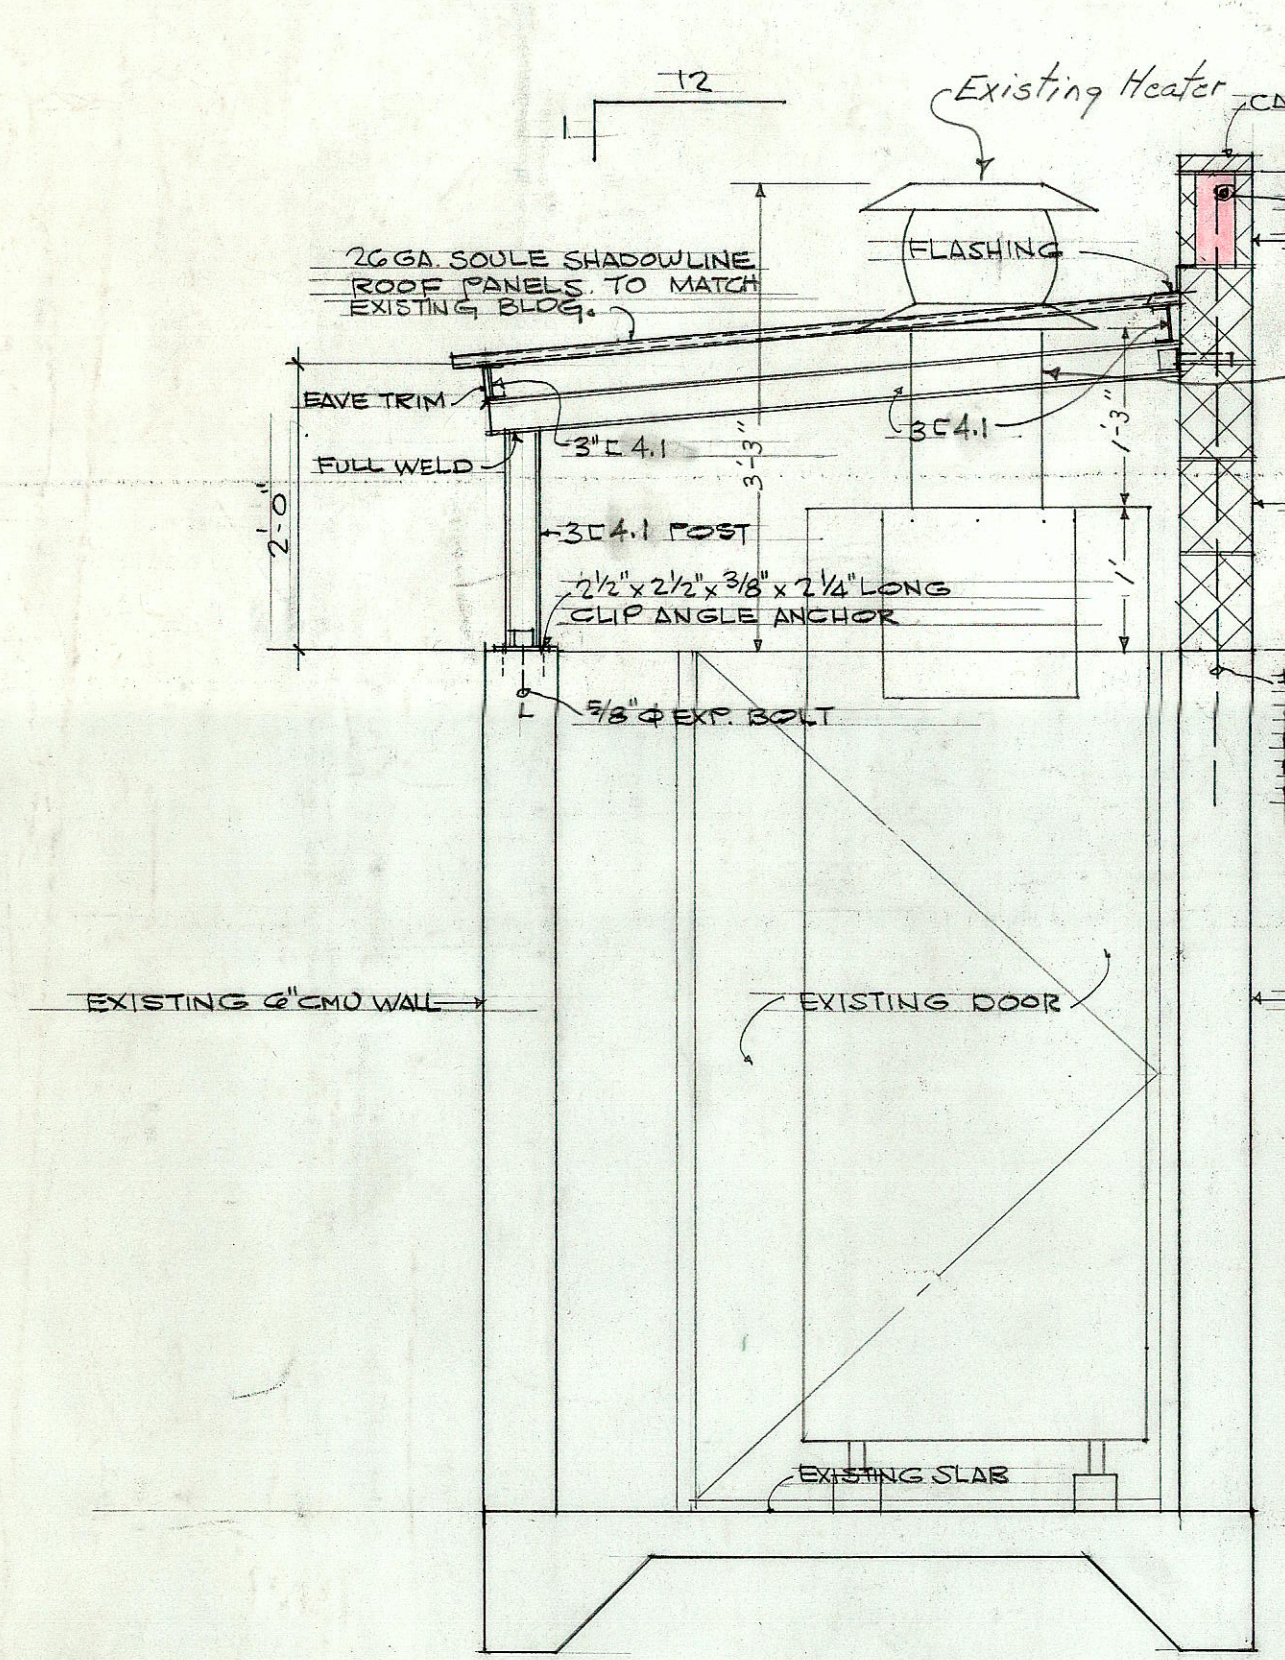

DATE	_____
DESIGNED BY	_____
CHECKED BY	_____
NOTED BY	_____
NO.	_____

POST CONTRACT DWG. NO. 1

STATE OF HAWAII
DEPARTMENT OF TRANSPORTATION
HIGHWAYS DIVISION

OAHU DISTRICT BASEYARD MAINTENANCE BUILDING
SHAPTER PLATS INDUSTRIAL DEVELOPEMENT
AT MOONALUA, HONOLULU, OAHU, HAWAII

EXISTING HEATER ENCLOSURE
ROOF ADDITION PLAN & DETAILS

HERBERT Y. MATSUMURA & ASSOCIATES, INC.
871 KAPOLANI BLVD. HONOLULU, HAWAII

SHEET No. | OF | SHEETS 12/18/72