



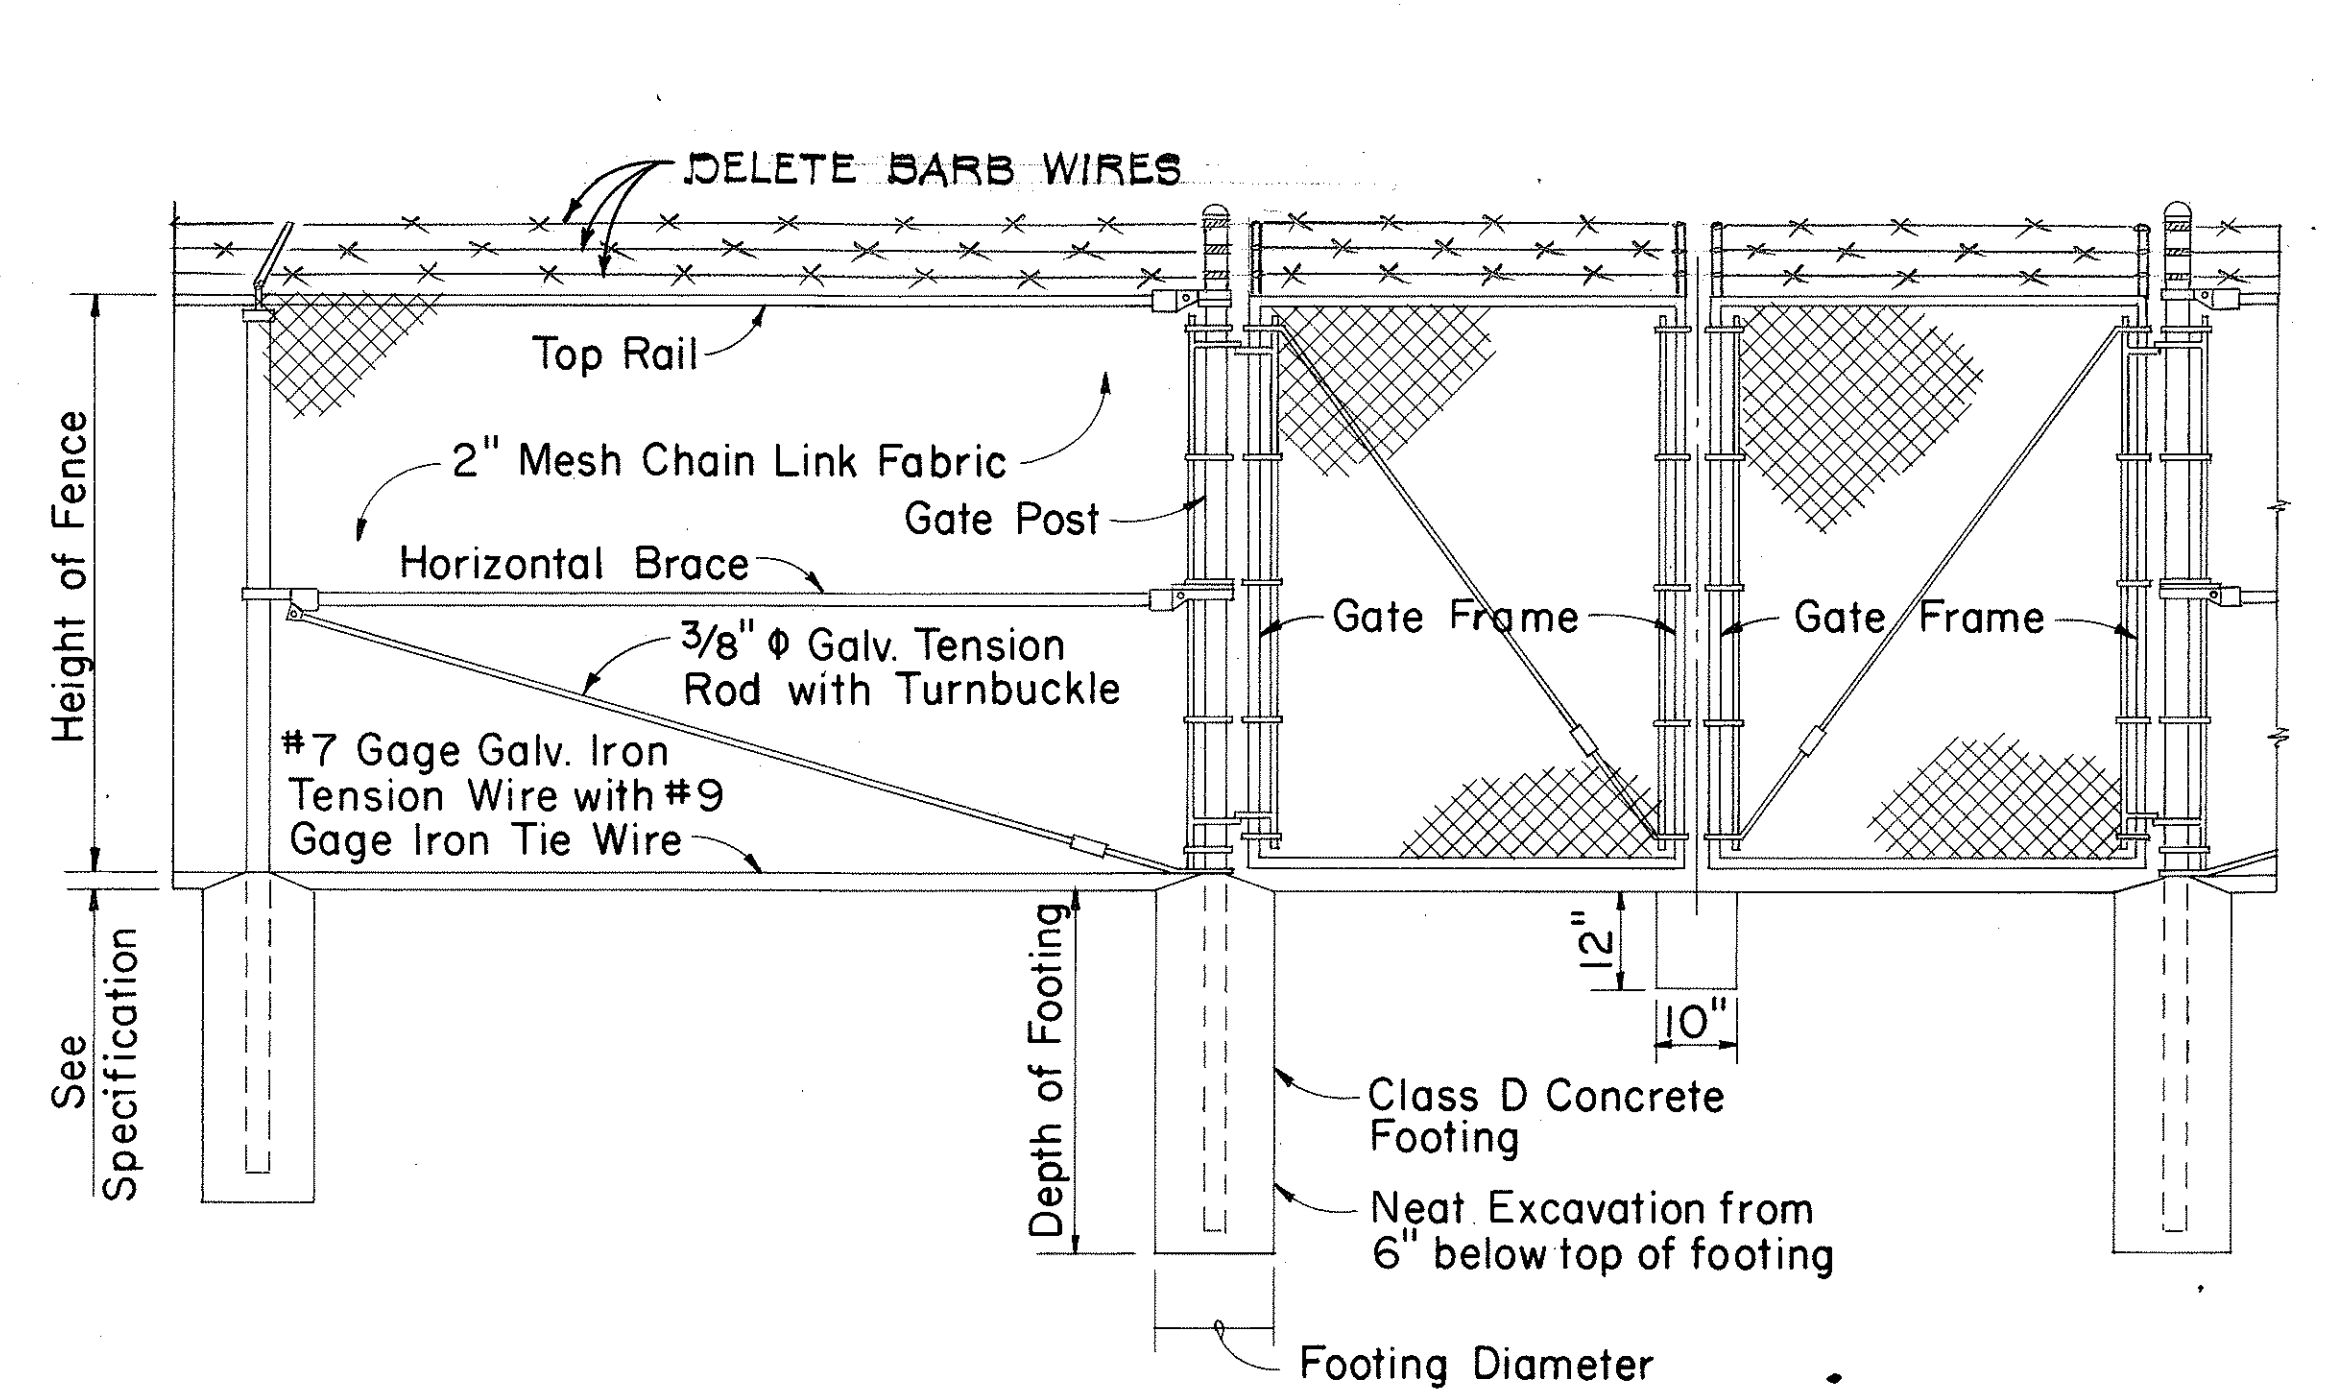

LINE POST GATE POST GATE POST


DETAIL OF CHAIN LINK GATE

- NOTE: 1. Gate fork latch and lock, flush plate and anchor, and plunger shall be installed with Gates, and shall be considered as incidental to Chain Link Fence Gate.
 2. Gate frames shall be mitered and welded at corners.
 3. Fence detail not shown shall be in accordance with the Standard Specifications.

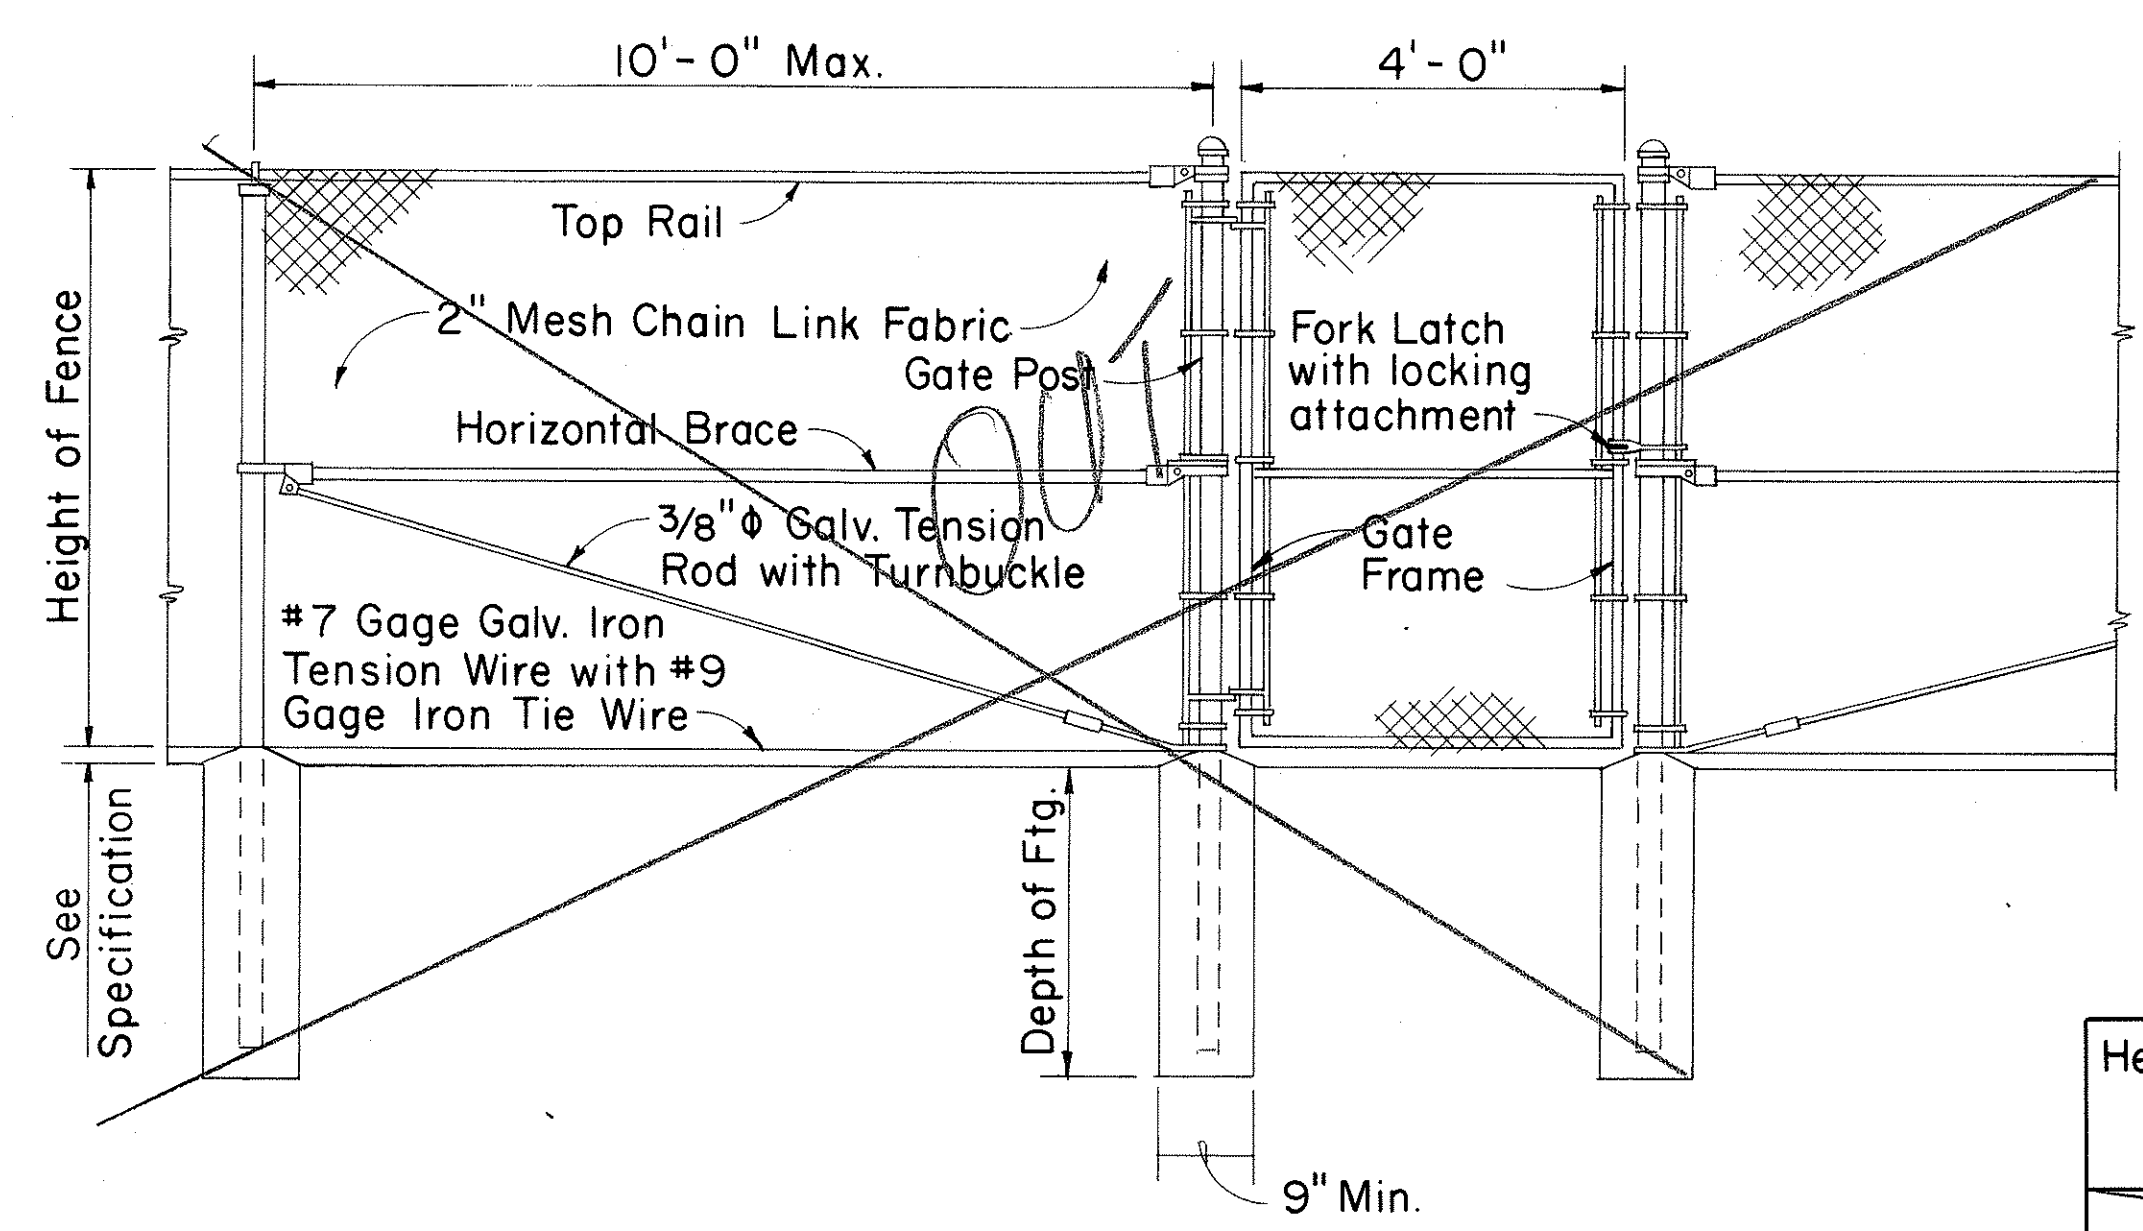


LINE POST GATE POST GATE POST

DETAIL OF 4 FT. CHAIN LINK GATE

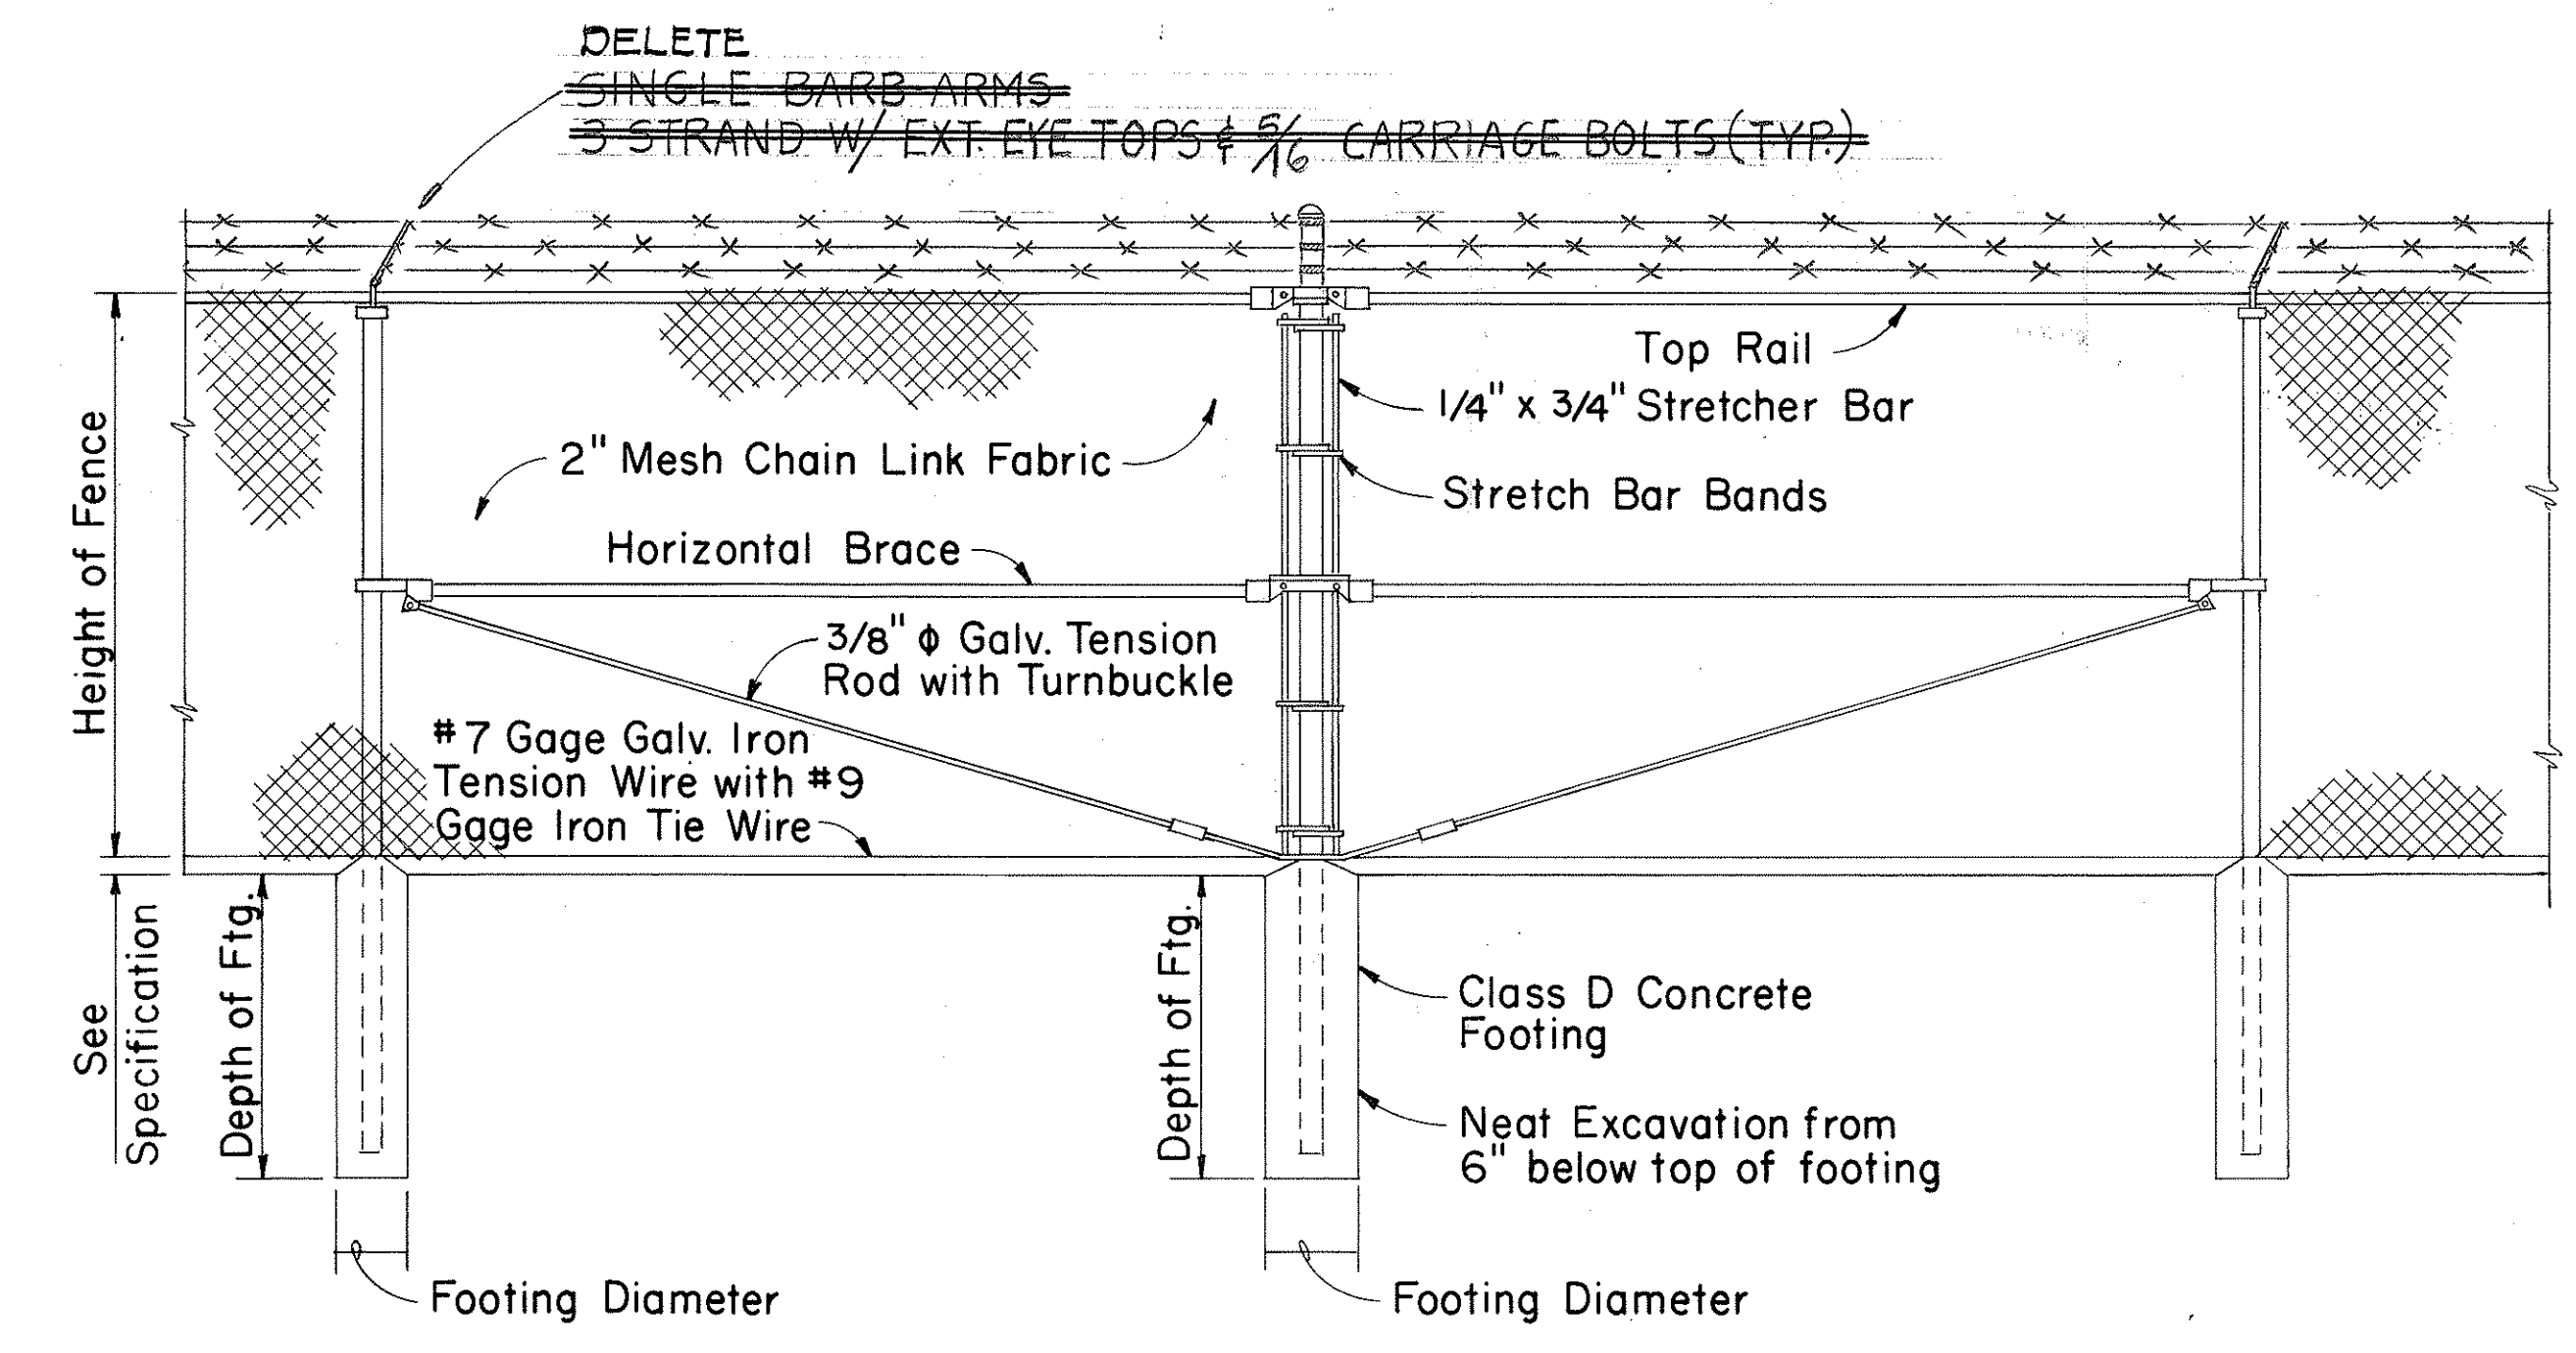


LINE POST PULL POST LINE POST

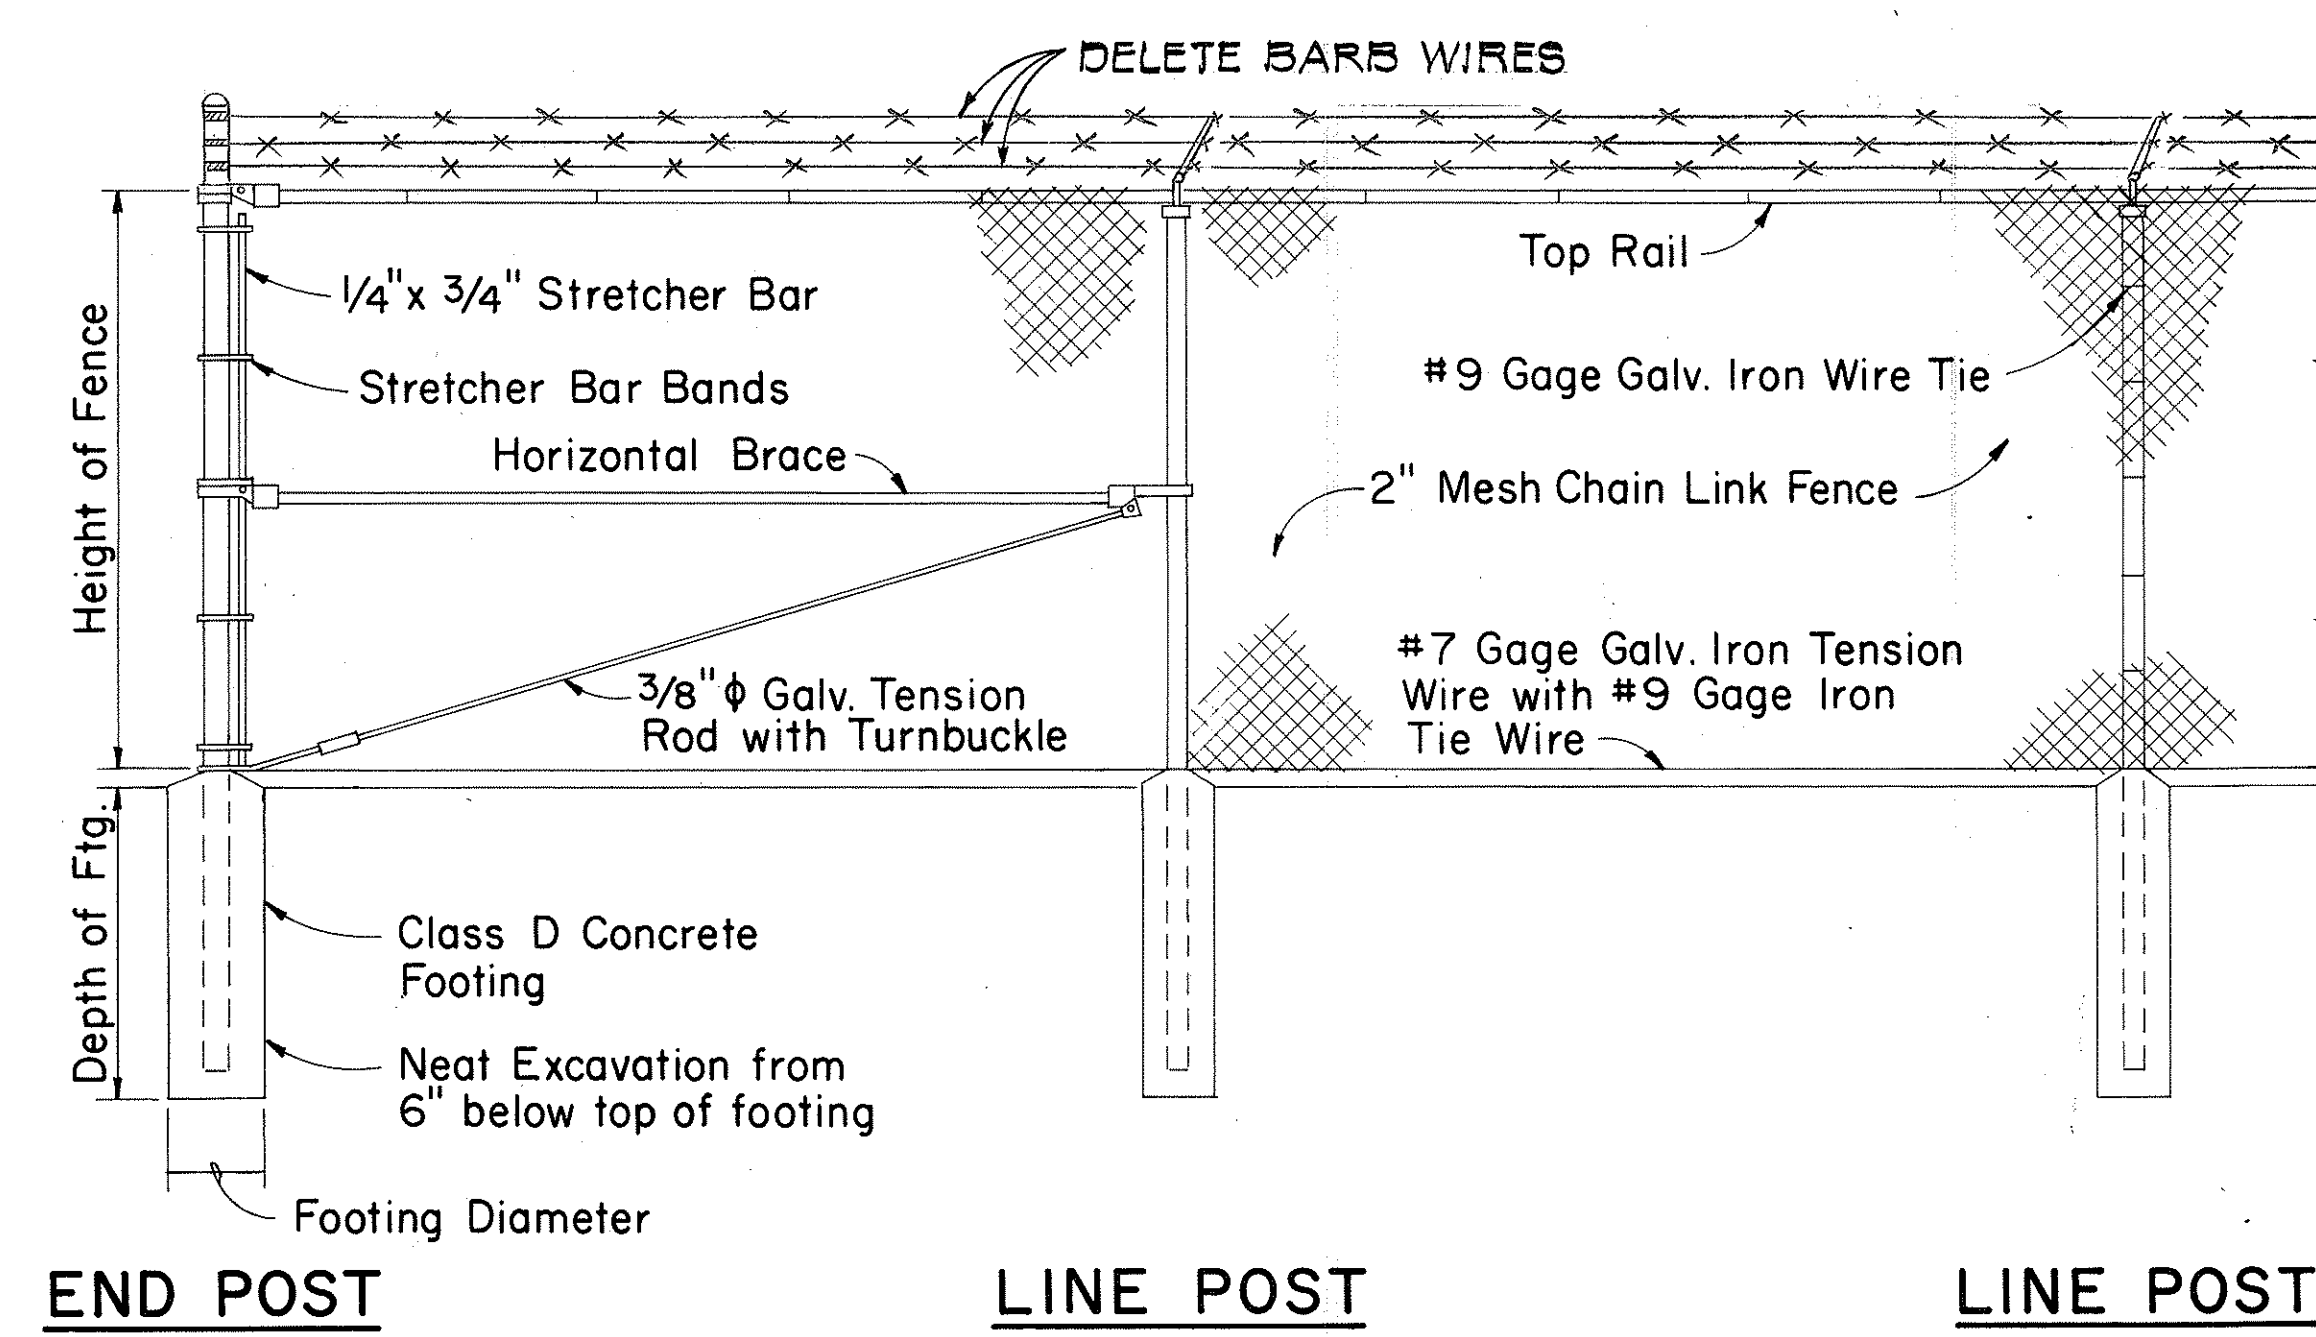


END POST LINE POST LINE POST

CHAIN LINK FENCE DETAILS

Height of Fence	Minimum Depth of Footing		Minimum Footing Diameter	
	Line Post	Corner, Pull, End and Gate Posts	Line Post	Corner, Pull and End Posts
3'	2'-0"	2'-6"	8"	8"
4'	2'-6"	2'-6"	8"	8"
5'	3'-0"	3'-0"	8"	8"
6'	3'-0"	3'-0"	8"	9"

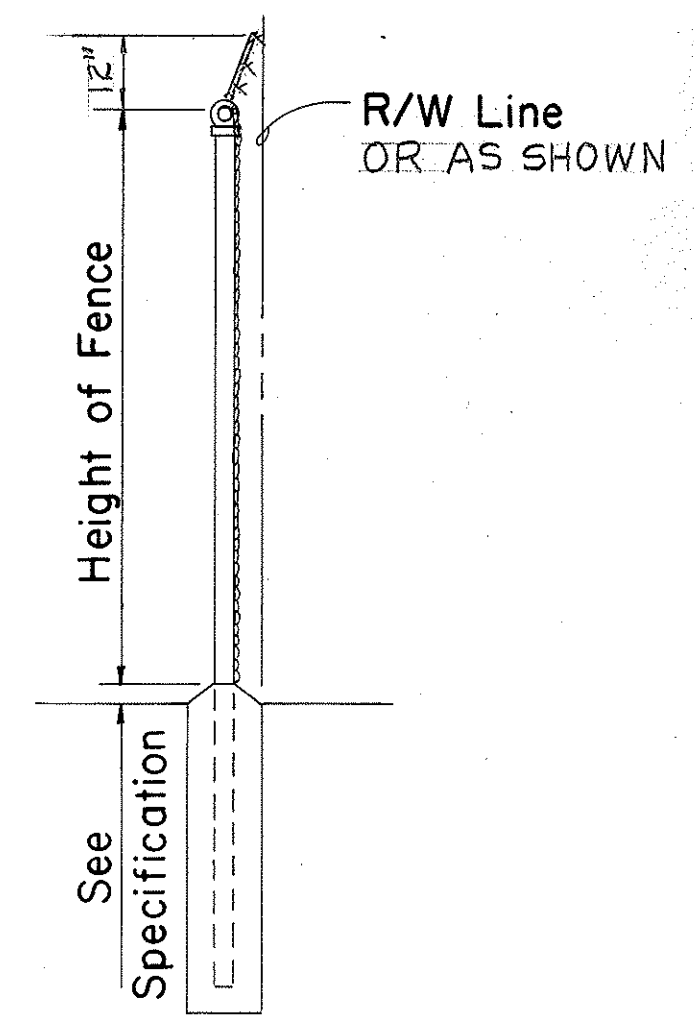

TYPICAL SECTION
(WITH CONCRETE FOOTING)

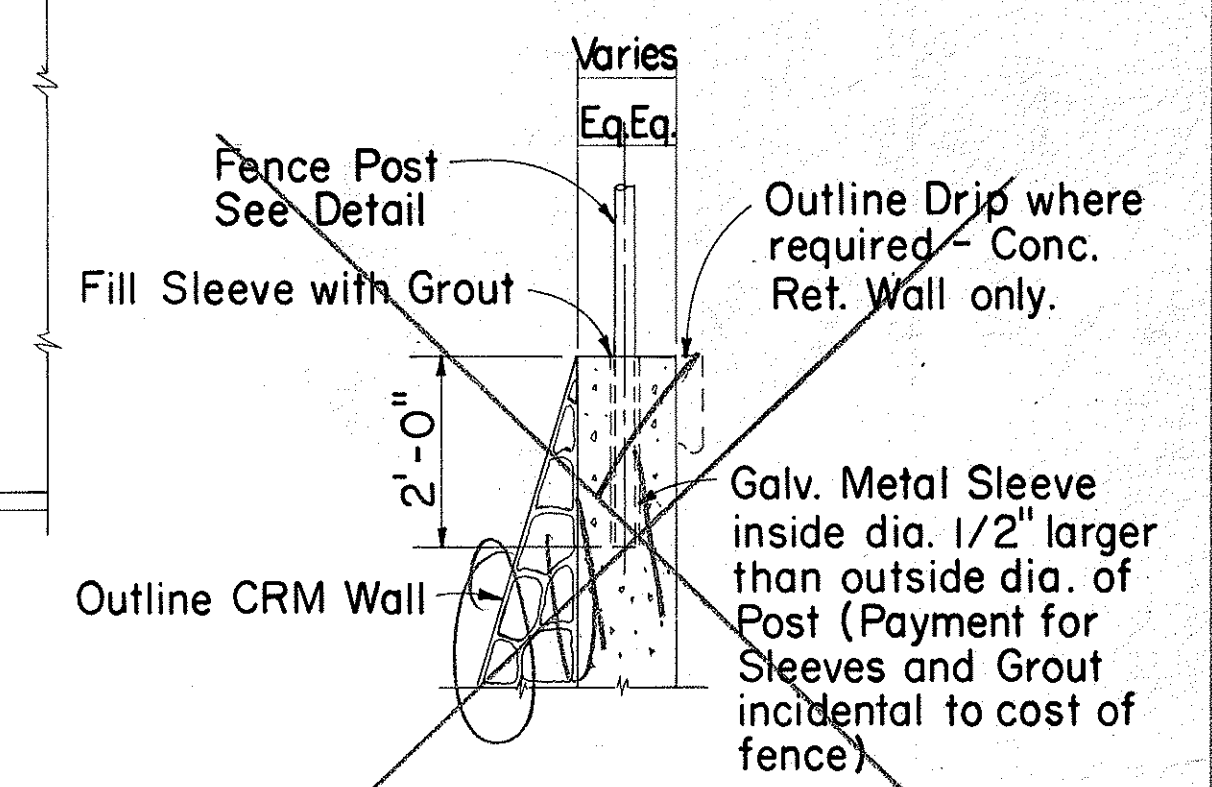

TYPICAL SECTION
(ON CRM & CONC. RET. WALL)

APPROVAL, RECOMMENDED: *M. H. Hagan* 12-4-69
 HIGHWAY DESIGN ENGINEER DATE

APPROVED: *Charles R. Bode* 12-10-69
 ASSISTANT CHIEF, ENGINEERING DATE

NO.	REVISION	APPROVED BY	DATE

STATE OF HAWAII
 DEPARTMENT OF TRANSPORTATION
 HIGHWAYS DIVISION

STANDARD DETAILS
 CHAIN LINK FENCE
 (WITH TOPRAIL)
 KANEHOE BASEYARD FACILITY
 Scale: 1/2" = 1'-0" Date:

ORIGINAL PLAN
 SURVEY PLOTTED BY:
 DATE:
 DRAWN BY:
 DESIGNED BY:
 QUANTITIES BY:
 CHECKED BY:
 No.