




FED. ROAD DIST. NO.	STATE	FED. AID PROJ. NO.	FISCAL YEAR	SHEET NO.	TOTAL SHEETS
HAWAII	HAW.		70	4	6

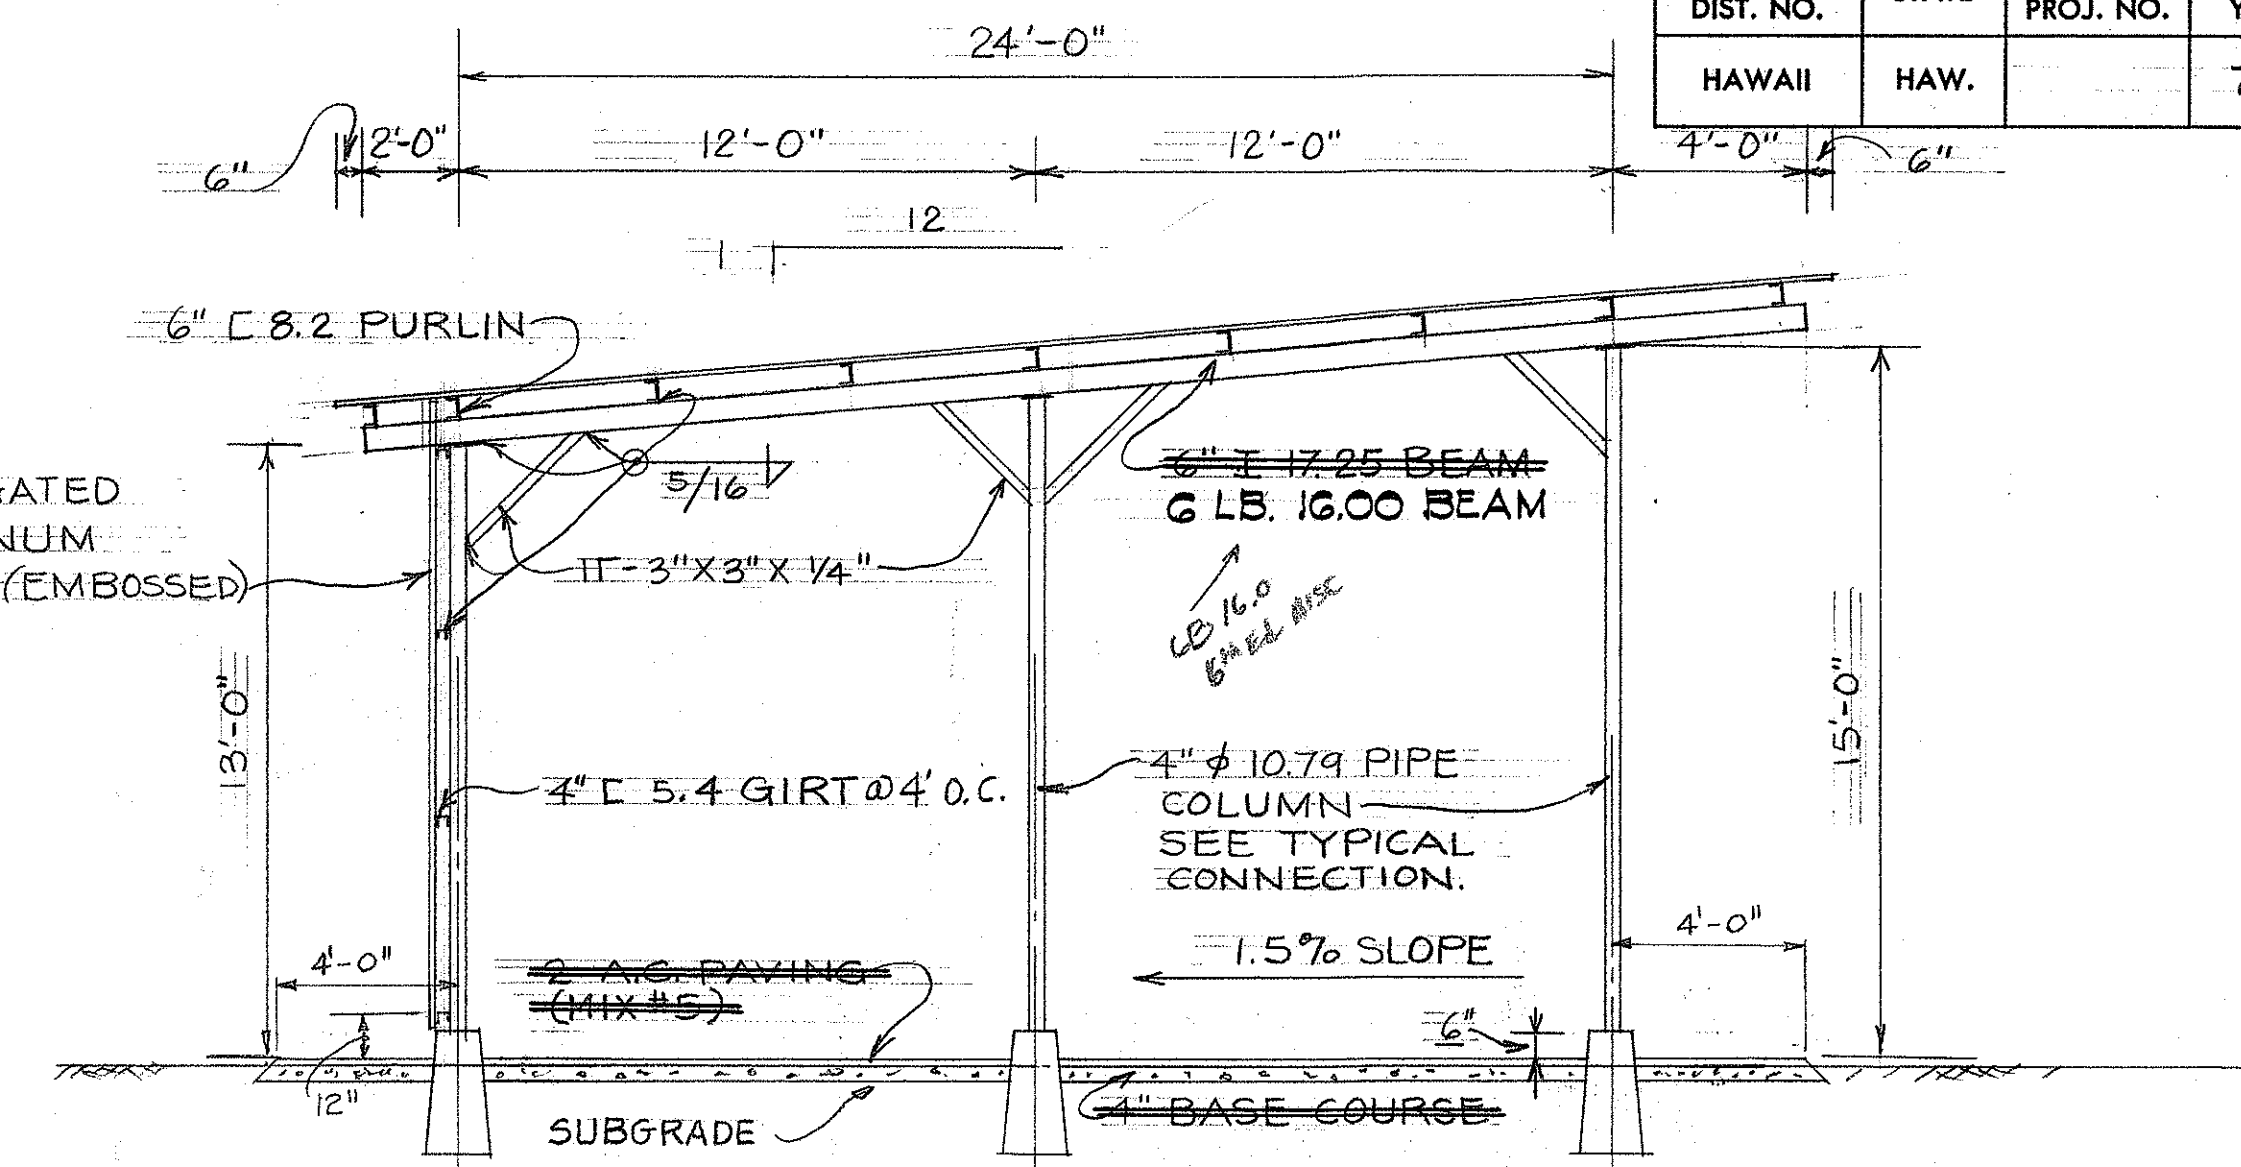


CROSS SECTION A
SCALE: 1/4" = 1'-0"

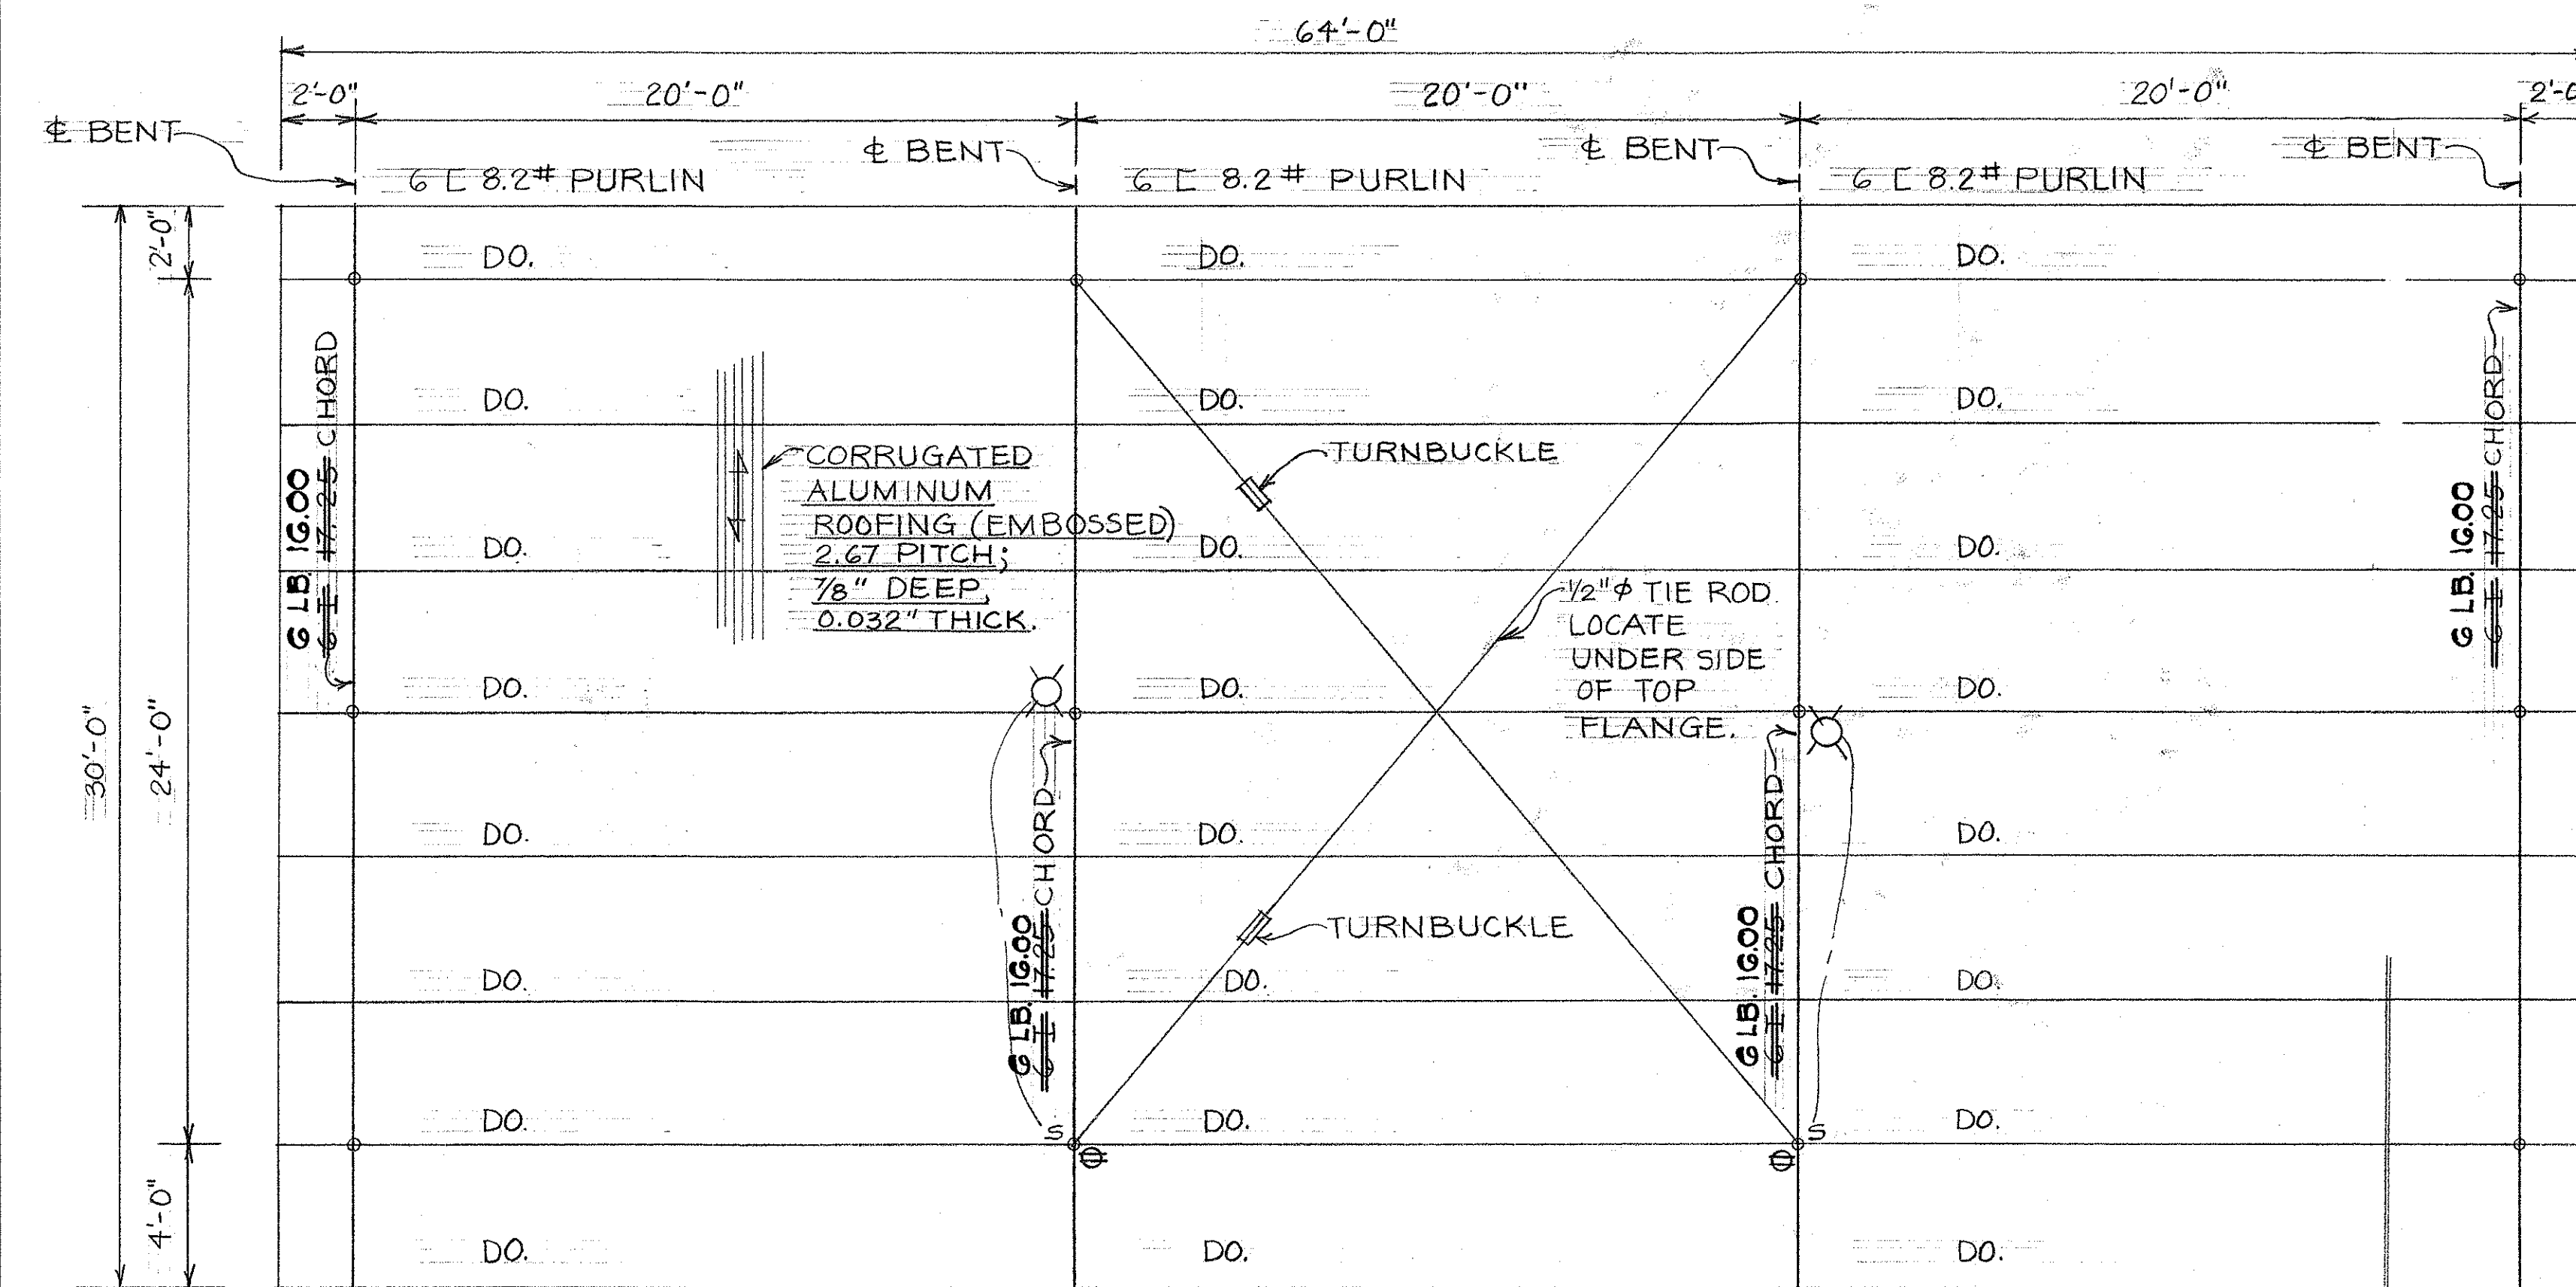

ROOF FRAMING PLAN SCALE: 1/4" = 1'-0"

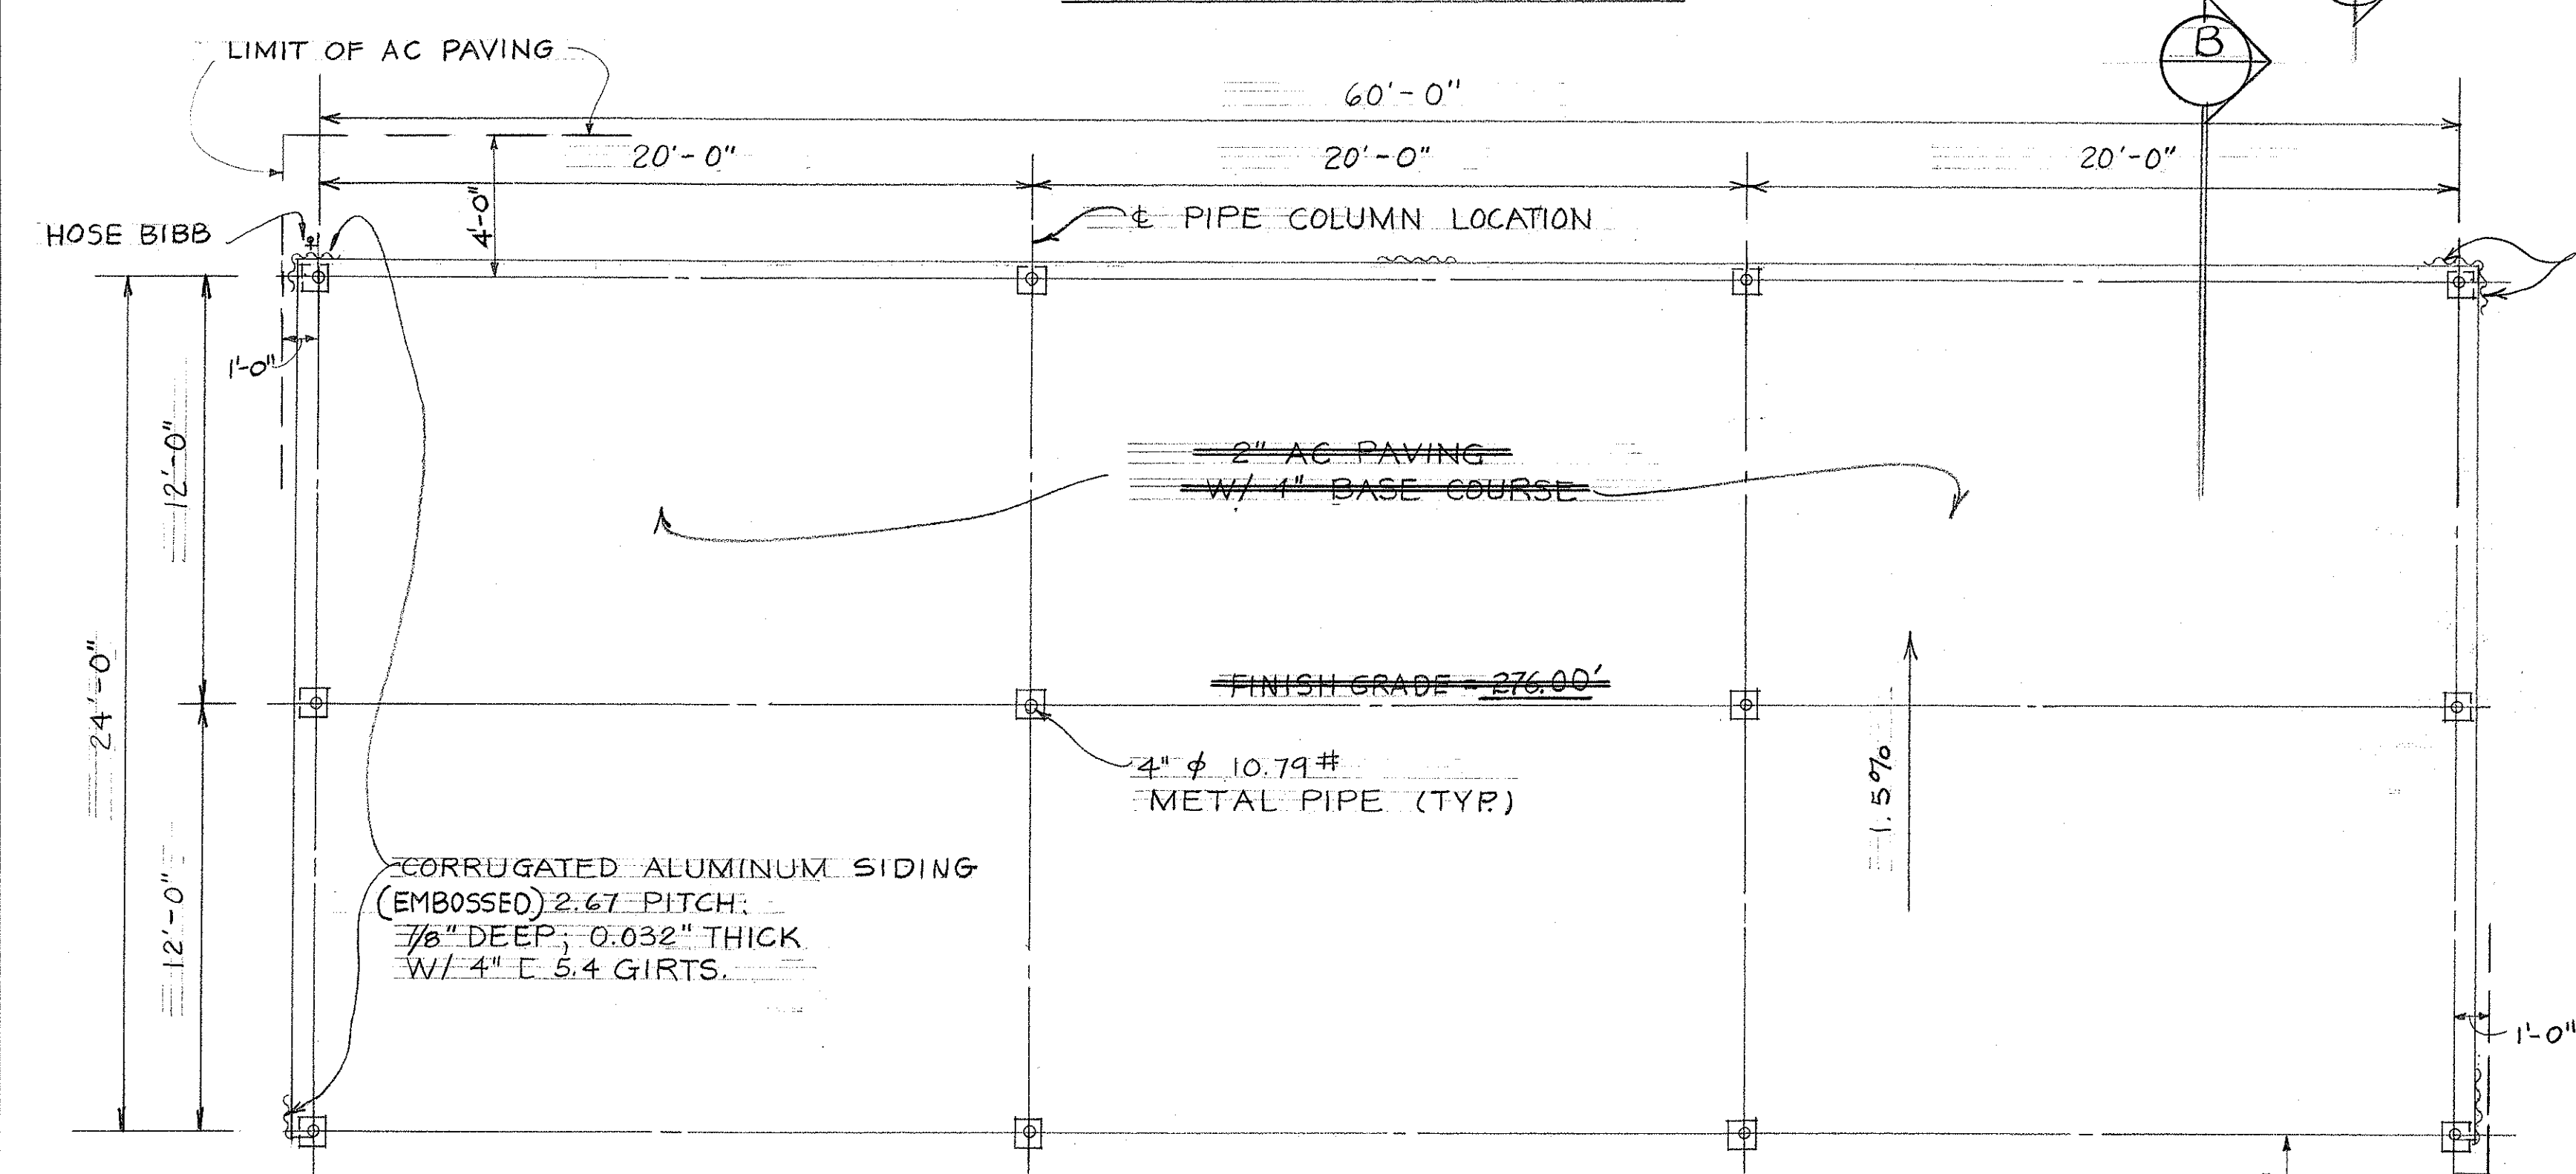

FOUNDATION PLAN
SCALE: 1/4" = 1'-0"

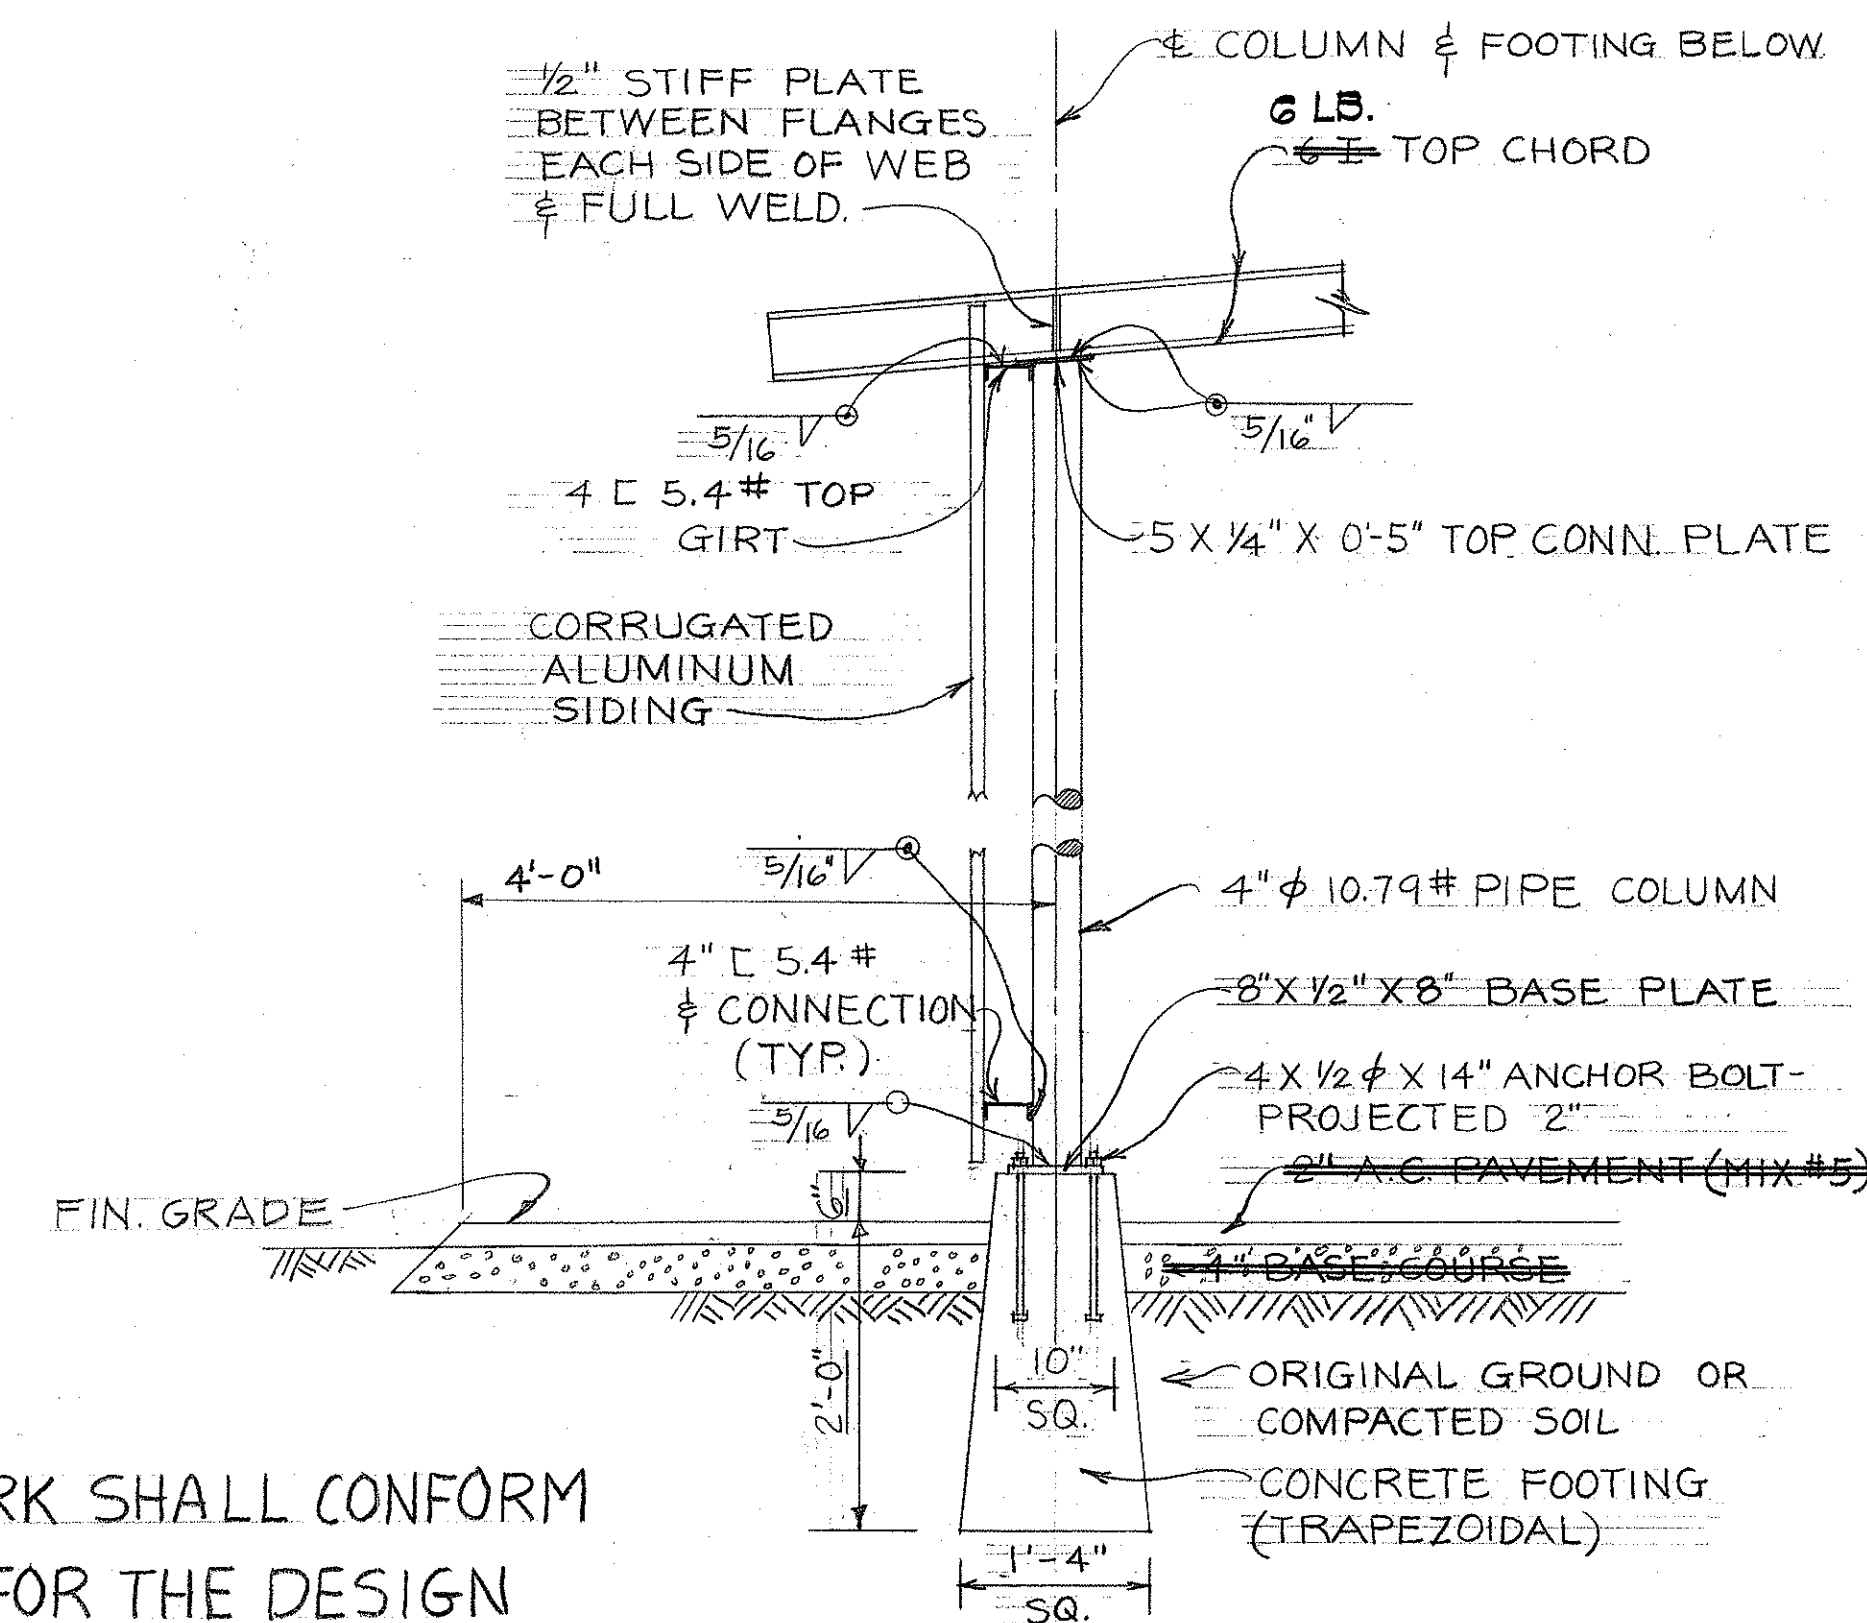

TYPICAL COLUMN DETAILS B
SCALE: 3/4" = 1'-0"

- GENERAL NOTES
- ① ALL STRUCTURAL STEEL WORK SHALL CONFORM TO AISC SPECIFICATION FOR THE DESIGN FABRICATION AND ERECTION OF STRUCTURAL STEEL FOR BUILDINGS
 - ② STRUCTURAL STEEL SHALL BE A-36
 - ③ FOOTING CONCRETE AT 28 DAYS $f'_c = 3000$ PSI

STATE OF HAWAII
DEPARTMENT OF TRANSPORTATION
HIGHWAYS DIVISION


STORAGE SHED FRAMING
KANEHOE BASEYARD FACILITY

PROJ.# SD 68-313

SHEET No. 4 OF 6 SHEETS

DATE	SURVEY PLOTTED BY
NO.	ORIGINAL PLAN
DESIGNED BY	NOTED BY
CHECKED BY	QUANTITIES BY

FED. ROAD DIST. NO.	STATE	FED. AID PROJ. NO.	FISCAL YEAR	SHEET NO.	TOTAL SHEETS
HAWAII	HAW.		70	5	6

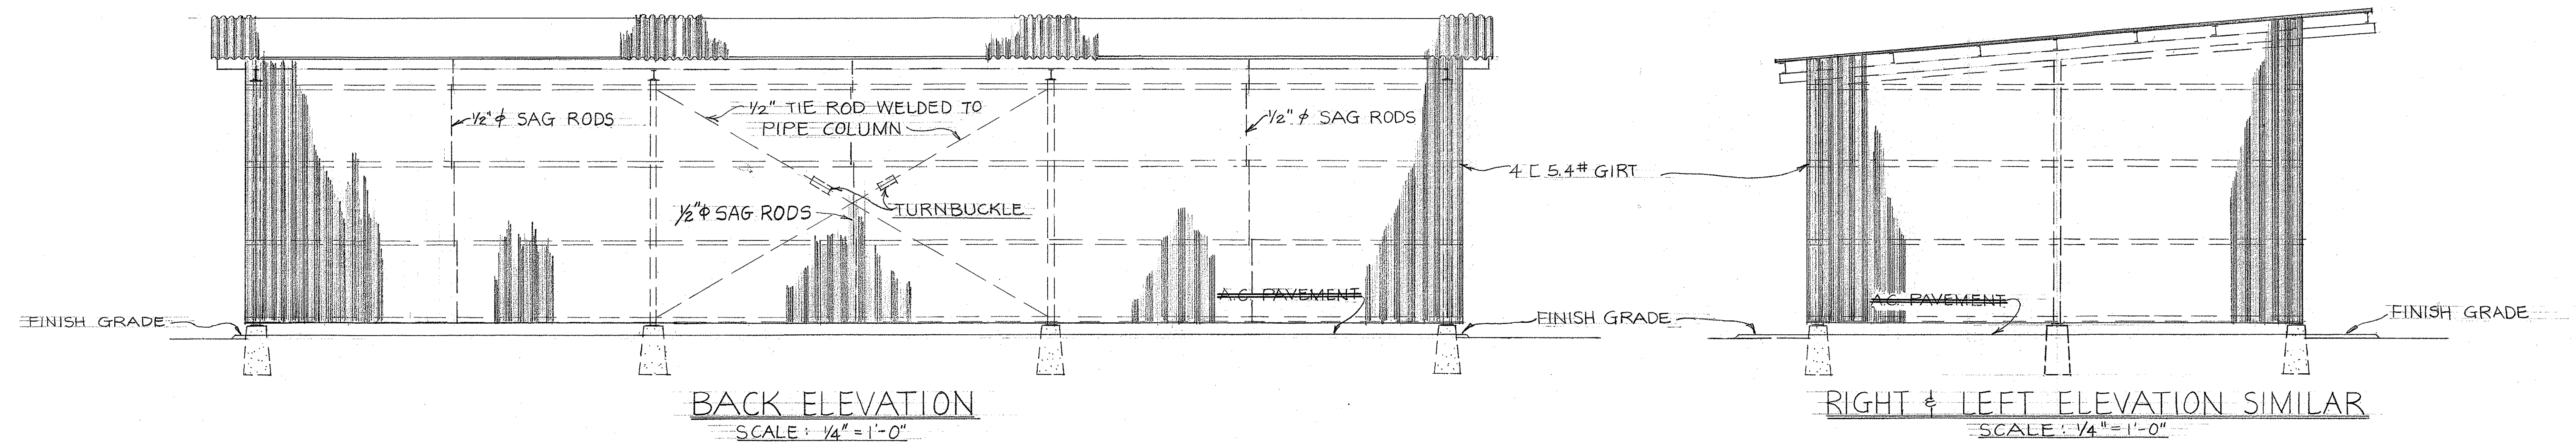

ORIGINAL PLAN	SURVEY PLOTTED BY	DATE
NOTE BOOK	DESIGNED BY	
No.	QUANTITIES BY	
	CHECKED BY	

STATE OF HAWAII
DEPARTMENT OF TRANSPORTATION
HIGHWAYS DIVISION

STORAGE SHED ELEVATION

KANEOHE BASEYARD FACILITY

PROJ # SD 68-313

SHEET No. 5 OF 6 SHEETS