



FED. ROAD DIST. NO.	STATE	FED. AID PROJ. NO.	FISCAL YEAR	SHEET NO.	TOTAL SHEETS
HAWAII	HAW.		70	4	5

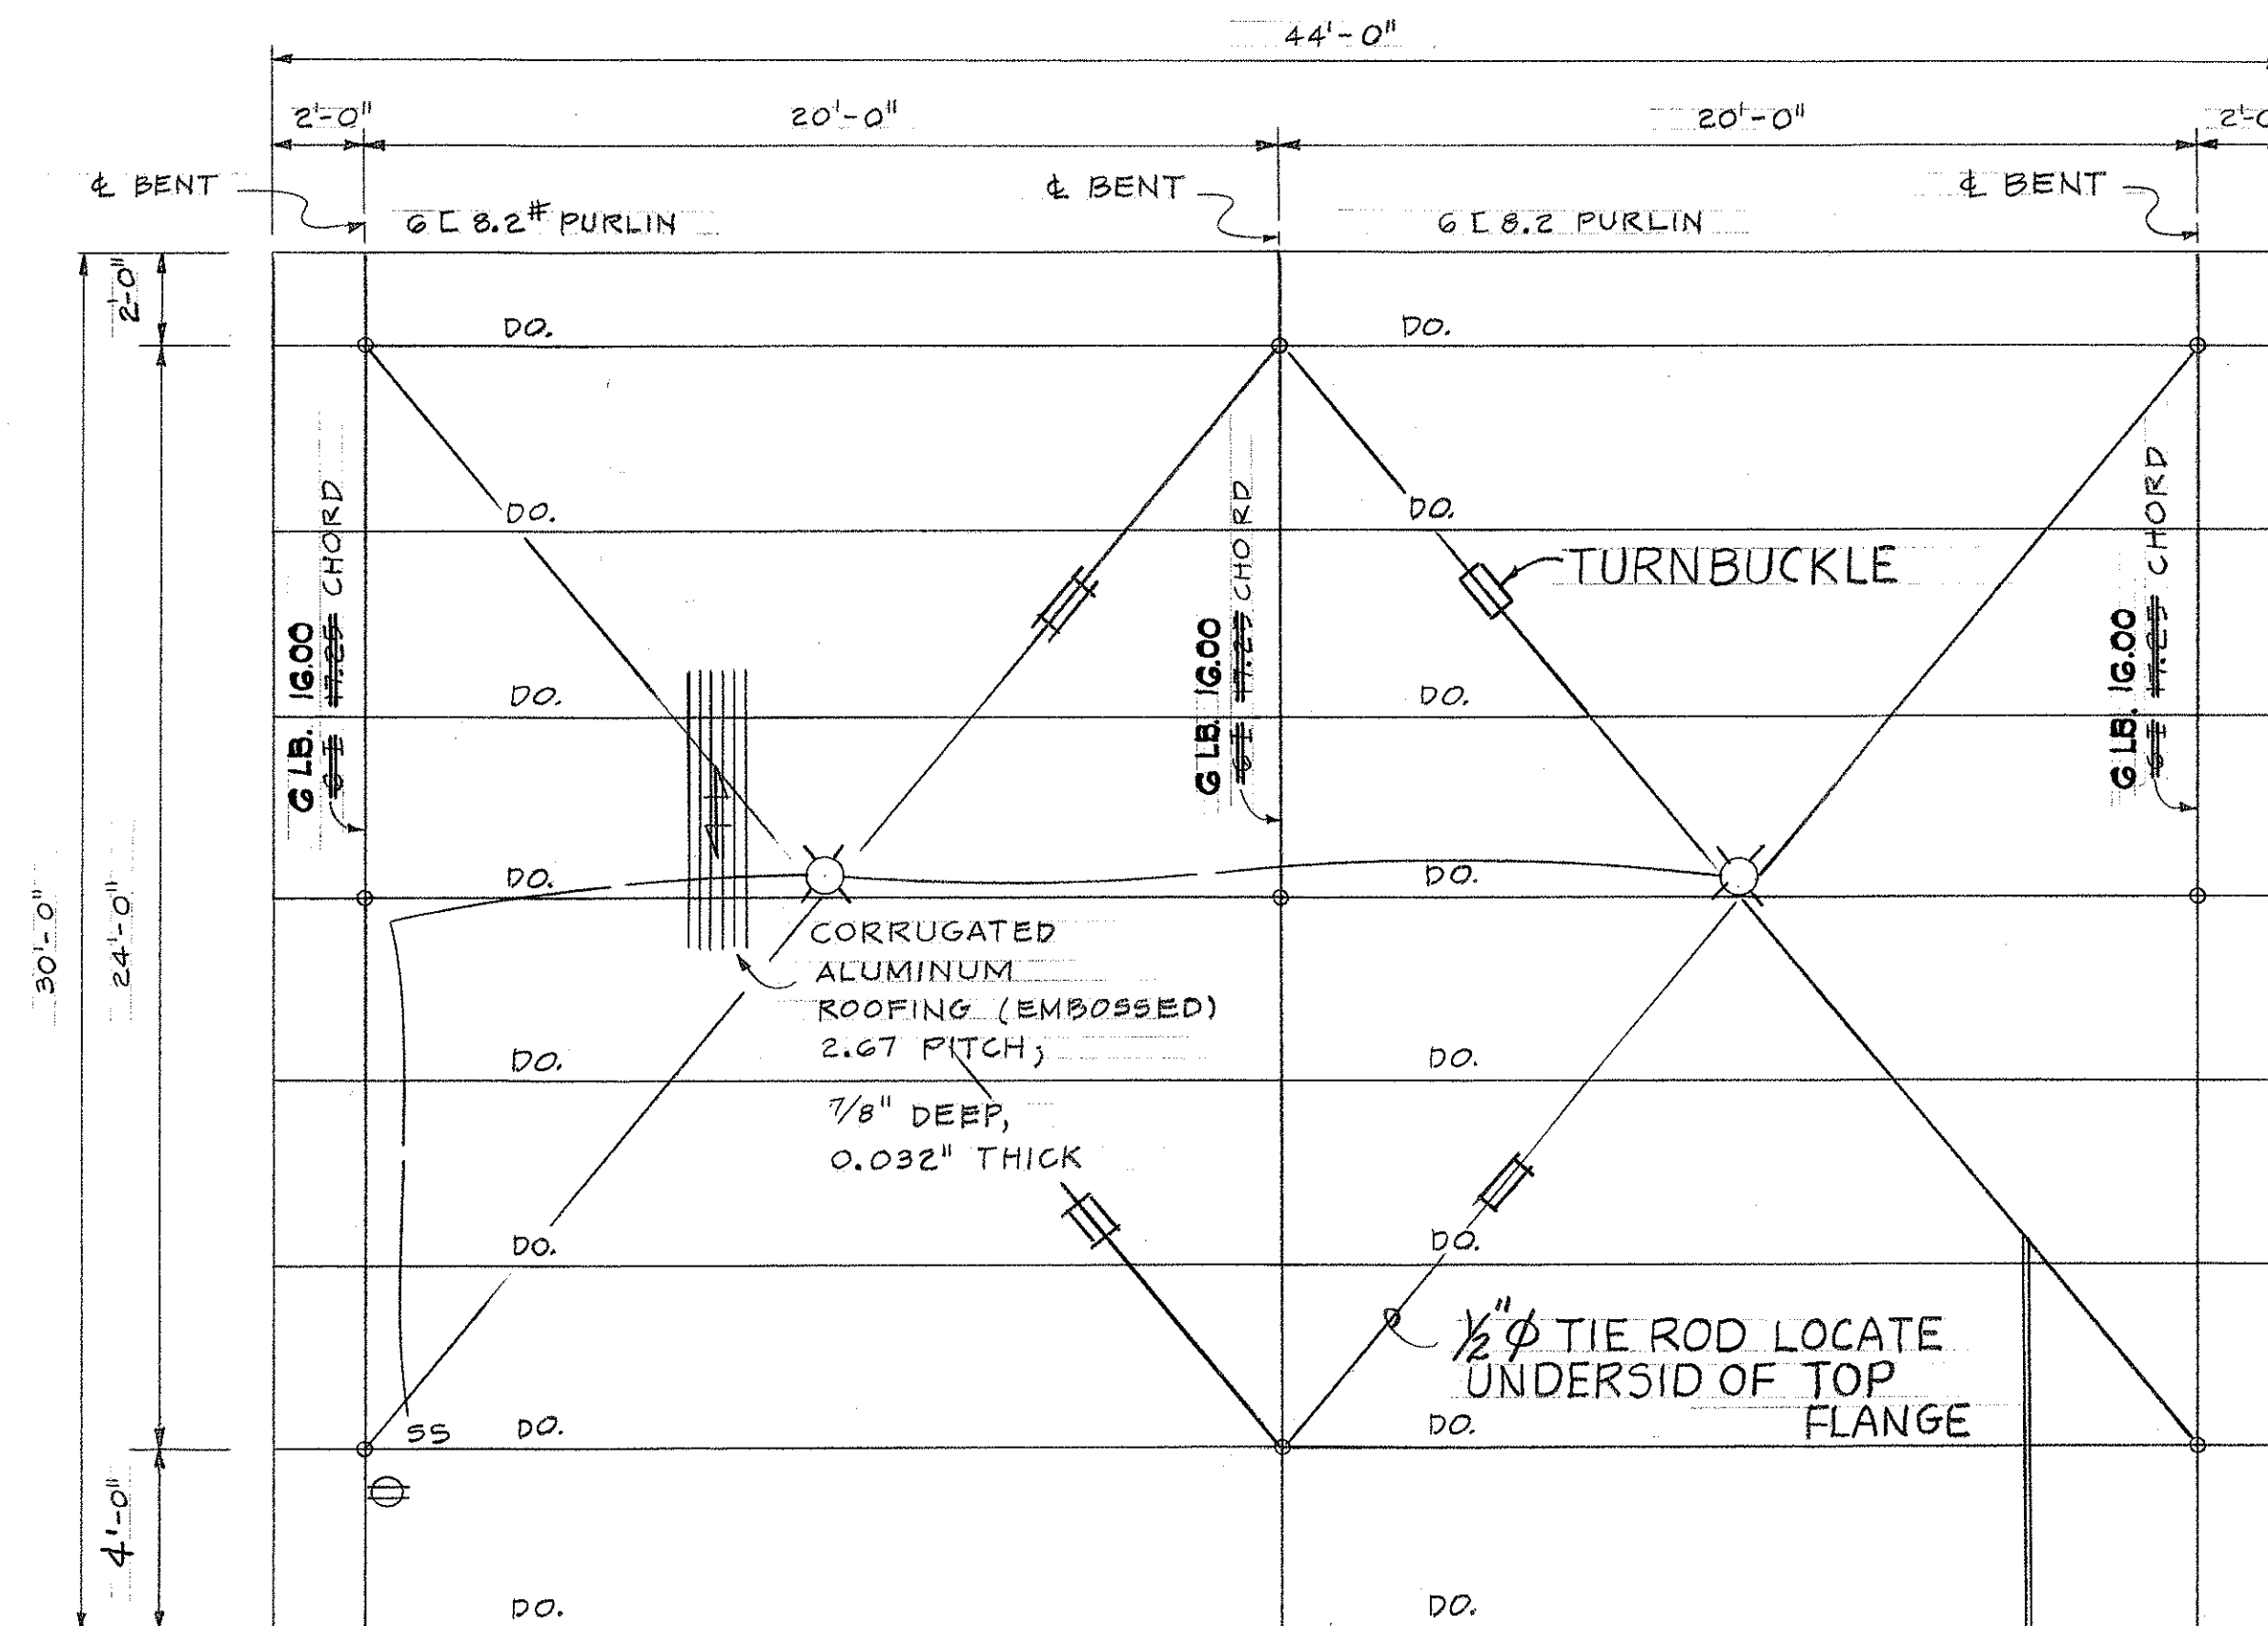


ROOF FRAMING PLAN

SCALE: 1/4" = 1'-0"

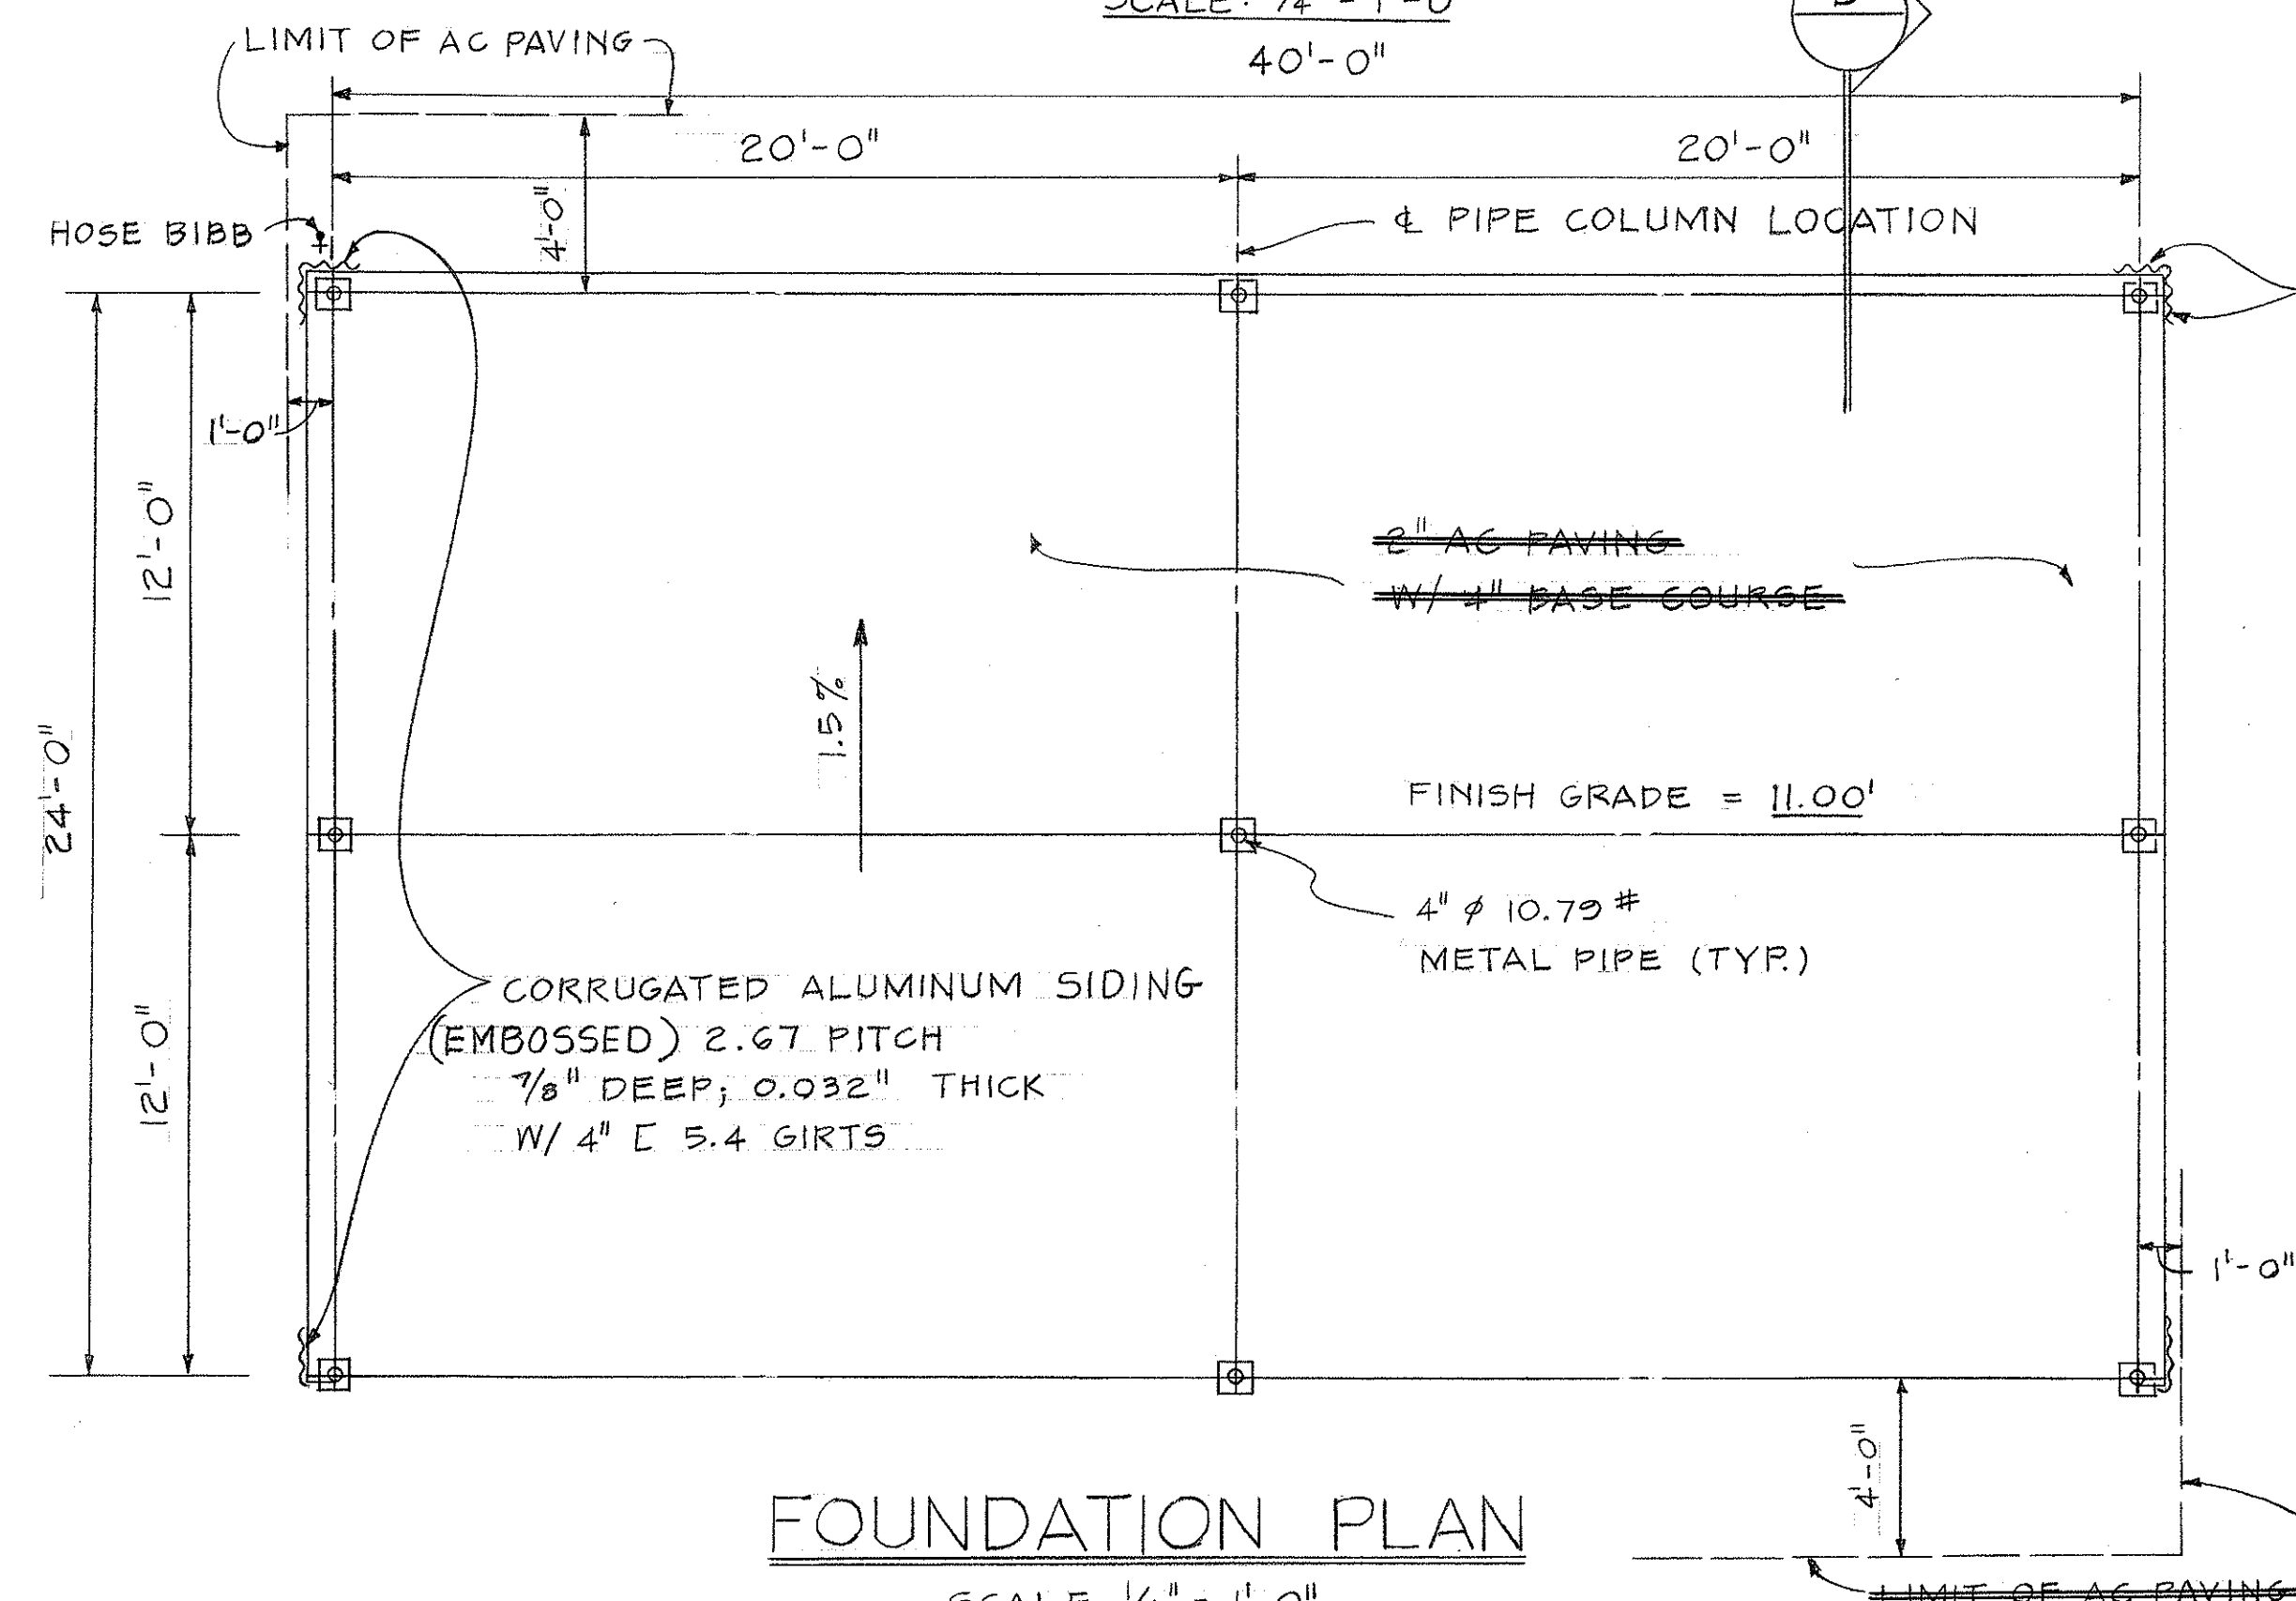


FOUNDATION PLAN

SCALE 1/4" = 1'-0"

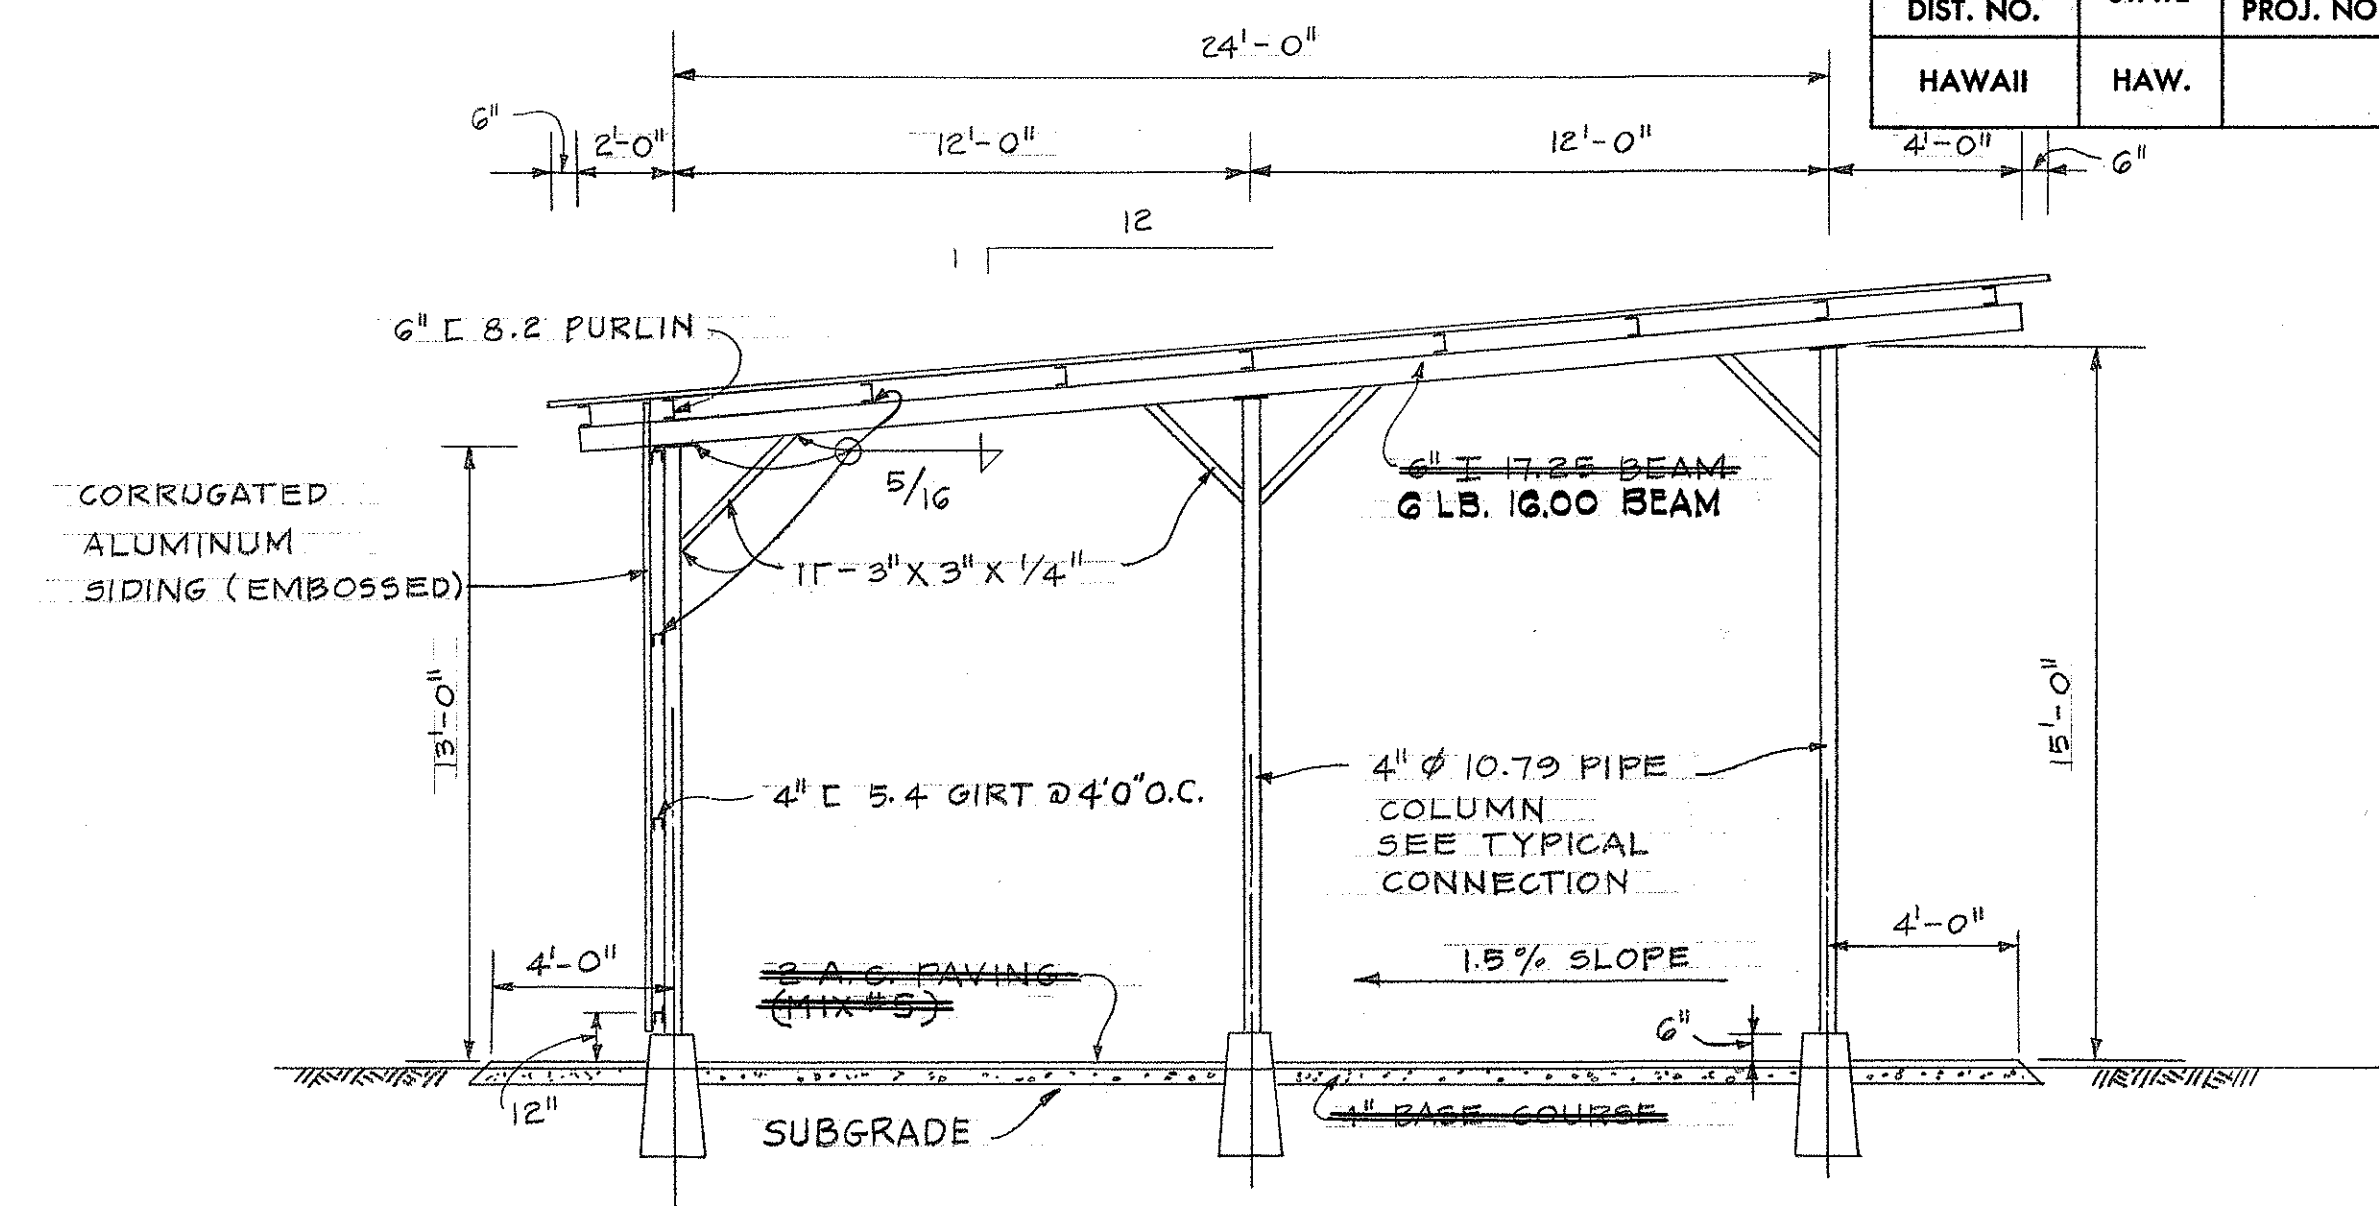

CROSS SECTION A

SCALE: 1/4" = 1'-0"

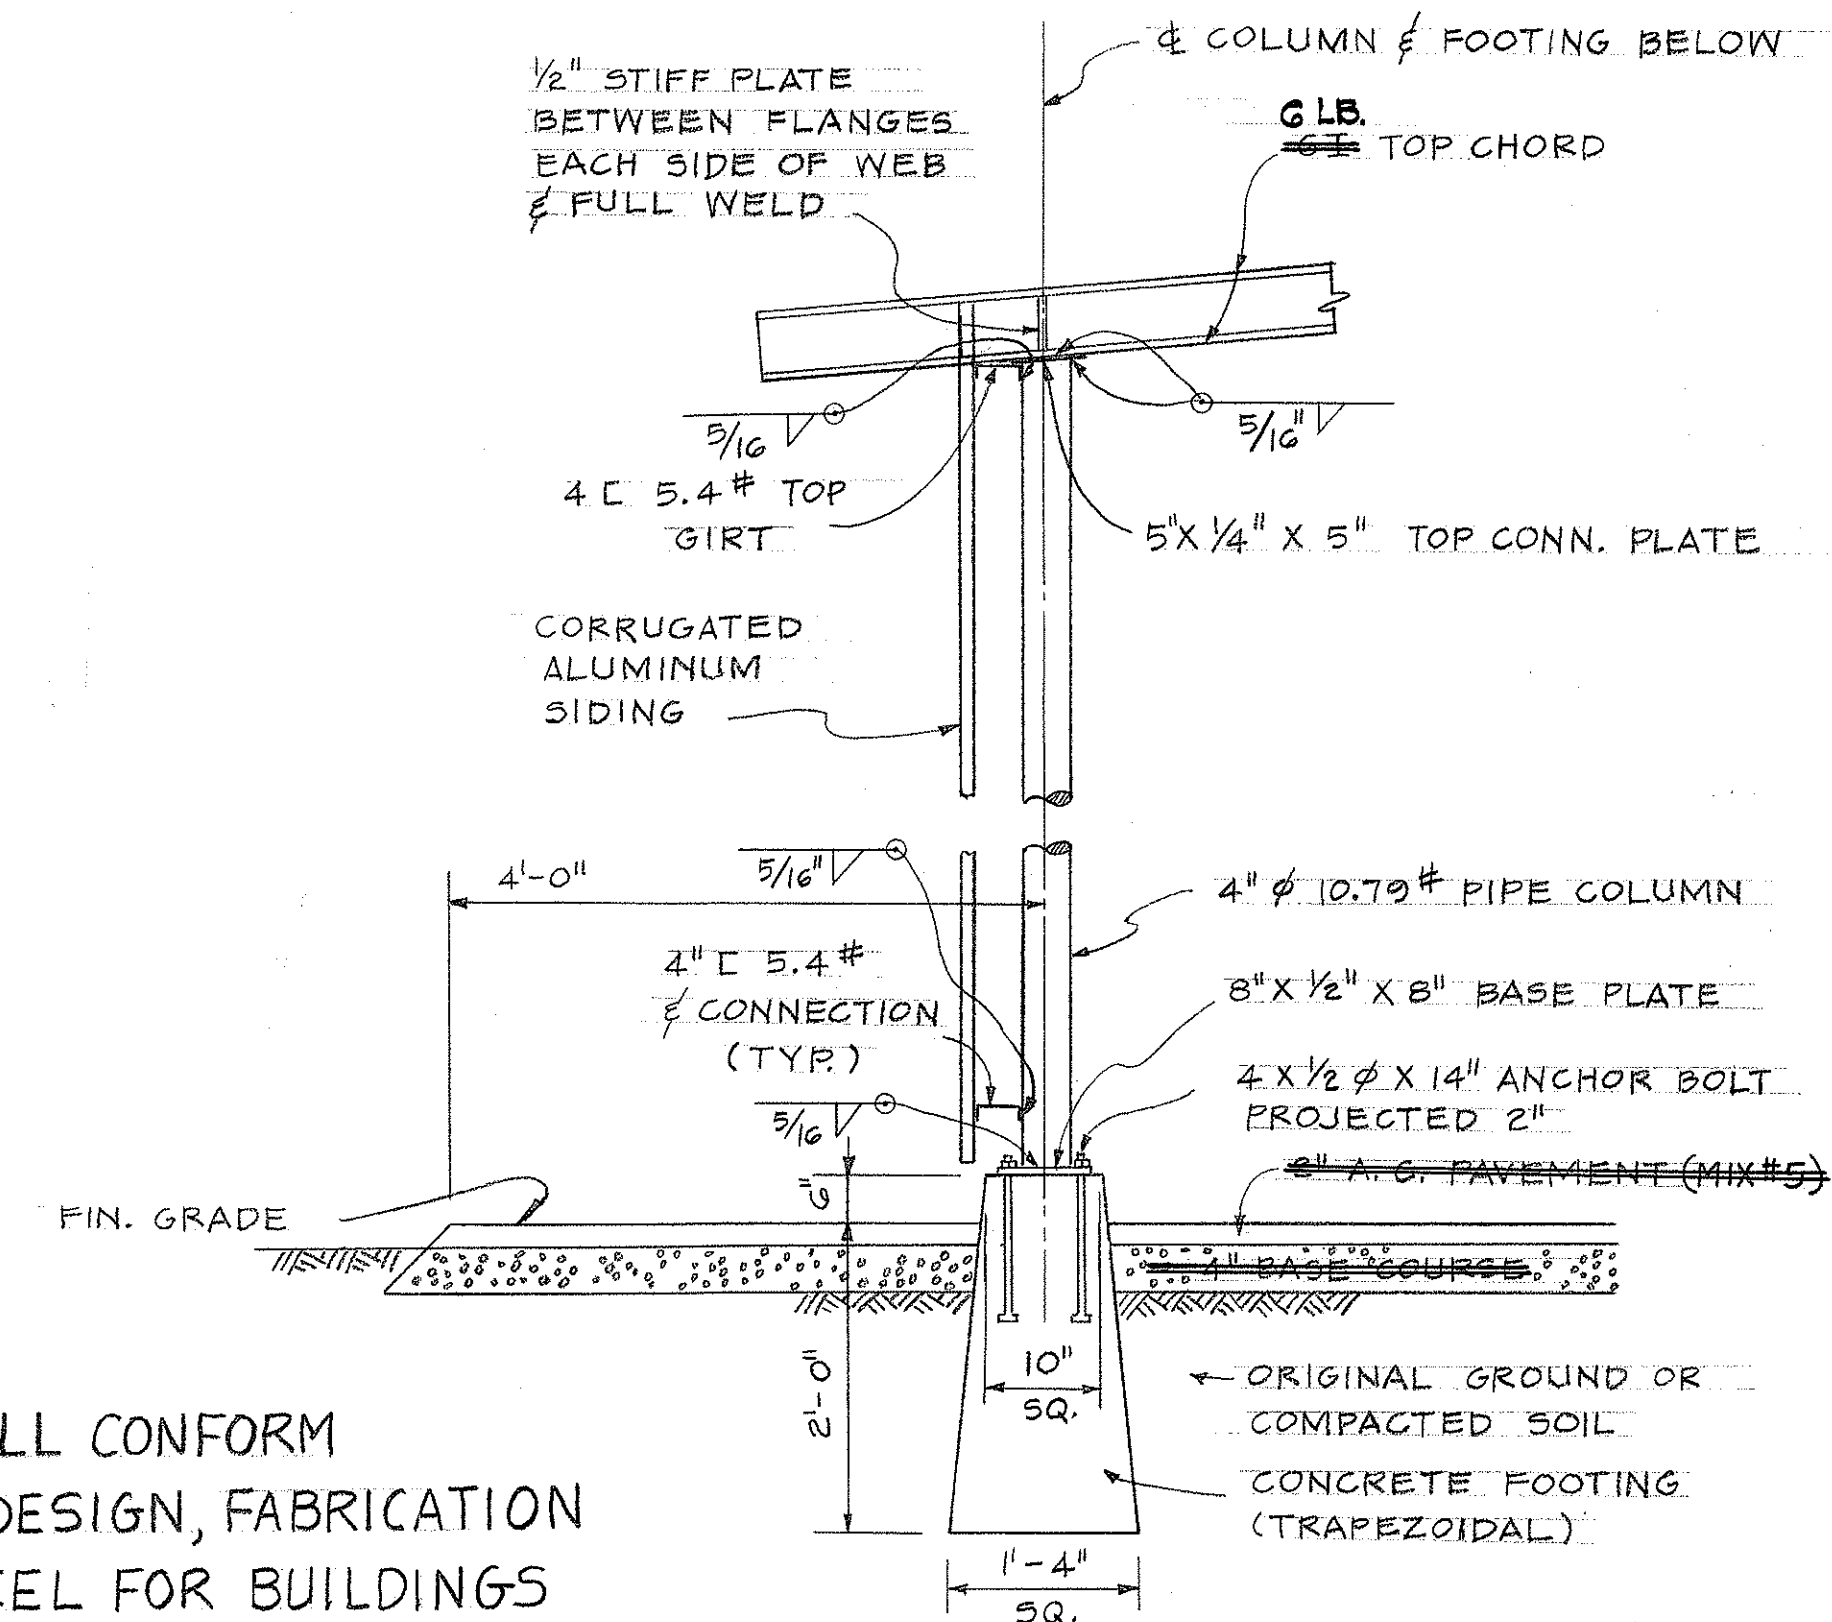

TYPICAL COLUMN DETAILS B

SCALE: 3/4" = 1'-0"

GENERAL NOTES

- ① ALL STRUCTURAL STEEL WORK SHALL CONFORM TO AISC SPECIFICATION FOR THE DESIGN, FABRICATION AND ERECTION OF STRUCTURAL STEEL FOR BUILDINGS
- ② STRUCTURAL STEEL SHALL BE A-36
- ③ FOOTING CONCRETE AT 28 DAYS $f'_c = 3000$ PSI

STATE OF HAWAII
DEPARTMENT OF TRANSPORTATION
HIGHWAYS DIVISION

STORAGE SHED FRAMING


HAUULA BASEYARD FACILITY

PROJ. # SD67-335

SHEET No. 4 OF 5 SHEETS

DATE	_____
DESIGNED BY	_____
TRACED BY	_____
DESIGNED BY	_____
QUANTITIES BY	_____
CHECKED BY	_____
ORIGINAL PLAN	_____
NOTE BOOK	_____
No.	_____

FED. ROAD DIST. NO.	STATE	FED. AID PROJ. NO.	FISCAL YEAR	SHEET NO.	TOTAL SHEETS
HAWAII	HAW.				

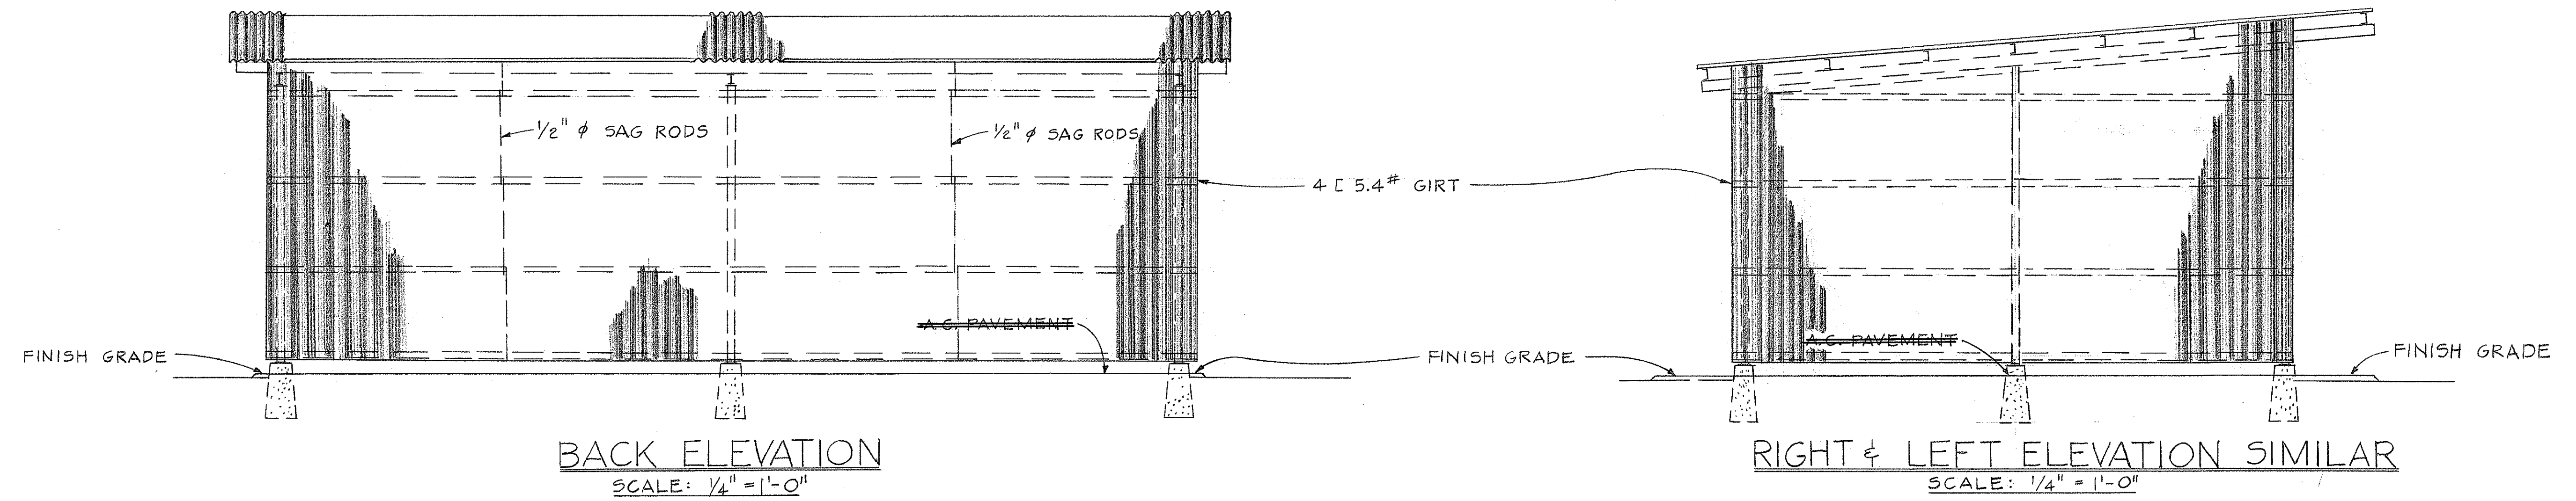

ORIGINAL PLAN	SURVEY PLOTTED BY	DATE
DESIGNED BY	DRAWN BY	
NOTED BY	CHECKED BY	
NO.		

STATE OF HAWAII
DEPARTMENT OF TRANSPORTATION
HIGHWAYS DIVISION

STORAGE SHED ELEVATION

HAUULA BASEYARD FACILITY

PROJ. # SD 67-335

SHEET No. 5 OF 5 SHEETS