


FED. ROAD DIST. NO.	STATE	PROJ. NO.	FISCAL YEAR	SHEET NO.	TOTAL SHEETS
HAWAII	HAW.	LT-0-02-80M	1980	4	4

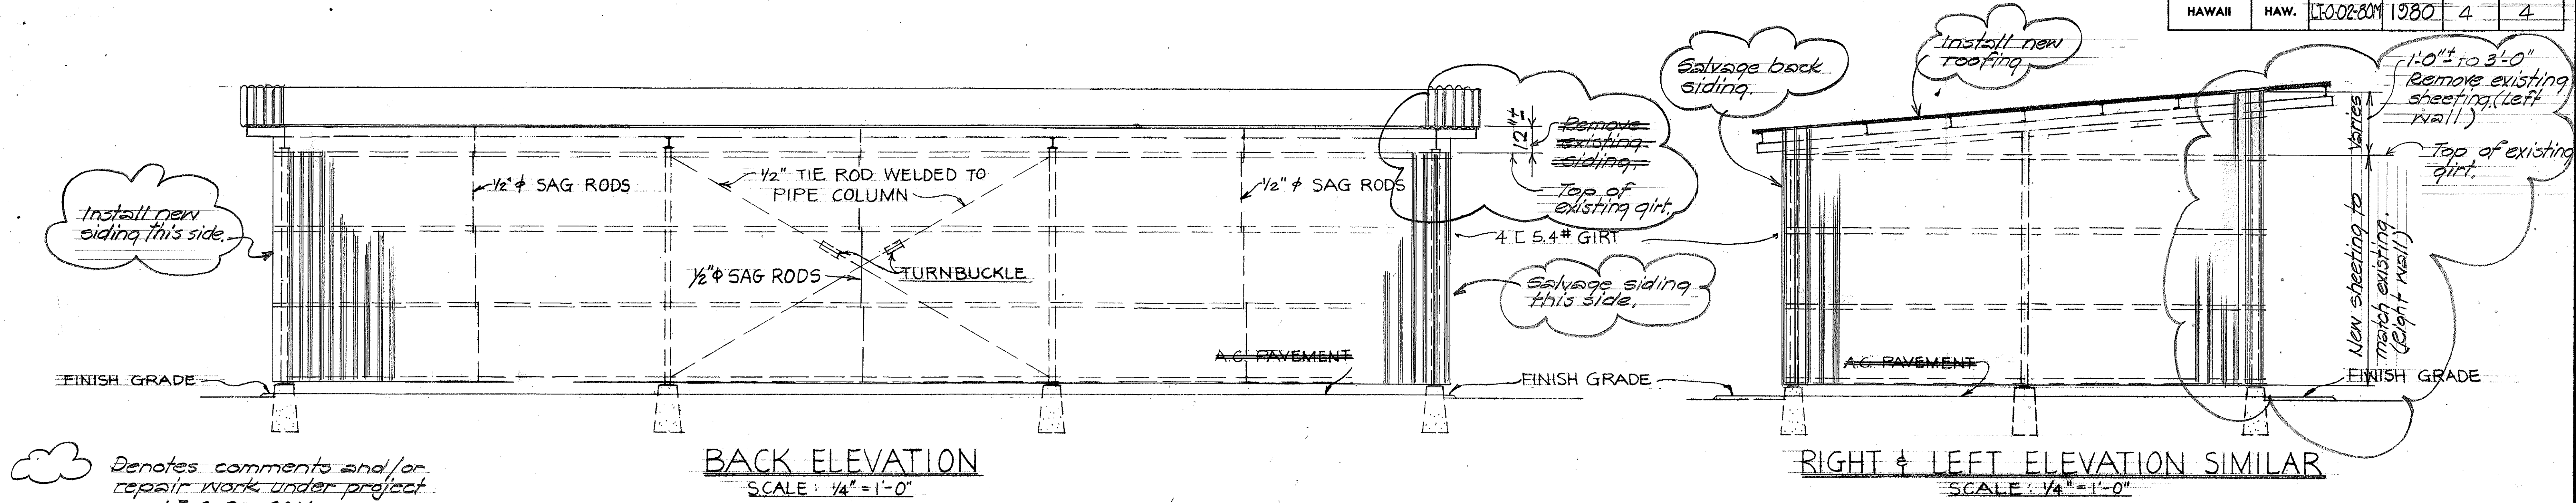

Denotes comments and/or repair work under project no. LT-0-02-80M.

SURVEY PLATTED BY	DATE
DRAWN BY	
TRACED BY	
NOTED BY	
CHECKED BY	
ORIGINAL PLAN	
NOTE BOOK	
No.	

STATE OF HAWAII
DEPARTMENT OF TRANSPORTATION
HIGHWAYS DIVISION

EQUIPMENT SHED ELEVATION
REPAIRS TO KANEOHE BASEYARD
EQUIPMENT SHED
PROJ. NO. LT-0-02-80M
DATE: MAY 1980

STATE OF HAWAII
DEPARTMENT OF TRANSPORTATION
HIGHWAYS DIVISION

STORAGE SHED ELEVATION
KANEOHE BASEYARD FACILITY
PROJ # SD 68-313