×	
	INDEX TO DRAWINGS
SHEET NO.	DESCRIPTION
l	TITLE SHEET
and the second s	PLOT, FOUNDATION PLAN AND
	TYPICAL DETAILS
3	STORAGE SHED FRAMING
4	STORAGE SHED ELEVATION
;	
	·



STATE OF HAWAII





DEPARTMENT OF TRANSPORTATION
HIGHWAYS DIVISION
" AS BUILT ""
PLANS FOR

REPAIRS TO KANEOHE BASEYARD EQUIPMENT SHED

PROJECT NO. LT-0-02-80M

DISTRICT OF KOOLAUPOKO
ISLAND OF OAHU

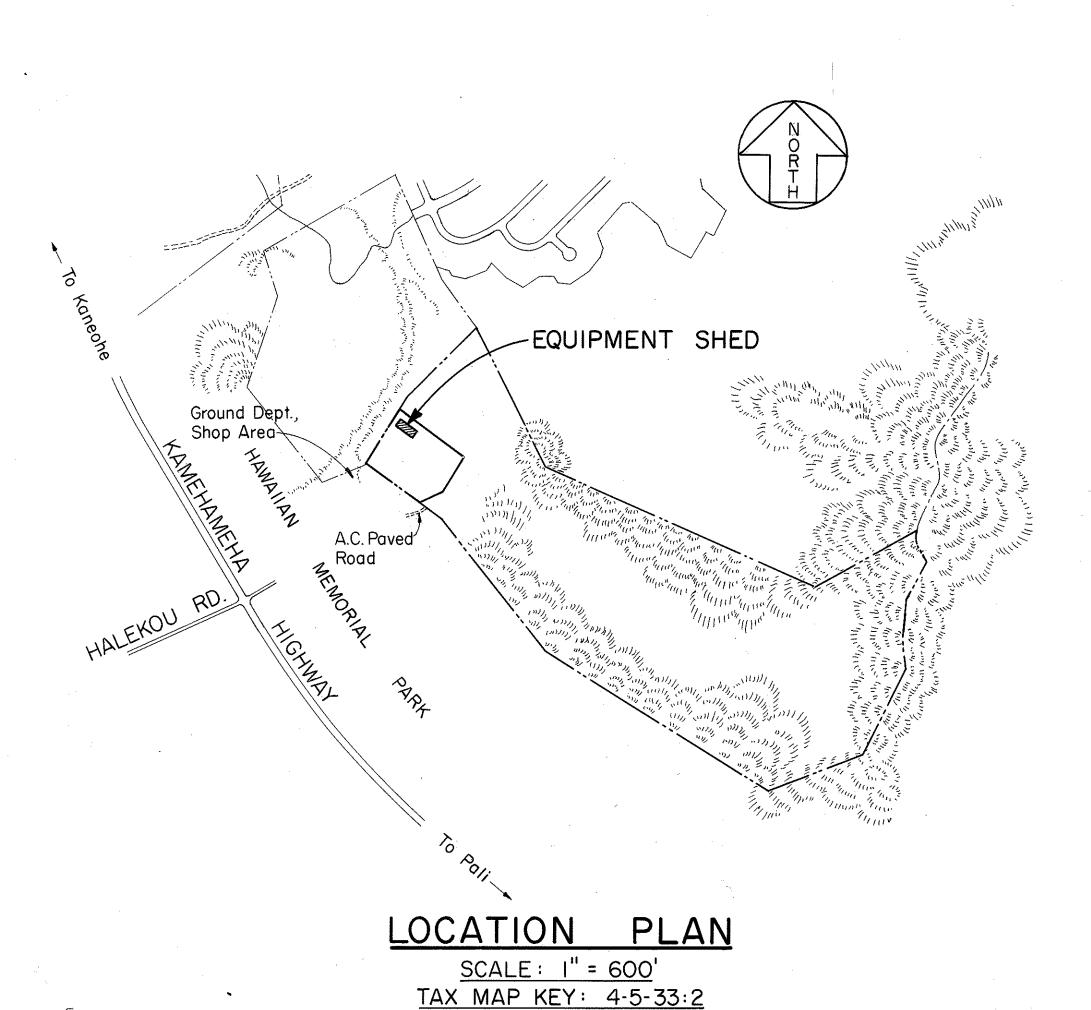

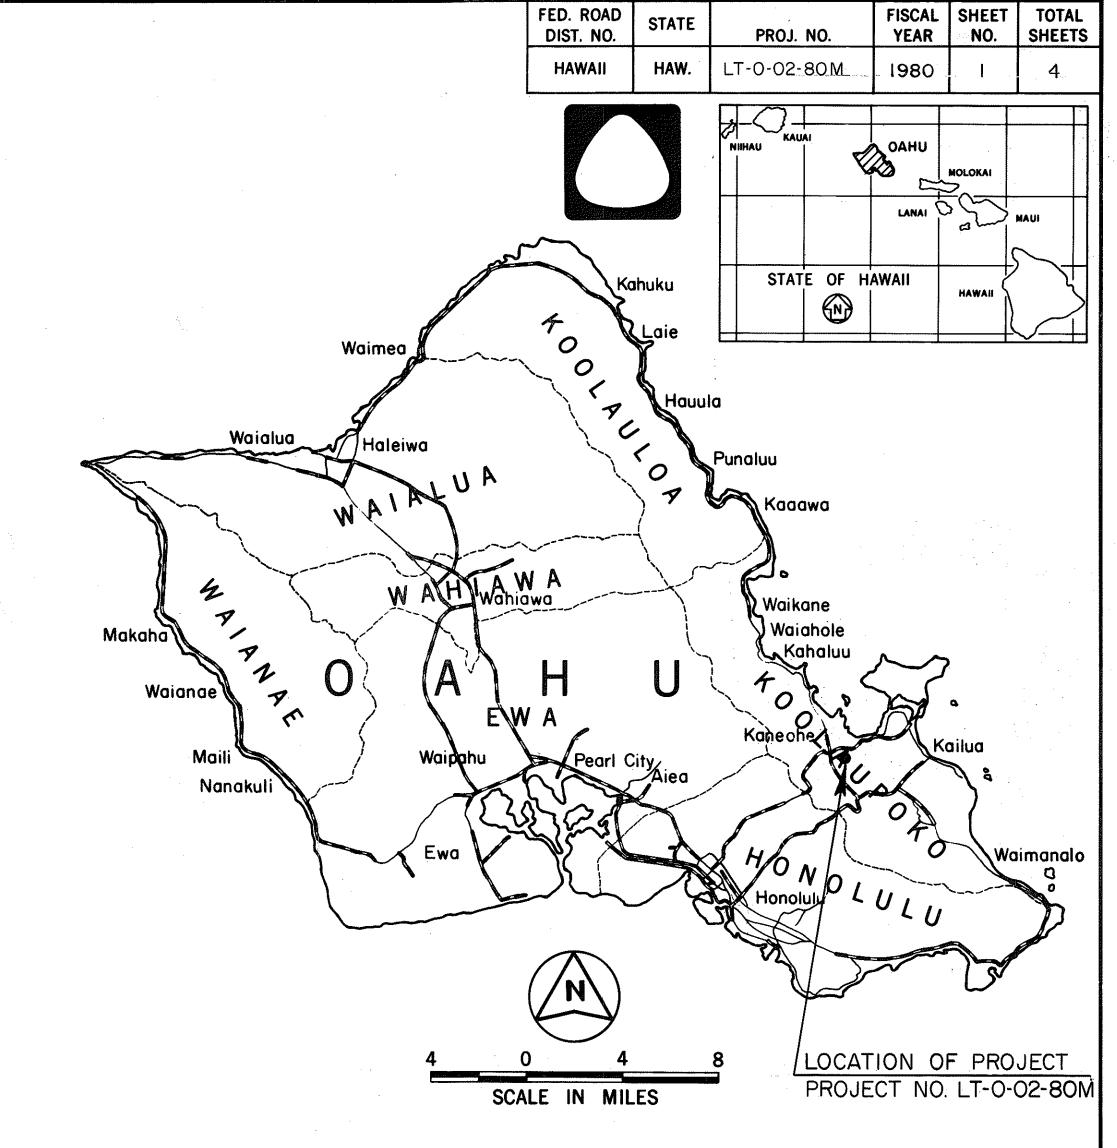

FEDERAL AID PROJECTS PREVIOUSLY CONSTRUCTED OR UNDER CONSTRUCTION

ALL CHANGES MADE DURING CONSTRUCTION
HAVE BEEN INCORPORATED ON THESE PLANS
EXCEPT CHANGES IN THE ORIGINAL THEORETICAL
QUANTITIES

PROJECT ENGINEER DATE

DEPARTMENT OF TRANSPORTATION
STATE OF HAWAII

APPROVED:

James K. Carras 6/4/80

ADIR. OF TRANSPORTATION DATE

0,0