


FED. ROAD DIST. NO.	STATE	PROJ. NO.	FISCAL YEAR	SHEET NO.	TOTAL SHEETS
HAWAII	HAW.	HWY-0-03-92	1994	8	35

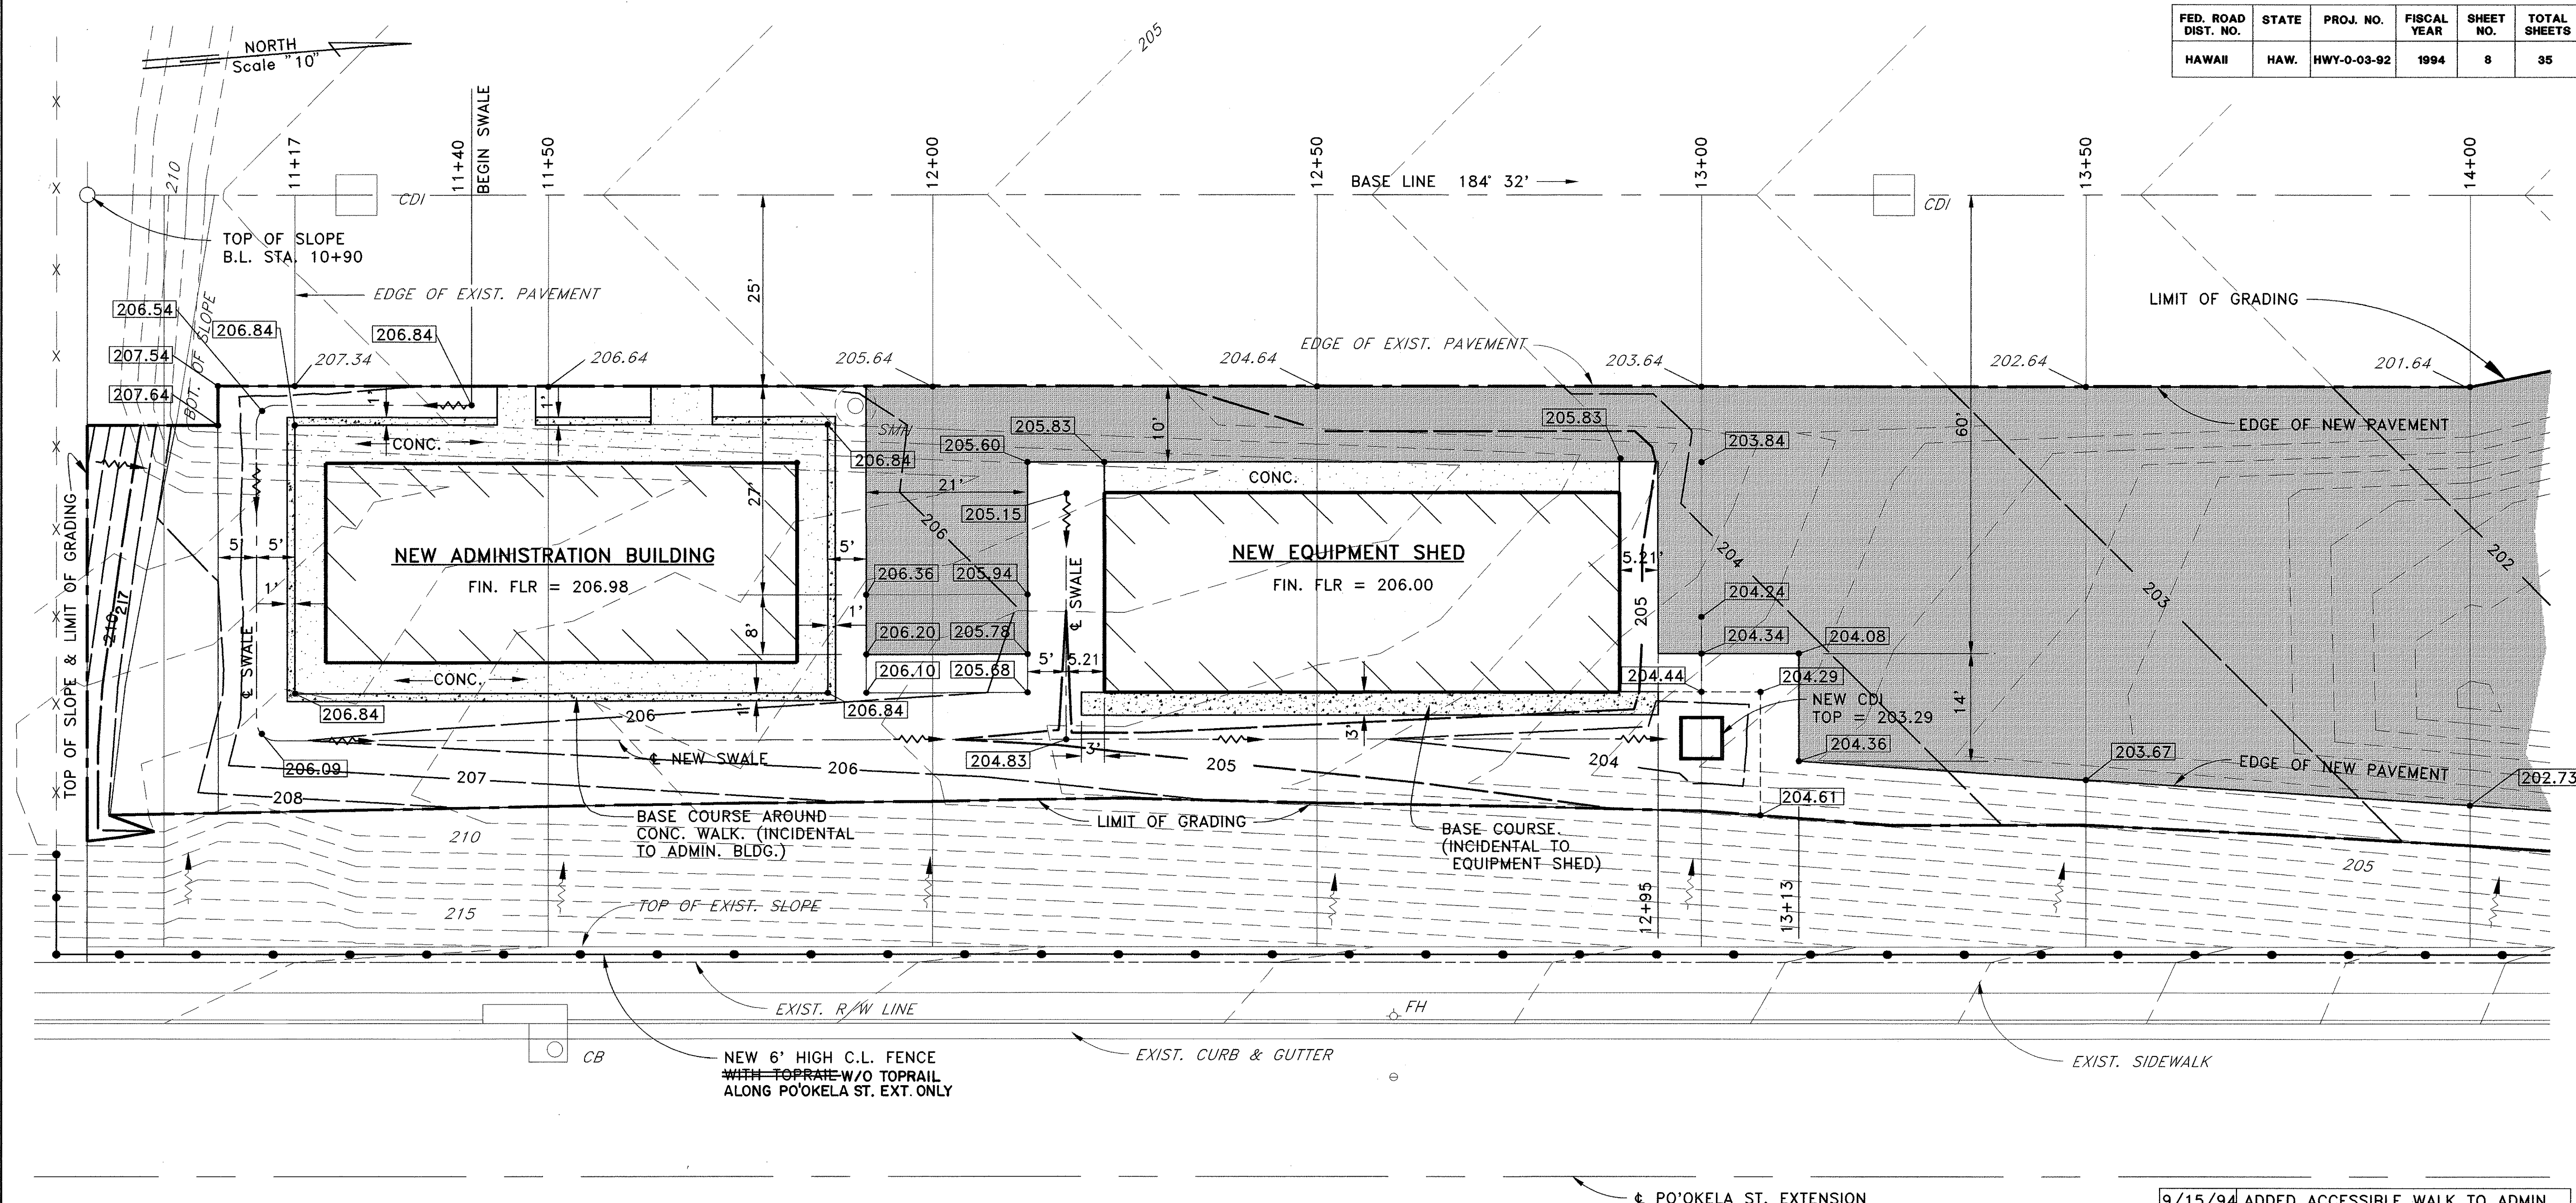

ORIGINAL PLAN	DATE
DRAWN BY	
DESIGNED BY	
NOTED BY	
CHECKED BY	
NO.	

LEGEND


- 206.64 FINISHED GRADE AT POINT
- 206.64 EXIST. GRADE AT POINT
- 200 EXIST. GROUND CONTOUR AT 5' INTERVAL
- 201 FIN. GRADE CONTOUR AT 1' INTERVAL
- 200 FIN. GRADE CONTOUR AT 5' INTERVAL
- DRAINAGE FLOW
- NEW A.C. PAVEMENT AREA

FINE GRADING PLAN
SCALE "10"

GRAPHIC SCALE



9/15/94	ADDED ACCESSIBLE WALK TO ADMIN. BLDG.
6/17/94	REVISED SWALE AND GRADES NEAR SOUTH END OF ADMINISTRATION BLDG. REVISED DIMENSION NEAR NORTH END OF EQUIPMENT SHED.
DATE	REVISION

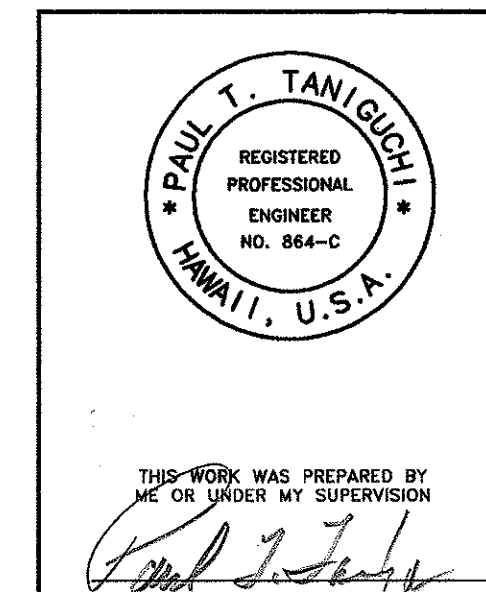

STATE OF HAWAII DEPARTMENT OF TRANSPORTATION HIGHWAYS DIVISION
FINE GRADING PLAN
Kaneohe Base Yard, Phase II ADMINISTRATION BUILDING PROJECT NO. HWY-0-03-92
SCALE: AS NOTED DATE: 4/15/94
SHEET NO. 8 OF 35 SHEETS