


NAME: C.O. ADD. BASE/ADD. OF GRADING DATE: MAY 18, 1994 TIME: 10:22 AM

FED. ROAD DIST. NO.	STATE	PROJ. NO.	FISCAL YEAR	SHEET NO.	TOTAL SHEETS
HAWAII	HAW.	HWY-0-03-92	1994	7	35

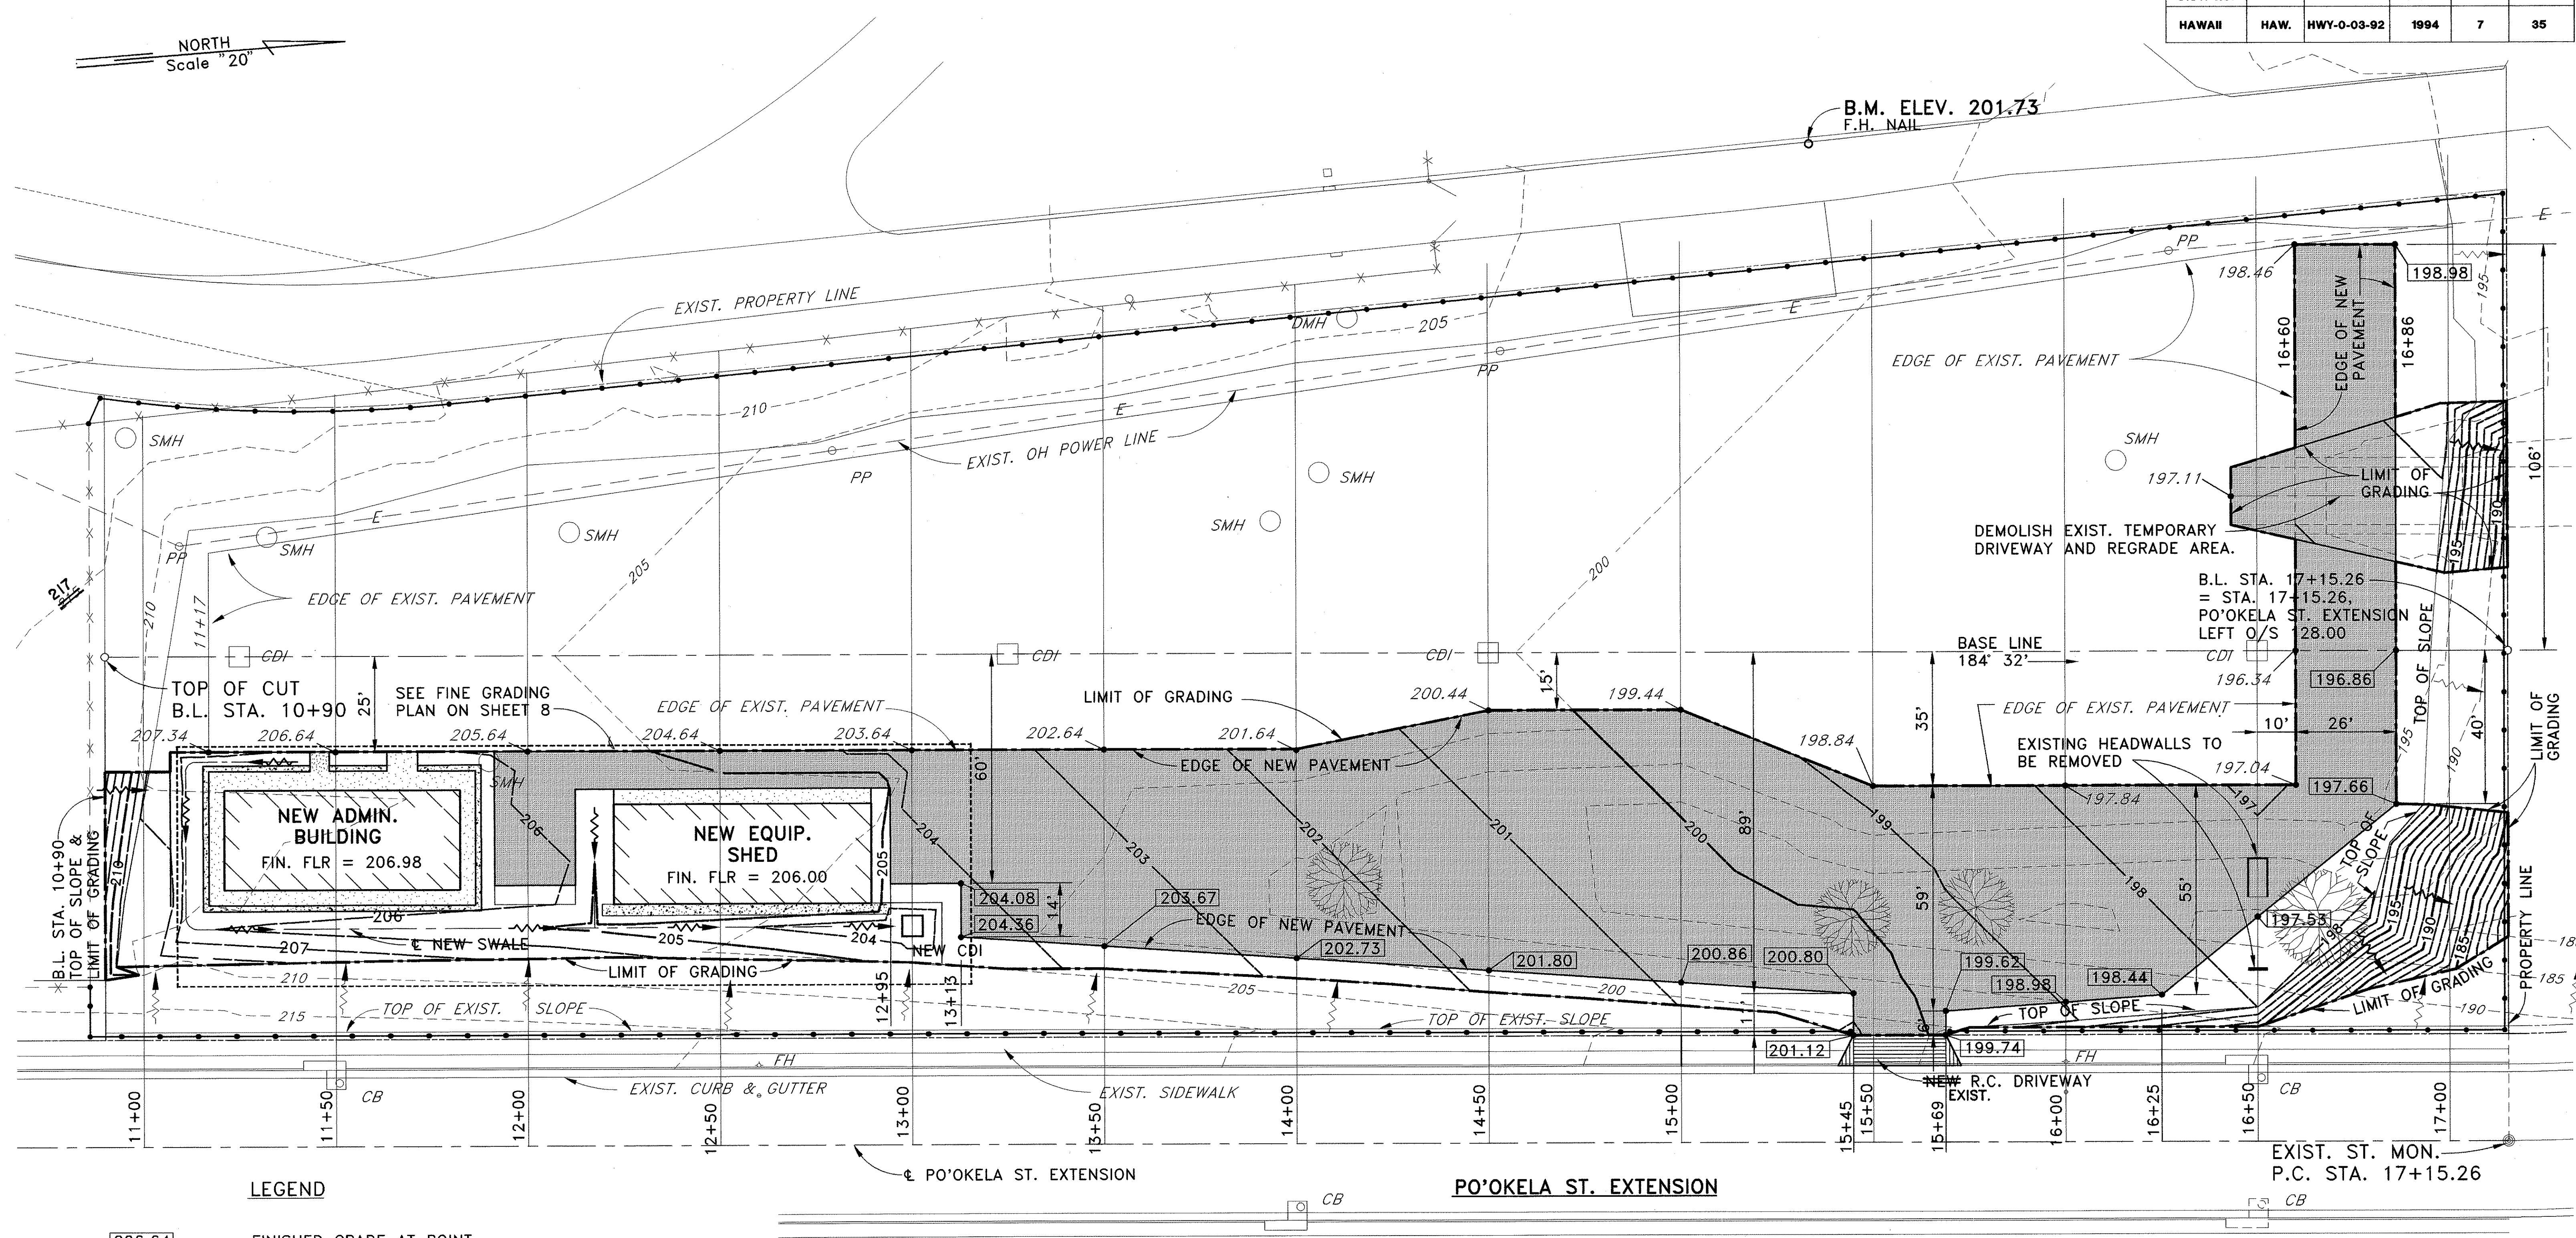

LEGEND

- 206.64 FINISHED GRADE AT POINT.
- 206.64 EXIST. GRADE AT POINT.
- 200 EXIST. GROUND CONTOUR AT 5' INTERVAL
- 201 FIN. GRADE CONTOUR AT 1' INTERVAL
- 200 FIN. GRADE CONTOUR AT 5' INTERVAL
- DRAINAGE FLOW
- NEW A.C. PAVEMENT AREA


NOTE: APPROXIMATELY 250 CU. YDS. OF GRAVEL ARE STOCKPILED IN THE PROJECT AREA WHICH MAY BE USED FOR THE CONSTRUCTION OF EMBANKMENTS. USE WILL BE PAID FOR UNDER ROADWAY EXCAVATION.

GRAPHIC SCALE

SCALE "20"



9/15/94	ADDED ACCESSIBLE WALK FOR ADMIN. BLDG.
6/17/94	REVISED CONTOURS & SWALE NEAR SOUTH END OF ADMIN. BLDG. REVISED BL STA. 17+15.26. REVISED QTY OF STOCKPILED MATERIAL TO 250 CY.
DATE	REVISION

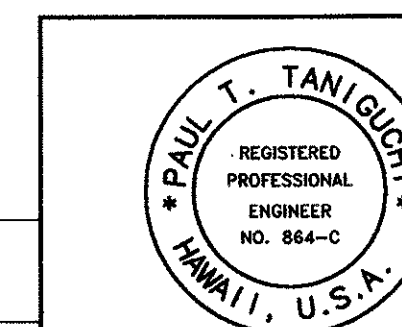

STATE OF HAWAII
DEPARTMENT OF TRANSPORTATION
HIGHWAYS DIVISION

GRADING PLAN

KANEOHE BASE YARD, PHASE II

ADMINISTRATION BUILDING

PROJECT NO. HWY-0-03-92

SCALE: AS NOTED

DATE: 4/15/94

SHEET NO. 7 OF 35 SHEETS

"AS-BUILT"

C.O.ADD. 7