
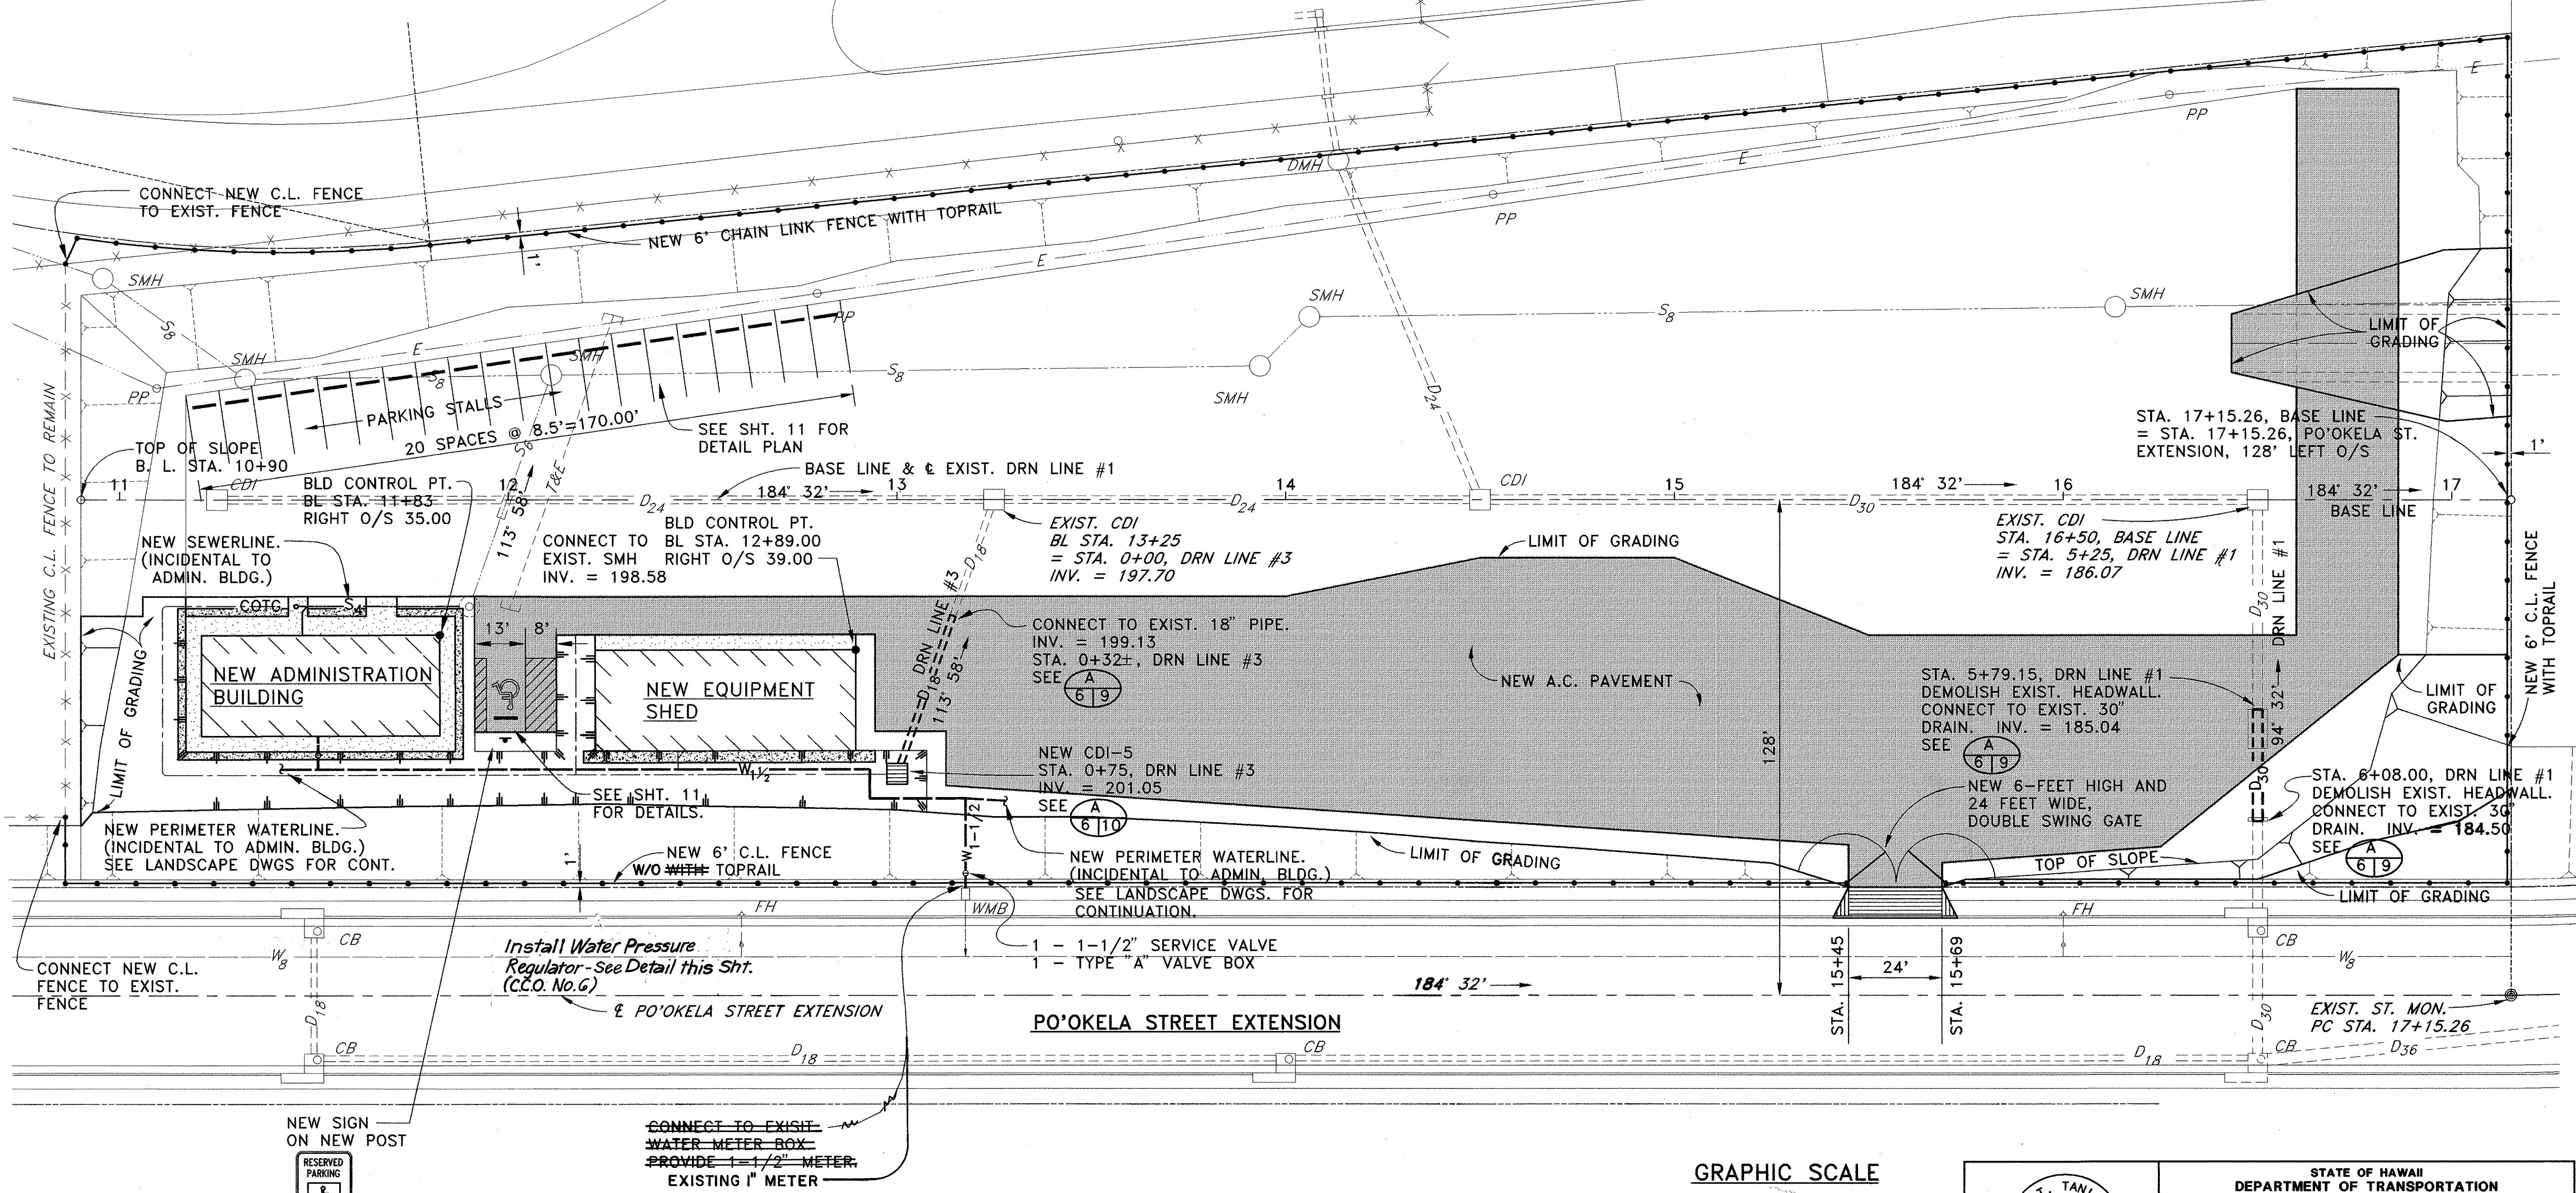


NAME: C:\CADD\1\BASEYARD\05-SITELING DATE: MAY 18, 1994 TIME: 10:15 AM

FED. ROAD DIST. NO.	STATE	PROJ. NO.	FISCAL YEAR	SHEET NO.	TOTAL SHEETS
HAWAII	HAW.	HWY-0-03-92	1994	6	35

NORTH
Scale "20"

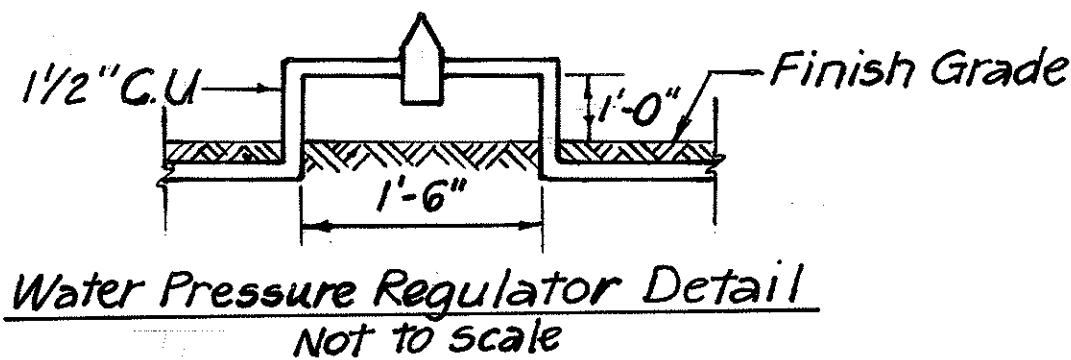


ORIGINAL PLAN	DATE
DRAWN BY	
CHECKED BY	
NOTE BOOK	
QUANTITIES BY	
CHECKED BY	
NO.	


RESERVED PARKING PLACED REQUIRED
R7-8 (12x18)
VAN ACCESSIBLE (12x8)

NOTE: ALL PAVEMENT STRIPING AND SYMBOLS SHALL BE PAINTED.

SITE PLAN
SCALE "20"

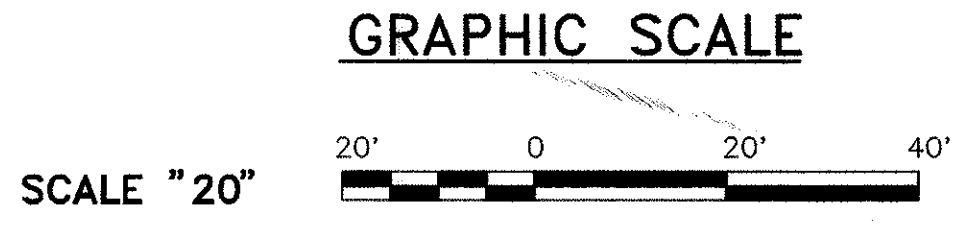

9/15/94	ADDED ACCESSIBLE WALK TO ADMIN. BLDG. REVISED HANDICAPPED PARKING.
6/17/94	REVISED BLDG CONTROL PT FOR EQUIP SHED. REVISED SWALE AROUND ADMIN. BLDG.
DATE	REVISION

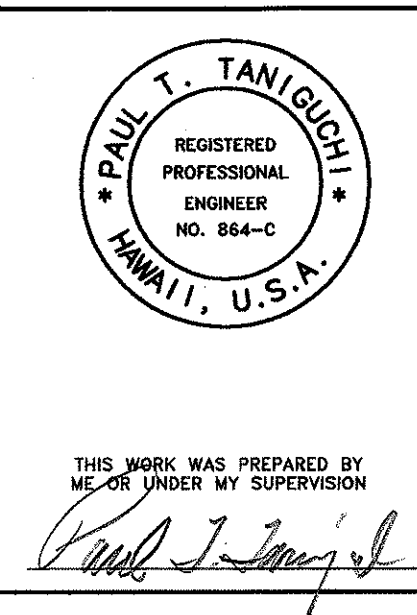

STATE OF HAWAII
DEPARTMENT OF TRANSPORTATION
HIGHWAYS DIVISION

SITE PLAN

KANEOHE BASE YARD, PHASE II

ADMINISTRATION BUILDING

PROJECT NO. HWY-0-03-92

SCALE: AS NOTED	DATE: 4/15/94
SHEET NO. 6	OF 35 SHEETS

"AS-BUILT" C.O.ADD. 6