





NAME: C:\C001\BASEYARD\04-SECT.DWG DATE: MAY 18, 1994 TIME: 9:53 AM

FED. ROAD DIST. NO.	STATE	PROJ. NO.	FISCAL YEAR	SHEET NO.	TOTAL SHEETS
HAWAII	HAW.	HWY-0-03-92	1994	4	35


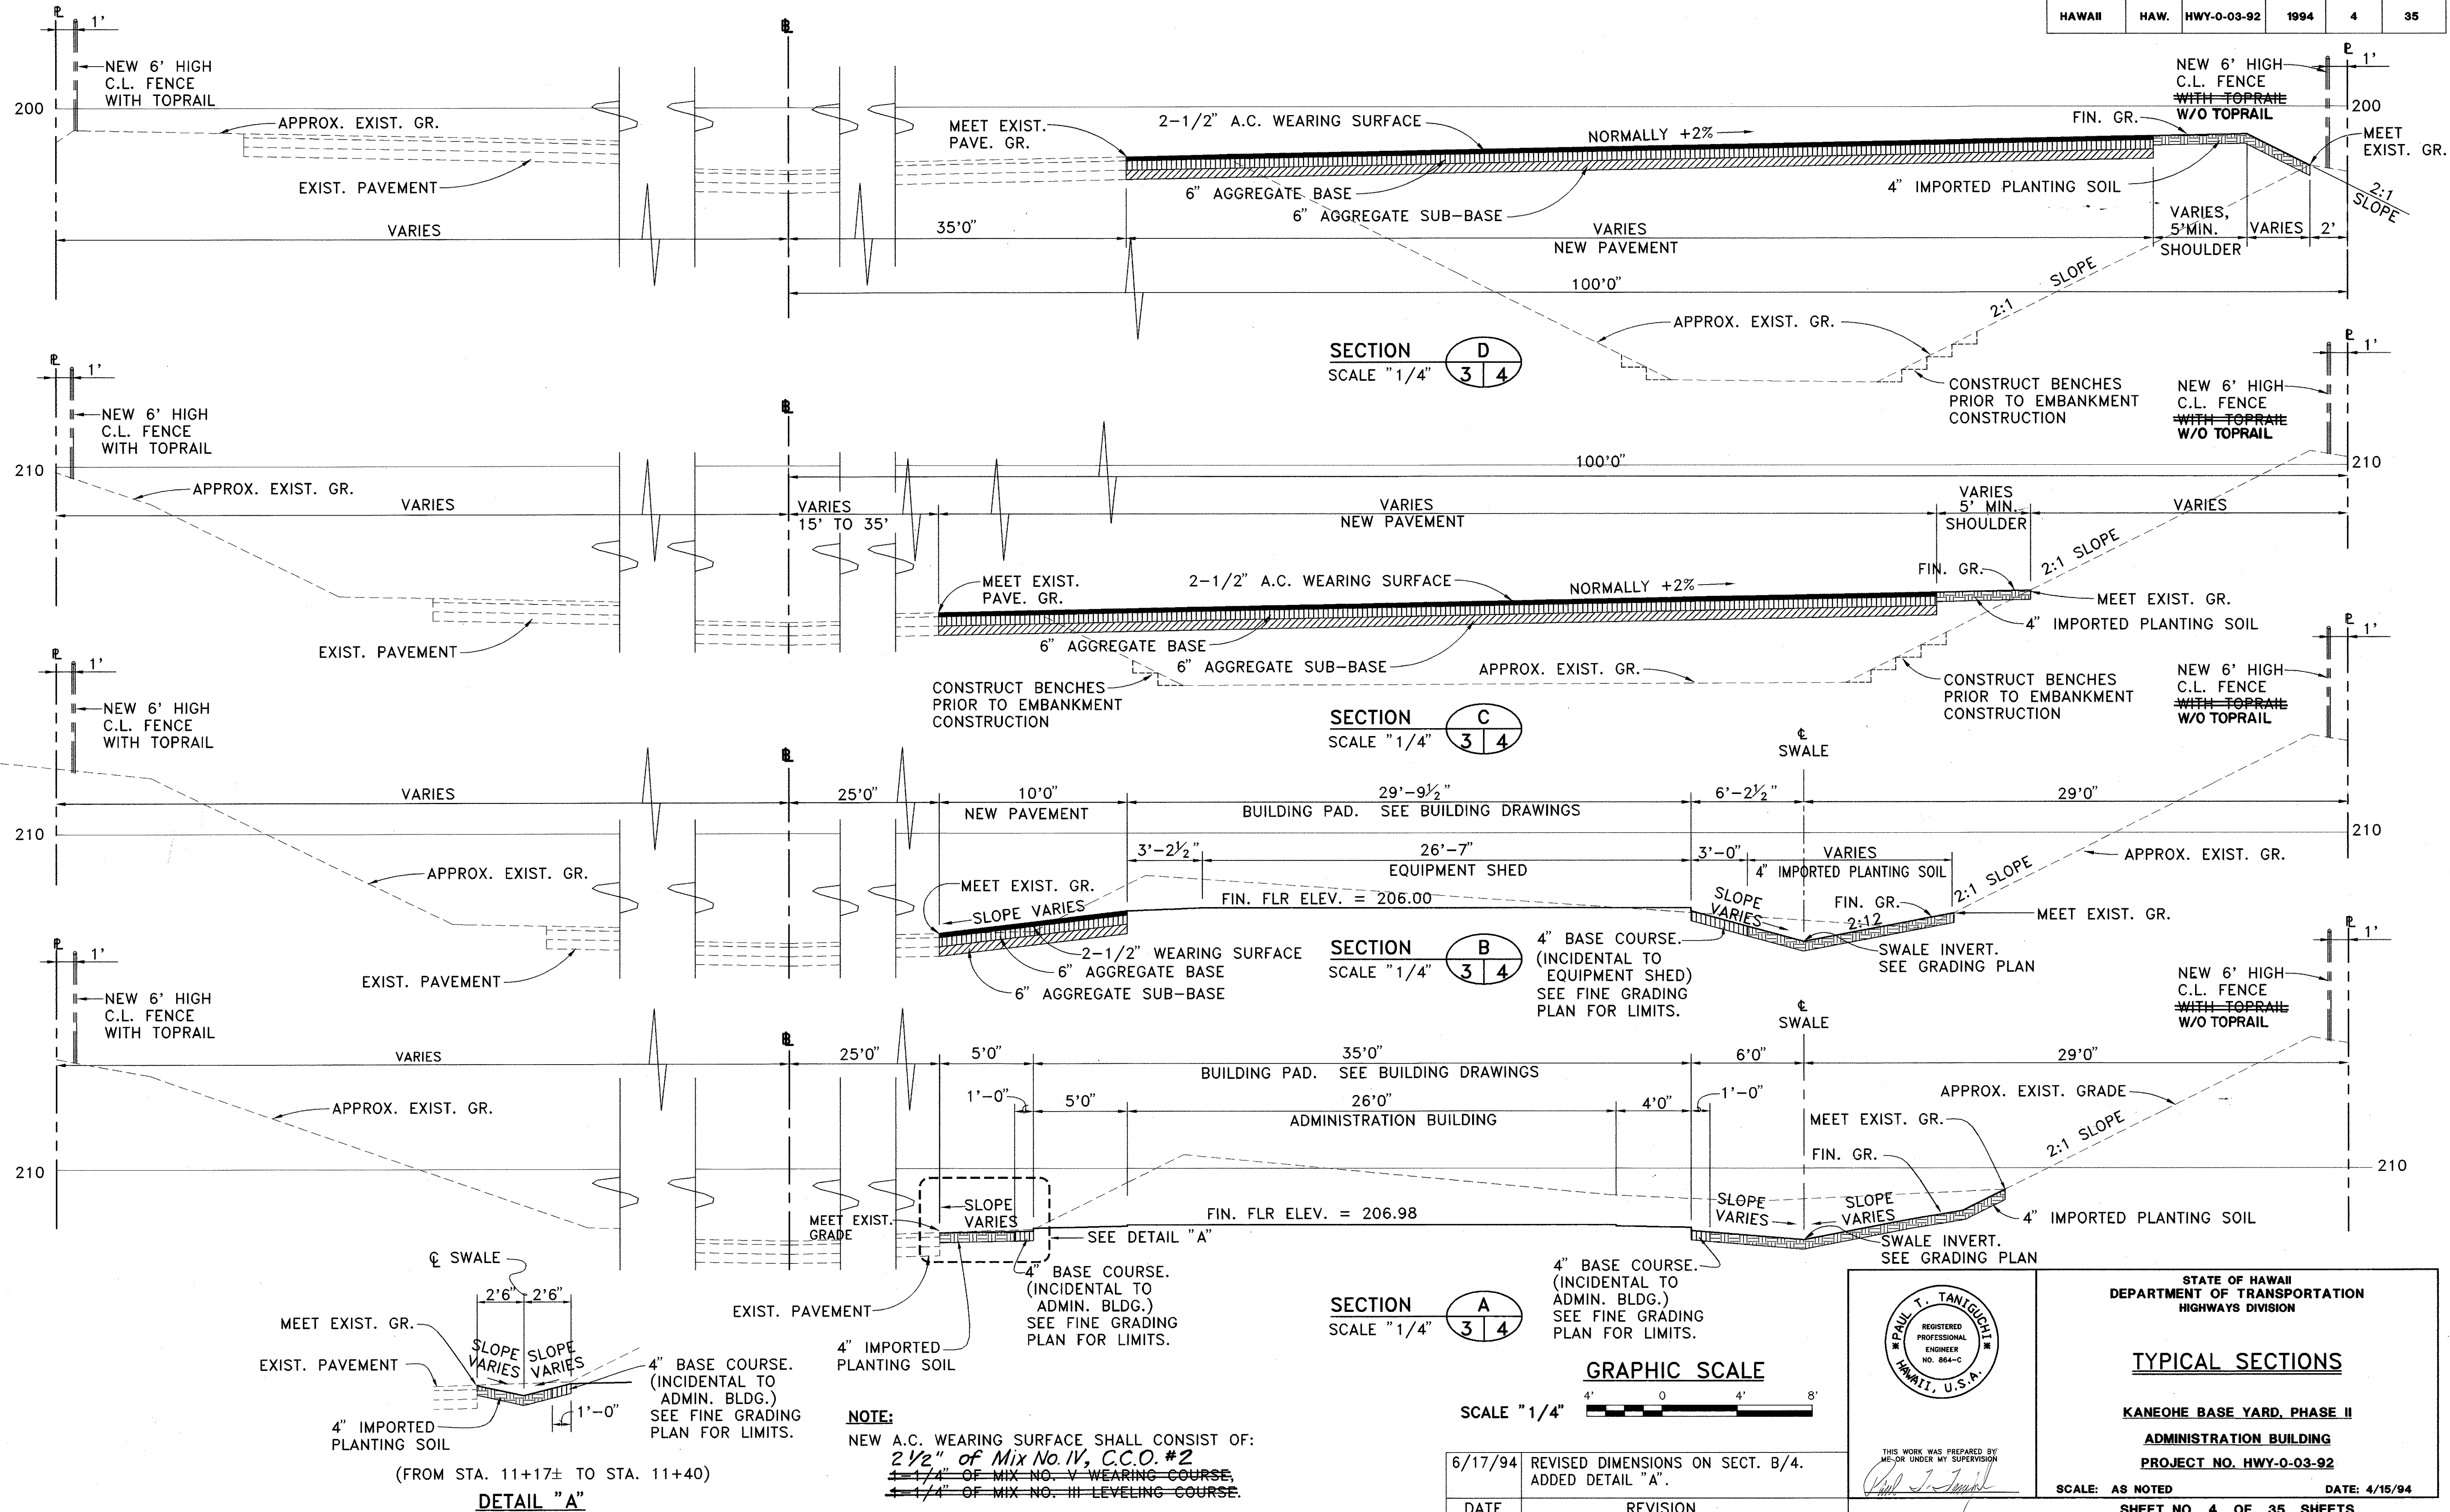


NAME: C:\CADD\1\BASE\HAWAII\05-SECTION\DWG DATE: MAY 10, 1994 TIME: 10:08 AM

FED. ROAD DIST. NO.	STATE	PROJ. NO.	FISCAL YEAR	SHEET NO.	TOTAL SHEETS
HAWAII	HAW.	HWY-0-03-92	1994	5	35

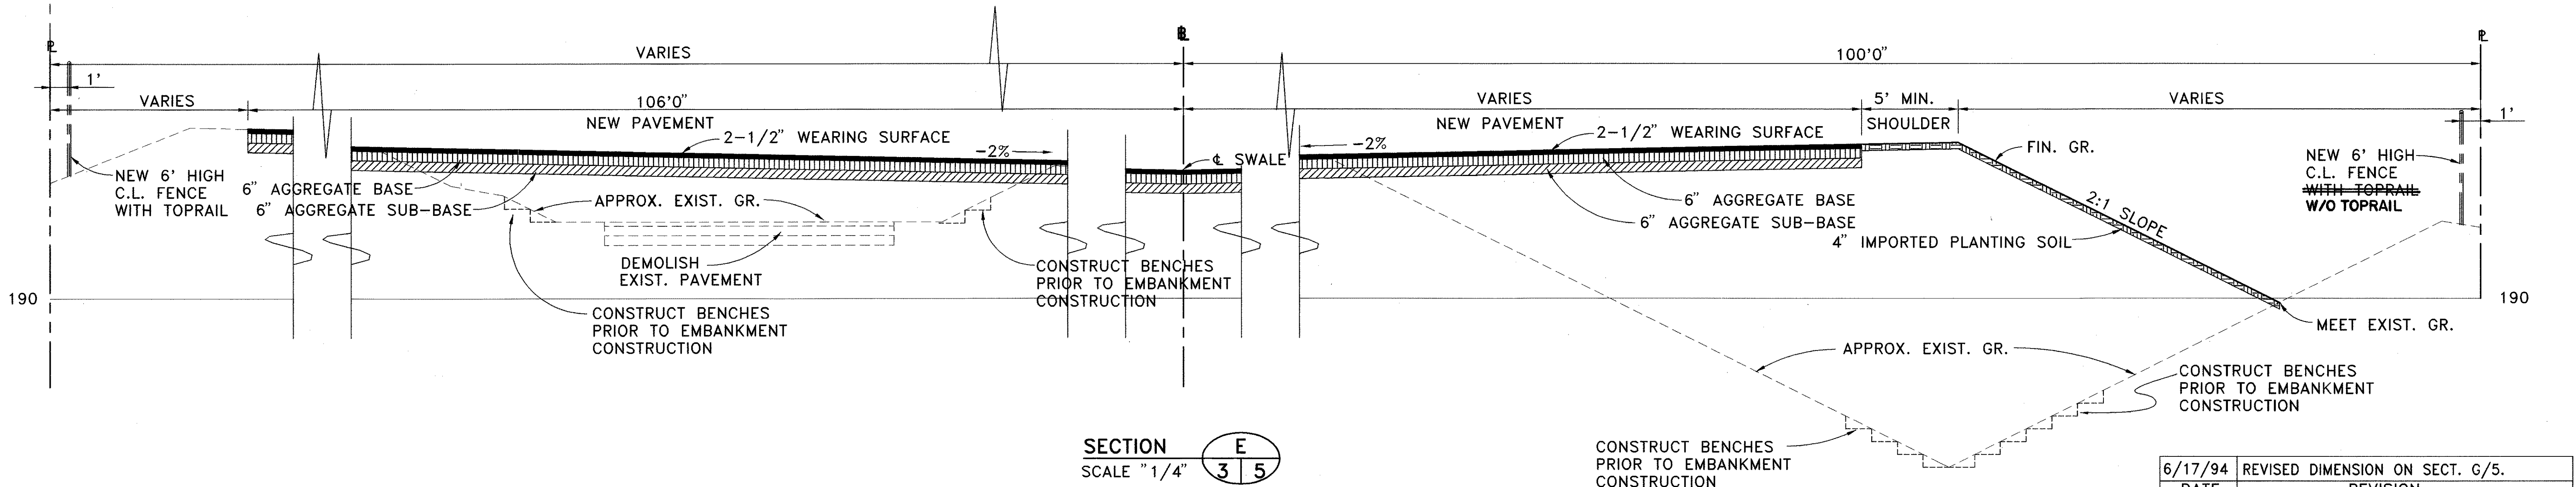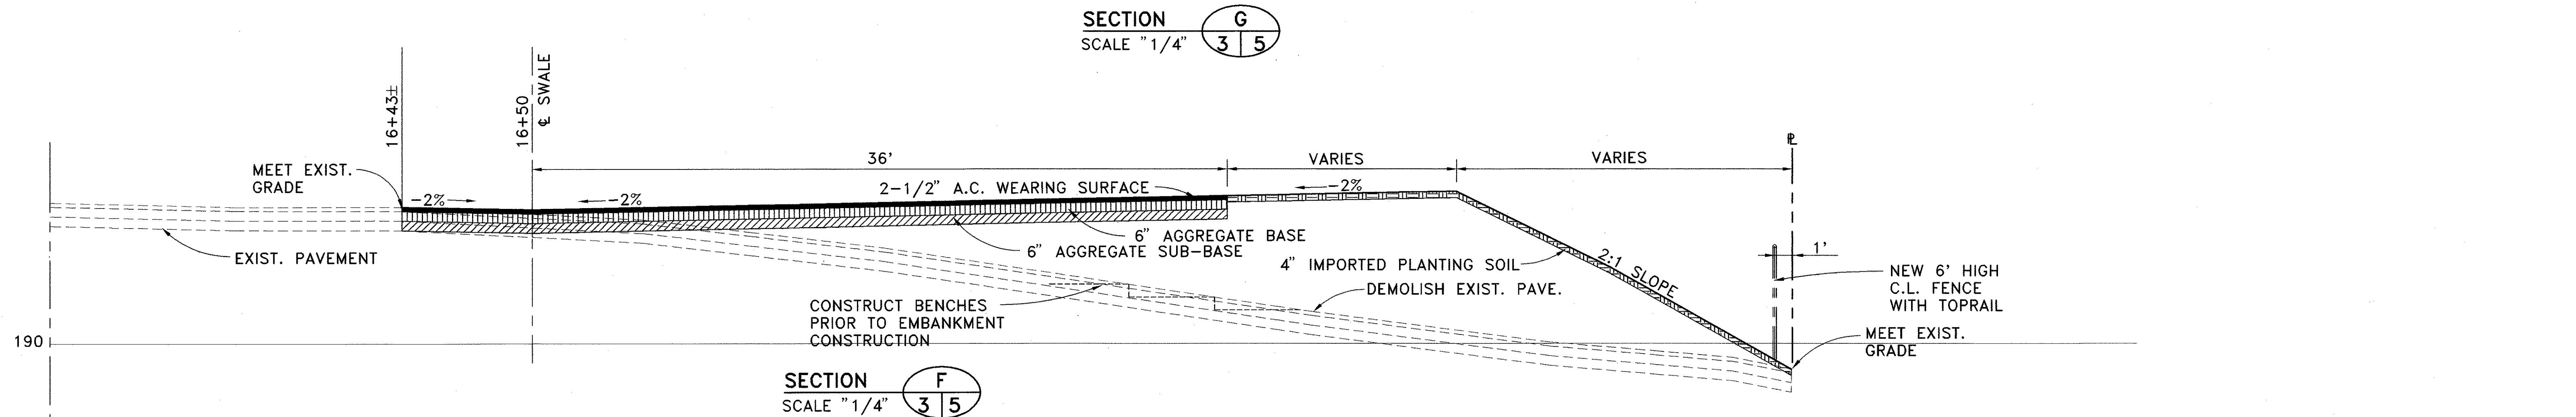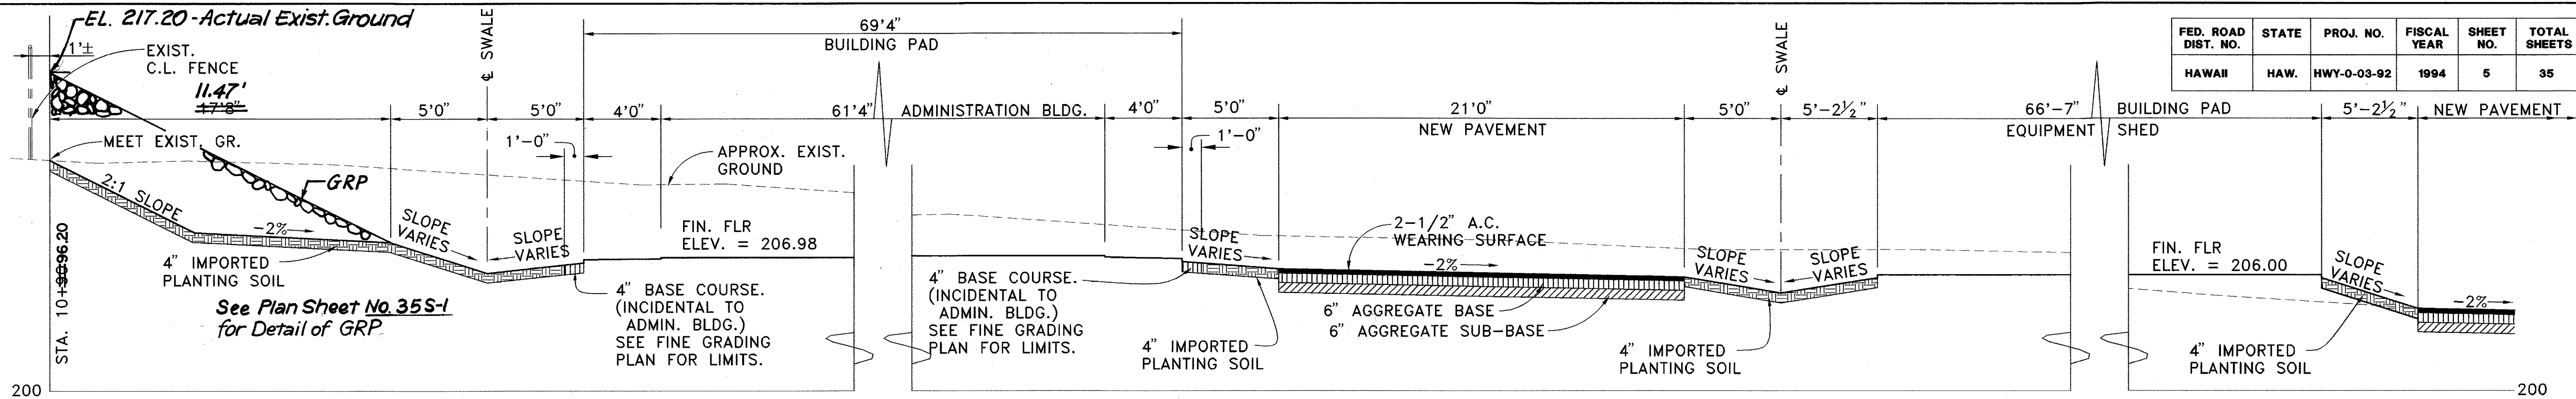

NOTE:
NEW A.C. WEARING SURFACE SHALL CONSIST OF:
2 1/2" OF MIX NO. IV - C.C.O. NO. IV
~~1 1/4" OF MIX NO. V WEARING COURSE,~~
~~1 1/4" OF MIX NO. III LEVELING COURSE~~

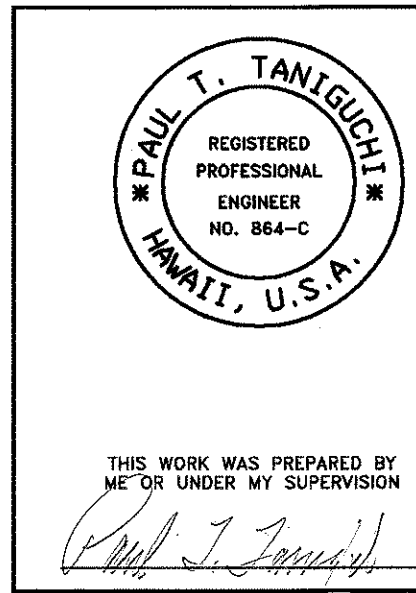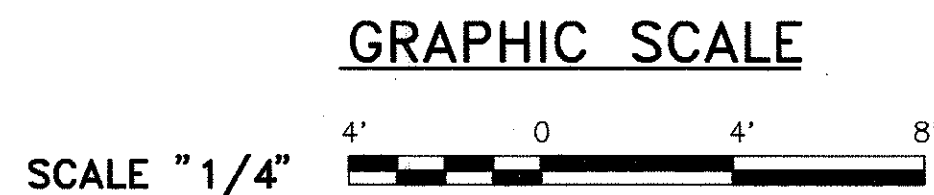

6/17/94	REVISD DIMENSION ON SECT. G/5.
DATE	REVISION
STATE OF HAWAII DEPARTMENT OF TRANSPORTATION HIGHWAYS DIVISION	
TYPICAL SECTIONS	
KANEHOE BASE YARD, PHASE II	
ADMINISTRATION BUILDING	
PROJECT NO. HWY-0-03-92	
SCALE: AS NOTED	DATE: 4/15/94
SHEET NO. 5 OF 35 SHEETS	