


FED. ROAD DIST. NO.	STATE	PROJ. NO.	FISCAL YEAR	SHEET NO.	TOTAL SHEETS
HAWAII	HAW.	HWY-0-18-98	1999	3	12

Notes:

- For Typical Trench, See Detail 4 C1C3
- See Sheet C2 For Wash Pad Plan And Sections.

LEGEND	
EXISTING	DESCRIPTION
	SINGLE LINE FOR AS-BUILT DELETION
	HATCH LINE FOR AS-BUILT DELETION
	HATCH LINE FOR TEXT AS-BUILT DELETION
	TEXT FOR AS-BUILT POSTING

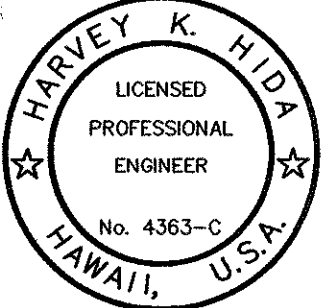

THIS WORK WAS PREPARED BY ME OR UNDER MY SUPERVISION

3-10-2001


STATE OF HAWAII
DEPARTMENT OF TRANSPORTATION
HIGHWAYS DIVISION

SITE & UTILITY PLAN

KEEHI BASEYARD WASHDOWN AREA
PROJECT NO. HWY-0-18-98

SCALE: AS NOTED DATE: OCT 1998

SHEET No. C1 OF 12 SHEETS

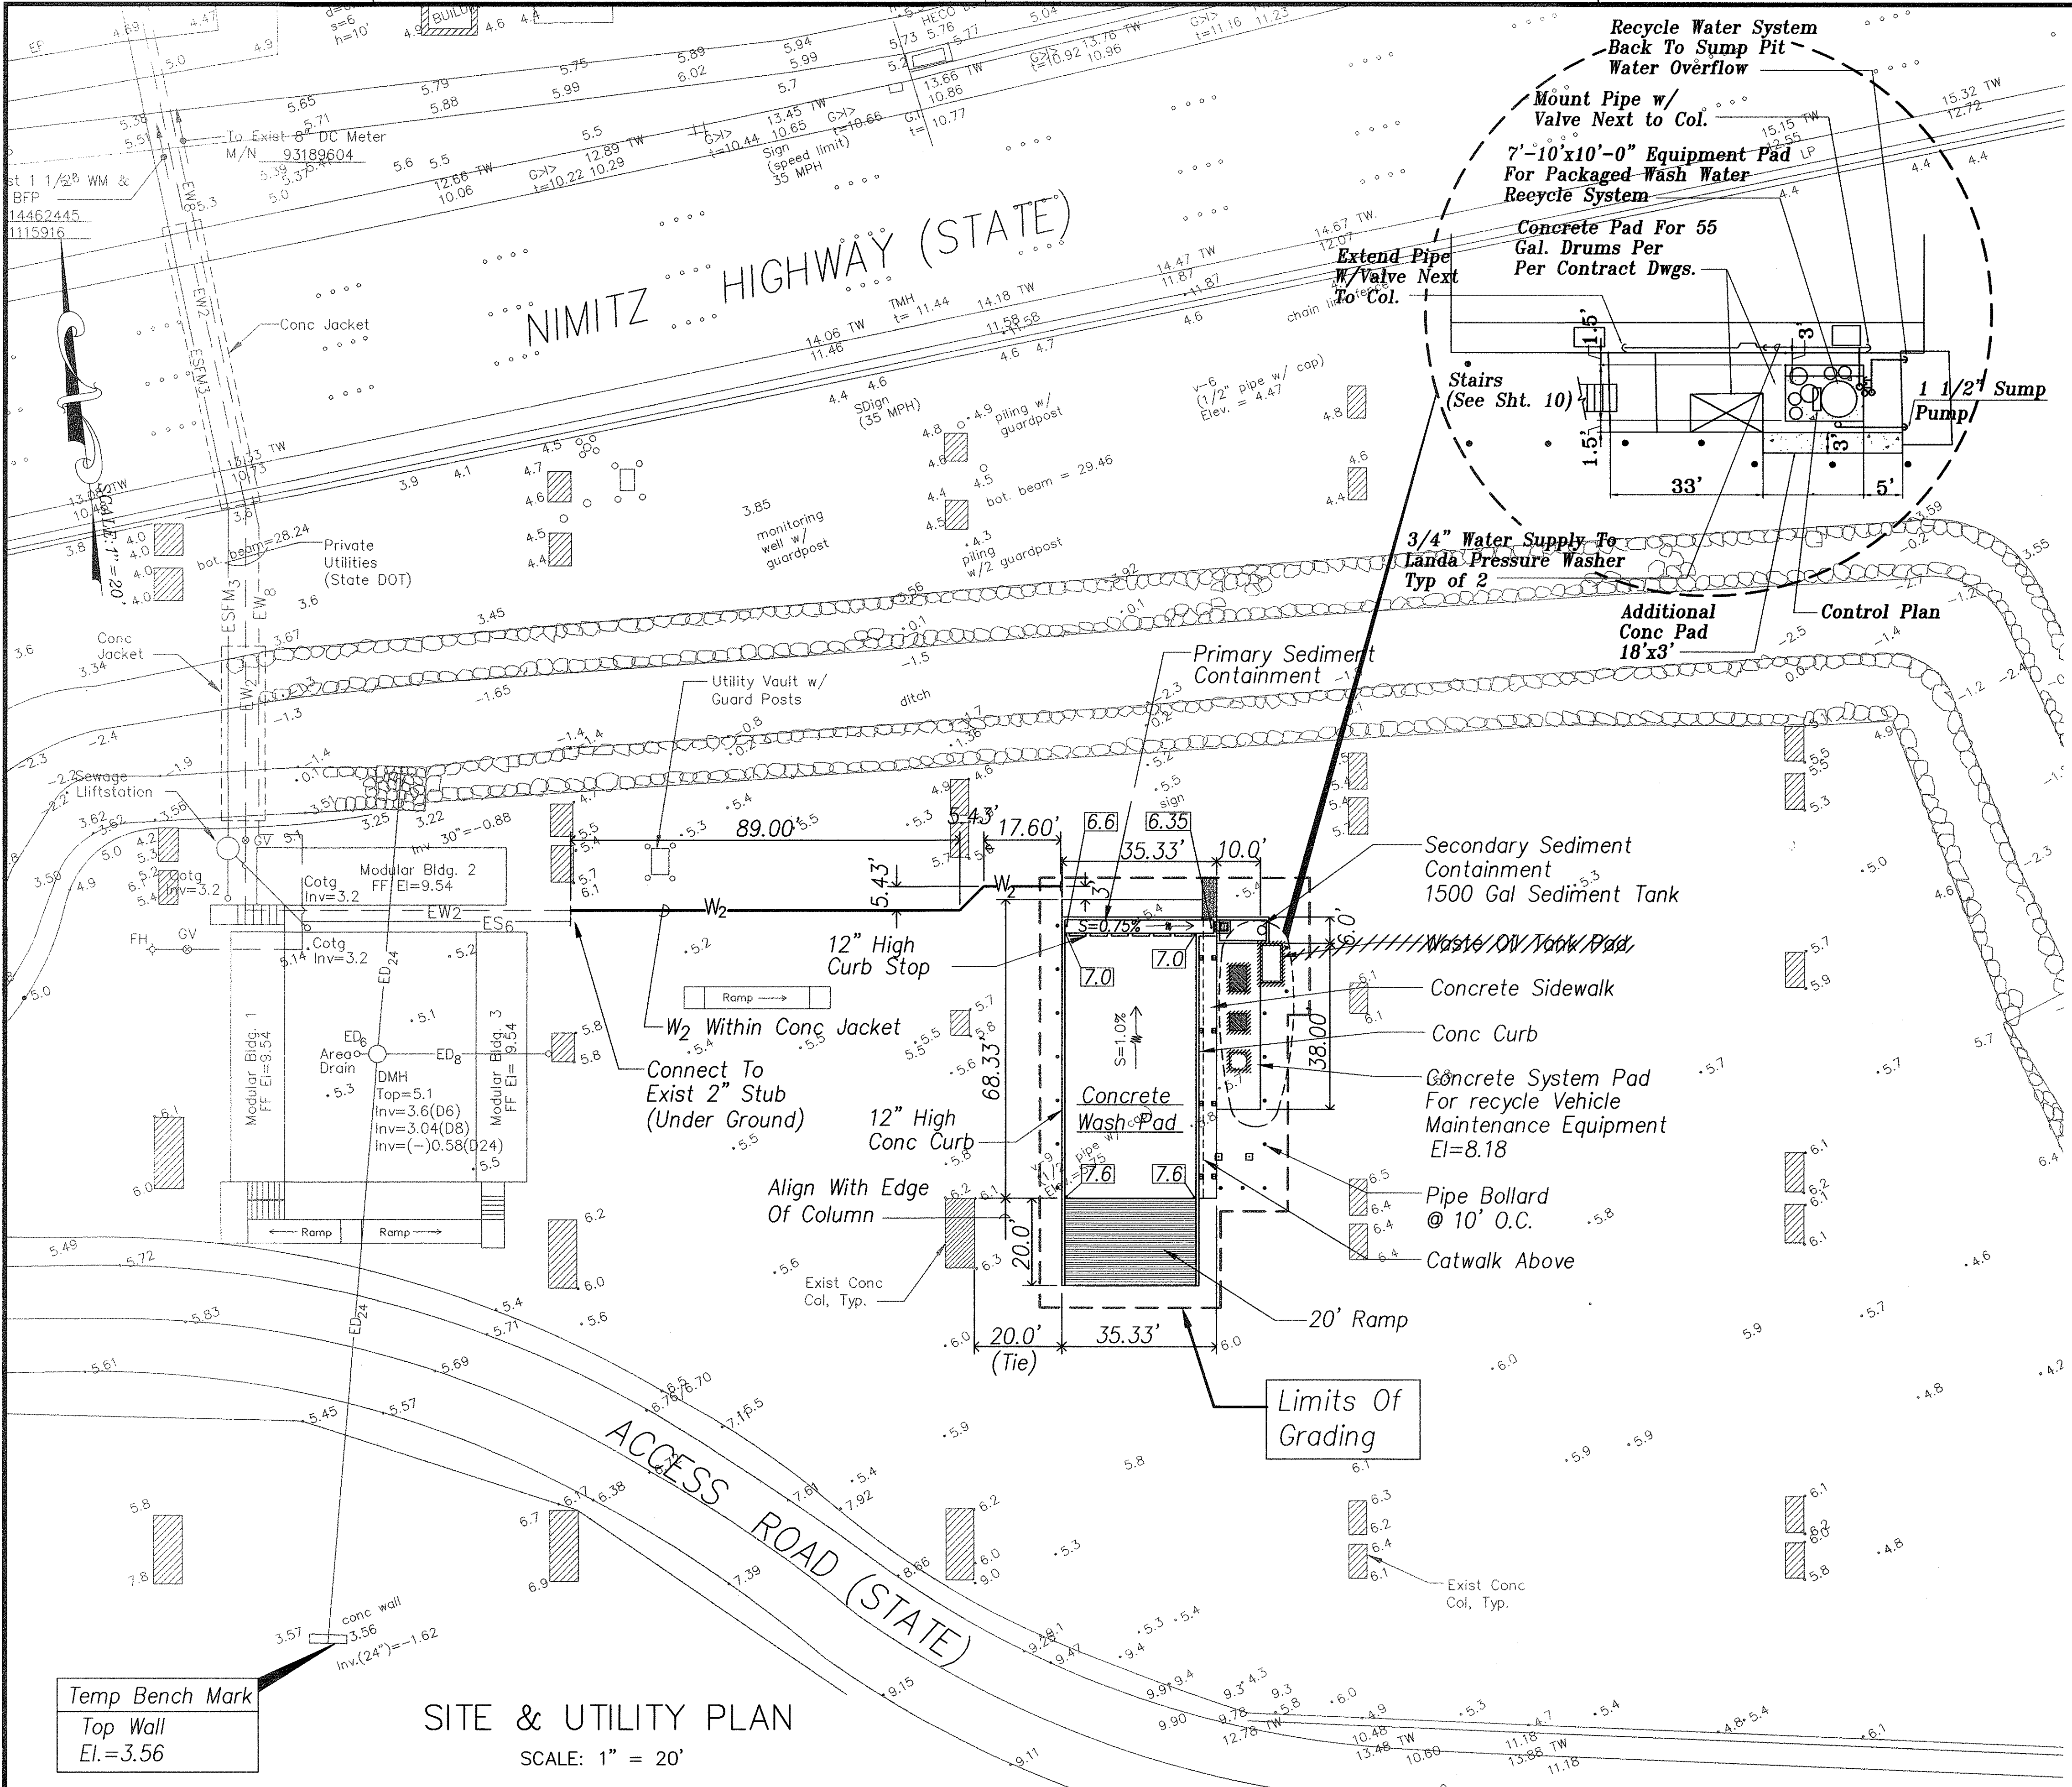

DATE	_____
SURVEY PLOTTED BY	_____
DRAWN BY	_____
DESIGNED BY	_____
CHECKED BY	_____
ORIGINAL PLAN	_____
NOTE BOOK	_____
QUANTITIES BY	_____
CHECKED BY	_____

Temp Bench Mark
Top Wall
El.=3.56

SITE & UTILITY PLAN
SCALE: 1" = 20'

AS-BUILT