	INDEX TO DRAWINGS
SHEET NO.	DESCRIPTION
1	TITLE SHEET
2	GENERAL NOTES
3	SITE & UTILITY PLAN
4	WASHPAD PLAN & SECTIONS
5	DETAILS
6	DETAILS
7	DETAILS
8	DETAILS
9	FLOW DIAGRAM & PIPING ISOMETRIC
10	CATWALK PLANS, SECTION & DETAIL
11	CATWALK & STAIR SECTIONS & DETAIL
12	ELECTRICAL SITE PLAN

STATE OF HAWAII

DEPARTMENT OF TRANSPORTATION

HIGHWAYS DIVISION HONOLULU, HAWAII


MAS-BUILTM

PLANS FOR

KEEHI BASEYARD WASHDOWN AREA


PROJECT NO. HWY-0-18-98

DISTRICT OF HONOLULU ISLAND OF OAHU

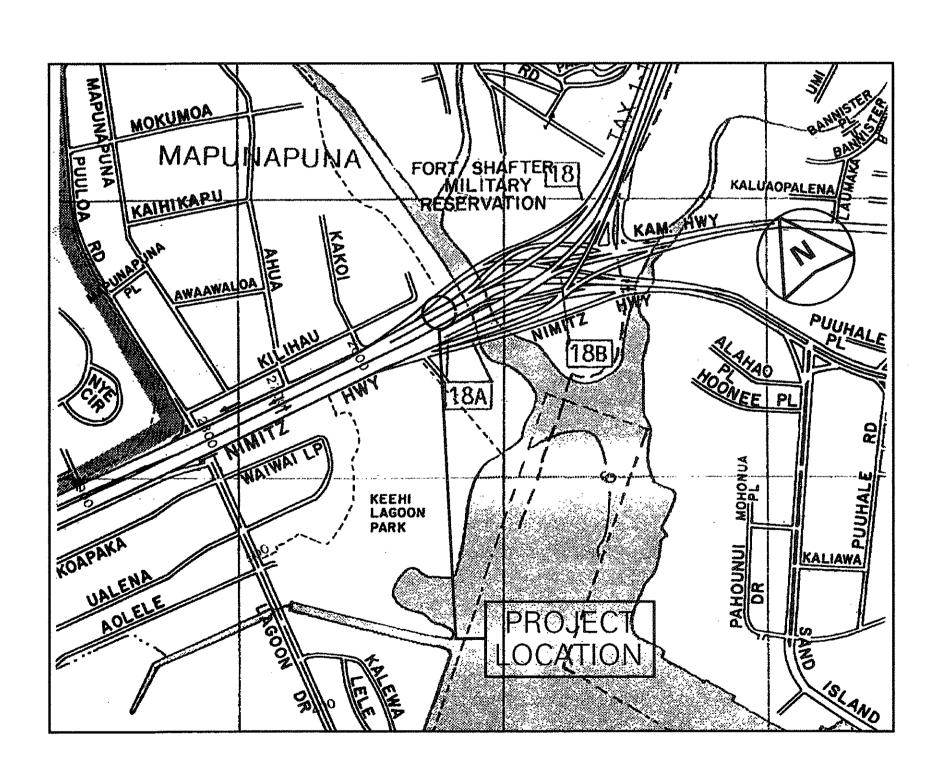

LOCATION PLAN



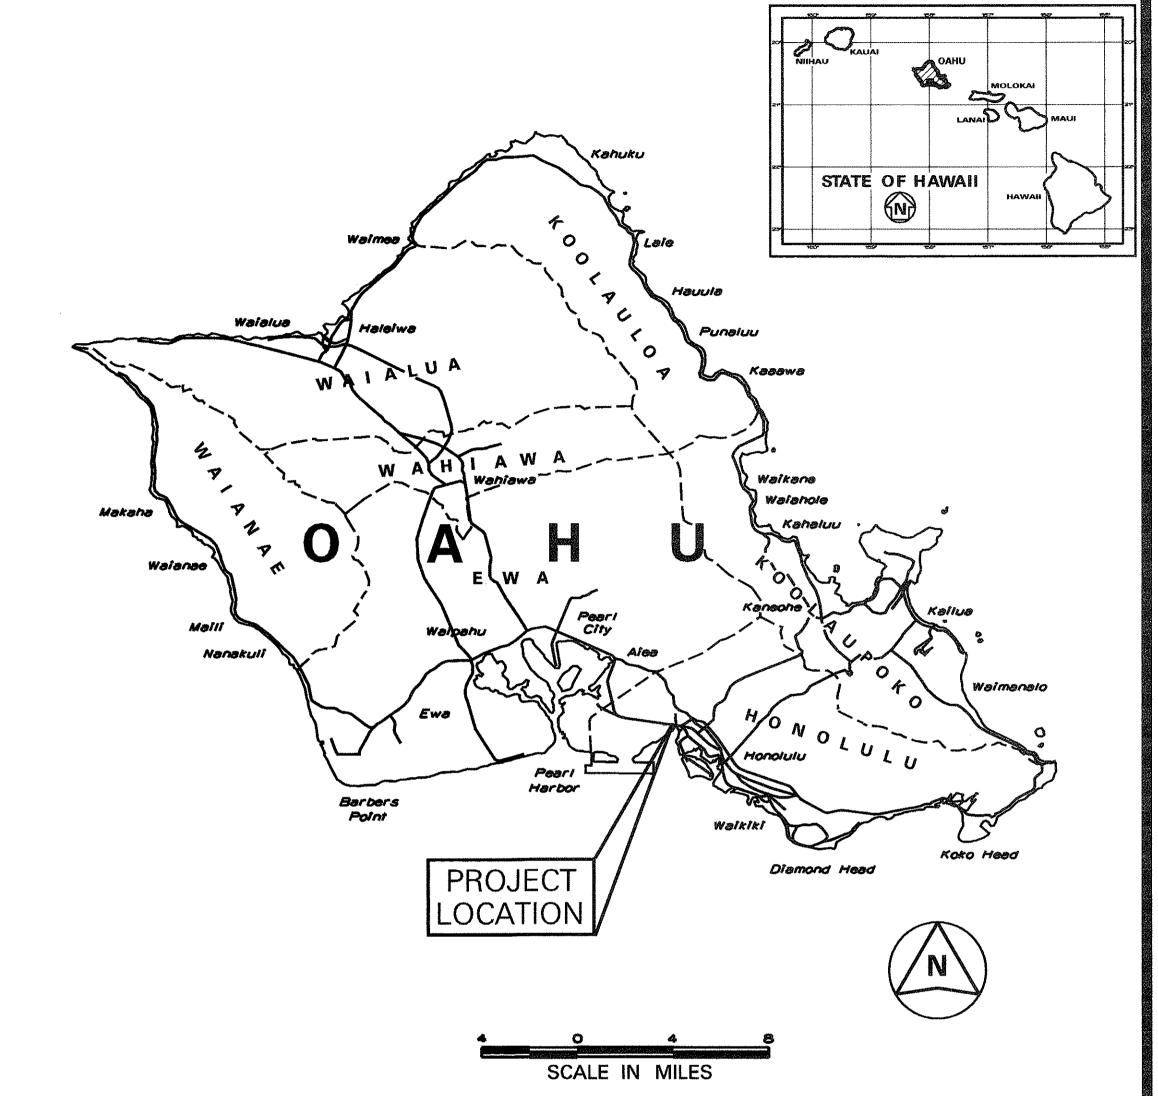

CHANGES MADE DURING CONSTRUCTION HAVE BEEN INCORPORATED ON THESE PLANS EXCEPT CHANGES IN THE ORIGINAL THEORETICAL QUANTITIES. FOR ACTUAL QUANTITIES, REFER TO PROJECT LEDGER AND/OR COMPUTATION BOOK.

HWY-O-18-98 1999

Side y S C Te 11/28/0/

DEPARTMENT OF TRANSPORTATION STATE OF HAWAII APPROVED:

DIR. OF TRANSPORTATION

1

R. Furomoto & Assoc, In DESIGNED BY