
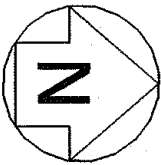
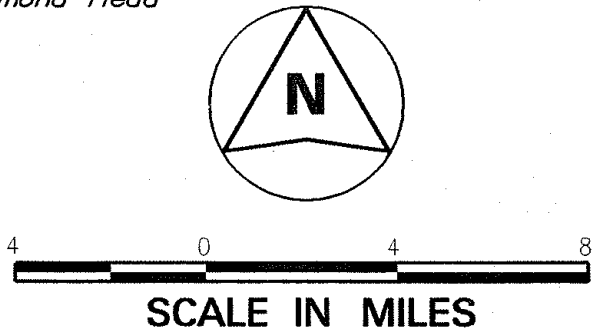
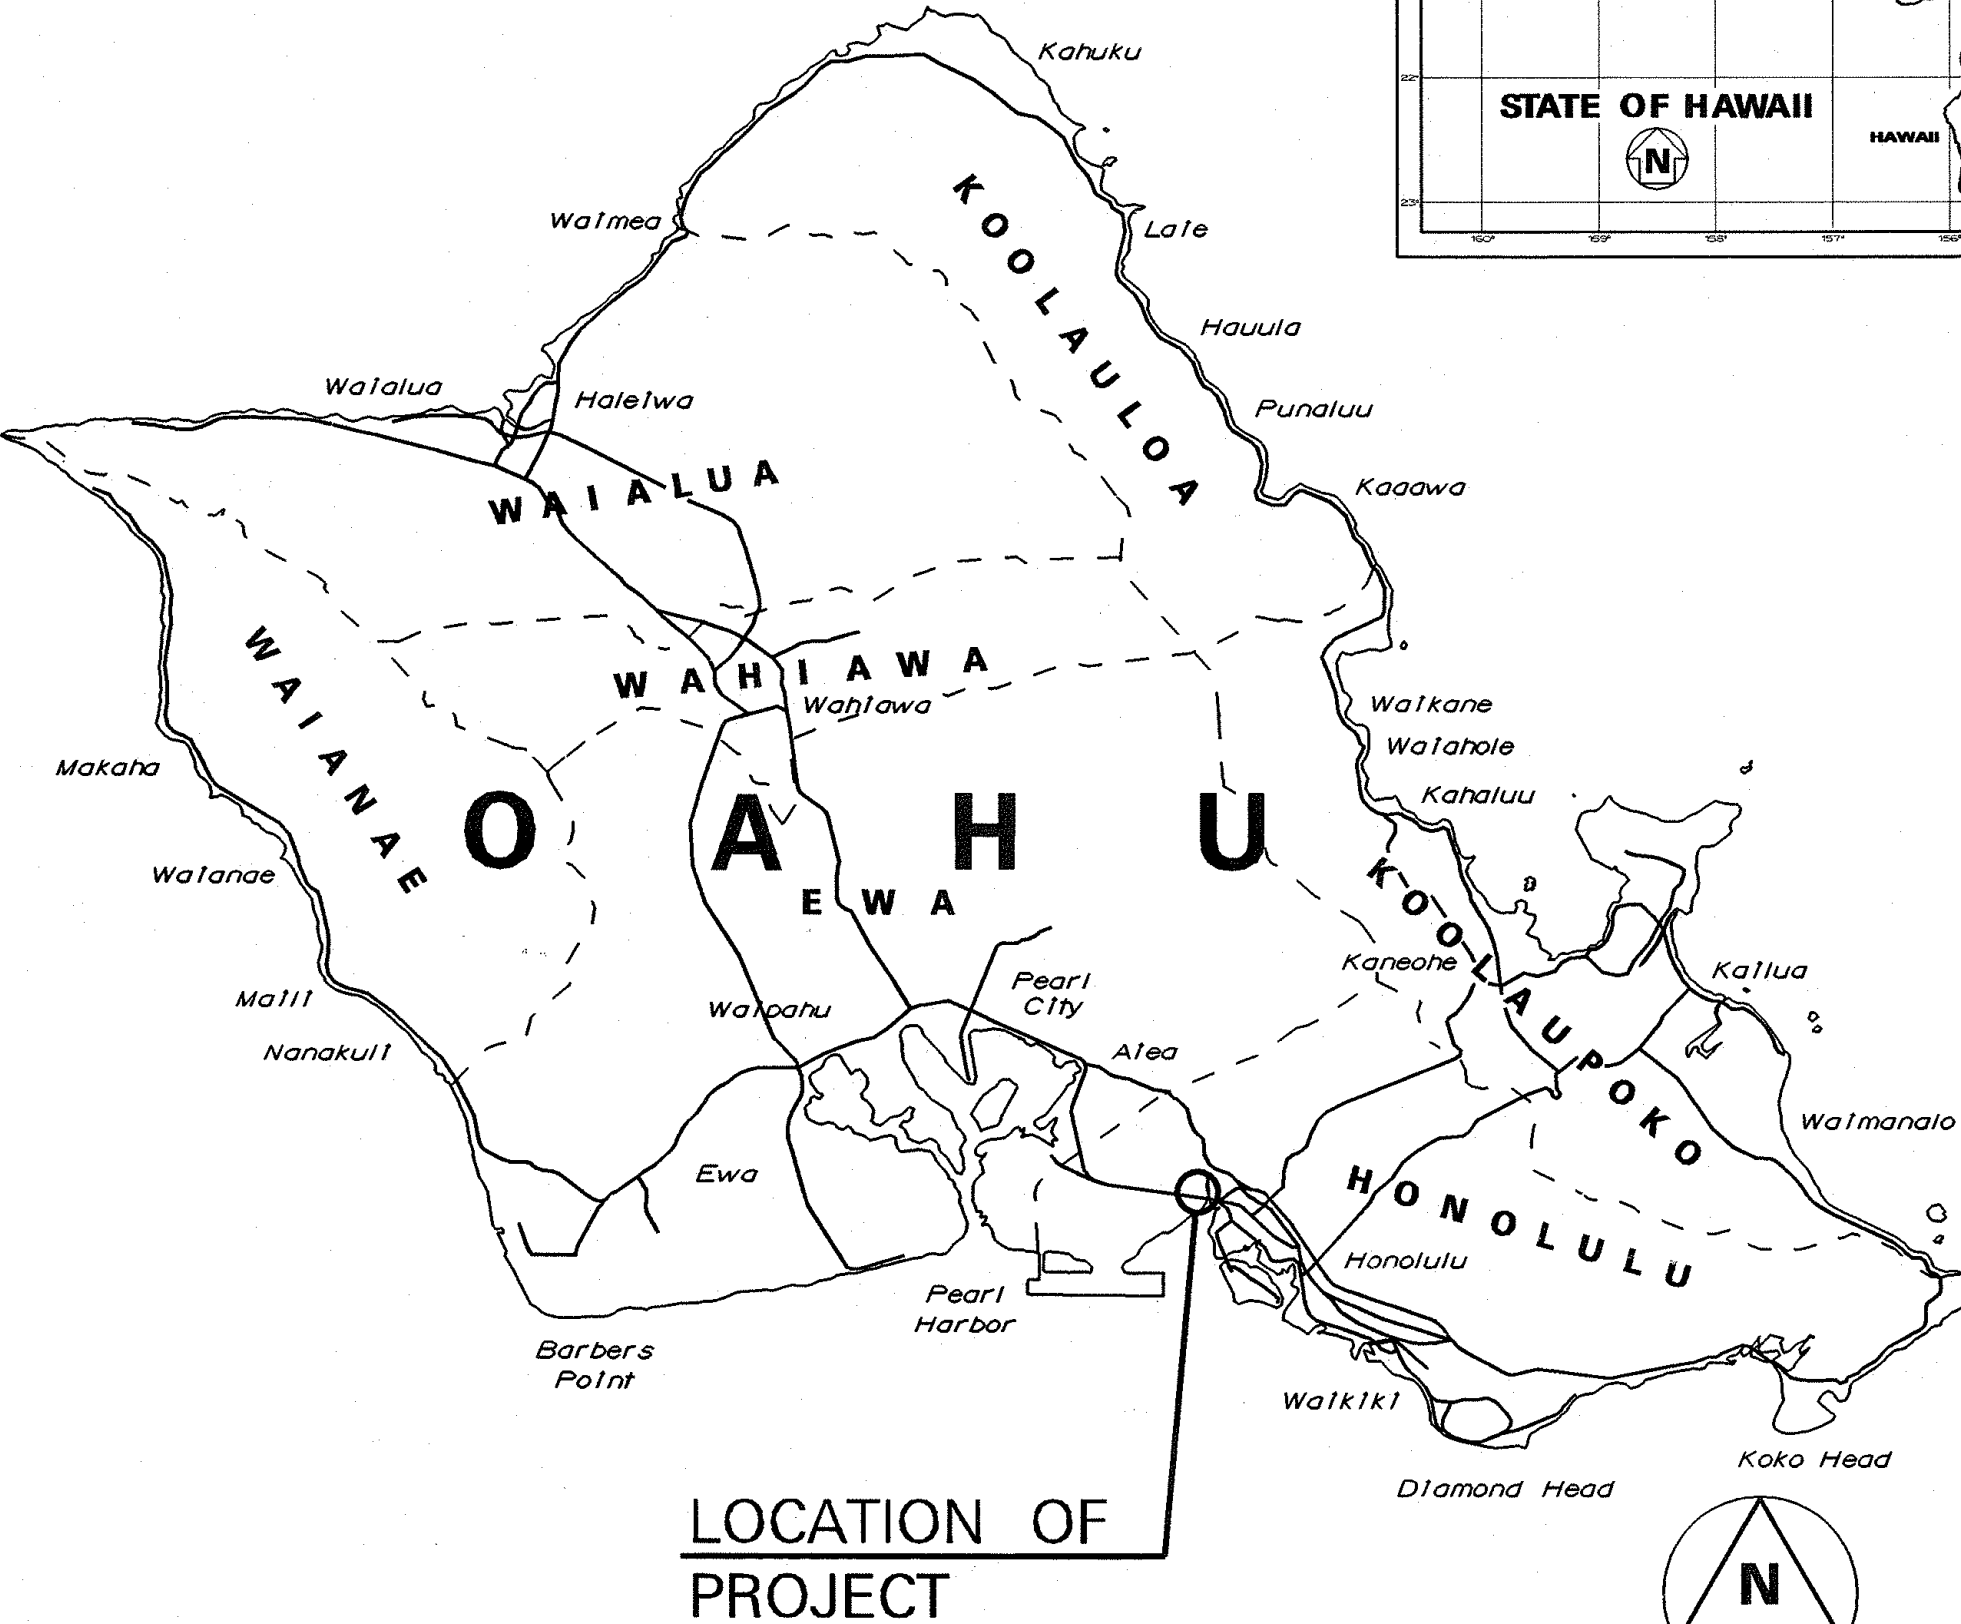



INDEX TO DRAWINGS	
SHEET NO.	DESCRIPTION
1	TITLE SHEET
2	STANDARD PLAN SUMMARY
3	GENERAL NOTES AND LEGEND
4 - 5	WATER POLLUTION AND EROSION CONTROL NOTES
6	PLAN
7	GRADING PLAN
8	DRAINAGE PLAN
9	GENERAL NOTES, INDEX TO DWGS, ESTIMATES, QUANTITIES, ABBREVIATIONS, AND SYMBOLS
10	CMU WALL PLAN AND ELEVATION
11	CMU WALL DETAILS

STATE OF HAWAII
DEPARTMENT OF TRANSPORTATION
HIGHWAYS DIVISION
HONOLULU, HAWAII
"AS-BUILT"
PLANS FOR
**OAHU DISTRICT
REAR MAINTENANCE YARD RESURFACING
PROJECT NO. HWY-O-01-03M**
DISTRICT OF HONOLULU
ISLAND OF OAHU


FED. ROAD DIST. NO.	STATE	PROJ. NO.	FISCAL YEAR	SHEET NO.	TOTAL SHEETS
HAWAII	HAW.	HWY-O-01-03M	2004	1	11

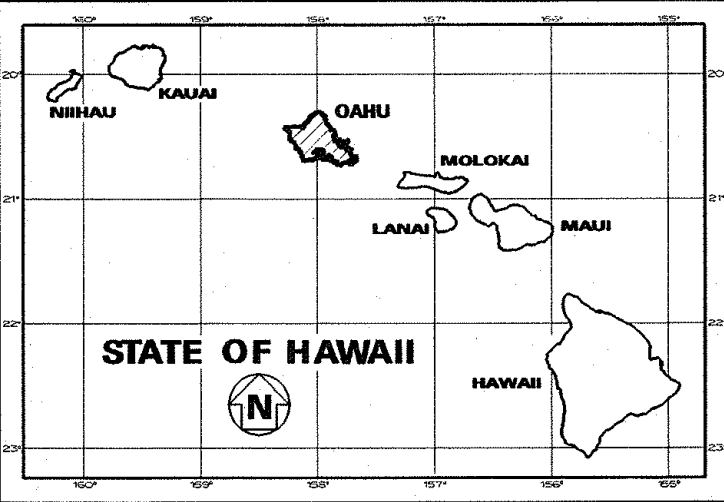

NIMITZ HIGHWAY

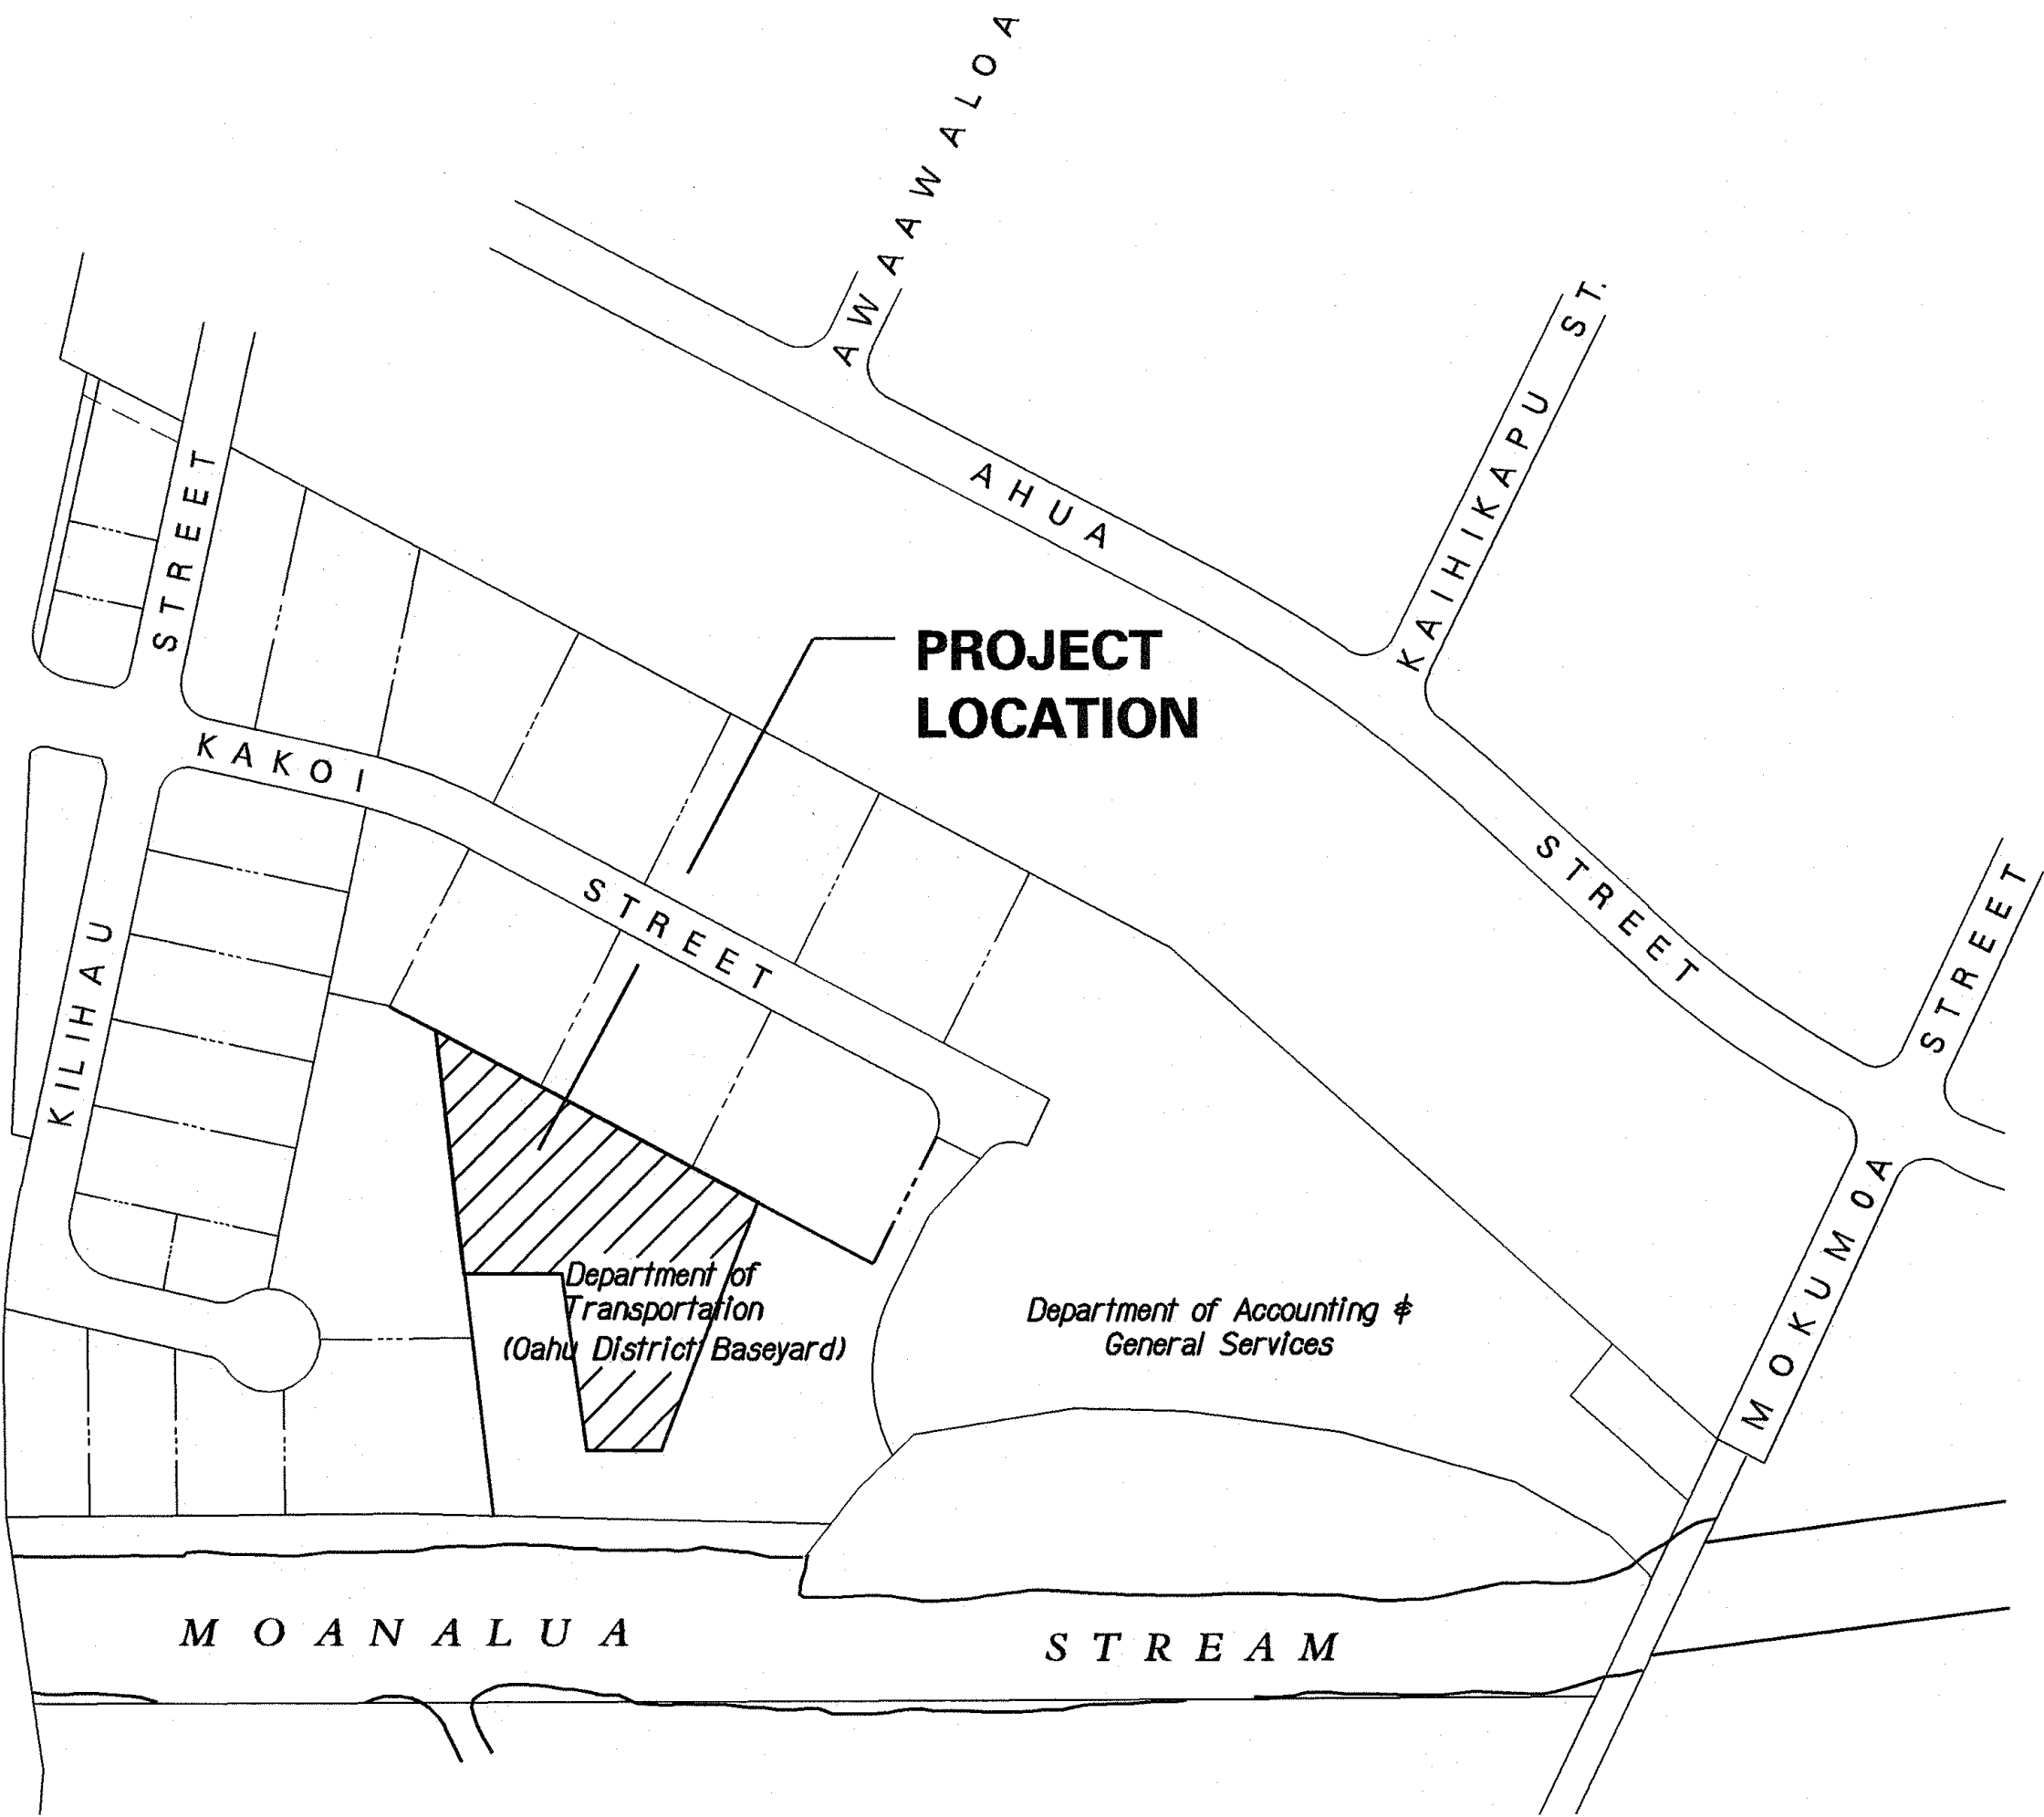

LAYOUT PLAN

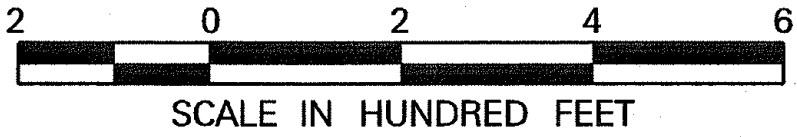

CHANGES MADE DURING CONSTRUCTION HAVE BEEN INCORPORATED ON THIS SET EXCEPT CHANGES IN THE ORIGINAL THEORETICAL QUANTITIES. FOR ACTUAL QUANTITIES, REFER TO PROJECT LEDGER AND/OR COMPUTATION BOOK.
[Signature] 0-25-08
REGISTERED ENGINEER DATE

DEPARTMENT OF TRANSPORTATION
STATE OF HAWAII
APPROVED:
[Signature] 11.4.03
DIR. OF TRANSPORTATION DATE

HWY-D DESIGNED BY
HWY-DD MANAGED BY
692-7570 PHONE
JUNE, 2003 DATE