



FED. ROAD DIST. NO.	STATE	PROJ. NO.	FISCAL YEAR	SHEET NO.	TOTAL SHEETS
HAWAII	HAW.	HWY-0-09-06	2008	ADD. 22	46

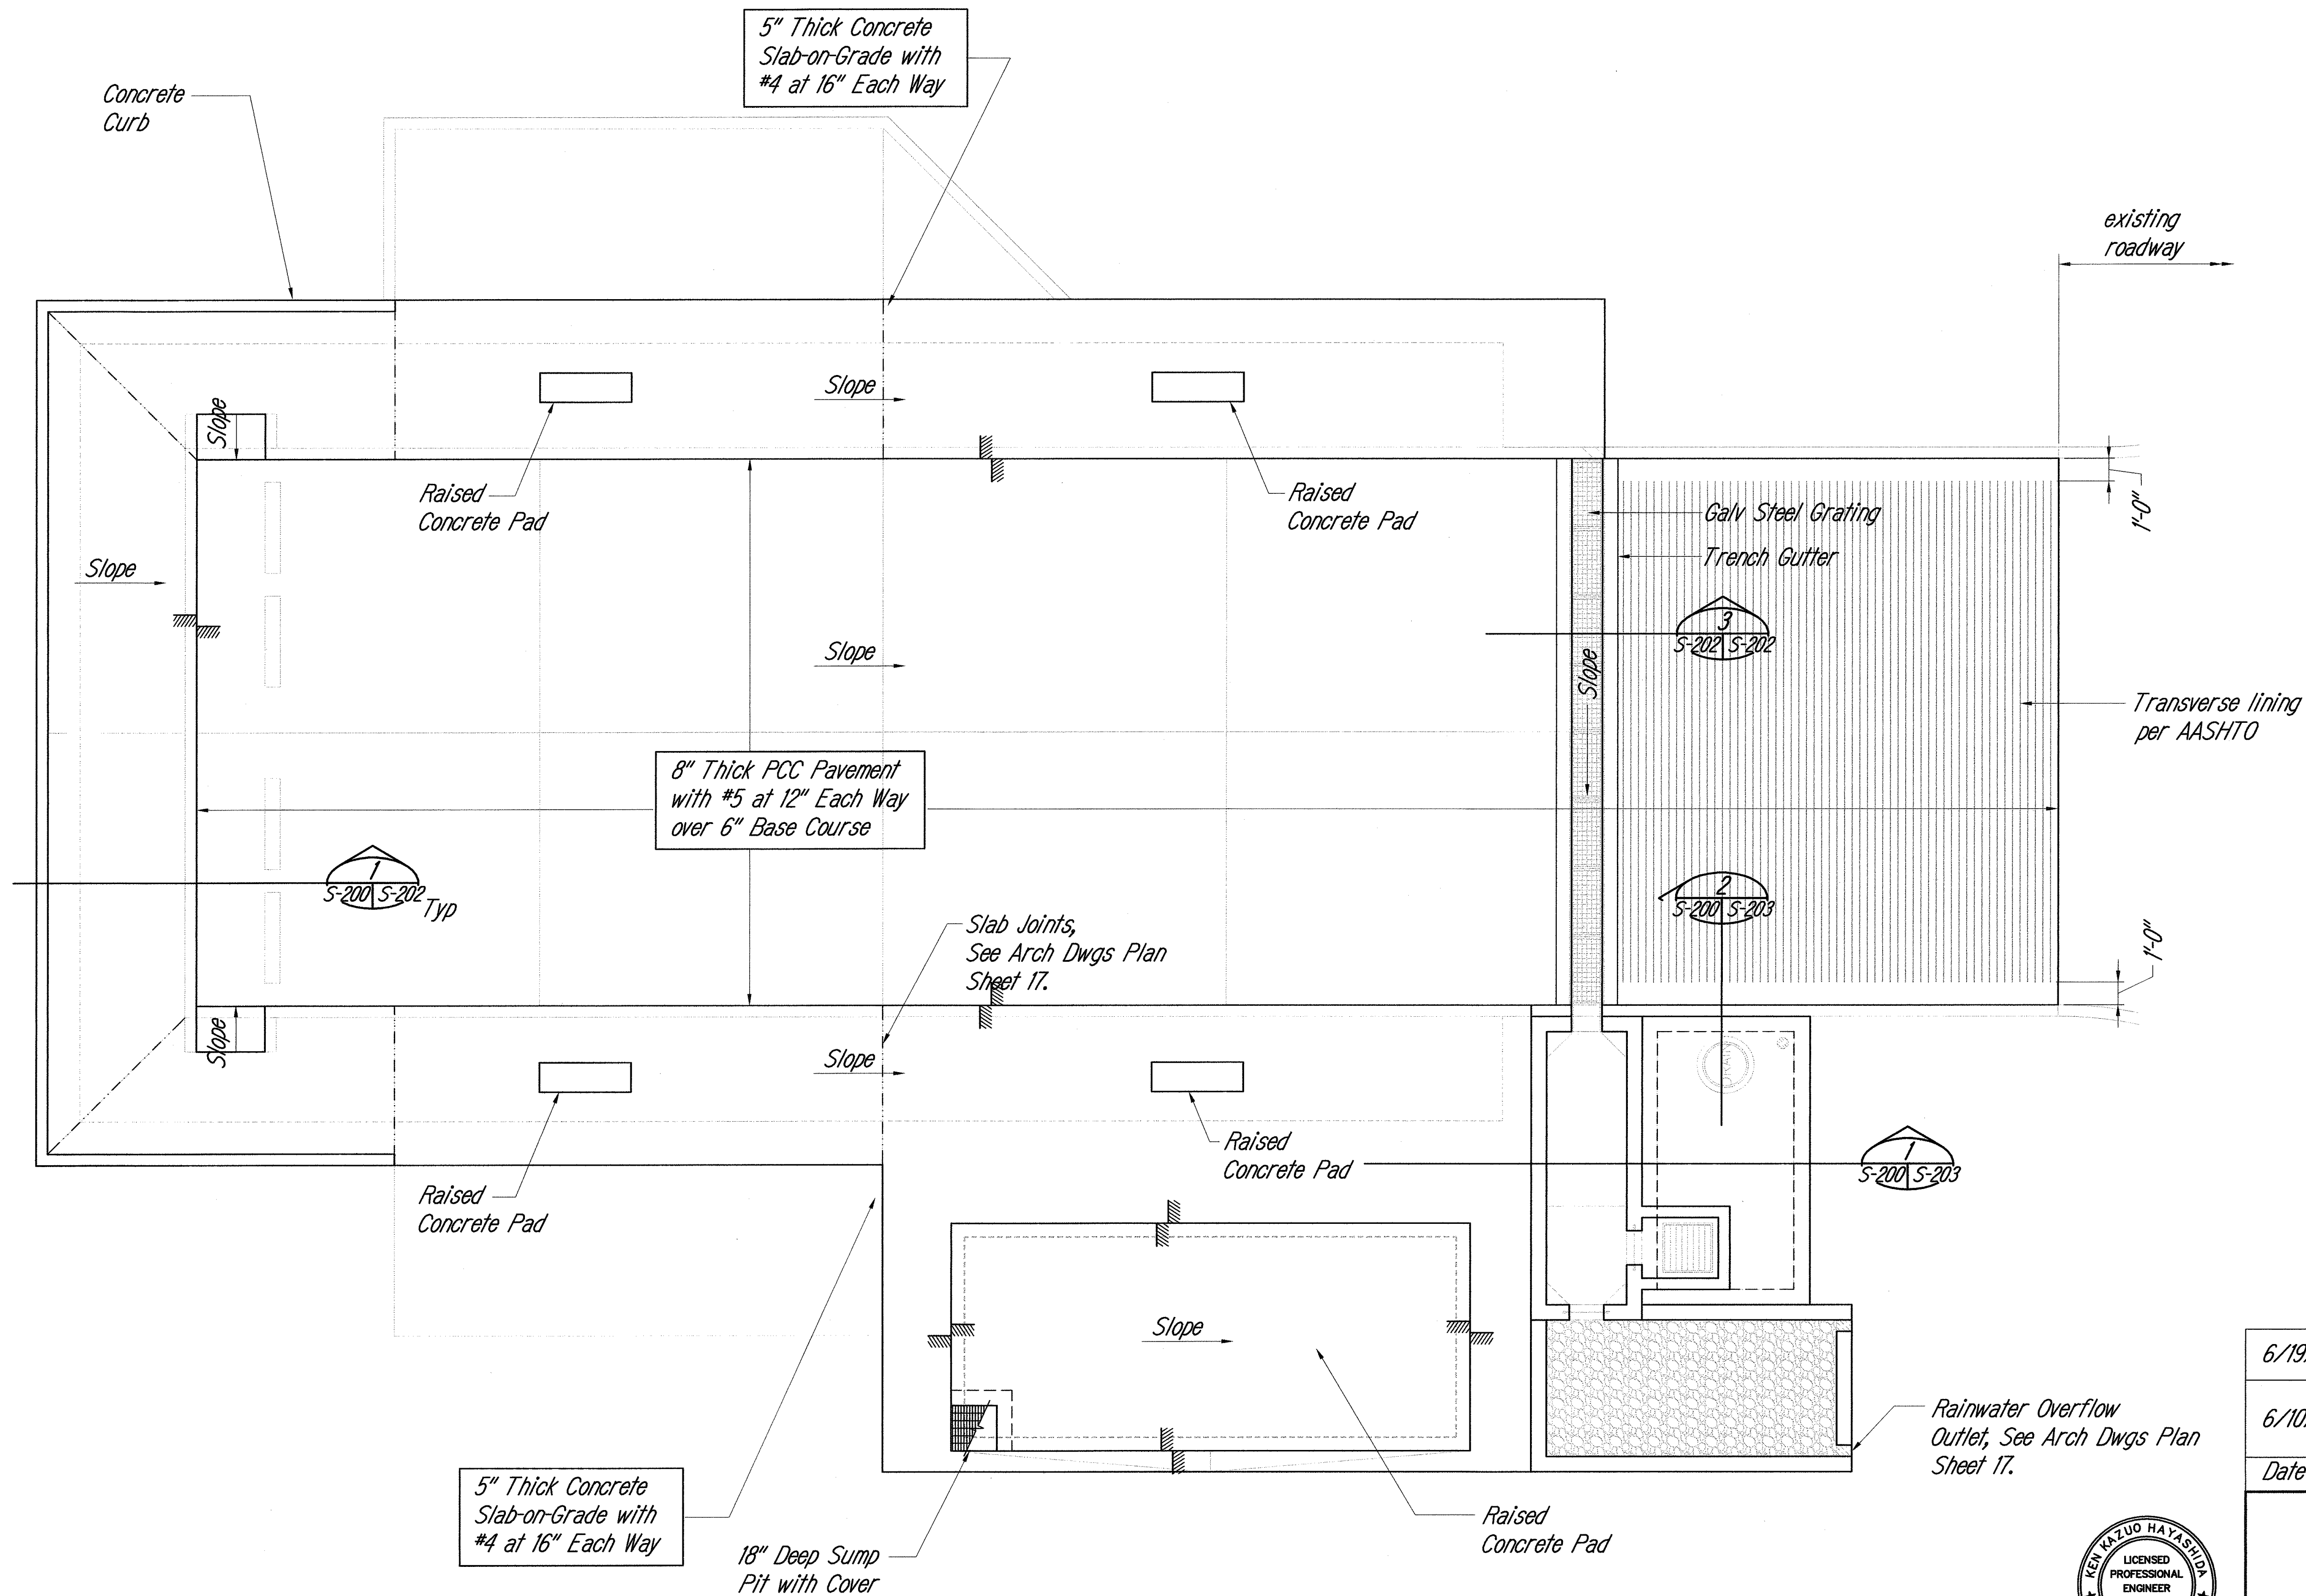

SURVEY PLOTTED BY	DATE
DRAWN BY	
CHECKED BY	
NOTED BY	
QUANTITIES BY	
CHECKED BY	
No.	

WASHDOWN RACK FOUNDATION PLAN

Scale : 1/4" = 1'-0"

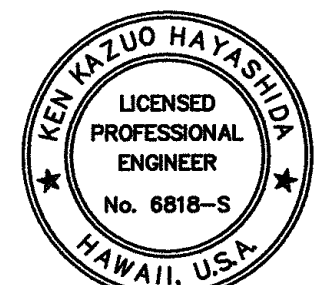

THIS WORK WAS PREPARED BY
ME OR UNDER MY SUPERVISION

6/19/08	Revised PCC Pavement Thickness
6/10/08	Delete catwalk, Reinf PCC, Add concrete pad and Lining at driveway
Date	Revision


STATE OF HAWAII
DEPARTMENT OF TRANSPORTATION
HIGHWAYS DIVISION
PEARL CITY BASEYARD
STRUCTURAL PLAN
KANEOHE, PEARL CITY AND WAIANAE
BASEYARD WASHDOWN RACKS
Project No. HWY-0-09-06

SCALE: AS NOTED DATE: MAY 2008

SHEET No. S-200 OF 46 SHEETS

ADD. 22

FED. ROAD DIST. NO.	STATE	PROJ. NO.	FISCAL YEAR	SHEET NO.	TOTAL SHEETS
HAWAII	HAW.	HWY-0-09-06	2008	ADD. 23	46

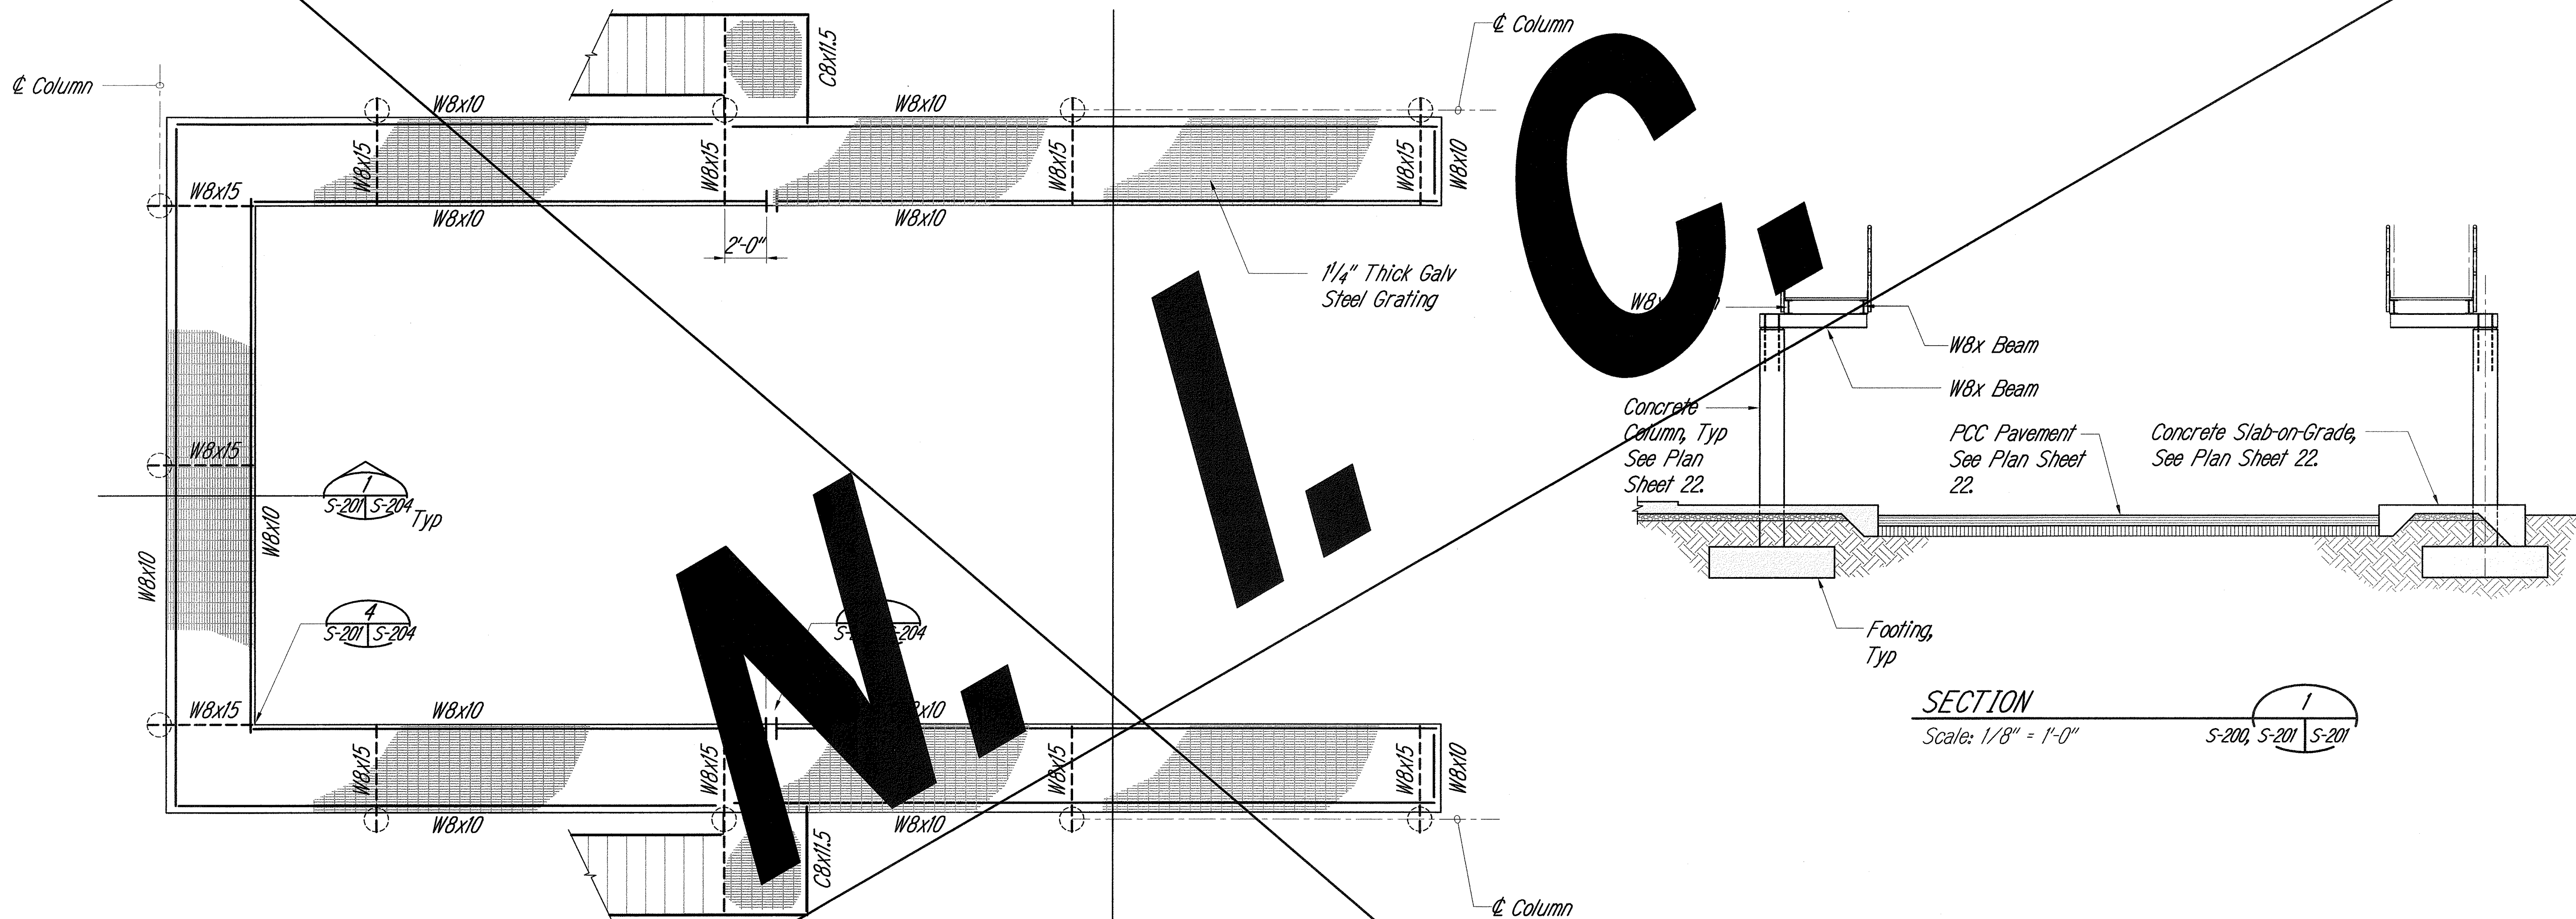


Grating Notes:
Grating shall consist of 1 1/4" x 3/16" bearing bars at 1 3/16" o.c. with 1/4" min cross bars at 4" o.c. Provide 1" x 1/4" end bands at all supports. All joints shall be fully welded and ground smooth prior to galvanizing. Provide galvanized steel clips to attach grating to steel beams (4" min for each panel).

CATWALK FRAMING PLAN
Scale : 1/4" = 1'-0"




SECTION
Scale: 1/8" = 1'-0"

SURVEY PLOTTED BY	DATE
DRAWN BY	
DESIGNED BY	
QUANTITIES BY	
CHECKED BY	
ORIGINAL PLAN	No.
NOTE BOOK	

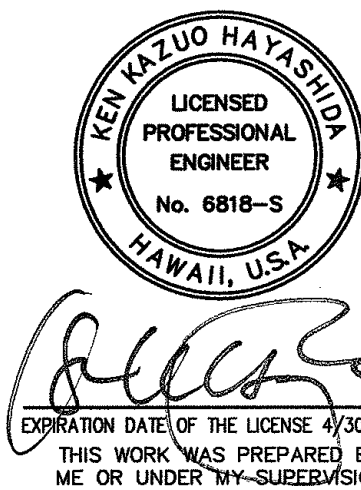


6/10/08	Delete catwalk
Date	Revision
STATE OF HAWAII DEPARTMENT OF TRANSPORTATION HIGHWAYS DIVISION PEARL CITY BASEYARD STRUCTURAL PLAN KANEOHE, PEARL CITY AND WAIANAE BASEYARD WASHDOWN RACKS Project No. HWY-0-09-06	
SCALE: AS NOTED	DATE: MAY 2008

FED. ROAD DIST. NO.	STATE	PROJ. NO.	FISCAL YEAR	SHEET NO.	TOTAL SHEETS
HAWAII	HAW.	HWY-0-09-06	2008	ADD. 24	46

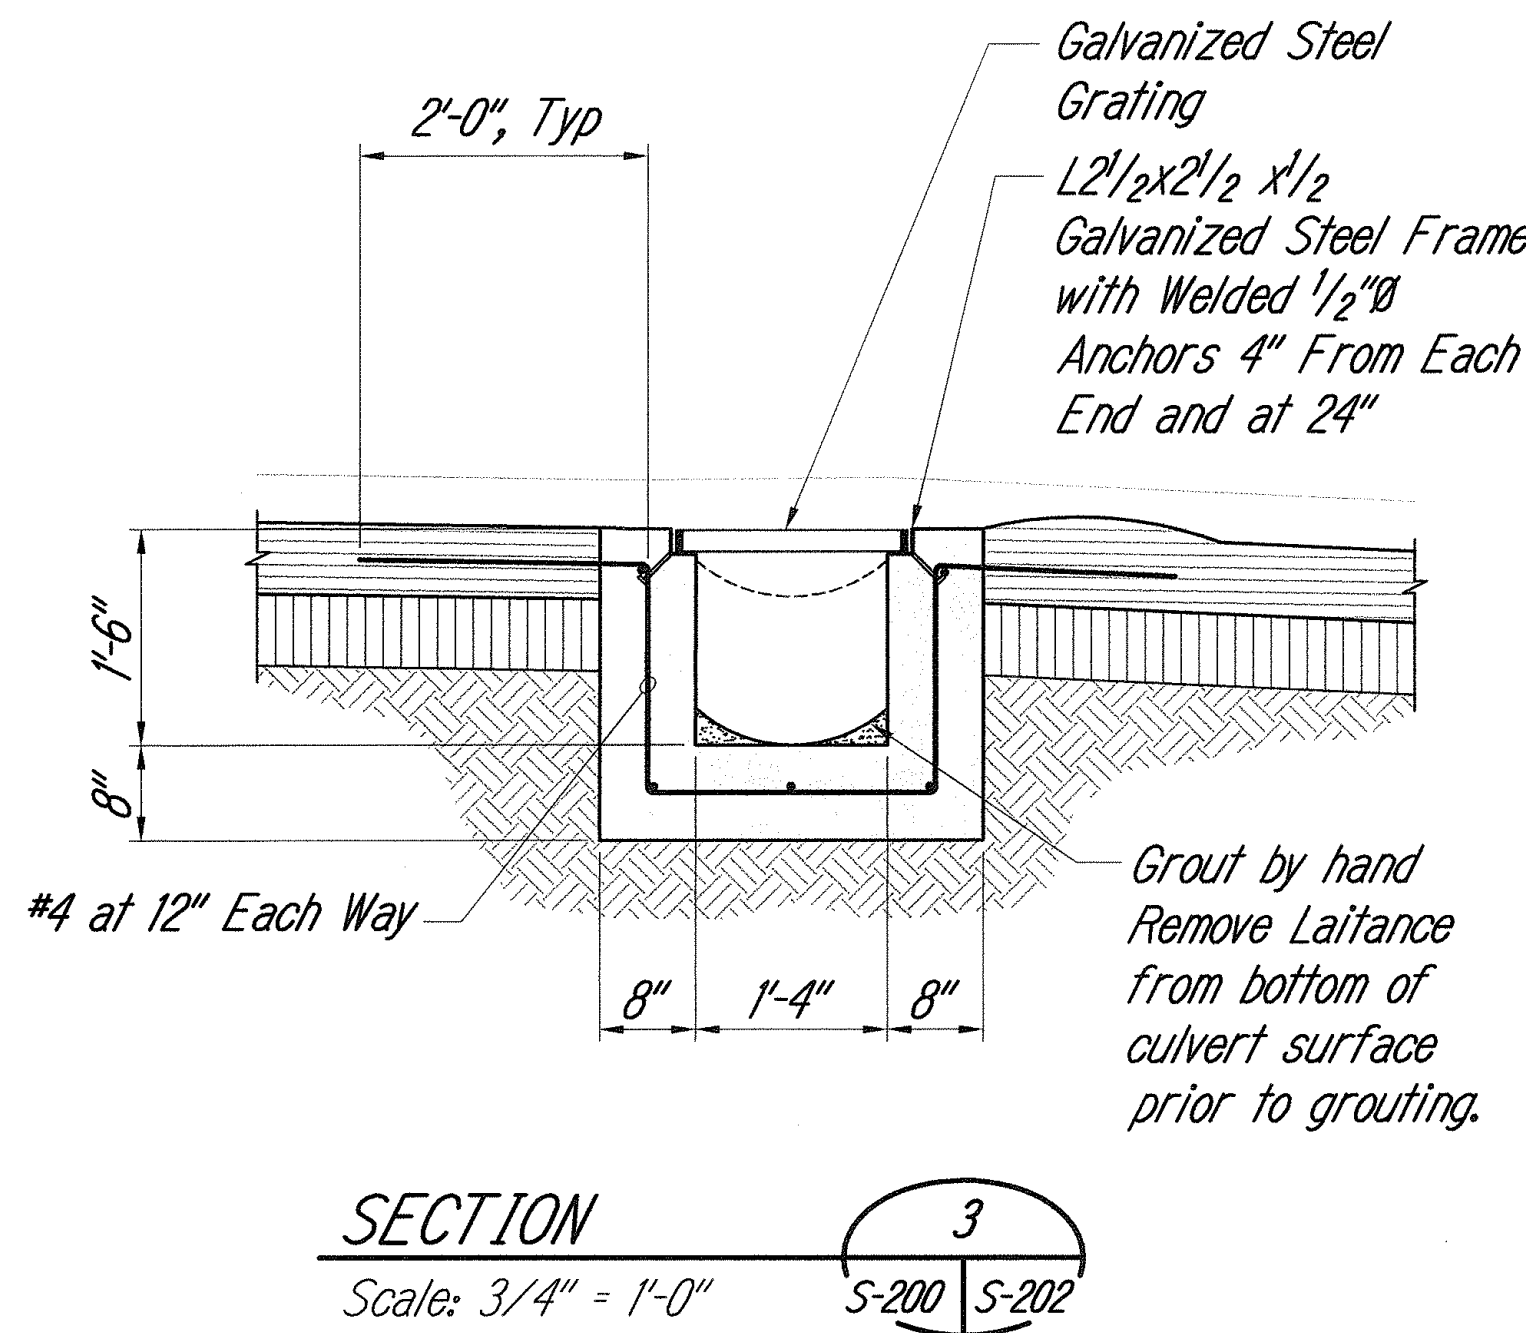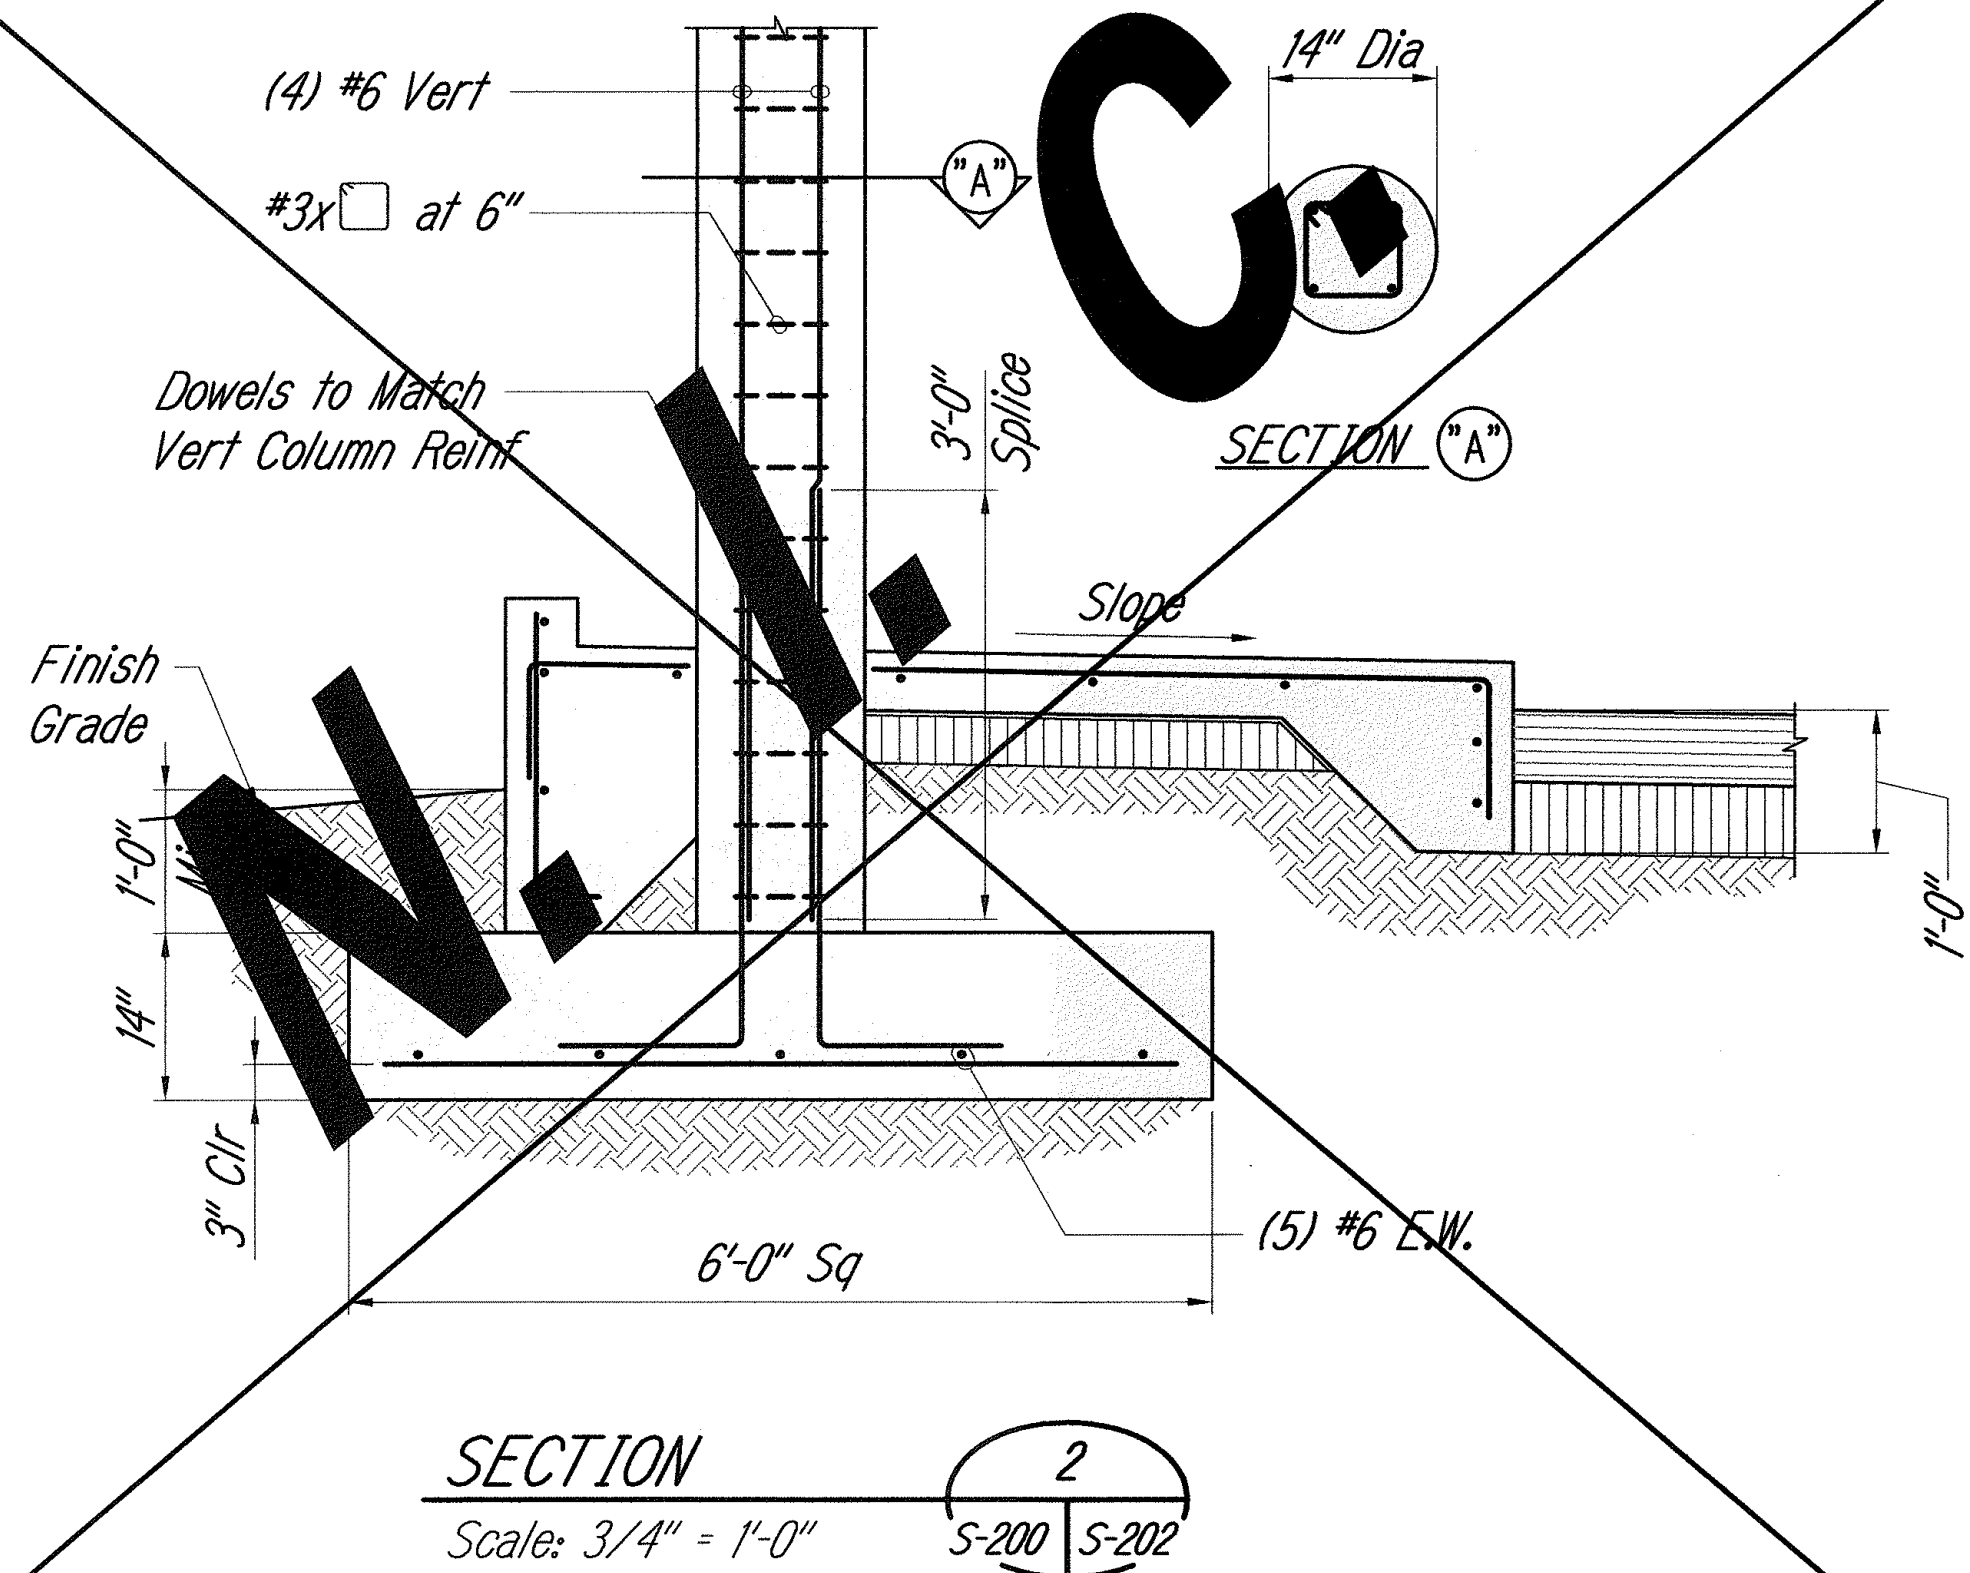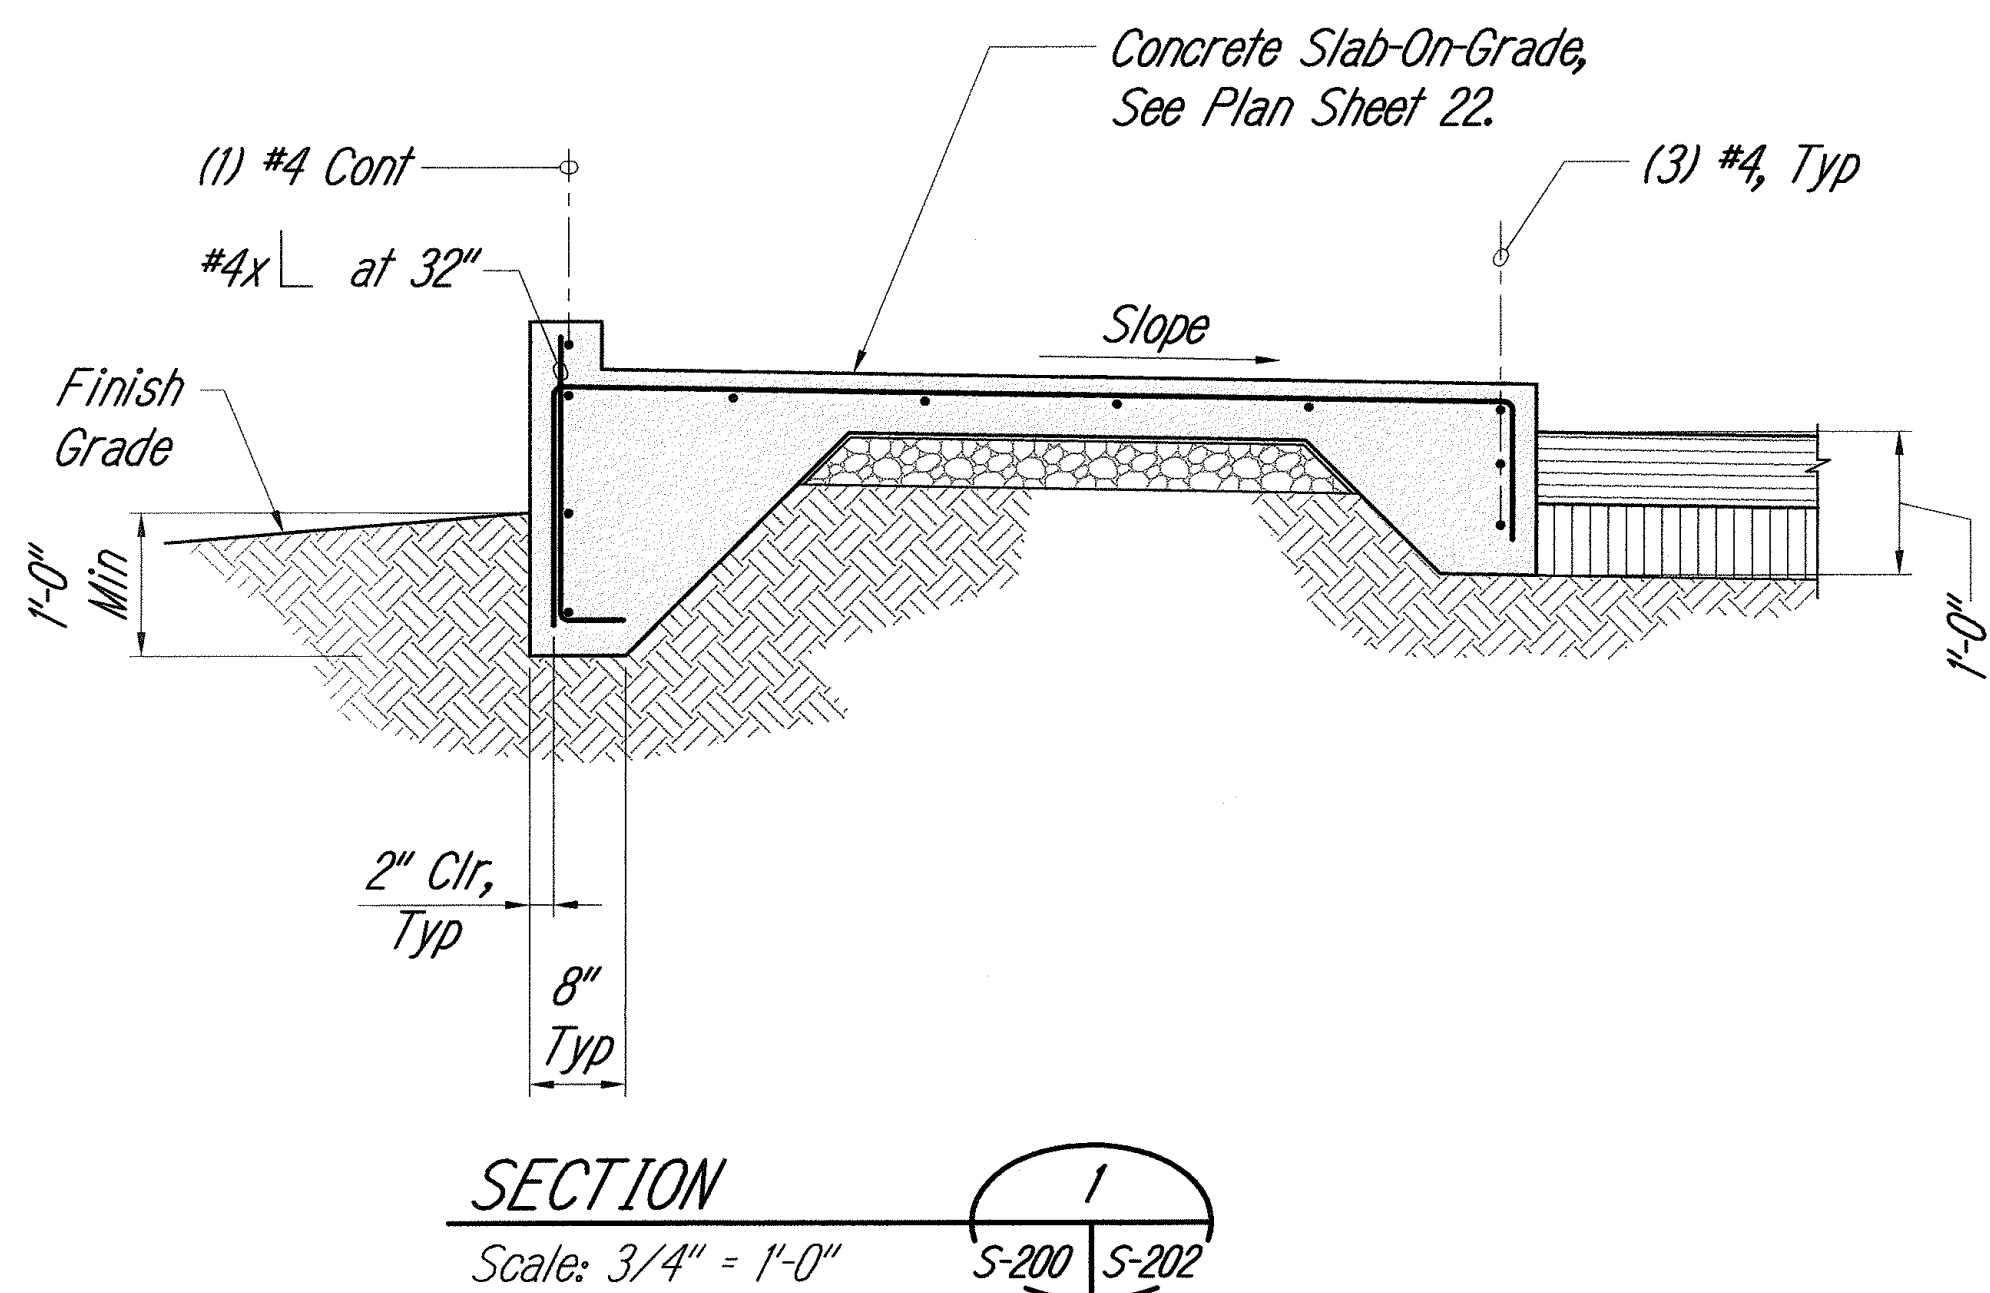


Note:
Grating shall consist of 2" x 1/4" bearing bars at 1 3/16" o.c. with 1/4" min. cross bars at 4" o.c. Provide 1 3/4" x 1/4" end bands at all supports. All joints shall be fully welded and ground smooth prior to galvanizing.

ORIGINAL PLAN	SURVEY PLOTTED BY	DATE
NOTE BOOK	DRAWN BY	
	TRACED BY	
	QUANTITIES BY	
	CHECKED BY	
No.		

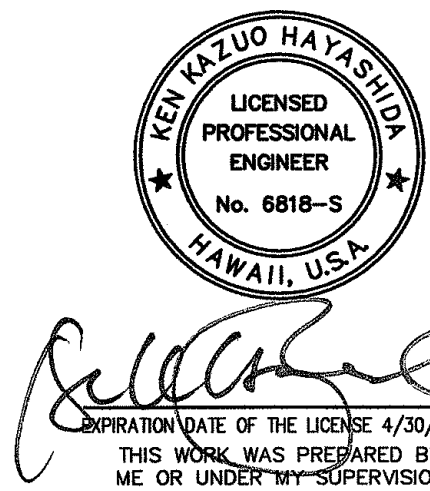


6/10/08	Revise Section 1, Delete Section 2 and Add Note to Section 3
Date	Revision
STATE OF HAWAII DEPARTMENT OF TRANSPORTATION HIGHWAYS DIVISION PEARL CITY BASEYARD SECTIONS AND DETAILS KANEOHE, PEARL CITY AND WAIANAE BASEYARD WASHDOWN RACKS Project No. HWY-0-09-06	
SCALE: AS NOTED	DATE: MAY 2008
SHEET No. S-202 OF 46 SHEETS	


FED. ROAD DIST. NO.	STATE	PROJ. NO.	FISCAL YEAR	SHEET NO.	TOTAL SHEETS
HAWAII	HAW.	HWY-0-09-06	2008	ADD. 26	46

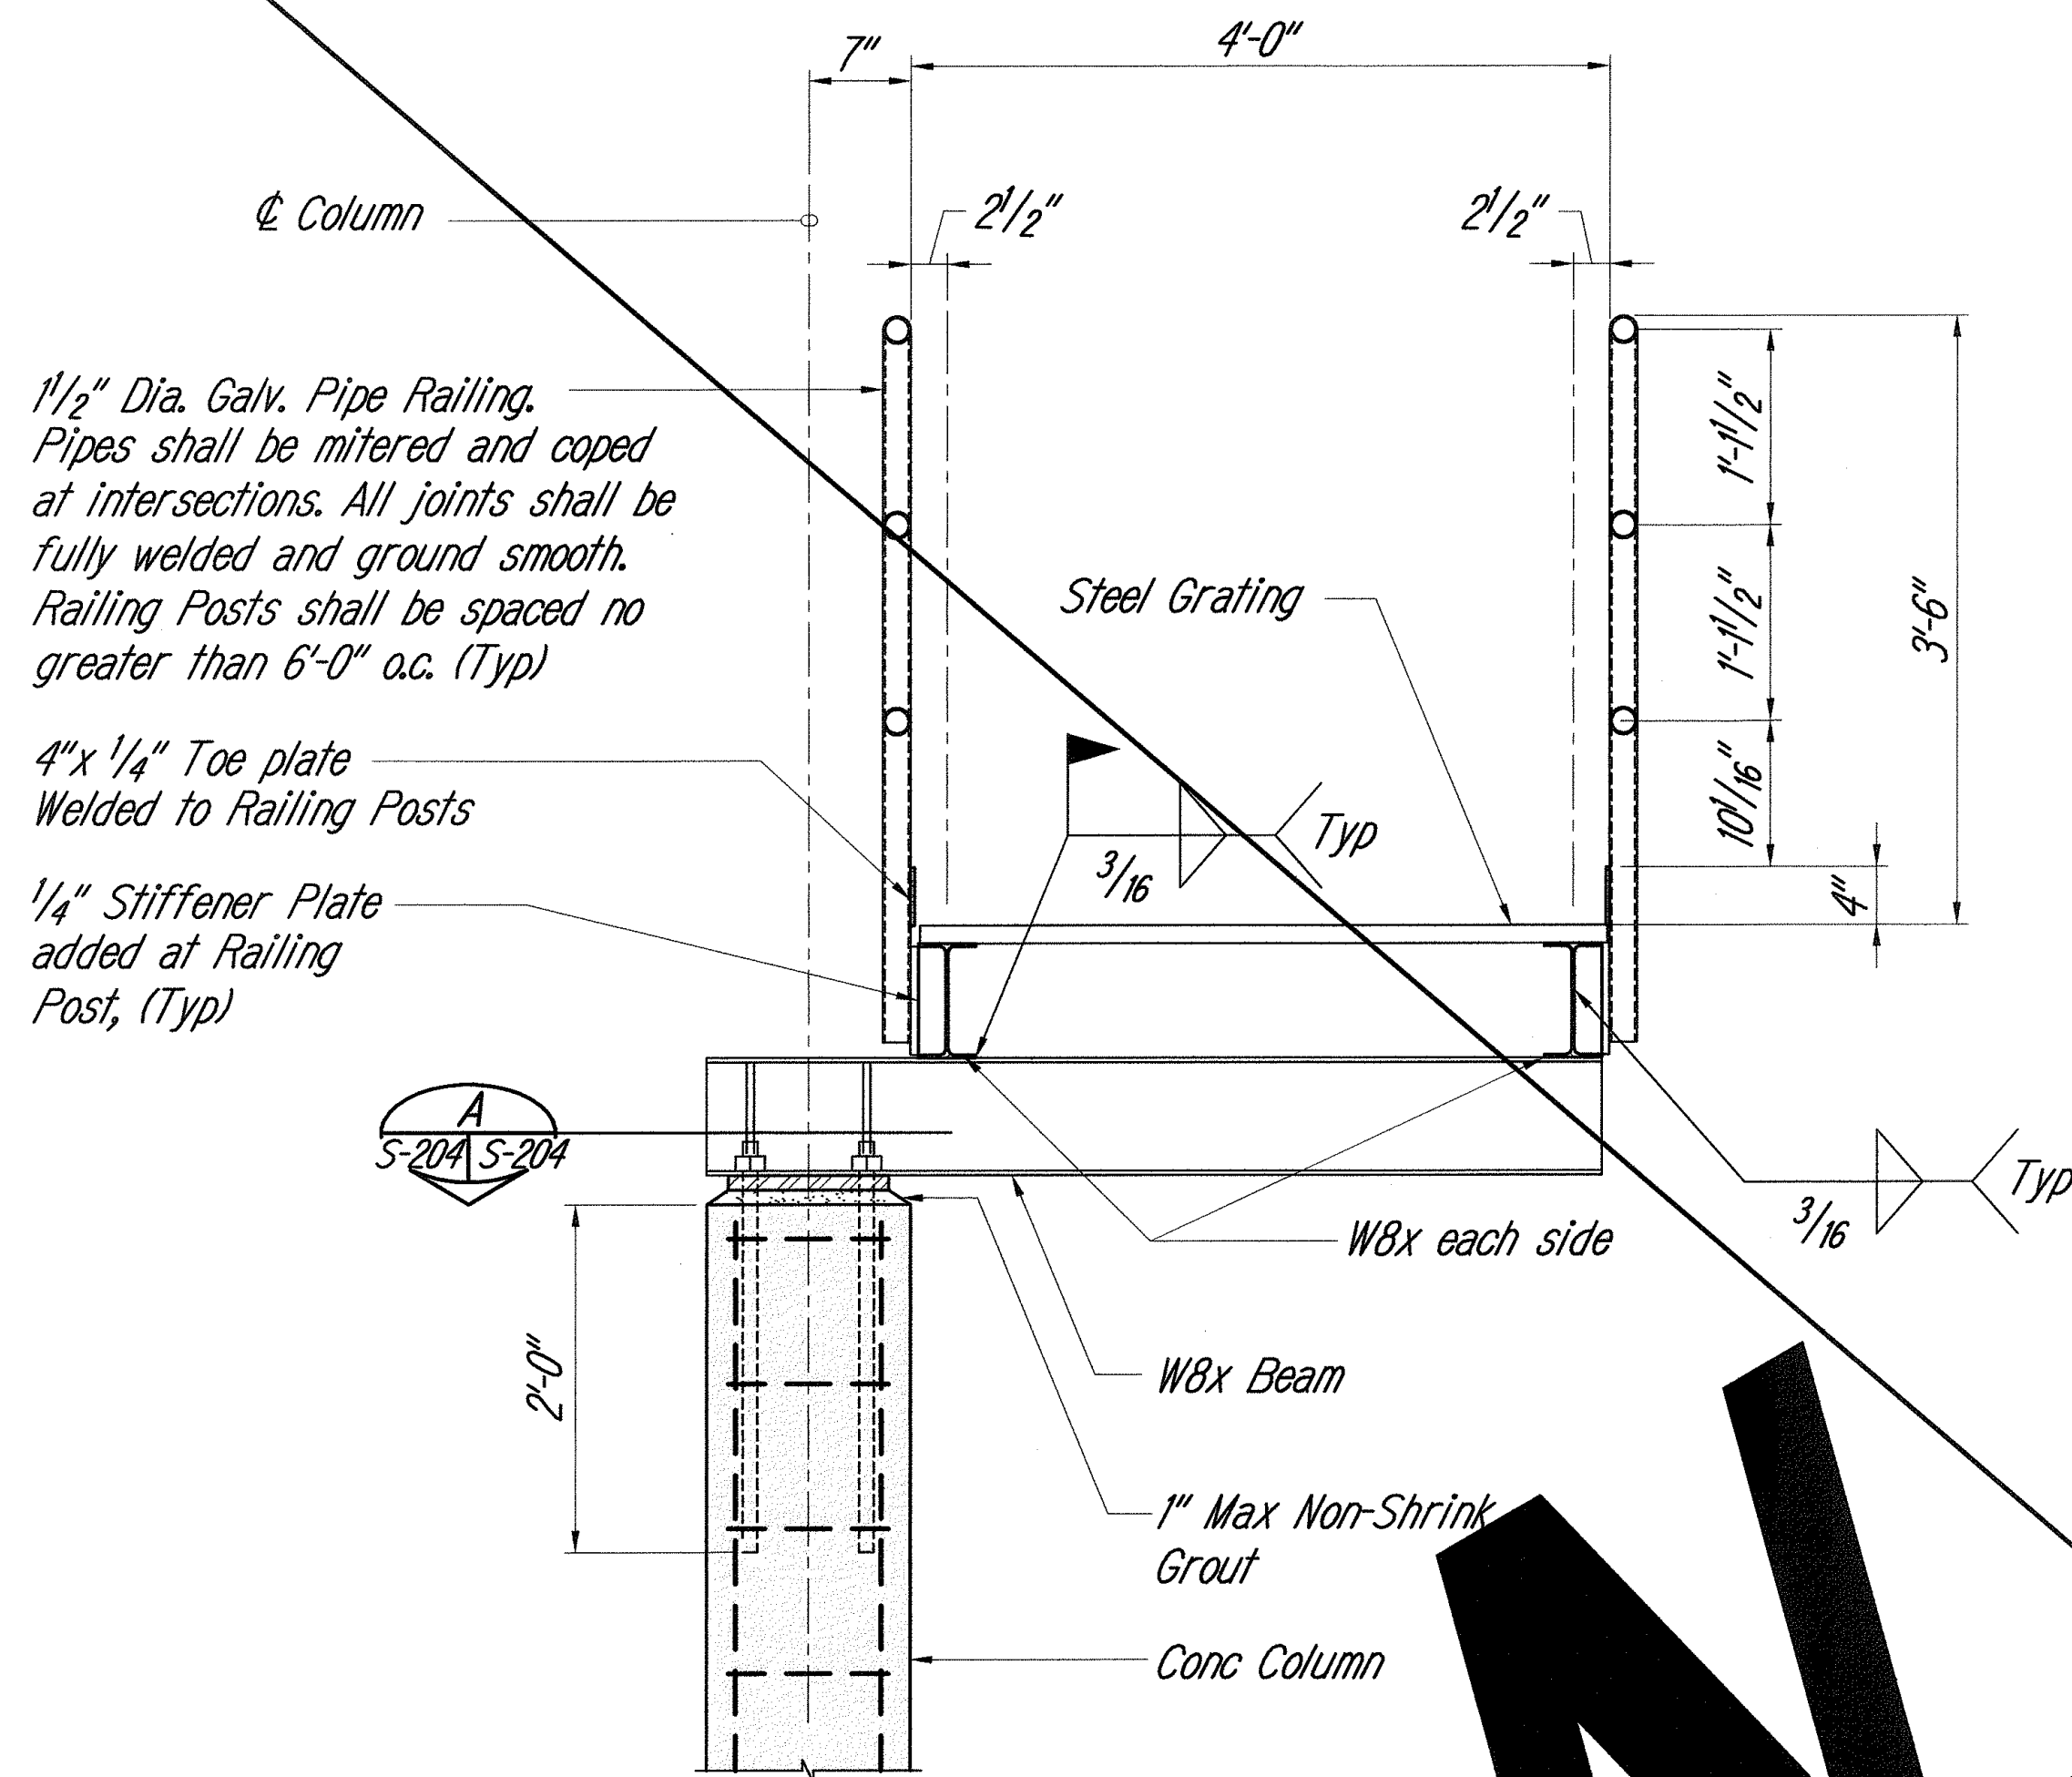


SECTION 1
Scale: 1/2" = 1'-0"

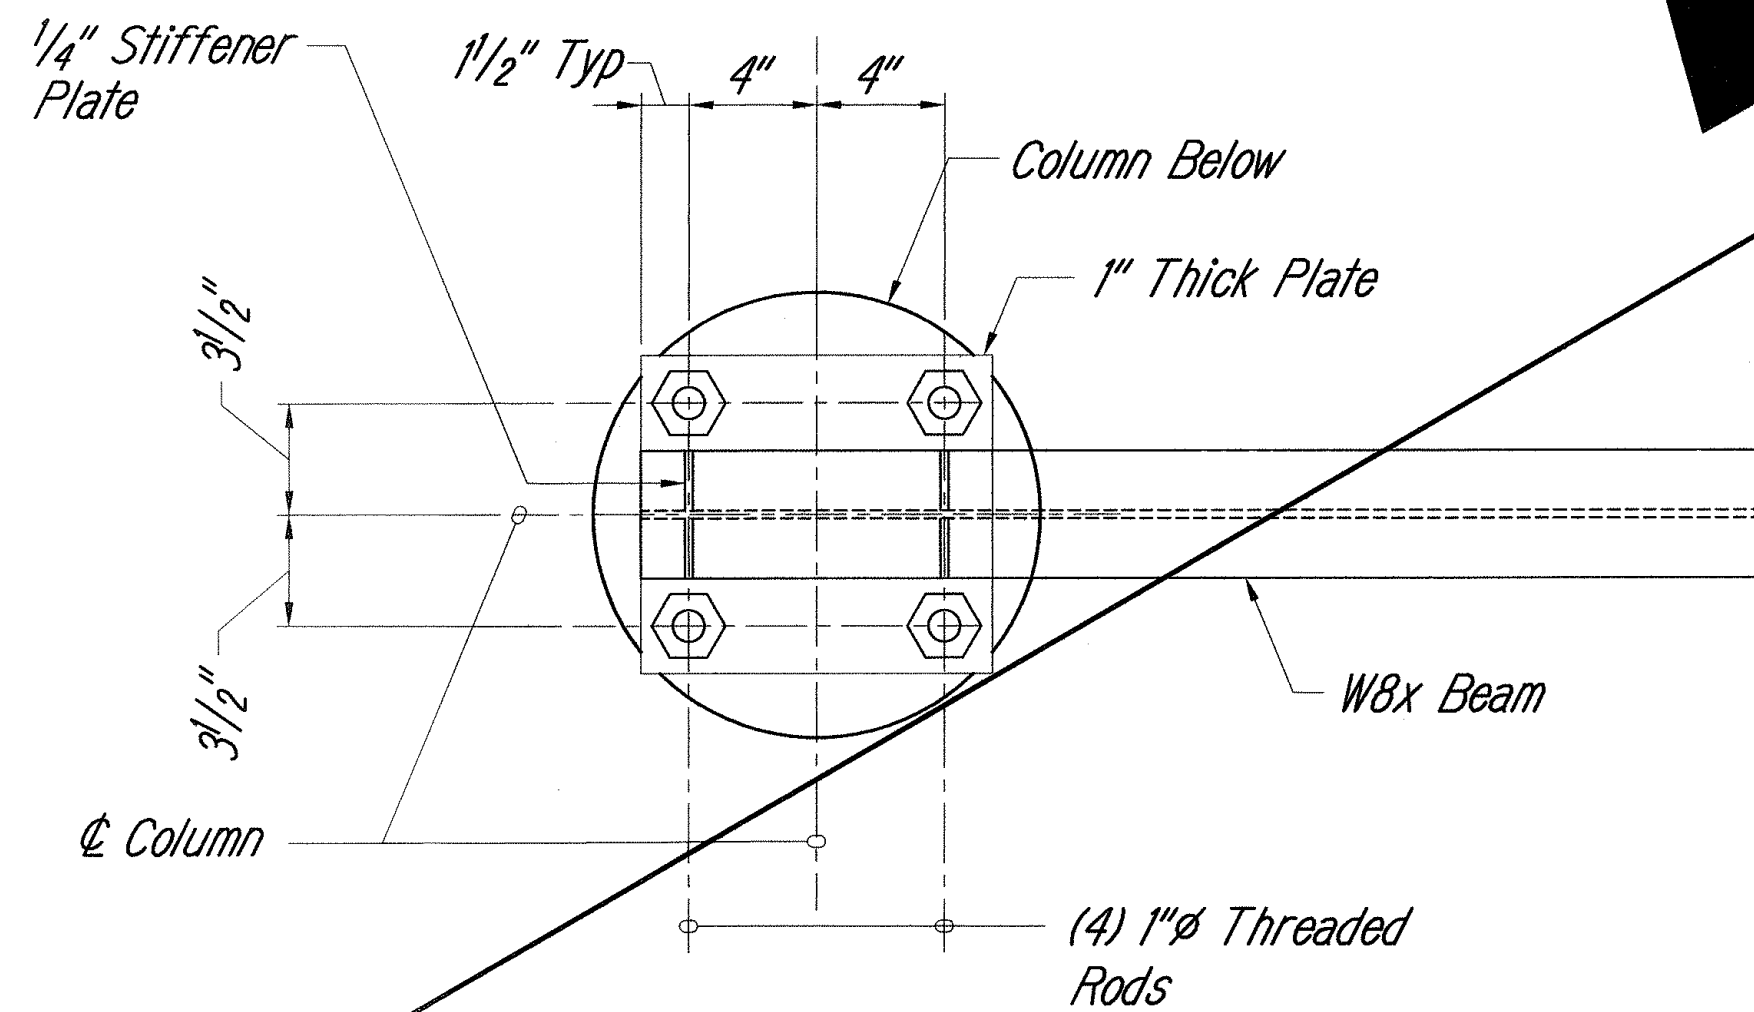


SECTION 2
Scale: 1" = 1'-0"

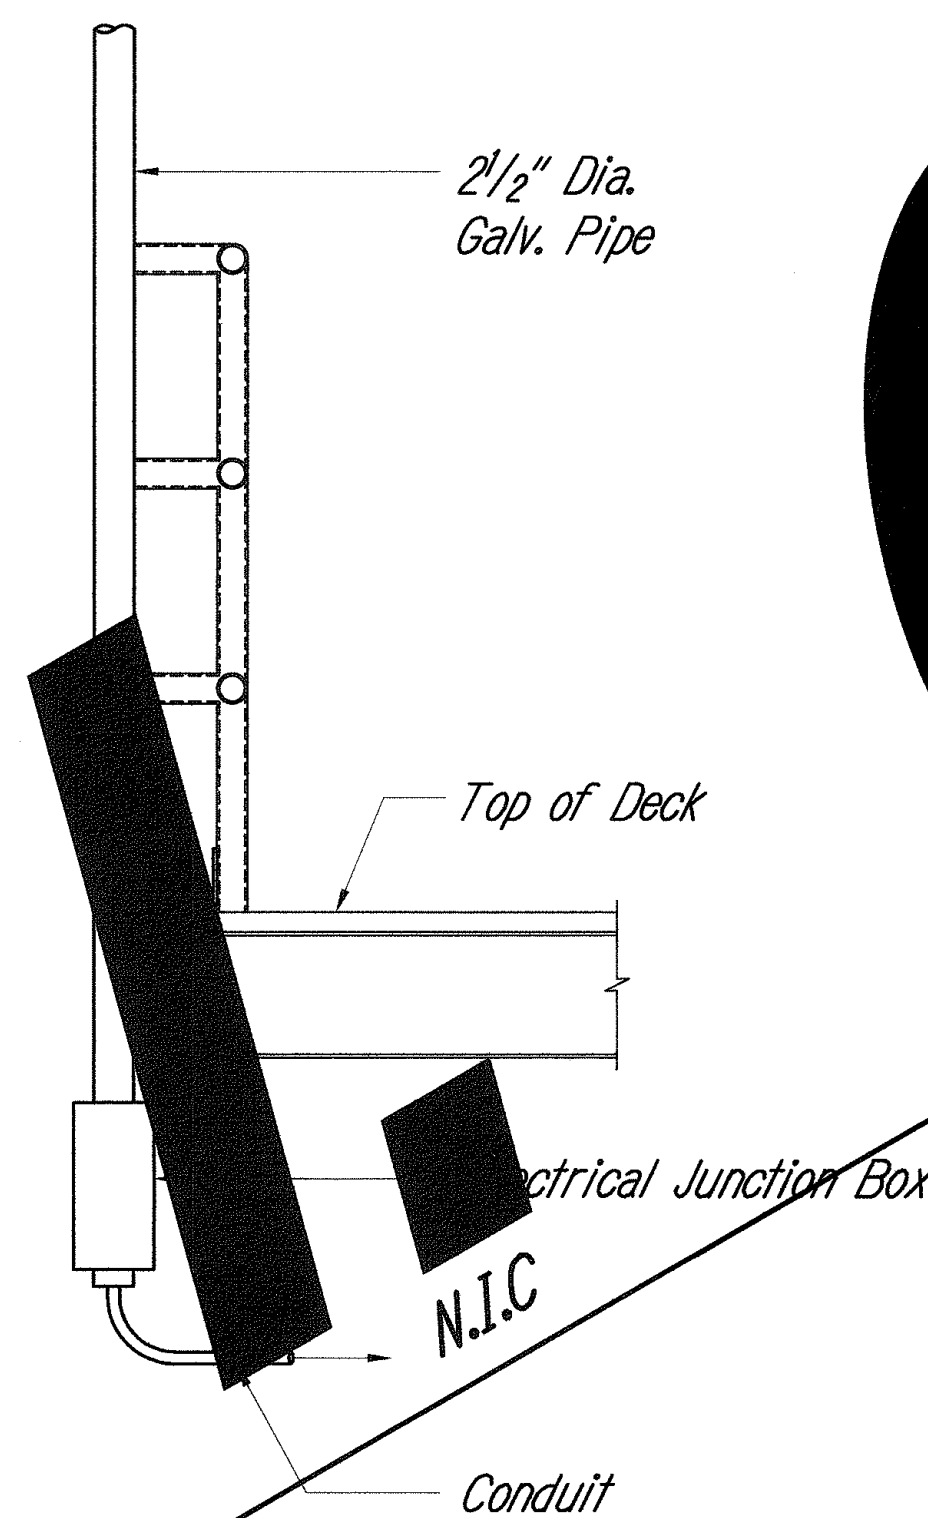

SECTION 3
Scale: 1/2" = 1'-0"

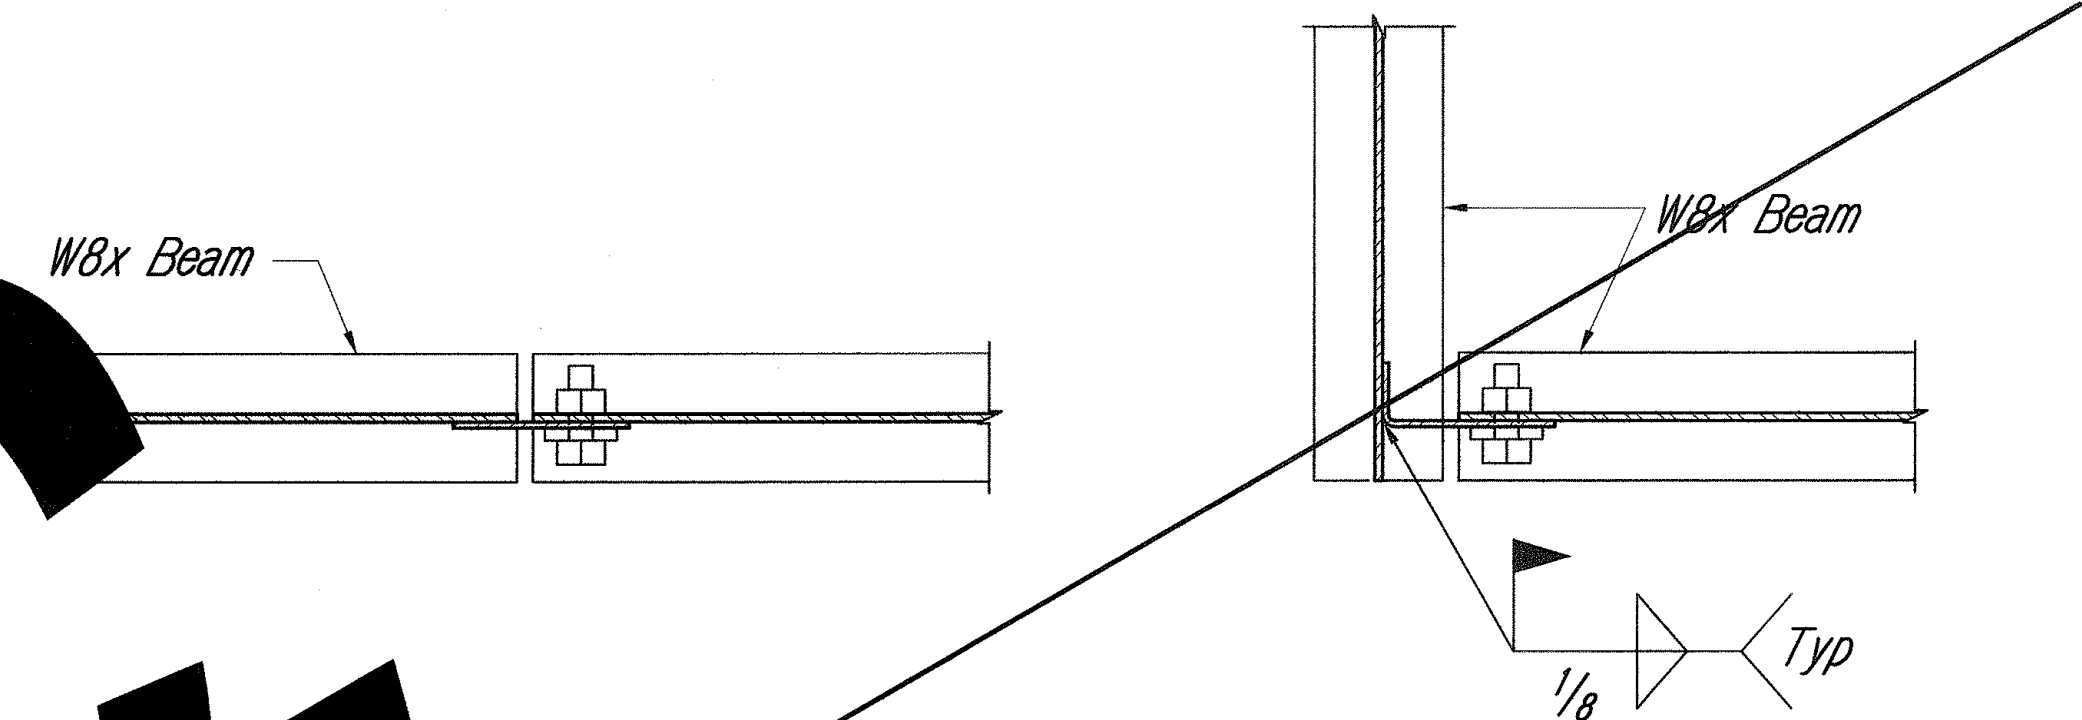

SECTION 4
Scale: 1" = 1'-0"

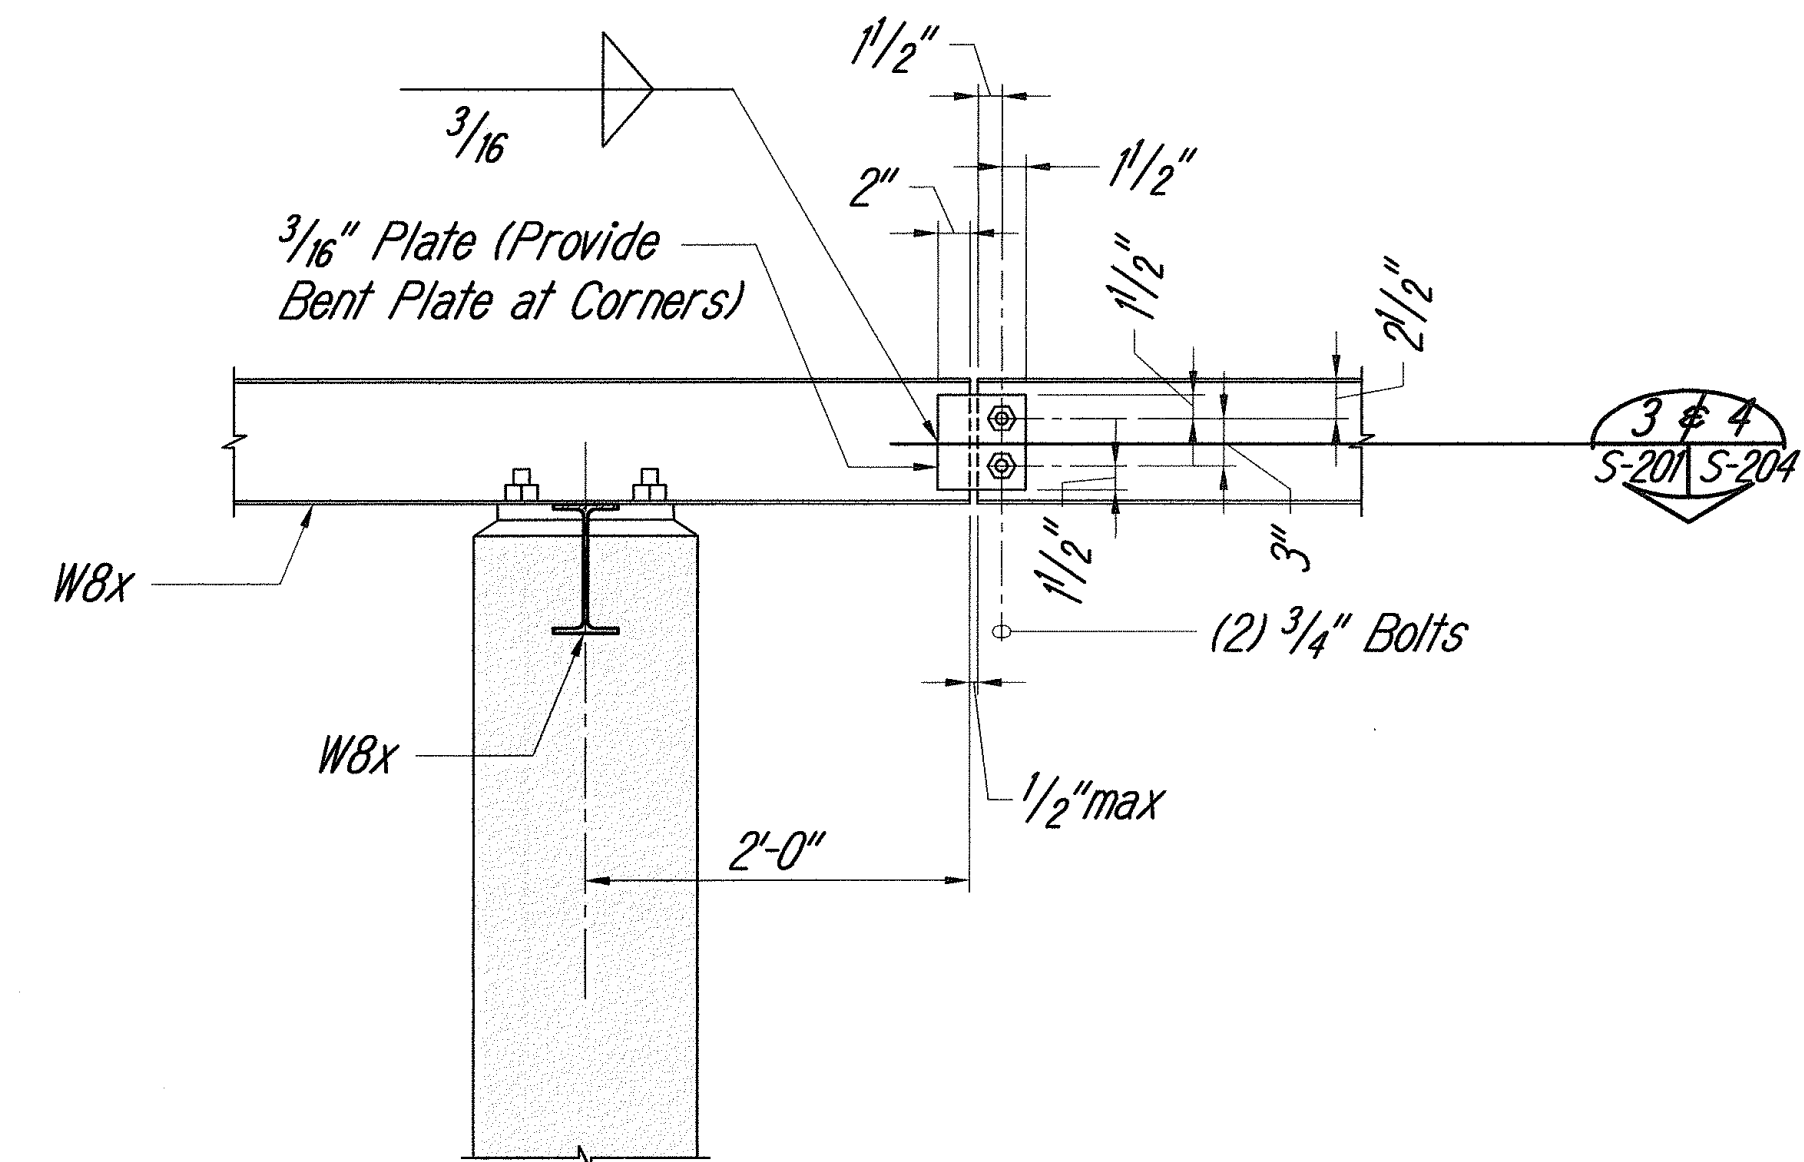

SECTION 5
Scale: 1/2" = 1'-0"


ORIGINAL PLAN	SURVEY PLOTTED BY	DATE
NOTE BOOK	DESIGNED BY	
	CHECKED BY	
No.		



THIS WORK WAS PREPARED BY
ME OR UNDER MY SUPERVISION

6/10/08	Delete catwalk
Date	Revision
STATE OF HAWAII DEPARTMENT OF TRANSPORTATION HIGHWAYS DIVISION PEARL CITY BASEYARD SECTIONS AND DETAILS KANEHOE, PEARL CITY AND WAIANAE BASEYARD WASHDOWN RACKS Project No. HWY-0-09-06	
SCALE: AS NOTED	DATE: MAY 2008

FED. ROAD DIST. NO.	STATE	PROJ. NO.	FISCAL YEAR	SHEET NO.	TOTAL SHEETS
HAWAII	HAW.	HWY-0-09-06	2008	ADD. 27	46

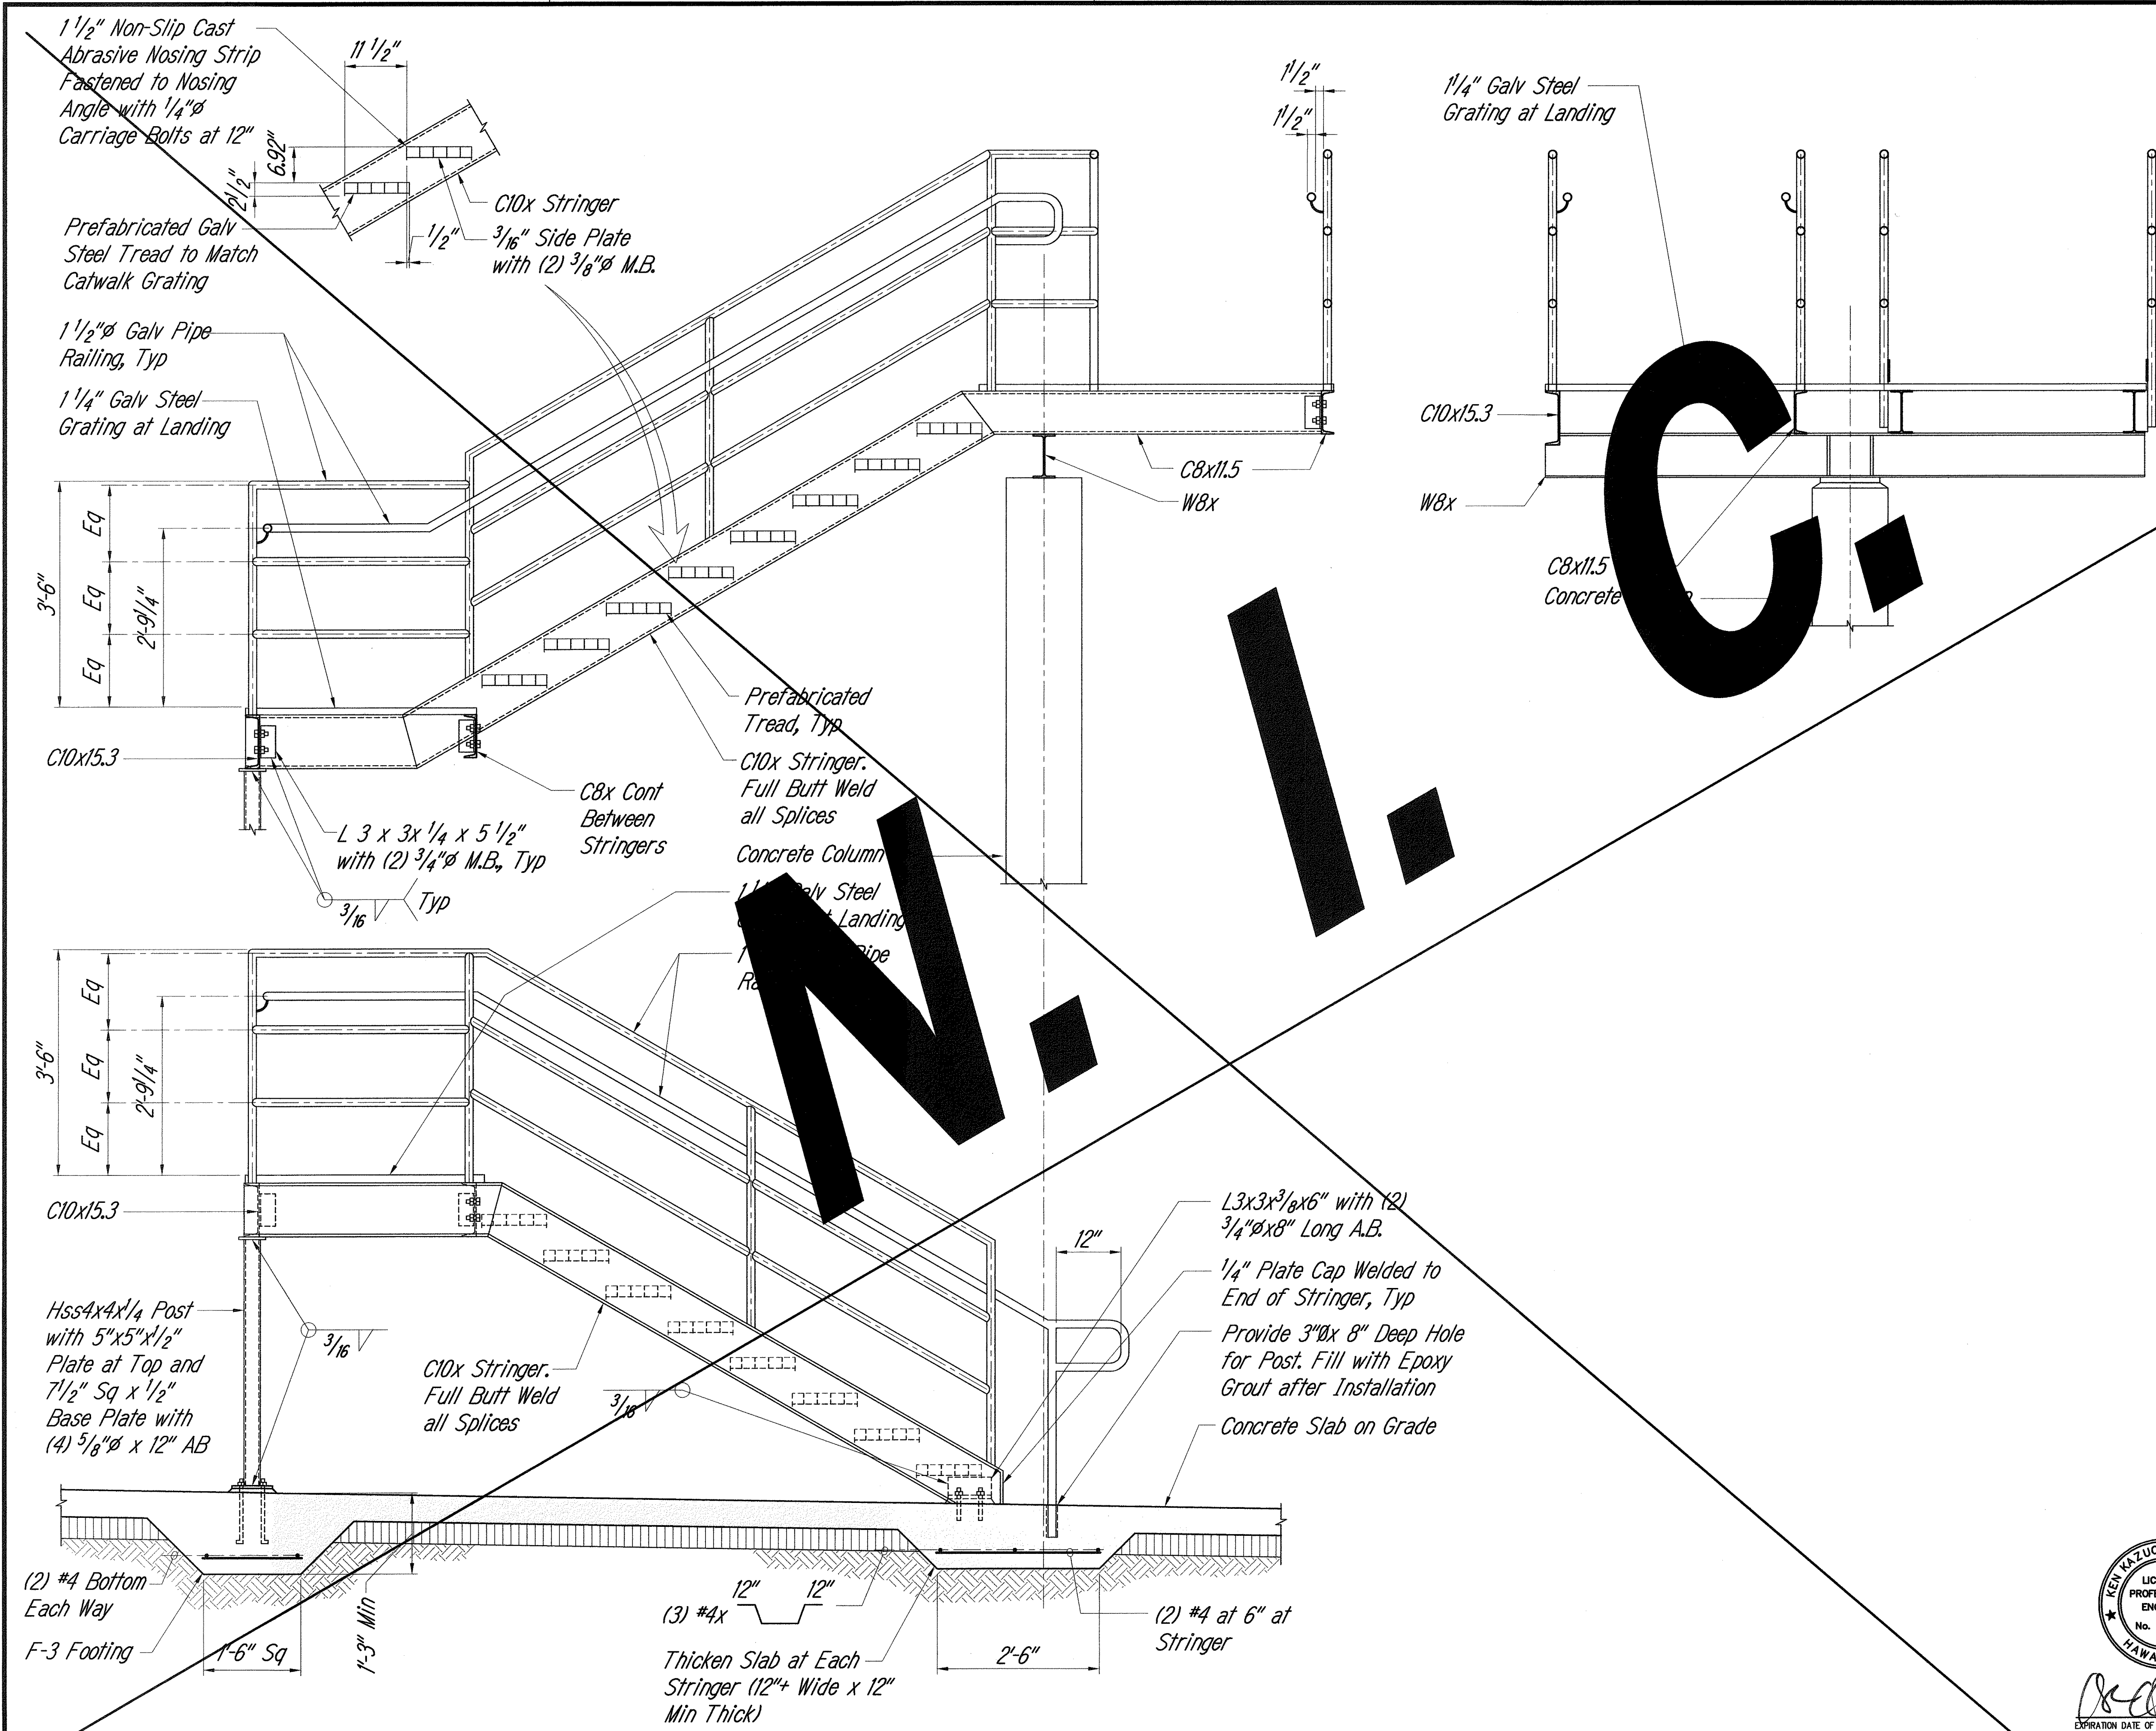

SURVEY PLOTTED BY	DATE
DRAWN BY	
TRACED BY	
QUANTITIES BY	
CHECKED BY	
ORIGINAL PLAN	
NOTE BOOK	
No.	

6/10/08	Delete catwalk
Date	Revision
STATE OF HAWAII DEPARTMENT OF TRANSPORTATION HIGHWAYS DIVISION PEARL CITY BASEYARD STAIRS DETAILS KANE OHE, PEARL CITY AND WAIANAE BASEYARD WASHDOWN RACKS Project No. HWY-0-09-06	
SCALE: AS NOTED	DATE: MAY 2008

