
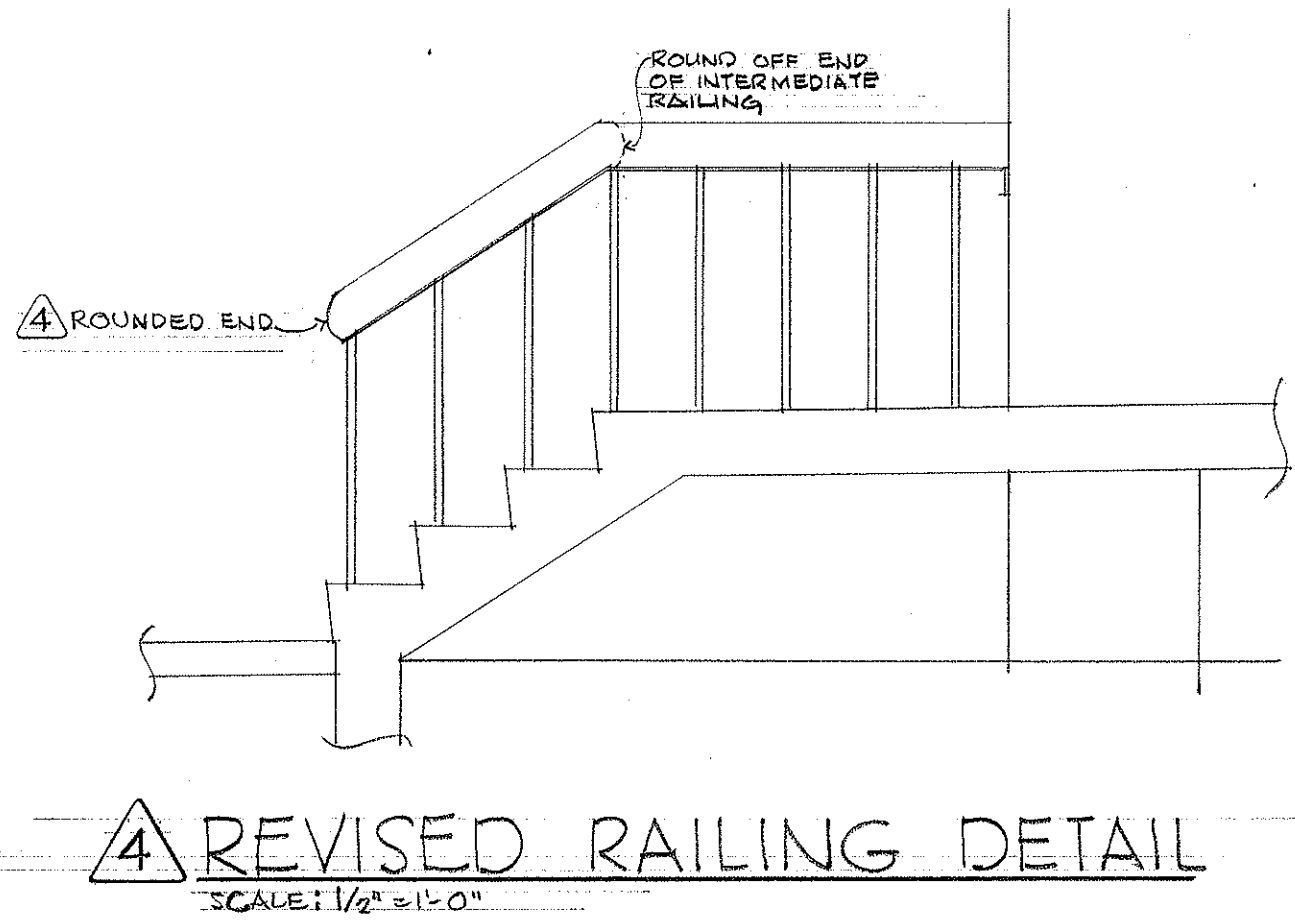
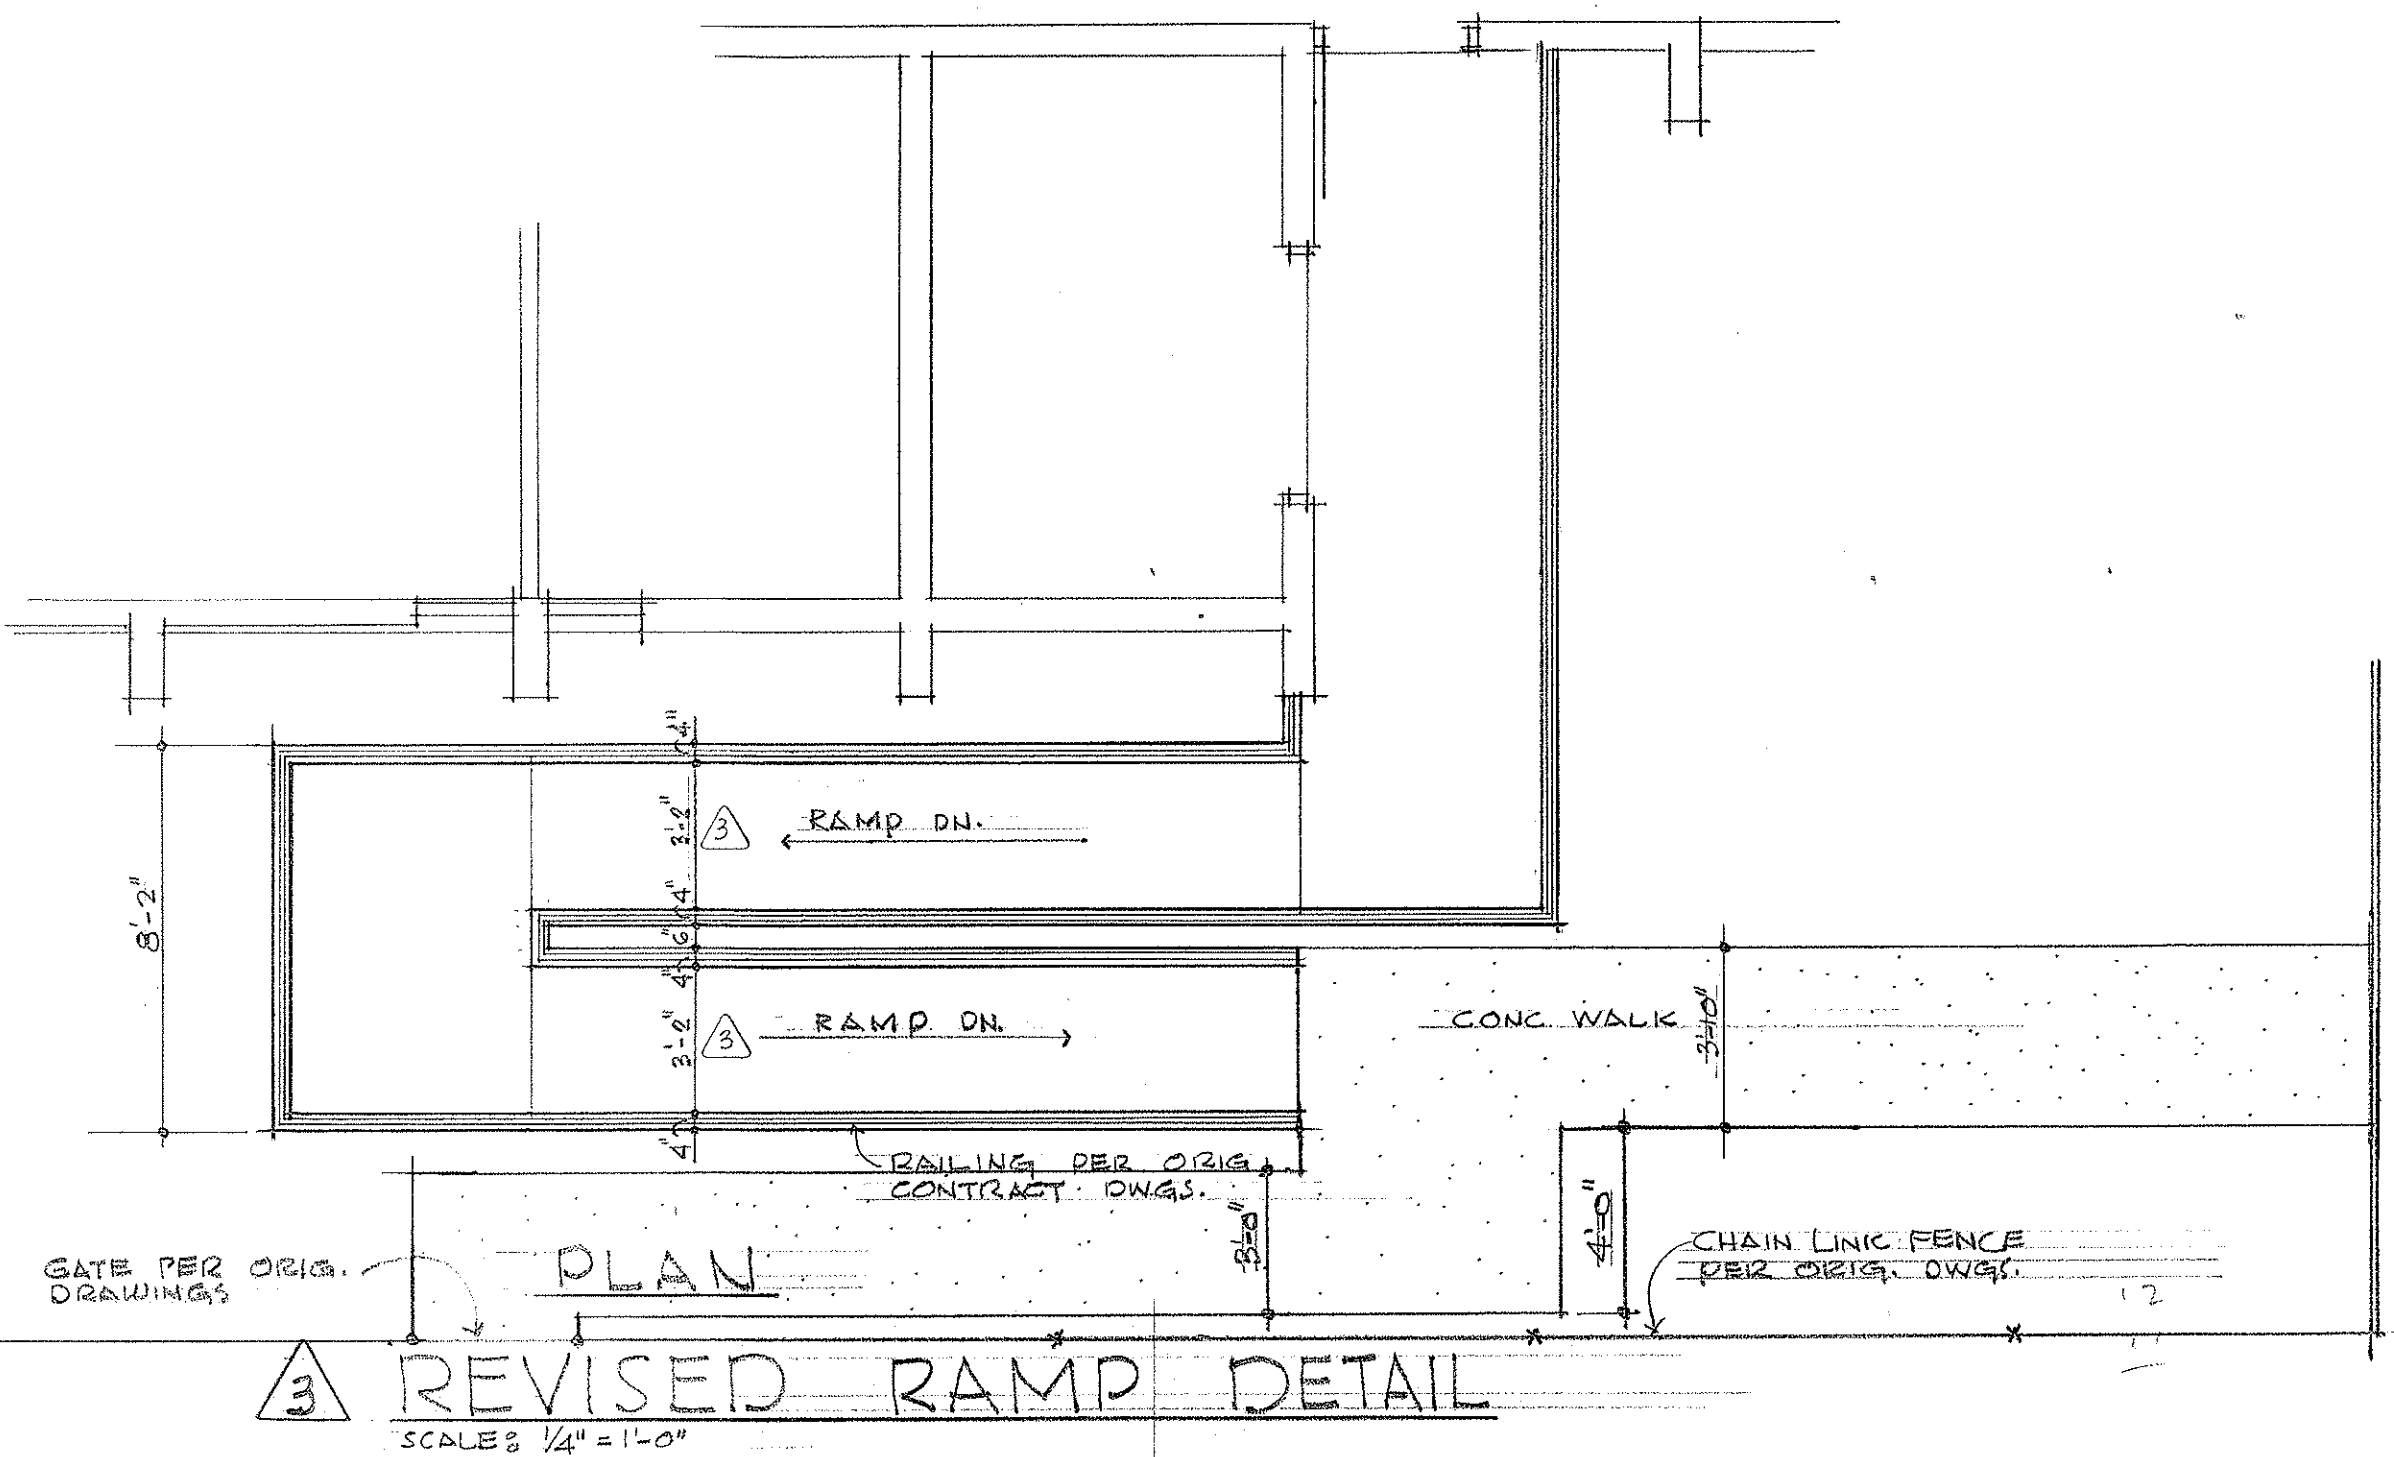


FED. ROAD DIST. NO.	STATE	FED. AID PROJ. NO.	FISCAL YEAR	SHEET NO.	TOTAL SHEETS
HAWAII	HAW.				

GENERAL NOTES:
ALL NOTES, DIMENSIONS, ETC., NOT SHOWN ON THIS
DRAWINGS REFER TO THE ORIGINAL CONTRACT DRAWINGS.

- REVISIONS:
- 1 MOVED VEHICLE SHED #2 & #3 TO SETBACK
DIMENSION SHOWN.
 - 2 MOVED VEHICLE SHED #1 SOUTHWARD TO SETBACK
DIMENSION SHOWN.
 - 3 CHANGE WIDTH OF RAMP FROM 2'-5" TO 3'-2" CHANGE
CONC. WALK AS SHOWN.
 - 4 ROUND OFF END OF SIDE & INTERMEDIATE RAILING
AT ENTRY.

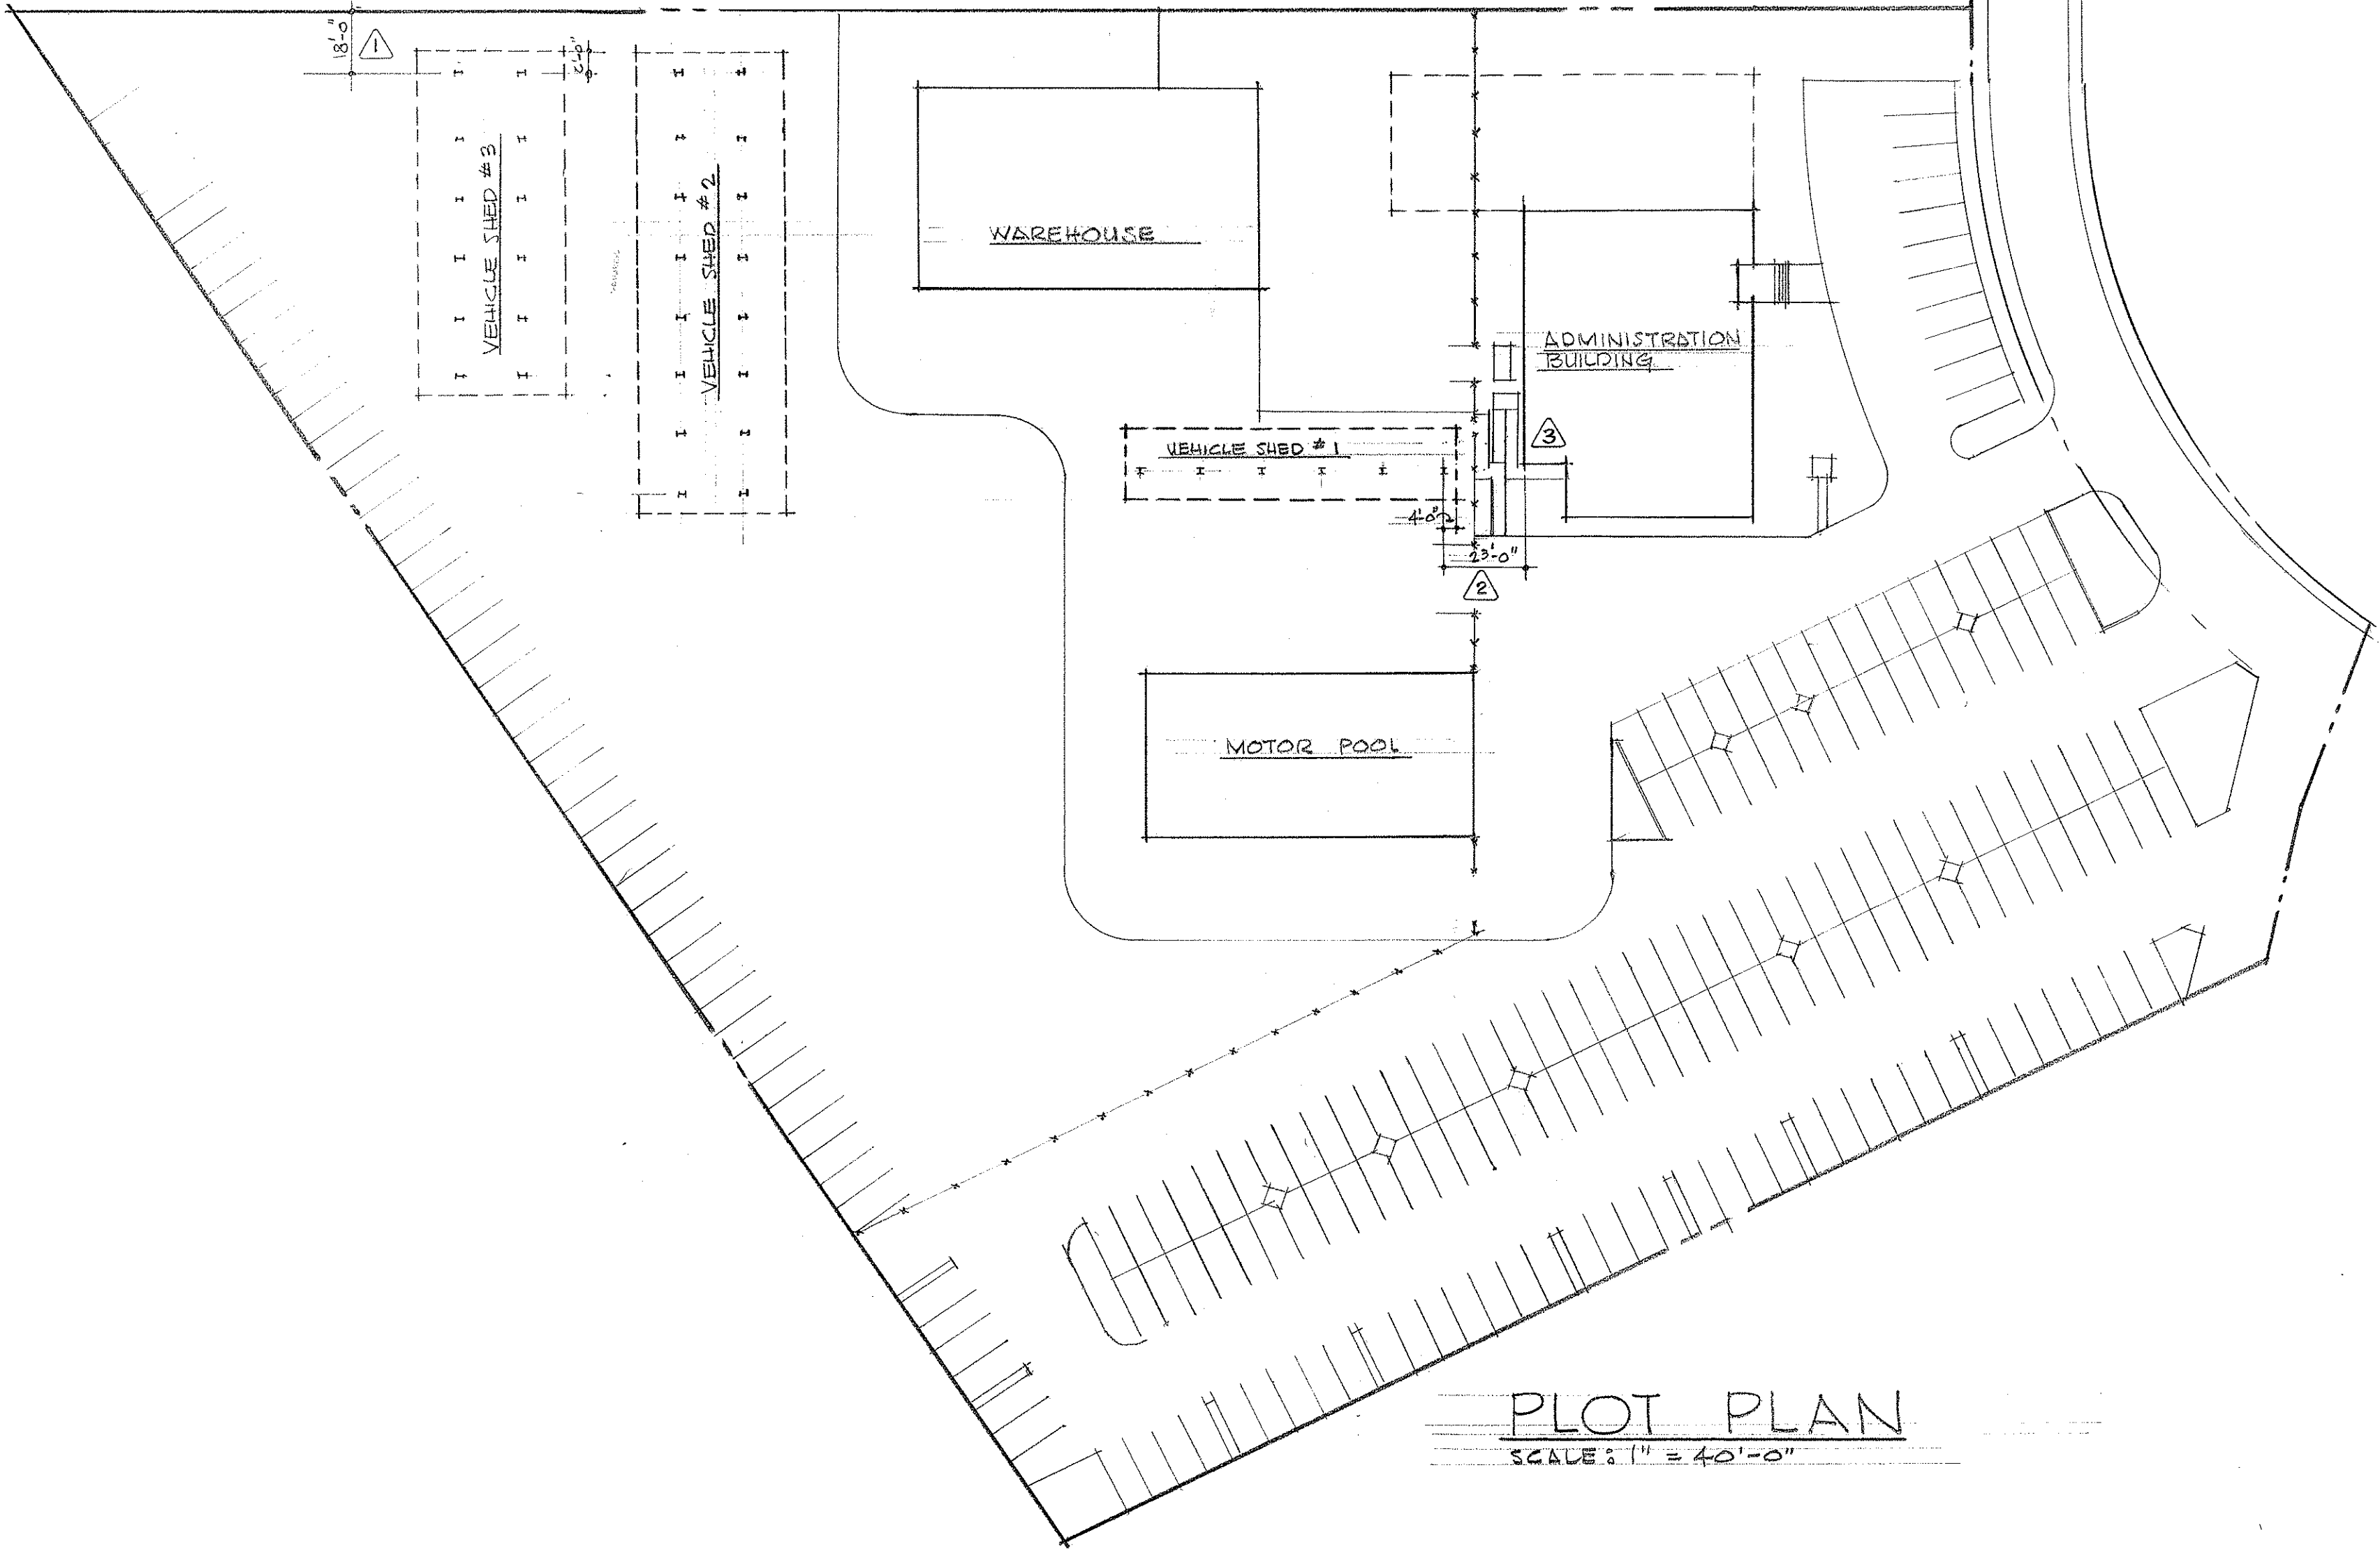

DATE: MAY 28, 1969

POST CONTRACT DRAWING #1

STATE OF HAWAII

DEPARTMENT OF TRANSPORTATION

HIGHWAYS DIVISION

OAHU DISTRICT BASEYARD FACILITIES

SHAFTER FLATS INDUSTRIAL DEVELOPMENT

AT MOANAWA, HONOLULU, OAHU, HAWAII

REVISION DRAWINGS.

HERBERT Y. MATSUMURA

ARCHITECT S.I.A.

871 KAPIOLANI BLVD.

HONOLULU, HAWAII

SHEET No. PC-1 OF 1 SHEETS

SURVEY PLOTTED BY	DATE
DESIGNED BY	"
TRACED BY	"
NOTED BY	"
CHECKED BY	"
ORIGINAL PLAN	No.
NOTE BOOK	No.