




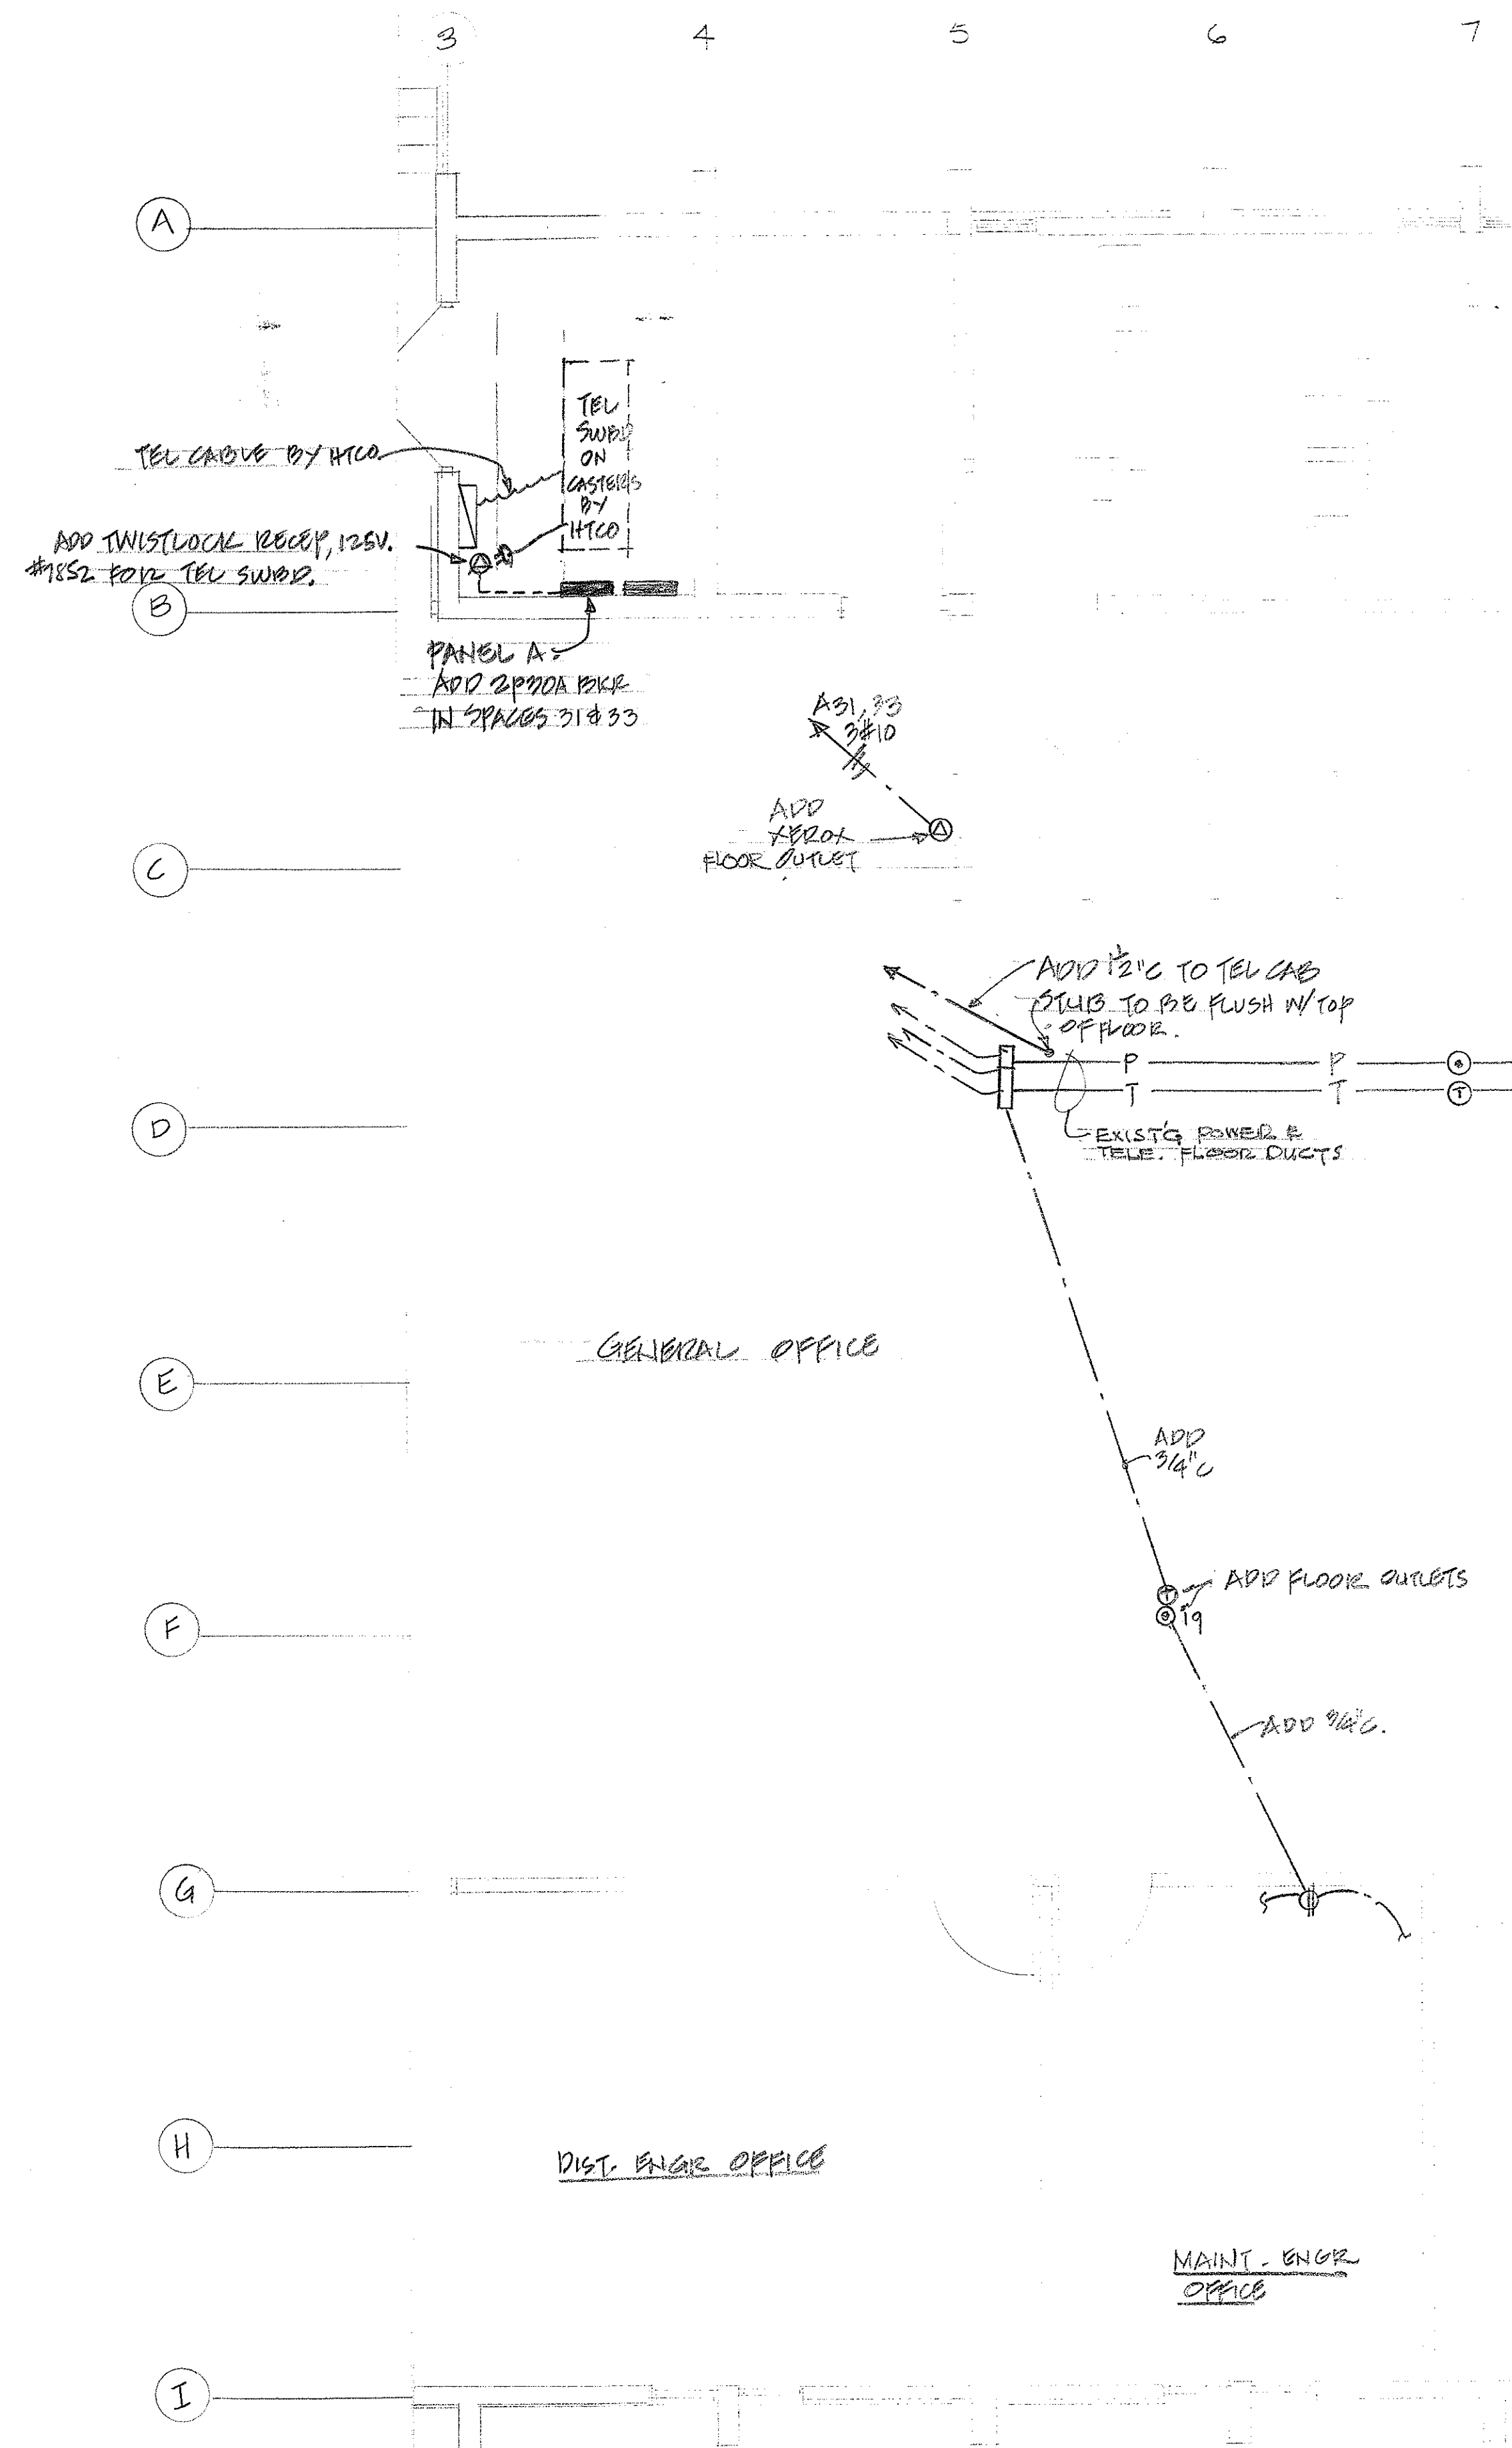


# PARTIAL FLOOR PLAN - ADMINISTRATION BLDG

SC. 1/4" = 1'-0"

- WIRING IN EXPOSED RACEWAY
- WIRING IN RACEWAY CONCEALED IN FLOOR

NOTE: CUT & PATCH EXIST'G CONC FLOOR SLAB TO ACCOMMODATE NEW CONDUITS WHERE INDICATED

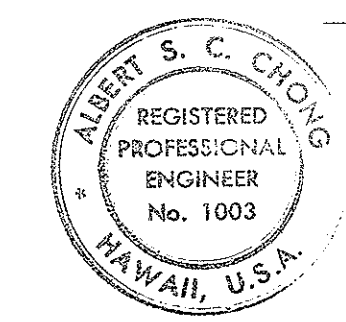

THIS WORK WAS PREPARED BY ME OR UNDER MY SUPERVISION  
*Albert S. C. Chong*  
 Albert S. C. Chong, P.E.

## POST CONTRACT DWG NO. 4


|                                                                                                          |                                       |
|----------------------------------------------------------------------------------------------------------|---------------------------------------|
| STATE OF HAWAII<br>DEPARTMENT OF TRANSPORTATION<br>HIGHWAYS DIVISION                                     |                                       |
| OAHU DISTRICT BASEYARD FACILITIES<br>SHAWT FLATS INDUSTRIAL DEVELOPMENT<br>AT MOXNAEUA, HONOLULU, HAWAII |                                       |
| REVISED TELEPHONE & XEROX<br>MACHINE LAYOUT - ADMINIST. BLDG                                             |                                       |
| HERBERT Y. MATSUMURA<br>871 KAPOLANI BLVD                                                                | ARCHITECT, A.I.A.<br>HONOLULU, HAWAII |

SHEET No 1 OF 1 SHEETS 10/6/69

| FED. ROAD DIST. NO. | STATE | FED. AID PROJ. NO. | FISCAL YEAR | SHEET NO. | TOTAL SHEETS |
|---------------------|-------|--------------------|-------------|-----------|--------------|
| HAWAII              | HAW.  |                    |             |           |              |

# GEN. NOTE:


- EXIST'G CONC. FLOOR IN ROOM TO REMAIN.
- CEILING IN ROOM TO REMAIN.
- REMOVE THE EXIST'G ROLL-UP DOOR & TURN OVER TO DEPT. OF TRANSPORTATION. DELIVER & STORE IN AREA DESIGNATED BY THE ENGINEER.
- FINISH HARDWARE FOR NEW DOOR:  
1/2 PR. BUTTS X450TBD-PC XNRP  
1 LOCKSET 8405 LL-10 B  
1 CLOSER 55-PP  
1 STOP & HOLDER 3276
- ALL MATERIALS & WORKMANSHIP SHALL BE IN ACCORDANCE WITH THE ORIGINAL CONTRACT SPECIFICATIONS.
- PATCH EXIST'G SILL OF ROLL-UP DOOR TO SUIT NEW DOOR & WALL CONSTRUCTION.
- MASONRY WALL REINFORCING PER ORIG. CONTRACT SPECIFICATIONS.

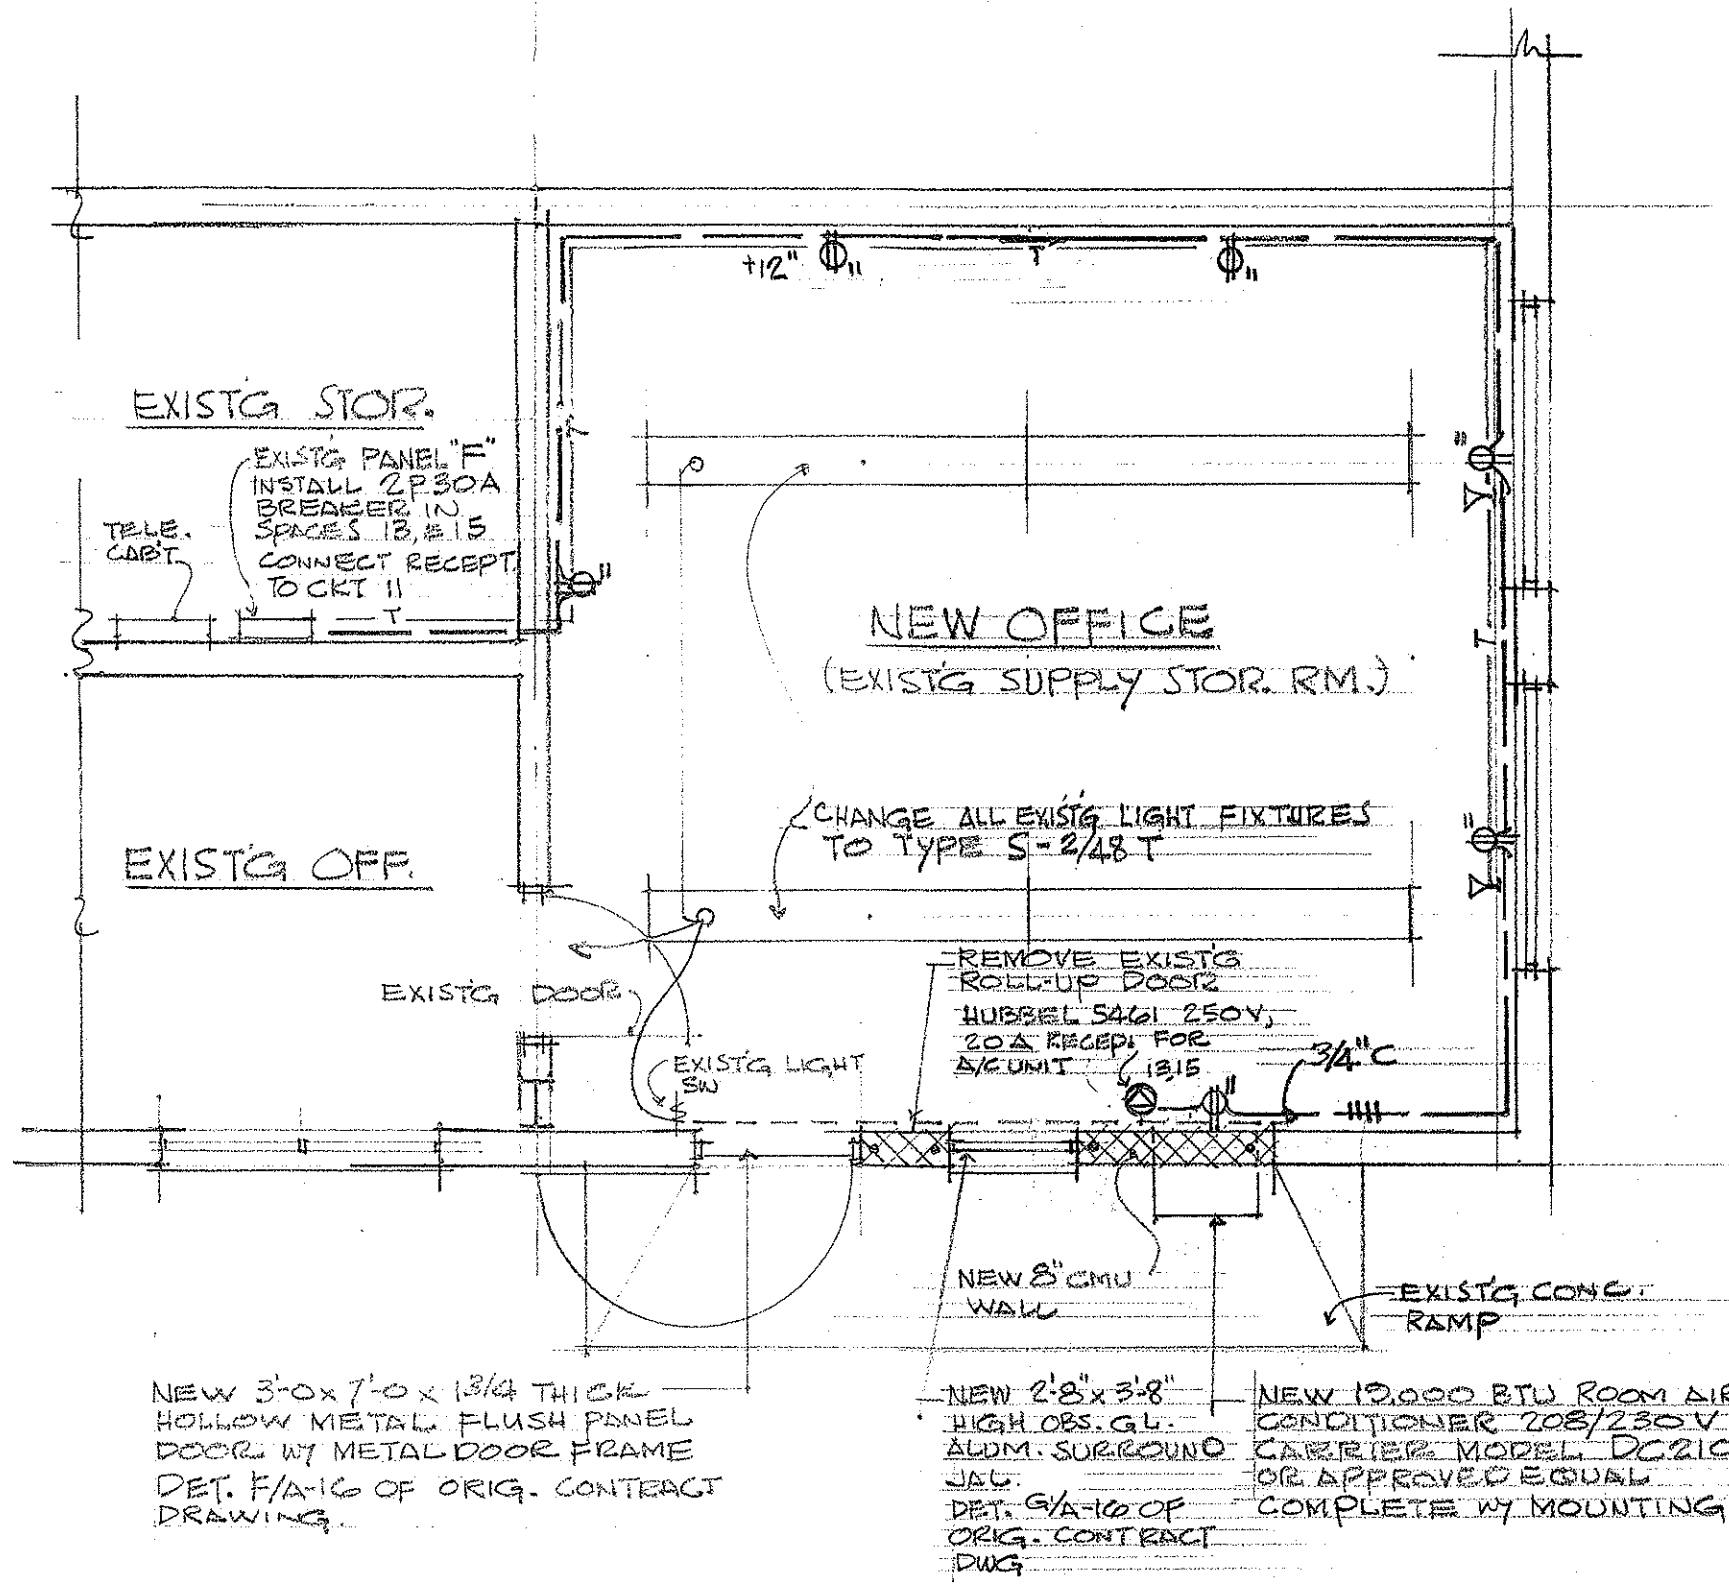

## PARTIAL FLOOR PLAN - WAREHOUSE BLDG.

Scale 1/4" = 1'-0"


- WIRING IN EXPOSED CONDUIT
- TEL. WIRING IN EXPOSED CONDUIT

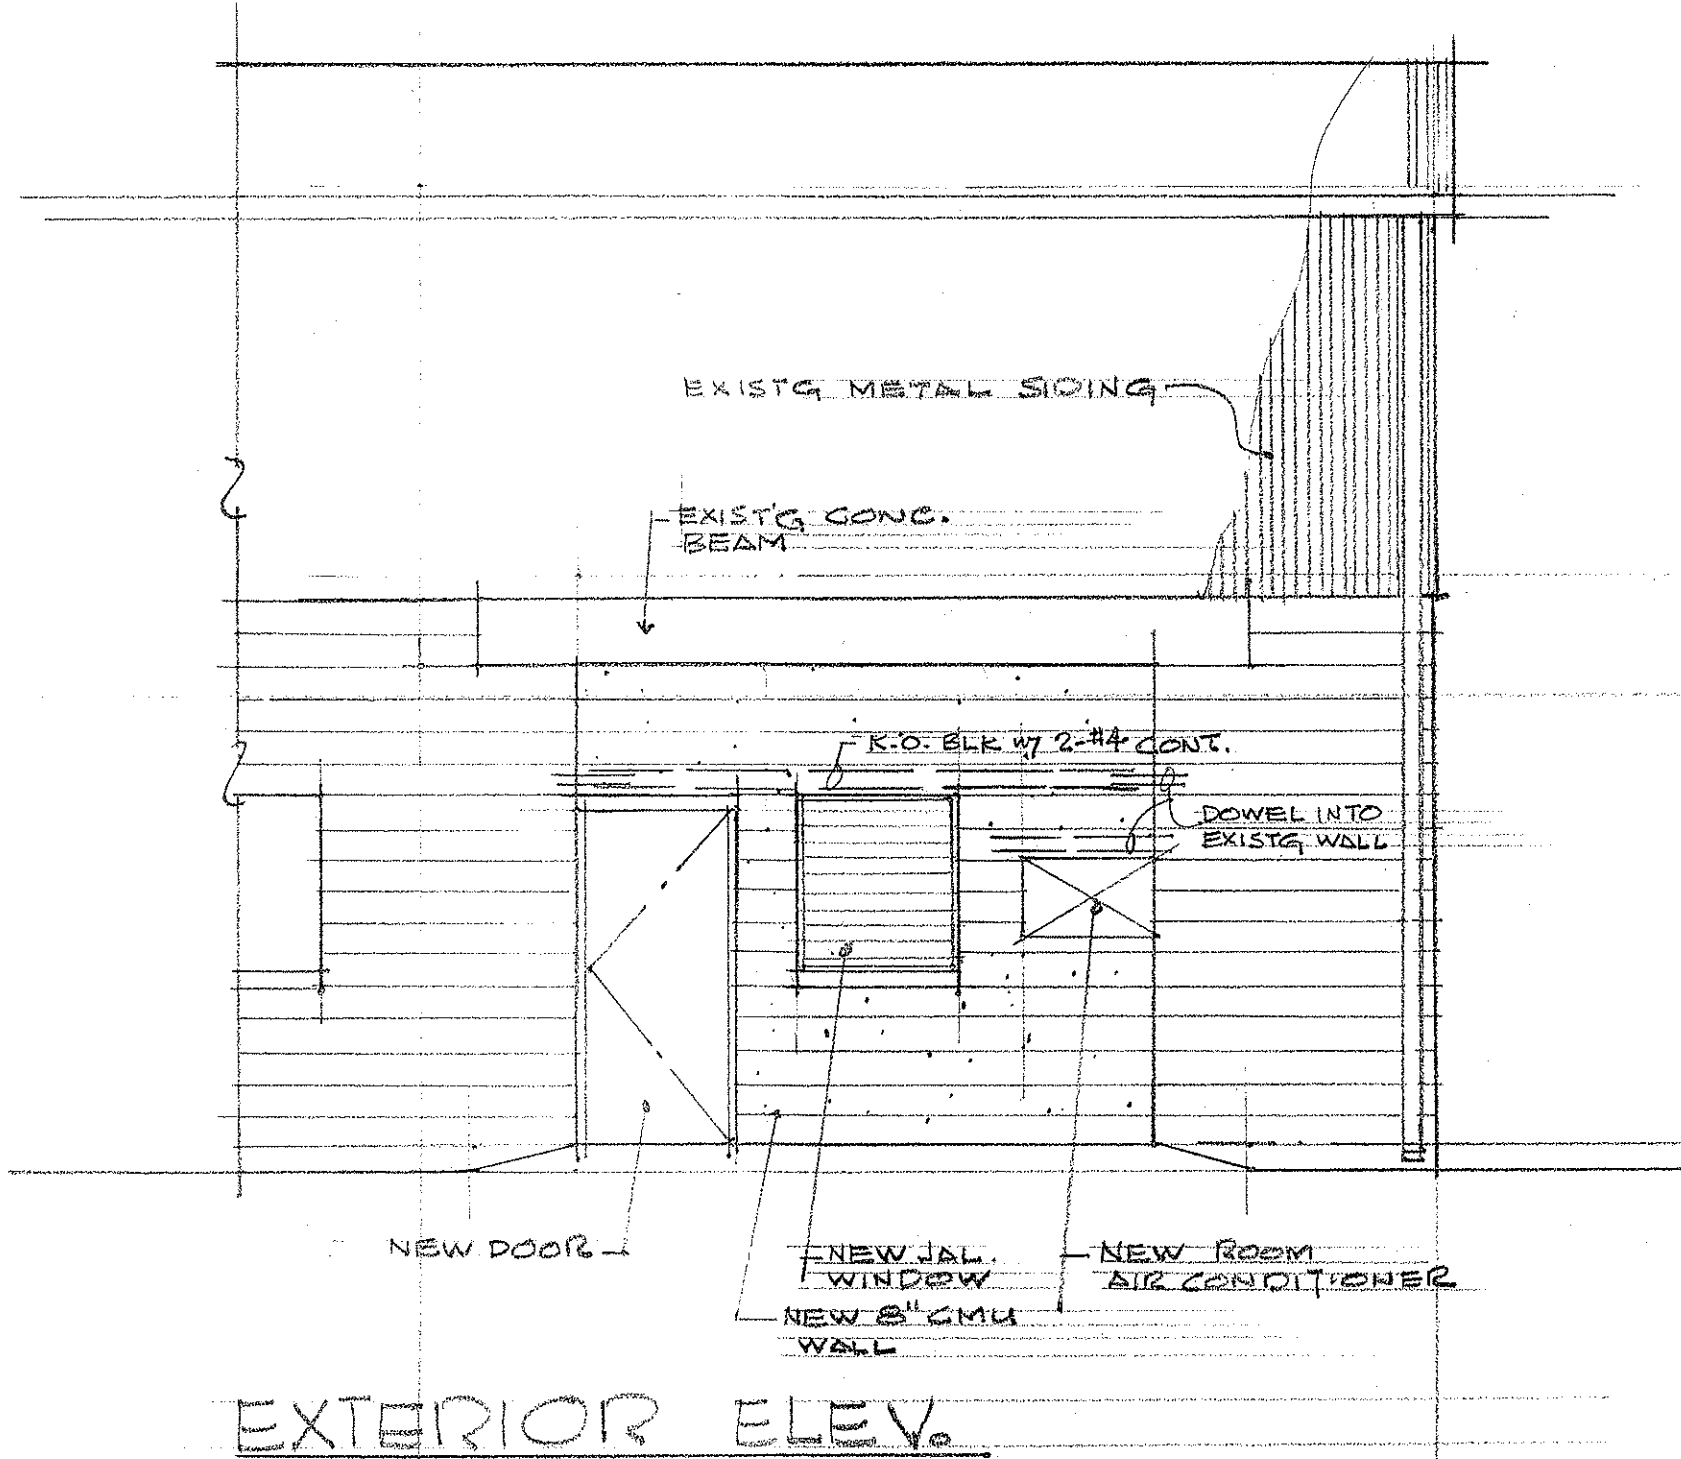

## EXTERIOR ELEV.


Scale 1/4" = 1'-0"

## DETAILS FOR NEW OFFICE RM IN WAREHOUSE BLDG.

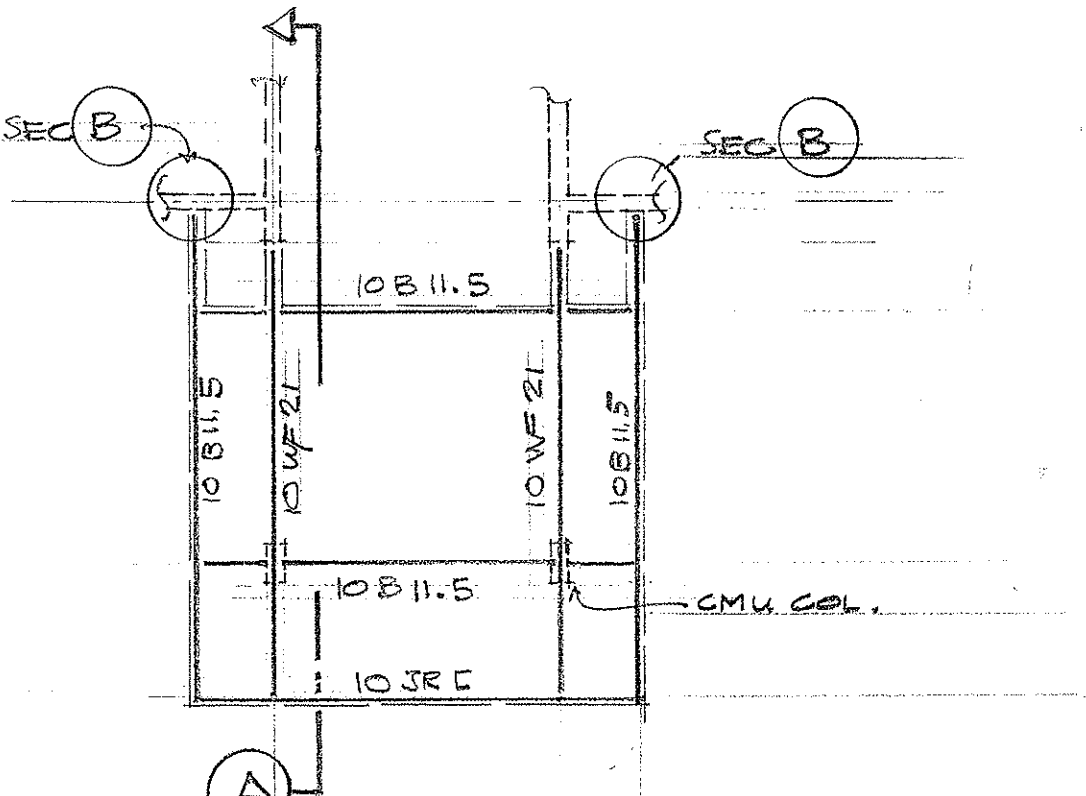

## ENTRY ROOF PLAN - EXIST'G FRAMING

Scale 1/8" = 1'-0"

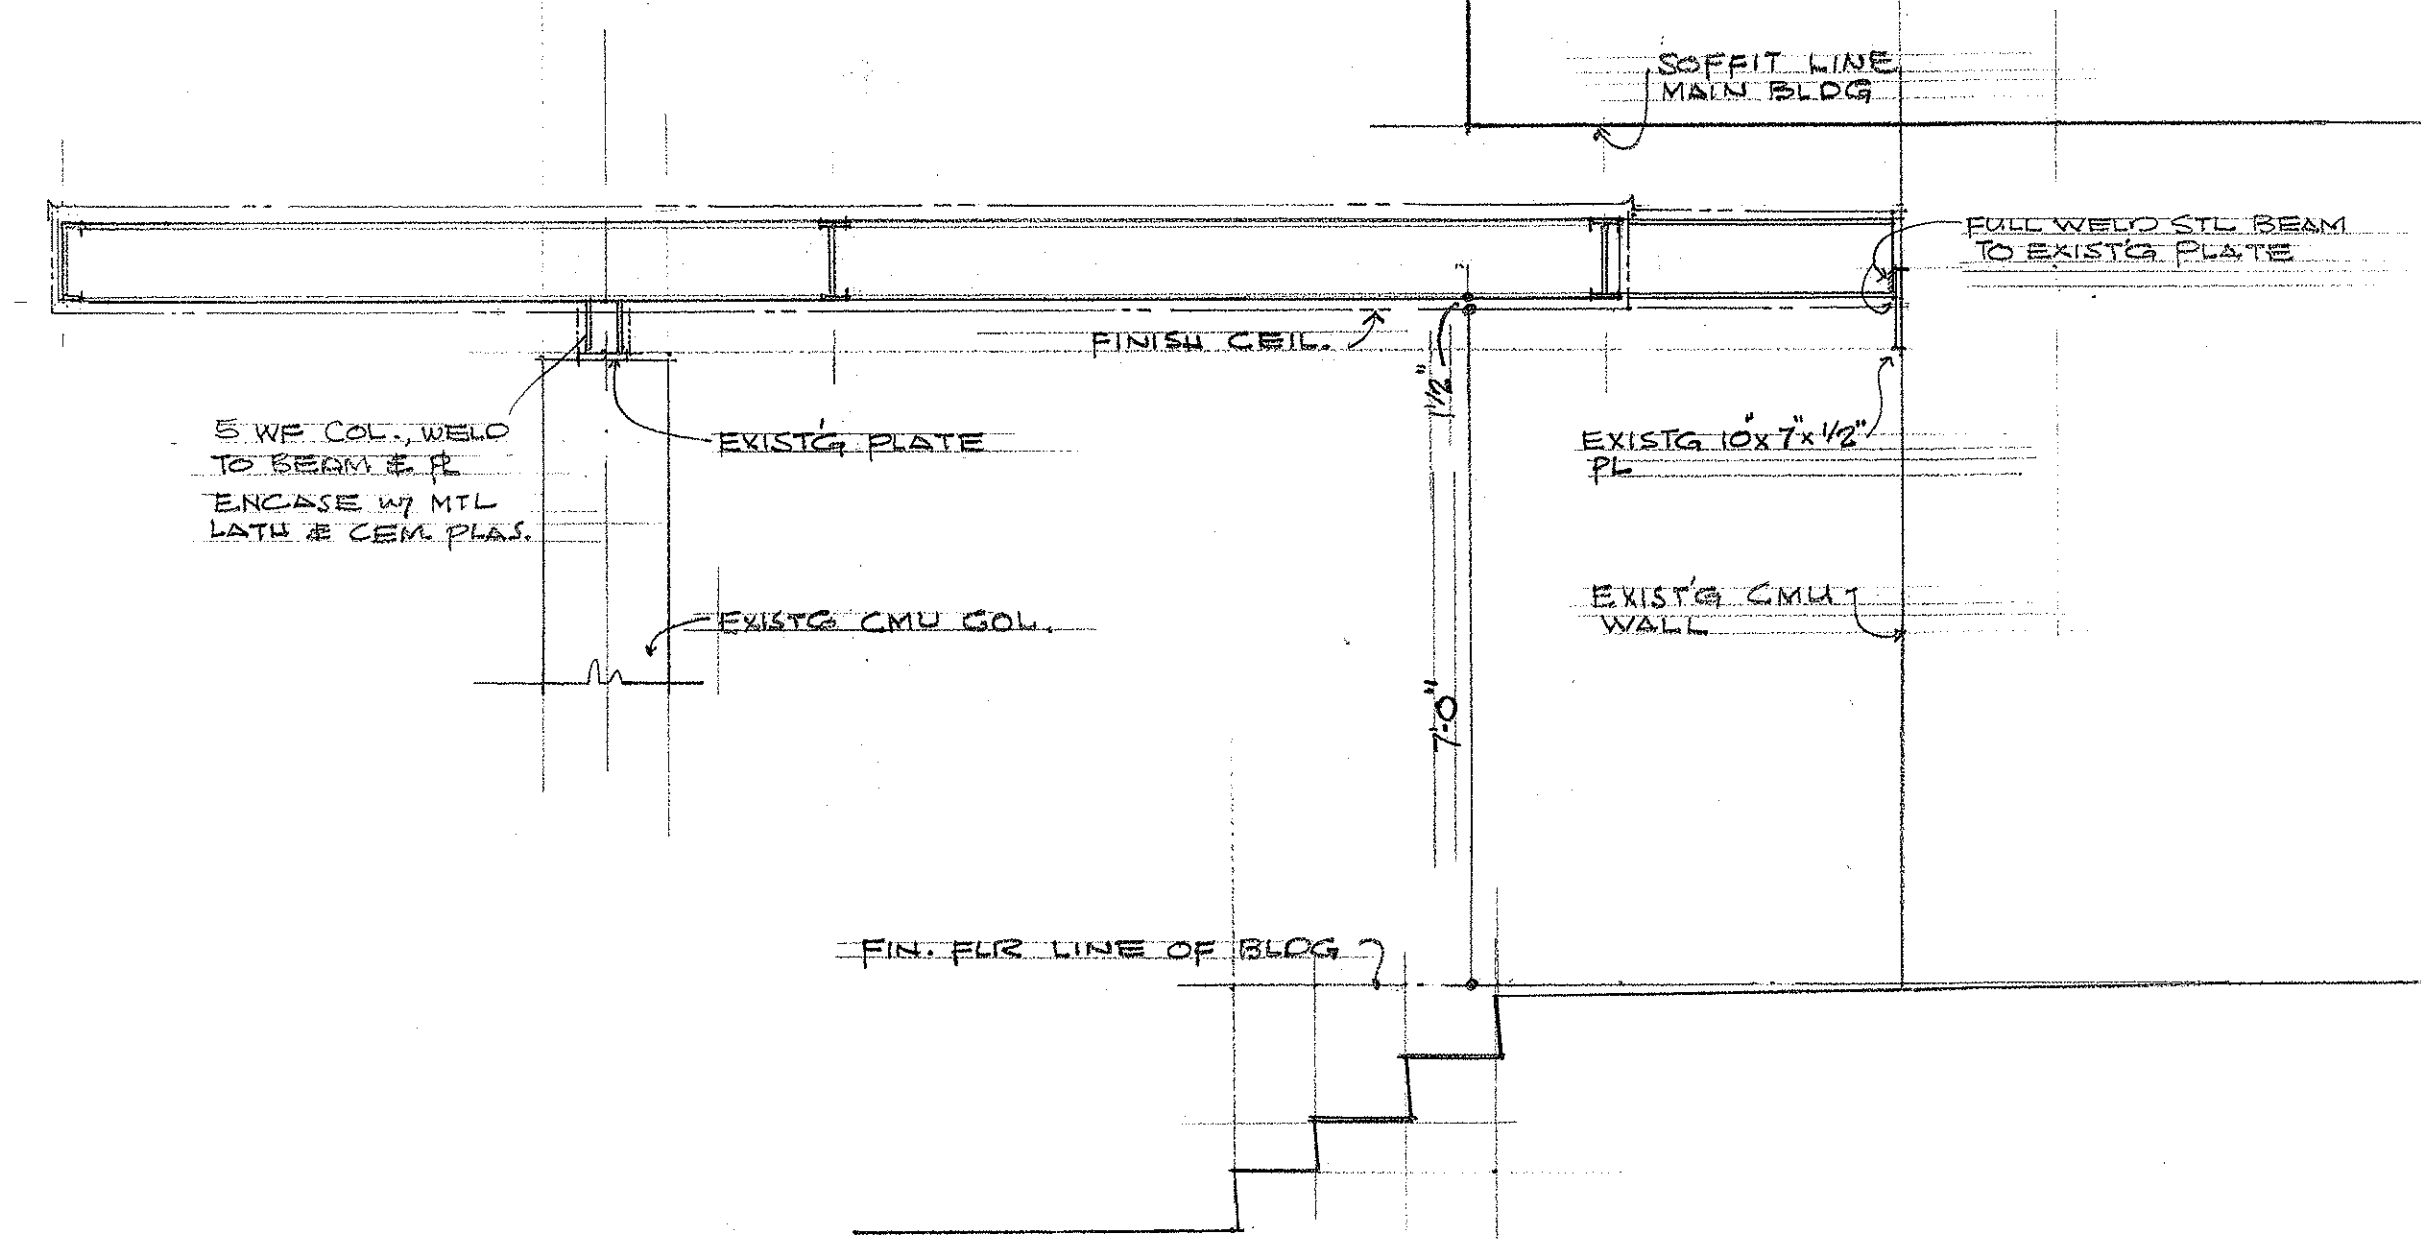

## SECTION A-A

Scale 1/2" = 1'-0"

## DETAILS FOR RAISING EXIST'G ENTRY ROOF - ADMINISTRATION BLDG.

## POST CONTRACT DWG NO. 5

|                                                                                                              |                                      |
|--------------------------------------------------------------------------------------------------------------|--------------------------------------|
| STATE OF HAWAII<br>DEPARTMENT OF TRANSPORTATION<br>HIGHWAYS DIVISION                                         |                                      |
| OAHU DISTRICT BASEYARD FACILITIES<br>SHARPER PLATS INDUSTRIAL DEVELOPMENT<br>ST. MICHAEL'S, HONOLULU, HAWAII |                                      |
| DETAILS FOR NEW OFFICE RM IN<br>WAREHOUSE BLDG, & RAISING OF<br>ENTRY ROOF AT ADMINIST. BLDG                 |                                      |
| HERBERT X. MATSUMURA<br>871 KAPIOLANI BLVD.                                                                  | ARCHITECT A.I.A.<br>HONOLULU, HAWAII |

|                   |      |
|-------------------|------|
| SURVEY PLOTTED BY | DATE |
| DESIGNED BY       |      |
| TRACED BY         |      |
| NOTE BOOK         |      |
| QUANTITIES BY     |      |
| CHECKED BY        |      |

| FED. ROAD DIST. NO. | STATE | FED. AID PROJ. NO. | FISCAL YEAR | SHEET NO. | TOTAL SHEETS |
|---------------------|-------|--------------------|-------------|-----------|--------------|
| HAWAII              | HAW.  |                    |             |           |              |

VEHICLE SHED #1

ADMINST. BLDG.

END ELEVATION

SIDE ELEVATION

PARTIAL PLOT PLAN

SECTION "B-B"

ROOF FRAMING

GEN. NOTES:

1. ALL MATERIALS, WORKMANSHIP SHALL BE IN ACCORDANCE WITH THE ORIGINAL CONTRACT SPECIFICATIONS & AS NOTED HEREIN.
2. FOR ELECT. & PLUMBING REQUIREMENTS FOR PUMP ISLAND EQUIPMENT REFER TO P.C. DWG. NO. 2
3. CONC. STRENGTH AT 28 DAYS - 3,000 PSI
4. REINFC. STEEL: ASTM A-15 & A-305
5. STRUCTURAL STEEL:
  - a. ALL PURLINS, EAVE STRUTS, FASCIA & RAKE CHANNELS SHALL BE 14 GA., 50,000 PSI STEEL
  - b. METAL SIDING & DECKING SHALL BE 26 GA. HONIRON RIB, DARK BEIGE COLOR TO MATCH EXISTING.
  - c. ALL OTHER STRUCTURAL STEEL MEMBERS, PLATES & BOLTS SHALL CONFORM TO ASTM A-36 & GALVANIZED
  - d. ALL BOLTS TO ROOF MEMBERS SHALL BE 1/2" DK 1/4" LONG MACHINE BOLTS.

SECTION

SEC. "A-A"

POST CONTRACT DWG NO. 6



THIS WORK WAS PREPARED BY ME OR UNDER MY SUPERVISION.  
Herbert Y. Matsumura

STATE OF HAWAII  
DEPARTMENT OF TRANSPORTATION  
HIGHWAYS DIVISION

OAHU DISTRICT BASEYARD FACILITIES  
SHAFTER PLATS INDUSTRIAL DEVELOPMENT  
AT MOANALUA, HONOLULU, OAHU, HAWAII

RELOCATION OF FUEL PUMP  
ISLAND ROOF STRUCTURE  
DETAIL

HERBERT Y. MATSUMURA & ASSOCIATES, INC.  
ARCHITECT  
401 KAPAHULU BLVD., RM. 200, HONOLULU, HAWAII, U.S.A.

SHEET No. 1 OF 1 SHEETS FEB. 2, 1970

|                   |      |
|-------------------|------|
| SURVEY PLOTTED BY | DATE |
| DRAWN BY          |      |
| DESIGNED BY       |      |
| QUANTITIES BY     |      |
| CHECKED BY        |      |
| ORIGINAL PLAN     |      |
| NOTE BOOK         |      |
| No.               |      |

| FED. ROAD DIST. NO. | STATE | FED. AID PROJ. NO. | FISCAL YEAR | SHEET NO. | TOTAL SHEETS |
|---------------------|-------|--------------------|-------------|-----------|--------------|
| HAWAII              | HAW.  |                    |             |           |              |

STORAGE RM

EXIST'G RECORD STOR. #2

EXIST'G RECORD STOR. #1

EXIST'G STOR

EXIST'G OFF.

PARTIAL FLOOR PLAN  
SCALE 1/4" = 1'-0"

WAREHOUSE BUILDING

GEN. NOTE:  
1. ALL MATERIALS AND WORKMANSHIP SHALL BE IN ACCORDANCE WITH THE ORIGINAL CONTRACT SPECIFICATIONS.  
2. ALL PIPE RAILING AND EXPANDED METAL MESH SHALL BE GALVANIZED

PARTIAL ELEVATION - WAREHOUSE BLDG.

EXP. MET. MESH PARTITION DET.

ELEVATION - MOTOR POOL BLDG. SCALE 1/4" = 1'-0"

SEC. 1

SEC. 2

SEC. 3

SEC. 6

PARTIAL FLOOR PLAN  
SCALE 1/4" = 1'-0"

UPPER FLOOR PLAN  
SCALE 1/4" = 1'-0"

MOTOR POOL BUILDING

DET. 4 TYP. REMOV. GUARD RAIL POST CONTRACT DWG NO. 7

STATE OF HAWAII  
DEPARTMENT OF TRANSPORTATION  
HIGHWAYS DIVISION

OAHU DISTRICT BASEYARD FACILITIES  
SHEPHERD PLATS INDUSTRIAL DEVELOPMENT  
AT MOANALUA, HONOLULU, OAHU, HAWAII

NEW STEEL STAIRS & REMOVABLE GUARD RAILS FOR MOTOR POOL & WAREHOUSE BLDGS.  
NEW ANTE RM PARTITION FOR WAREHOUSE BLDG.

HERBERT Y. MATSUMURA & ASSOCIATES, INC.  
ARCHITECT  
171 KAPAHULU BLVD., RM. 2  
HONOLULU, HAWAII 96815

SHEET No. 1 OF 1 SHEETS FEB. 20 '70

THIS WORK WAS PREPARED BY  
ME OR UNDER MY SUPERVISION.  
*Herbert Y. Matsumura*



|                   |      |
|-------------------|------|
| SURVEY PLOTTED BY | DATE |
| DRAWN BY          |      |
| TRACED BY         |      |
| QUANTITIES BY     |      |
| CHECKED BY        |      |
| NO.               |      |