

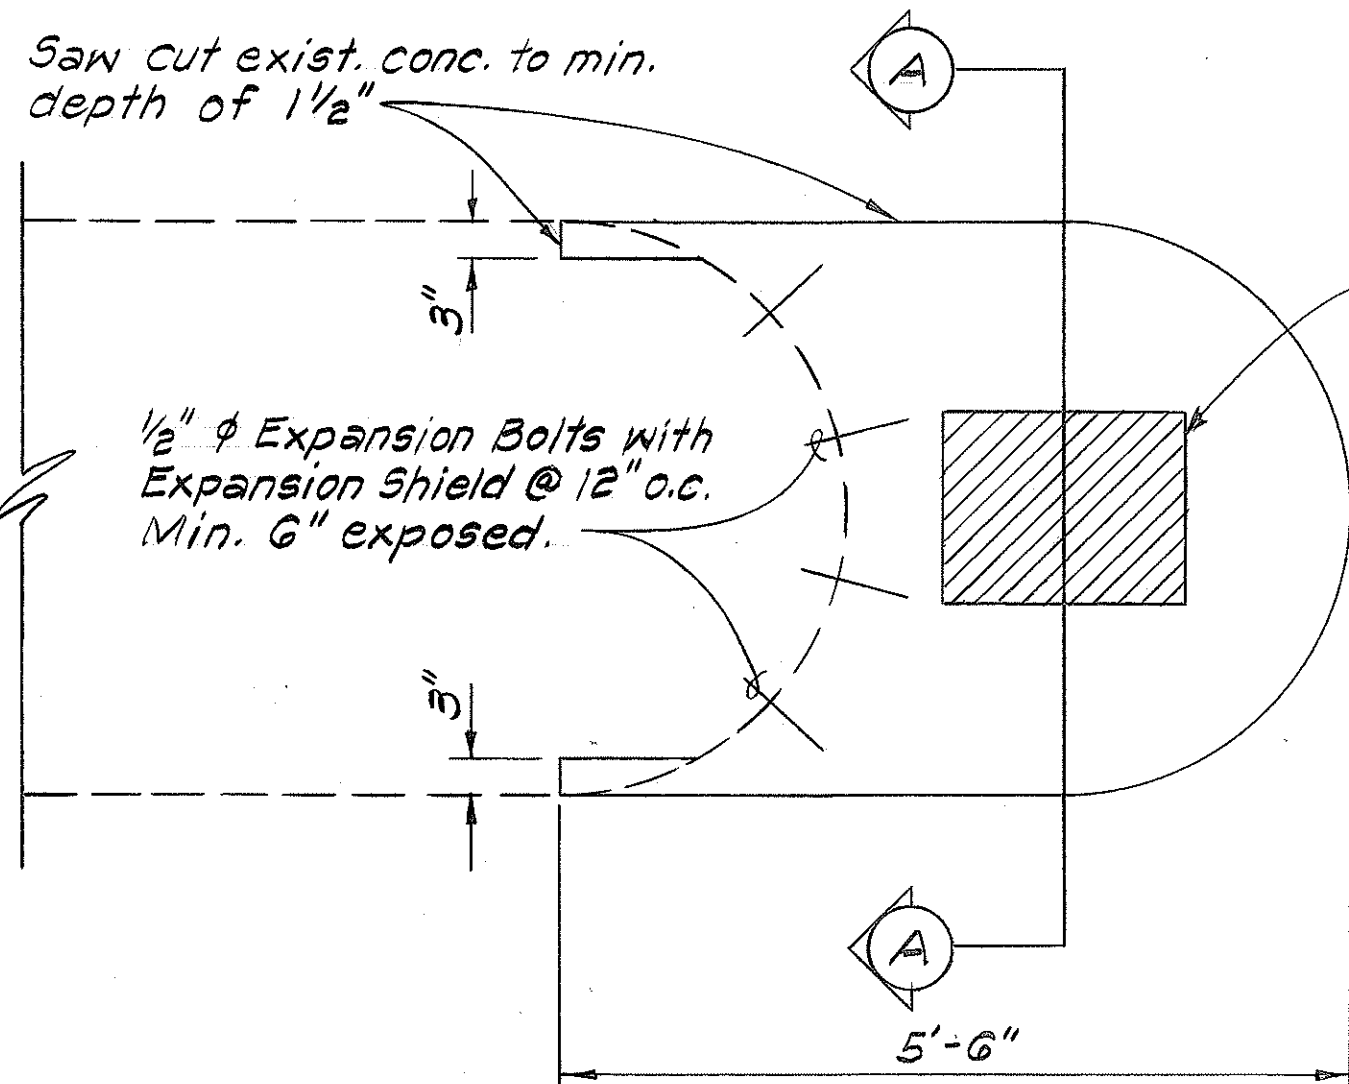


FED. ROAD DIST. NO.	STATE	PROJ. NO.	FISCAL YEAR	SHEET NO.	TOTAL SHEETS
HAWAII	HAW.	LT-0-05-79	1981	2	4

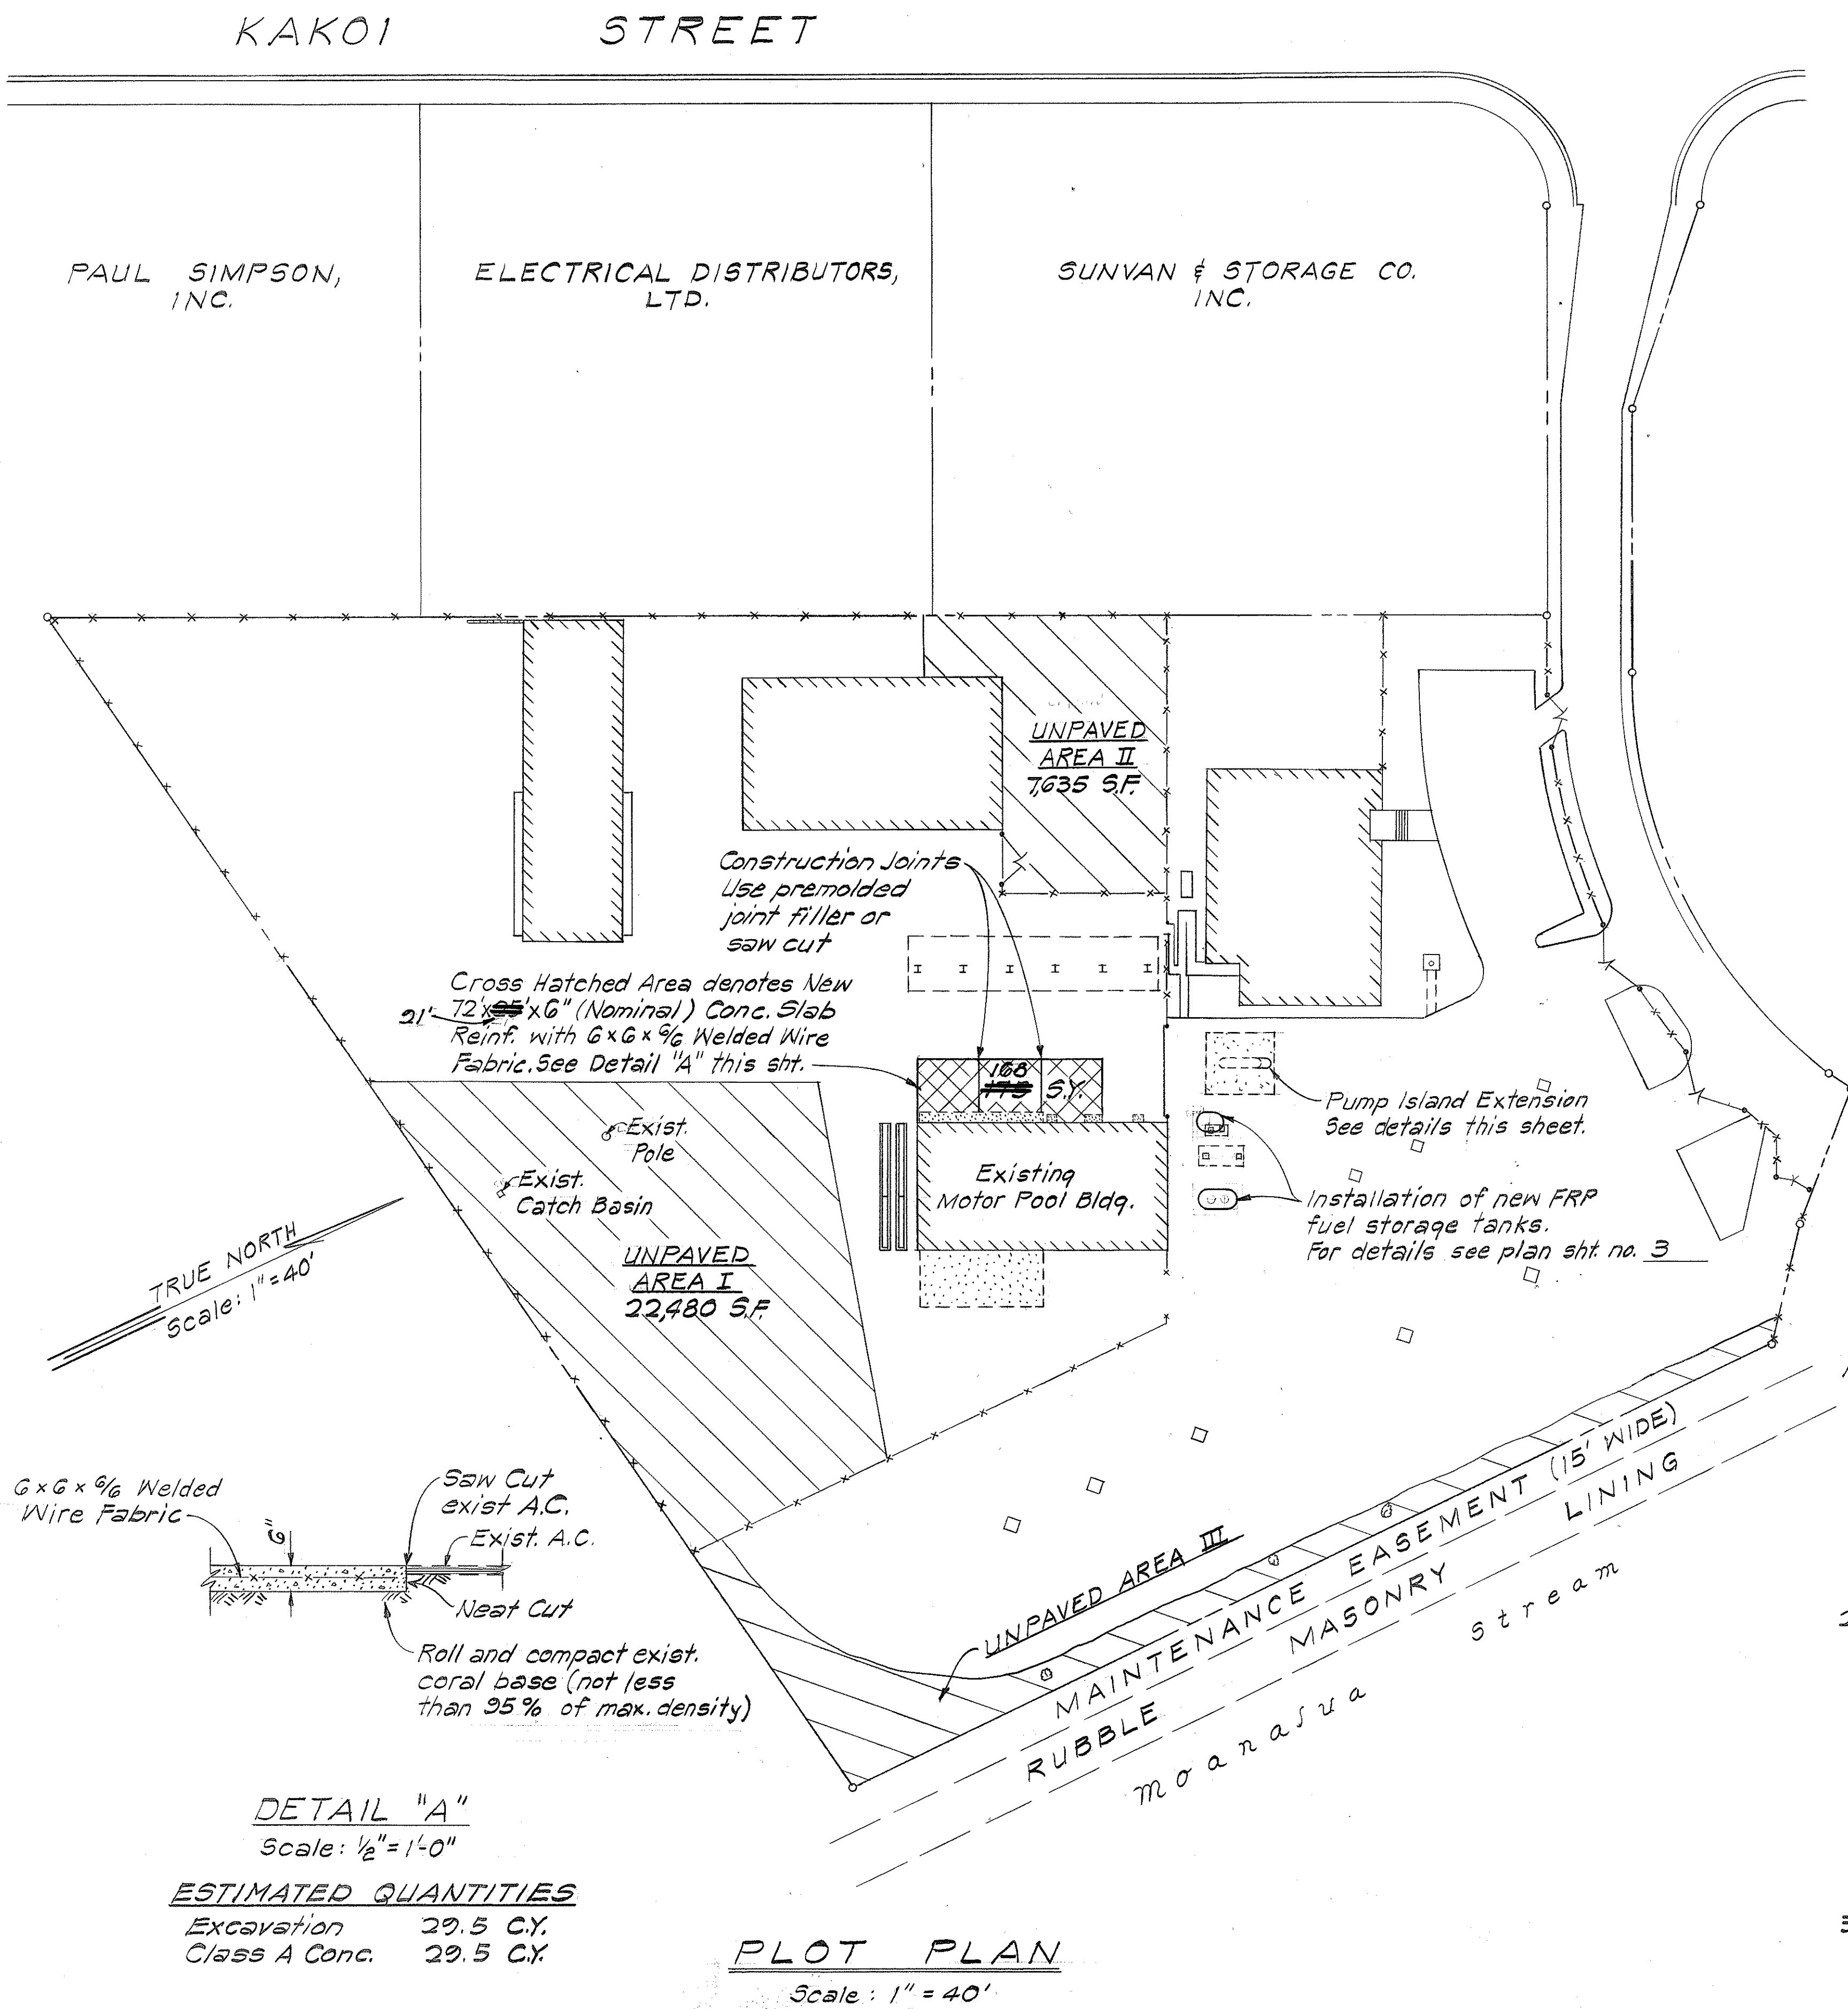

PUMP ISLAND EXTENSION
Scale: 3/4" = 1'-0"

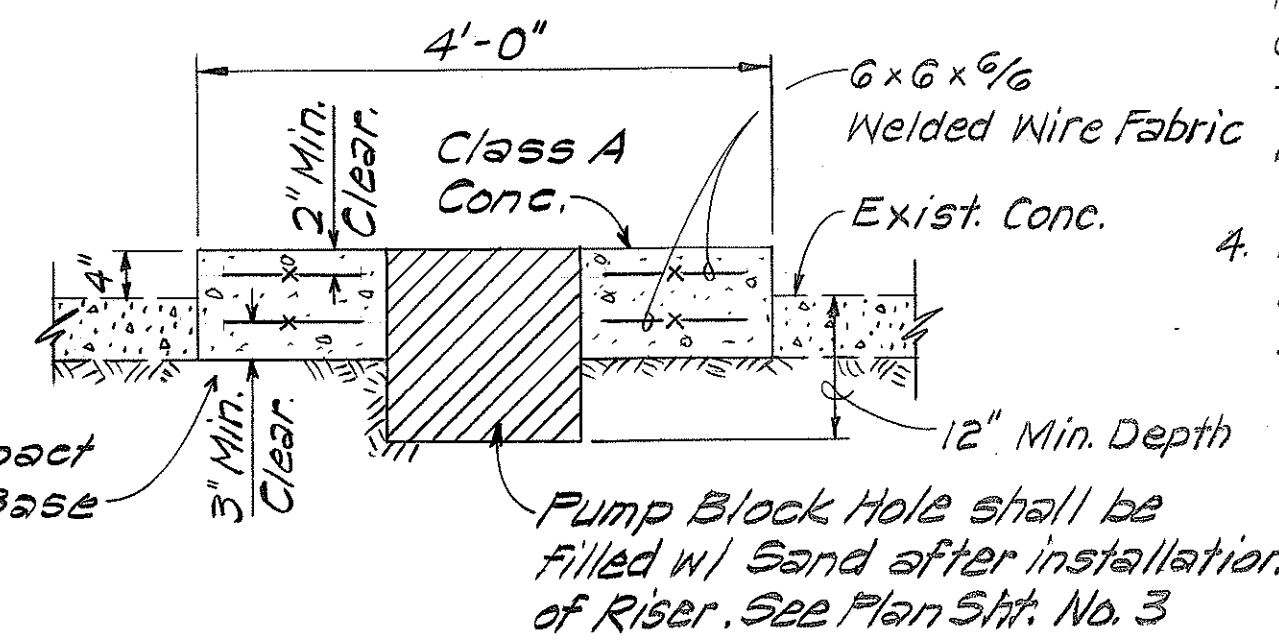

SECTION "A-A"
Scale: 3/4" = 1'-0"

ESTIMATED QUANTITIES

Excavation	0.3 C.Y.
Class A Conc.	0.5 C.Y.

GENERAL NOTES

- The existence and location of underground electric, fuel, water, vent and air lines as shown on the plans are approximate only. They are not guaranteed as to the locations shown or as to other lines or obstacles that may be encountered in the course of work. The Contractor shall assume that existing underground lines not shown on the plans may exist.
- The Contractor shall exercise extreme care in his operations near existing facilities and shall be held liable for any damages to the existing facilities including underground lines as a result of his operations. The Contractor shall immediately repair said damages in accordance with the Standards and Specifications of the State or as ordered by the Engineer. Any costs as a result of said damages by the Contractor shall be the Contractor's responsibility and no compensation will be made therefor.
- All trenches and/or excavations within the area of the gasoline pumps shall be covered as directed by the Engineer to permit vehicles to traverse safely over during the following times:
6:30 A.M. to 9:30 A.M.
2:00 P.M. to 3:15 P.M.
- Both sides of the gasoline pumps shall be accessible to Baseyard vehicles during the aforementioned times.
- CAUTION NOTE.** The Baseyard is operative during hours of darkness therefore, the Contractor shall insure that all excavations are protected by effective barricades during non-working hours and obstructions shall be illuminated during hours of darkness. This work shall be considered incidental to "Baseyard Improvements" and shall not be paid for separately.

DETAIL "A"
Scale: 1/2" = 1'-0"

ESTIMATED QUANTITIES

Excavation	29.5 C.Y.
Class A Conc.	29.5 C.Y.

PLOT PLAN

Scale: 1" = 40'

STATE OF HAWAII
DEPARTMENT OF TRANSPORTATION
LAND TRANSPORTATION FACILITIES DIVISION

PLAN AND DETAILS

OAHU DISTRICT
BASEYARD IMPROVEMENTS
Proj. No. LT-0-05-79
Scale: As Shown Date: Nov, 1980
SHEET NO. 1 OF 1 SHEETS

DATE	11/1/80
SURVEY PLOTTED BY	W. J. B.
DRAWN BY	W. J. B.
DESIGNED BY	W. J. B.
NOTED BY	W. J. B.
QUANTITIES BY	W. J. B.
CHECKED BY	W. J. B.
ORIGINAL PLAN	NO.
NOTE BOOK	NO.