
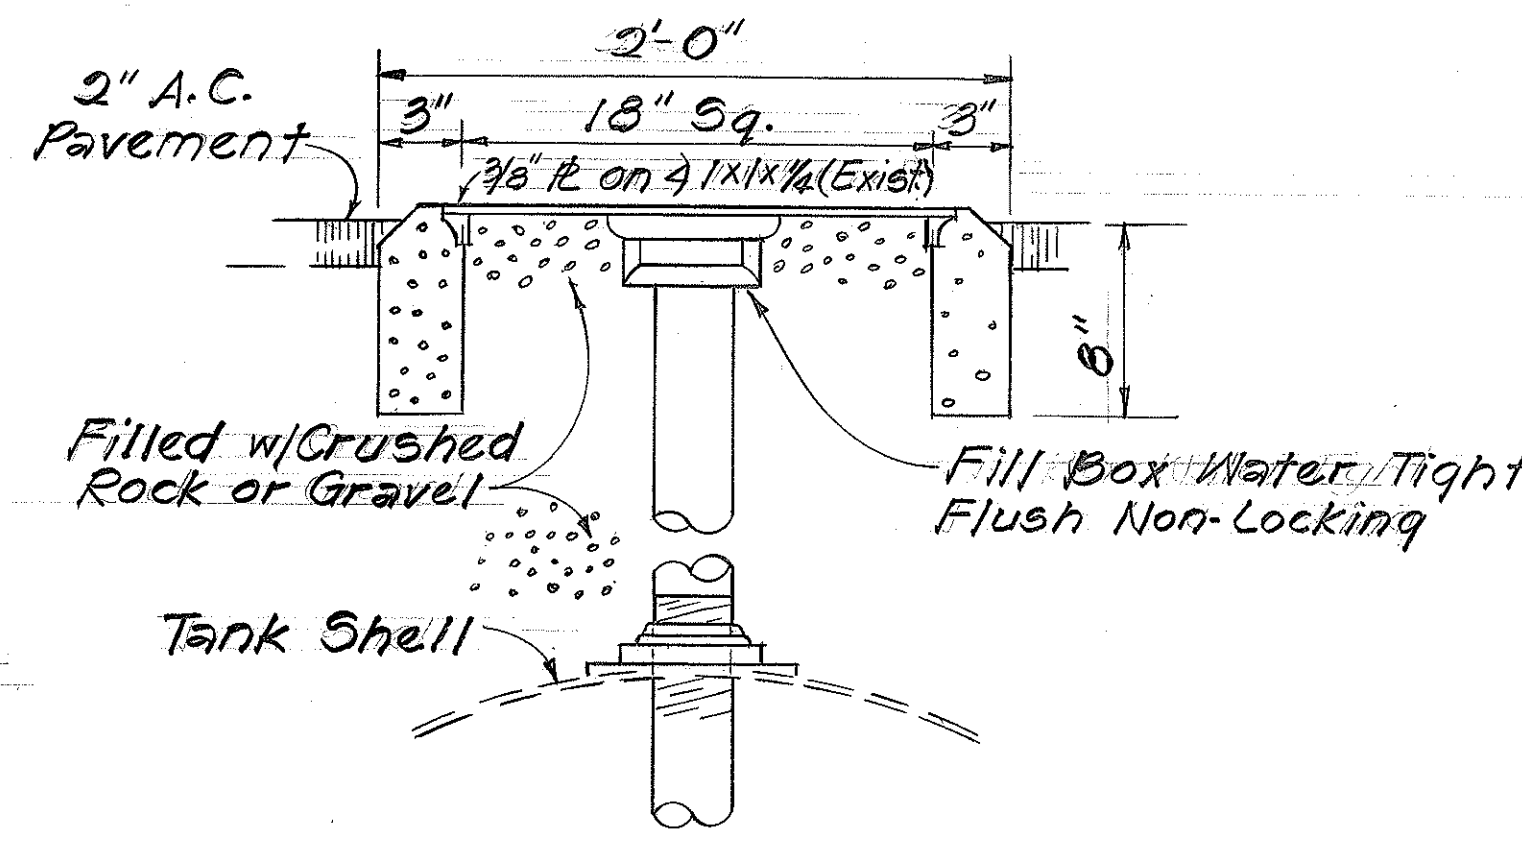
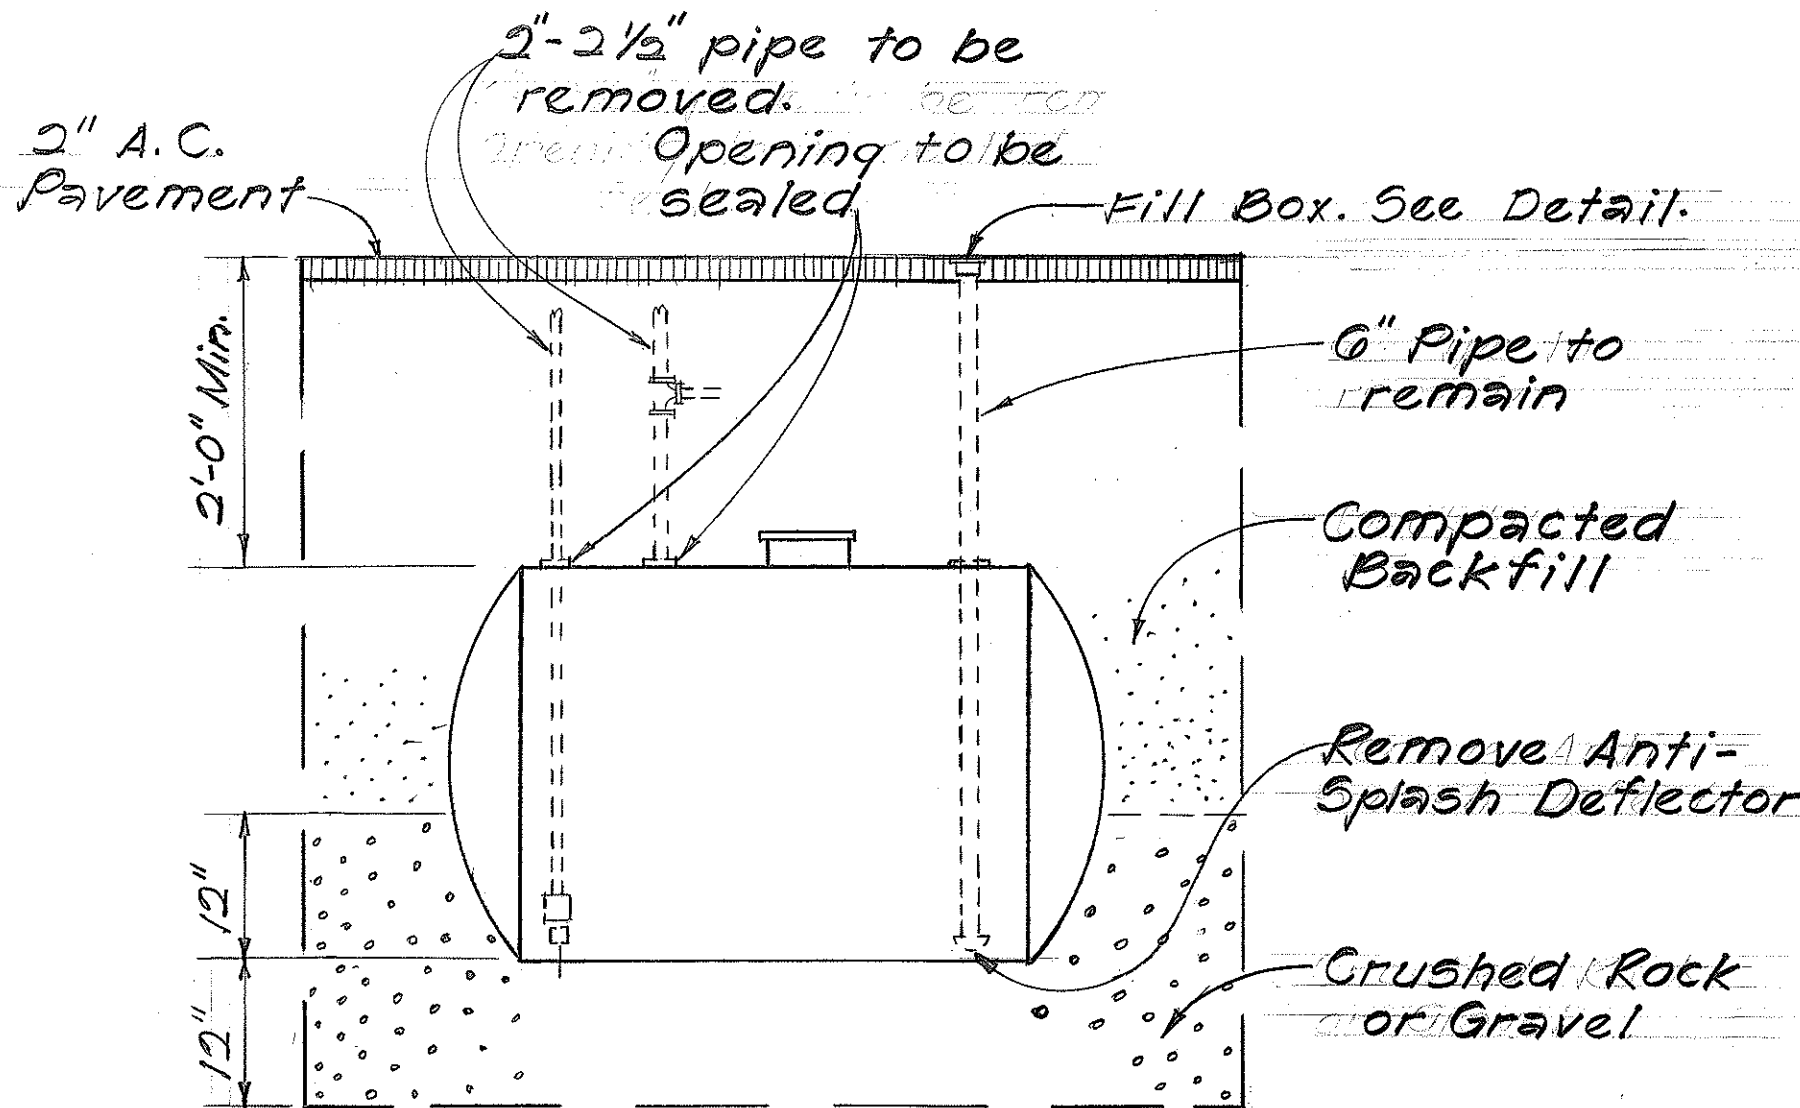
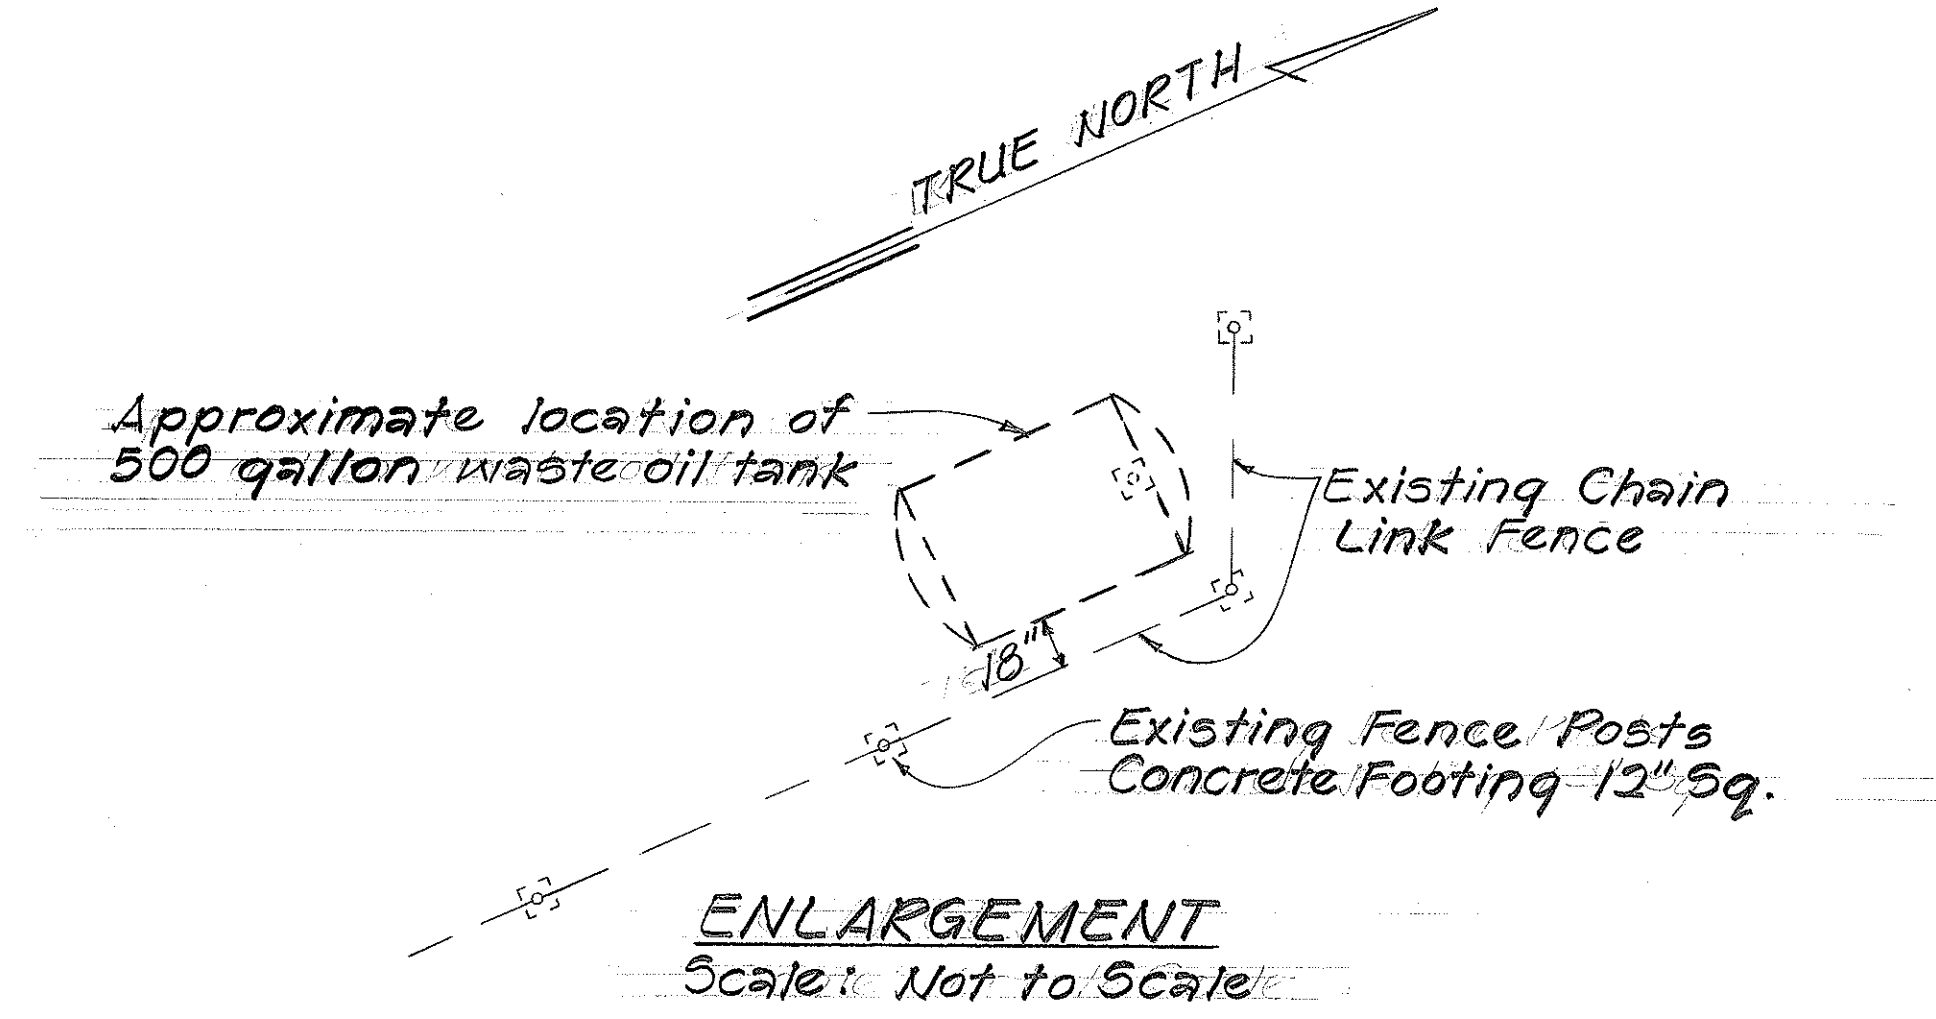


FED. ROAD DIST. NO.	STATE	FED. AID PROJ. NO.	FISCAL YEAR	SHEET NO.	TOTAL SHEETS
HAWAII	HAW.	LT-0-05-79	1981	45-1	4

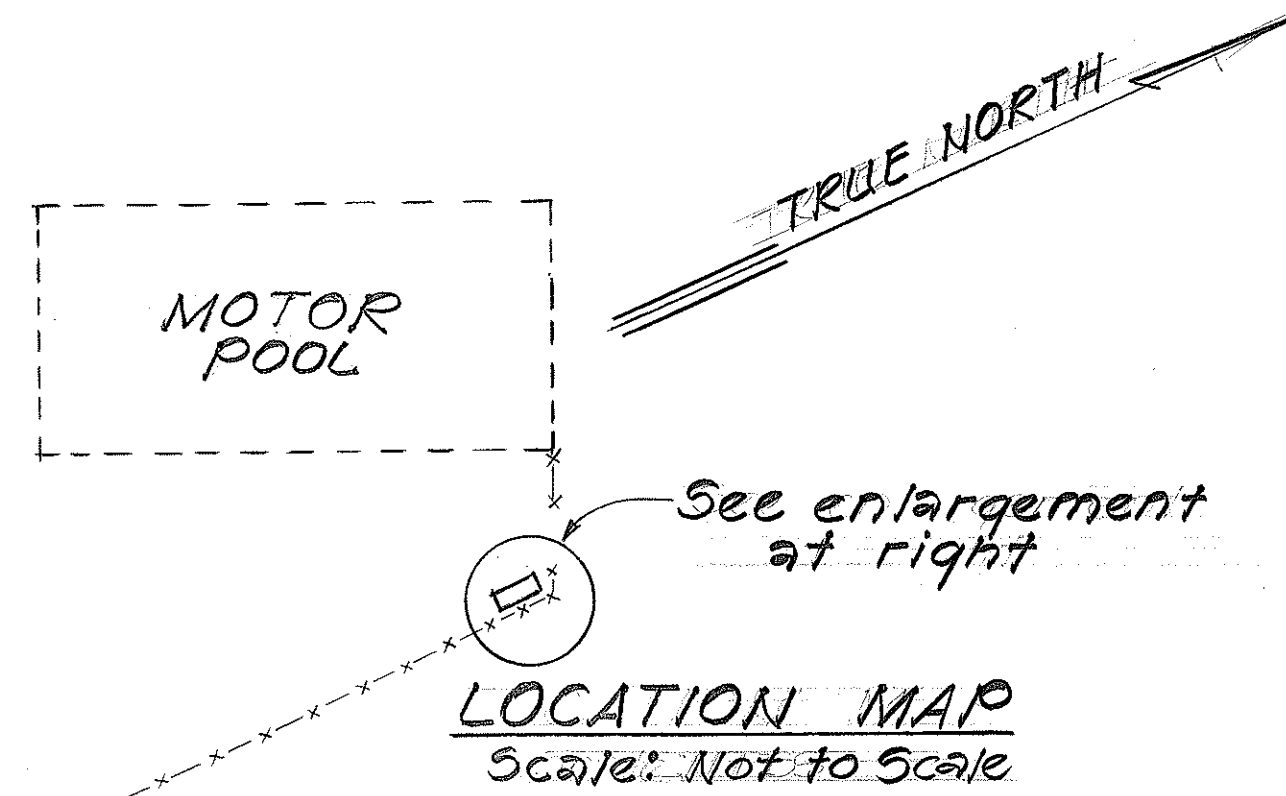

REINSTALL EXISTING 500 GAL. TANK
(For Use As Waste Oil Storage Tank)

SURVEY PLOTTED BY	DATE
DRAWN BY	
DESIGNED BY	
QUANTITIES BY	
CHECKED BY	

THIS SHEET PREPARED DURING "AS-BUILT" POSTING

STATE OF HAWAII
DEPARTMENT OF TRANSPORTATION
LAND TRANSPORTATION FACILITIES DIVISION
REINSTALL
EXISTING 500 GALLON TANK
OAHU DISTRICT
BASEYARD IMPROVEMENTS
Proj. No. LT-0-05-79
Not to Scale Date: Sept., 1982
SHEET NO. 1 OF 1 SHEETS