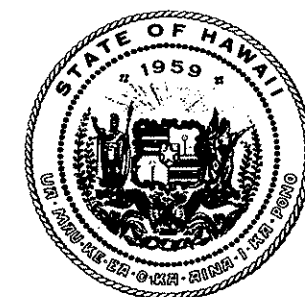


[illegible]


STATE OF HAWAII
DEPARTMENT OF TRANSPORTATION
HIGHWAYS DIVISION
"AS-BUILT"
PLANS FOR

DISTRICT OF HONOLULU
ISLAND OF OAHU

ALL CHANGES MADE DURING CONSTRUCTION HAVE BEEN INCORPORATED ON THESE PLANS IN RED EXCEPT CHANGES IN THE ORIGINAL THEORETICAL QUANTITIES. FOR ACTUAL QUANTITIES, REFER TO PROJECT LEDGER AND/OR COMPUTATION BOOK.

Robert Y. Mironaka
RESIDENT ENGINEER

9/10/82
DATE

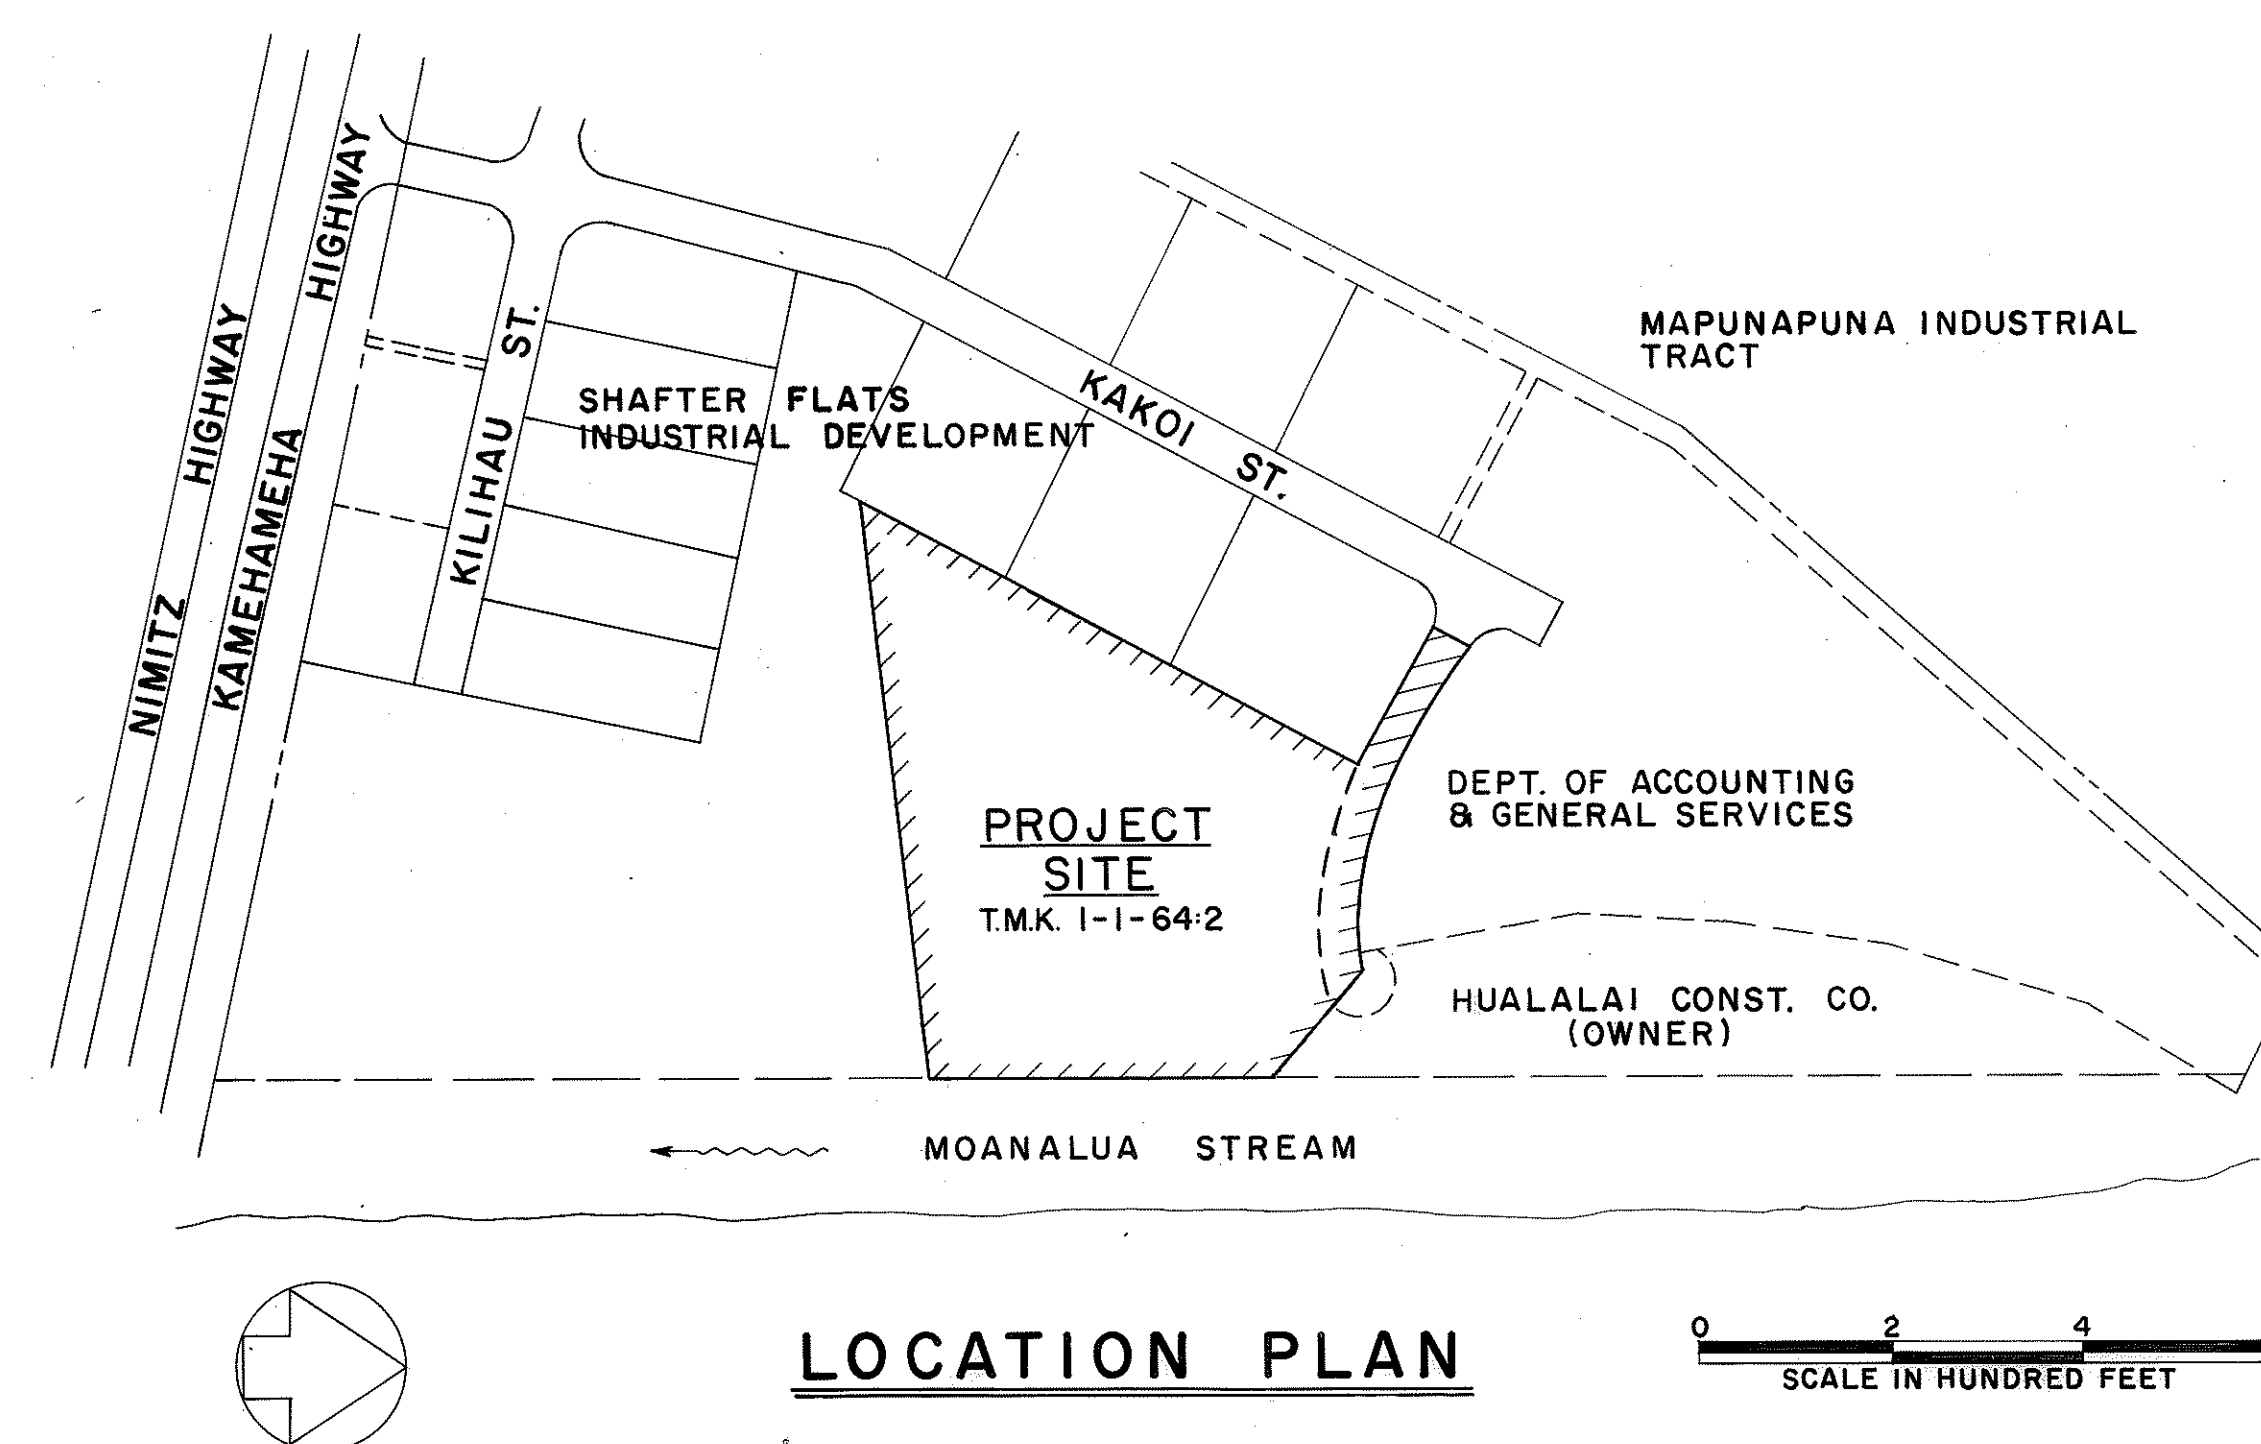

A horizontal scale bar with markings at 0, 2, and 4. Below the bar is the text "SCALE IN HUNDRED FEET".

DEPARTMENT OF TRANSPORTATION
STATE OF HAWAII

APPROVED:
James R. Canas 12/5/80
Asst. DIR. OF TRANSPORTATION DATE

A. Nishimura A. Nishimura 548-7537 Nov., 1980
DESIGNED BY P. S. & E. BY PHONE DATE