


FED. AID DIST. NO.	STATE	FED. AID PROJ. NO.	FISCAL YEAR	SHEET NO.	TOTAL SHEETS
HAWAII	HAW.	DANR100(1)	1944	5-A	12

FED. AID DIST. NO.	STATE	FED. AID PROJ. NO.	FISCAL YEAR	SHEET NO.	TOTAL SHEETS
HAWAII	HAW.	DANR100(1)	1944	3D	12


FED. AID DIST. NO.	STATE	FED. AID PROJ. NO.	FISCAL YEAR	SHEET NO.	TOTAL SHEETS
HAWAII	HAW.	DANR100(1)	1944	8	12

Orig. Tracing Filed Under — HAWAII HAW. DANR100(1) 1944 8 12

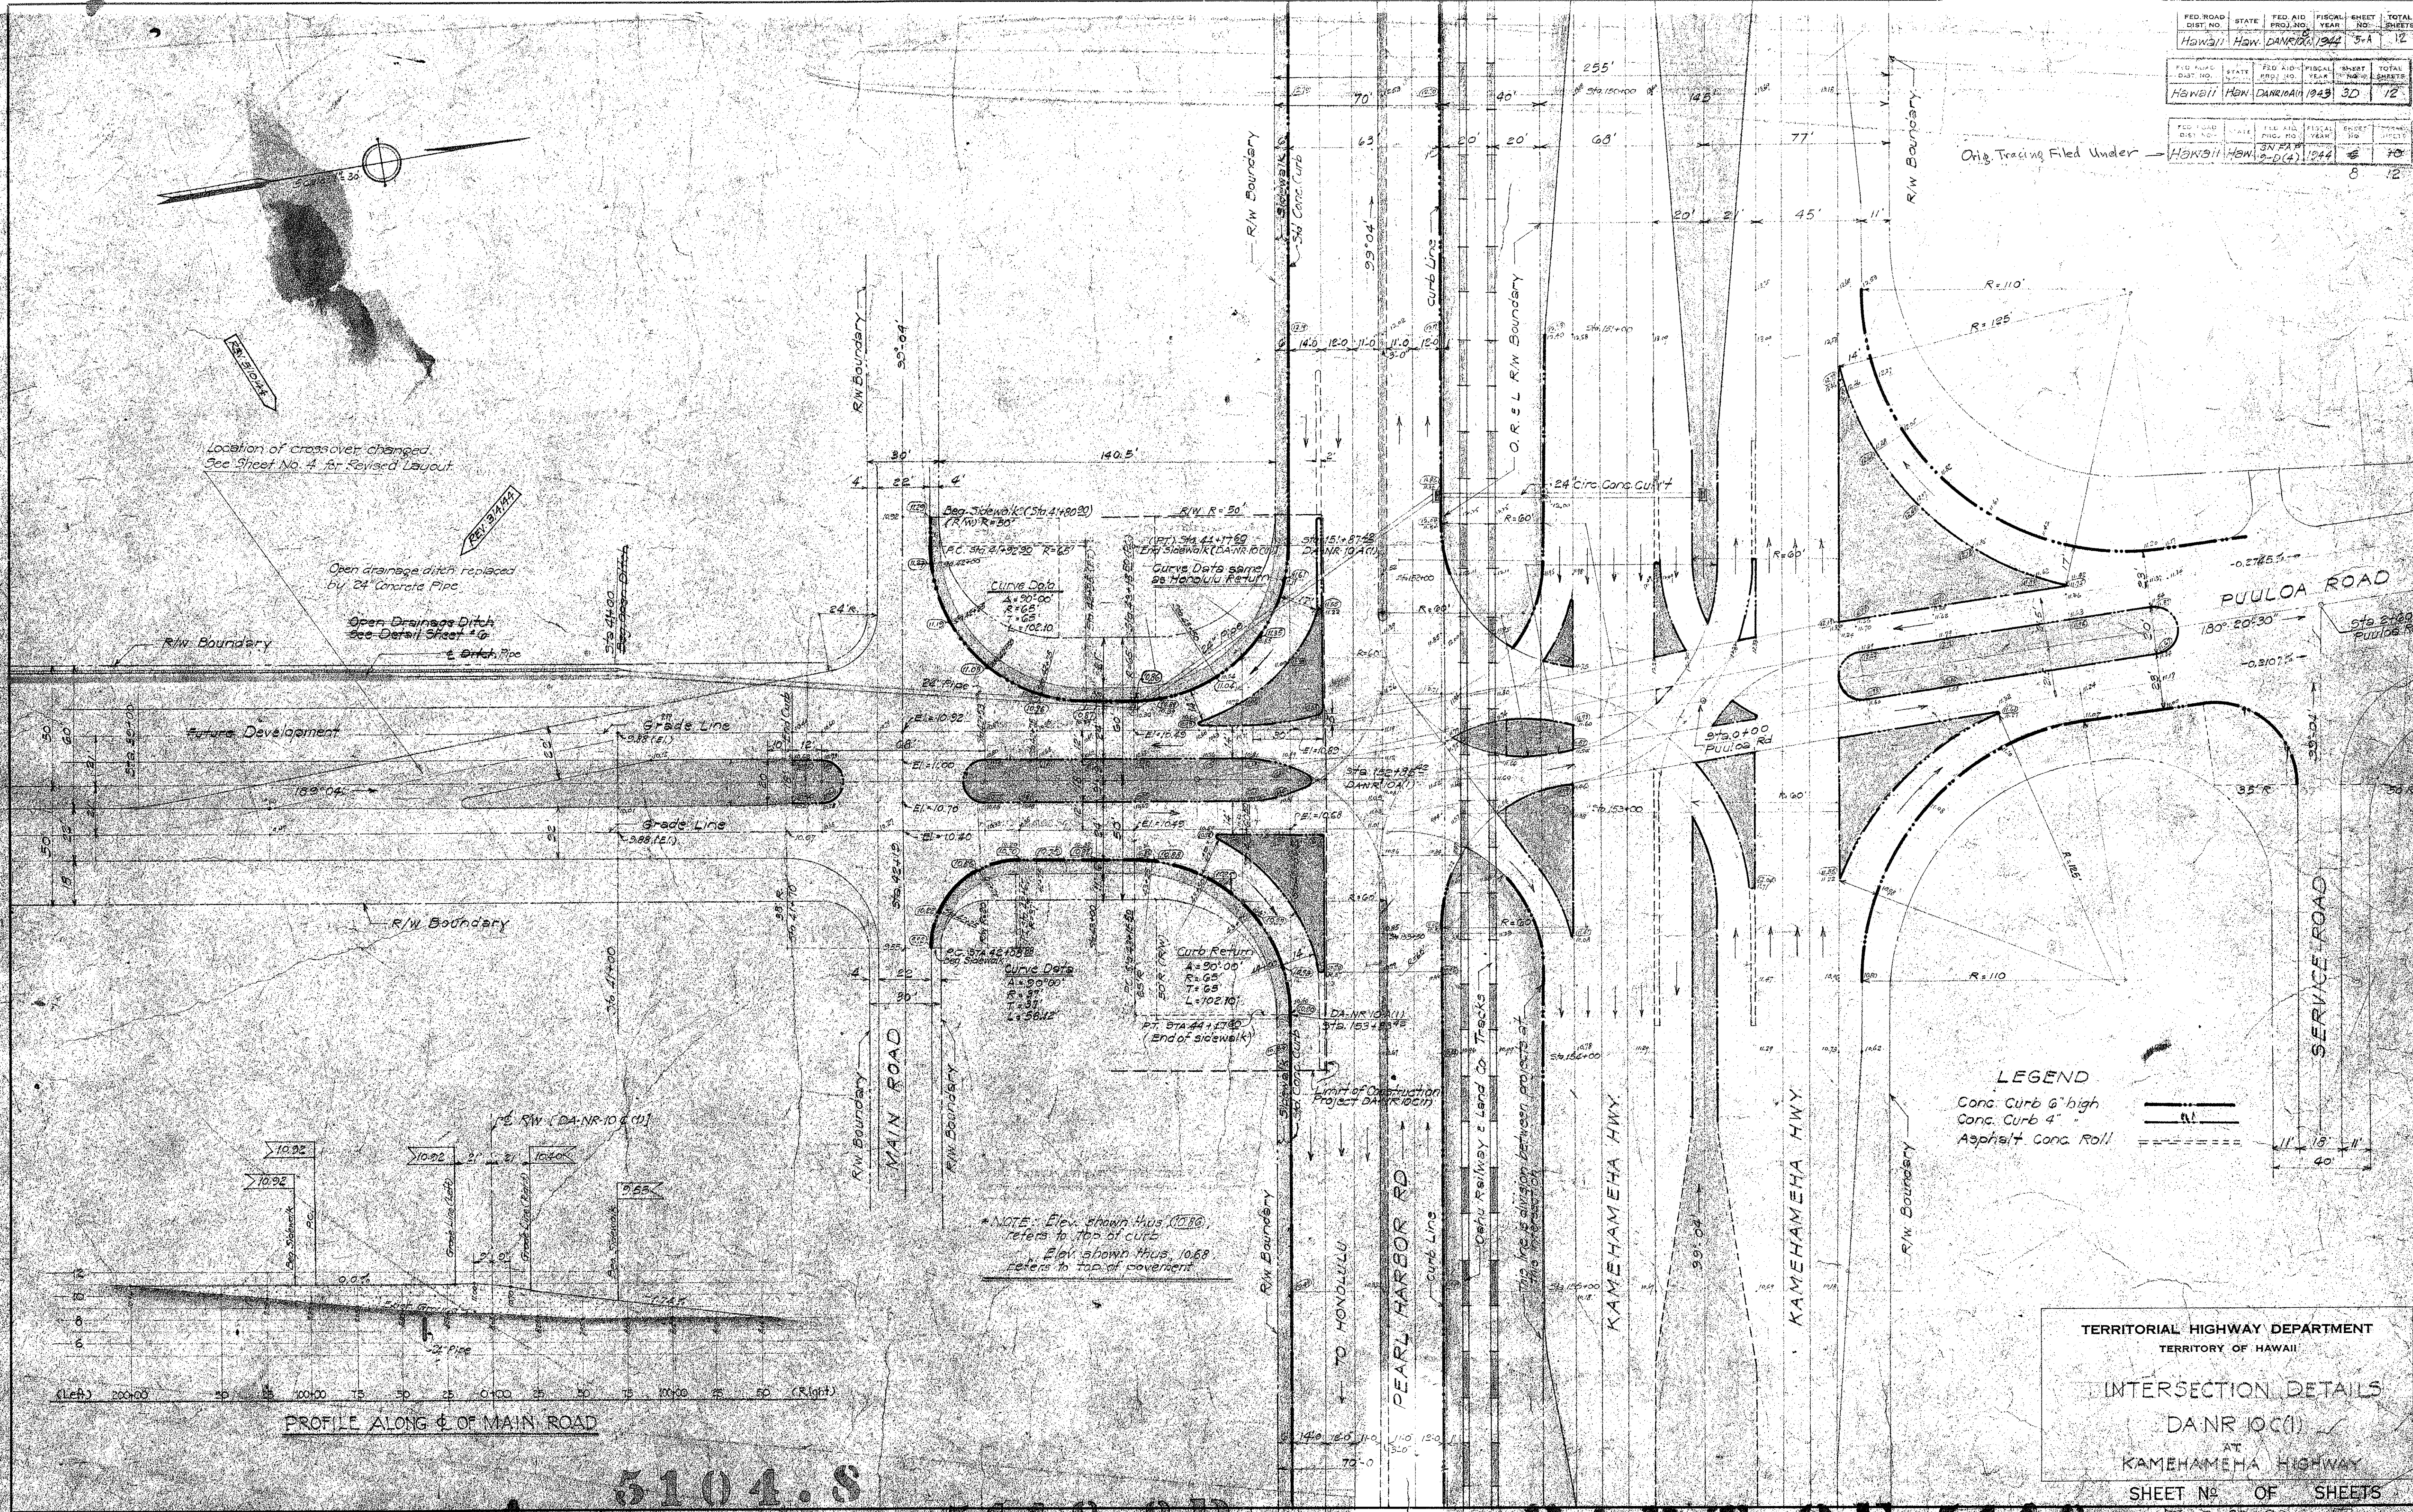

Checked by: J.O.
 Date: 1/10/44
 Original Surveyed by: J.O.
 Plan: J.O.
 Note Book: J.O.
 Checked by: J.O.

ORIGINAL SURVEY PLATTED BY: J.O.
 DESIGNED BY: J.O.
 TRACED BY: J.O.
 NOTE BOOK: J.O.
 CHECKED BY: J.O.

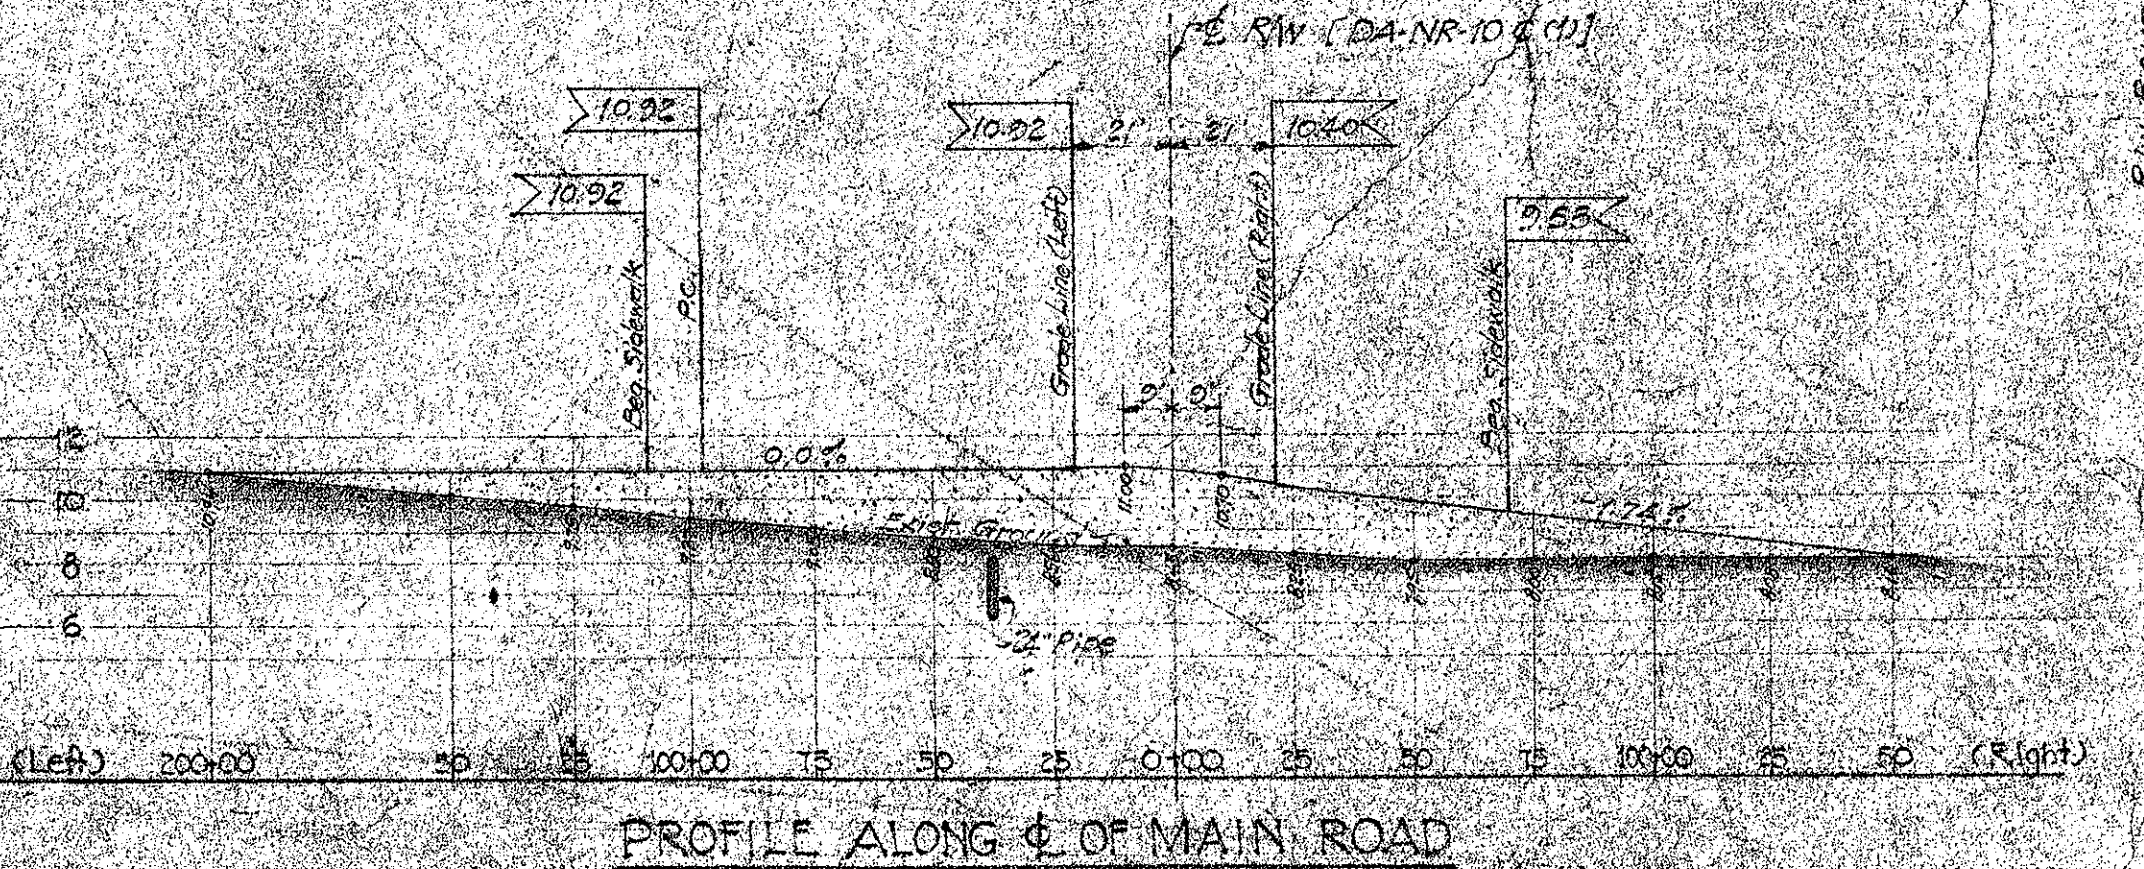

PROFILE ALONG C OF MAIN ROAD

LEGEND
 Conc. Curb 6" high
 Conc. Curb 4"
 Asphalt Conc. Roll

TERRITORIAL HIGHWAY DEPARTMENT
 TERRITORY OF HAWAII
 INTERSECTION DETAILS
 DANR 100(1)
 AT
 KAMEHAMEHA HIGHWAY
 SHEET NO. 5 OF SHEETS