
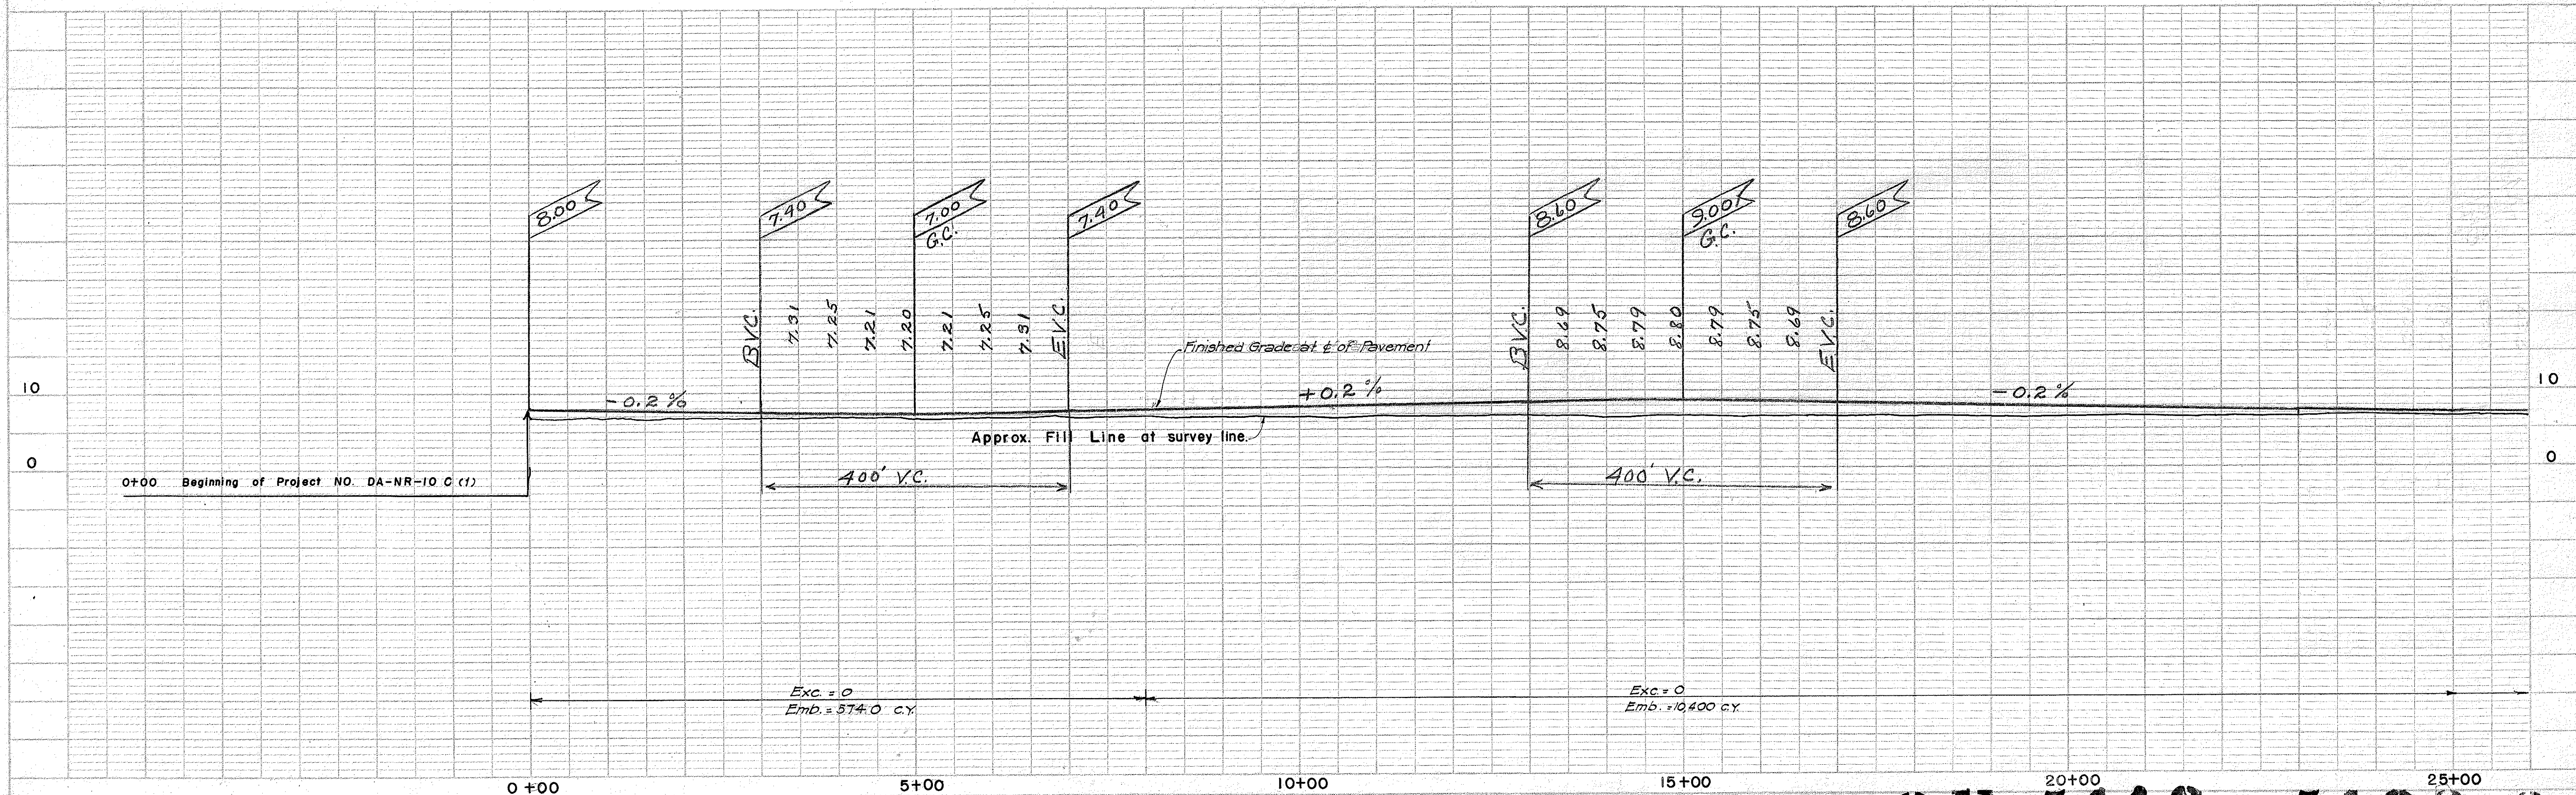


FED. ROAD DIST. NO.	STATE	FED. AID PROJ. NO.	FISCAL YEAR	SHEET NO.	TOTAL SHEETS
HAWAII	HAW.	DANR1000	1943	3	12

All Azimuths Referred to Salt Lake Δ
All Elev. Referred to U.S.C. & G.S. Datum (M.S.L. = 0.00')


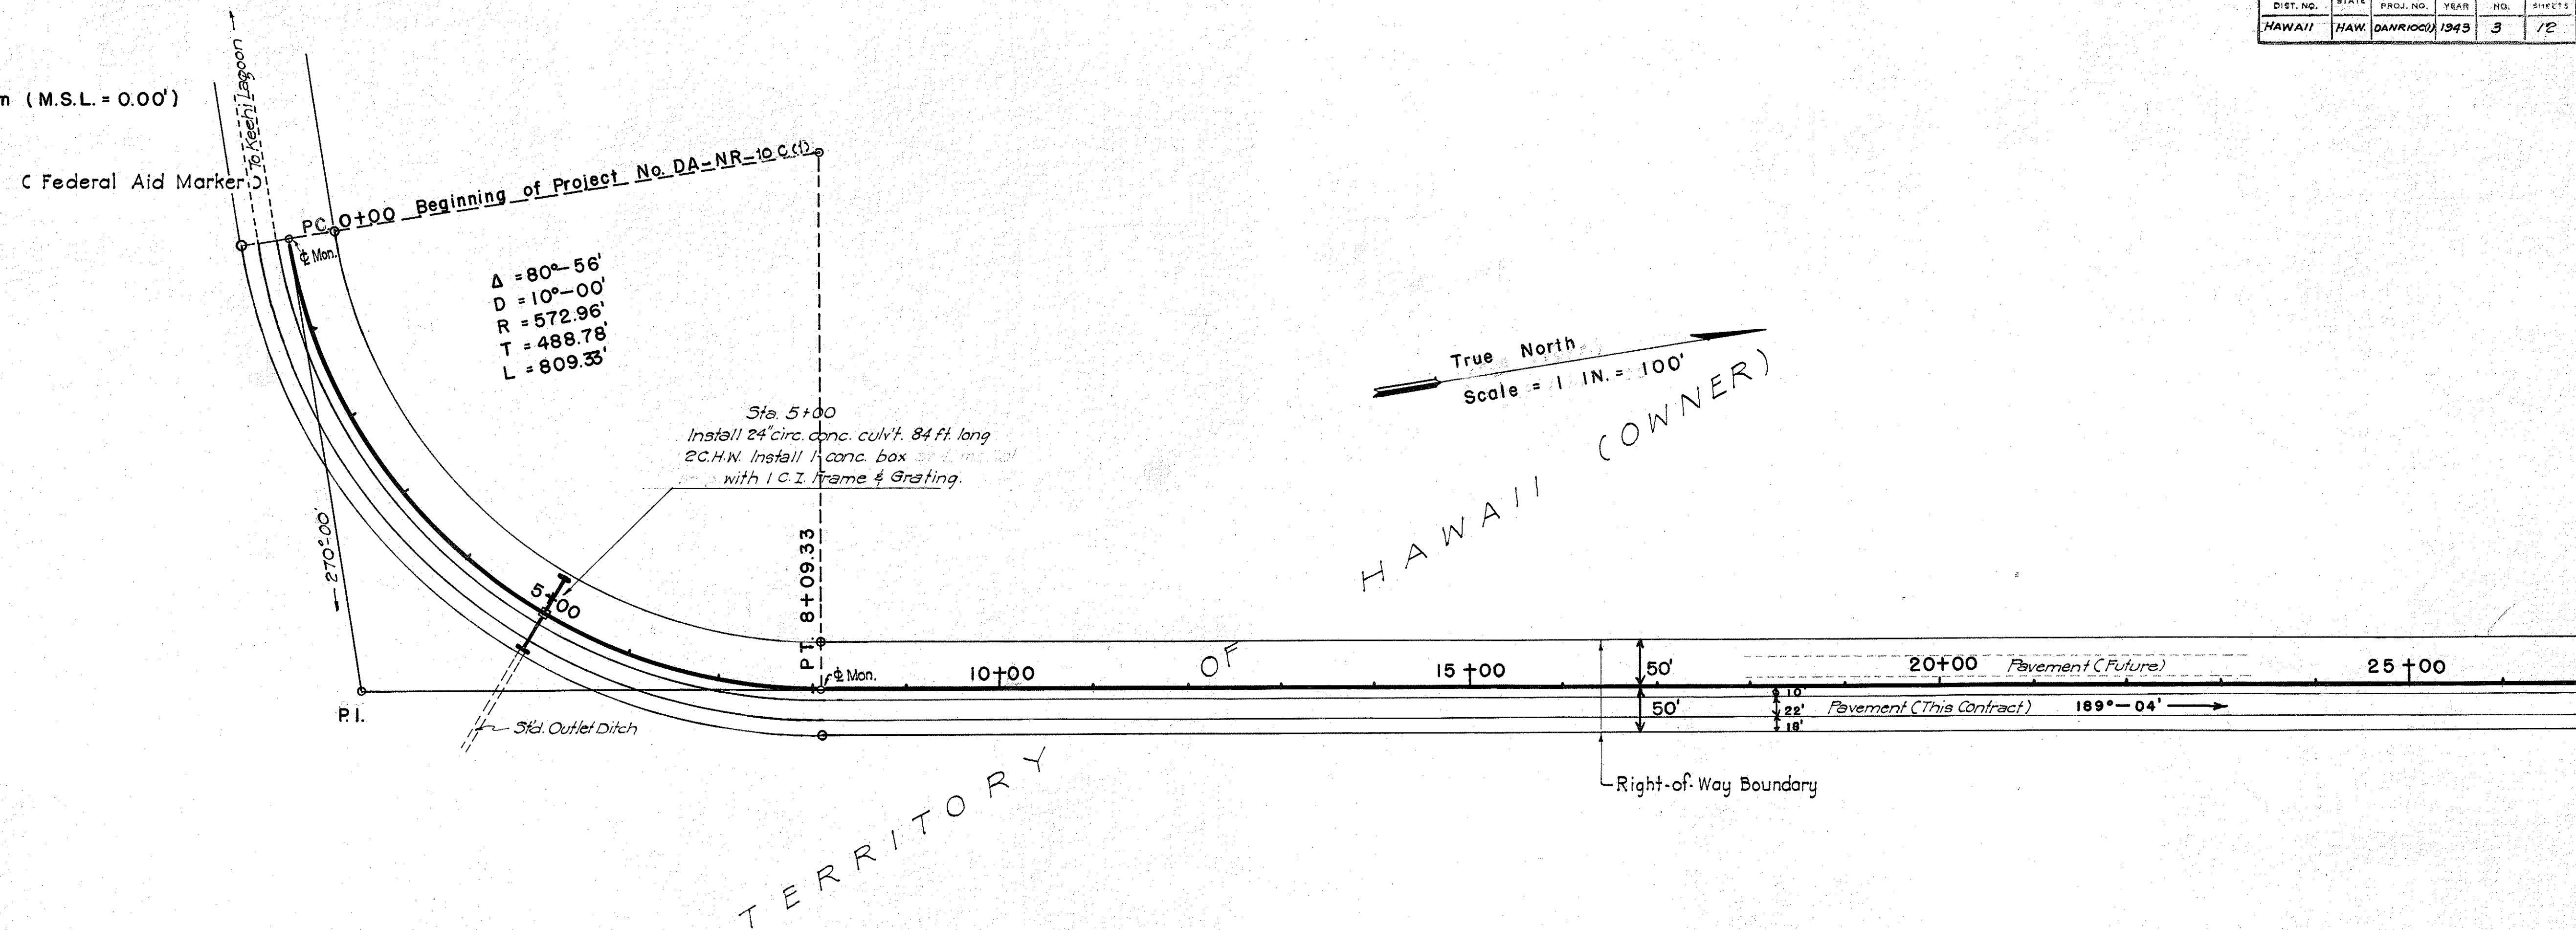


PLAN	REVISED	DATE	BY
NOTE BOOK	REVISED	DATE	BY
NOTE BOOK	REVISED	DATE	BY
NOTE BOOK	REVISED	DATE	BY
NOTE BOOK	REVISED	DATE	BY

Revision: May 10, 1944
Revision: March 4, 1944
24" concrete pipe substituted
in place of open ditch.

PROFILE	REVISED	DATE	BY
NOTE BOOK	REVISED	DATE	BY
NOTE BOOK	REVISED	DATE	BY
NOTE BOOK	REVISED	DATE	BY
NOTE BOOK	REVISED	DATE	BY

FED. ROAD DIST. NO.	STATE	FED. AID PROJ. NO.	FISCAL YEAR	SHEET NO.	TOTAL SHEETS
HAWAII	HAW.	DA-NR-10C(1)	1943	4	12

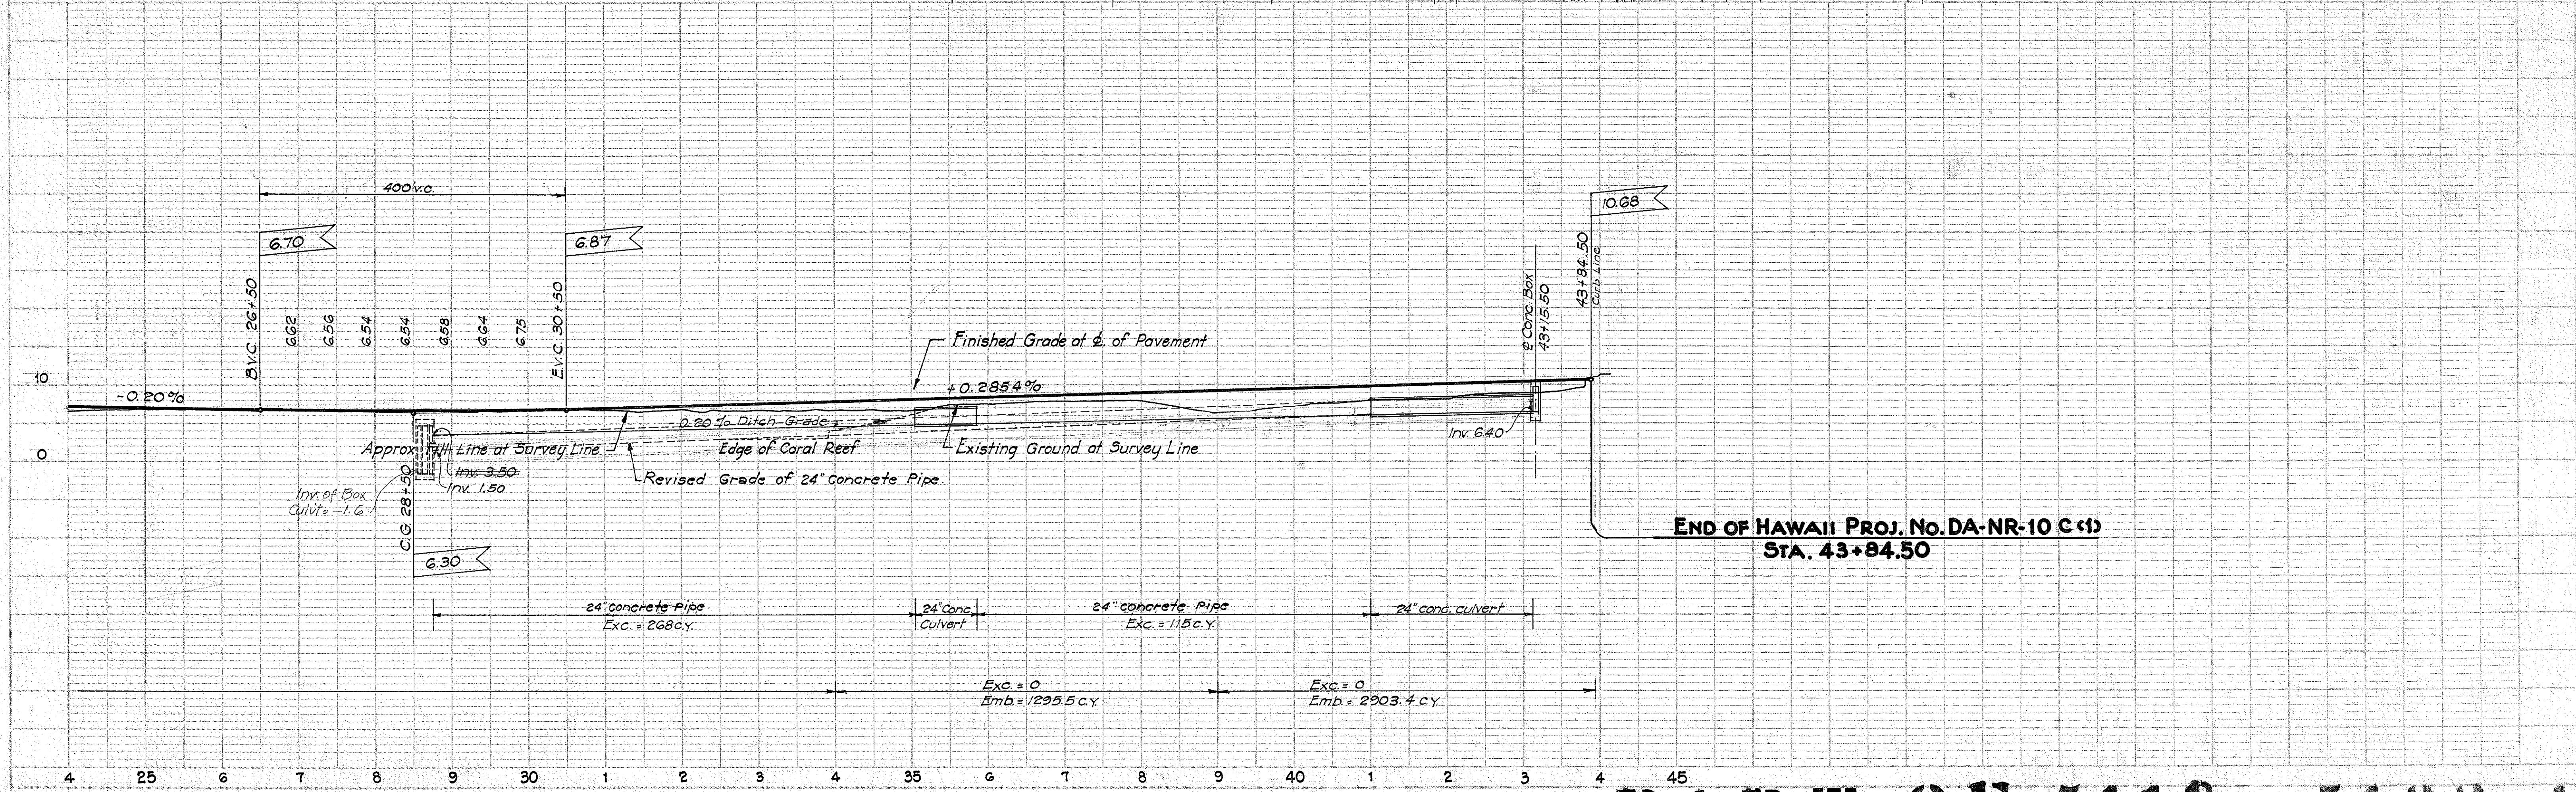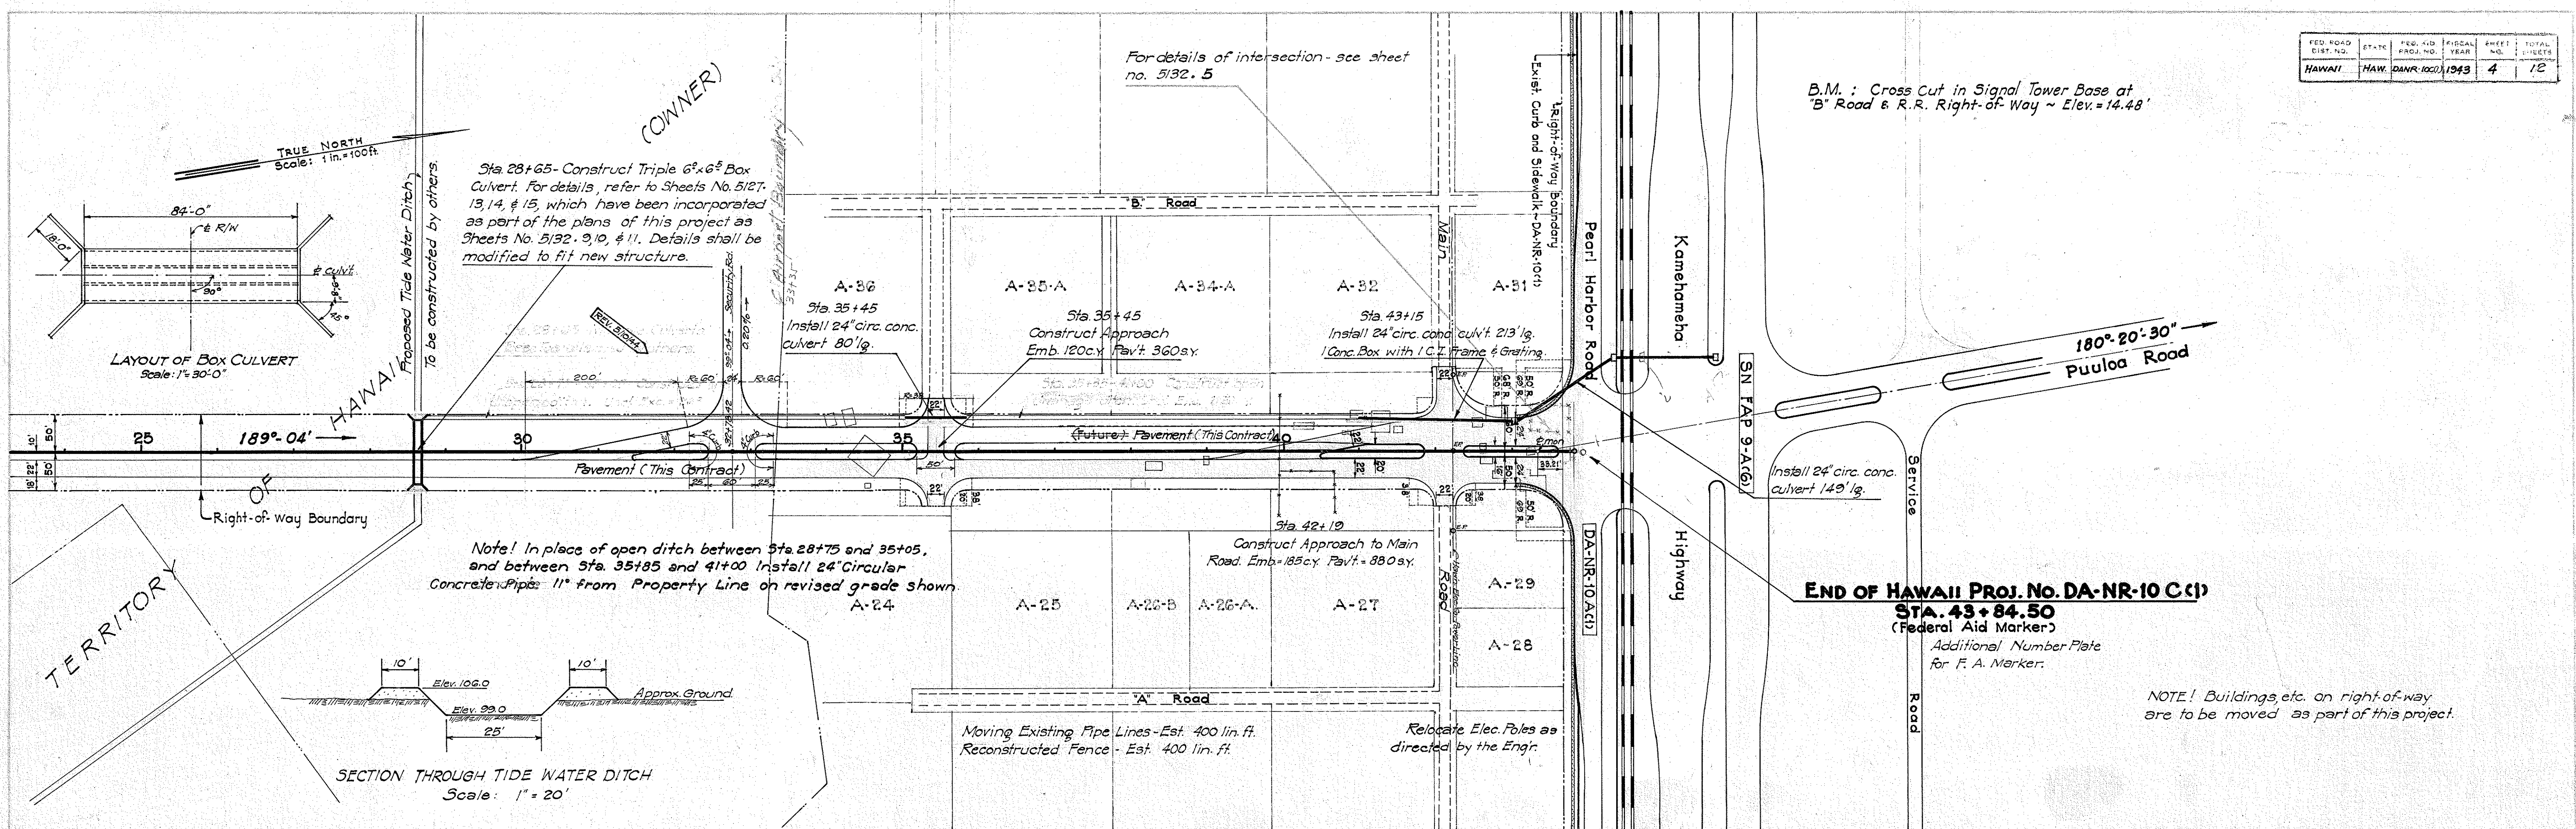

PART OF 5118. 5182.4