




FED. ROAD DIST. NO.	STATE	PROJ. NO.	FISCAL YEAR	SHEET NO.	TOTAL SHEETS
HAWAII	HAW.	HWY-0-12-00	2004	29	82

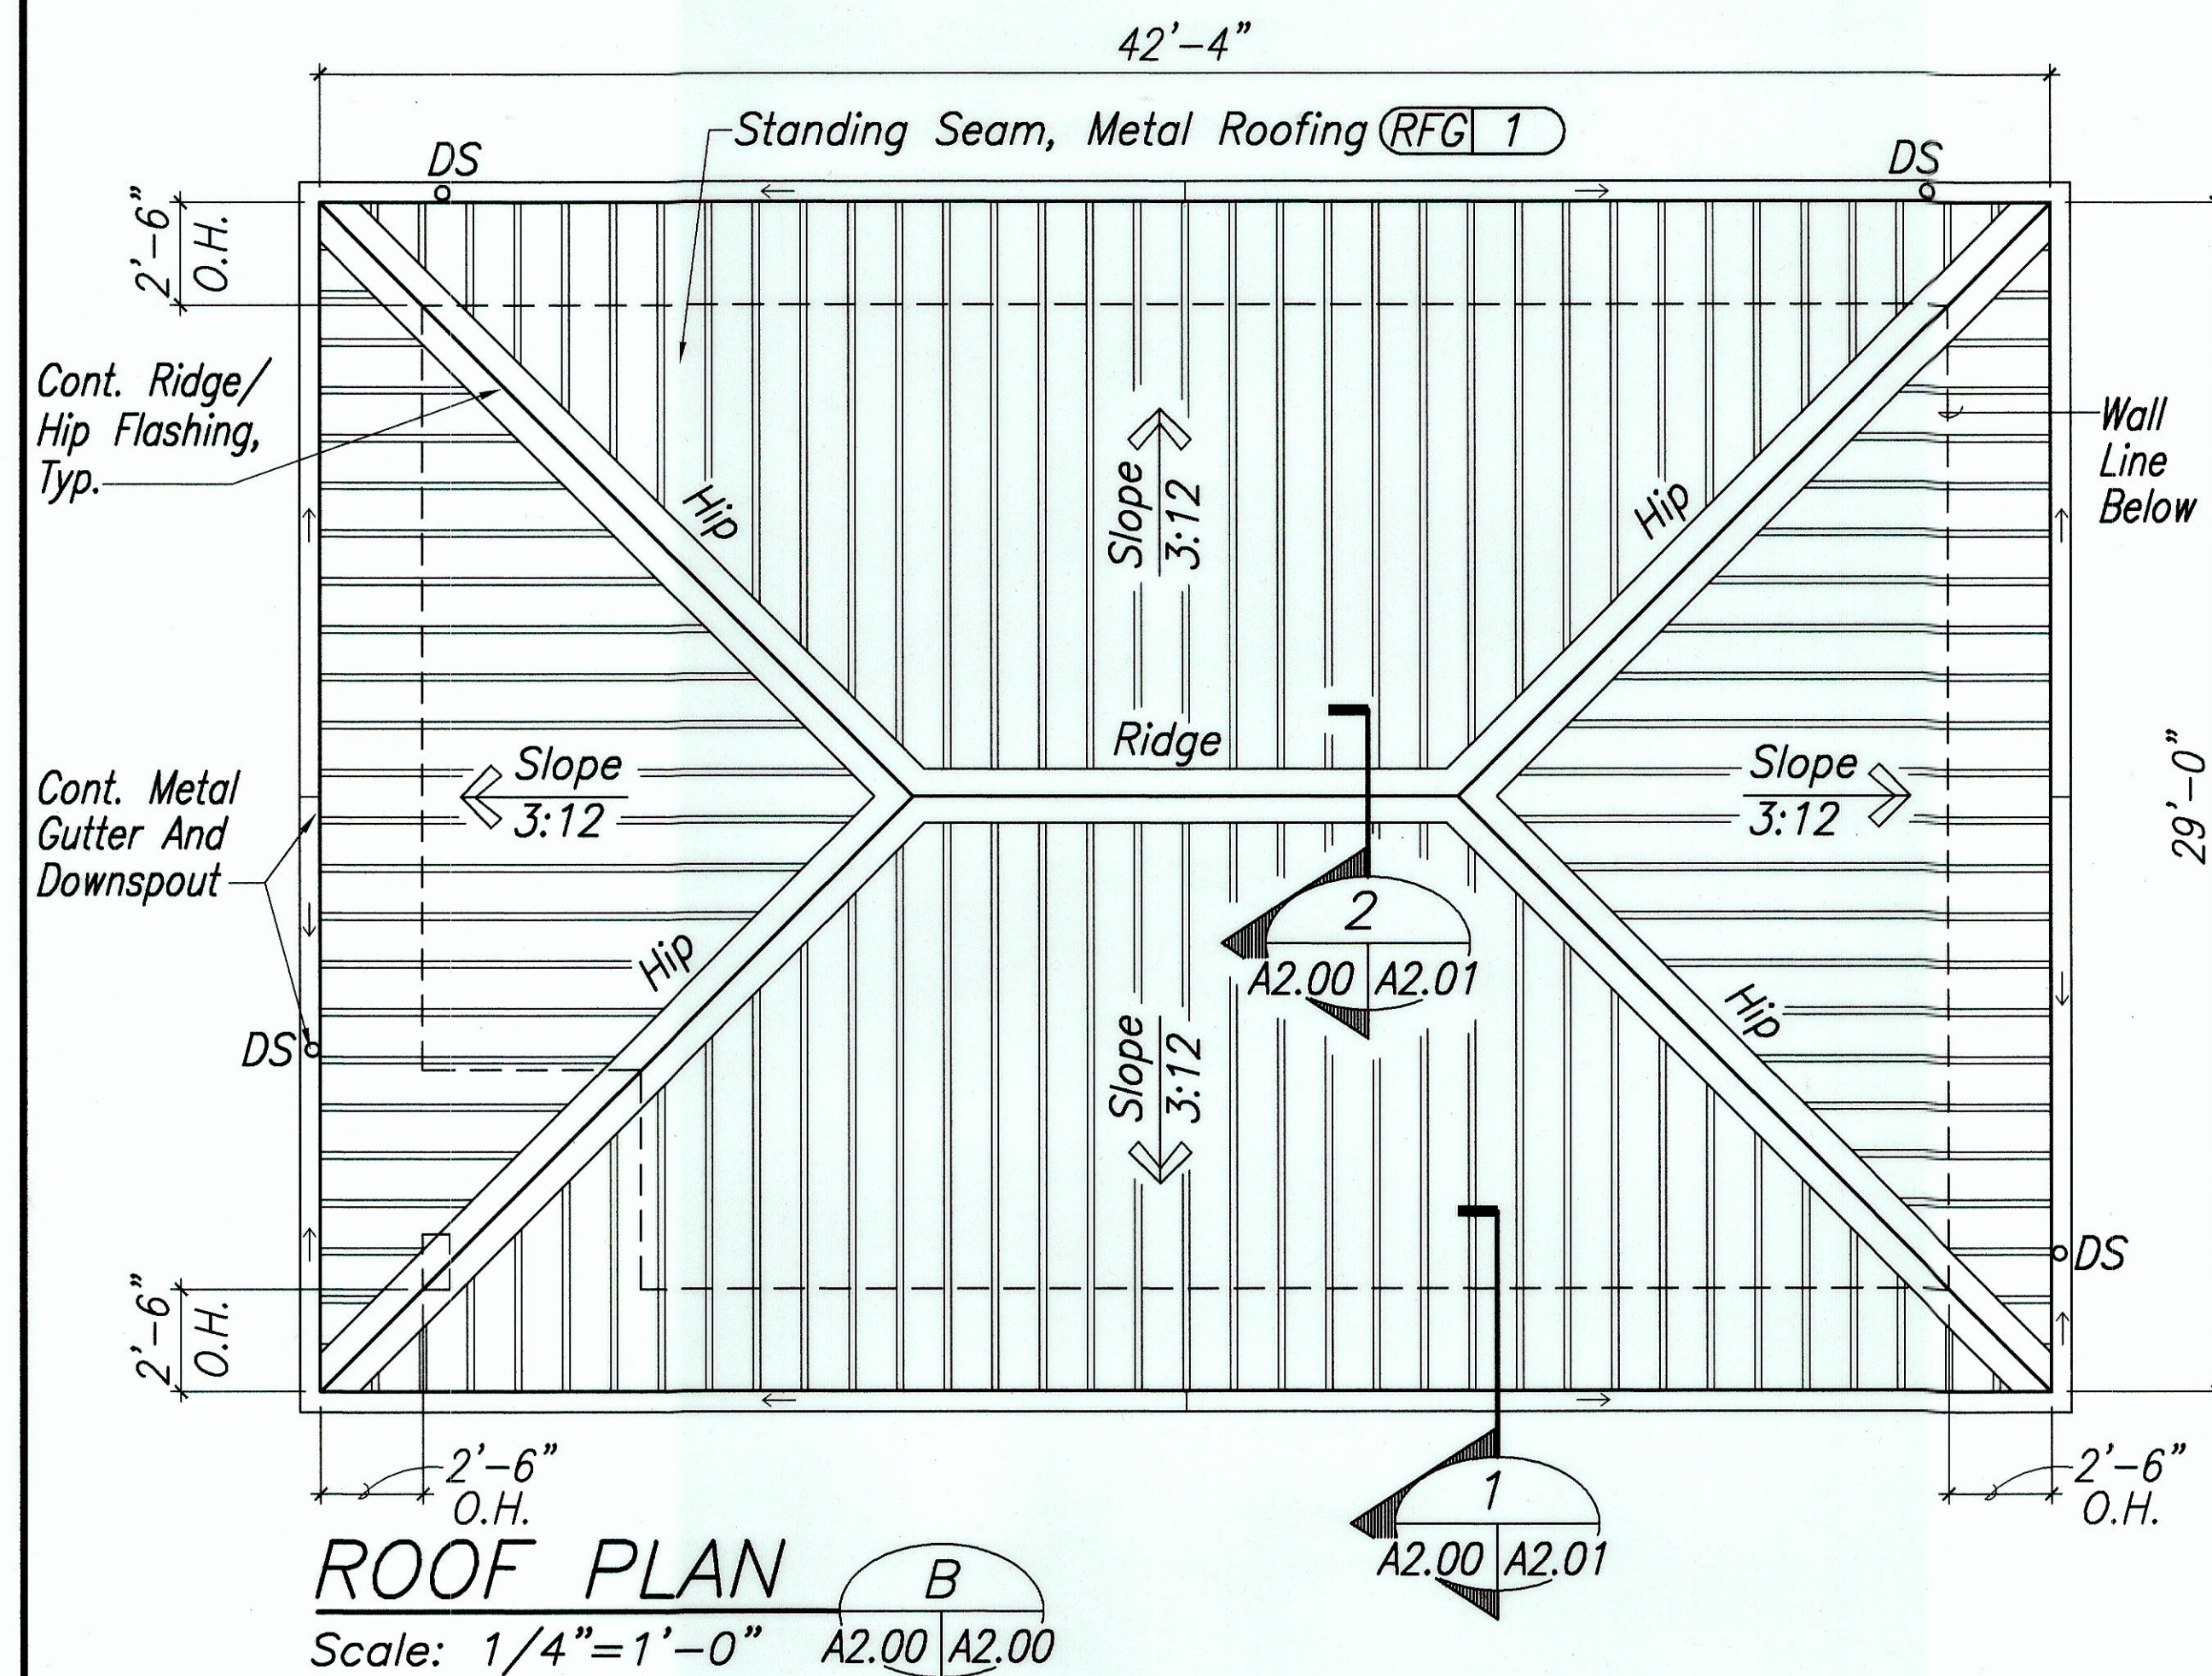

ROOF PLAN B
Scale: 1/4"=1'-0" A2.00 A2.01

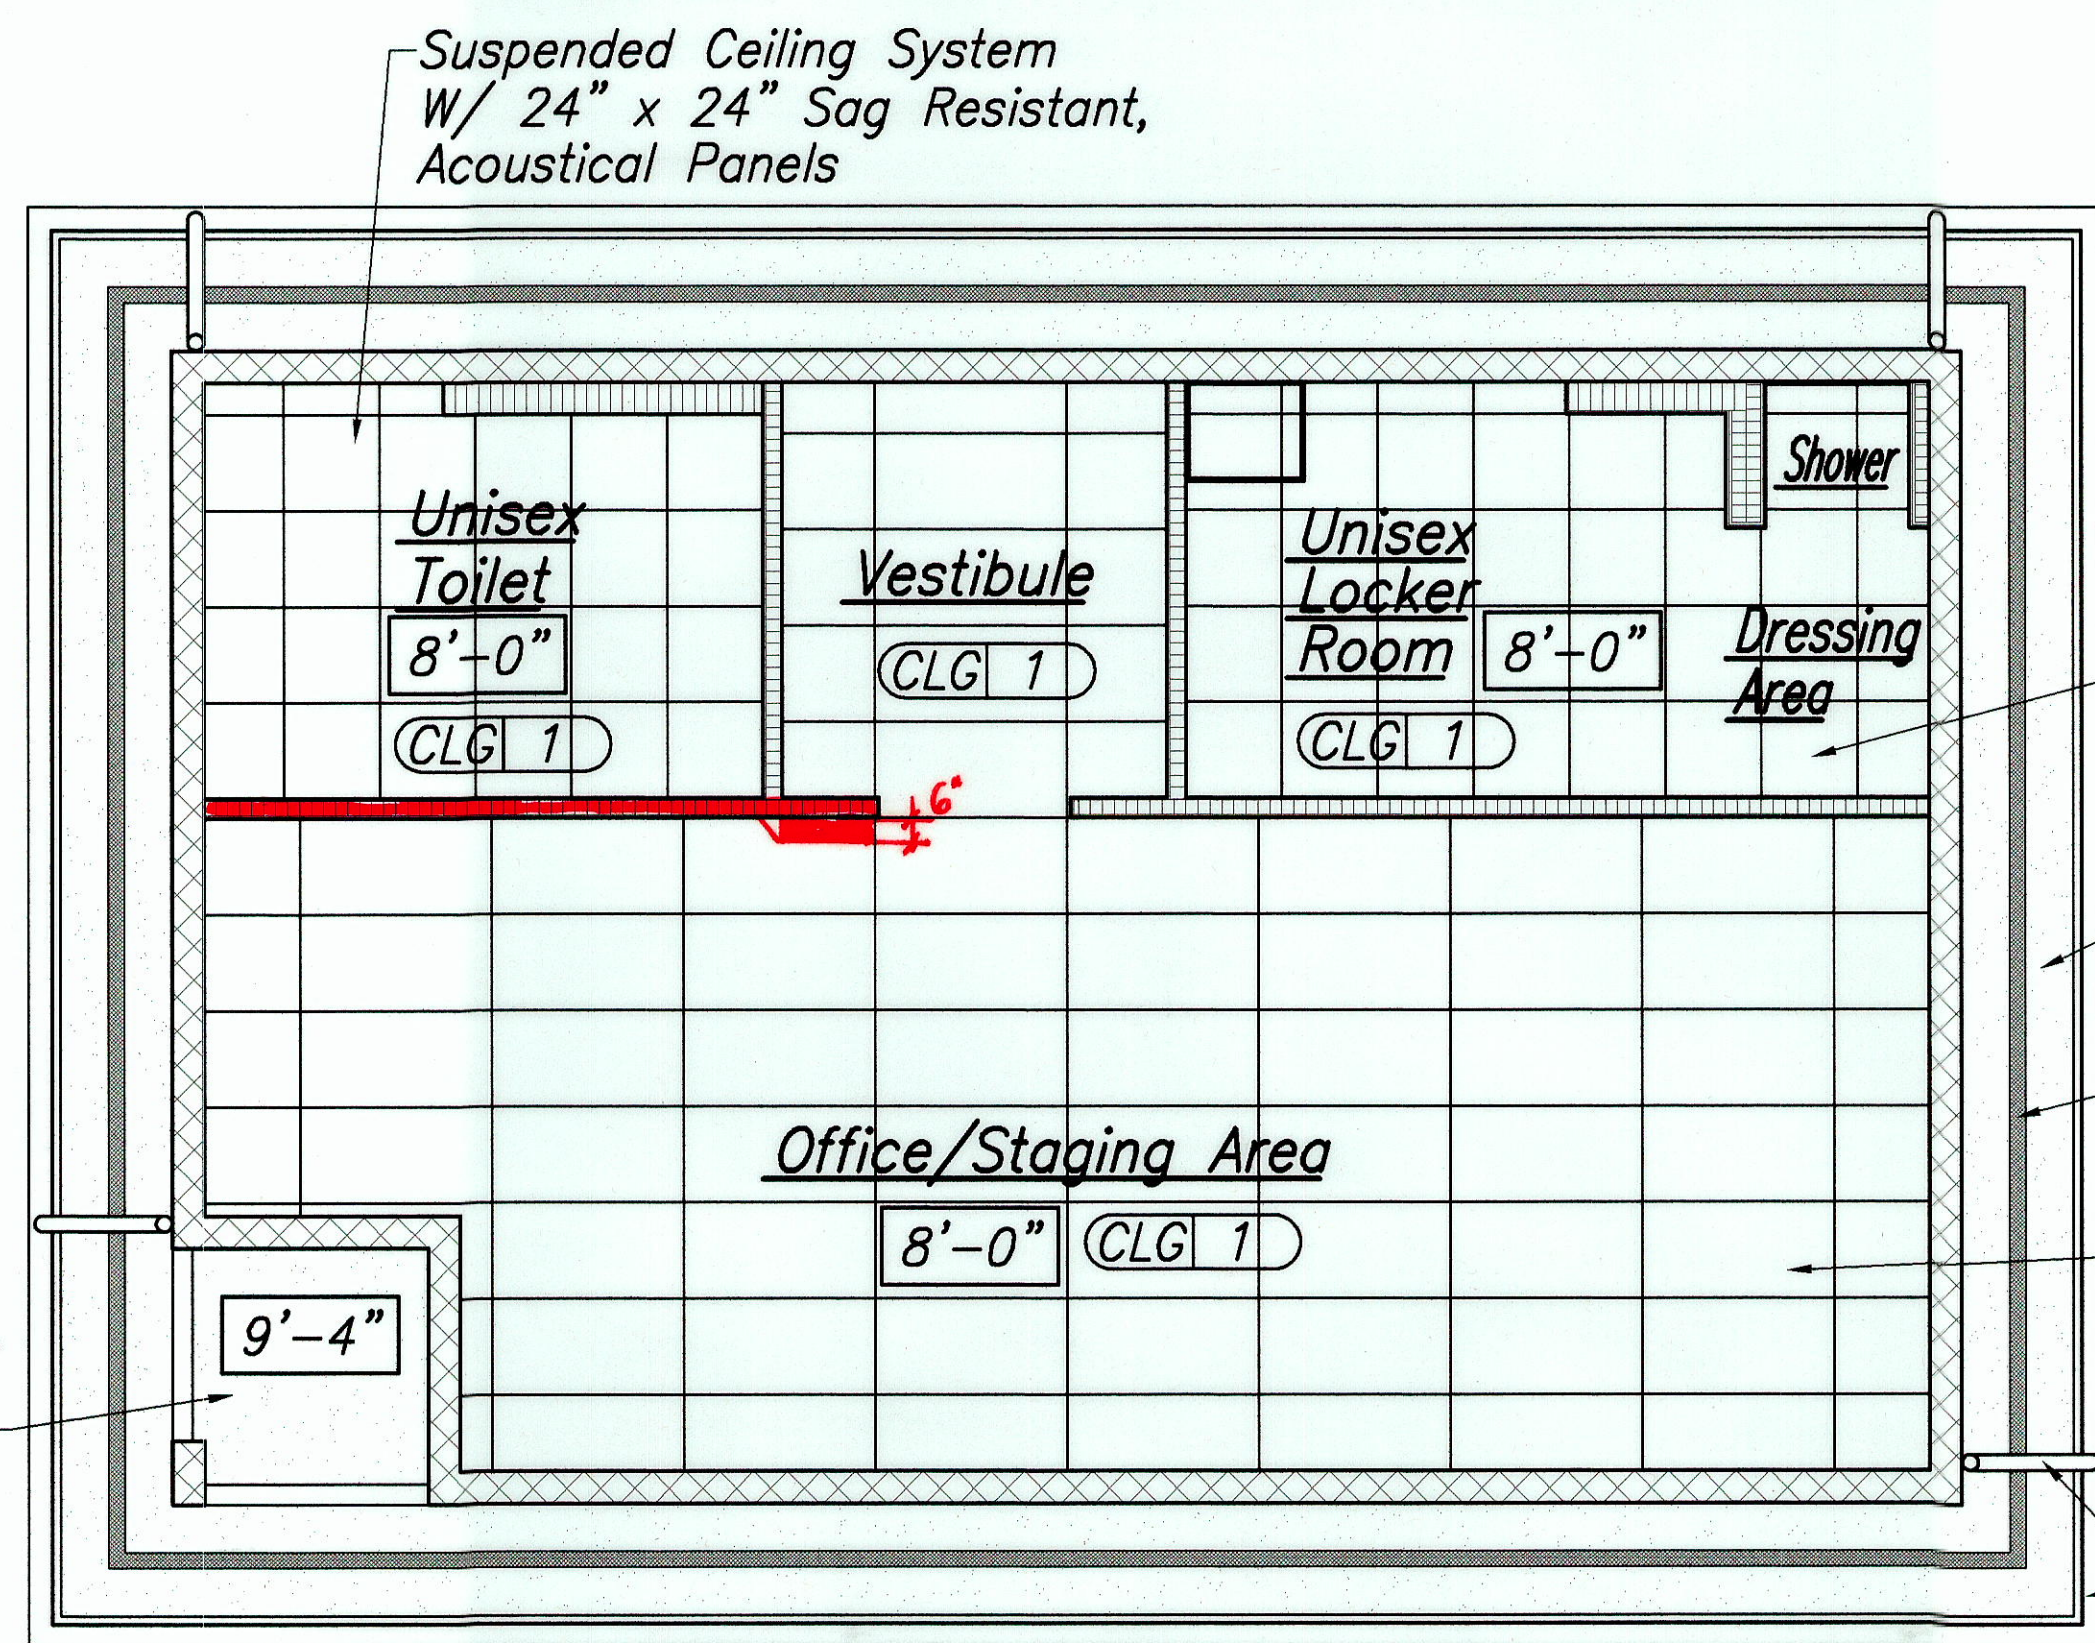

REFLECTED CEILING PLAN C
Scale: 1/4"=1'-0" A2.00 A2.00

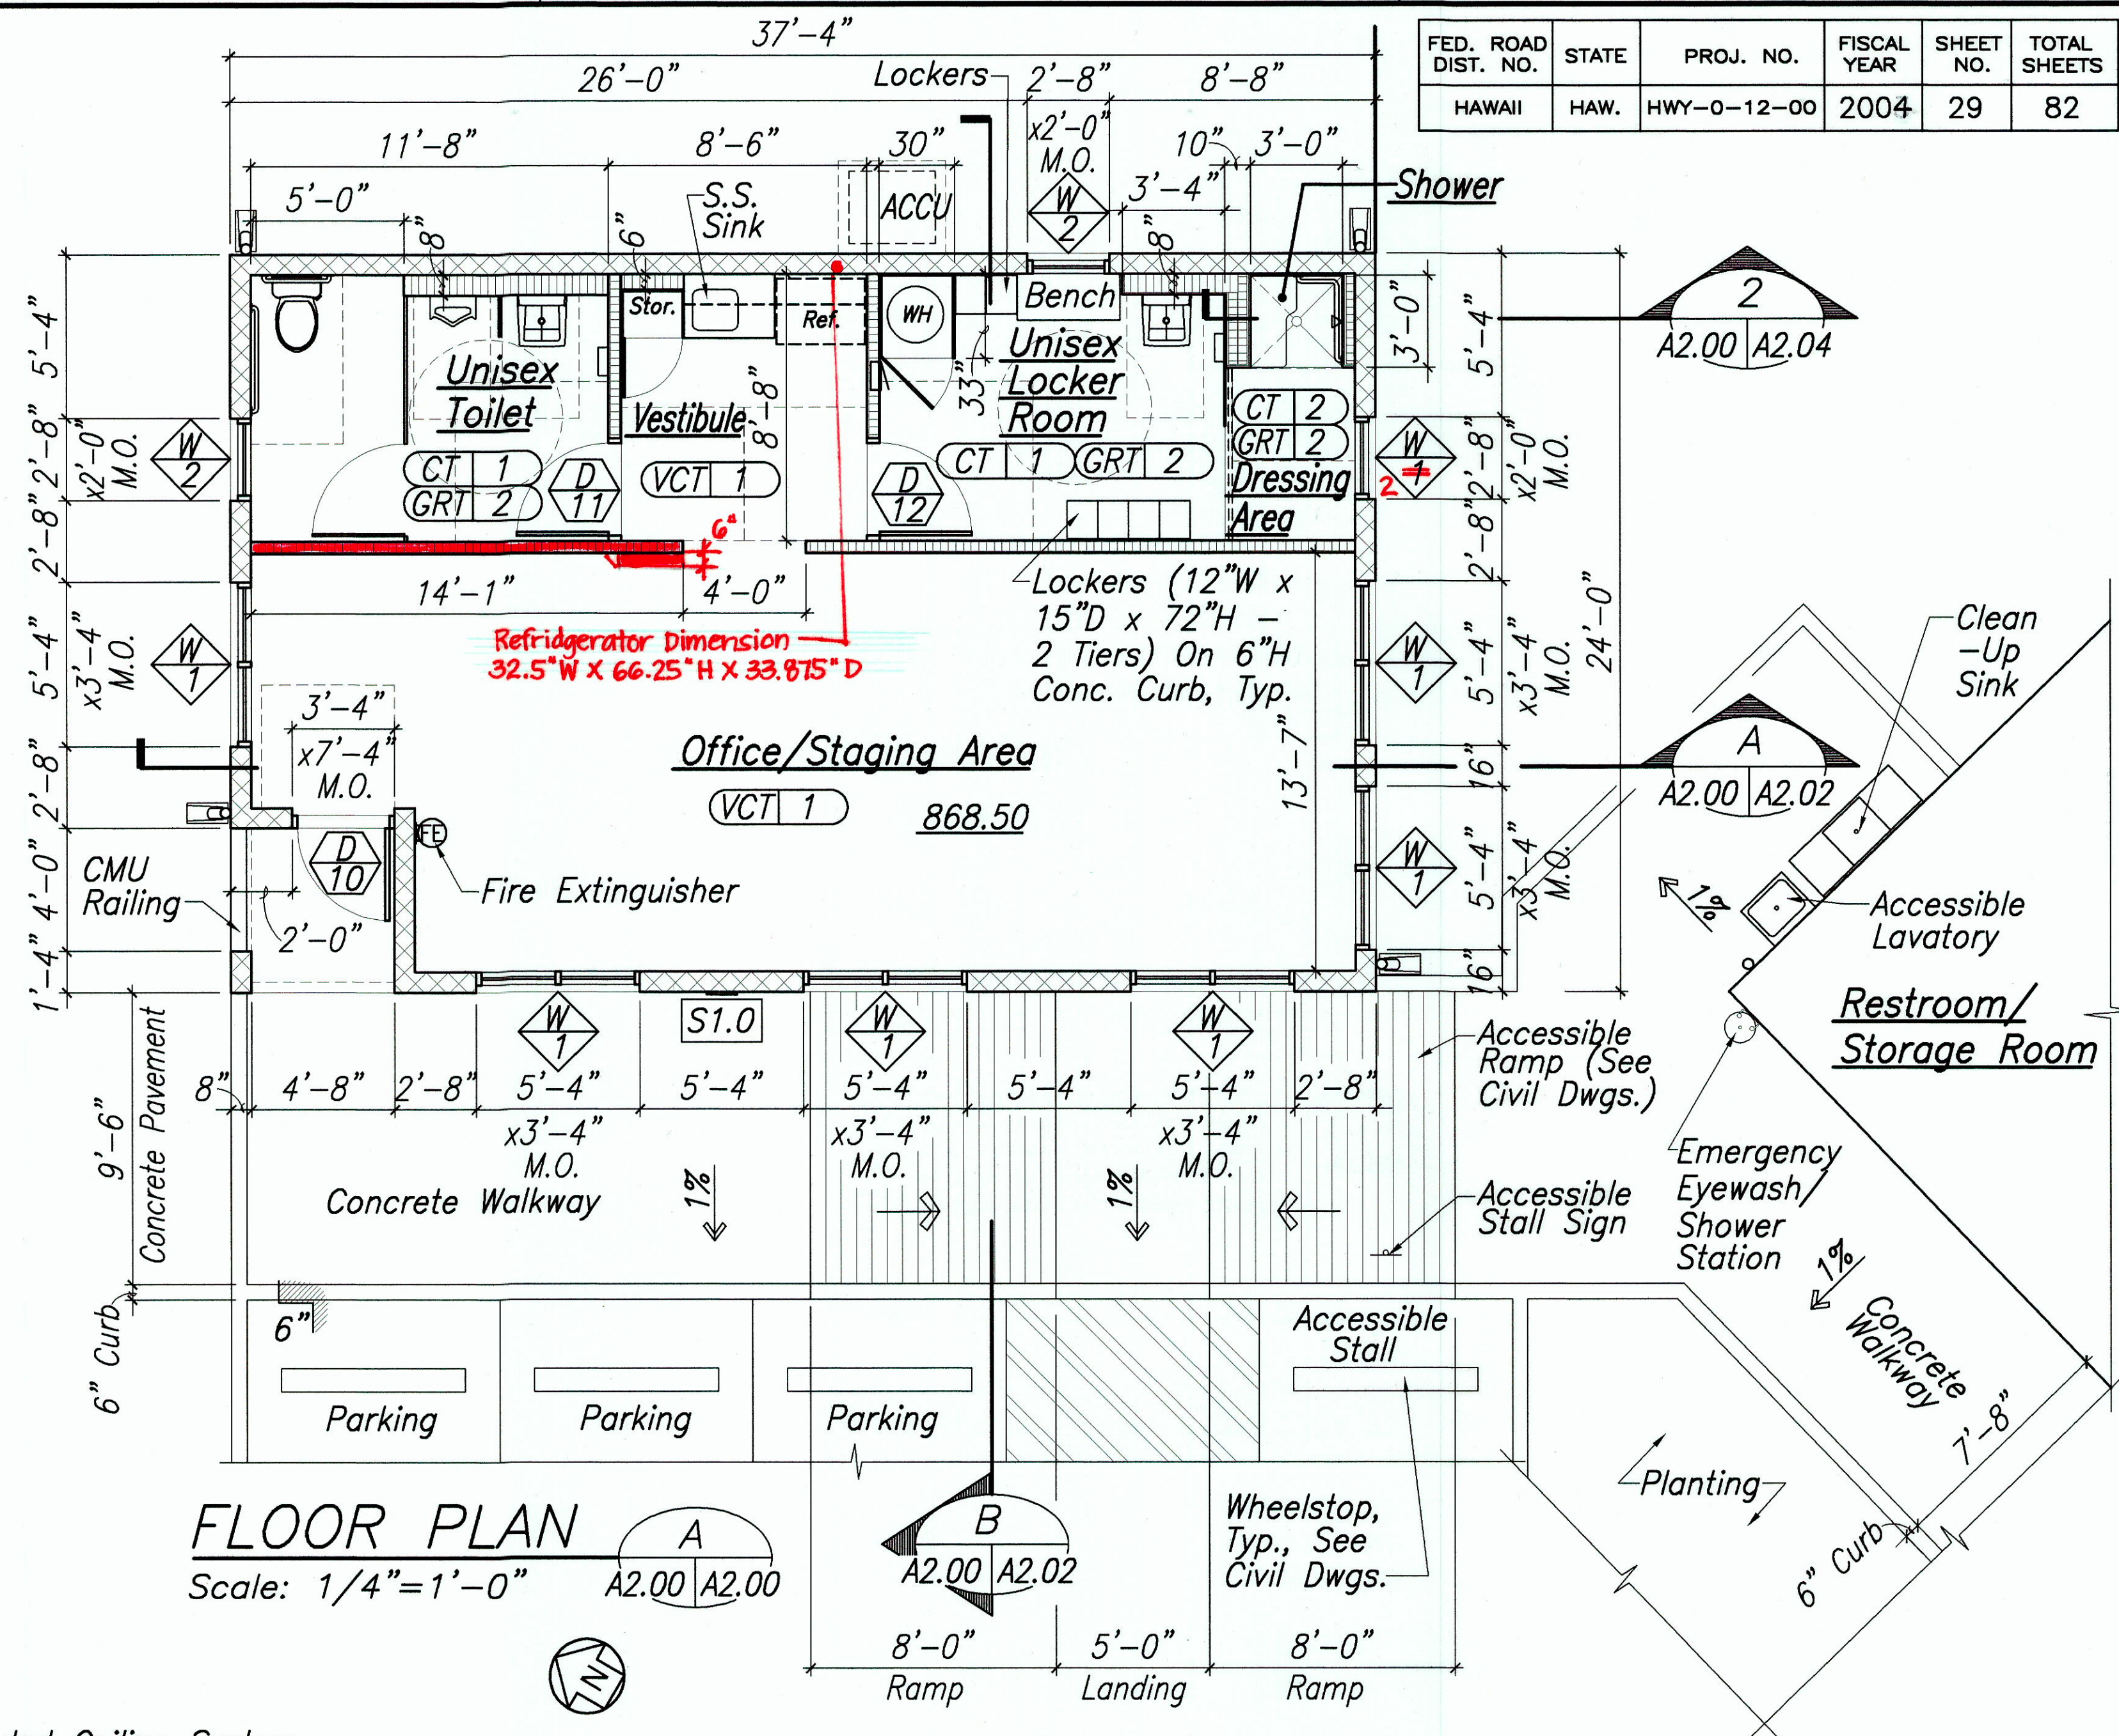



FLOOR PLAN A
Scale: 1/4"=1'-0" A2.00 A2.00

Wall Legend

- CMU Wall As Indicated
- Gyp. Bd. on Metal Stud Wall As Indicated
- Gyp. Bd. on Metal Stud Furred Plumbing Wall As Indicated

Legend

- 234.56 Finish Floor Elevation
- CT 1 Material Finish Or Color, See COLOR AND MATERIAL SCHEDULE, Sheet A5.05

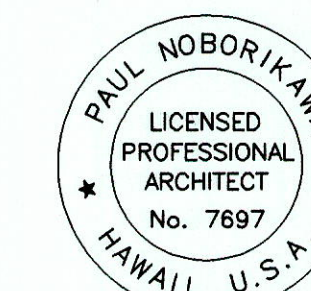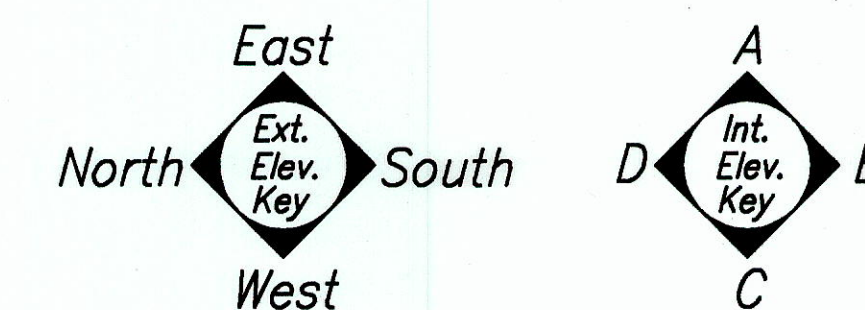

THIS WORK WAS PREPARED BY ME OR UNDER MY SUPERVISION

STATE OF HAWAII
DEPARTMENT OF TRANSPORTATION
HIGHWAYS DIVISION





**OFFICE BUILDING,
MISC. PLANS**

**WAIHAWA BASEYARD
IMPROVEMENTS**

Project No. HWY-0-12-00
Scale: AS SHOWN Date: JAN. 2003
SHEET No. A2.00 OF 82 SHEETS




"AS-BUILT"

FED. ROAD DIST. NO.	STATE	PROJ. NO.	FISCAL YEAR	SHEET NO.	TOTAL SHEETS
HAWAII	HAW.	HWY-0-12-00	2003	30	82

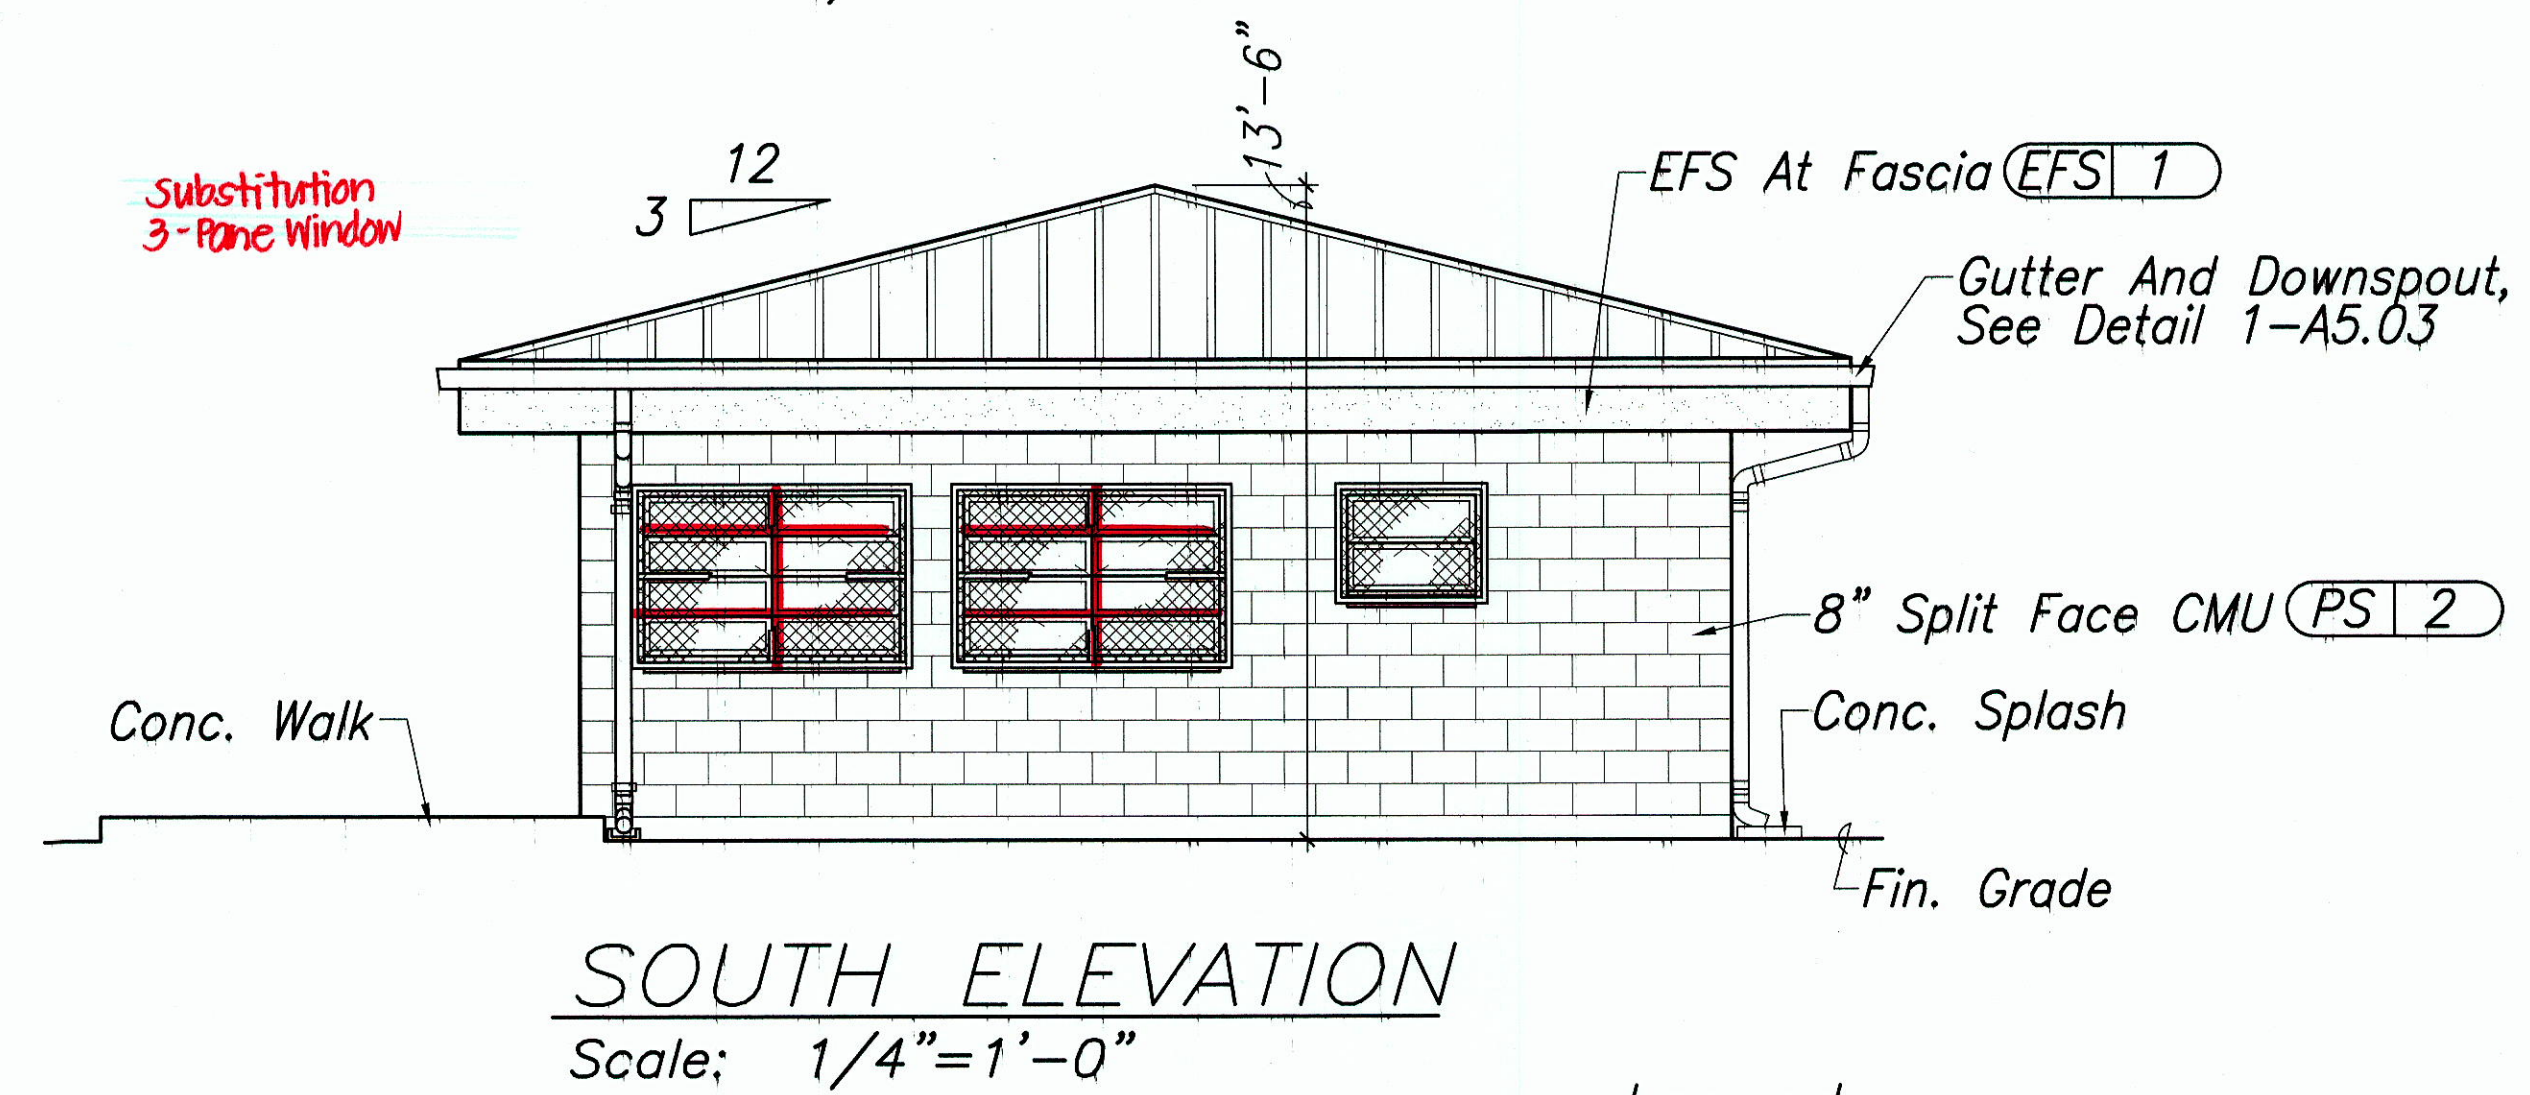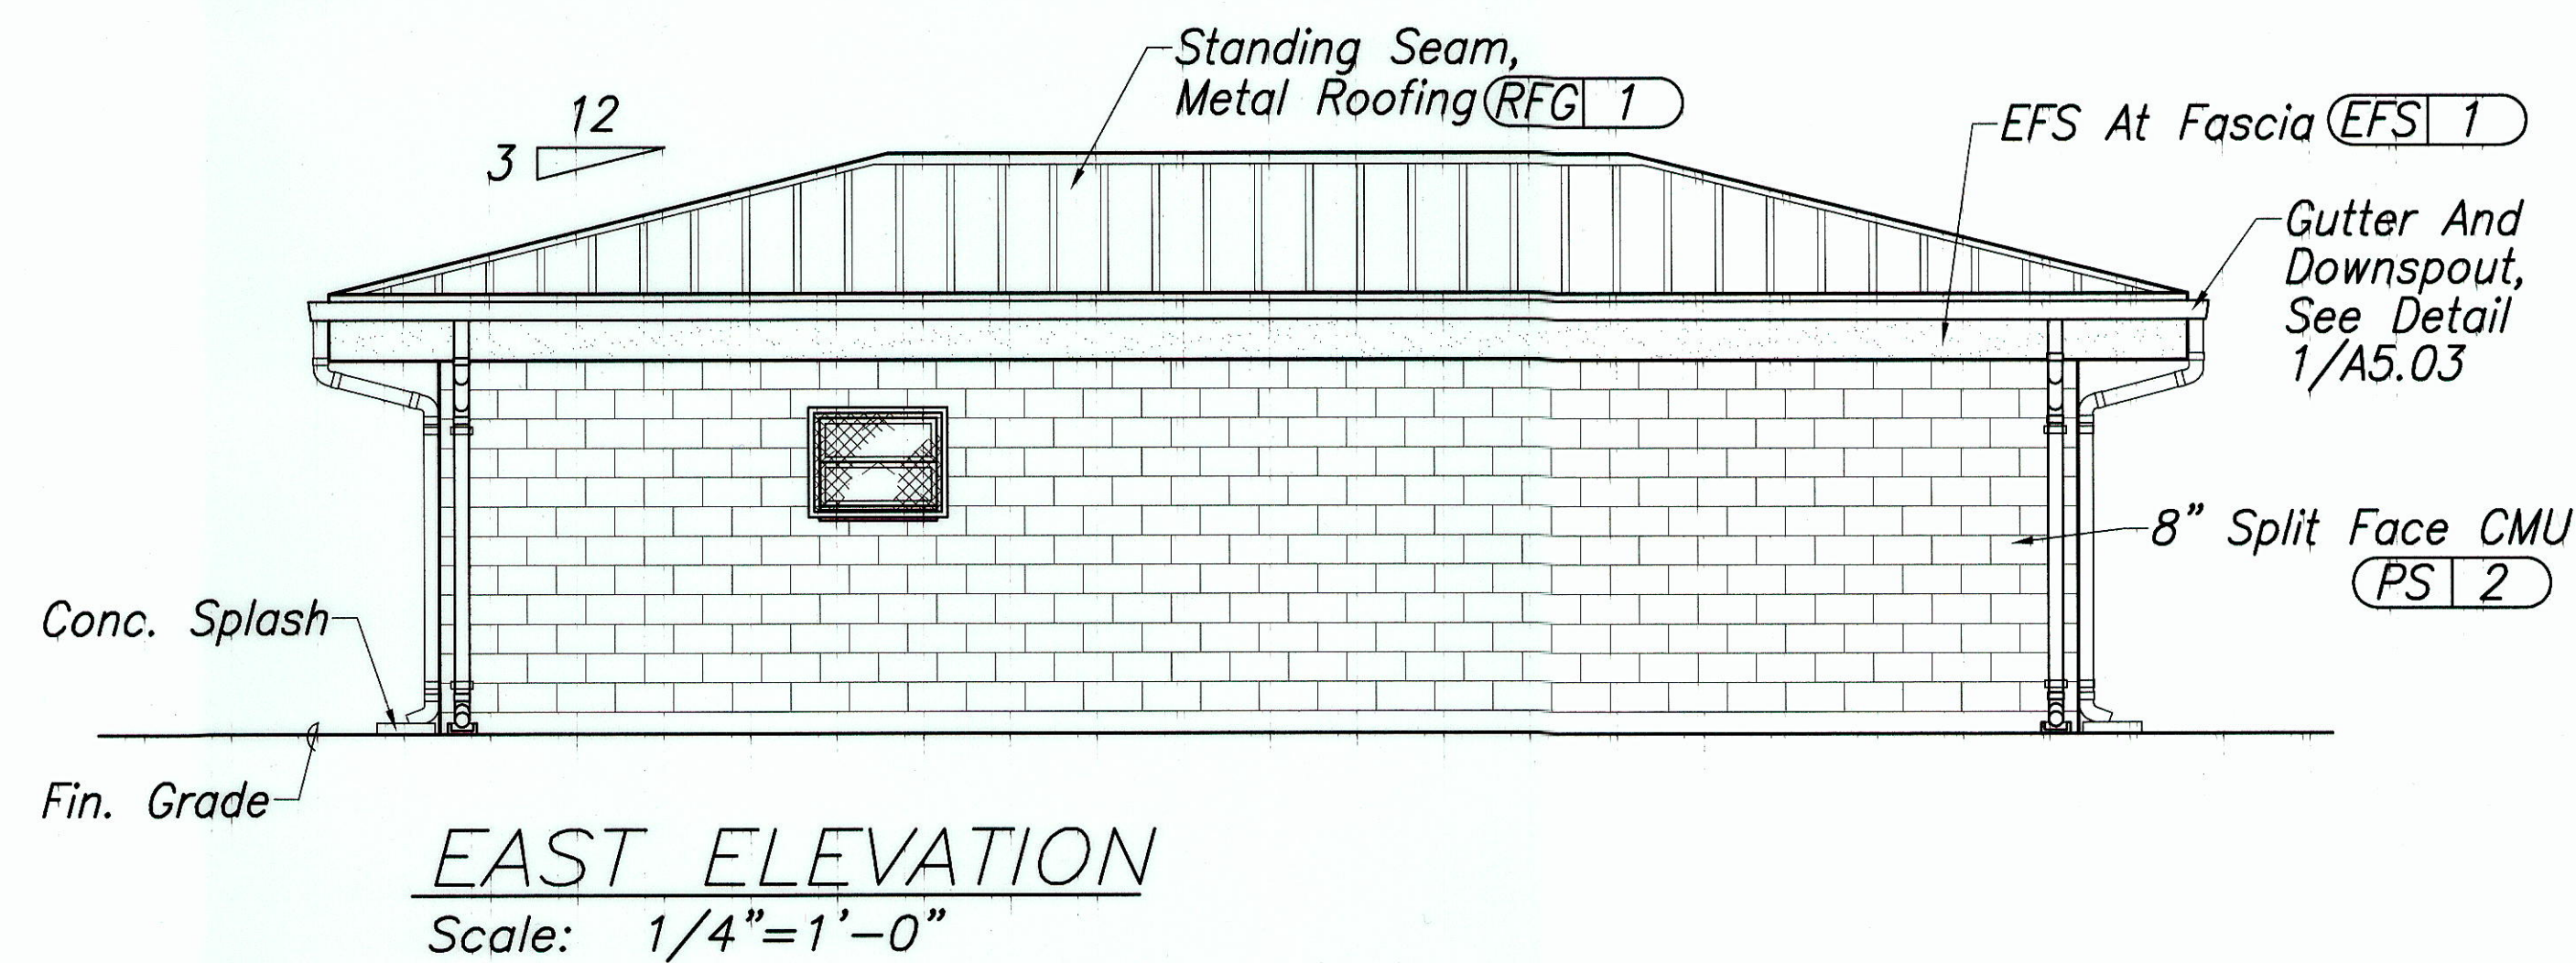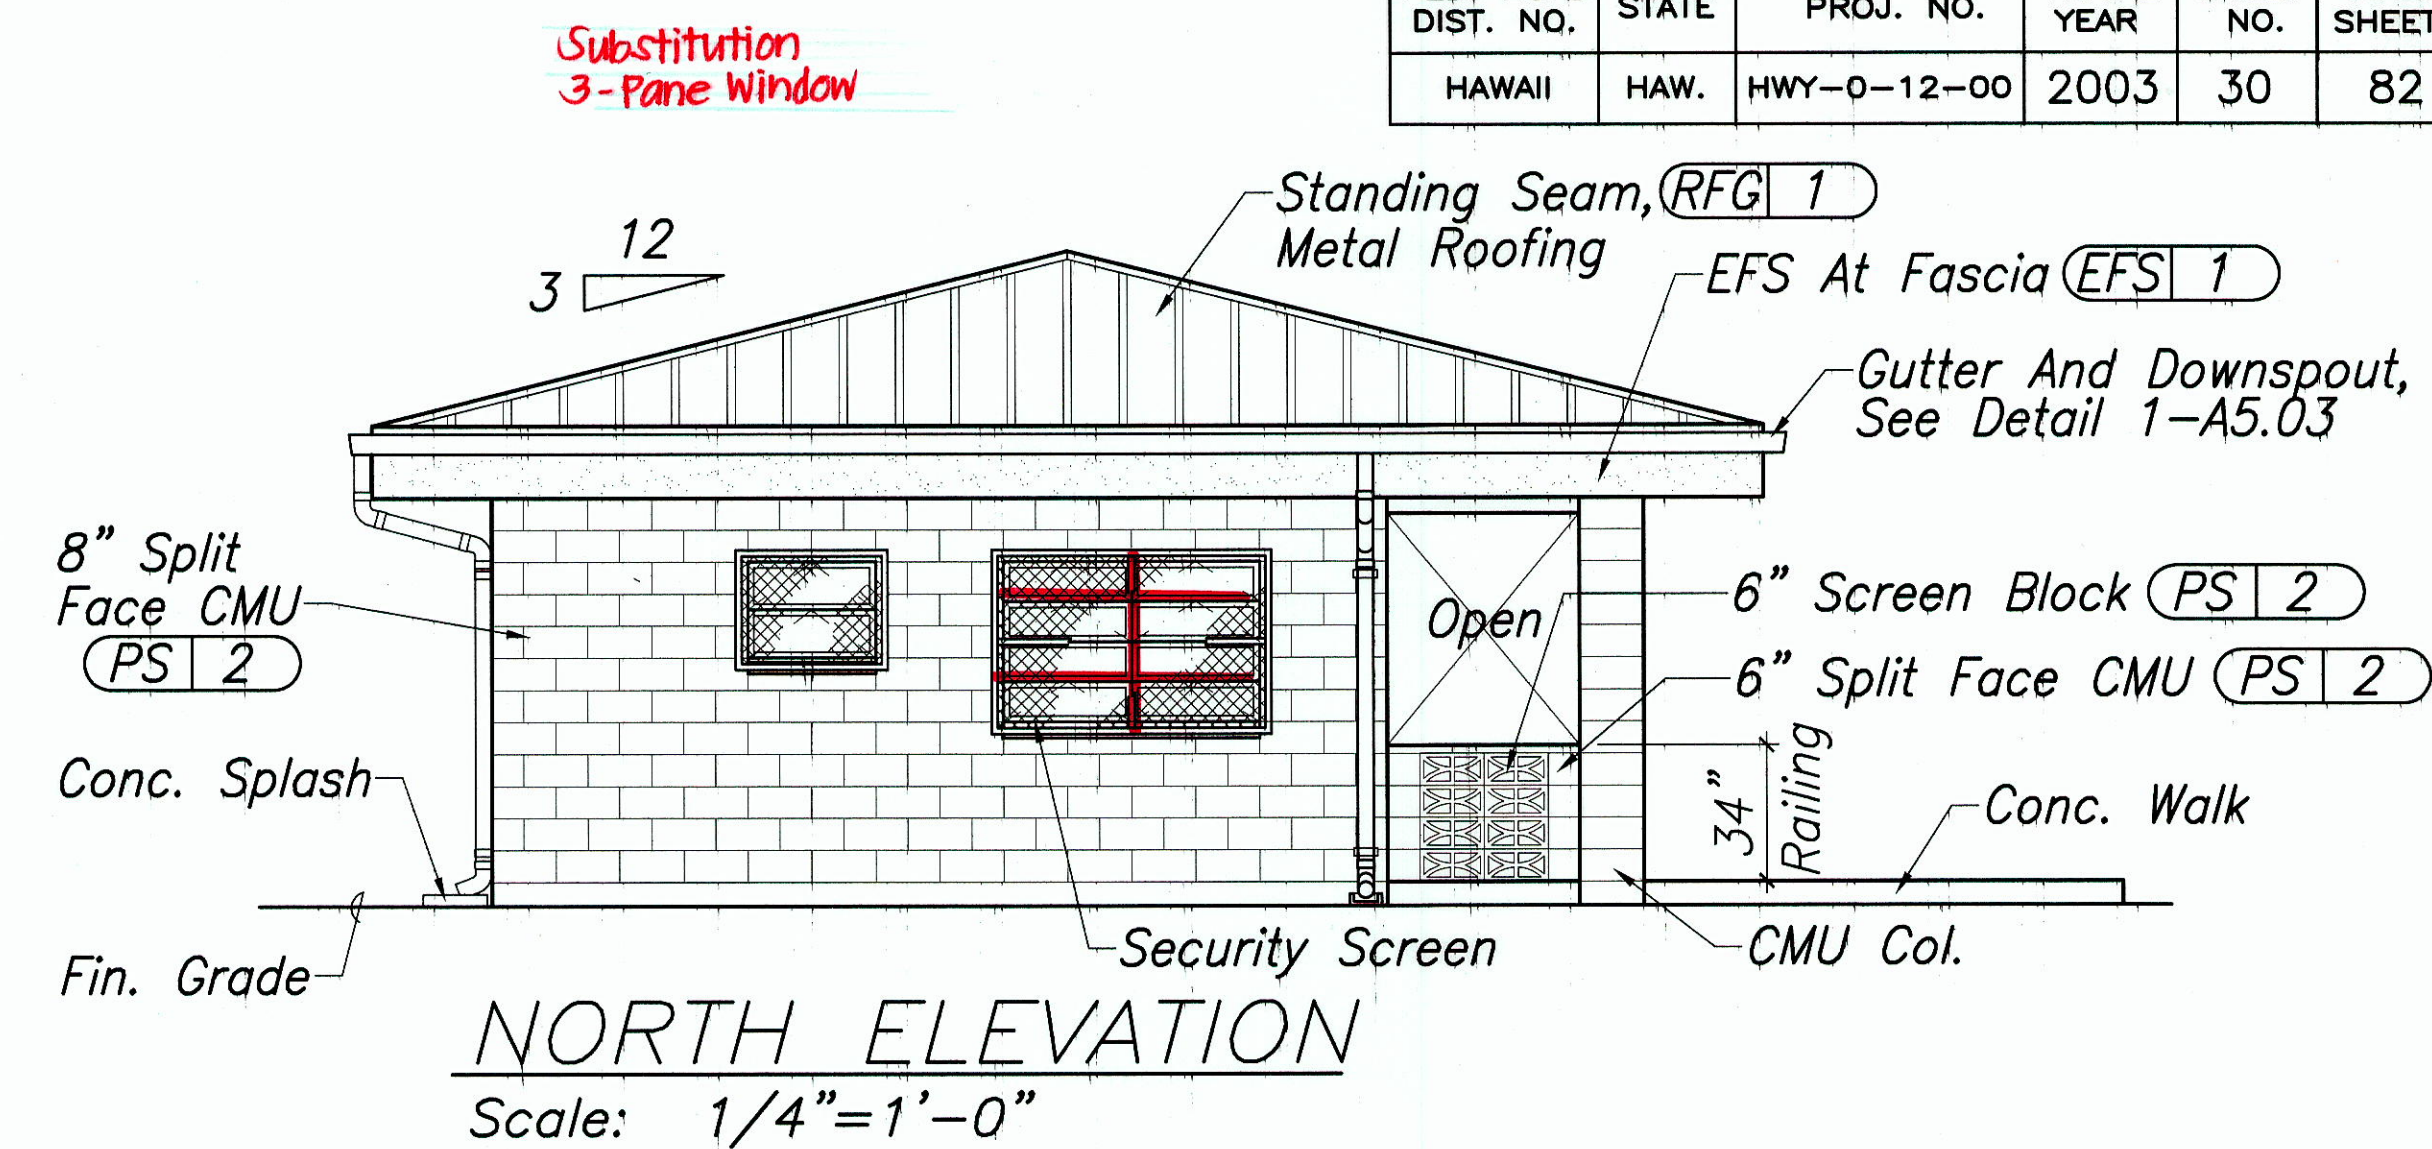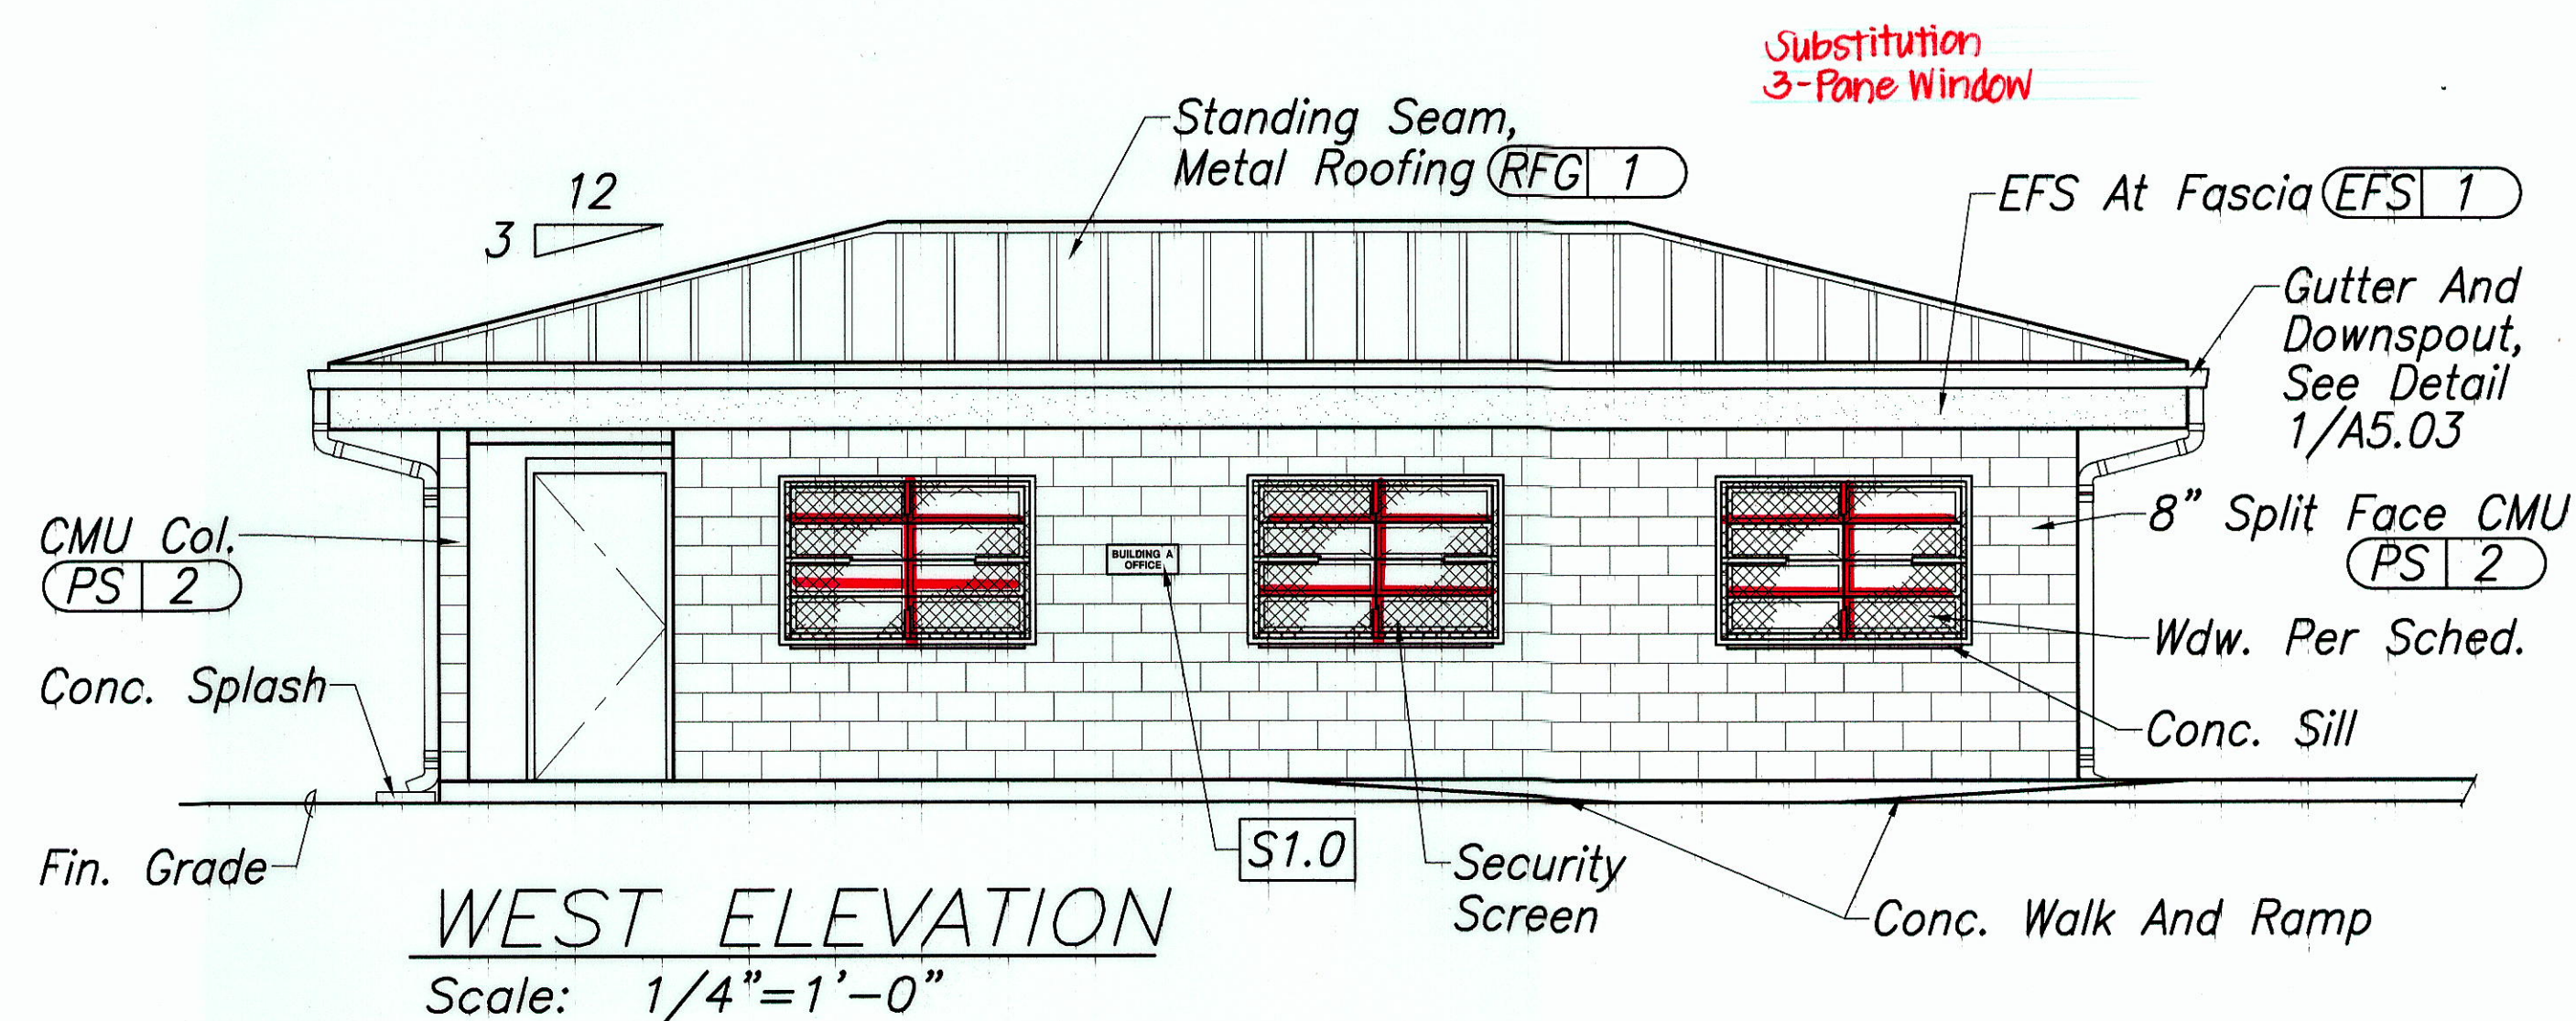

Legend

(CT 1) Material Finish Or Color, See COLOR AND MATERIAL SCHEDULE, Sheet A5.05

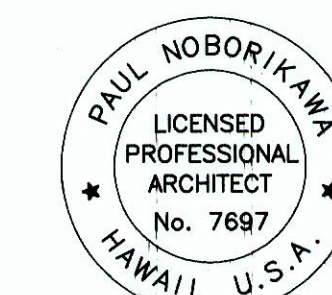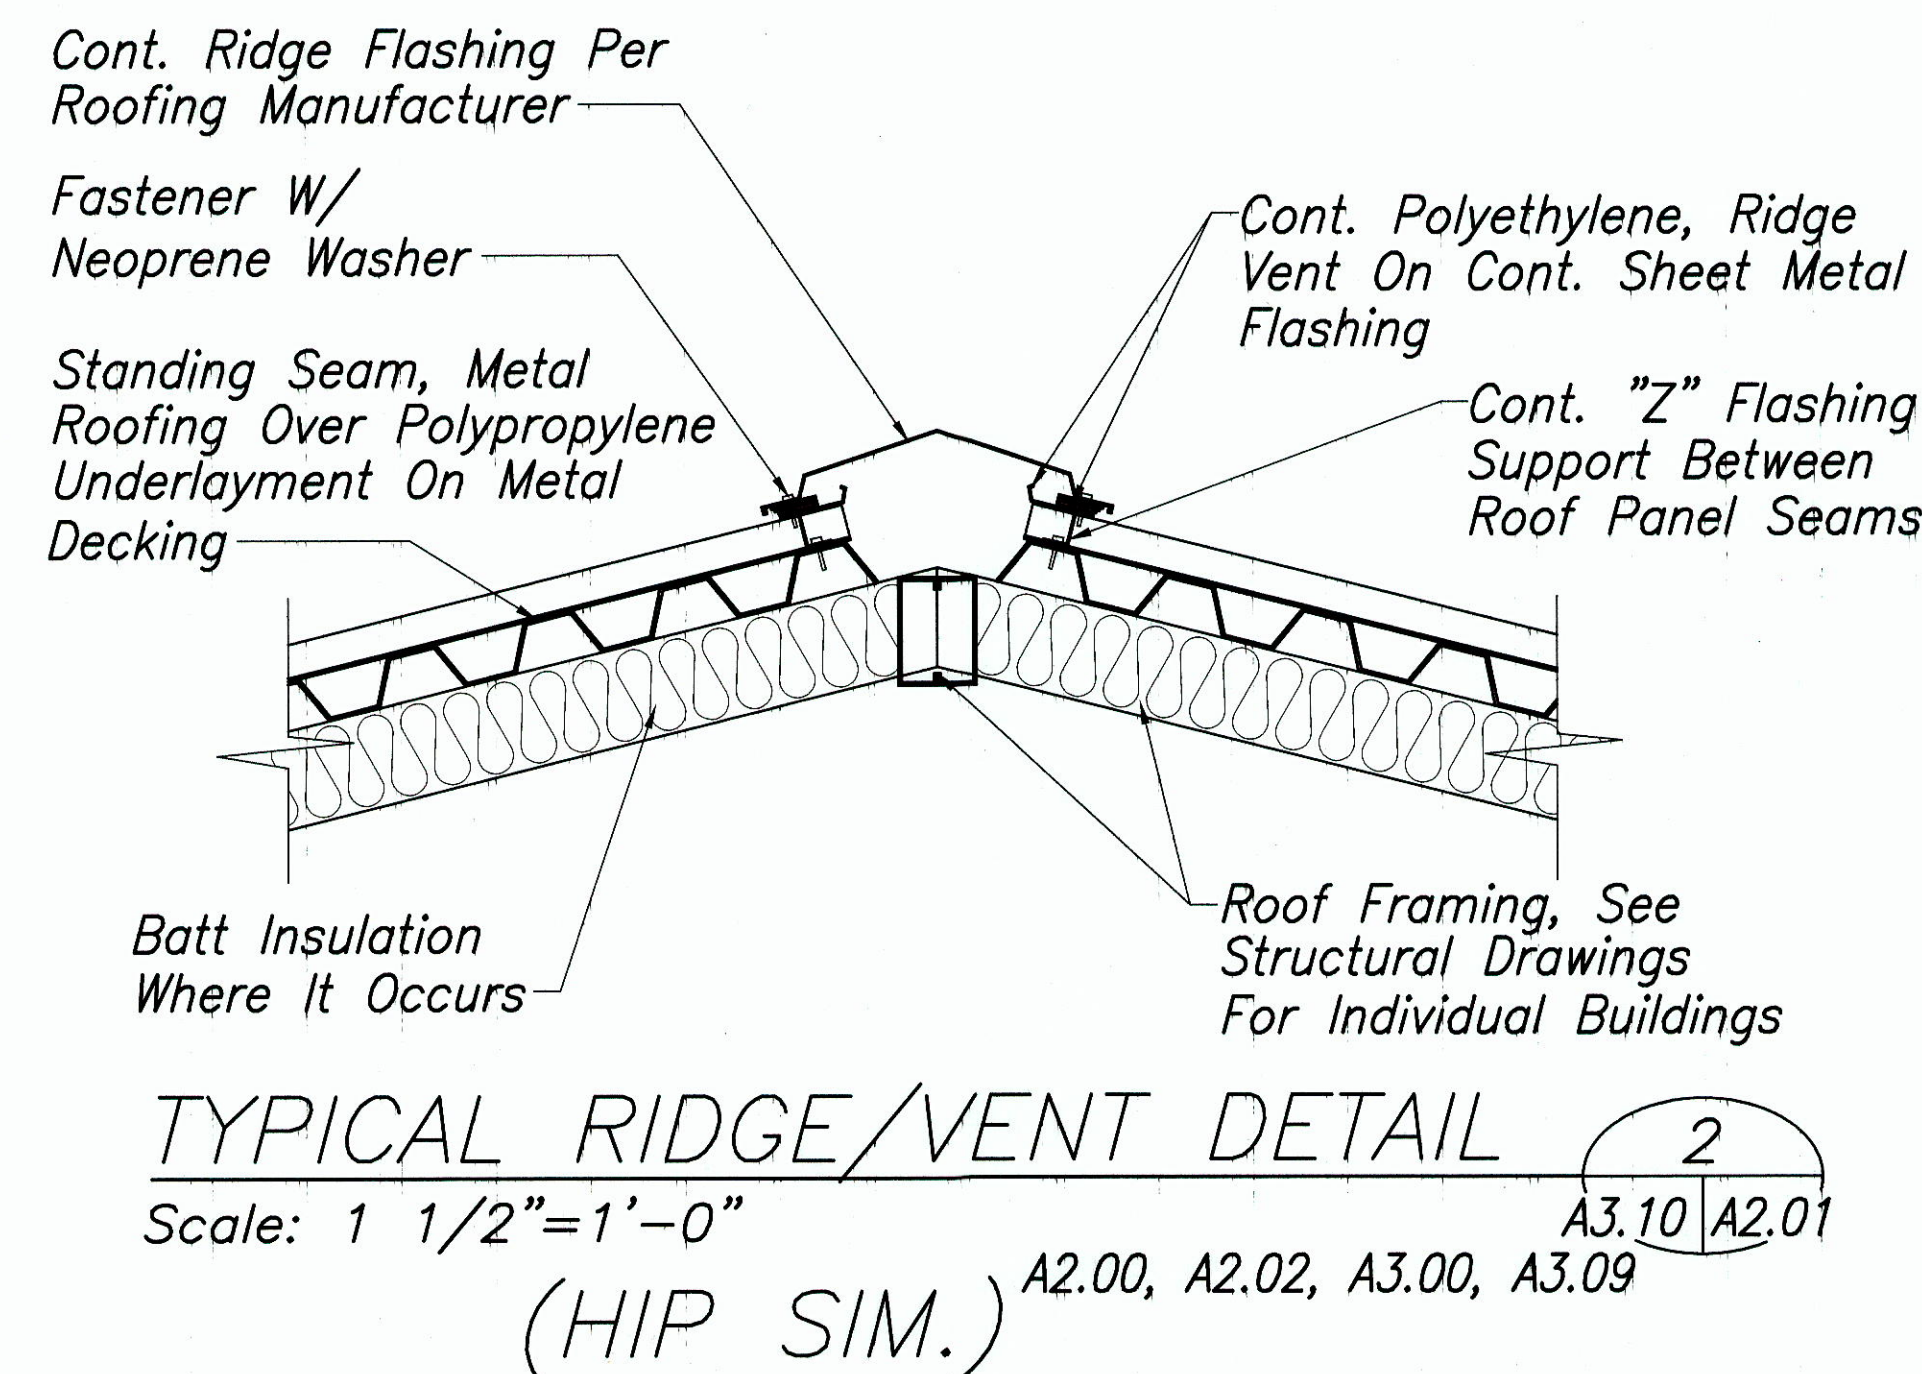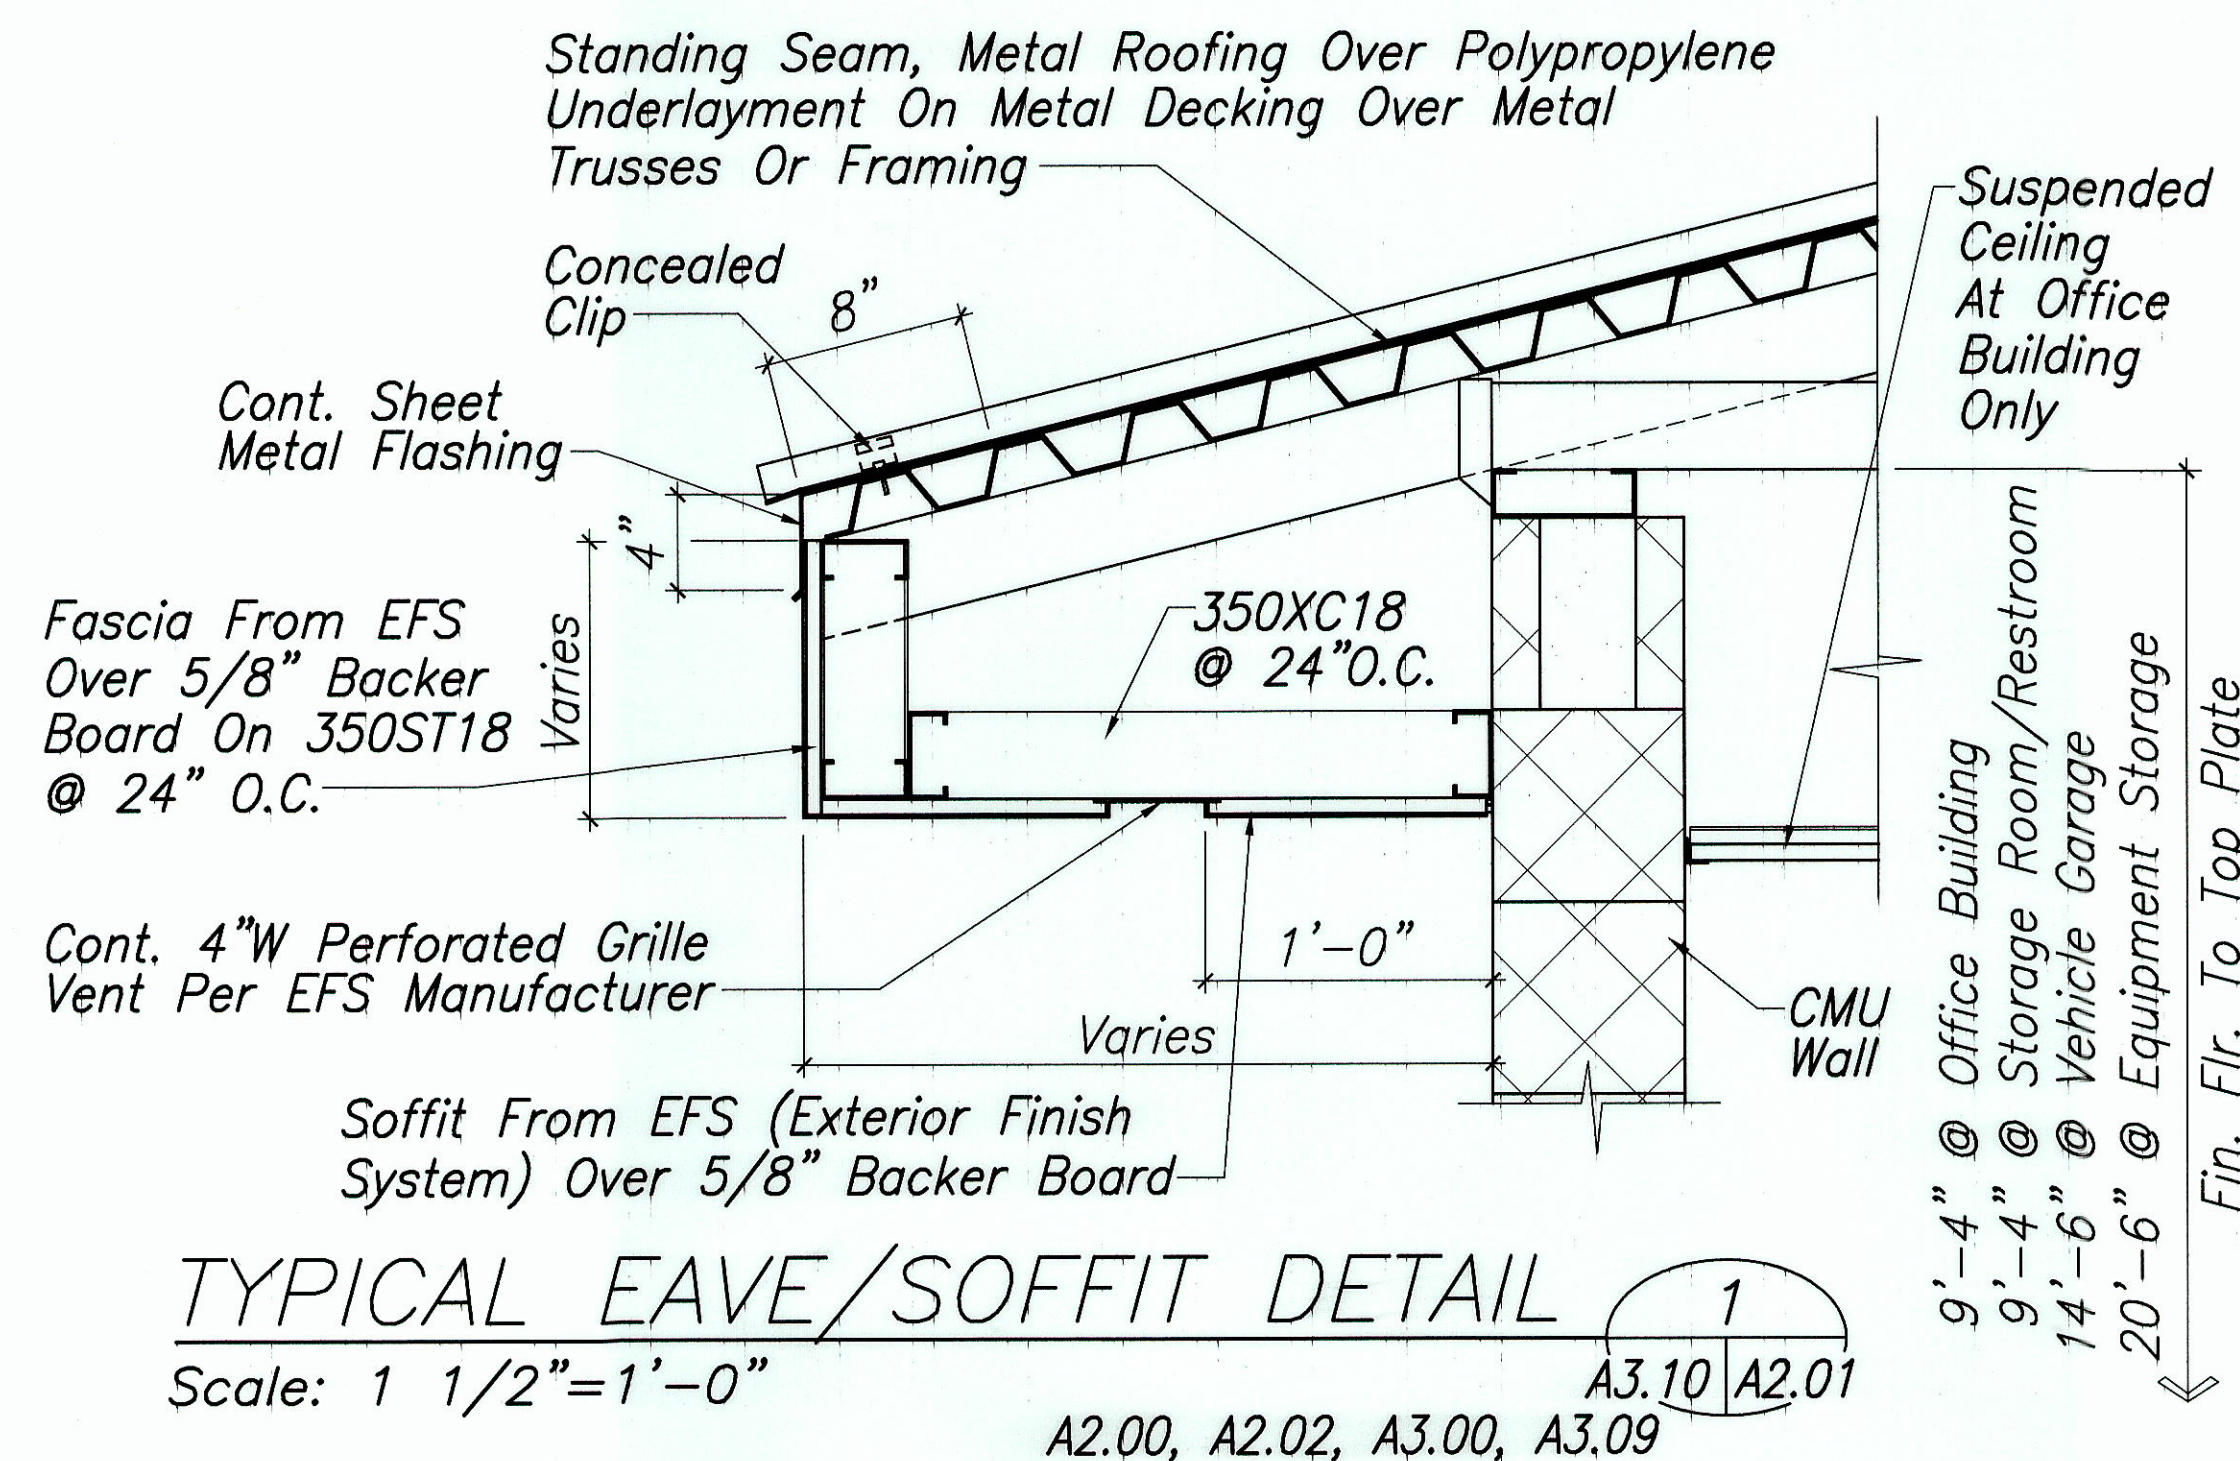


THIS WORK WAS PREPARED BY ME OR UNDER MY SUPERVISION

12/15/08	This sheet replaces the original sheet 2 DPP/DLU Comments dated 7/9/07
DATE	REVISION
STATE OF HAWAII DEPARTMENT OF TRANSPORTATION HIGHWAYS DIVISION	
OFFICE BUILDING EXT. ELEV., ROOF DETAILS	
WAHIAWA BASEYARD IMPROVEMENTS	
Project No. HWY-0-12-00	
Scale: AS SHOWN	Date: JAN. 2003
SHEET No. A2.01 OF 82 SHEETS	


"AS-BUILT"

C.O.30


FED. ROAD DIST. NO.	STATE	PROJ. NO.	FISCAL YEAR	SHEET NO.	TOTAL SHEETS
HAWAII	HAW.	HWY-0-12-00	2004	31	82

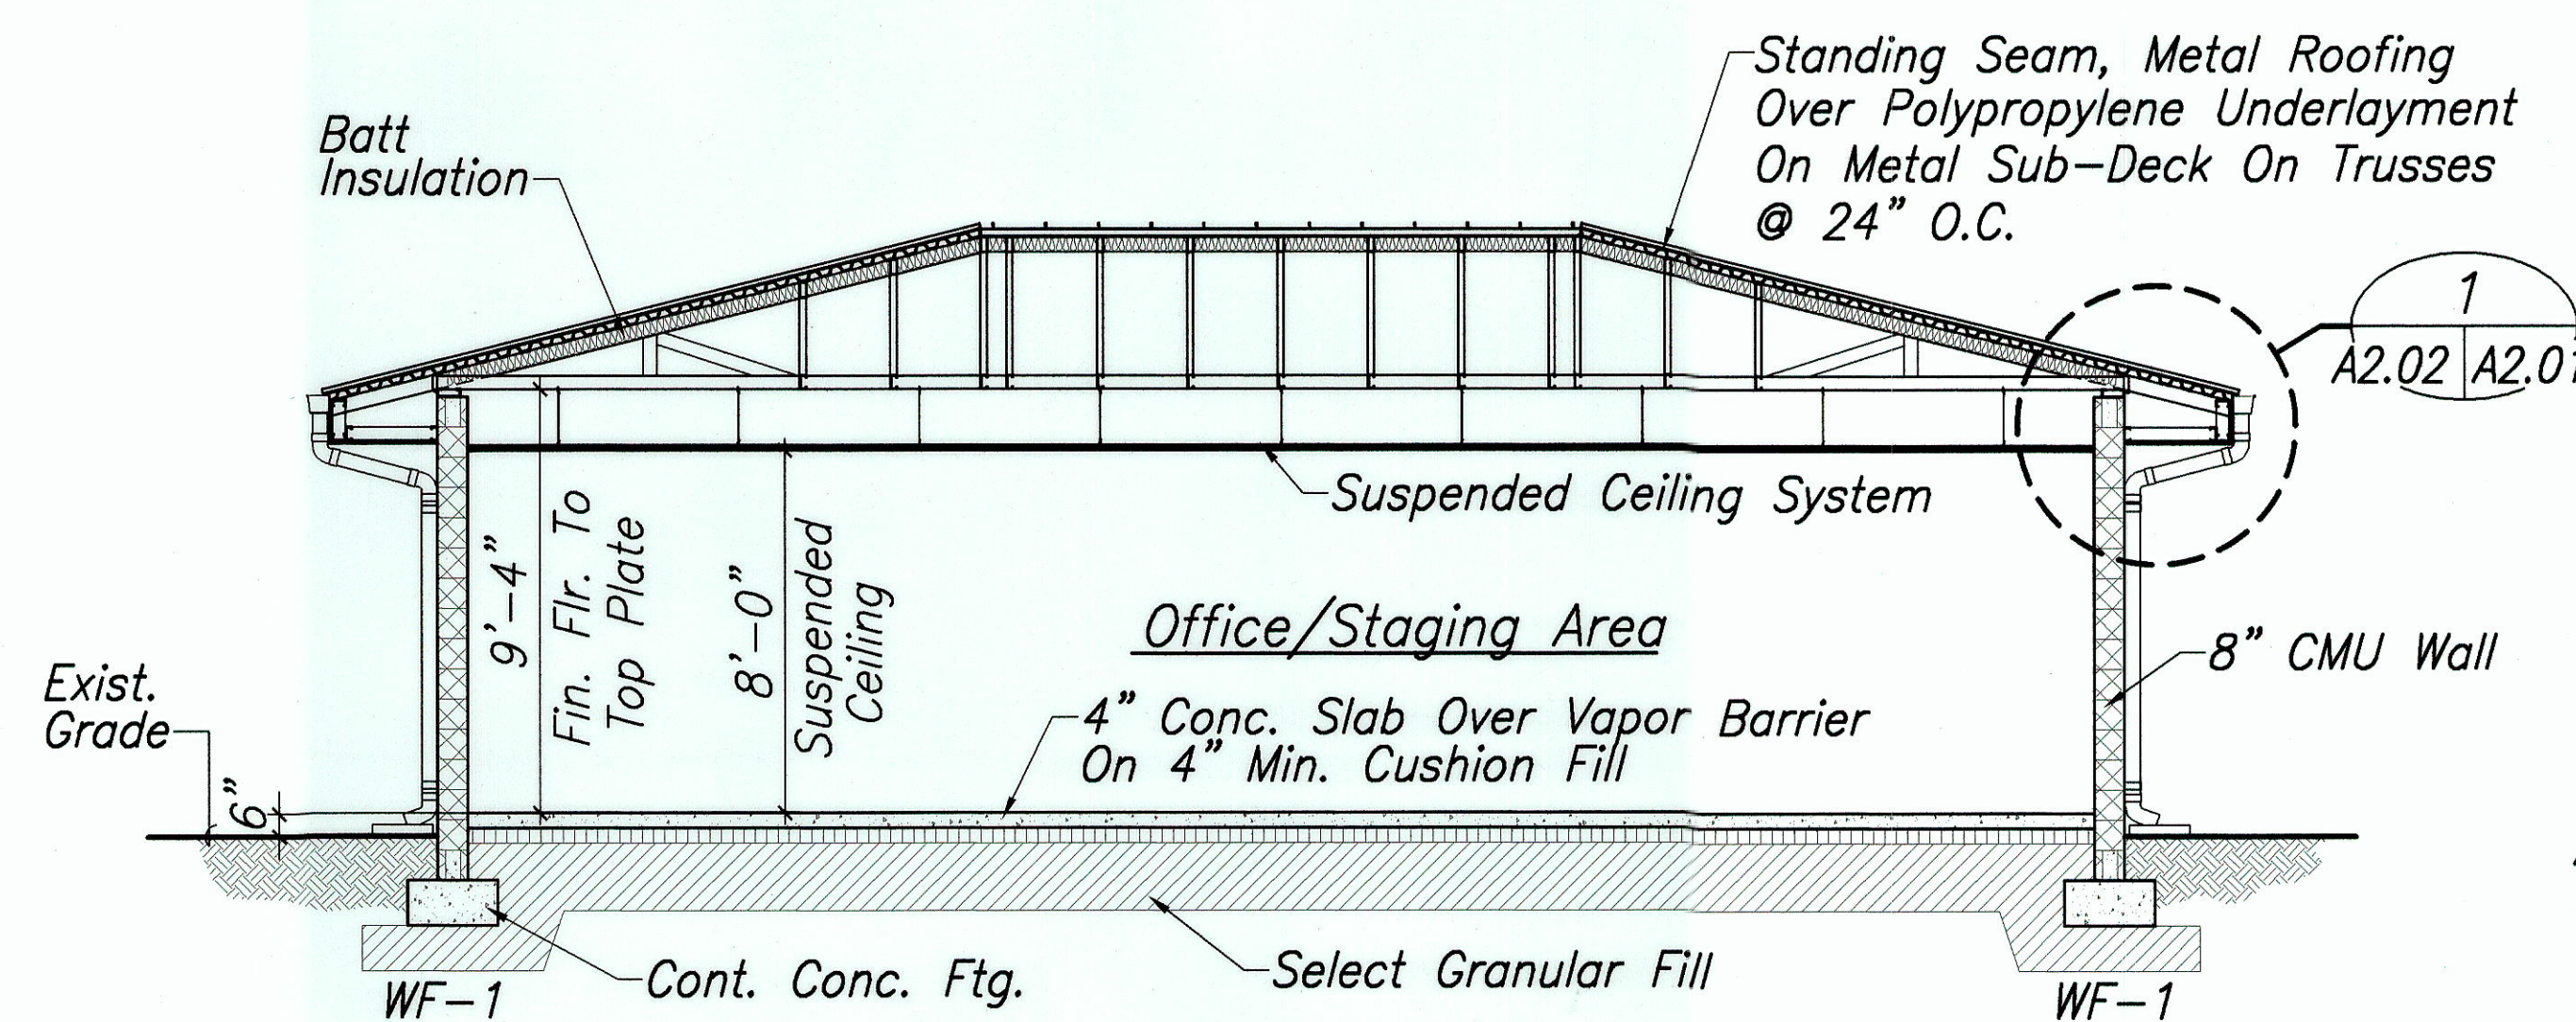





BUILDING SECTION A
Scale: 1/4"=1'-0" A2.00 A2.02

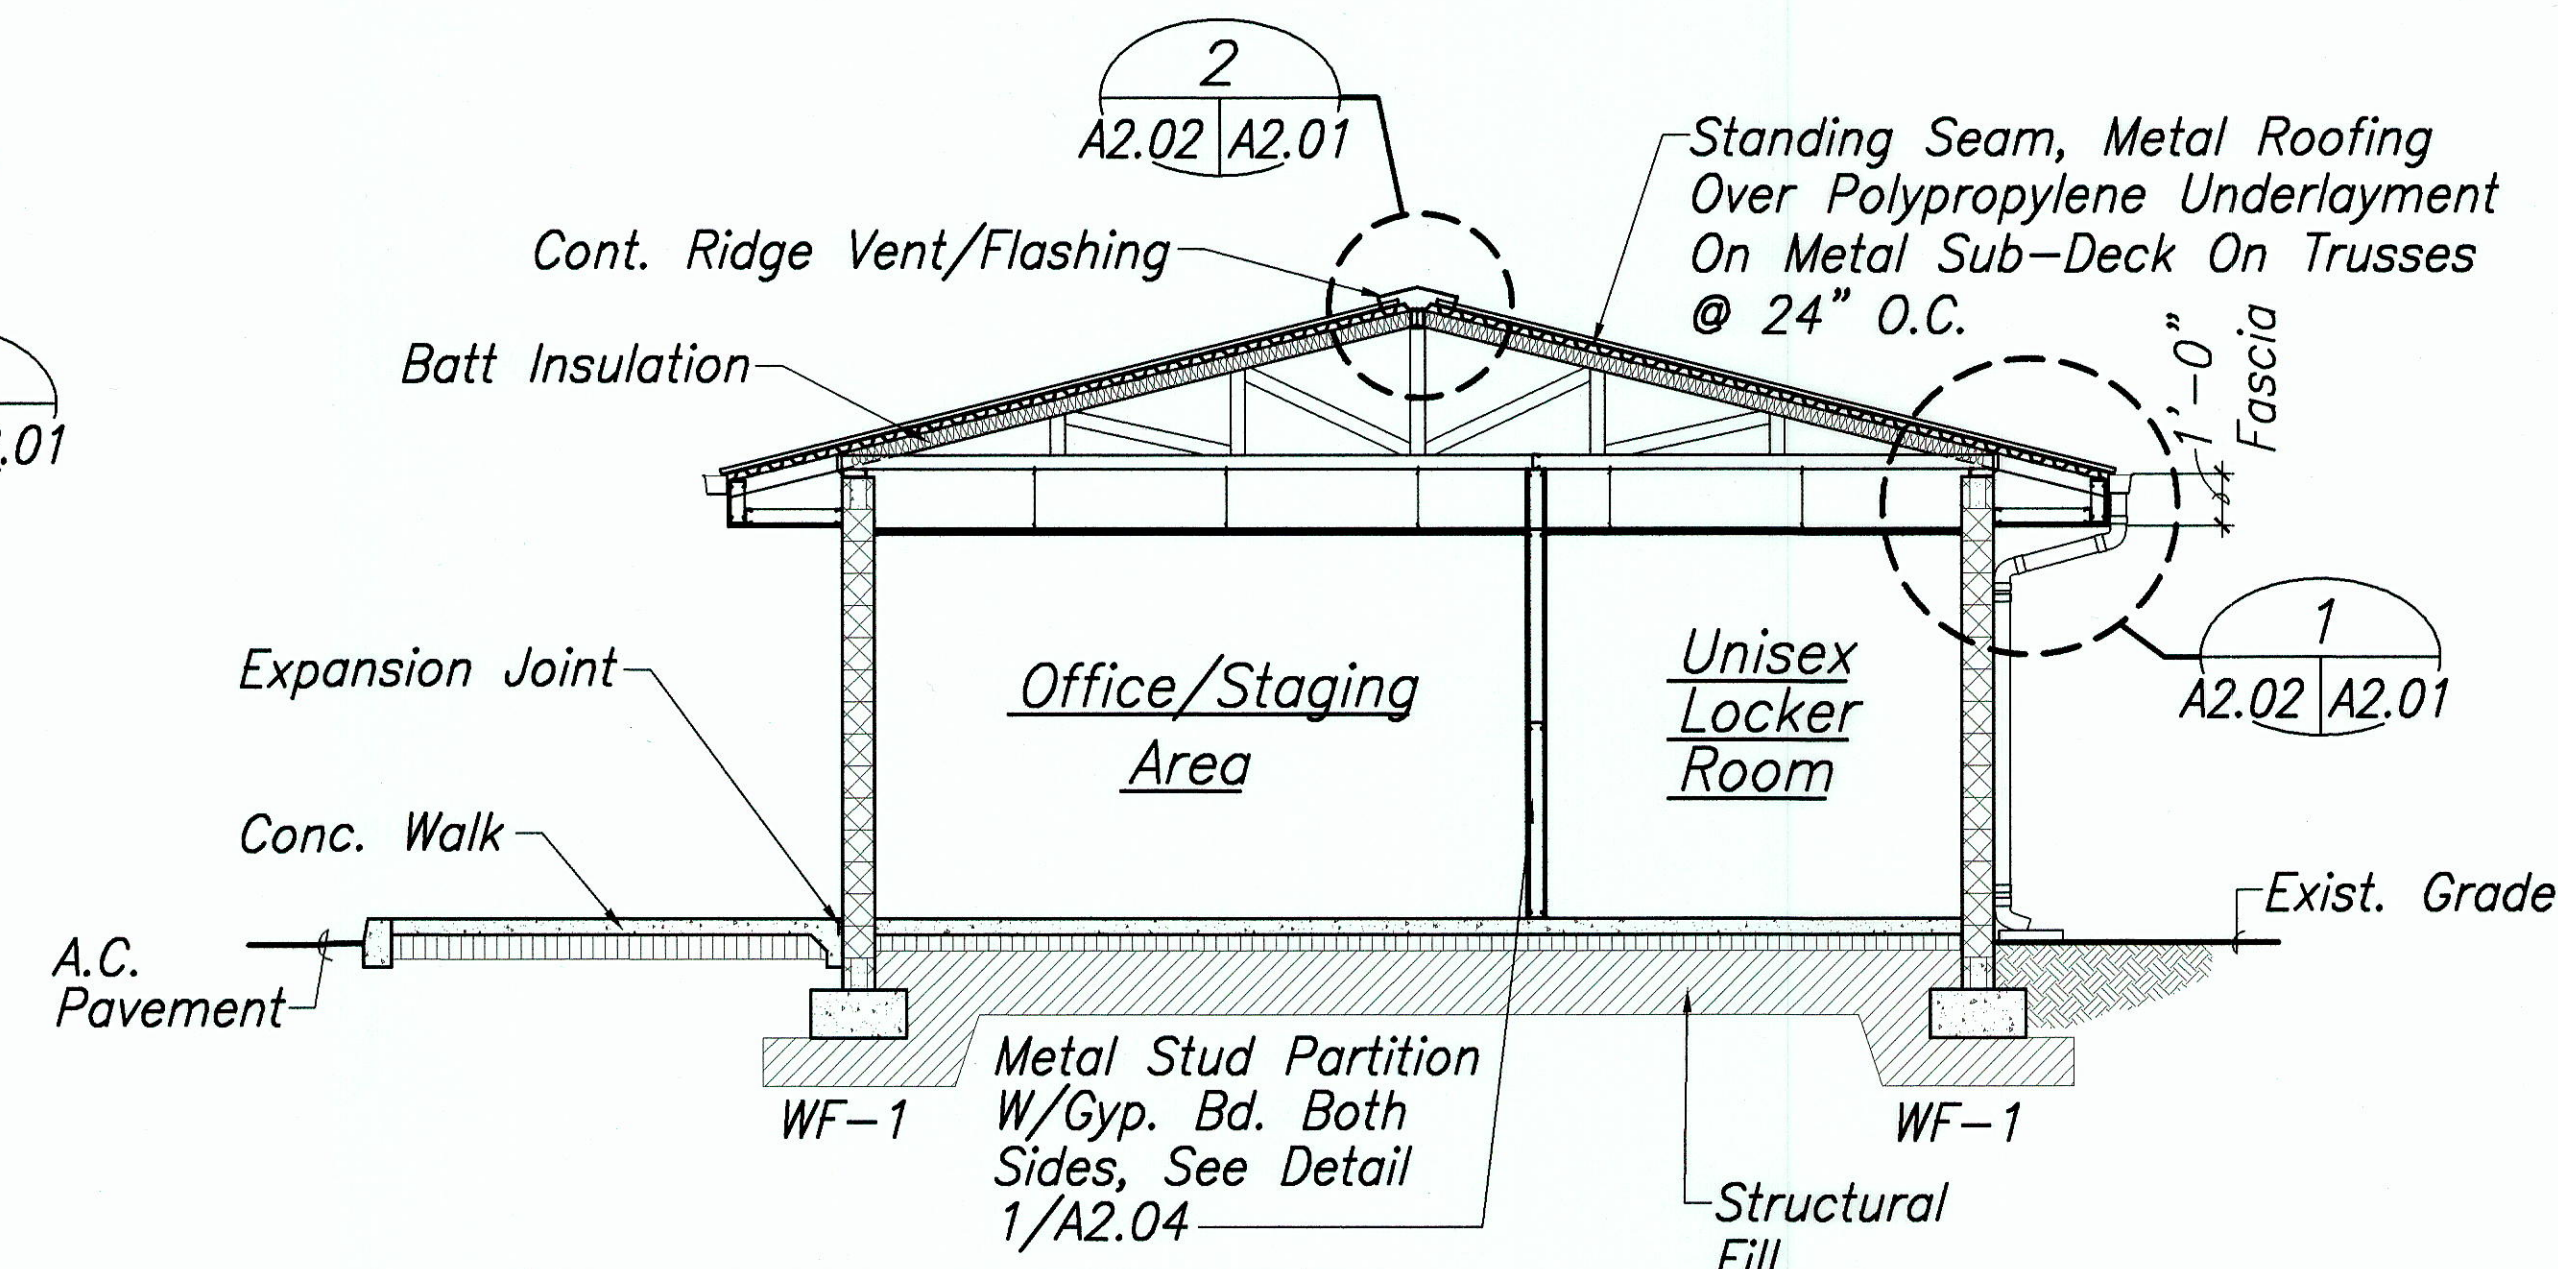

BUILDING SECTION B
Scale: 1/4"=1'-0" A2.00 A2.02

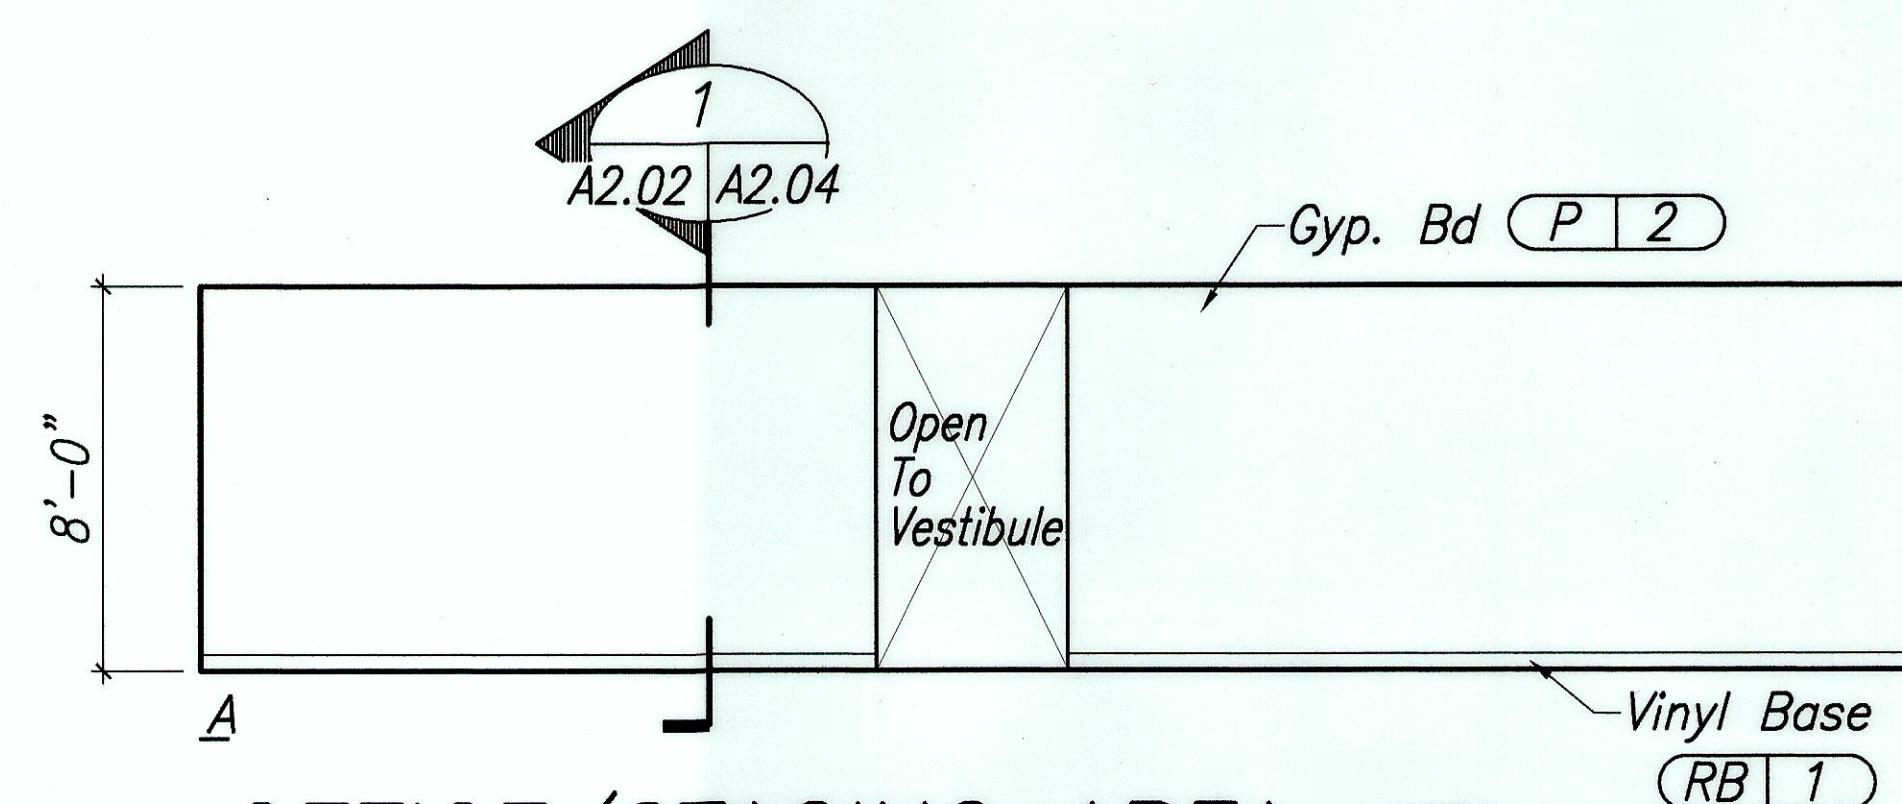


OFFICE/STAGING AREA
Scale: 1/4"=1'-0" A2.00 A2.02

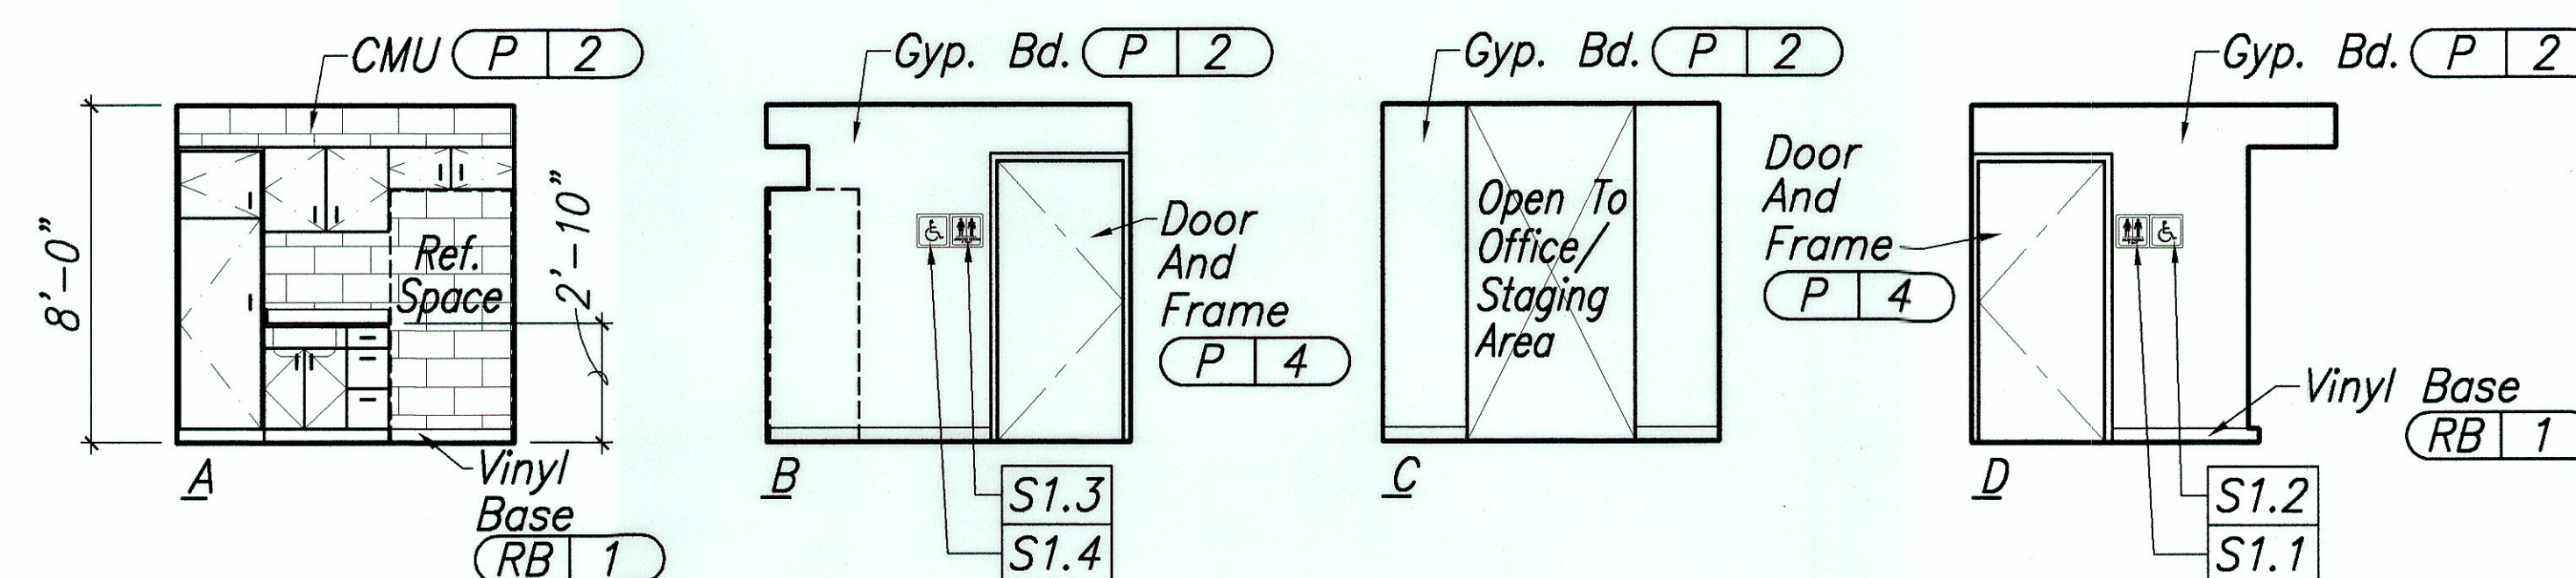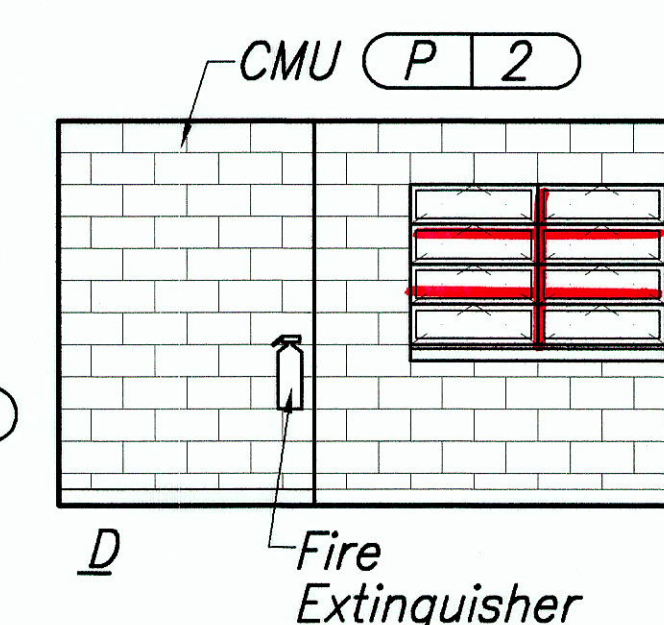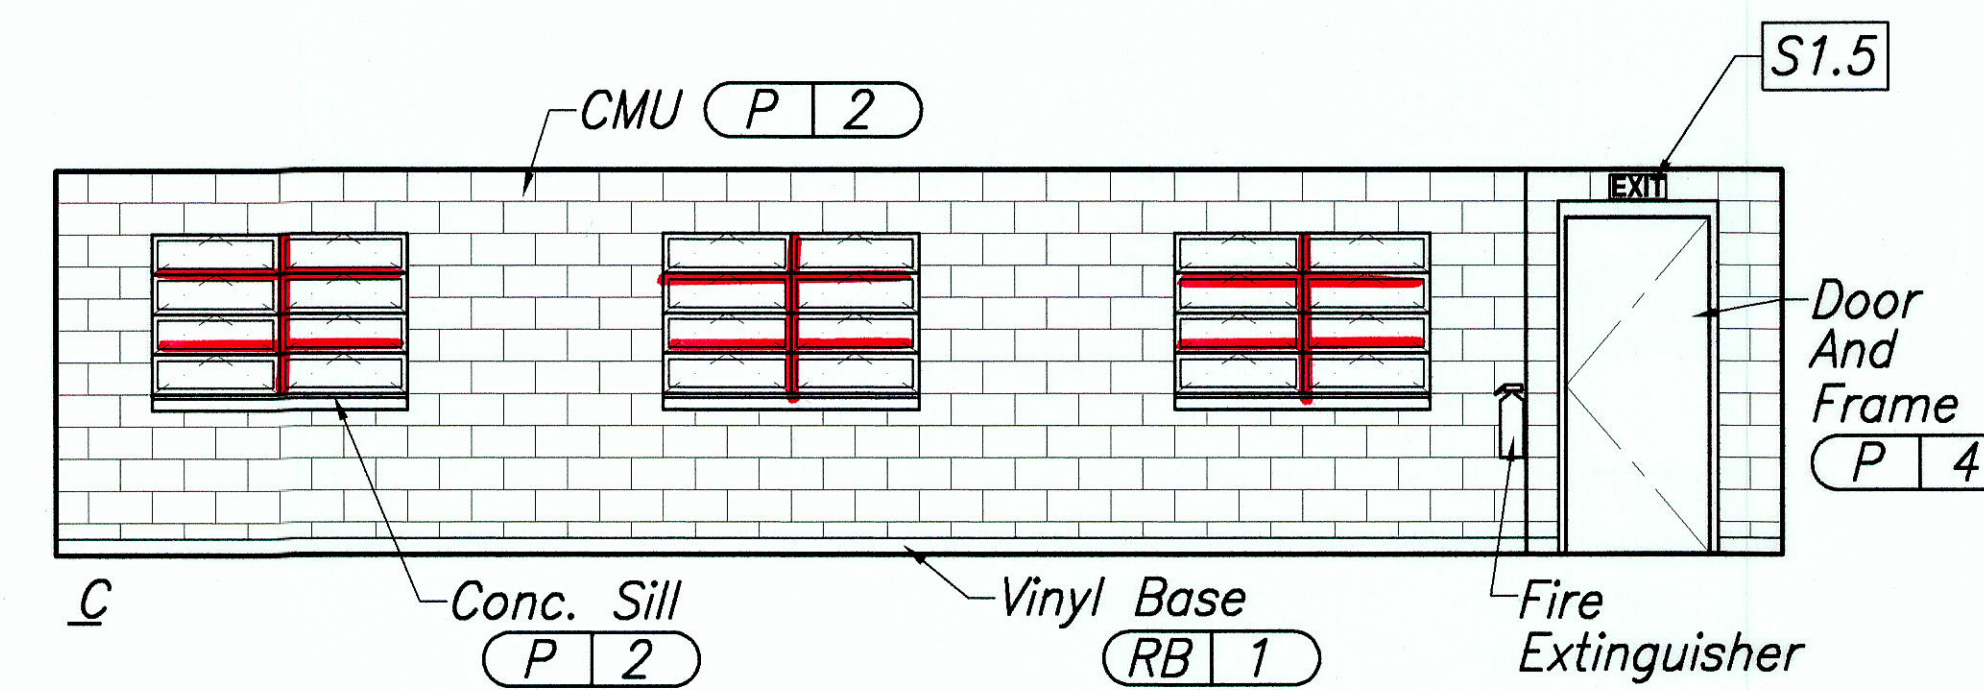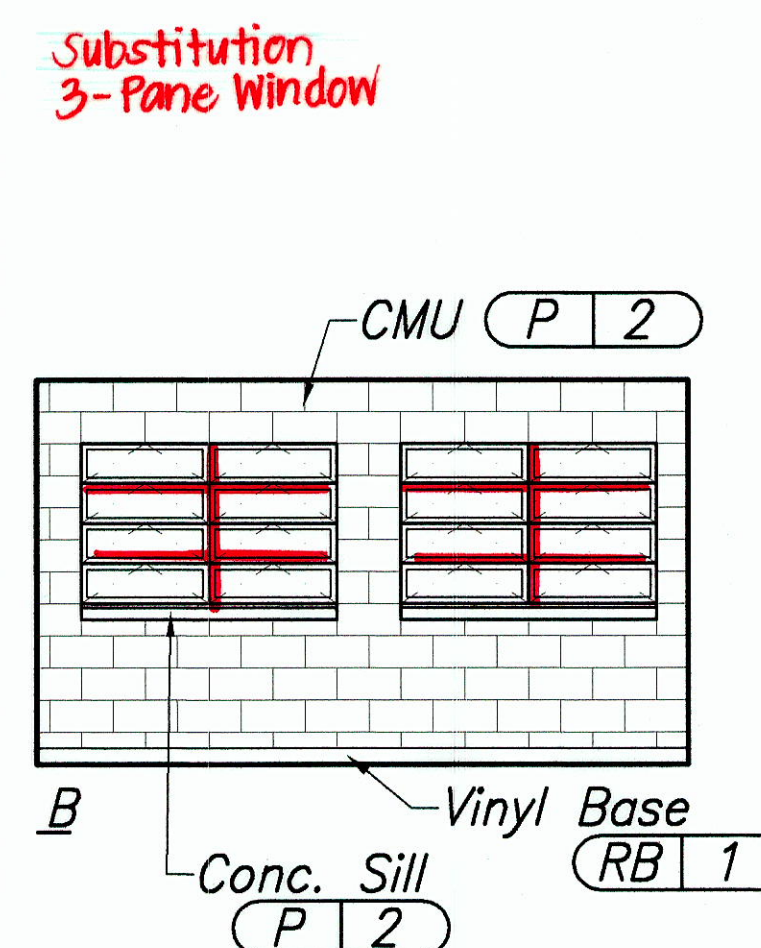

VESTIBULE
Scale: 1/4"=1'-0" A2.00 A2.02

Legend
CT 1 Material Finish Or Color, See COLOR AND MATERIAL SCHEDULE, Sheet A5.05

ORIGINAL PLAN	DATE
NOTE BOOK	DESIGNED BY
XX	QUANTITIES BY
	CHECKED BY






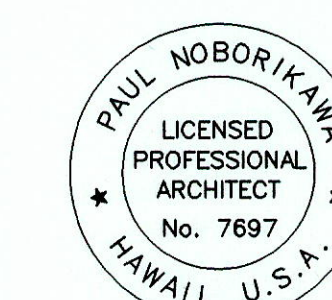


THIS WORK WAS PREPARED BY ME OR UNDER MY SUPERVISION

STATE OF HAWAII
DEPARTMENT OF TRANSPORTATION
HIGHWAYS DIVISION
OFFICE BUILDING
BLDG. SECTIONS, INT. ELEVS
WAHIAWA BASEYARD
IMPROVEMENTS
Project No. HWY-0-12-00
Scale: AS SHOWN Date: JAN. 2003
SHEET No. A2.02 OF 82 SHEETS

"AS-BUILT"

FED. ROAD DIST. NO.	STATE	PROJ. NO.	FISCAL YEAR	SHEET NO.	TOTAL SHEETS
HAWAII	HAW.	HWY-0-12-00	2004	32	82

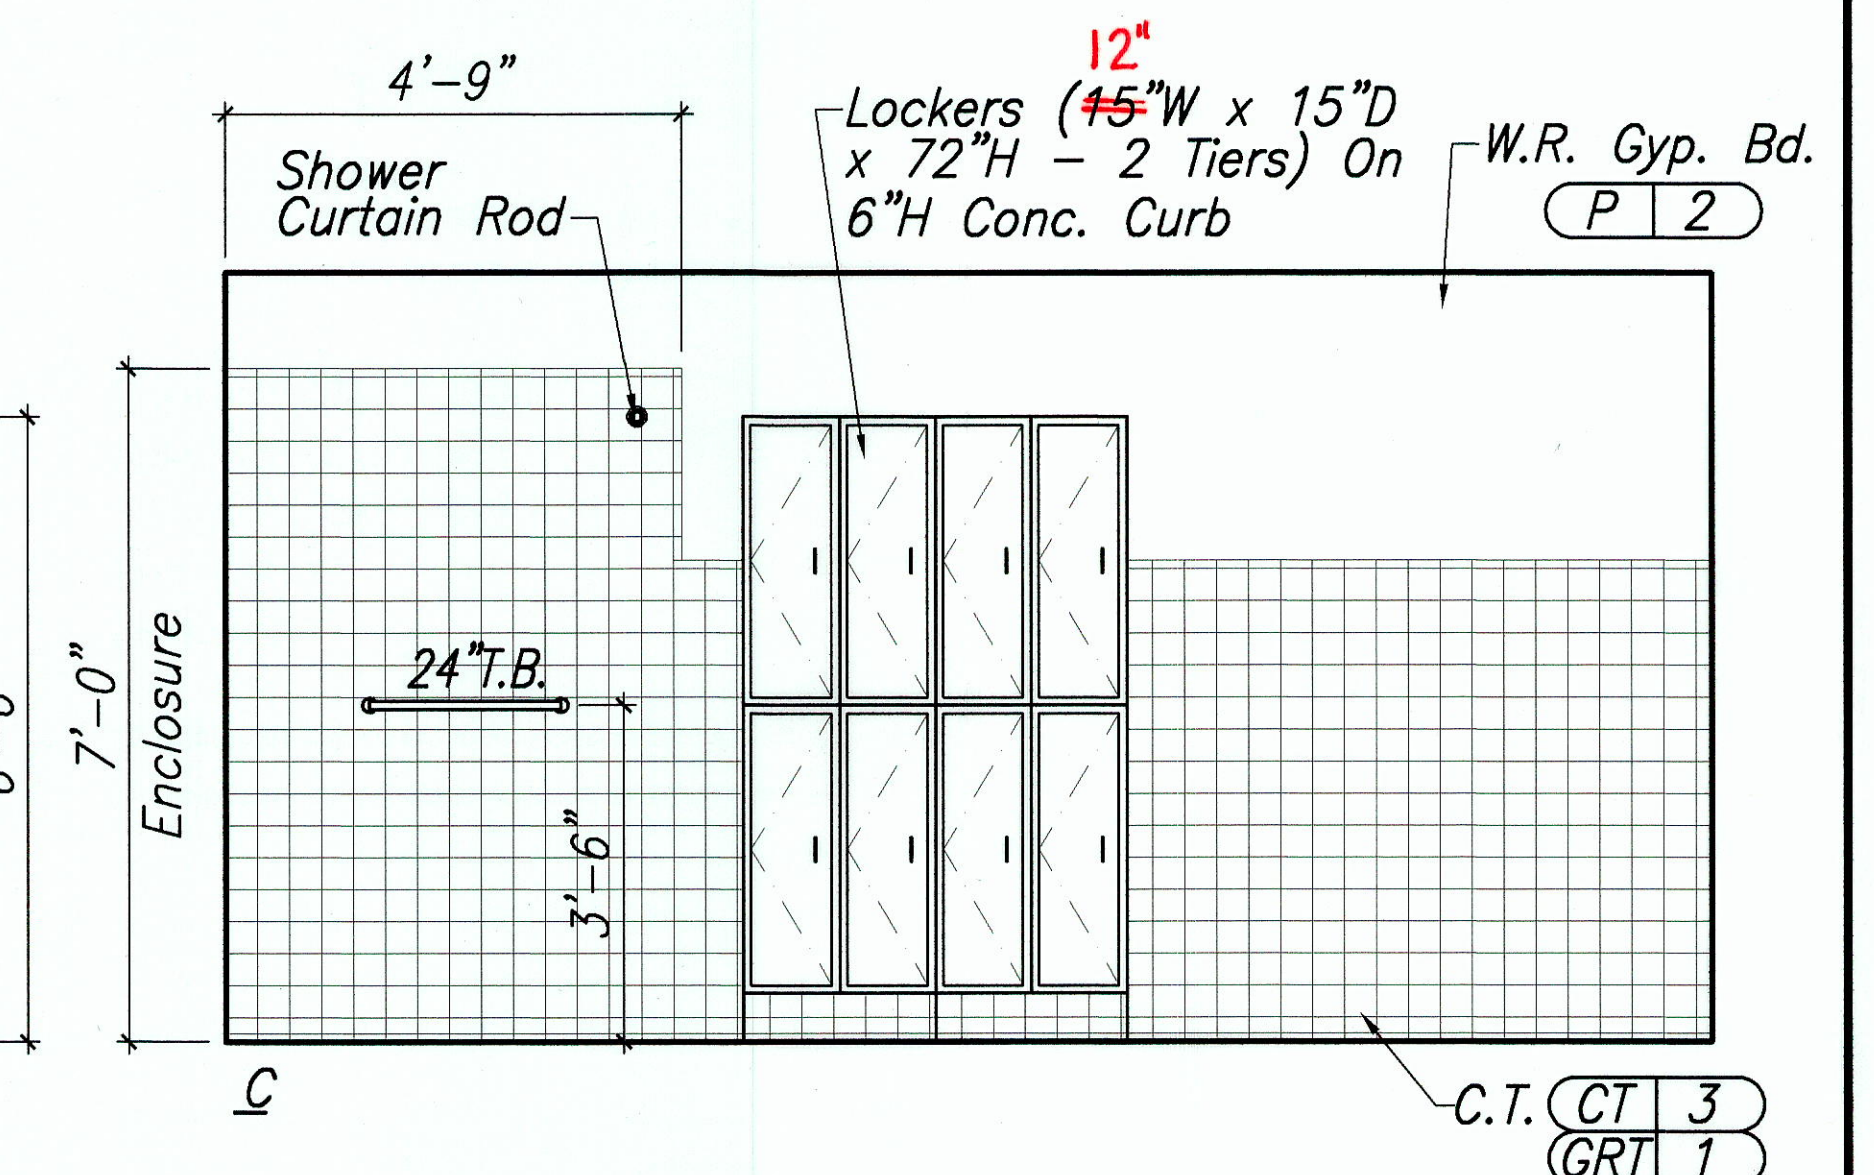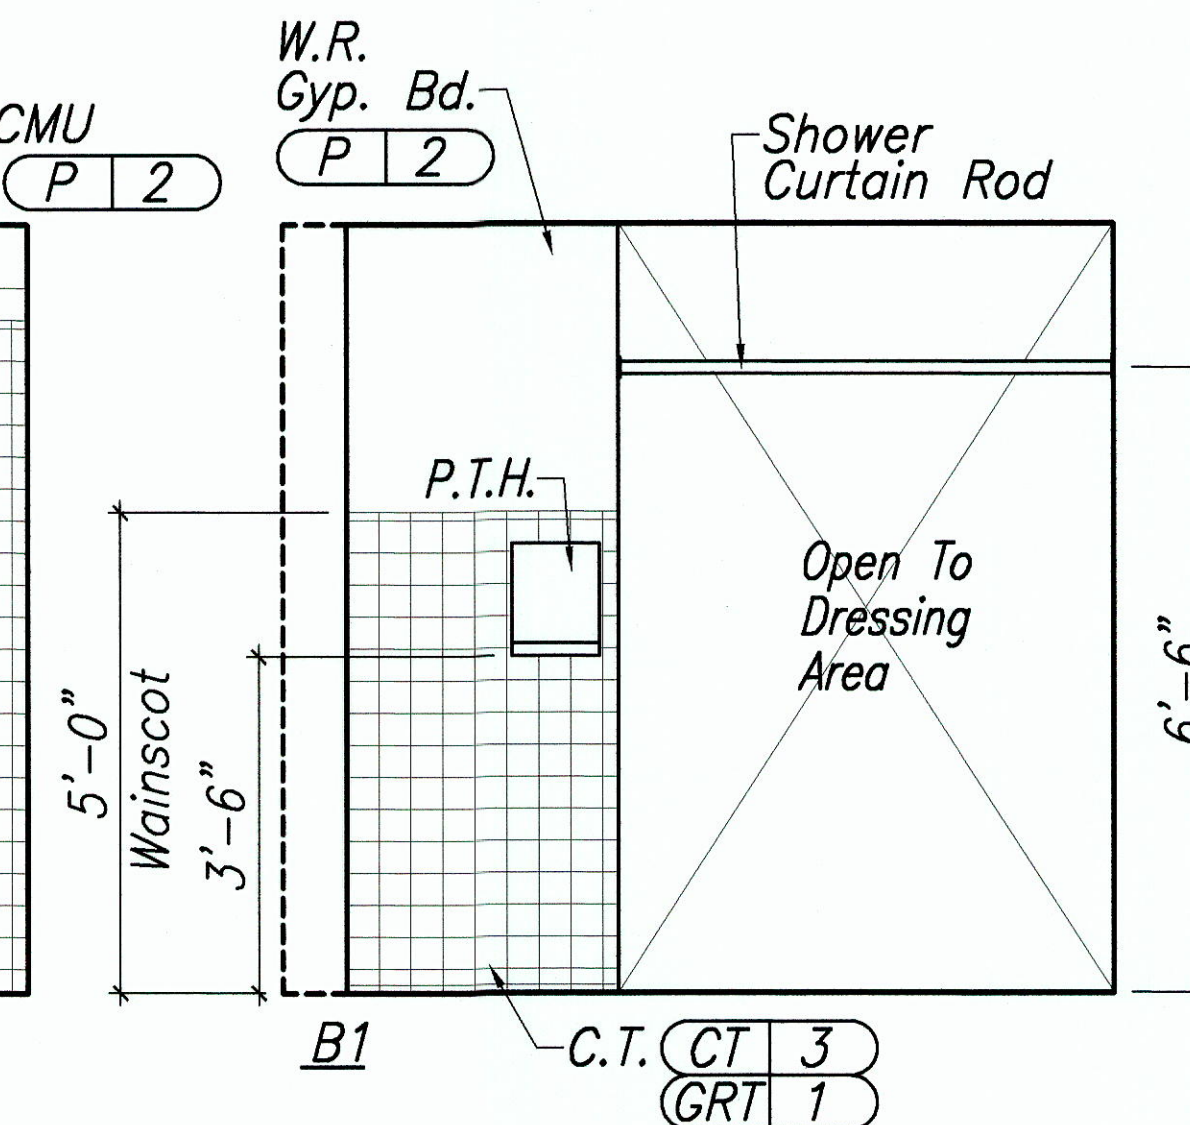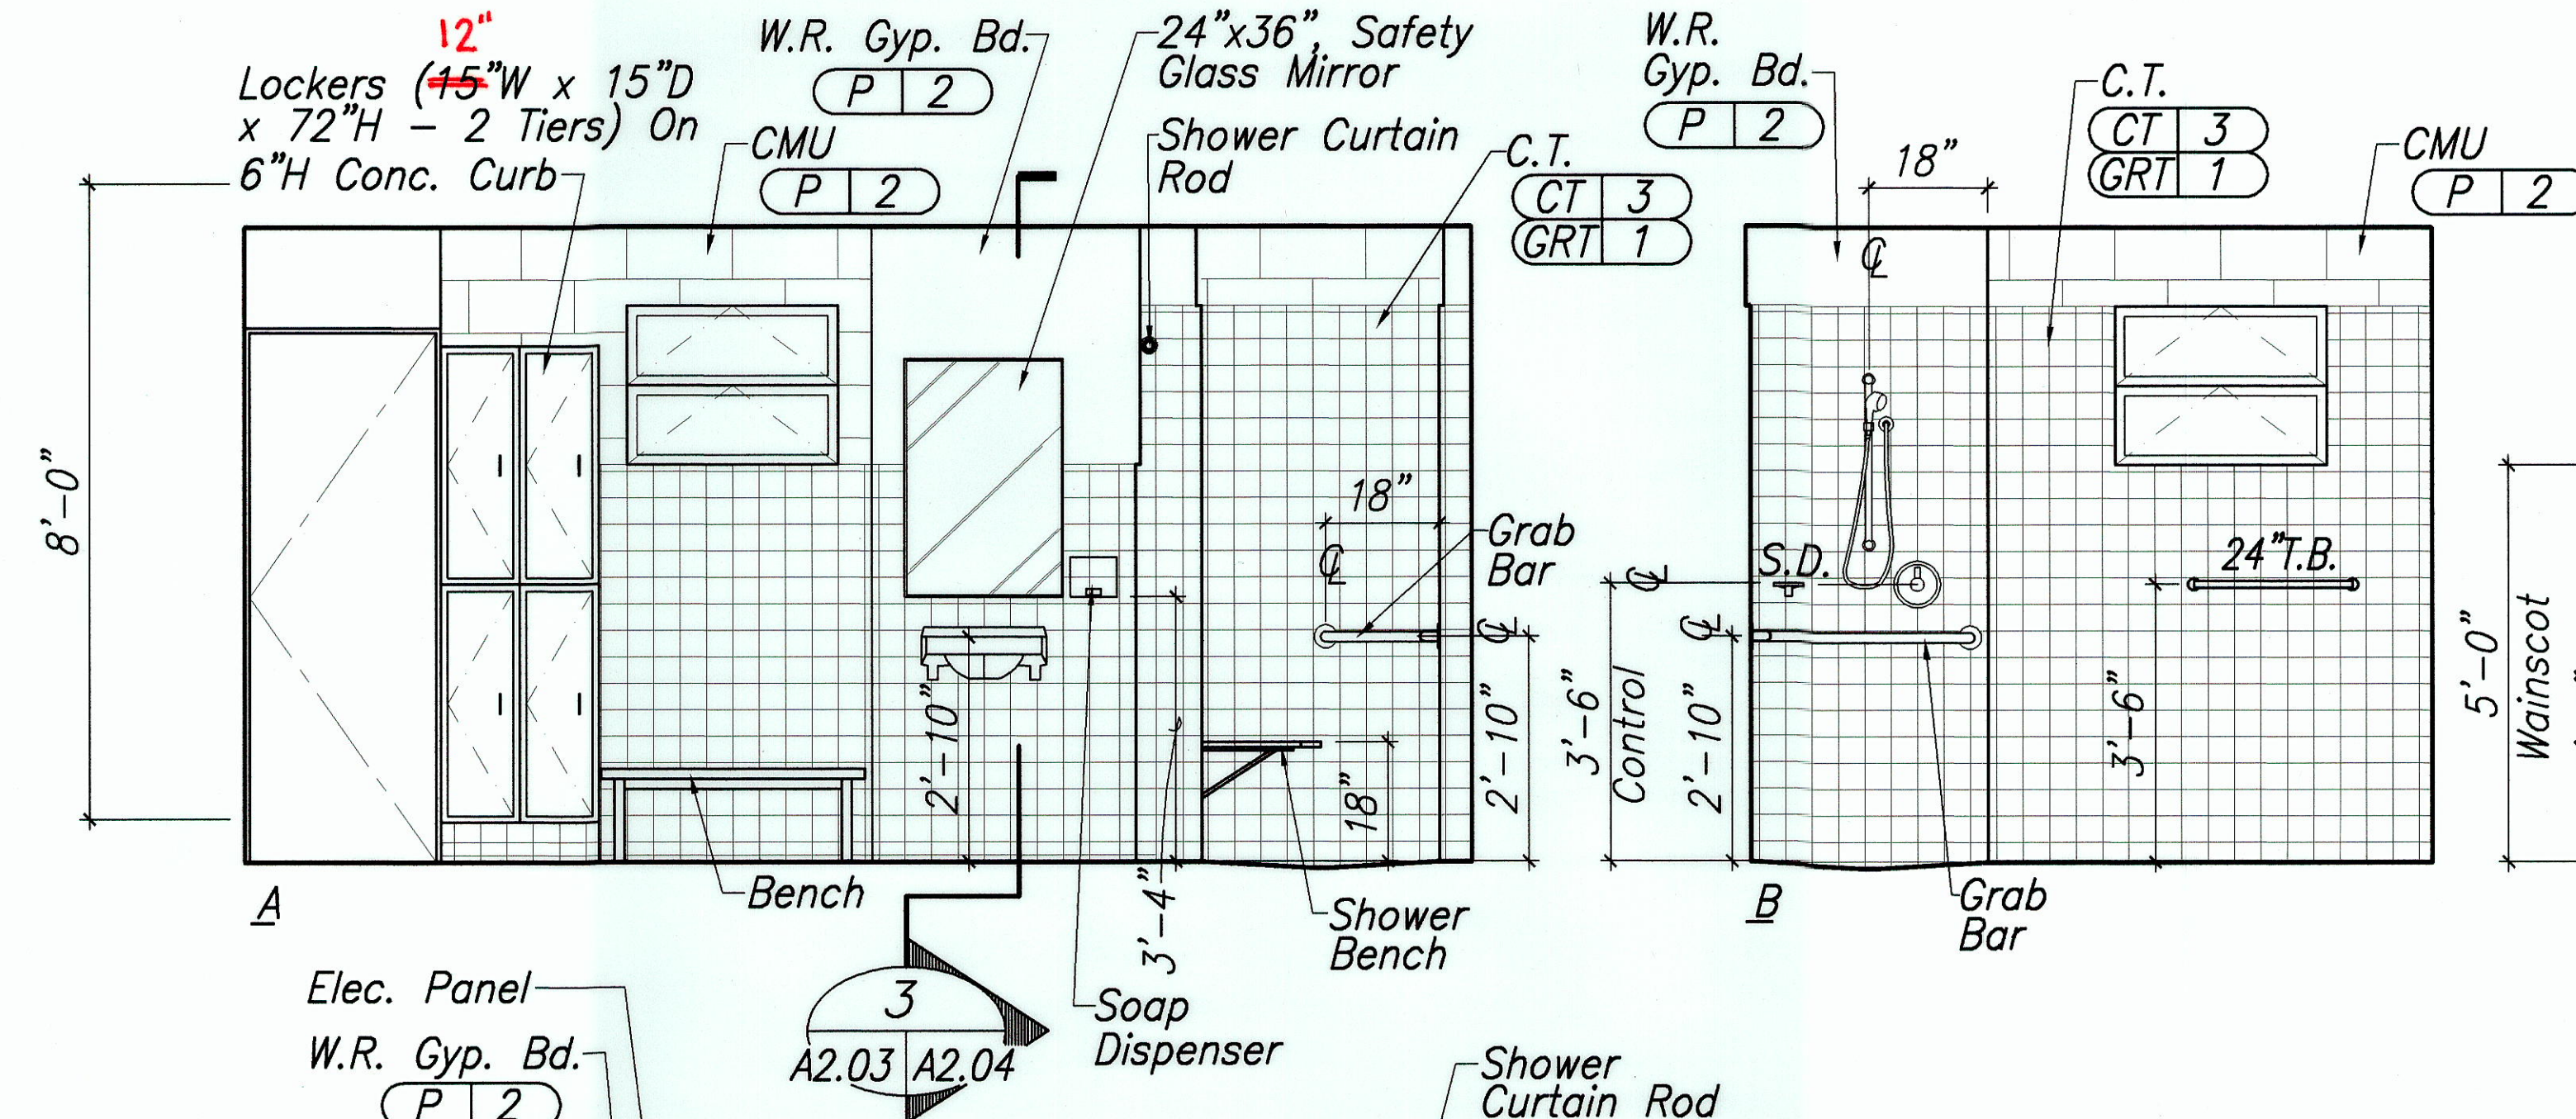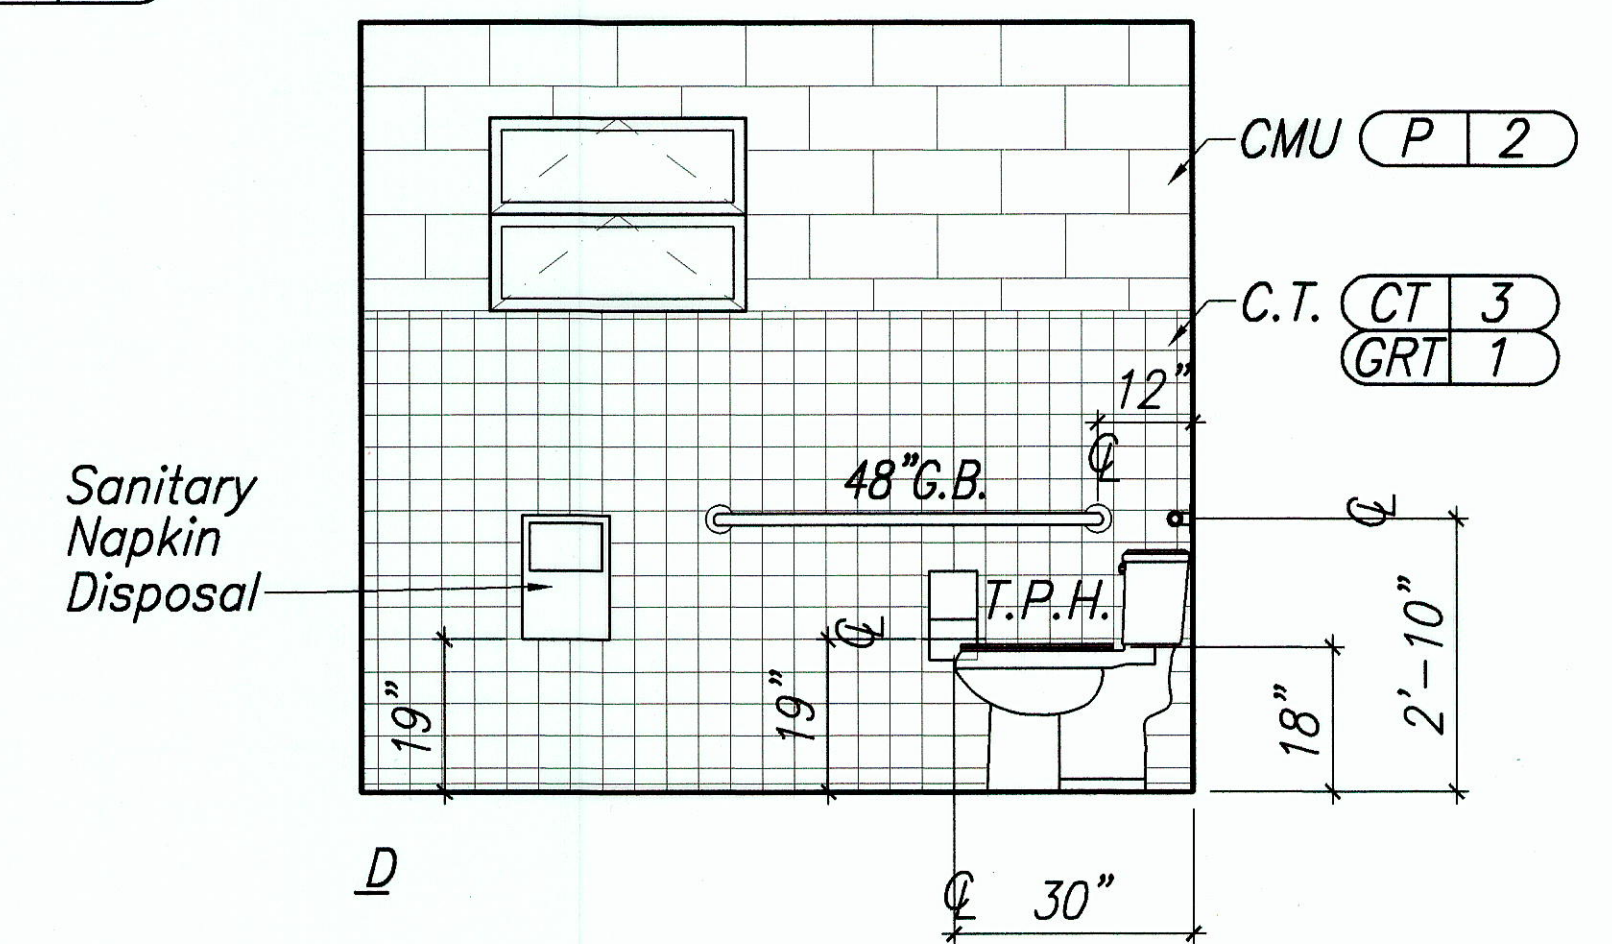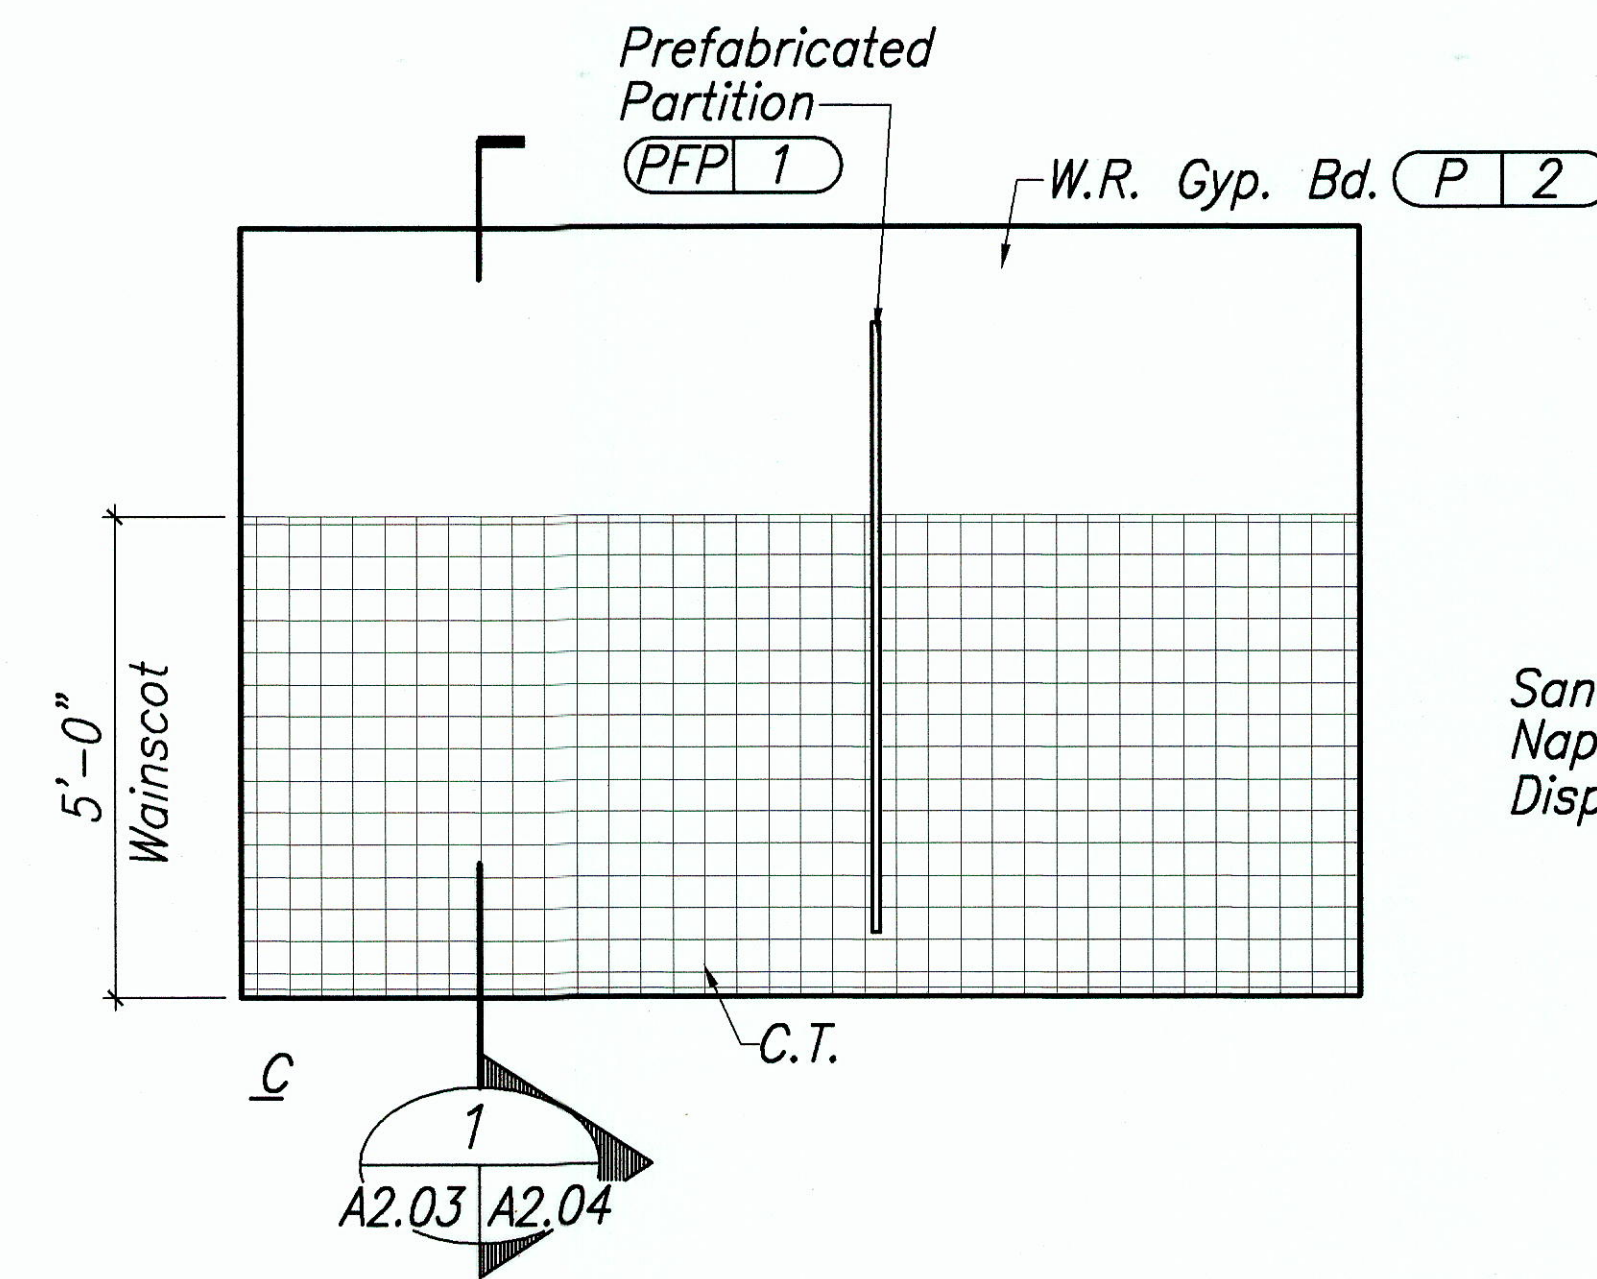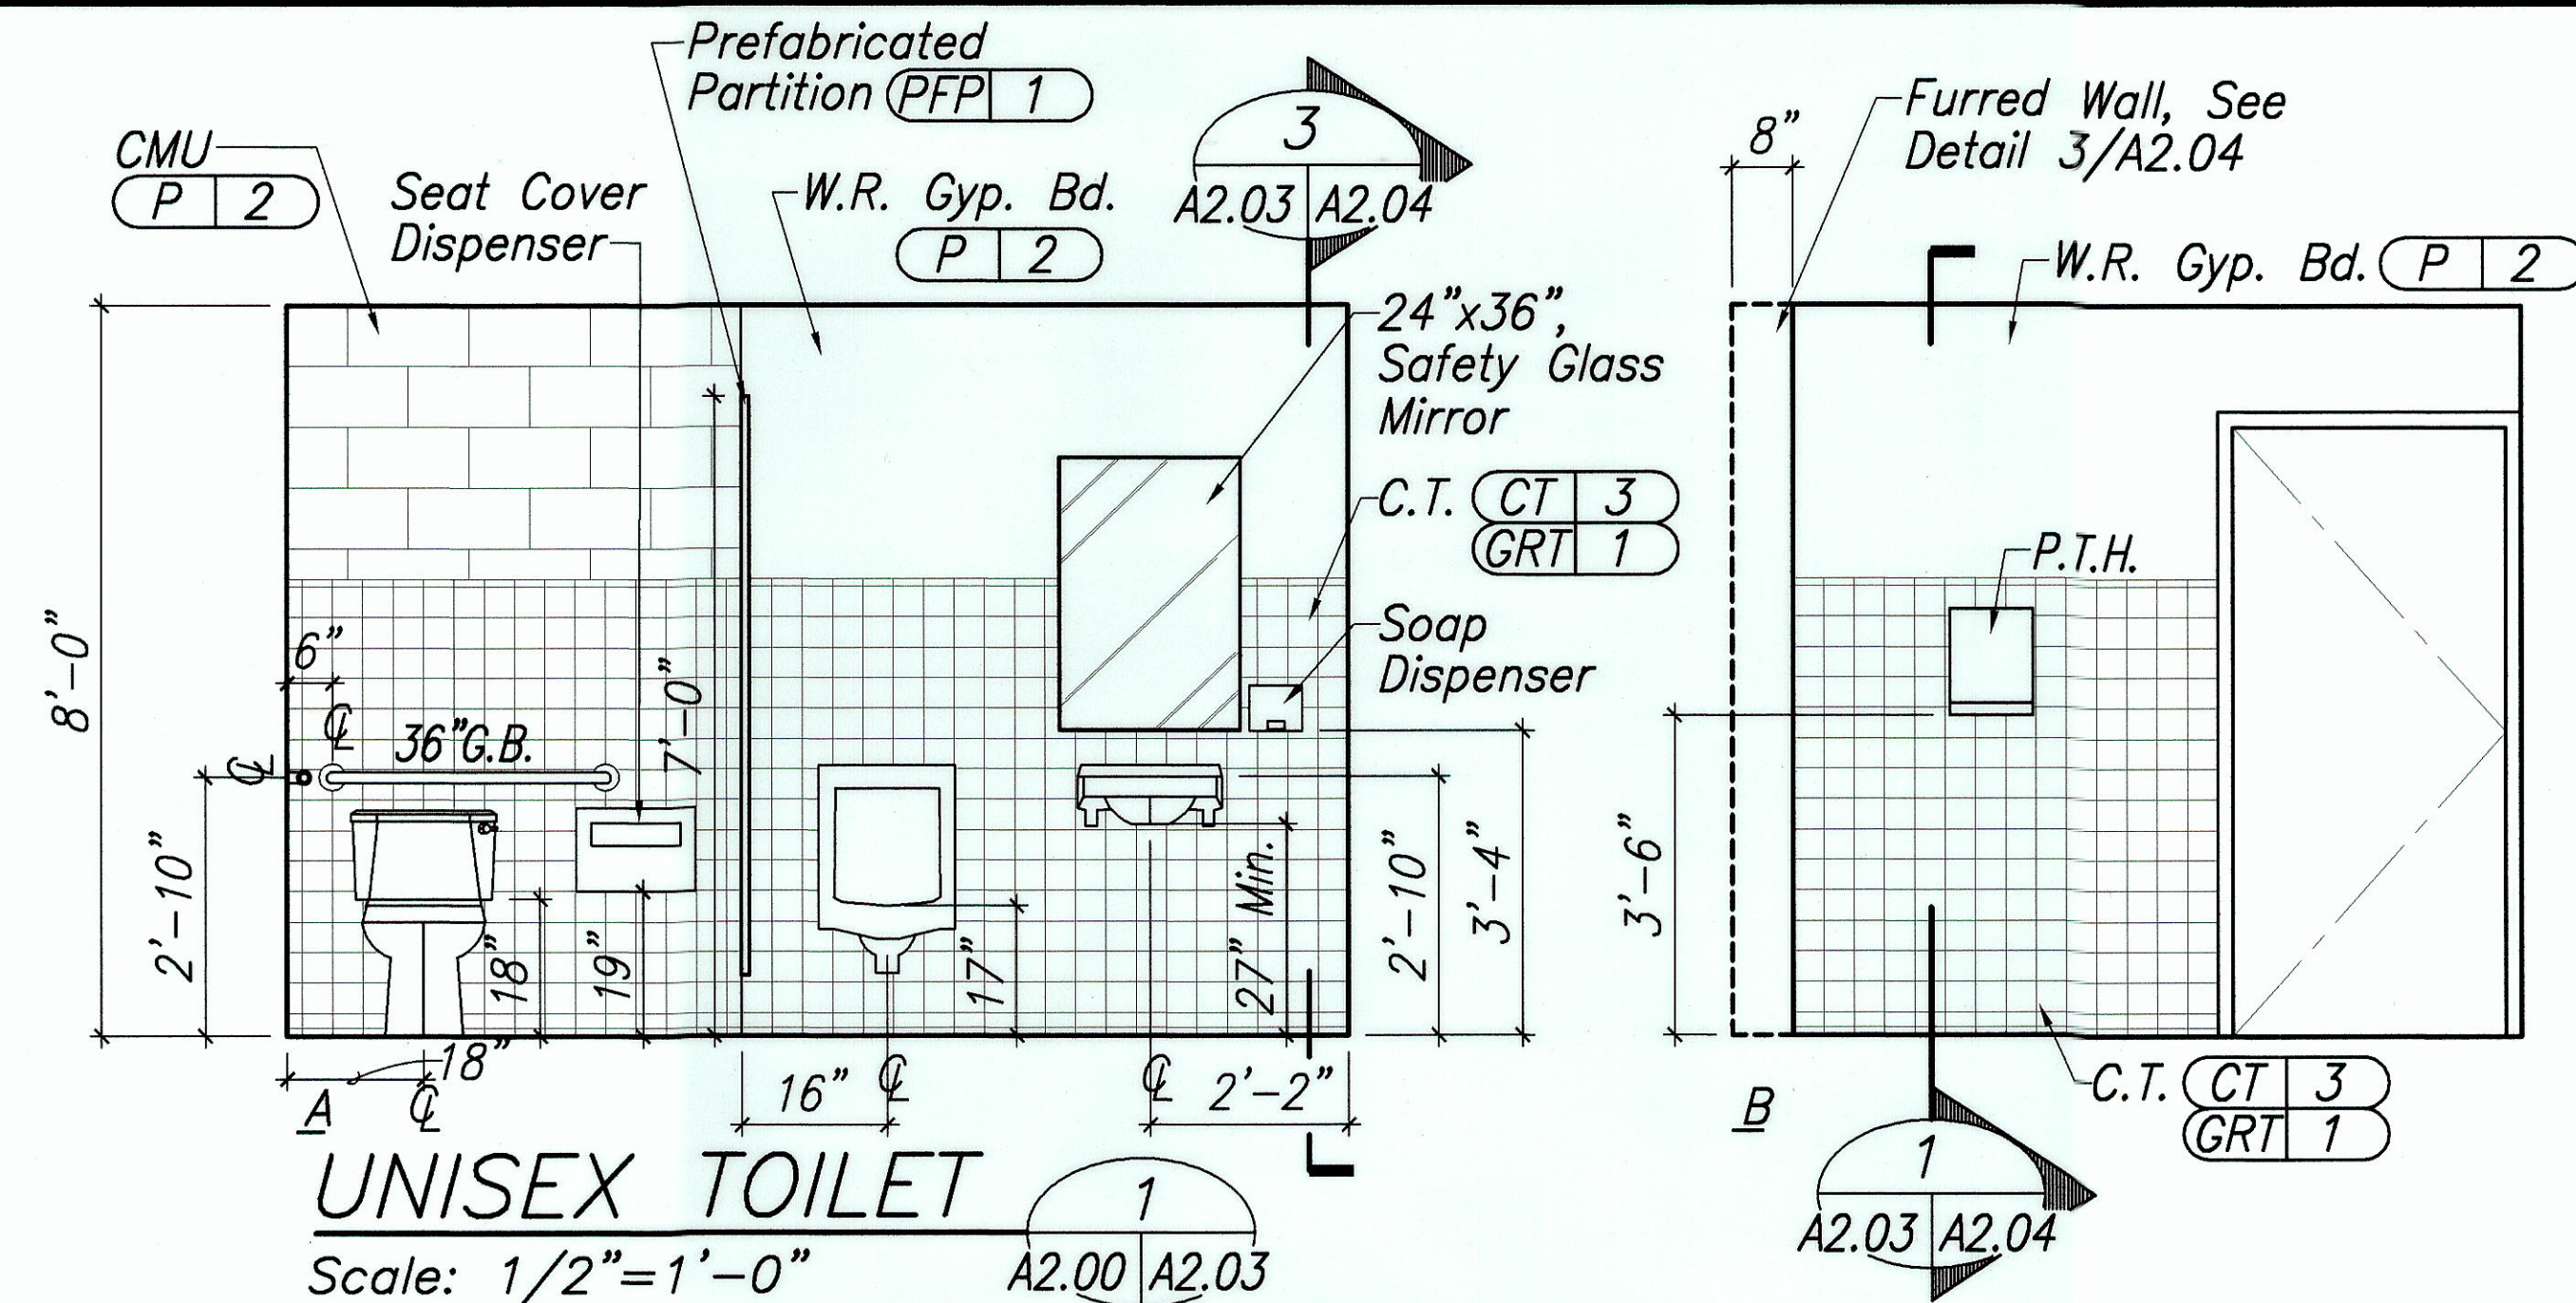


Legend

CT 1 Material Finish Or Color,
See COLOR AND MATERIAL
SCHEDULE, Sheet A5.05

Note:

All Plumbing Fixture Controls Shall Comply With ADAAG 4.27.4, "Controls And Operating Mechanisms Shall Be Operable With One Hand And Shall Not Require Tight Grasping, Pinching, Or Twisting Of The Wrist. The Force Required To Activate Controls Shall Be No Greater Than 5 lbf."

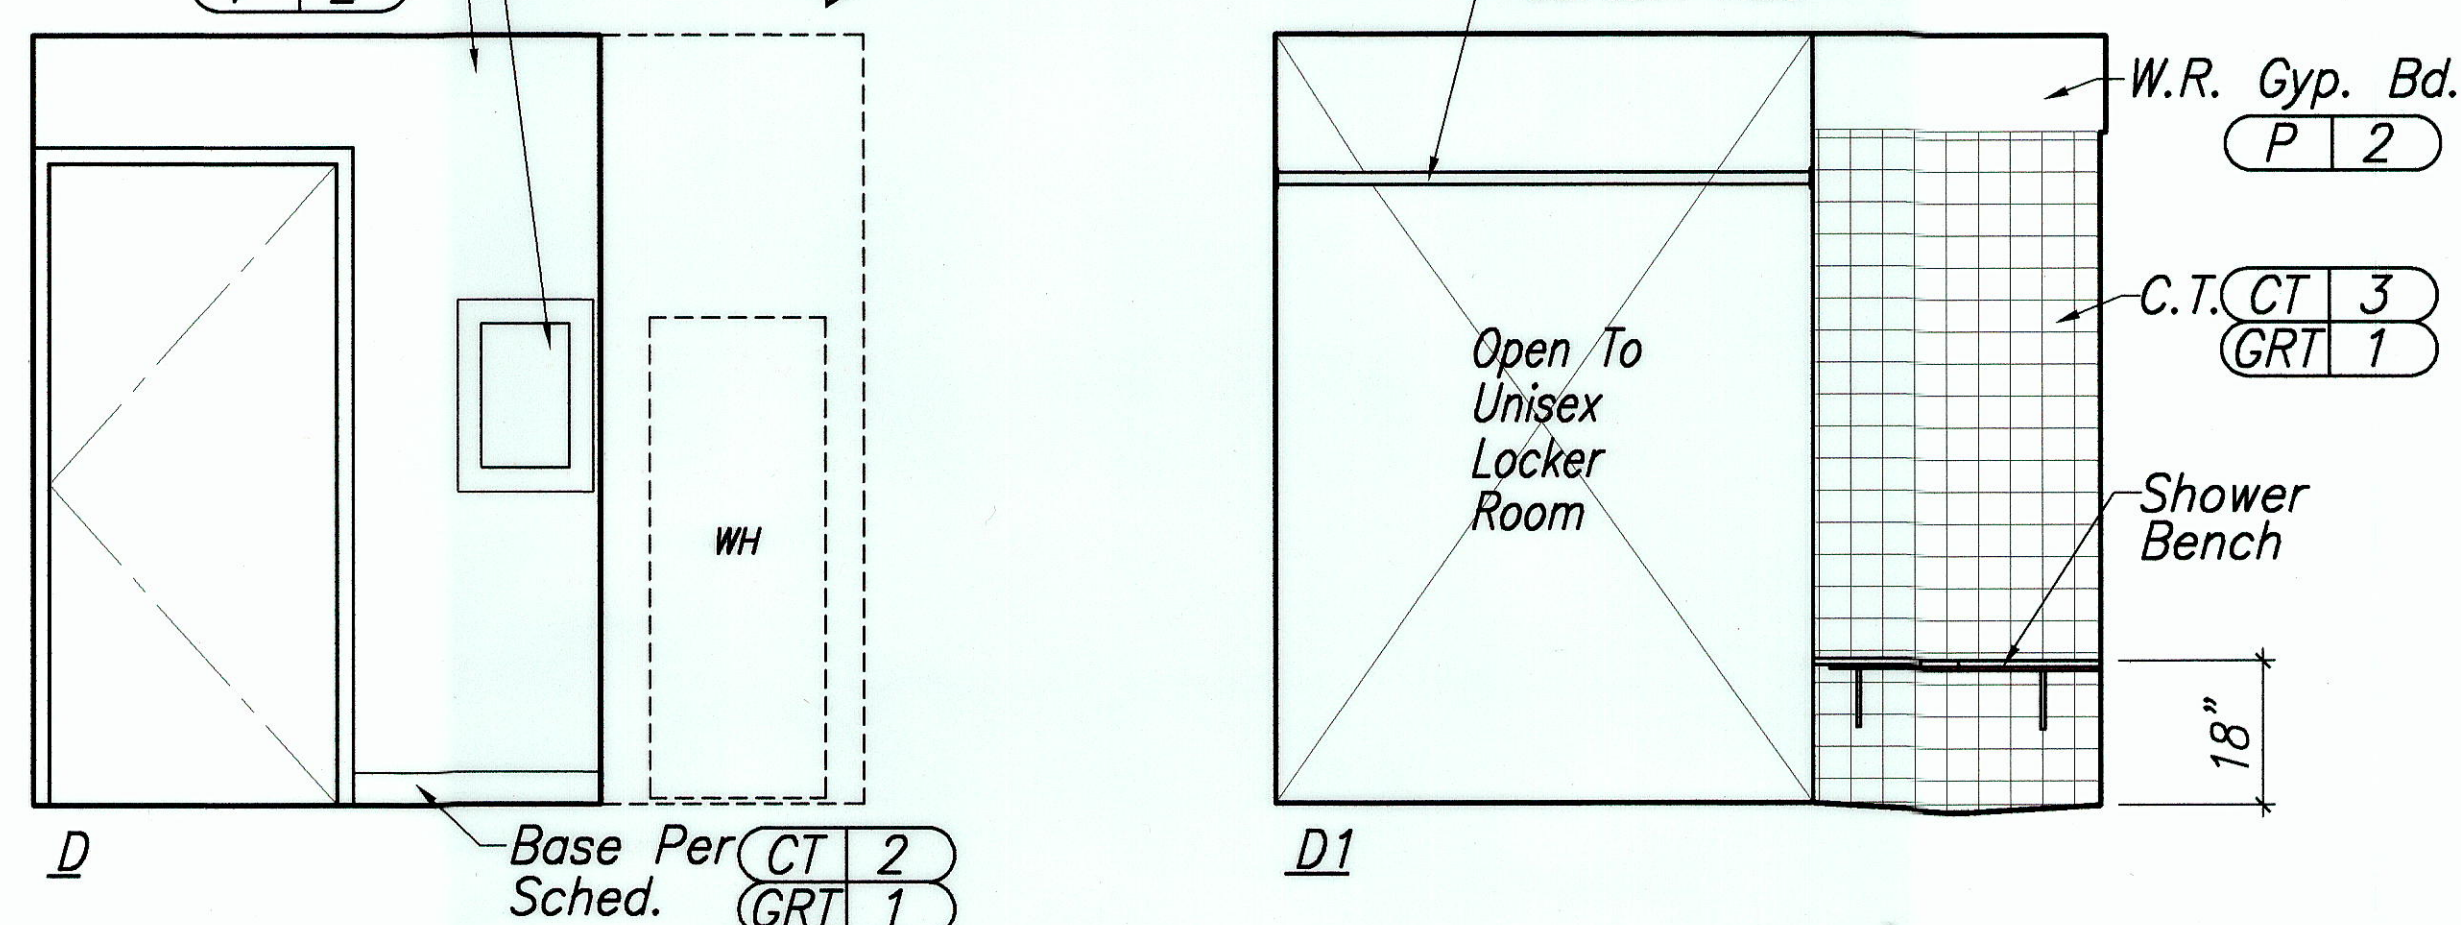

UNISEX LOCKER ROOM/SHOWER

Scale: $1/2" = 1'-0"$

2

A2.00 | A2.03

ORIGINAL PLAN	SURVEY PLOTTED BY _____ DATE _____
NOTE BOOK	DRAWN BY _____
	TRACED BY _____
	DESIGNED BY _____
	QUANTITIES BY _____
	CHECKED BY _____
No. XX	



THIS WORK WAS PREPARED BY M
OR UNDER MY SUPERVISION

STATE OF HAWAII
DEPARTMENT OF TRANSPORTATION
HIGHWAYS DIVISION

OFFICE BUILDING INTERIOR ELEVATIONS


WAHIAWA BASEYARD
IMPROVEMENTS

Project No. HWY-0-12-00


Scale: AS SHOWN Date: JAN. 2003

SHEET No. A2.03 OF 82 SHEETS


FED. ROAD DIST. NO.	STATE	PROJ. NO.	FISCAL YEAR	SHEET NO.	TOTAL SHEETS
HAWAII	HAW.	HWY-0-12-00	2004	33	82

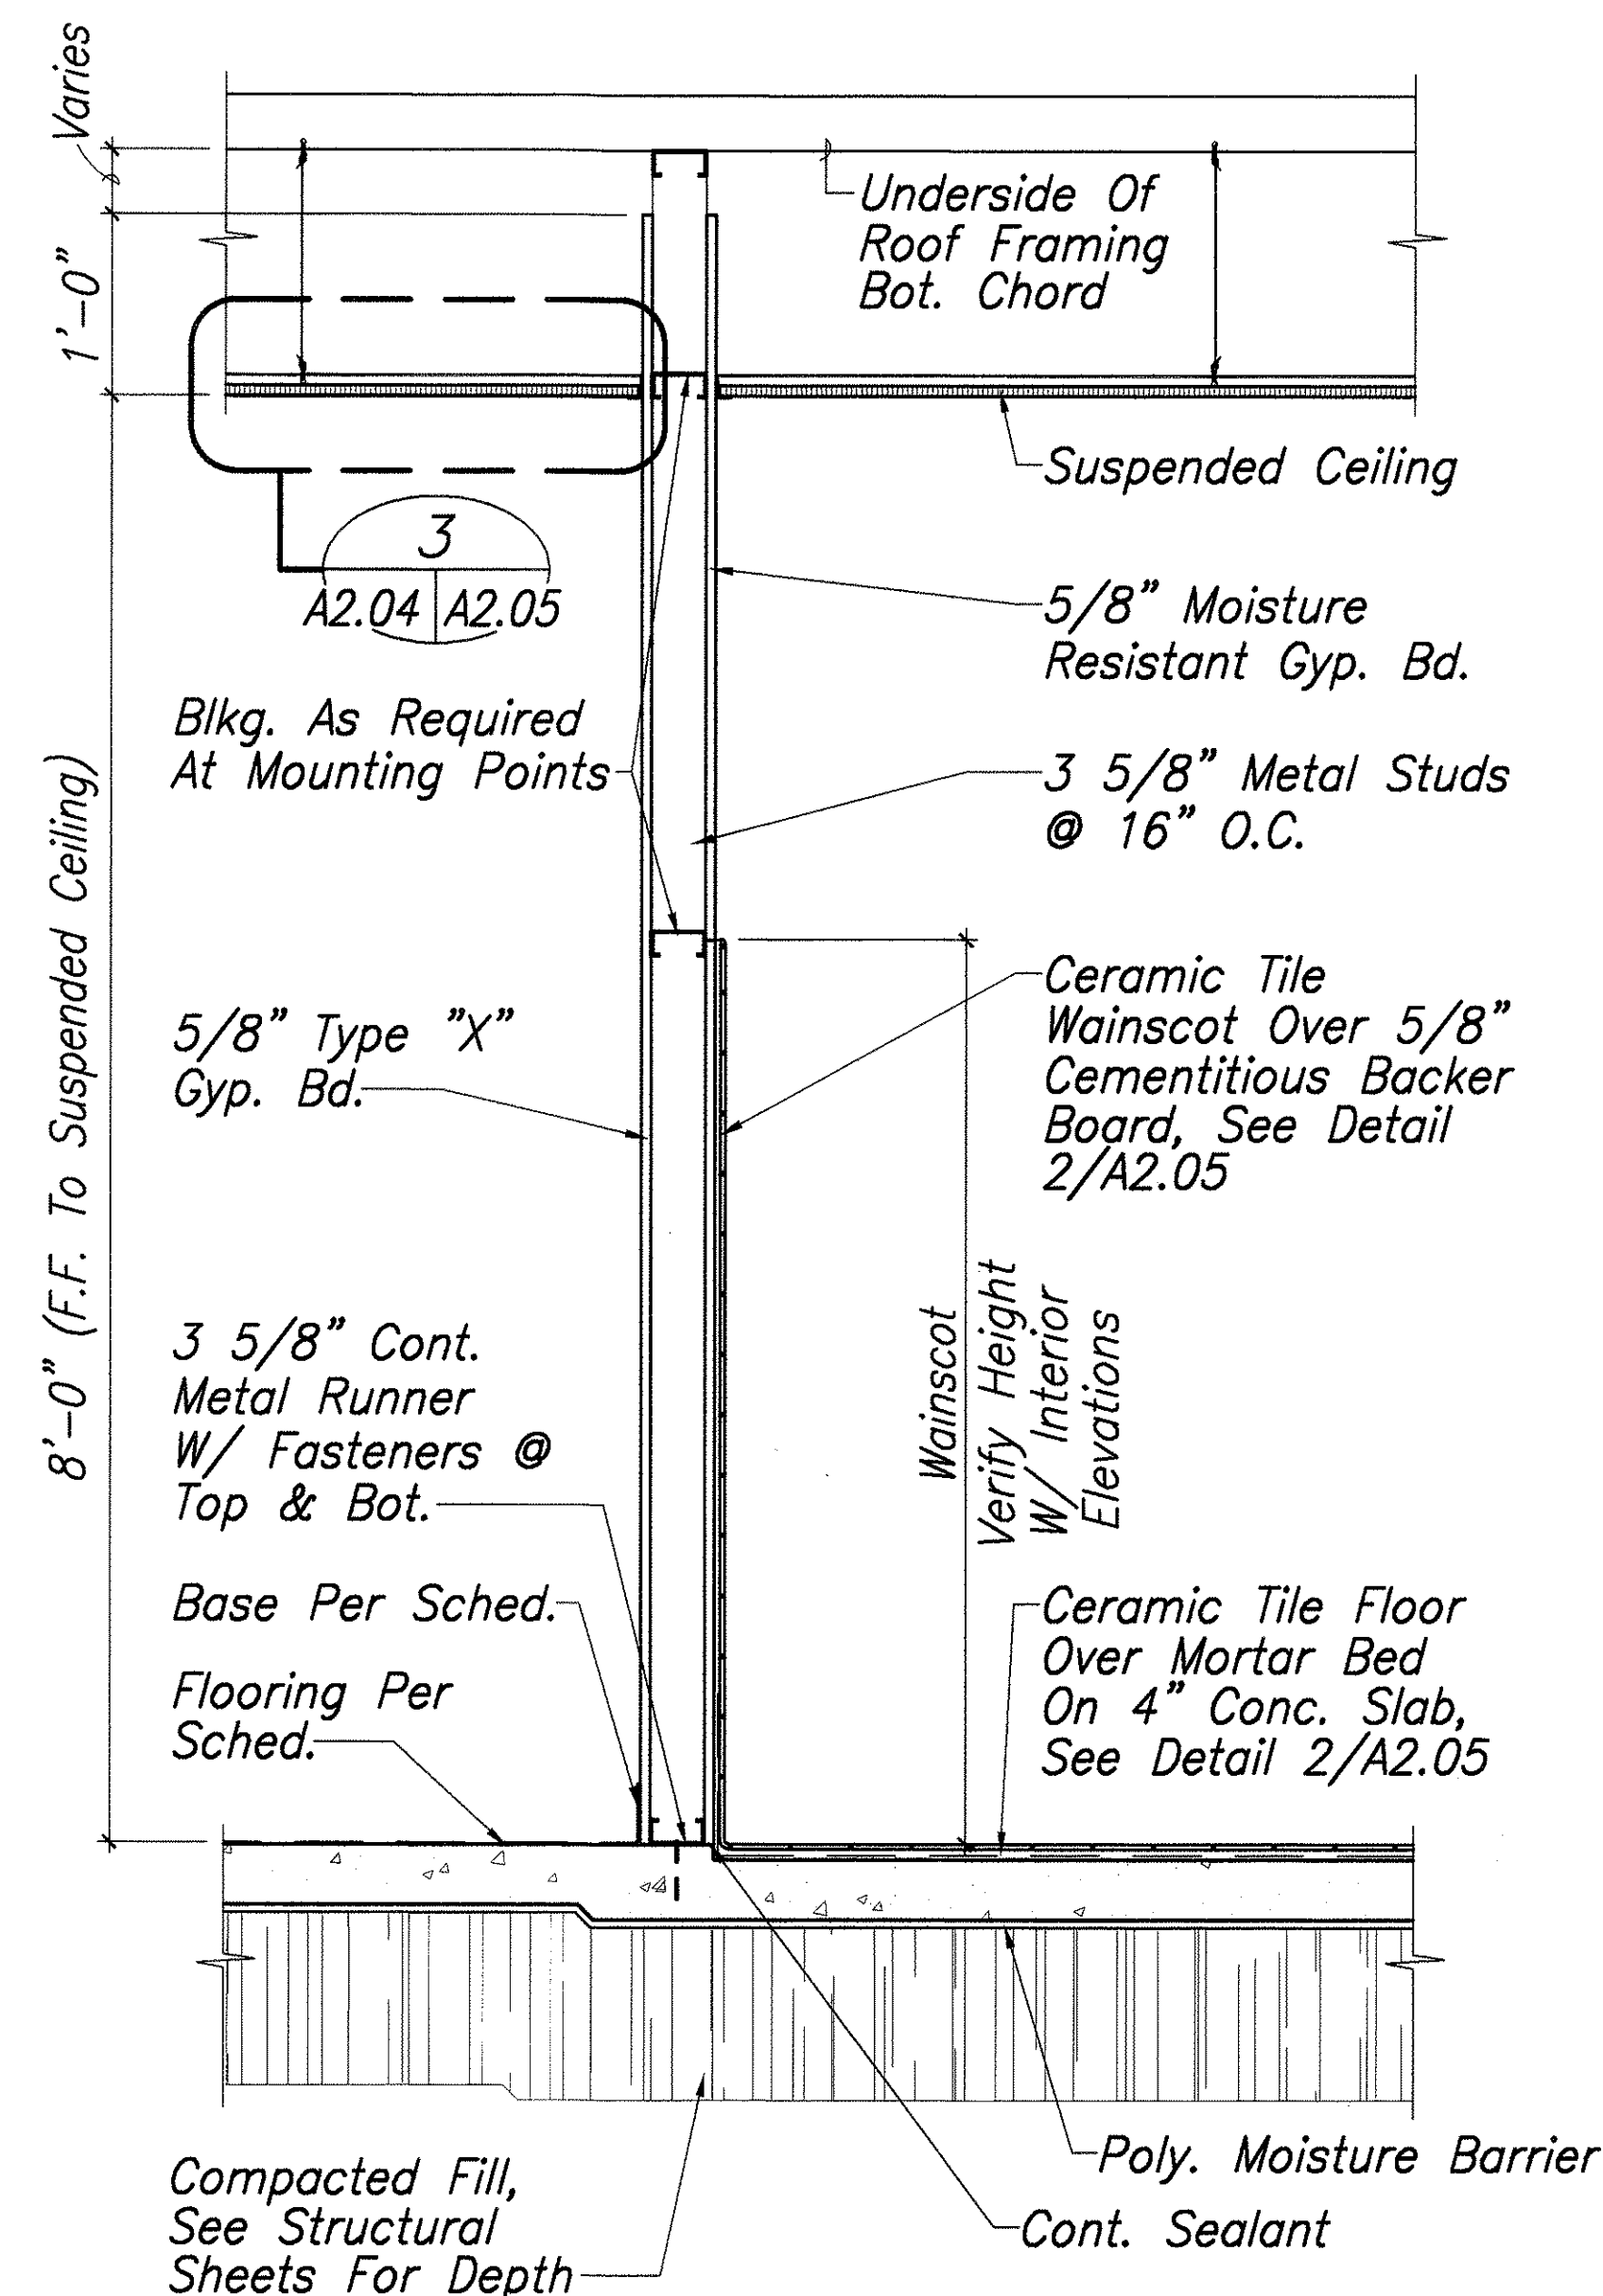

WALL SECTION 1
Scale: 1"=1'-0"
A2.03 A2.04
A2.02

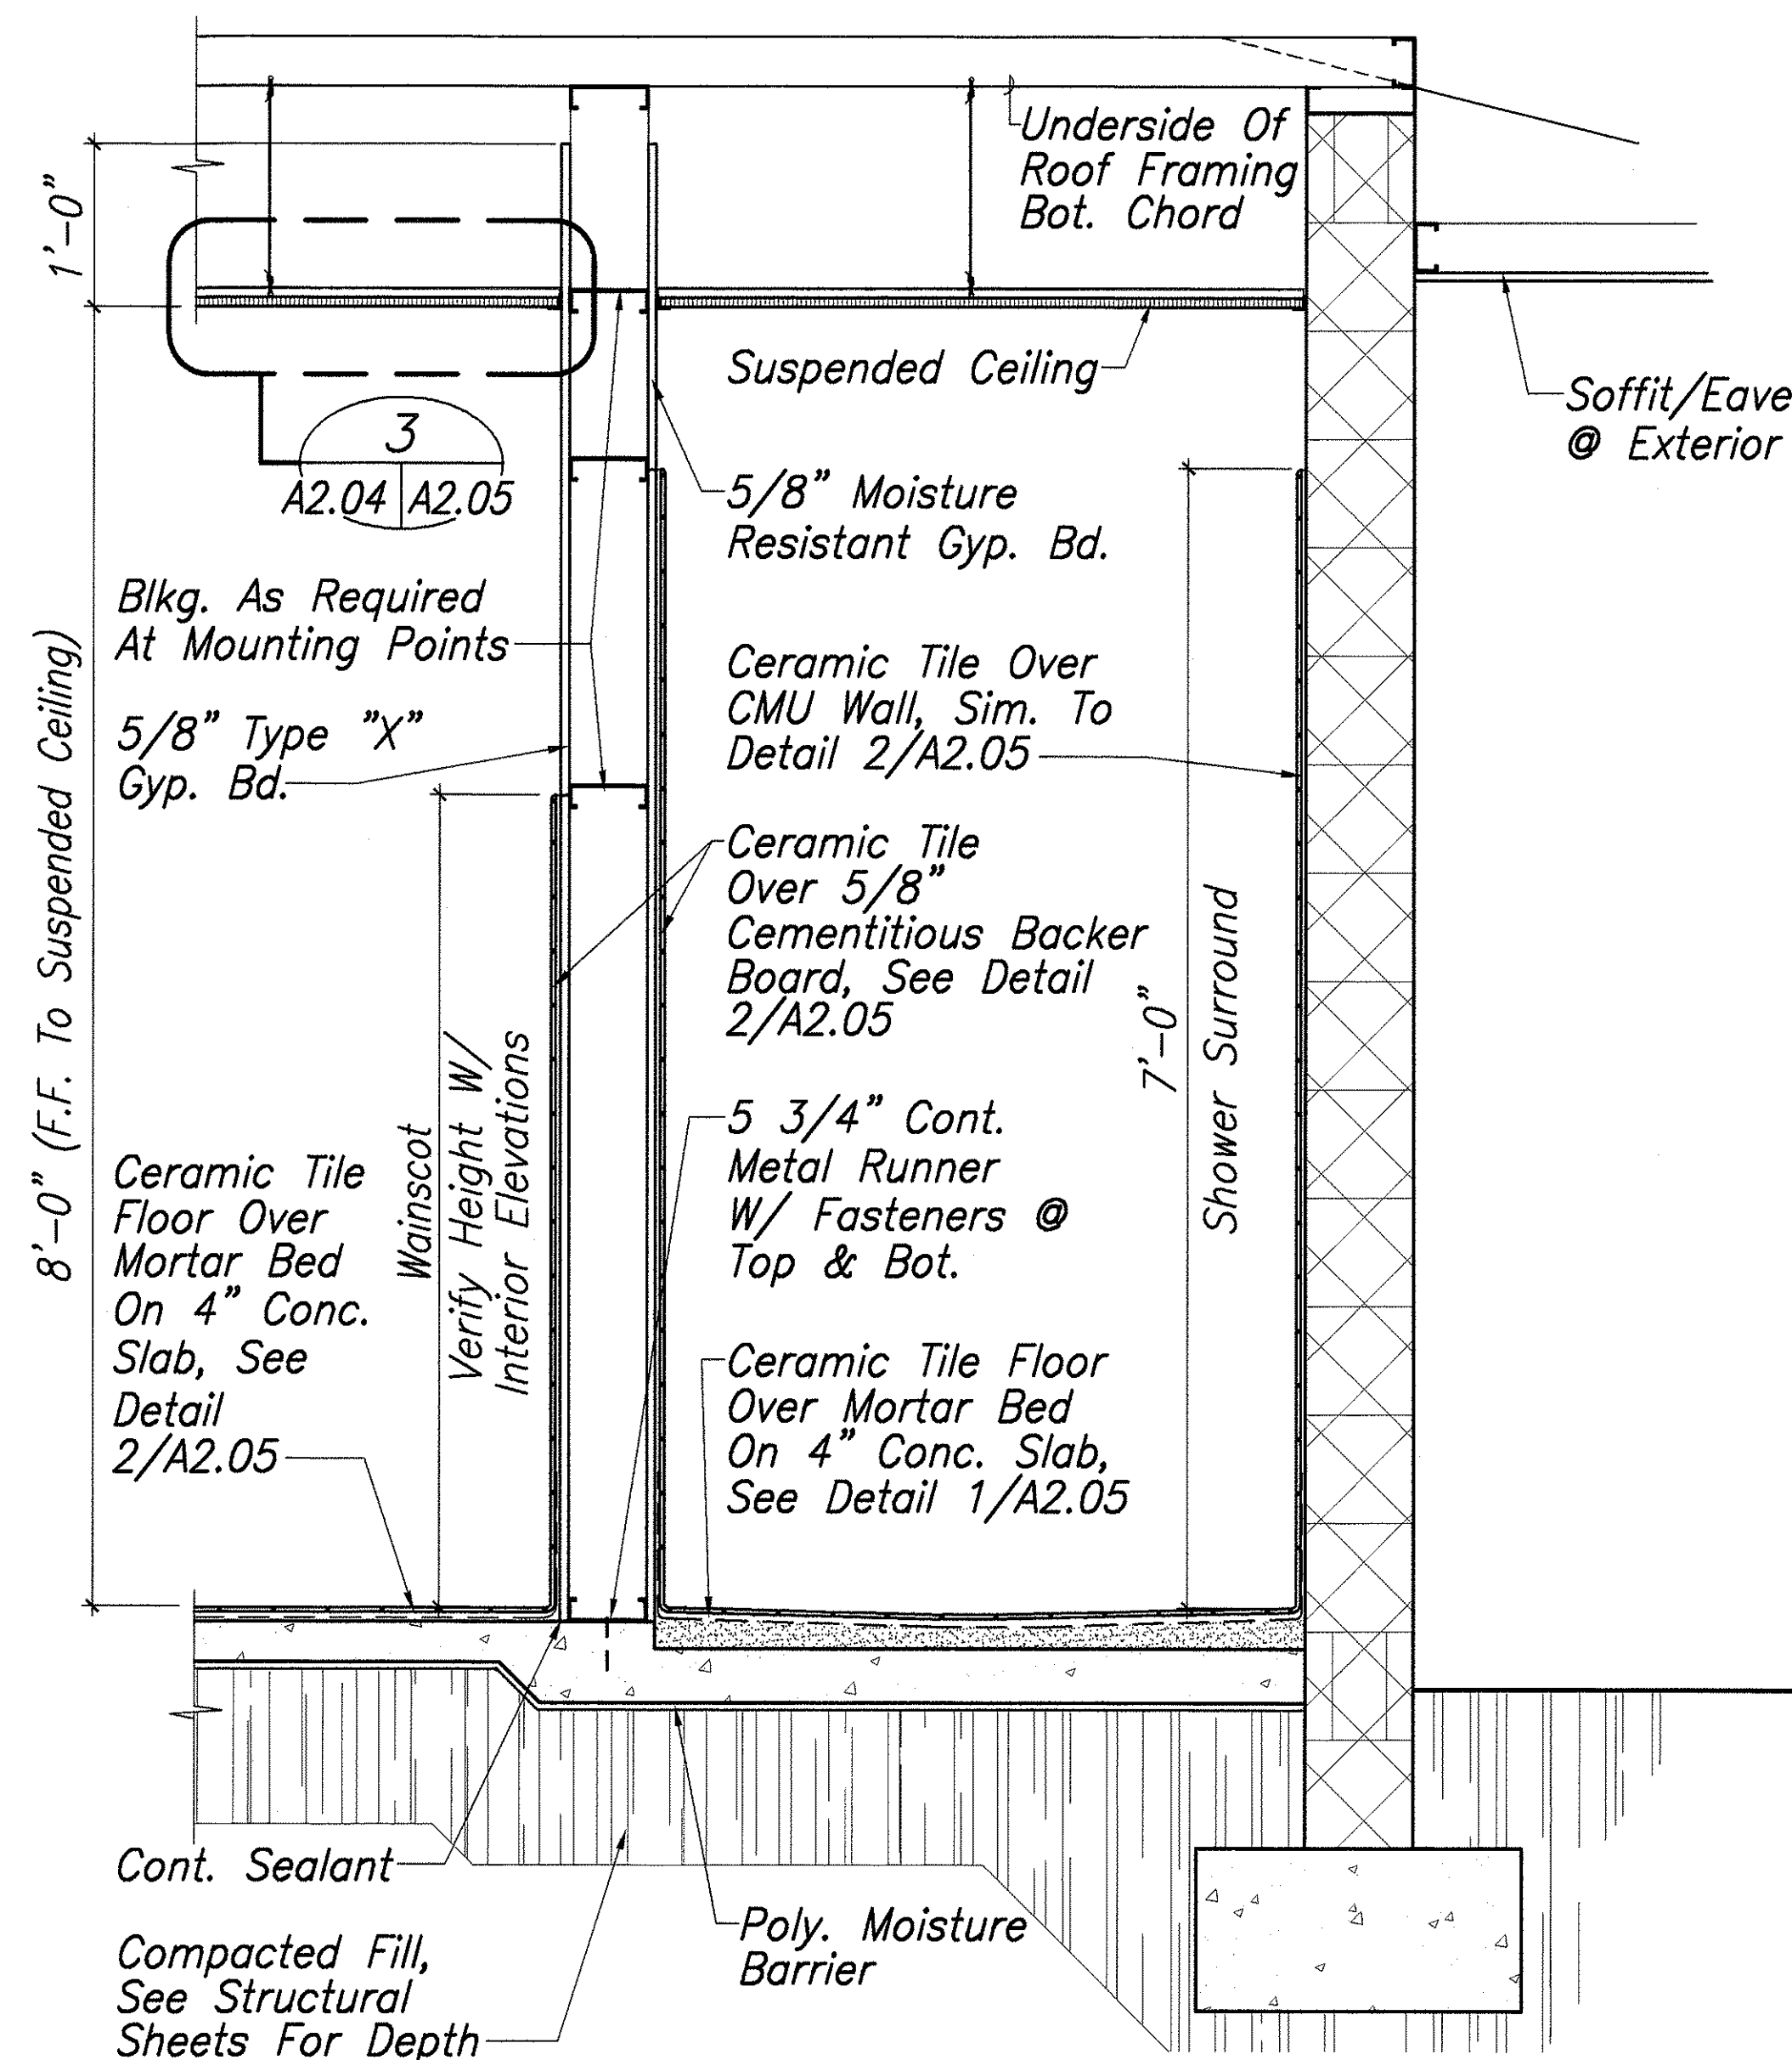


WALL SECTION 2
Scale: 1"=1'-0"
A2.00 A2.04

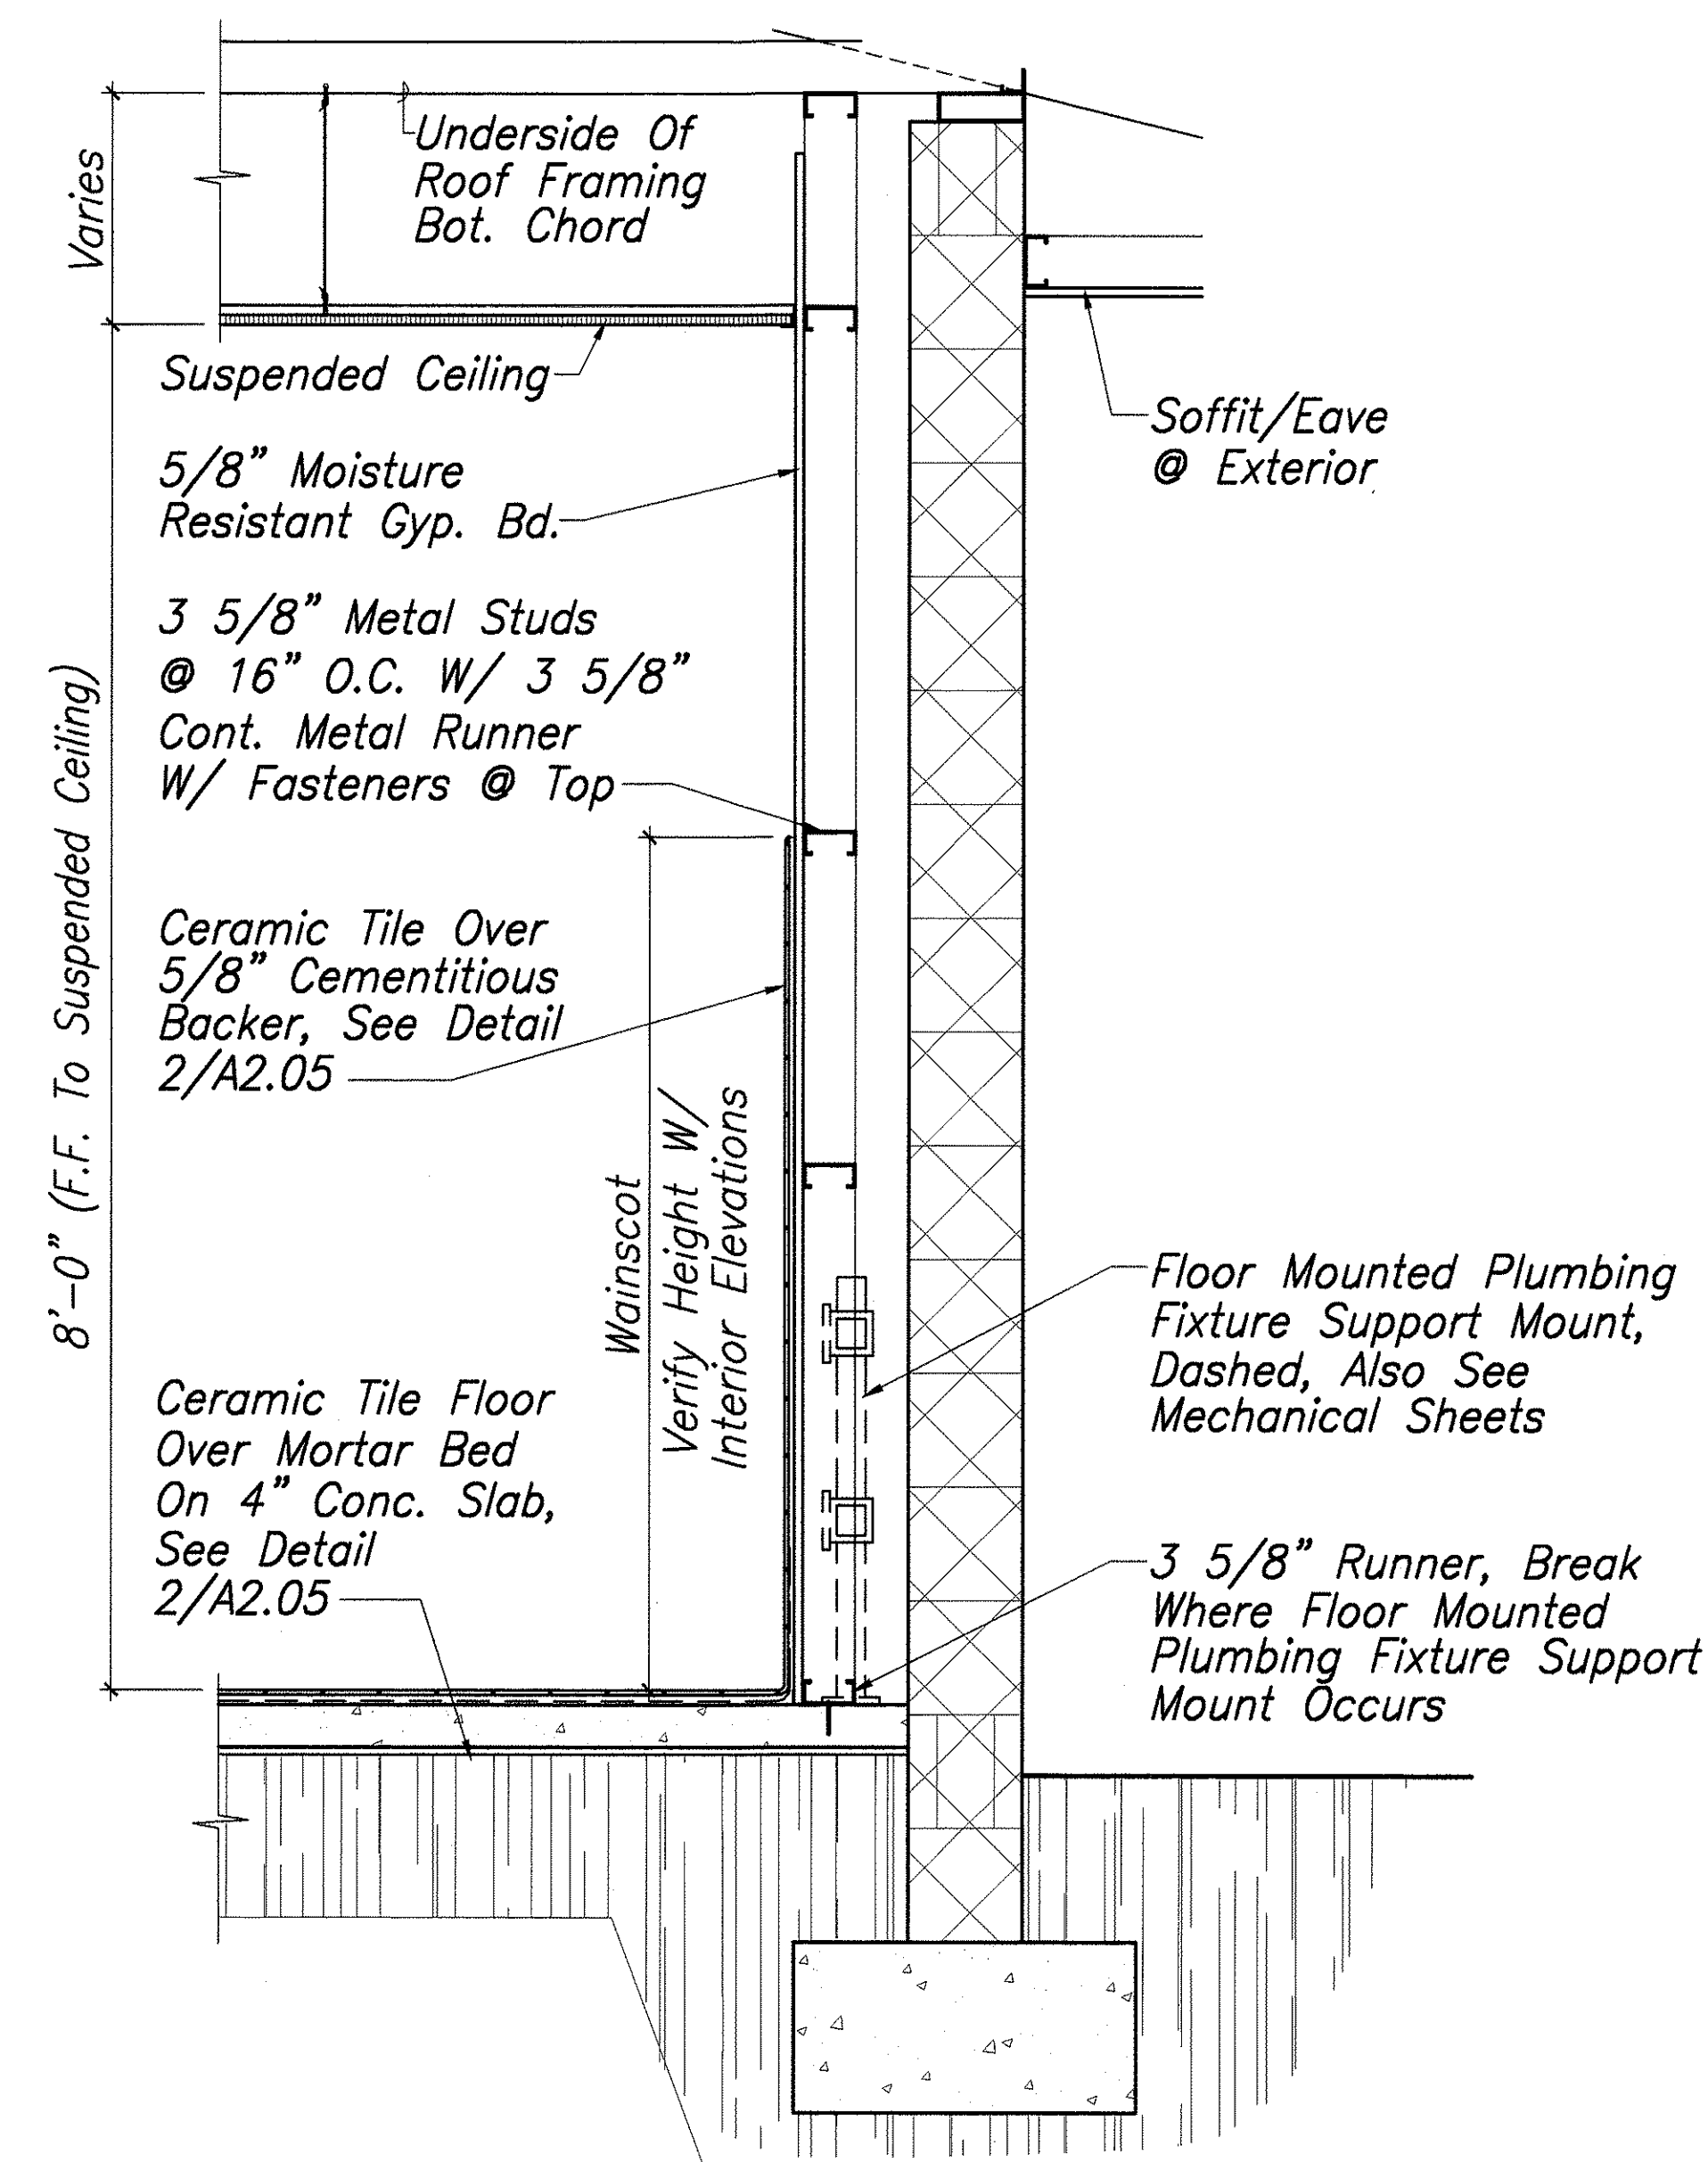

WALL SECTION 3
Scale: 1"=1'-0"
A3.08 A2.04
A2.03

SURVEY PLOTTED BY	DATE
DRAWN BY	
DESIGNED BY	
QUANTITIES BY	
CHECKED BY	
ORIGINAL PLAN	
NOTE BOOK	XX
No.	

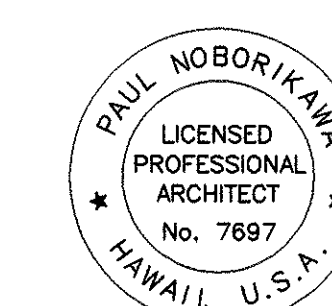

THIS WORK WAS PREPARED BY ME OR UNDER MY SUPERVISION

[Signature]

STATE OF HAWAII
DEPARTMENT OF TRANSPORTATION
HIGHWAYS DIVISION

**OFFICE BUILDING
WALL SECTIONS**


**WAIHAWA BASEYARD
IMPROVEMENTS**

Project No. HWY-0-12-00


Scale: AS SHOWN Date: JAN. 2003

SHEET No. A2.04 OF 82 SHEETS


FED. ROAD DIST. NO.	STATE	PROJ. NO.	FISCAL YEAR	SHEET NO.	TOTAL SHEETS
HAWAII	HAW.	HWY-0-12-00	2004	34	82

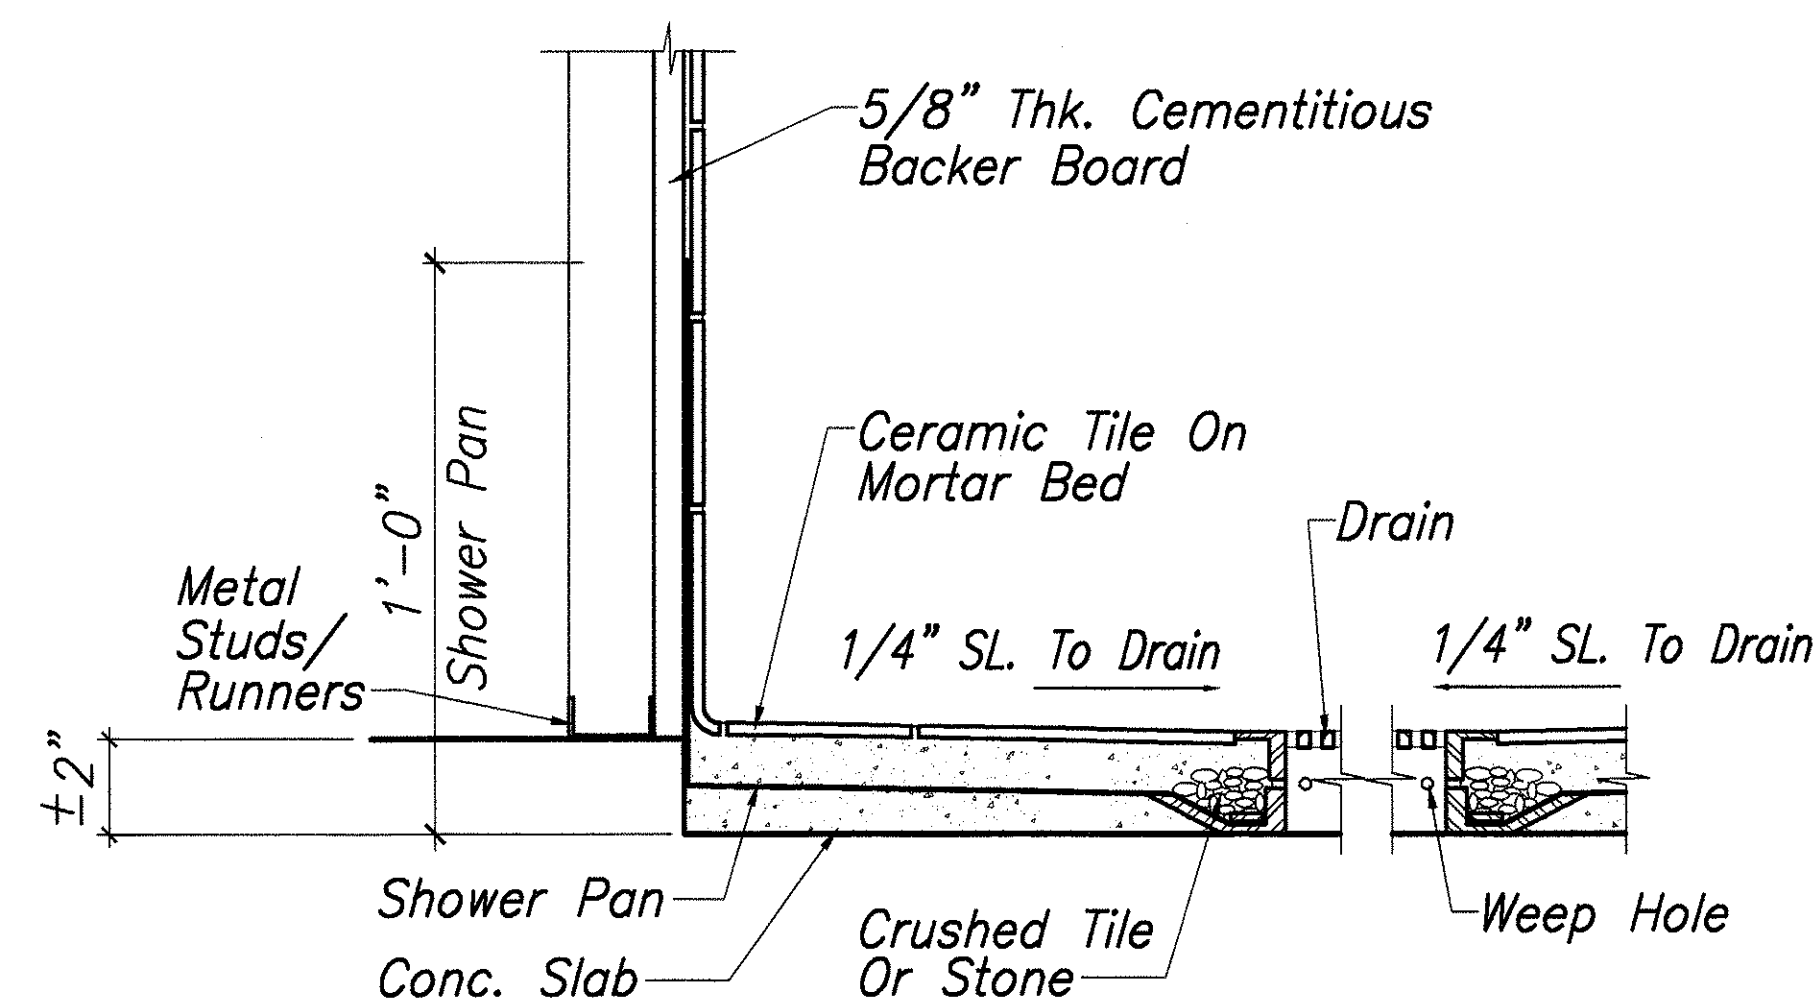

**SHOWER STALL/DRAIN/
CERAMIC TILE DETAIL** 1
Scale: 3"=1'-0" A2.04 A2.05

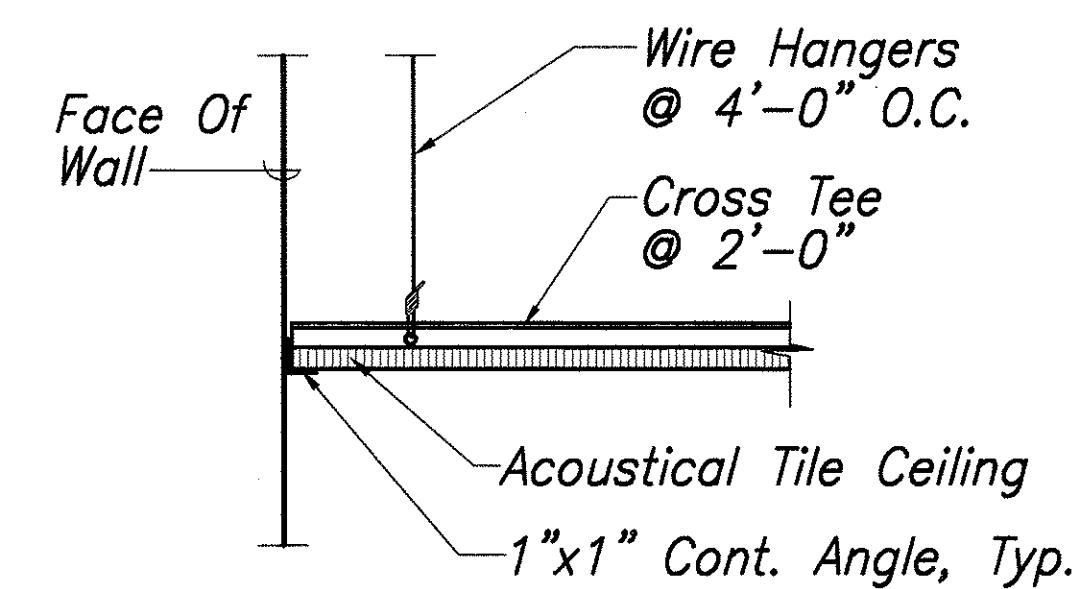


ACCOUSTICAL CEILING @ WALL

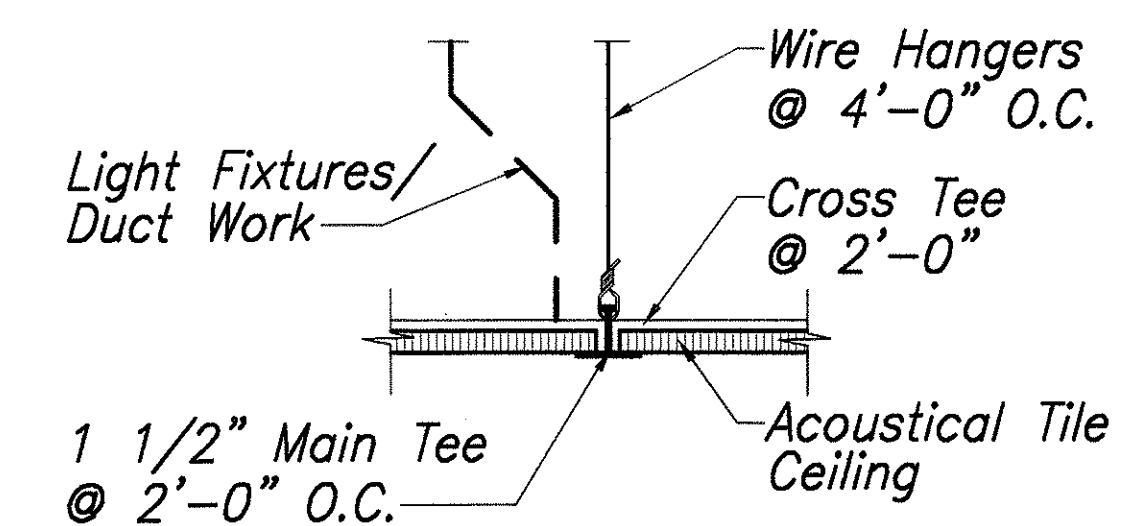


TYPICAL TEE

SUSPENDED CEILING DETAILS 3
Scale: 3"=1'-0" A2.04 A2.05

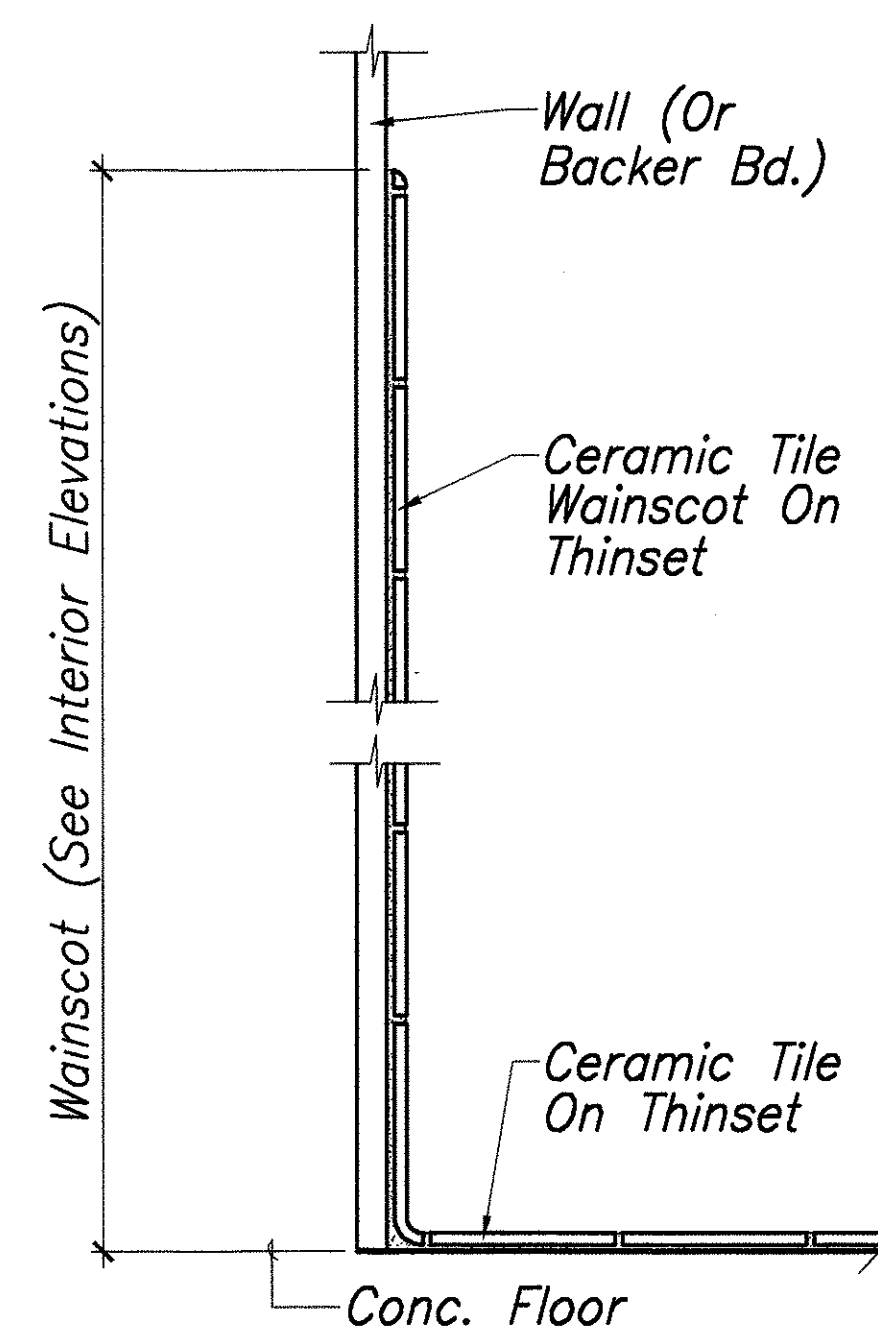

WAINSCOT DETAIL 2
Scale: 3"=1'-0" A3.08 A2.05
A2.04

ORIGINAL PLAN	DATE
NO. XX	
DESIGNED BY	
TRACED BY	
NOTED BY	
CHECKED BY	

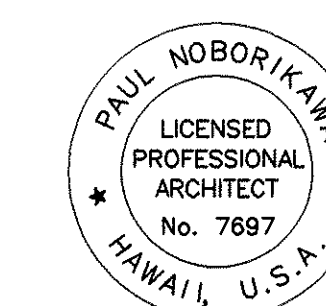


THIS WORK WAS PREPARED BY ME
OR UNDER MY SUPERVISION

[Signature]


STATE OF HAWAII
DEPARTMENT OF TRANSPORTATION
HIGHWAYS DIVISION
**OFFICE BUILDING
MISC. DETAILS**
**WAHIAWA BASEYARD
IMPROVEMENTS**
Project No. HWY-0-12-00
Scale: AS SHOWN Date: JAN. 2003
SHEET No. A2.05 OF 82 SHEETS

FED. ROAD DIST. NO.	STATE	PROJ. NO.	FISCAL YEAR	SHEET NO.	TOTAL SHEETS
HAWAII	HAW.	HWY-0-12-00	2004	35	82

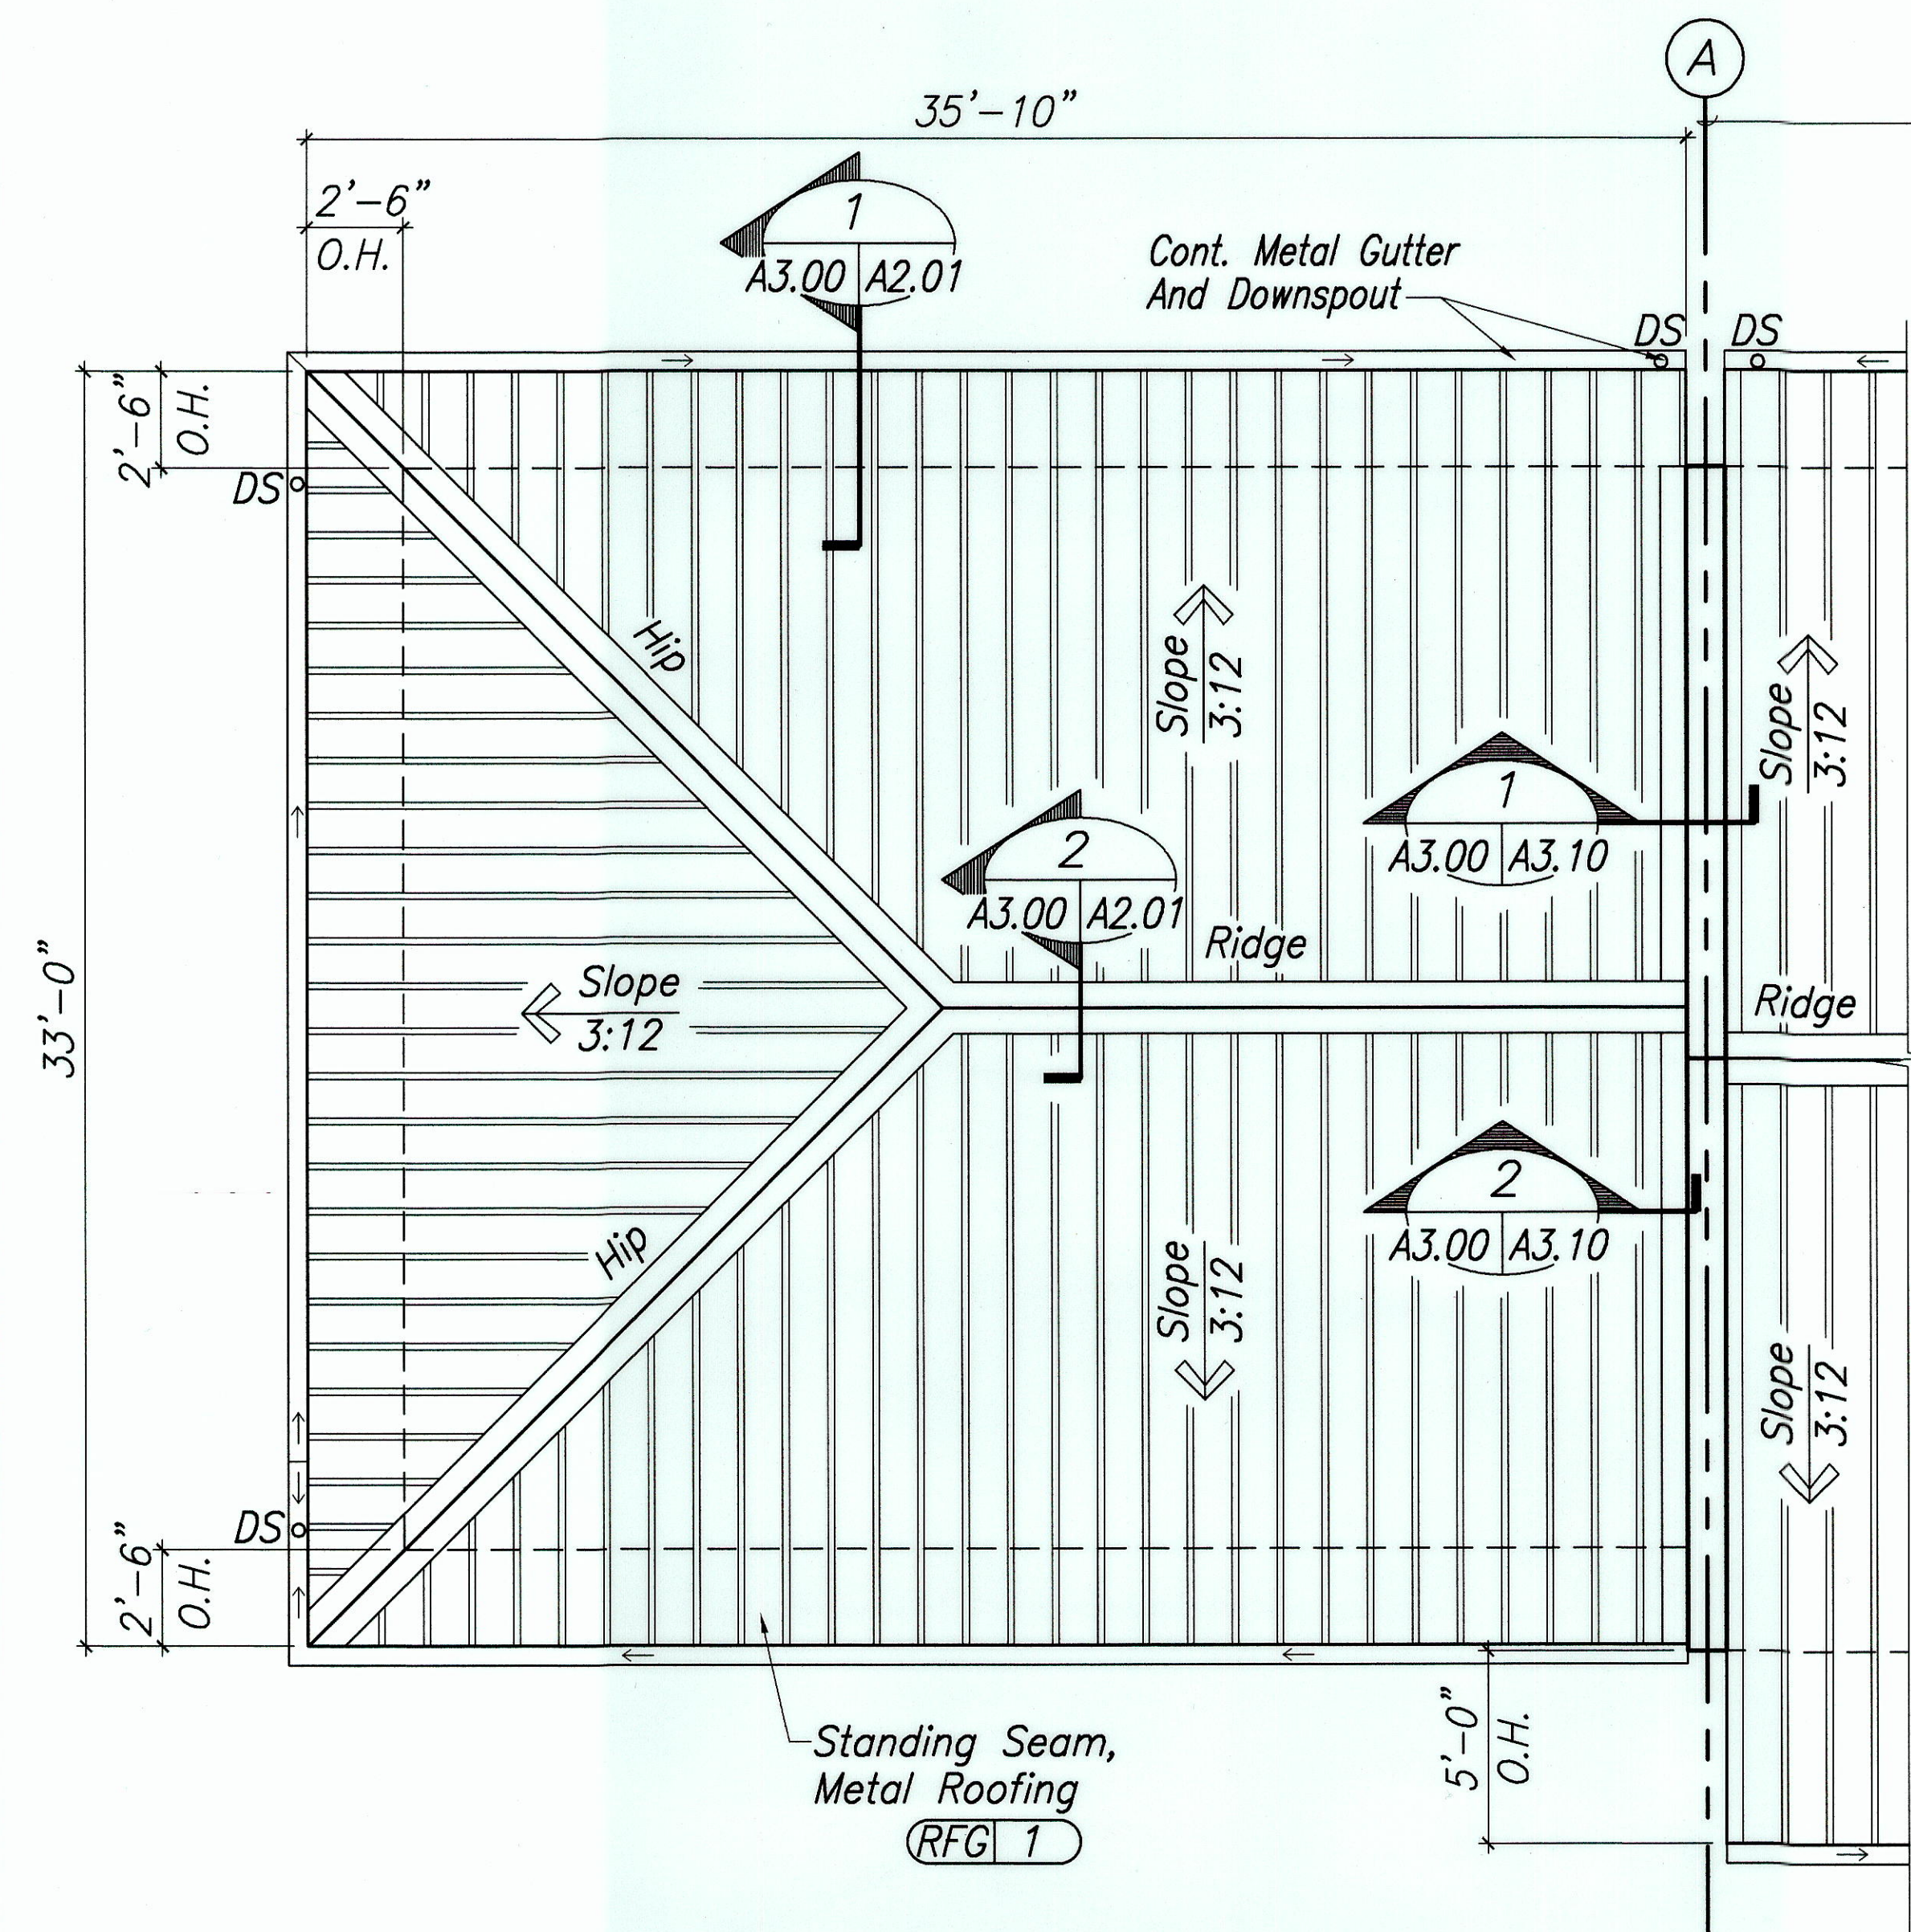


PARTIAL ROOF PLAN
Scale: 1/4"=1'-0"

- 8" Split Face CMU Wall
- 12" Split Face CMU Wall
- 6" CMU Partition

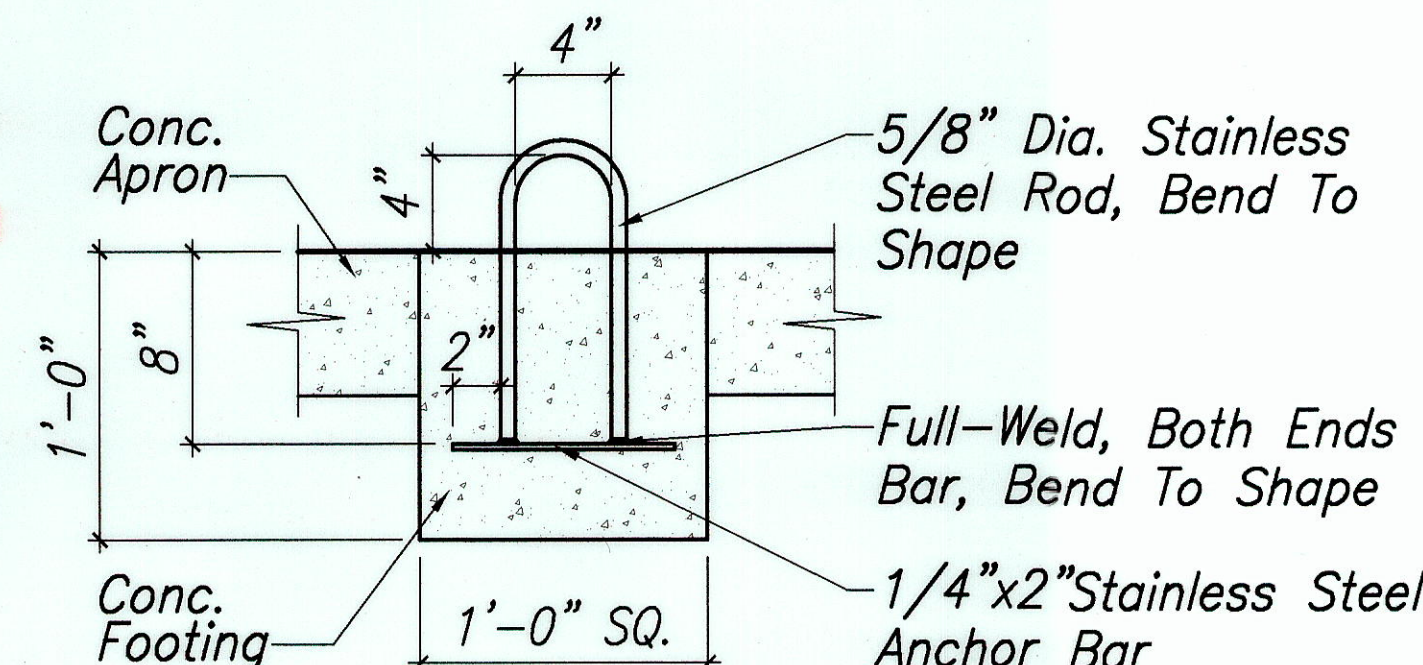


ANCHOR DETAIL
Scale: 1 1/2"=1'-0"

Match Line, See Sheet A3.02 For Balance Of Floor Plan

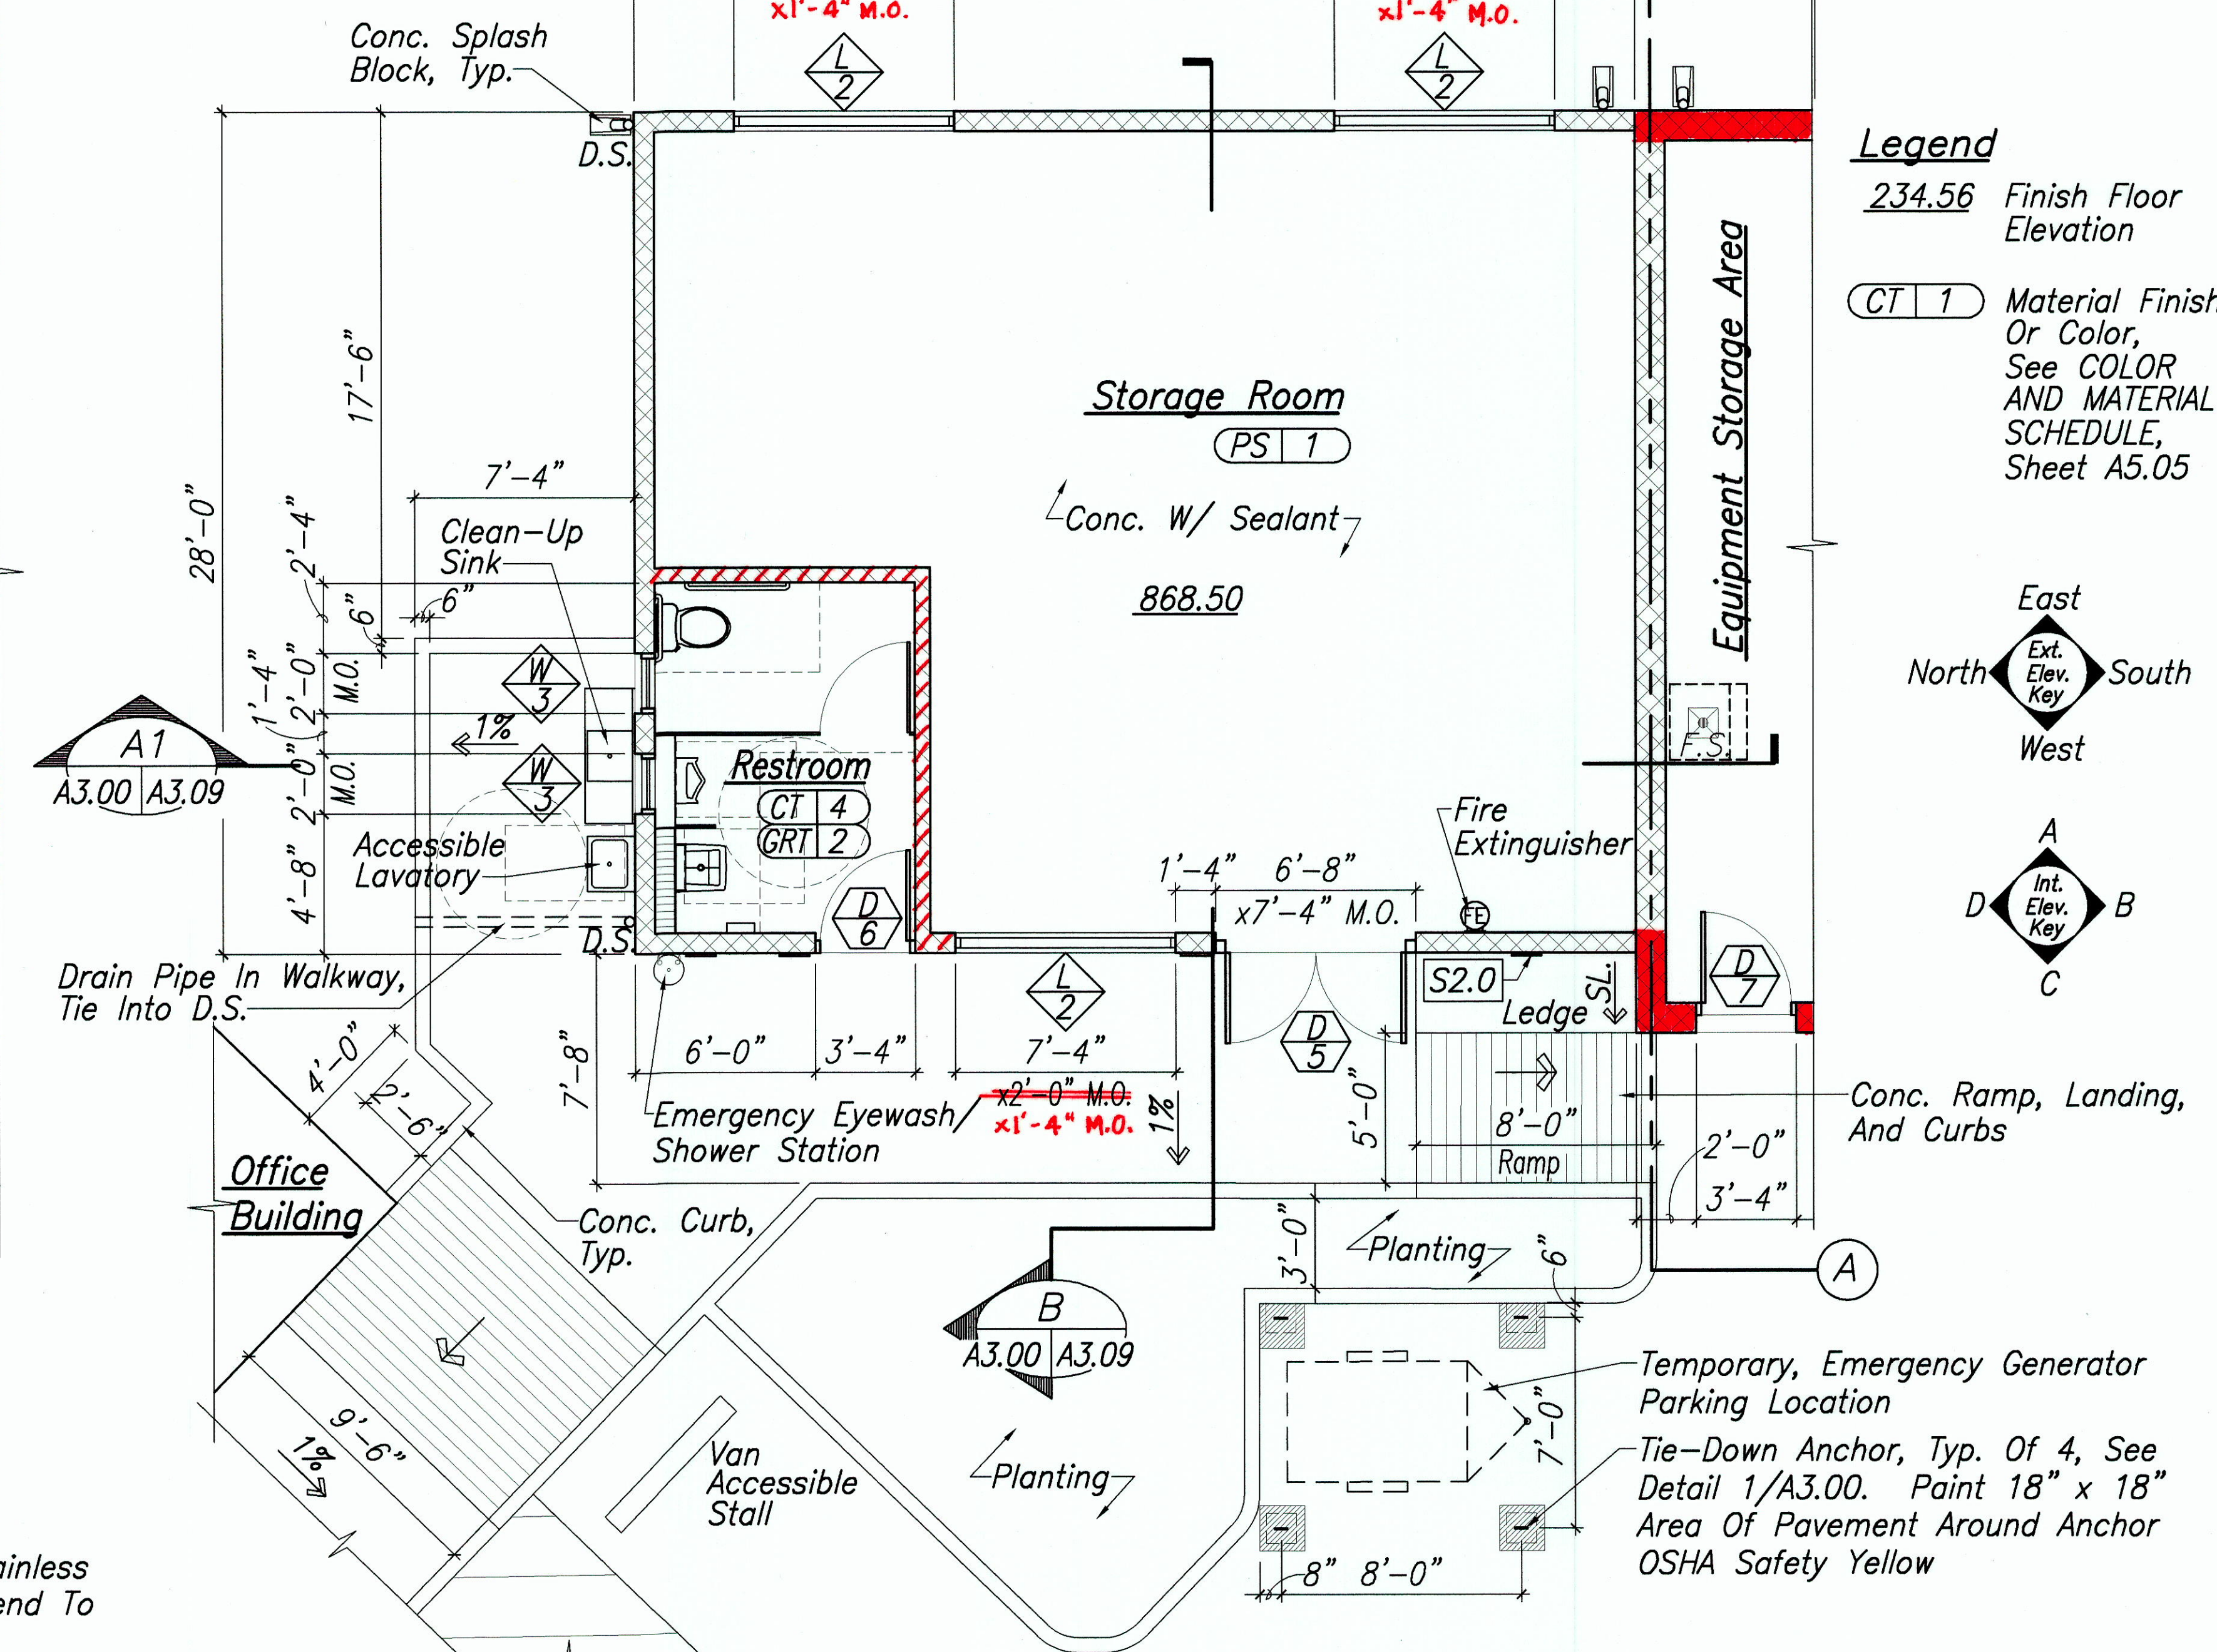


PARTIAL FLOOR PLAN
Scale: 1/4"=1'-0"

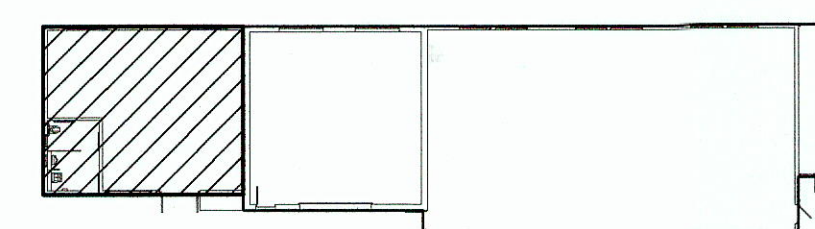

KEY PLAN
Scale: 1/32"=1'-0"

- Legend**
- 234.56 Finish Floor Elevation
 - CT 1 Material Finish Or Color, See COLOR AND MATERIAL SCHEDULE, Sheet A5.05

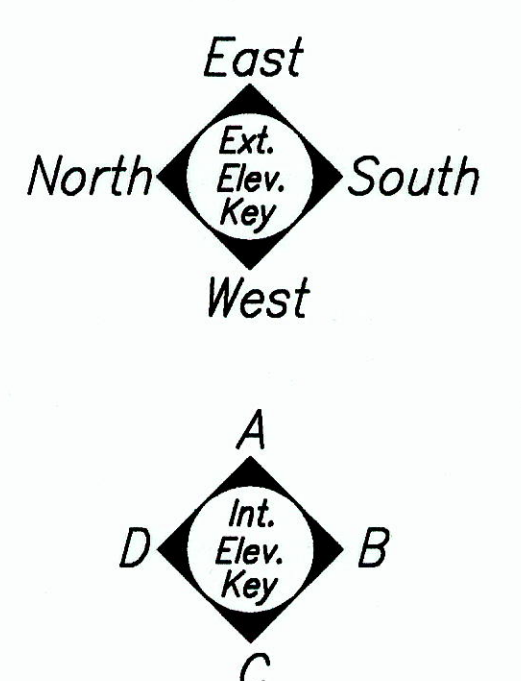

Conc. Ramp, Landing, And Curbs

Temporary, Emergency Generator Parking Location
Tie-Down Anchor, Typ. Of 4, See Detail 1/A3.00. Paint 18" x 18" Area Of Pavement Around Anchor OSHA Safety Yellow



THIS WORK WAS PREPARED BY ME OR UNDER MY SUPERVISION


STATE OF HAWAII
DEPARTMENT OF TRANSPORTATION
HIGHWAYS DIVISION

**GARAGE/STORAGE BUILDING
PARTIAL FLOOR & ROOF PLAN**

WAIHAWA BASEYARD
IMPROVEMENTS
Project No. HWY-0-12-00
Scale: AS SHOWN Date: JAN. 2003
SHEET No. A3.00 OF 82 SHEETS


"AS-BUILT"

FED. ROAD DIST. NO.	STATE	PROJ. NO.	FISCAL YEAR	SHEET NO.	TOTAL SHEETS
HAWAII	HAW.	HWY-0-12-00	2003	37	82

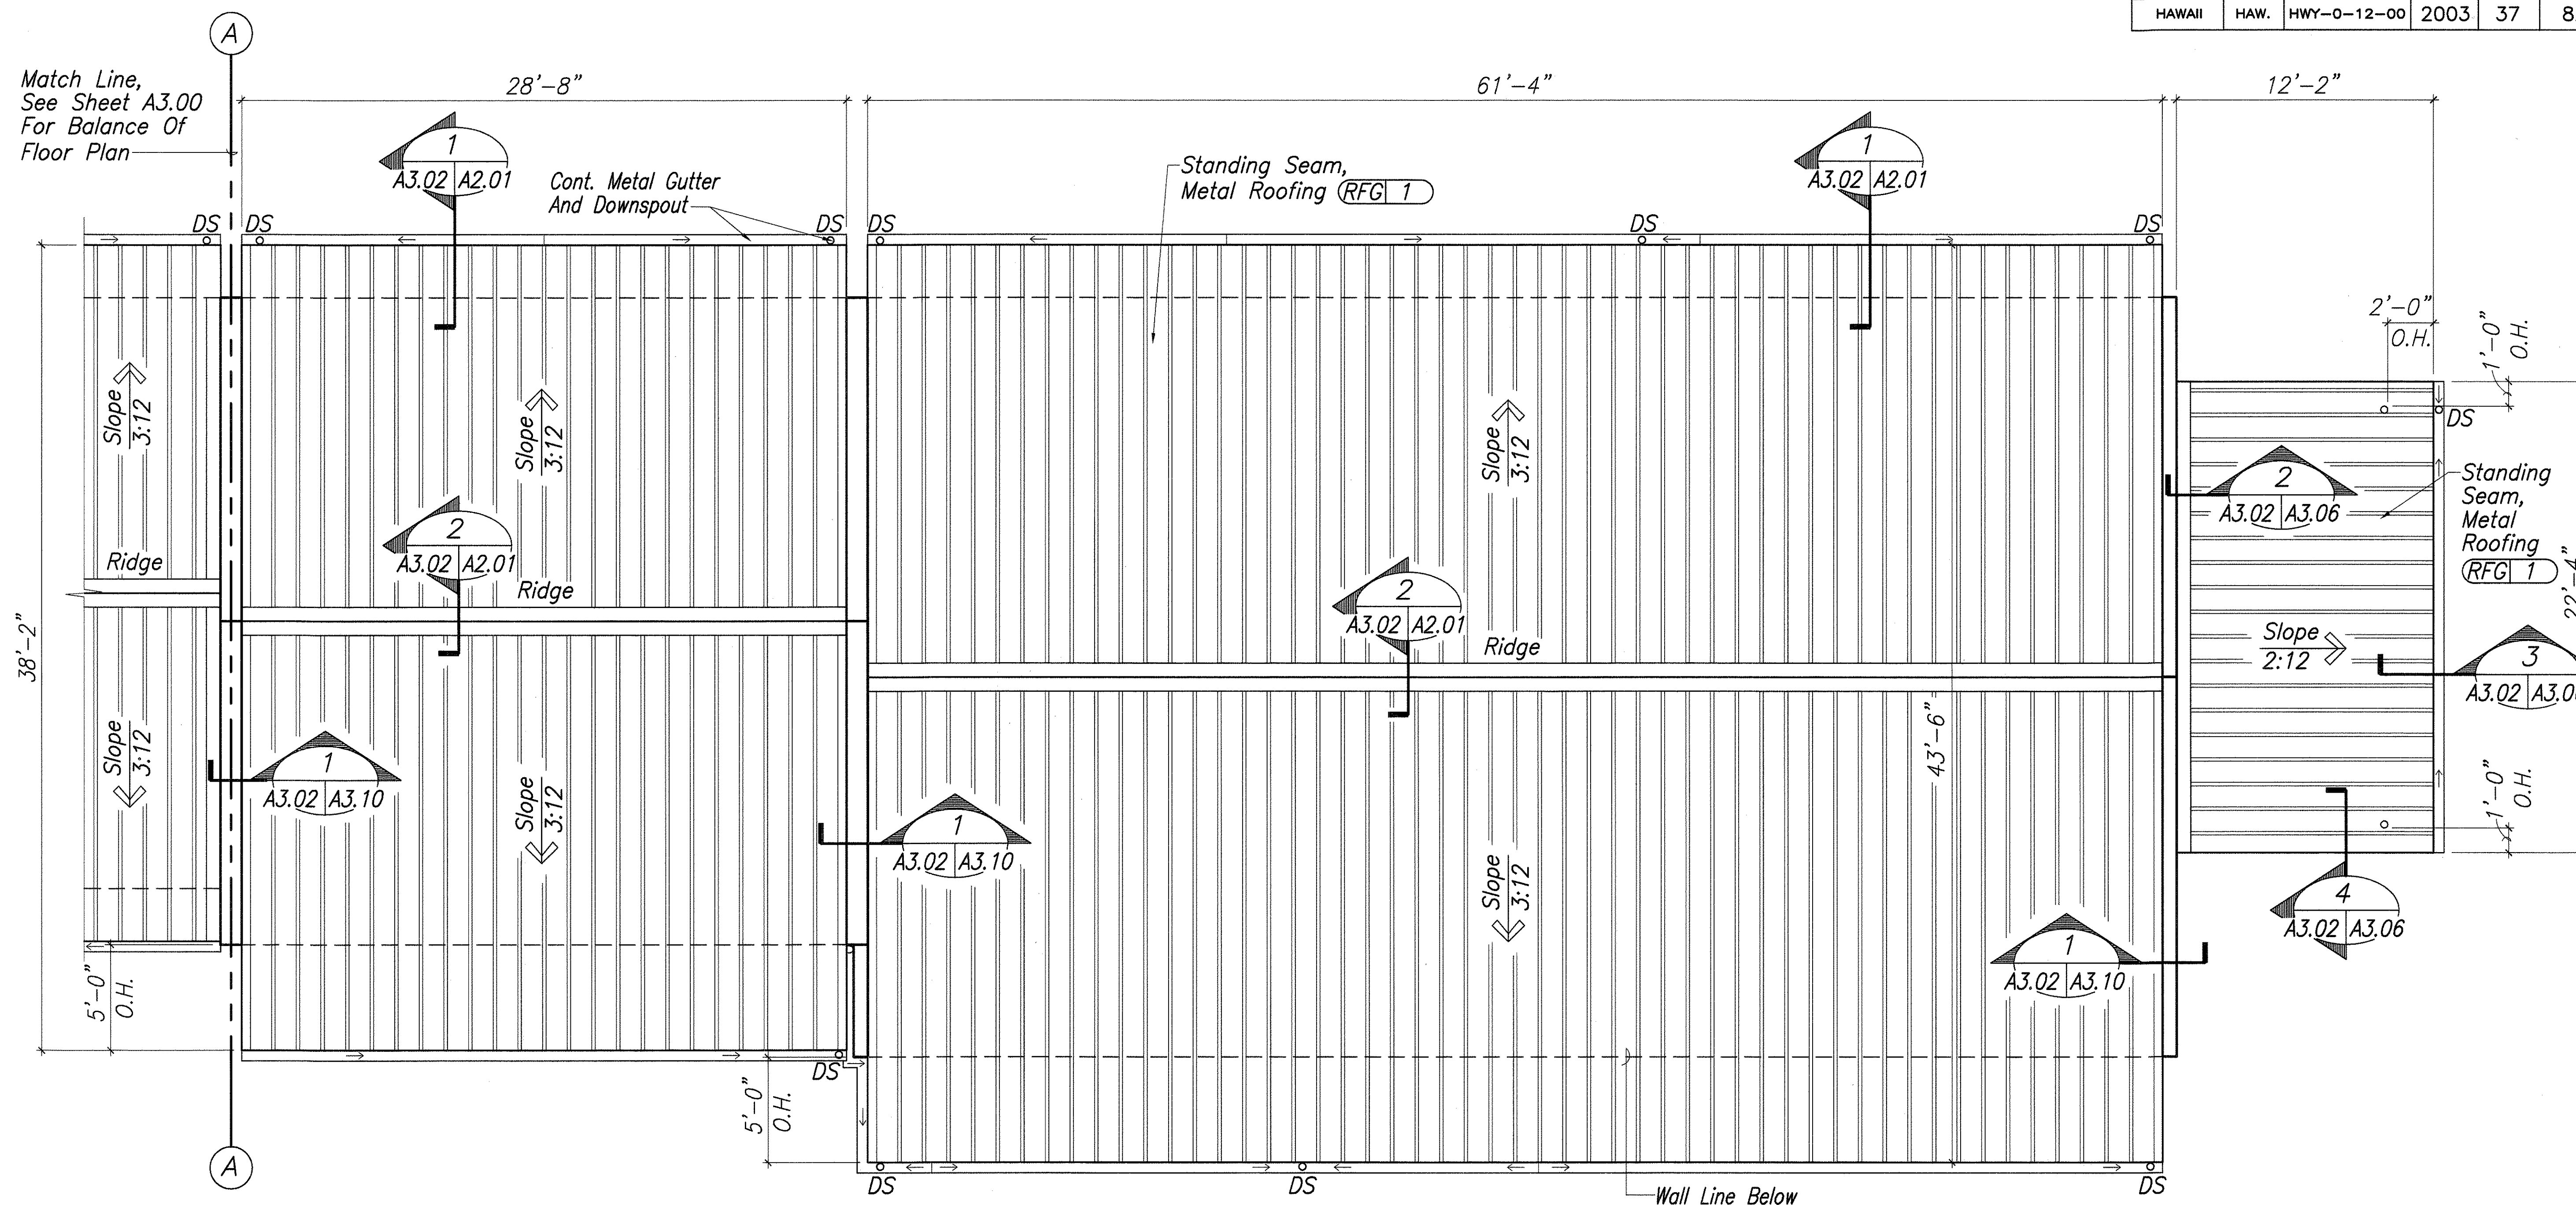


PARTIAL ROOF PLAN
Scale: 1/4"=1'-0"
A3.02 A3.02

Legend
CT 1 Material Finish Or Color,
See COLOR AND MATERIAL
SCHEDULE, Sheet A5.05

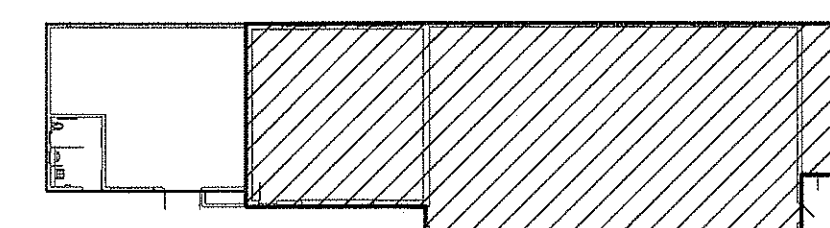


KEY PLAN
Scale: 1/32"=1'-0"

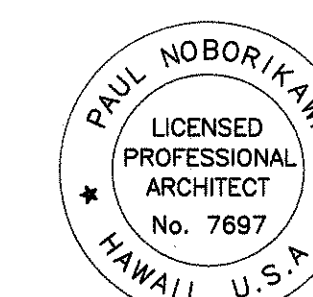


THIS WORK WAS PREPARED BY ME
OR UNDER MY SUPERVISION

6/22/04	Revisions Per DPP Comments
DATE	REVISION
STATE OF HAWAII DEPARTMENT OF TRANSPORTATION HIGHWAYS DIVISION	
GARAGE/STORAGE BUILDING	
PARTIAL ROOF PLAN	
WAHIAWA BASEYARD IMPROVEMENTS	
Project No. HWY-0-12-00	
Scale: AS SHOWN	Date: JAN. 2003
SHEET No. A3.02 OF 82 SHEETS	

FED. ROAD DIST. NO.	STATE	PROJ. NO.	FISCAL YEAR	SHEET NO.	TOTAL SHEETS
HAWAII	HAW.	HWY-0-12-00	2003	38	82

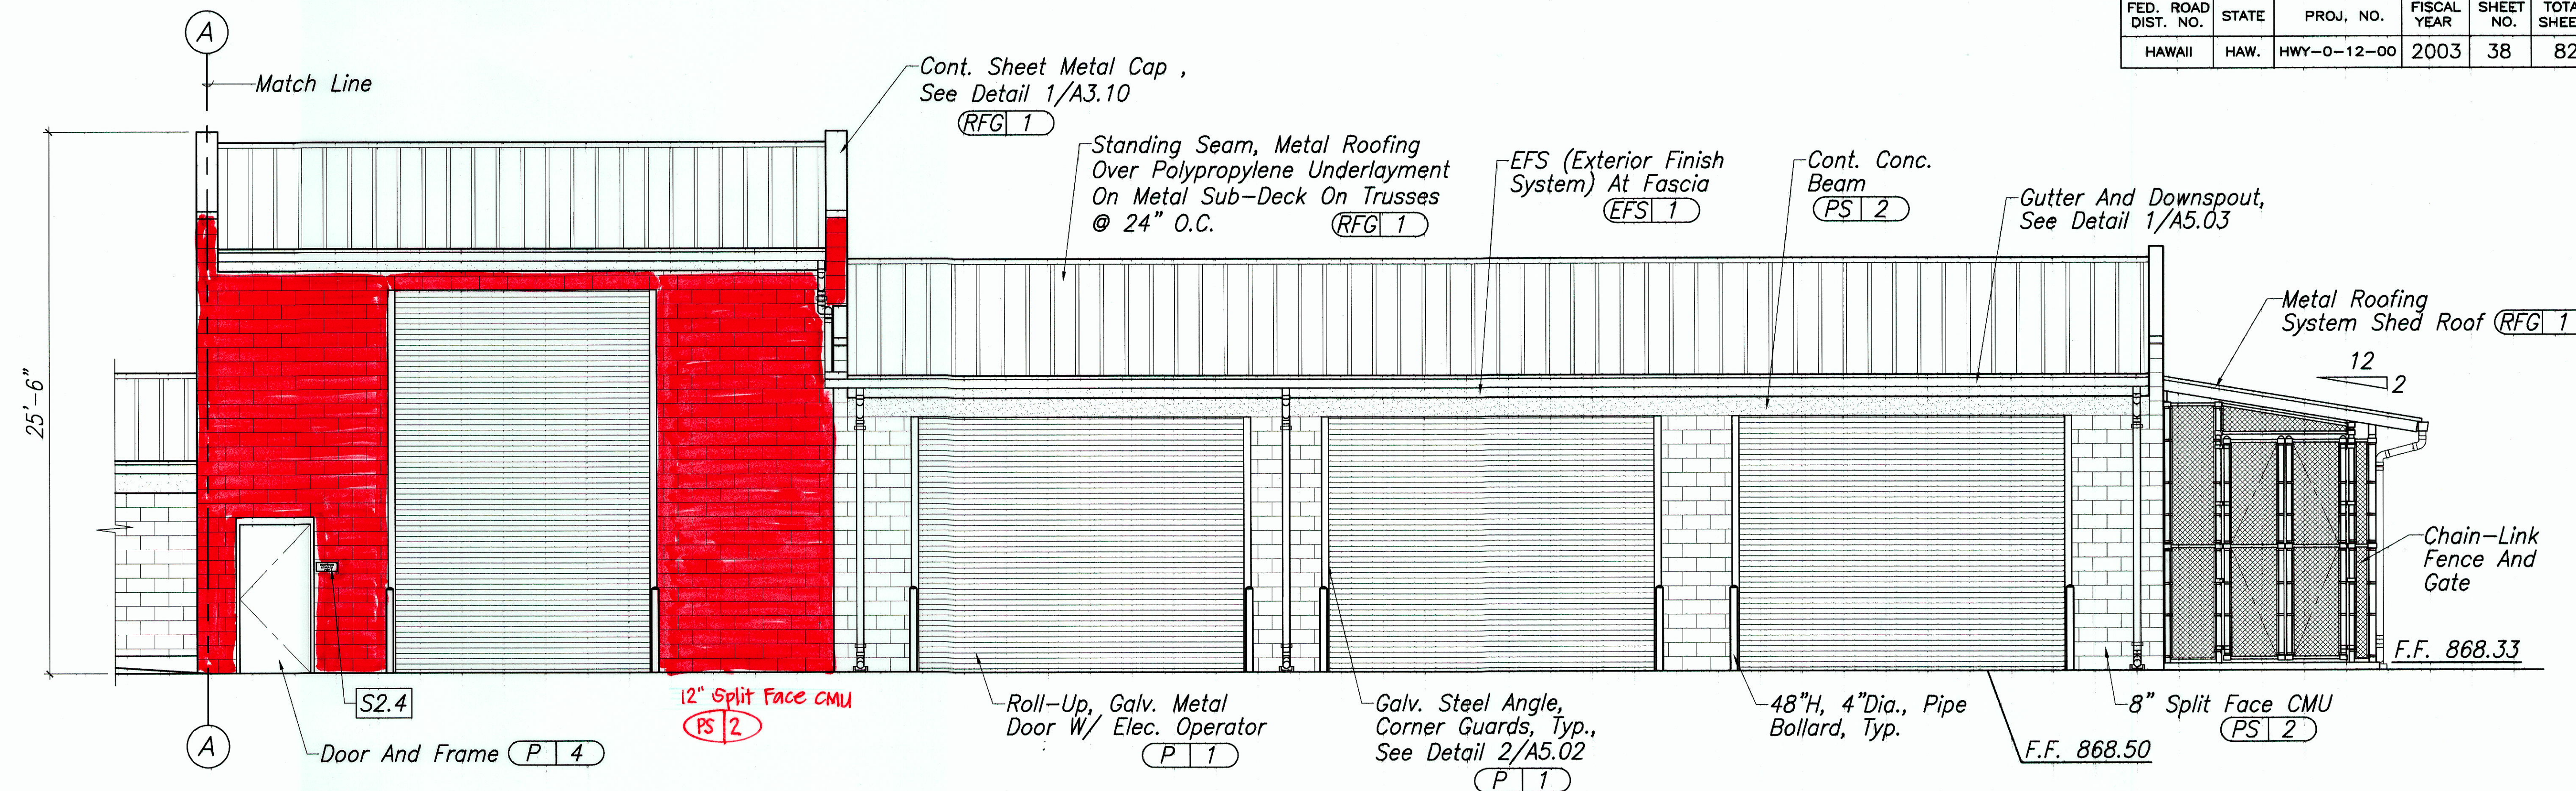

PARTIAL WEST ELEVATION
Scale: 1/4"=1'-0"

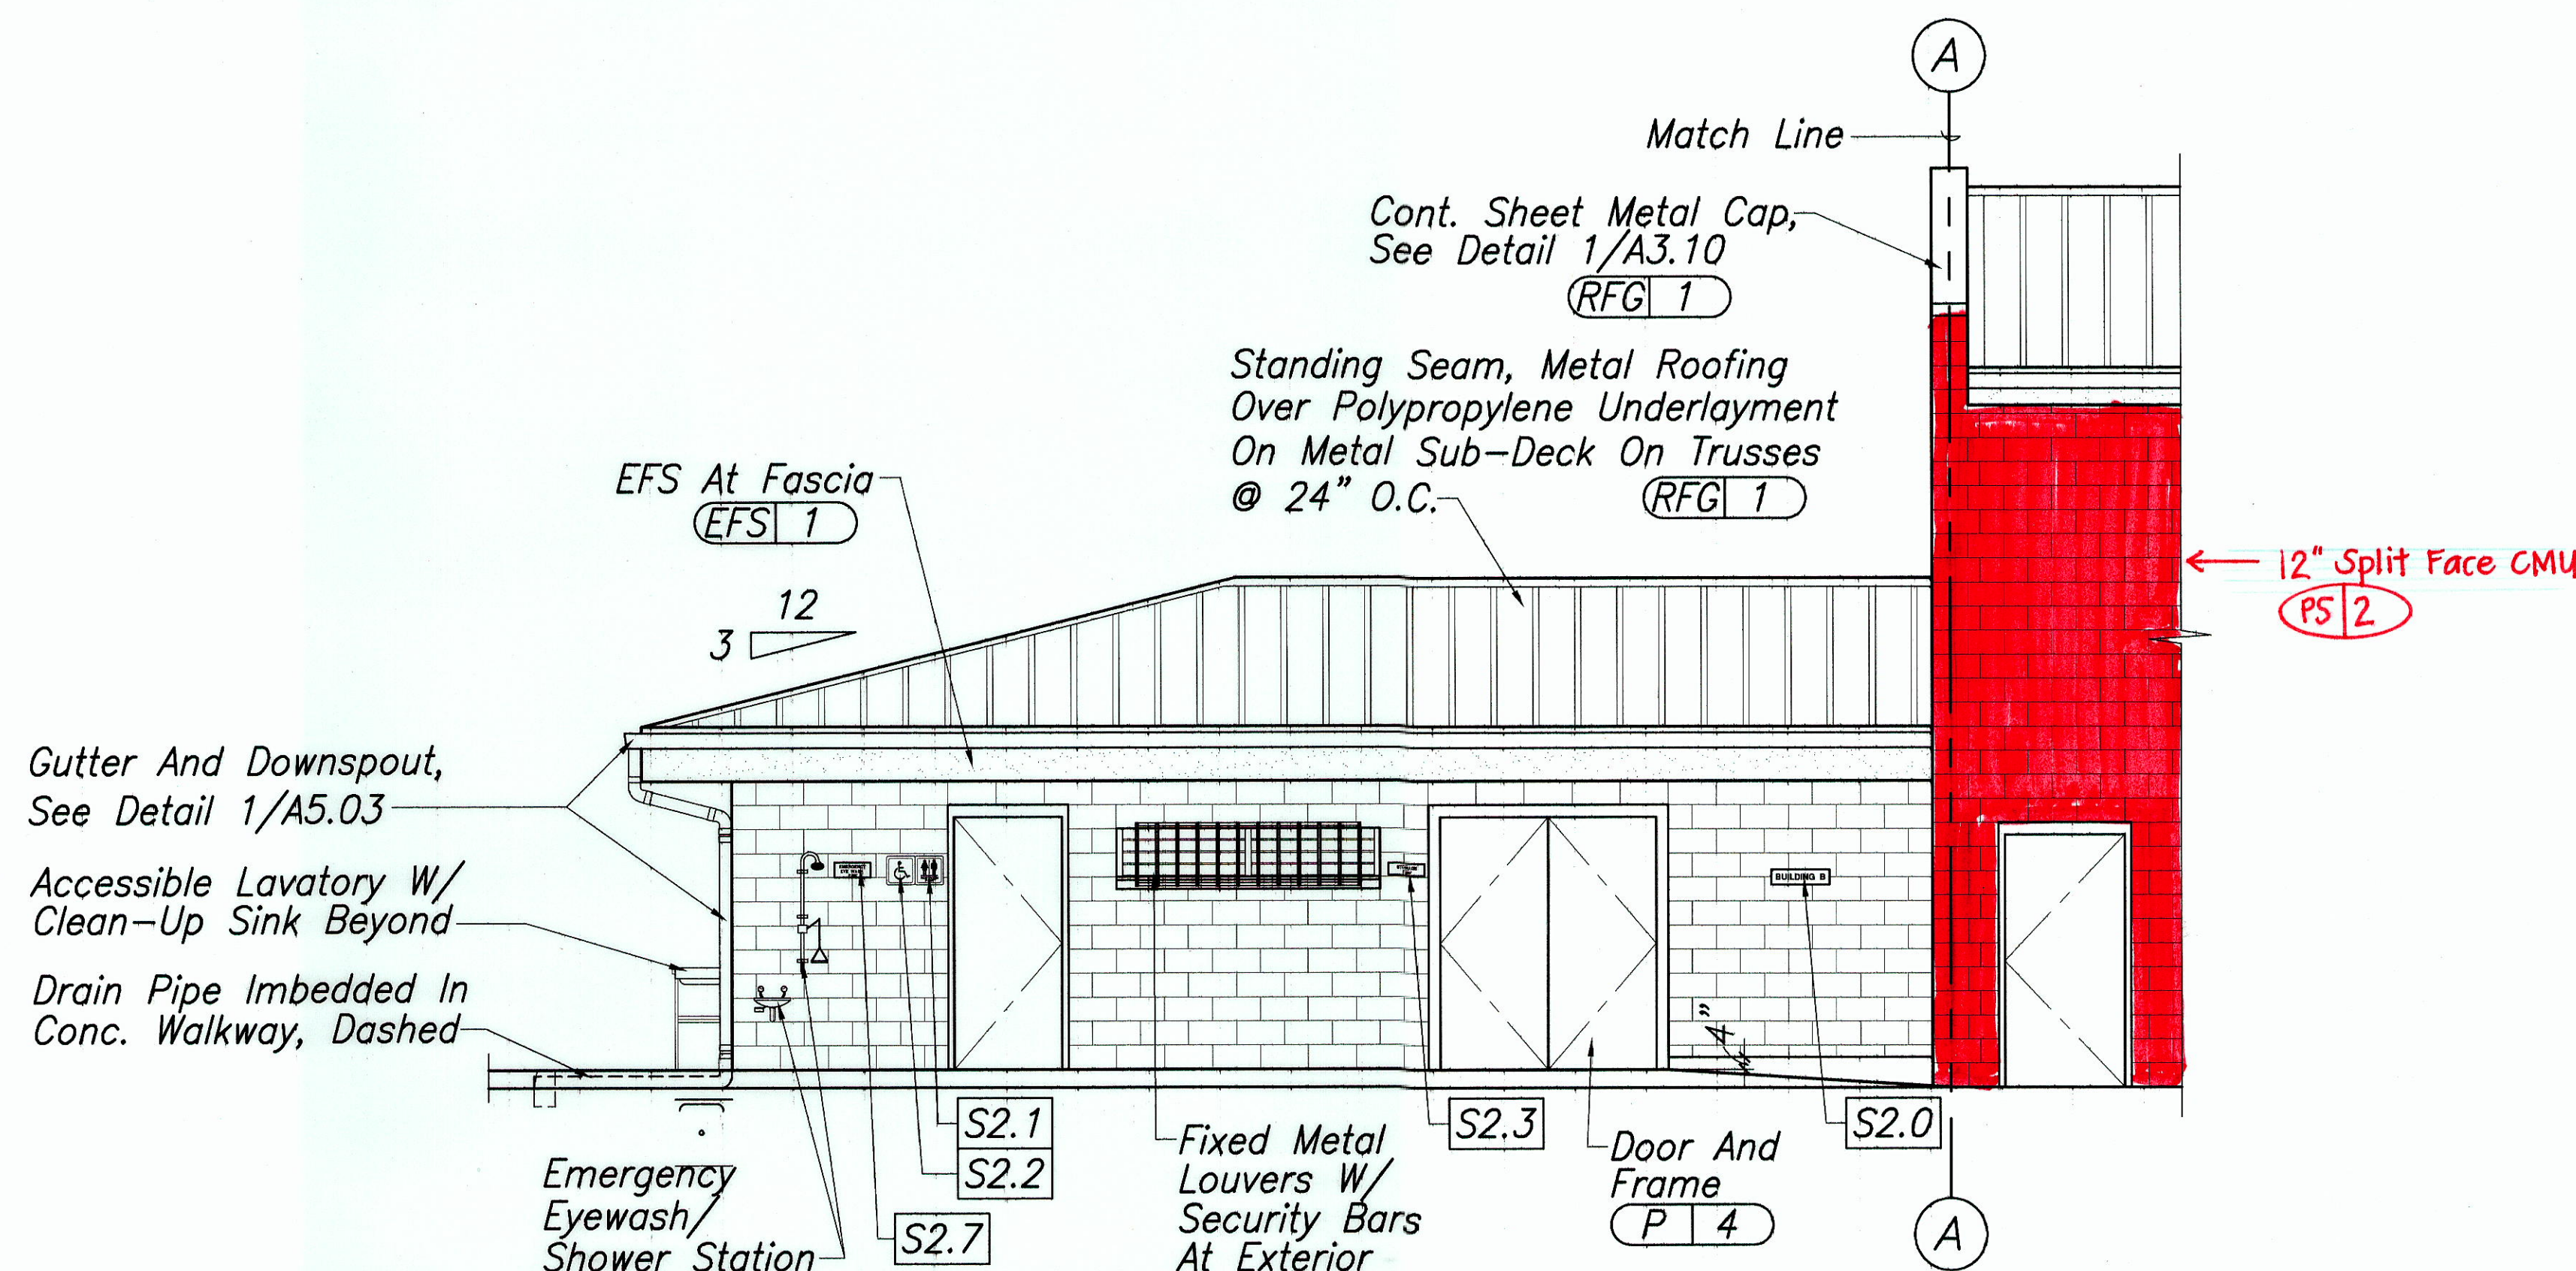


PARTIAL WEST ELEVATION
Scale: 1/4"=1'-0"

Legend

- (CT 1) Material Finish Or Color, See COLOR AND MATERIAL SCHEDULE, Sheet A5.05
- 8" Thick Split Face CMU Wall
- 12" Thick Split Face CMU Wall

STUDY PLOTTED BY	DATE
DRAWN BY	
TRACED BY	
DESIGNED BY	
CHECKED BY	
ORIGINAL PLAN	
NOTE BOOK	
No.	XX

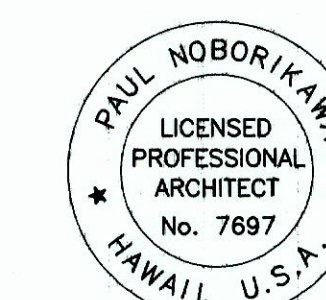



THIS WORK WAS PREPARED BY ME OR UNDER MY SUPERVISION

12/15/08	This sheet replaces the original sheet 2 DPP/DLU Comments dated 7/9/07
DATE	REVISION
STATE OF HAWAII DEPARTMENT OF TRANSPORTATION HIGHWAYS DIVISION GARAGE/STORAGE BUILDING EXTERIOR ELEVATIONS WAHIAWA BASEYARD IMPROVEMENTS Project No. HWY-0-12-00 Scale: AS SHOWN Date: JAN. 2003 SHEET No. A3.03 OF 82 SHEETS	

"AS-BUILT"


C.O.38

FED. ROAD DIST. NO.	STATE	PROJ. NO.	FISCAL YEAR	SHEET NO.	TOTAL SHEETS
HAWAII	HAW.	HWY-0-12-00	2004	39	82

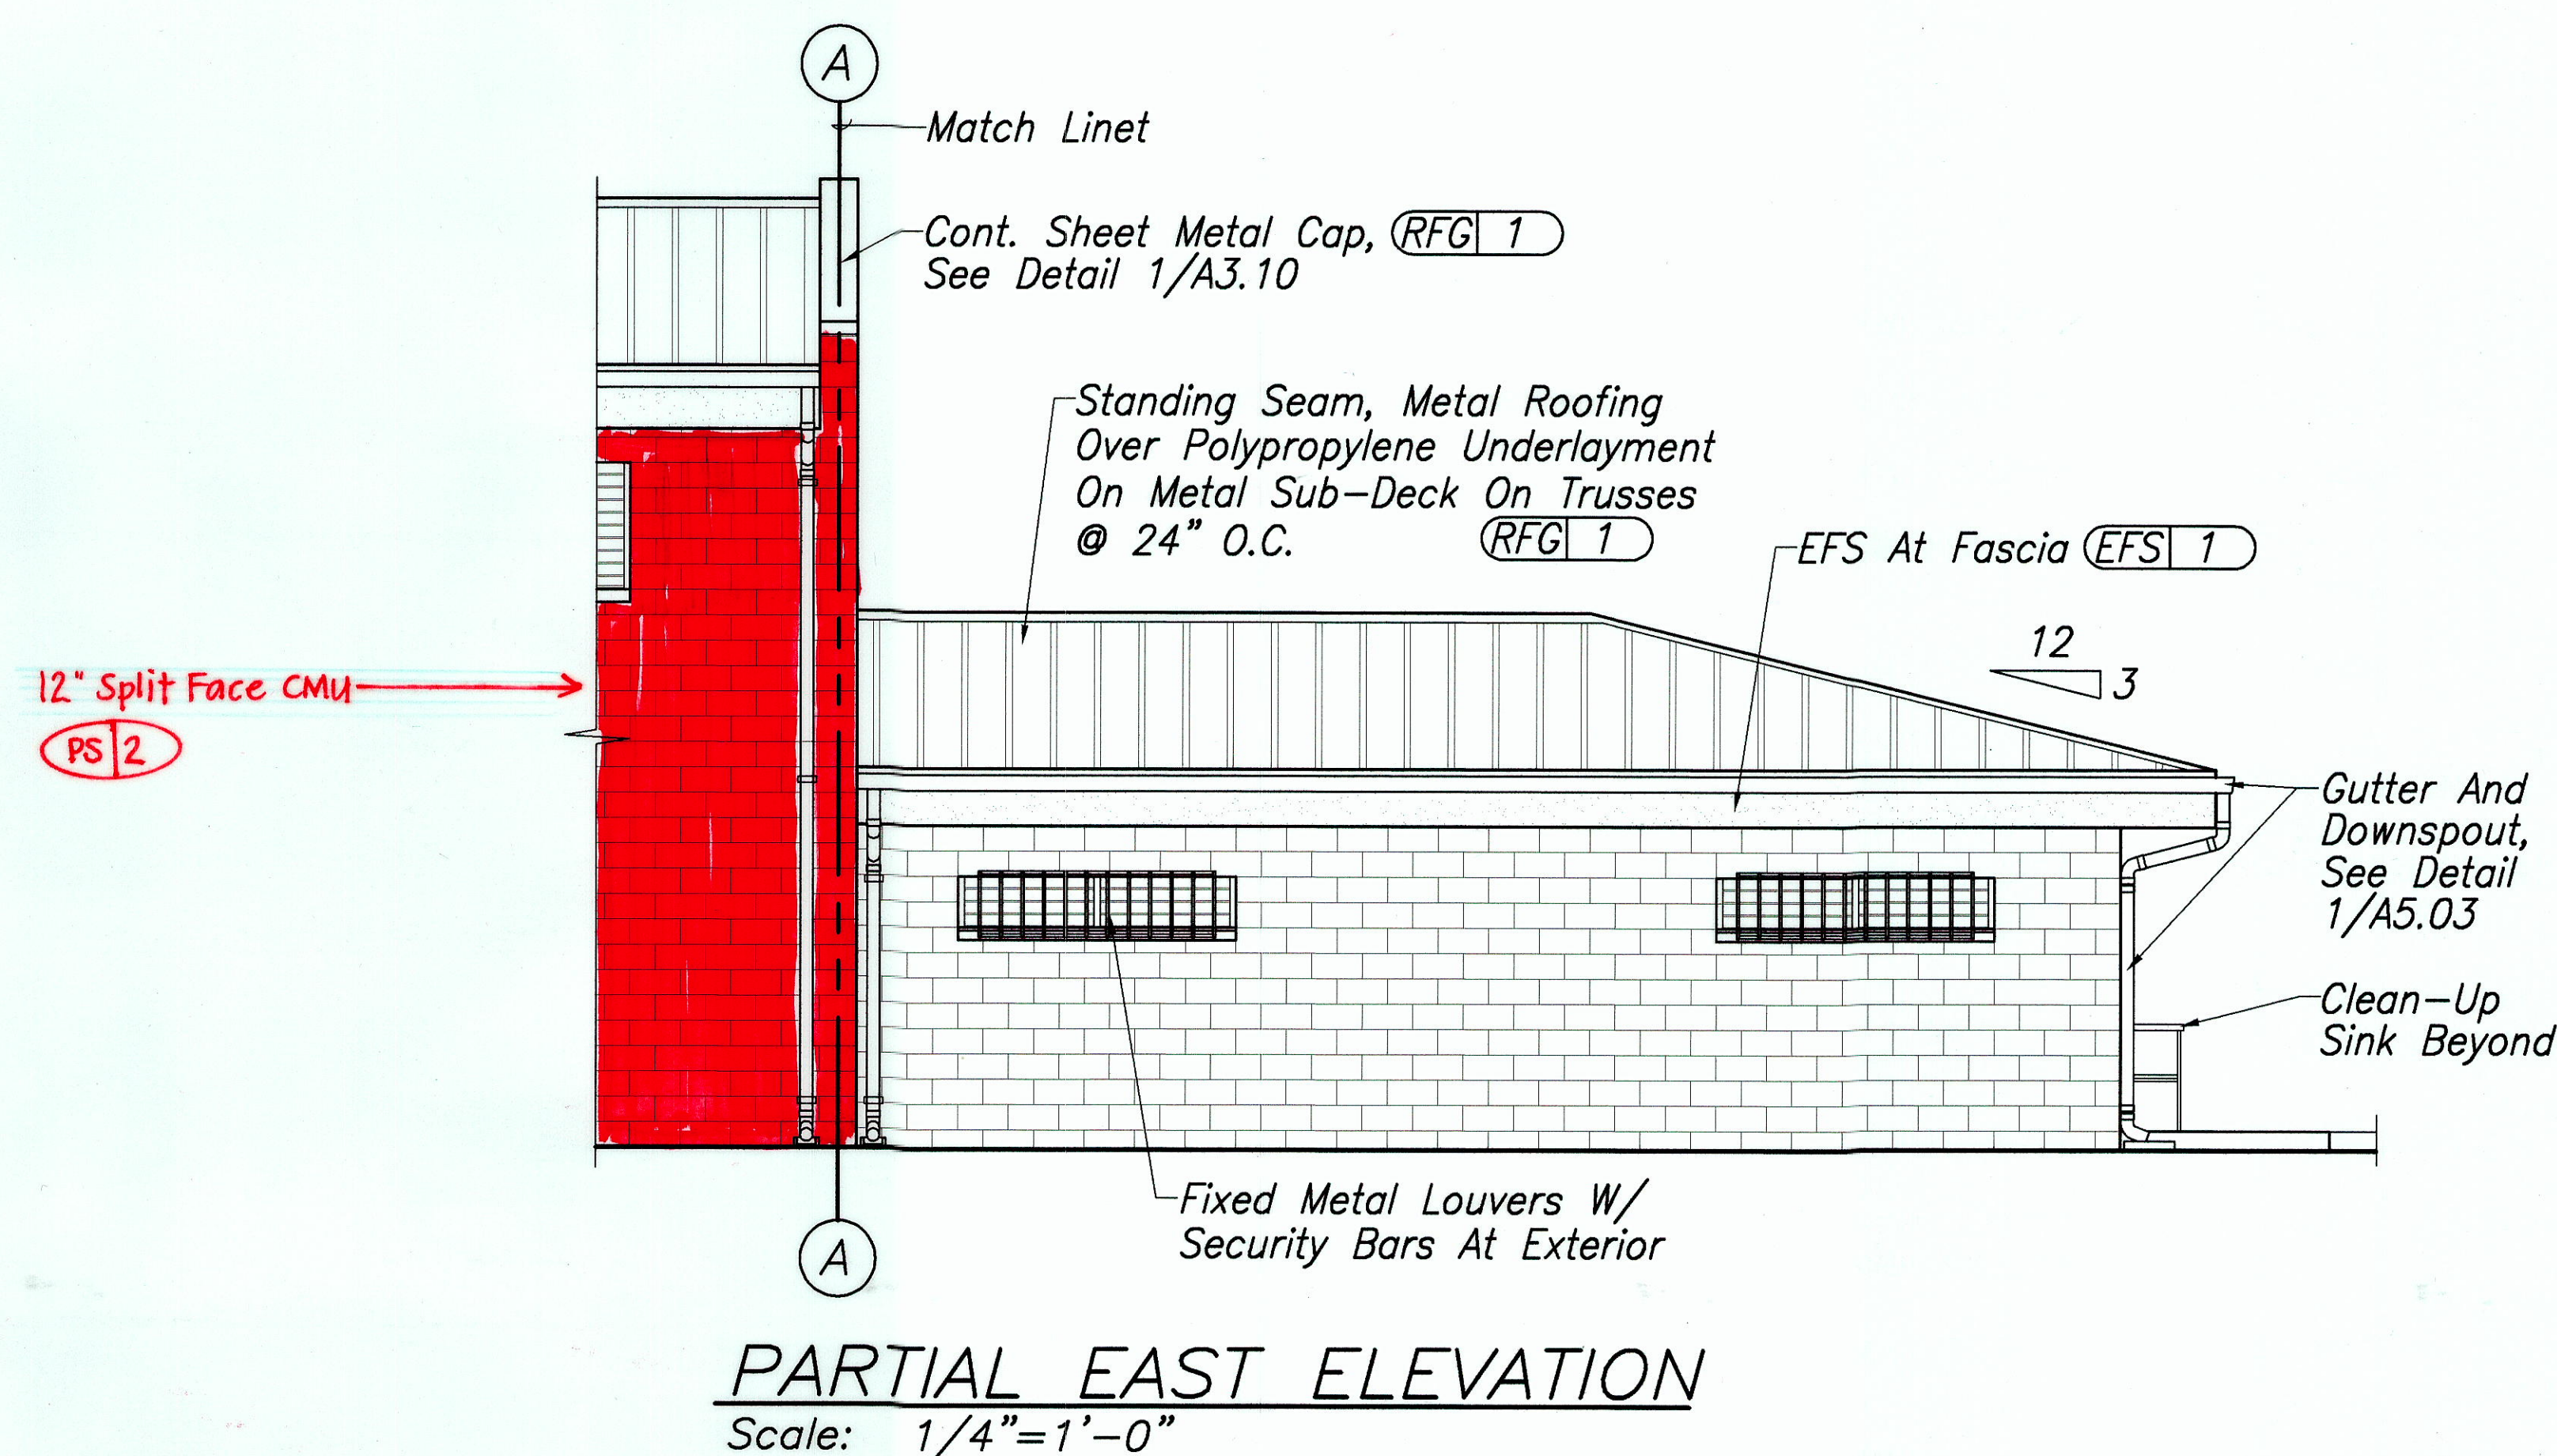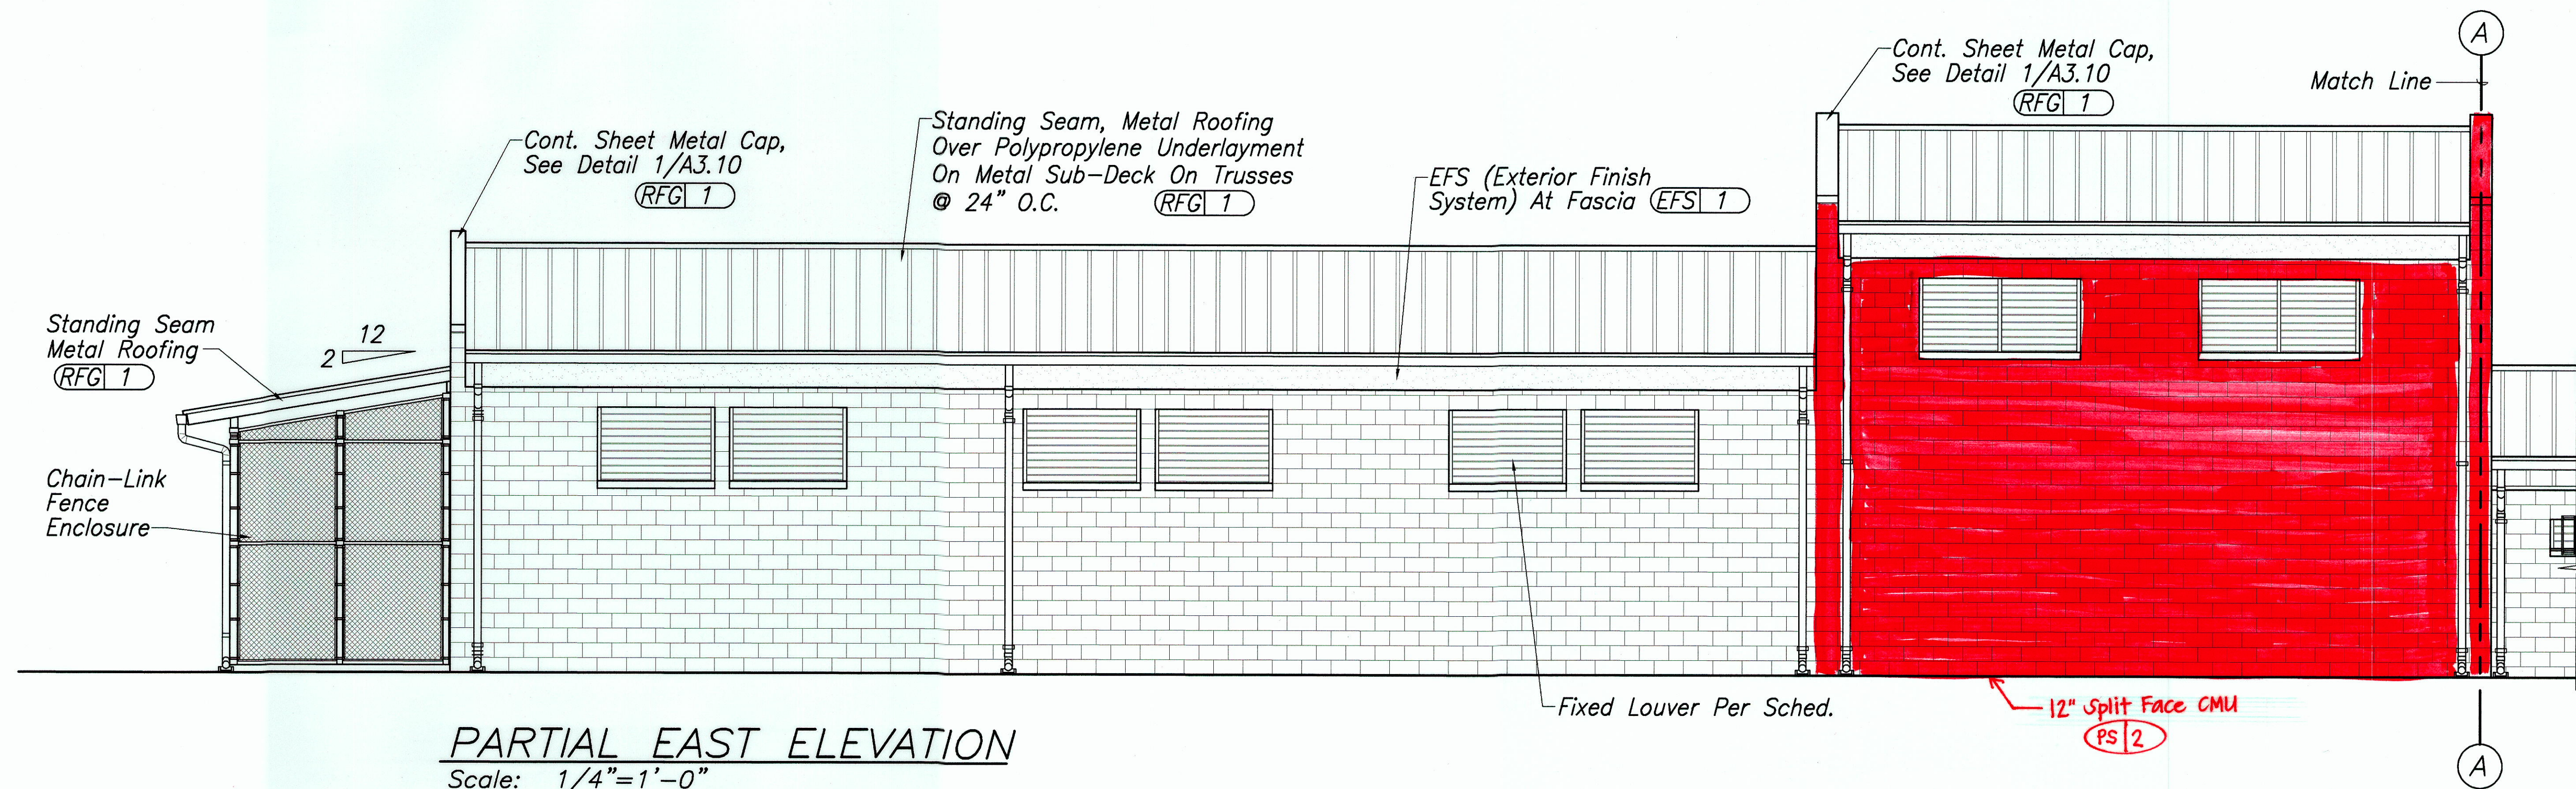


Legend

(CT 1) Material Finish Or Color, See COLOR AND MATERIAL SCHEDULE, Sheet A5.05

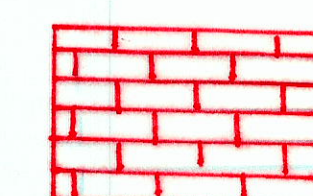


8" Thick Split Face CMU Wall

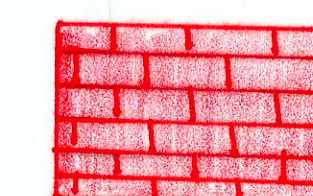

12" Thick Split Face CMU Wall

SURVEY PLATTED BY	DATE
DRAWN BY	
TRACED BY	
DESIGNED BY	
CHECKED BY	
ORIGINAL PLAN	XX
NOTE BOOK	No.

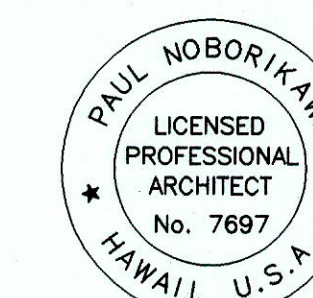

THIS WORK WAS PREPARED BY ME OR UNDER MY SUPERVISION

STATE OF HAWAII
DEPARTMENT OF TRANSPORTATION
HIGHWAYS DIVISION

**GARAGE/STORAGE BUILDING
EXTERIOR ELEVATIONS**

WAHIAWA BASEYARD
IMPROVEMENTS


Project No. HWY-0-12-00

Scale: AS SHOWN Date: JAN. 2003


SHEET No. A3.04 OF 82 SHEETS

"AS-BUILT"


FED. ROAD DIST. NO.	STATE	PROJ. NO.	FISCAL YEAR	SHEET NO.	TOTAL SHEETS
HAWAII	HAW.	HWY-0-12-00	2004	41	82

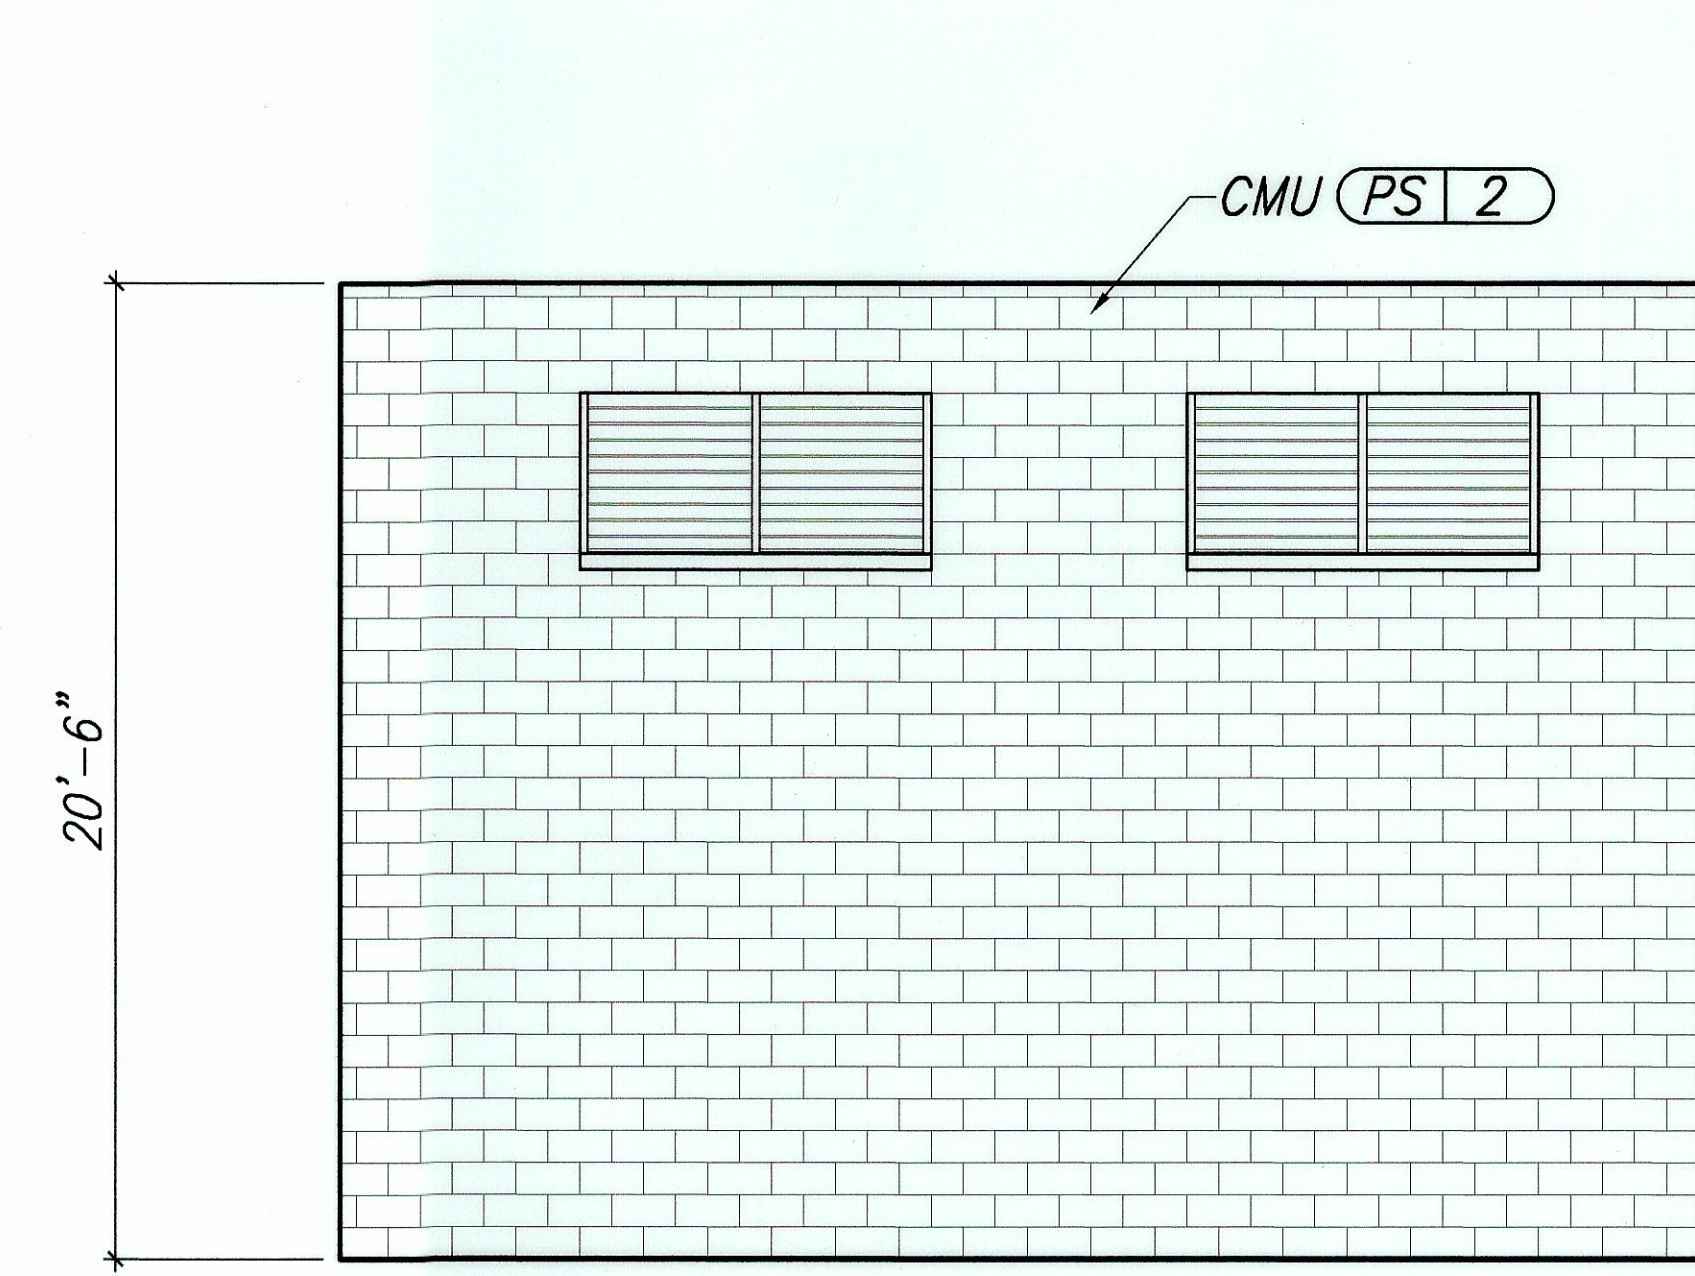

A

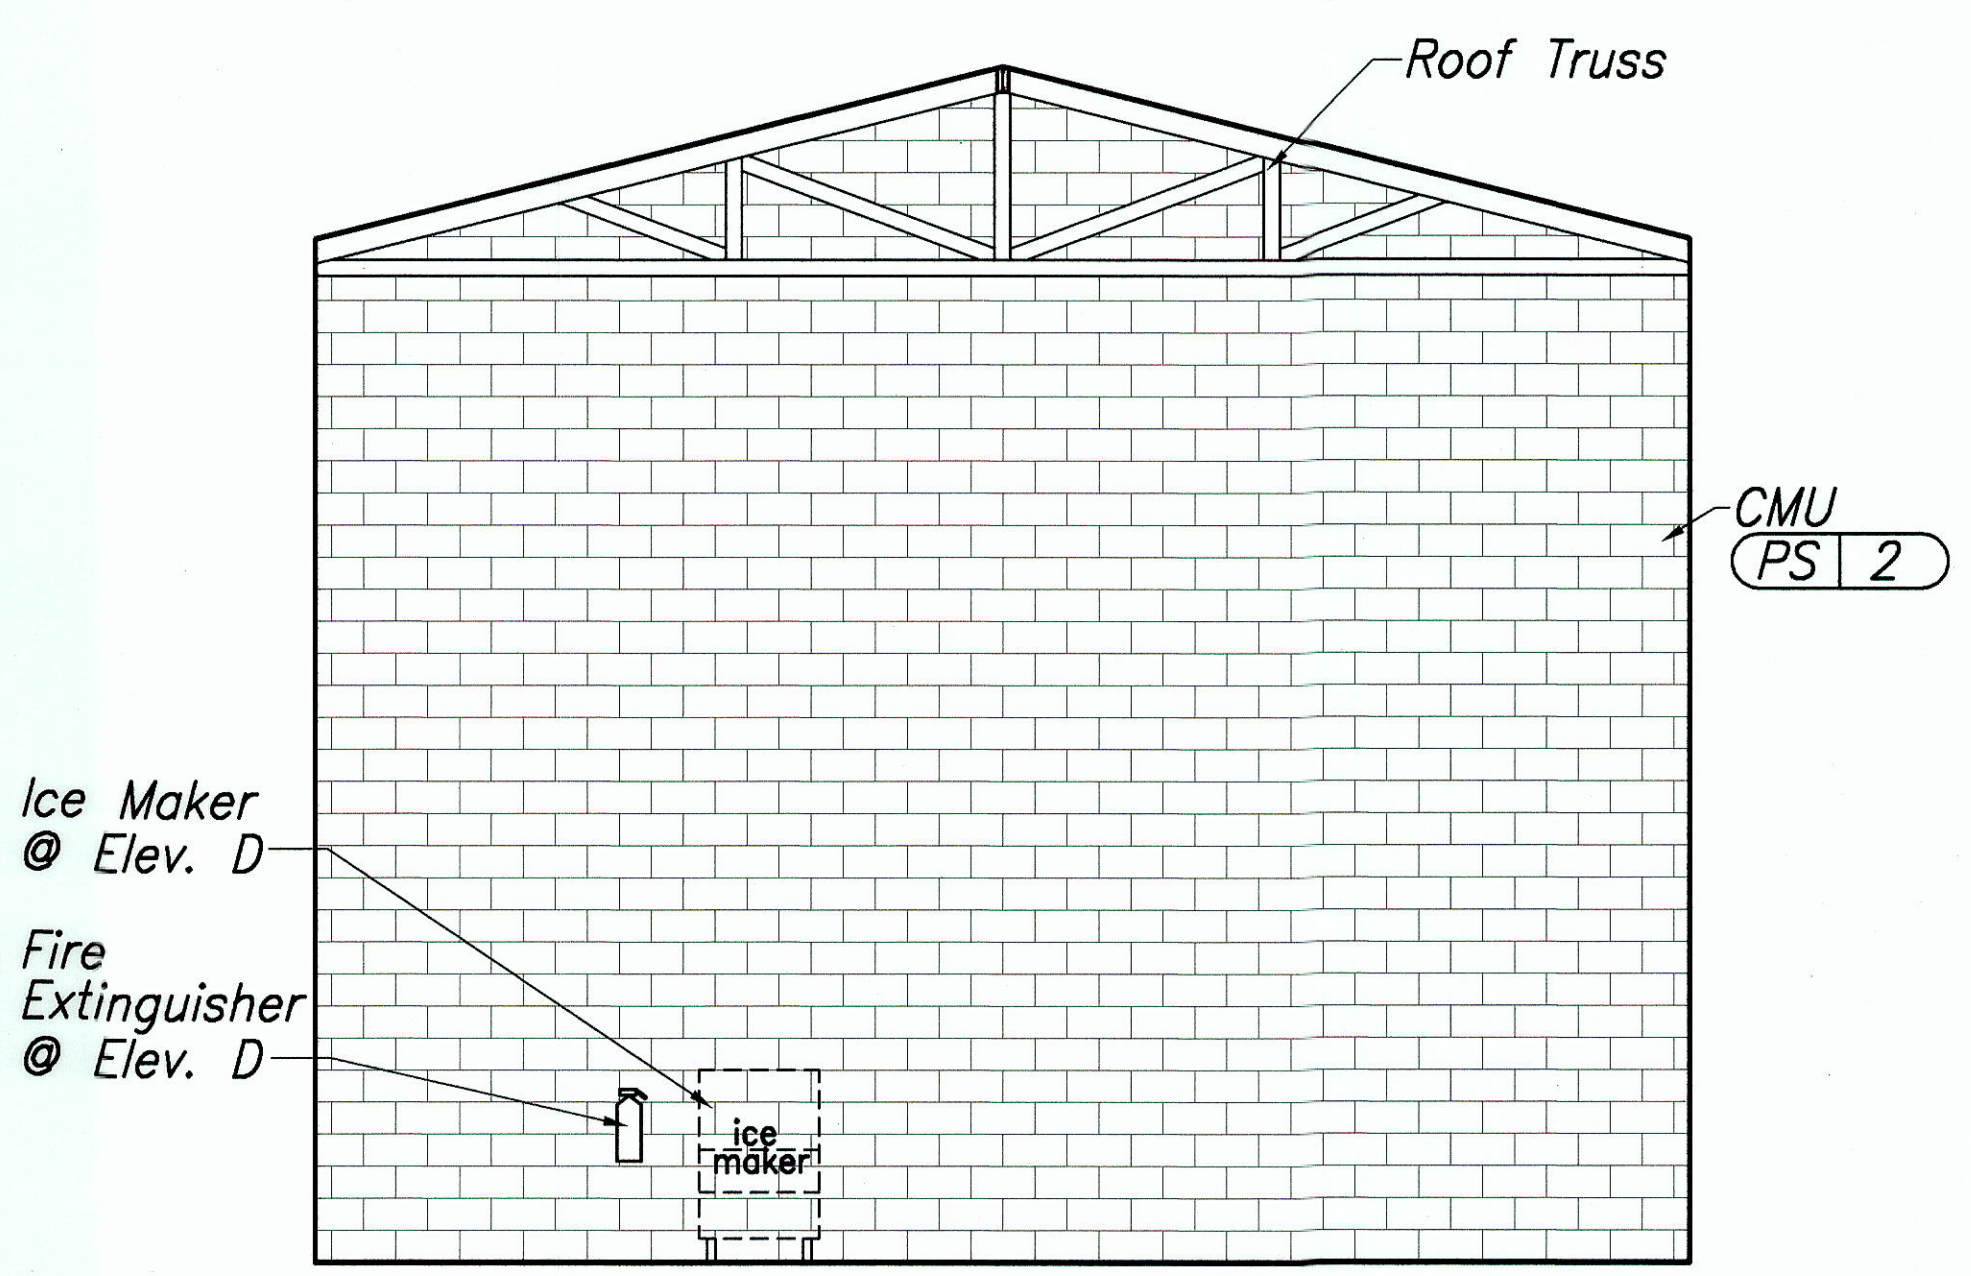


B (D IDENTICAL AT OPPOSITE HAND)

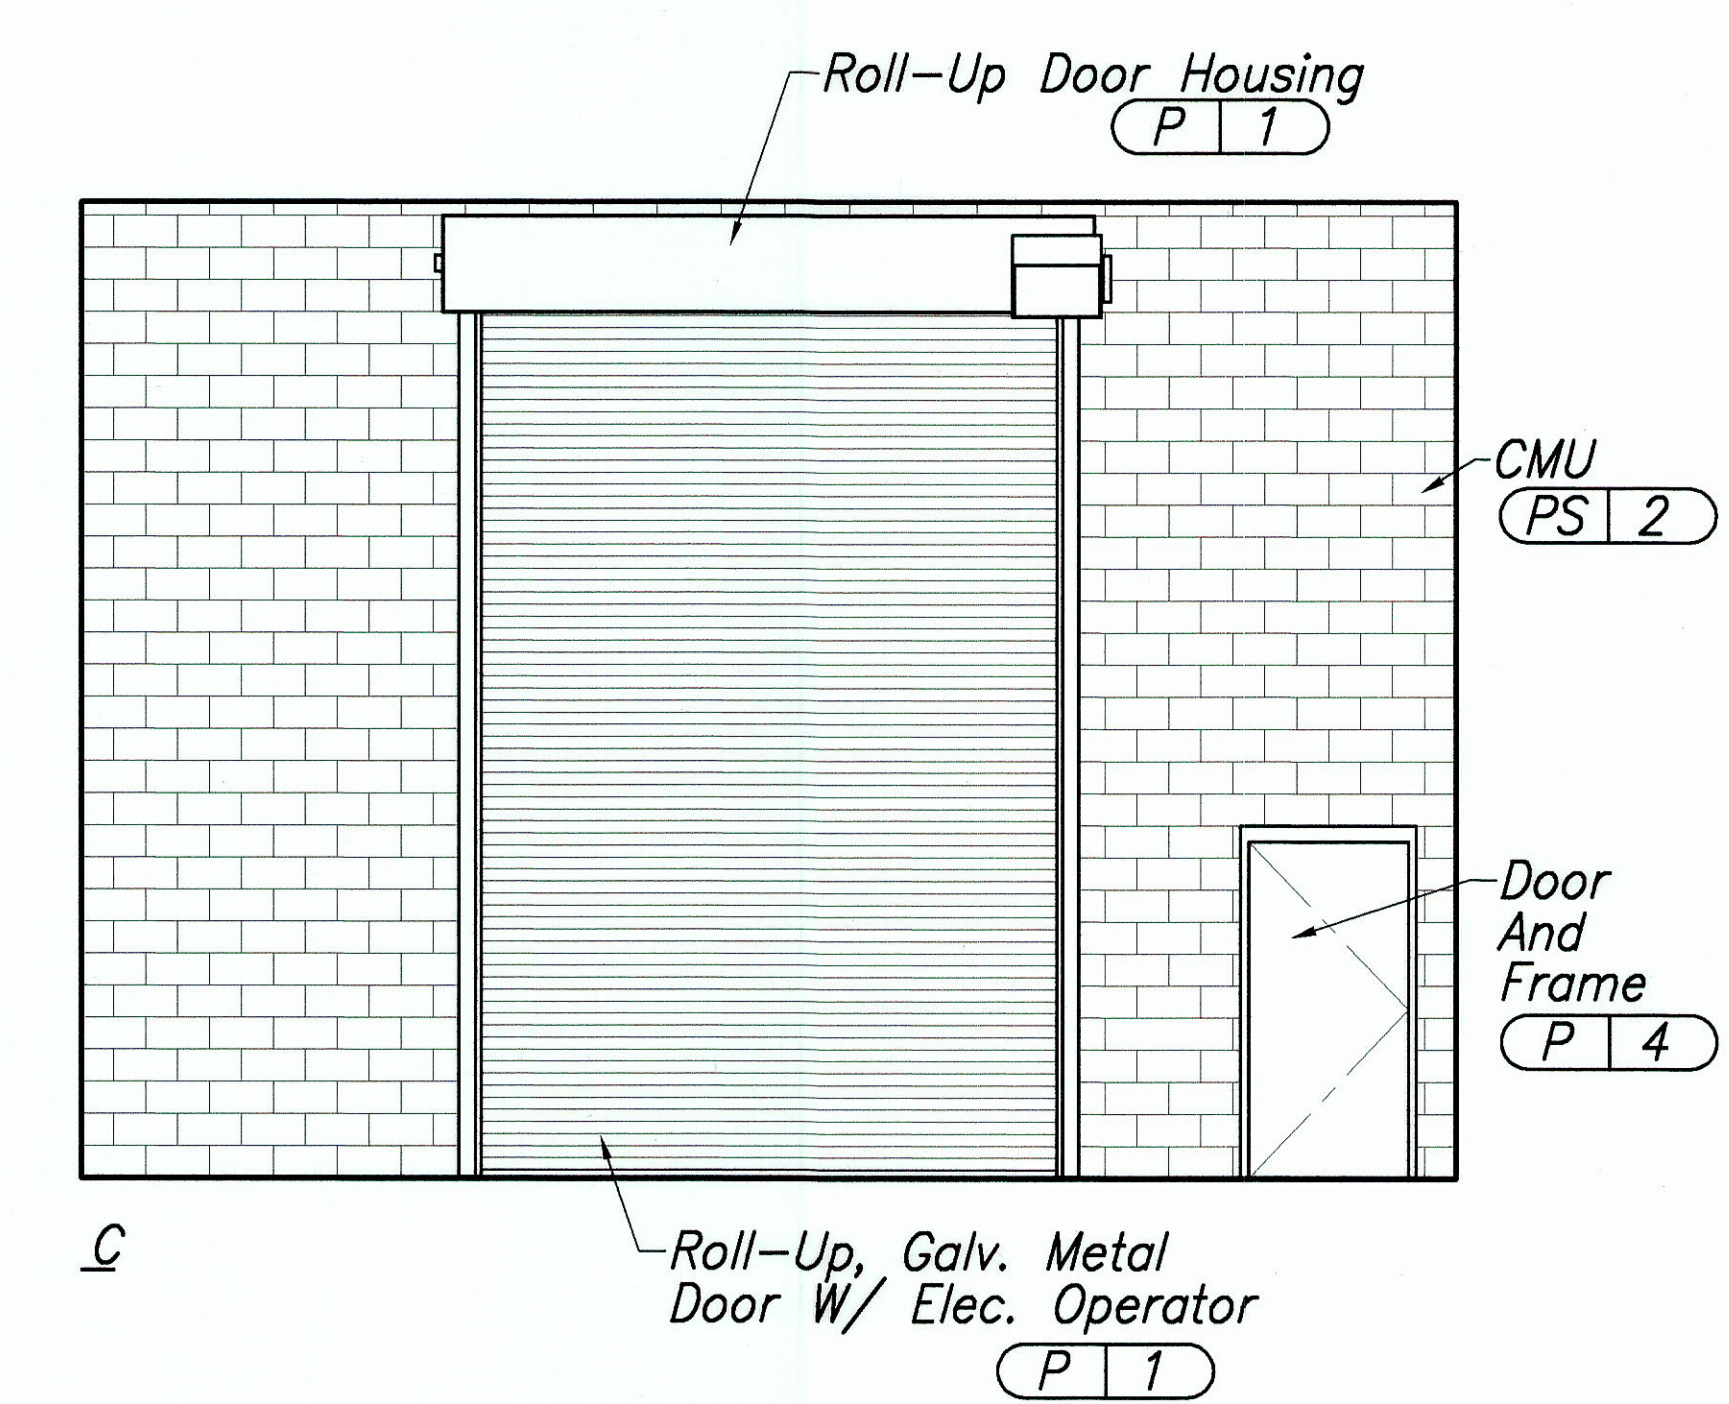


C

EQUIPMENT STORAGE AREA
Scale: 1/4"=1'-0"


Legend
CT 1 Material Finish Or Color, See COLOR AND MATERIAL SCHEDULE, Sheet A5.05

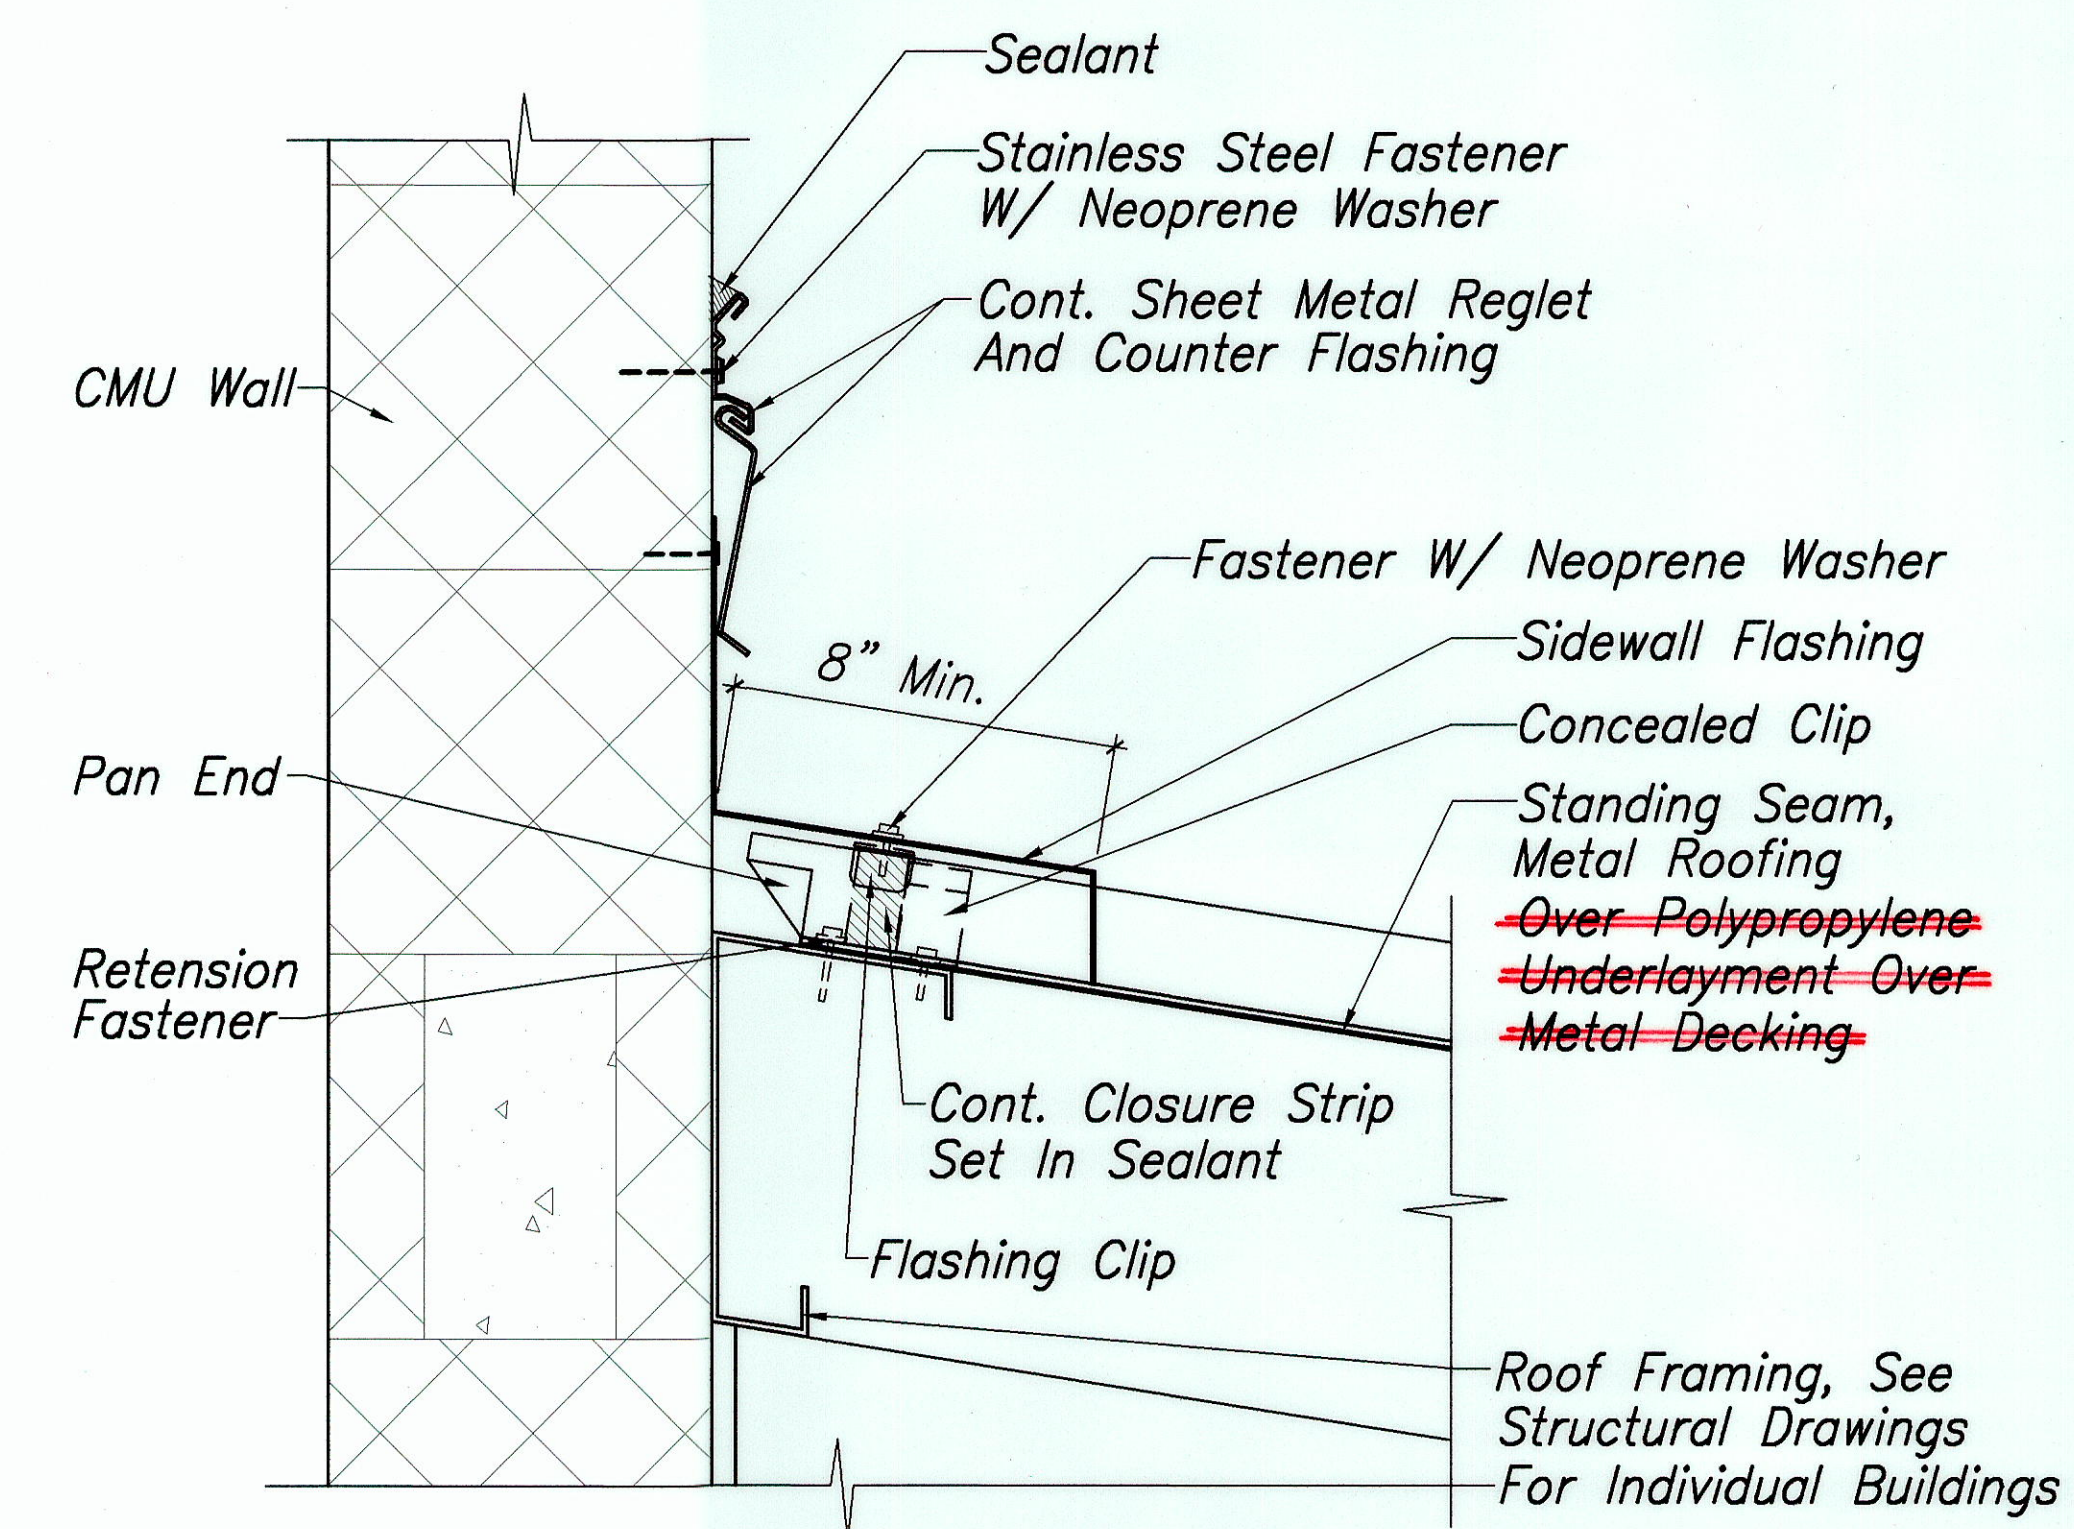

SIDEWALL FLASHING DETAIL
Scale: 3"=1'-0"

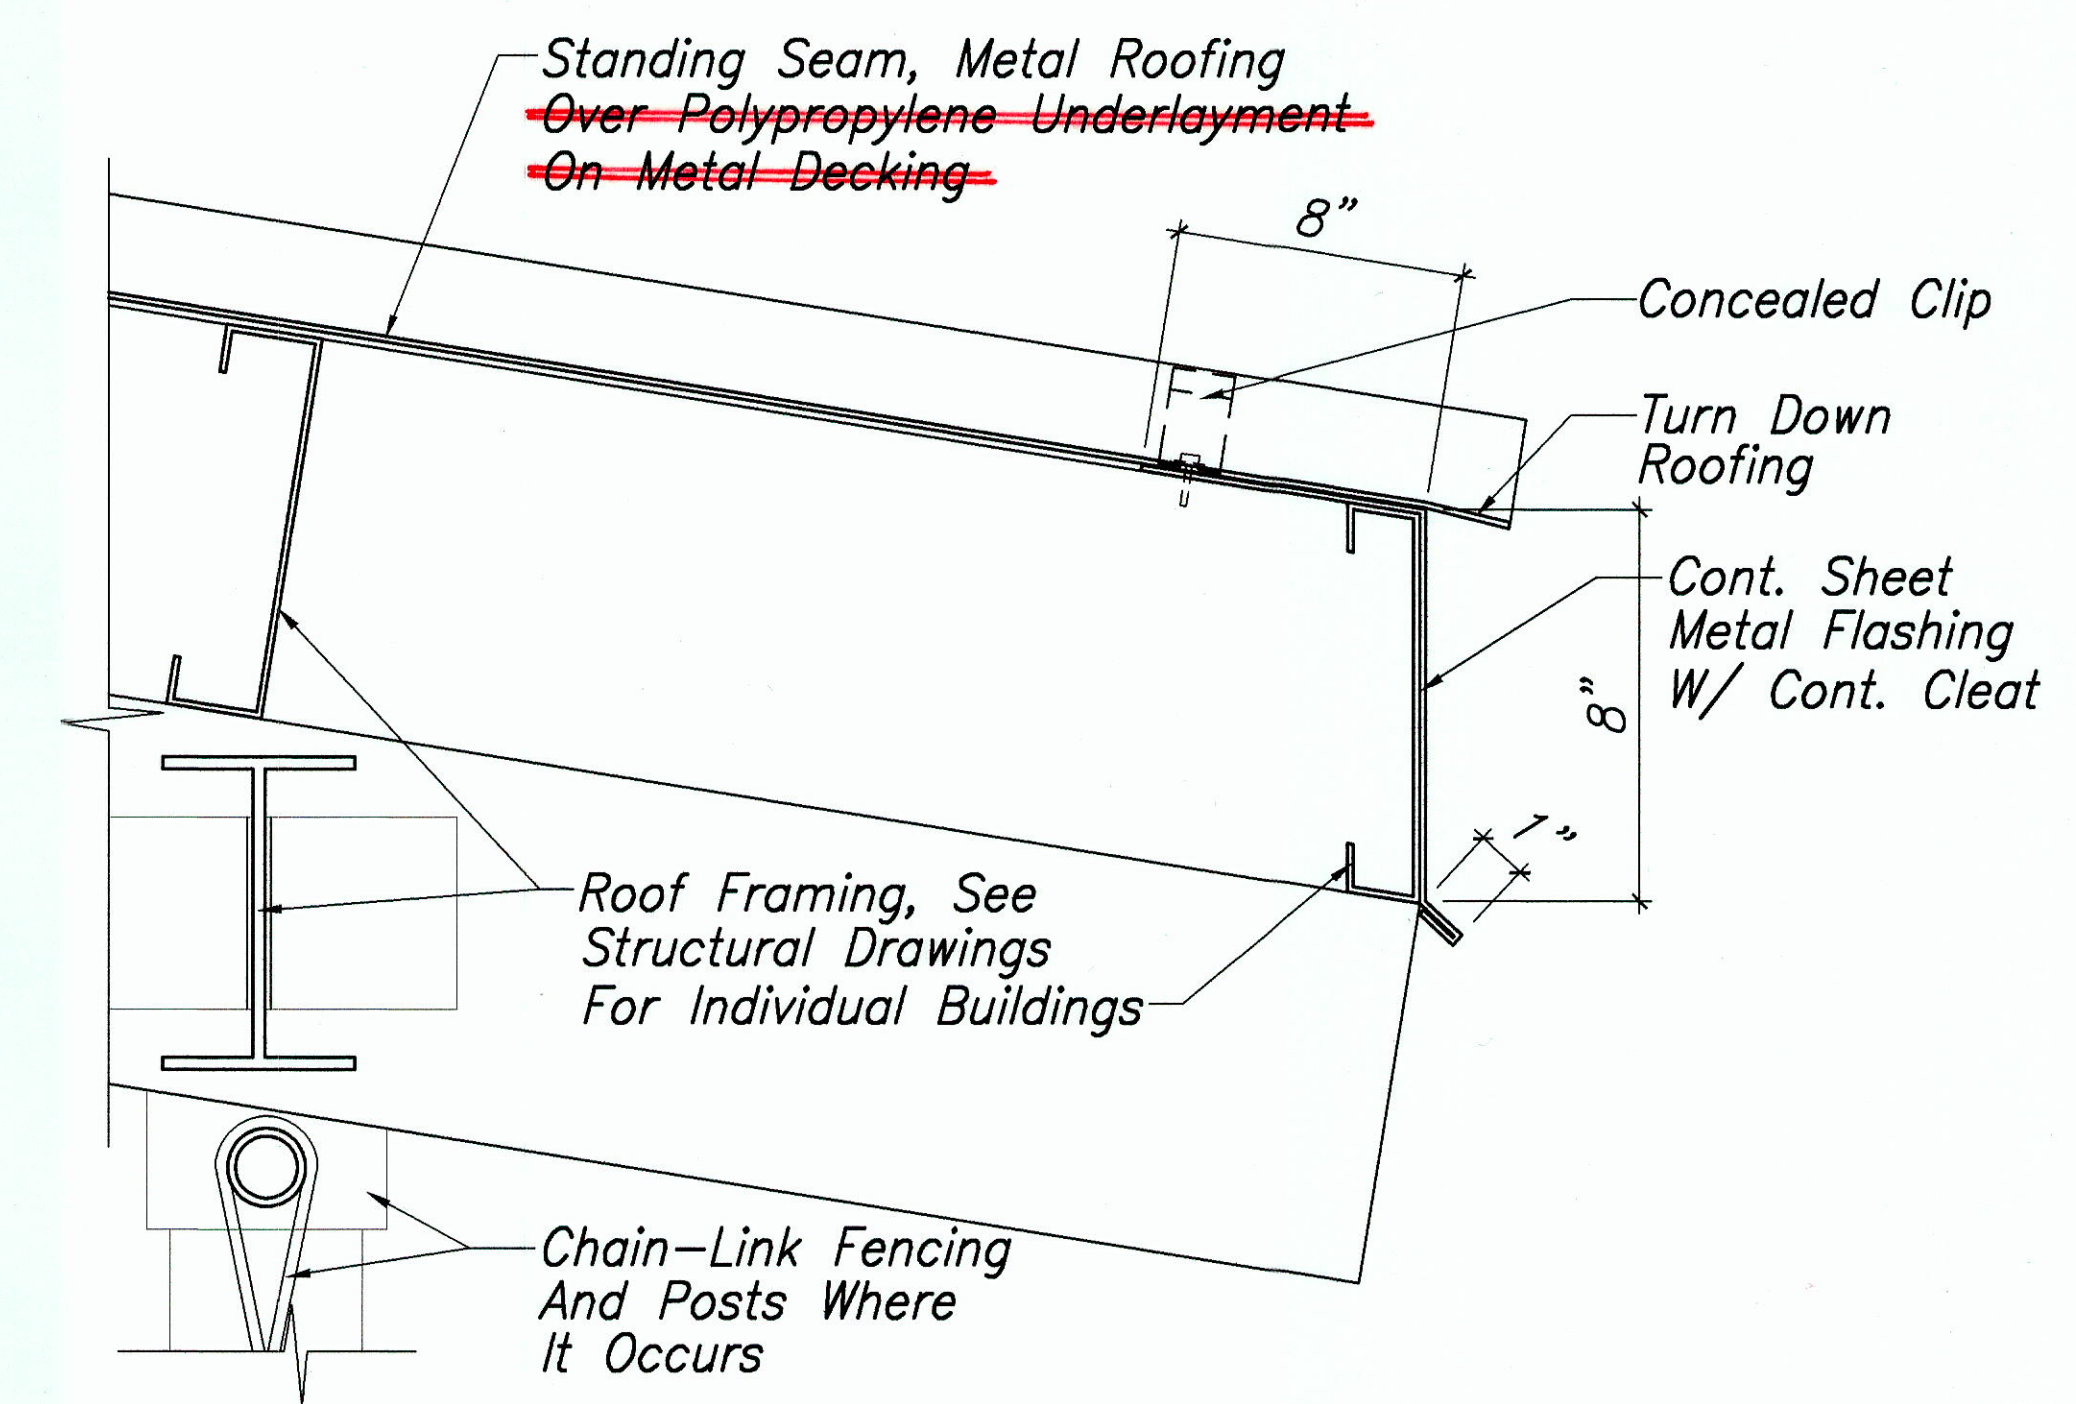


EAVE FLASHING DETAIL
Scale: 3"=1'-0"

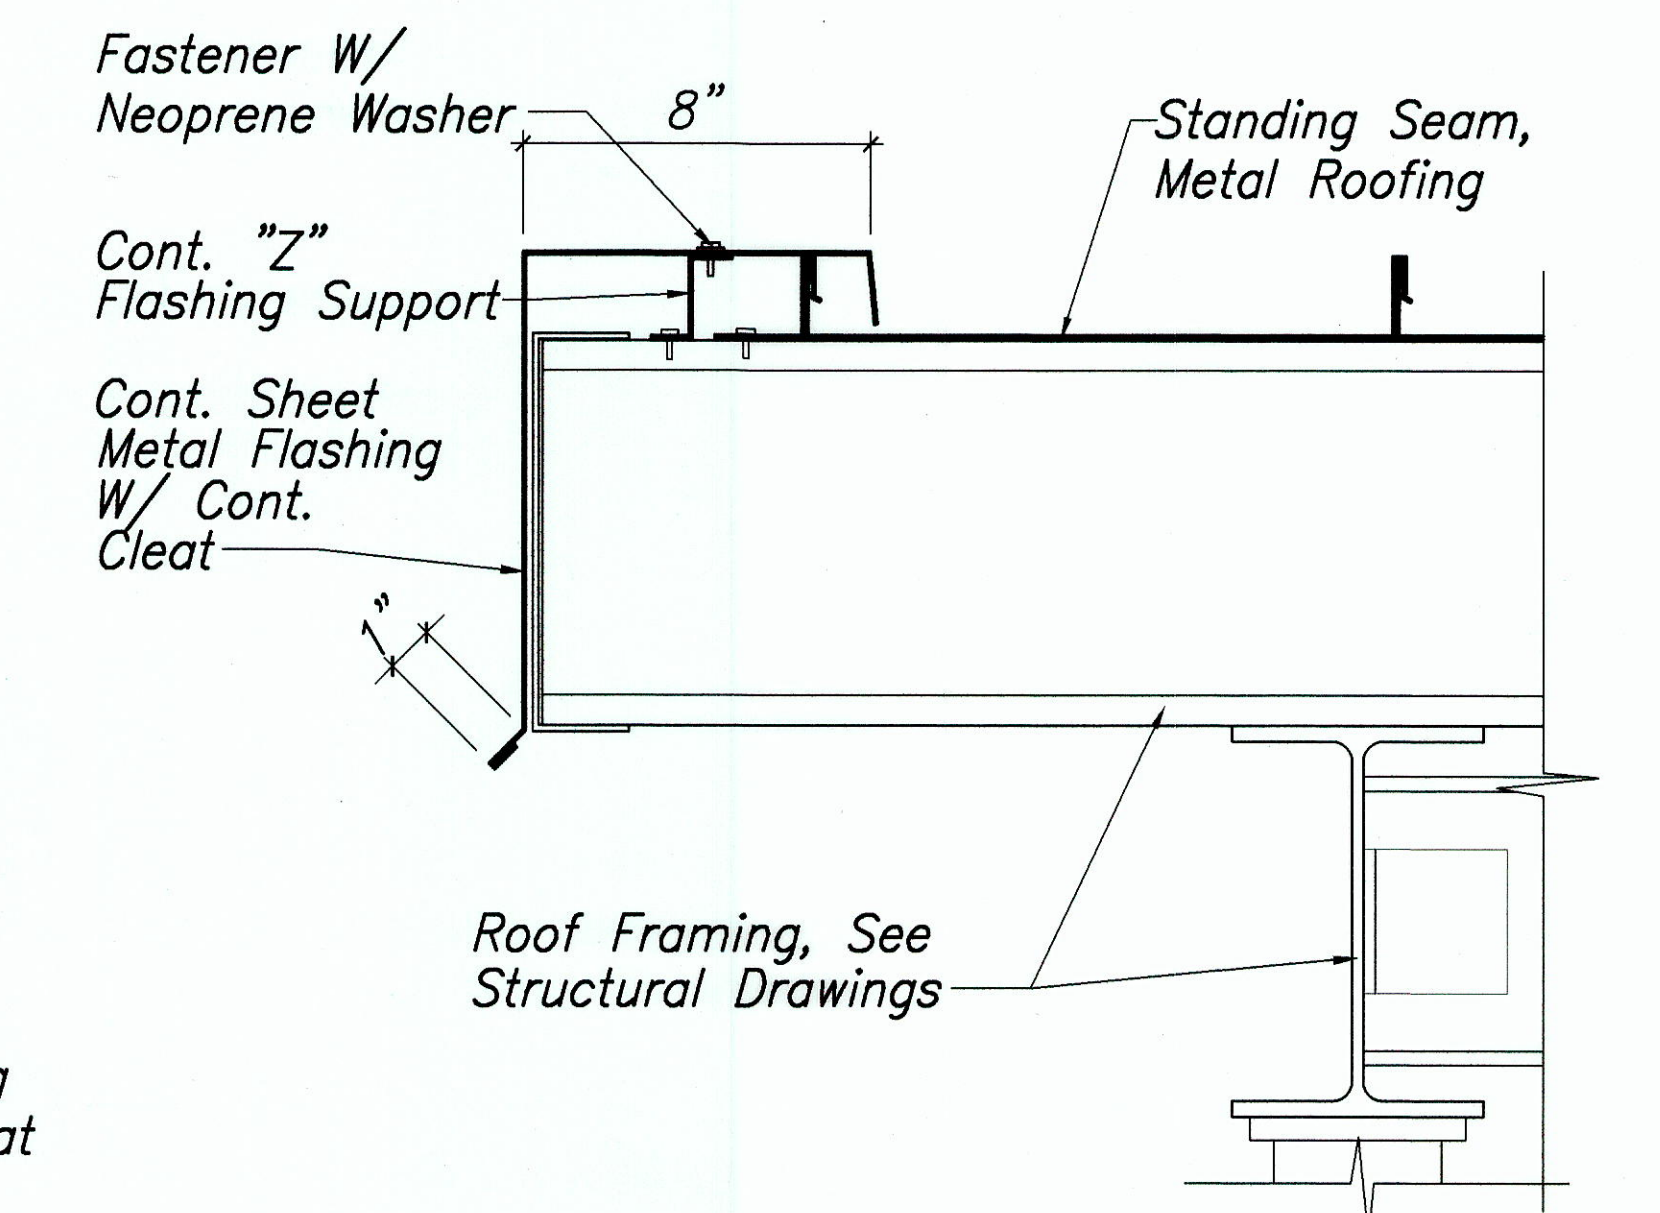

RAKE FLASHING DETAIL
Scale: 3"=1'-0"

DATE	*****
SURVEY PLOTTED BY	*****
PLAN	*****
DESIGNED BY	*****
NOTE BOOK	*****
NO.	XX
CHECKED BY	*****

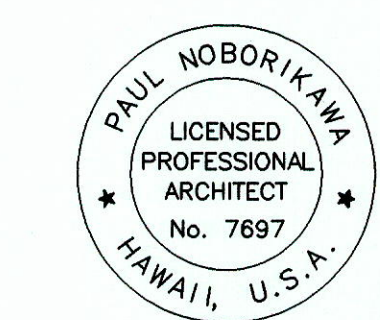

THIS WORK WAS PREPARED BY ME OR UNDER MY SUPERVISION

AS-BUILT

STATE OF HAWAII
DEPARTMENT OF TRANSPORTATION
HIGHWAYS DIVISION

GARAGE/STORAGE BUILDING
INT. ELEVS., ROOF DETAILS


WAIHAWA BASEYARD
IMPROVEMENTS

Project No. HWY-0-12-00


Scale: AS SHOWN Date: JAN. 2003

SHEET No. A3.06 OF 82 SHEETS


FED. ROAD DIST. NO.	STATE	PROJ. NO.	FISCAL YEAR	SHEET NO.	TOTAL SHEETS
HAWAII	HAW.	HWY-0-12-00	2004	42	82

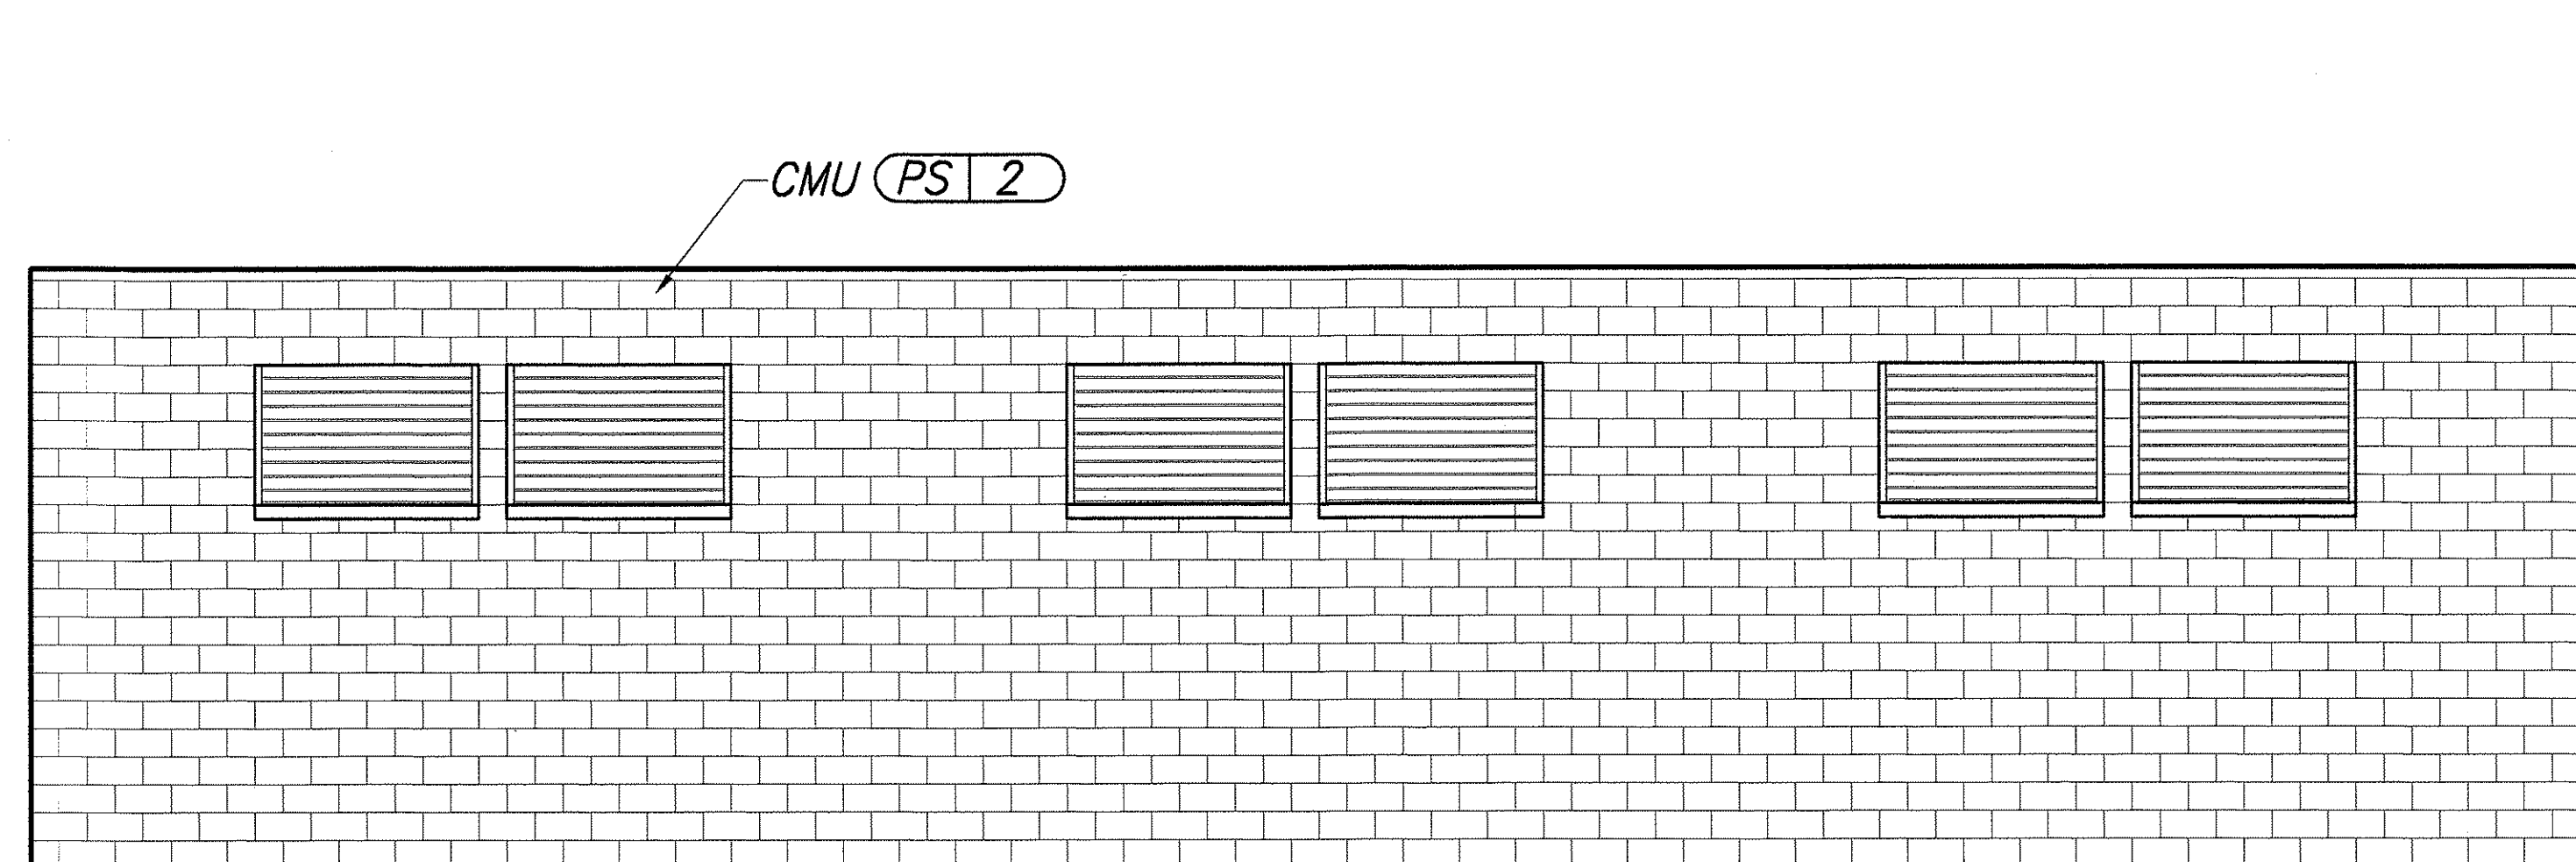


A

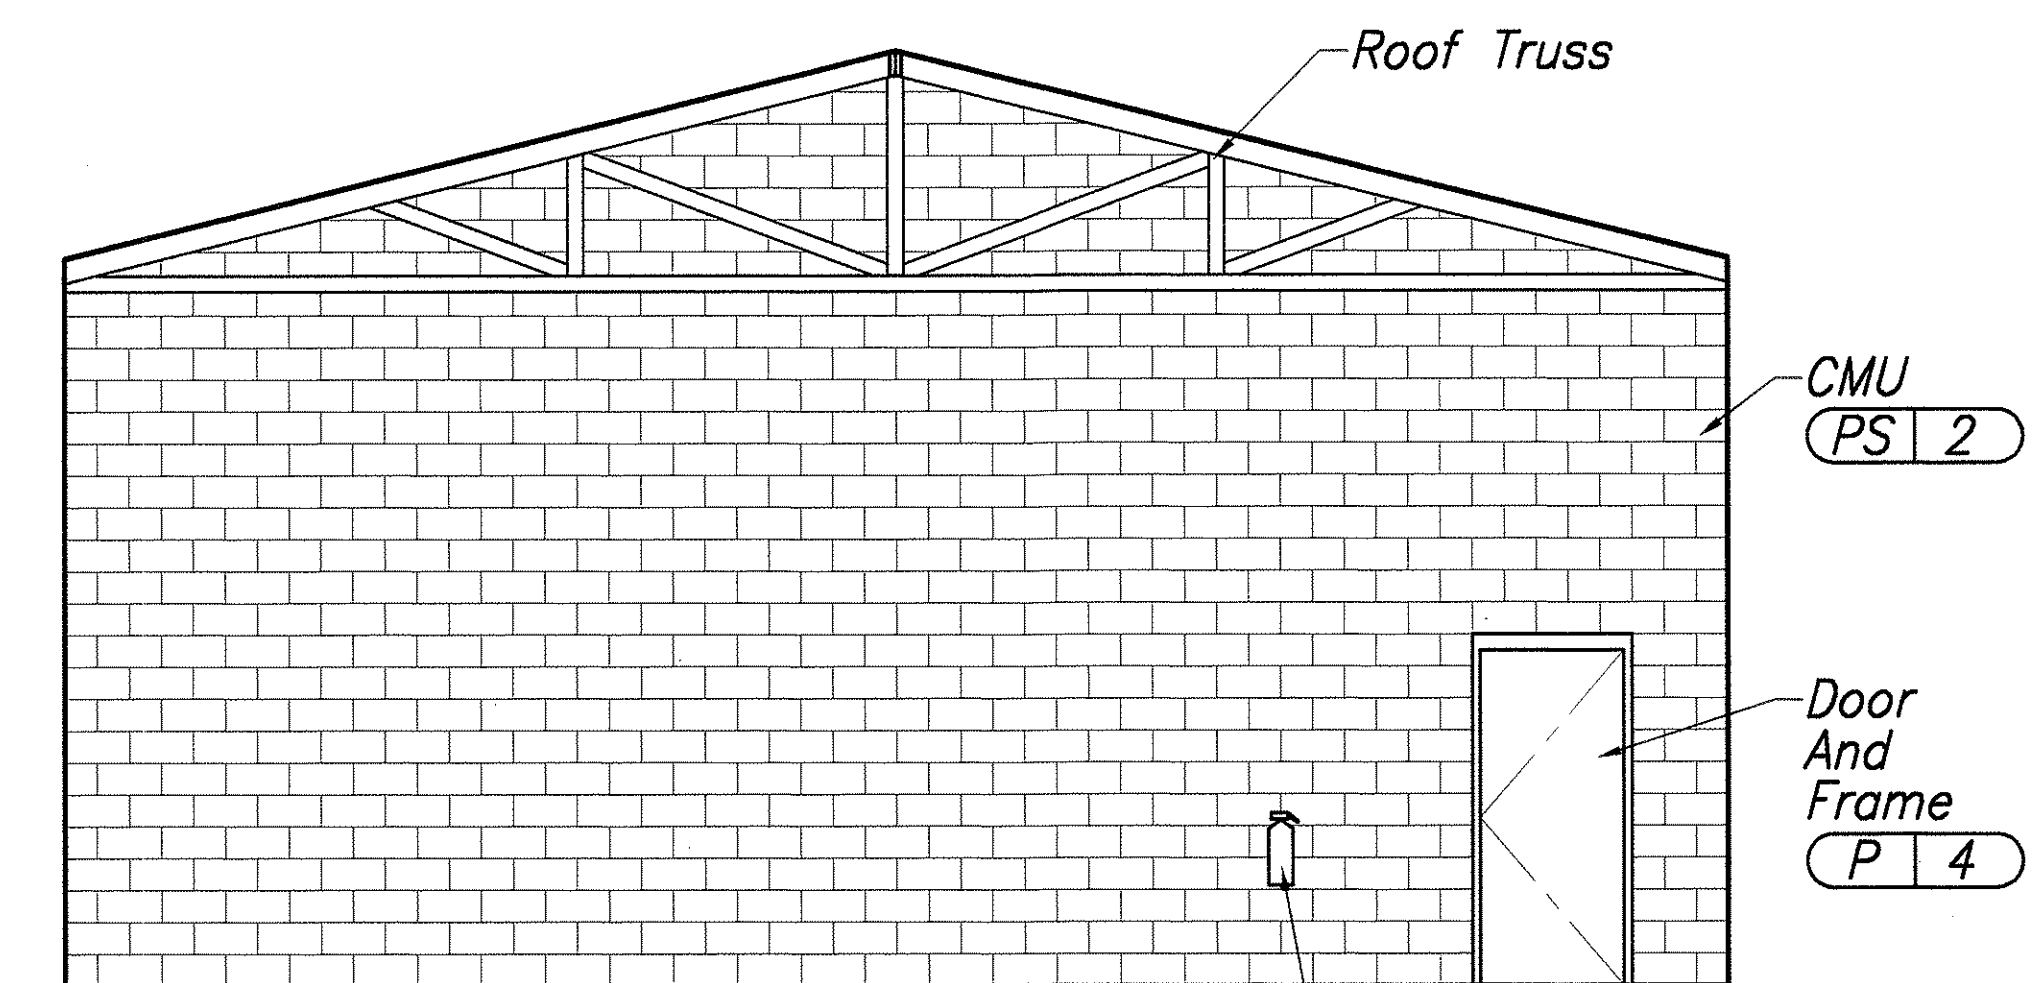

B

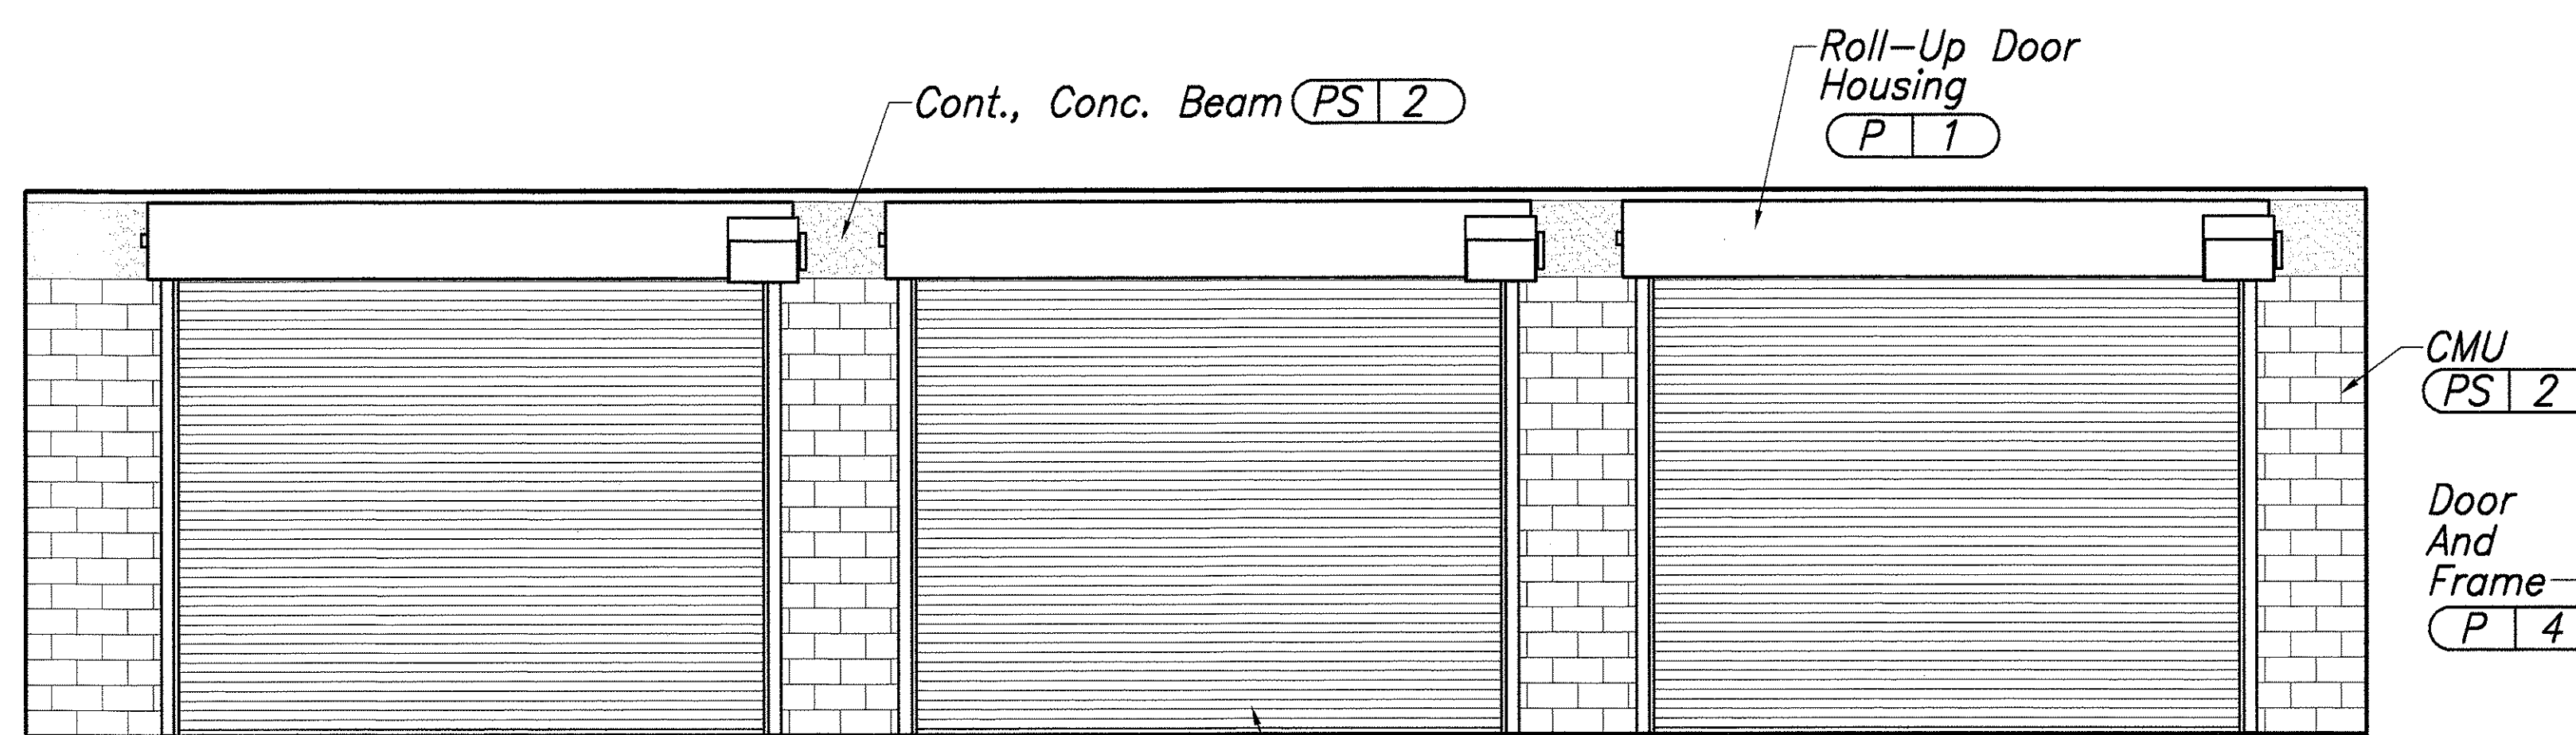

C

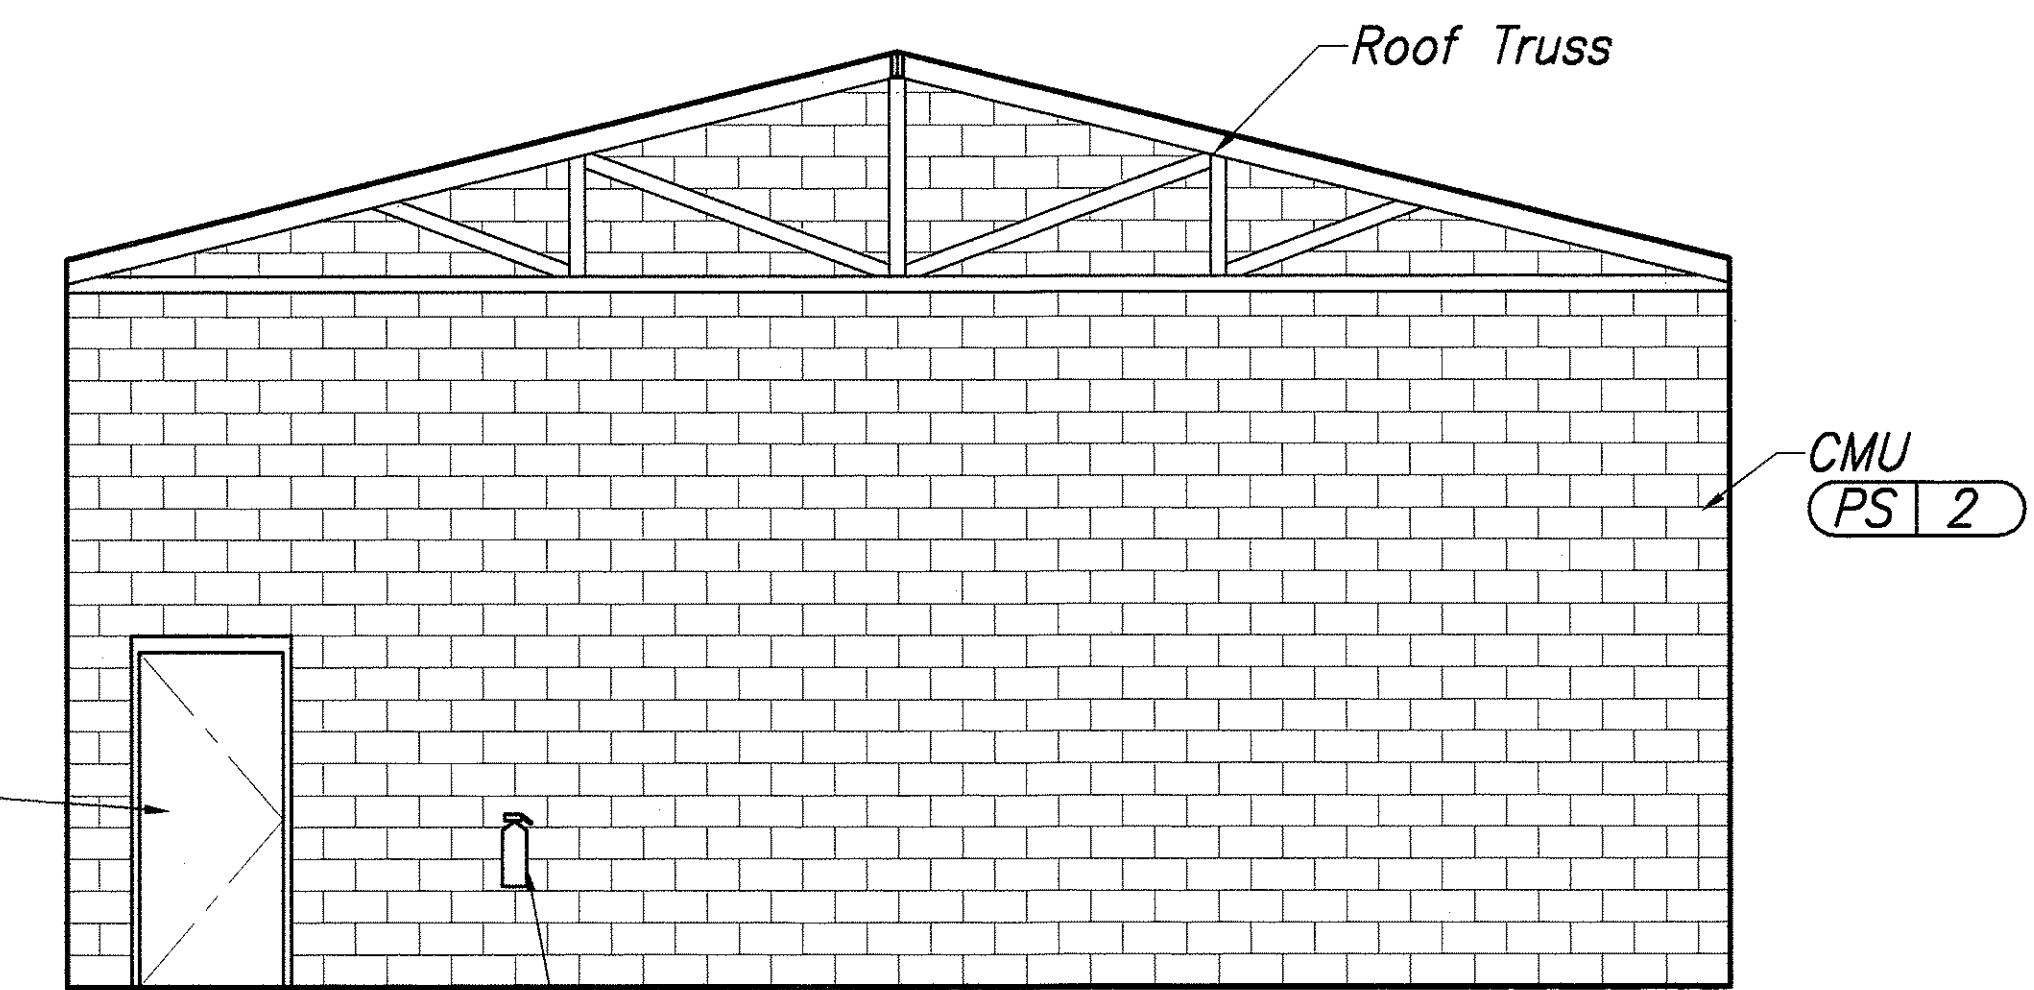

D


VEHICLE GARAGE AREA
Scale: 1/4"=1'-0"

1
A3.01 A3.07

Legend

(CT 1) Material Finish Or Color,
See COLOR AND MATERIAL
SCHEDULE, Sheet A5.05


SURVEY PLOTTED BY	DATE
DRAWN BY	
DESIGNED BY	
QUANTITIES BY	
CHECKED BY	
ORIGINAL PLAN	
NOTE BOOK	XX
No.	

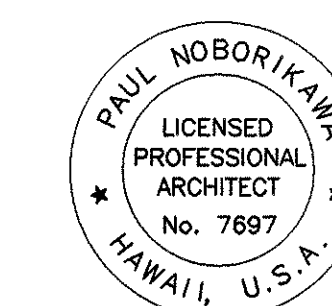

THIS WORK WAS PREPARED BY ME
OR UNDER MY SUPERVISION


STATE OF HAWAII
DEPARTMENT OF TRANSPORTATION
HIGHWAYS DIVISION
**GARAGE/STORAGE BUILDING
INTERIOR ELEVATIONS**
WAHIAWA BASEYARD
IMPROVEMENTS
Project No. HWY-0-12-00
Scale: AS SHOWN Date: JAN. 2003
SHEET No. A3.07 OF 82 SHEETS

FED. ROAD DIST. NO.	STATE	PROJ. NO.	FISCAL YEAR	SHEET NO.	TOTAL SHEETS
HAWAII	HAW.	HWY-0-12-00	2004	43	82

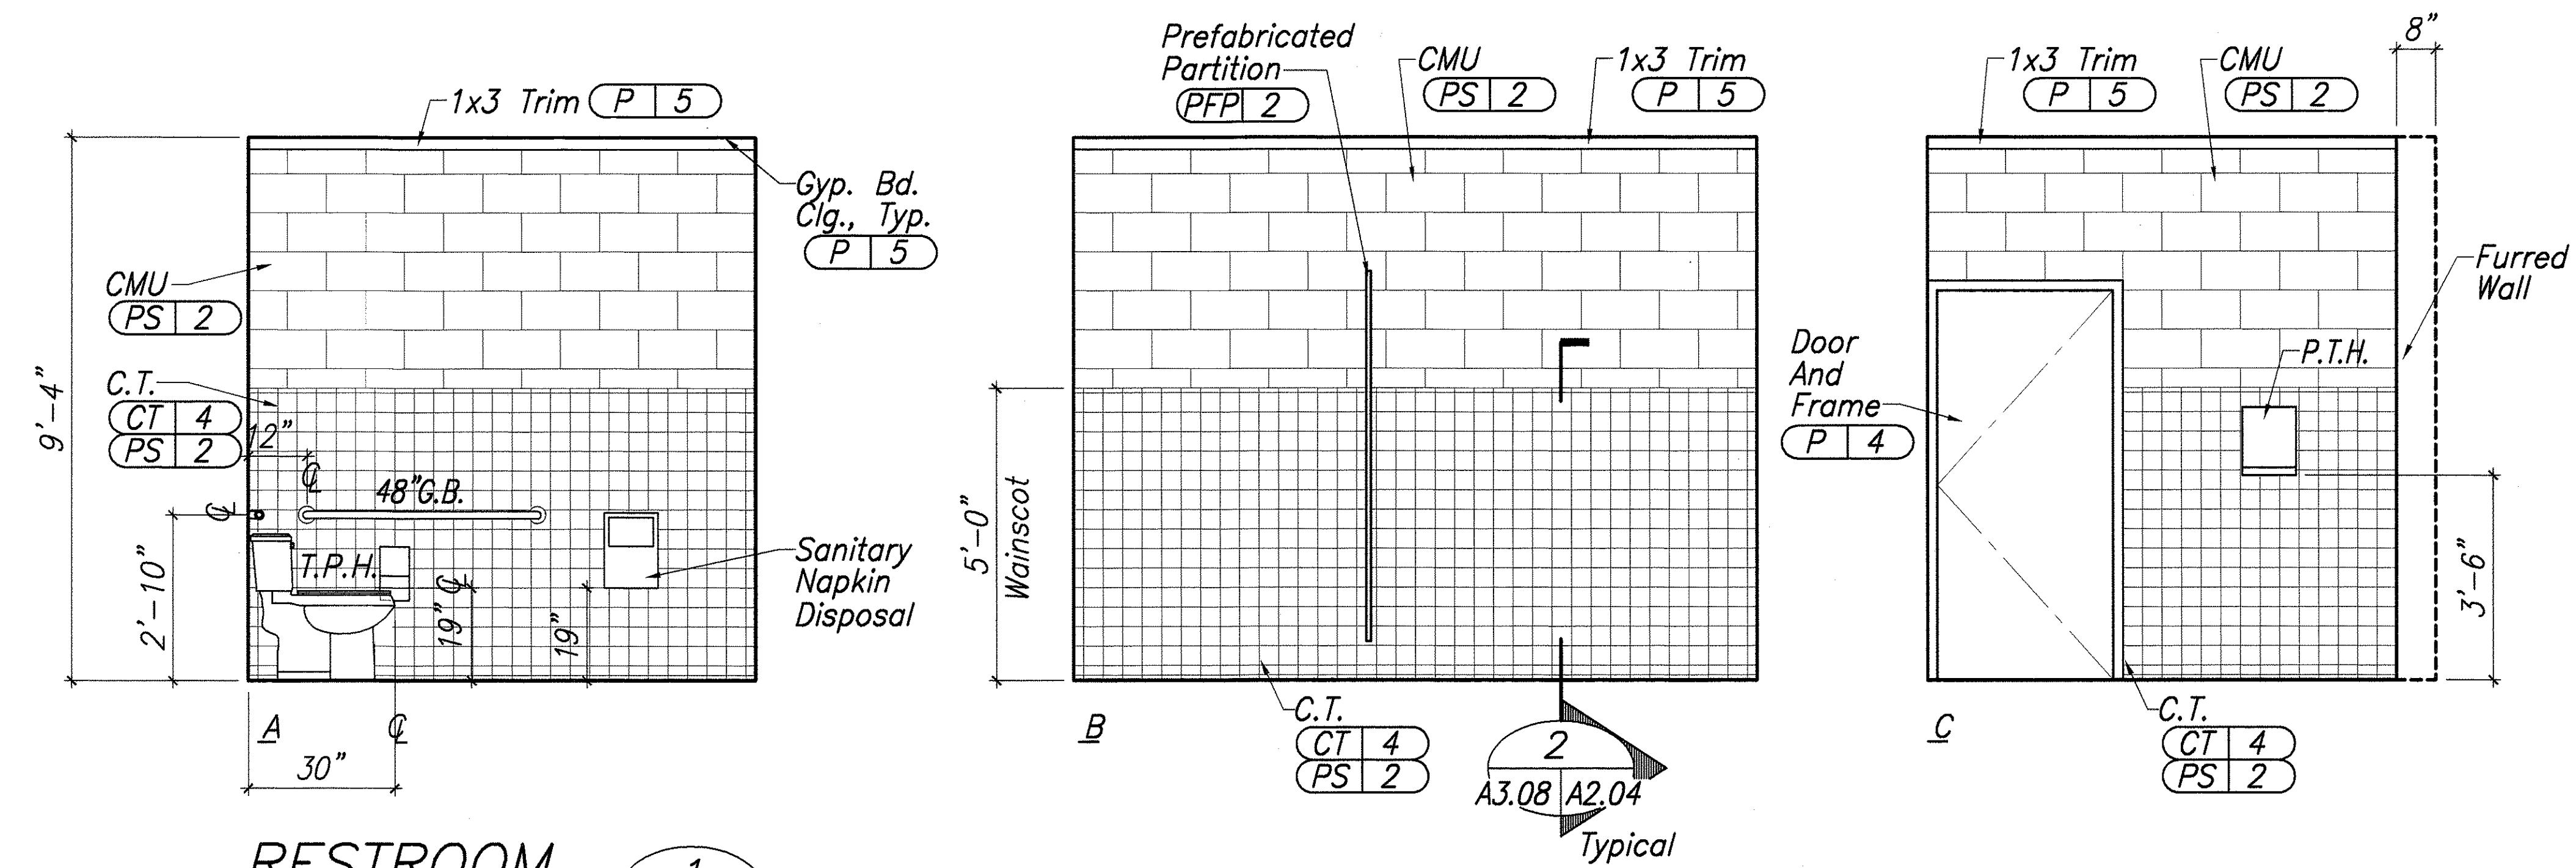


RESTROOM

Scale: 1/2"=1'-0" A3.00 A3.08

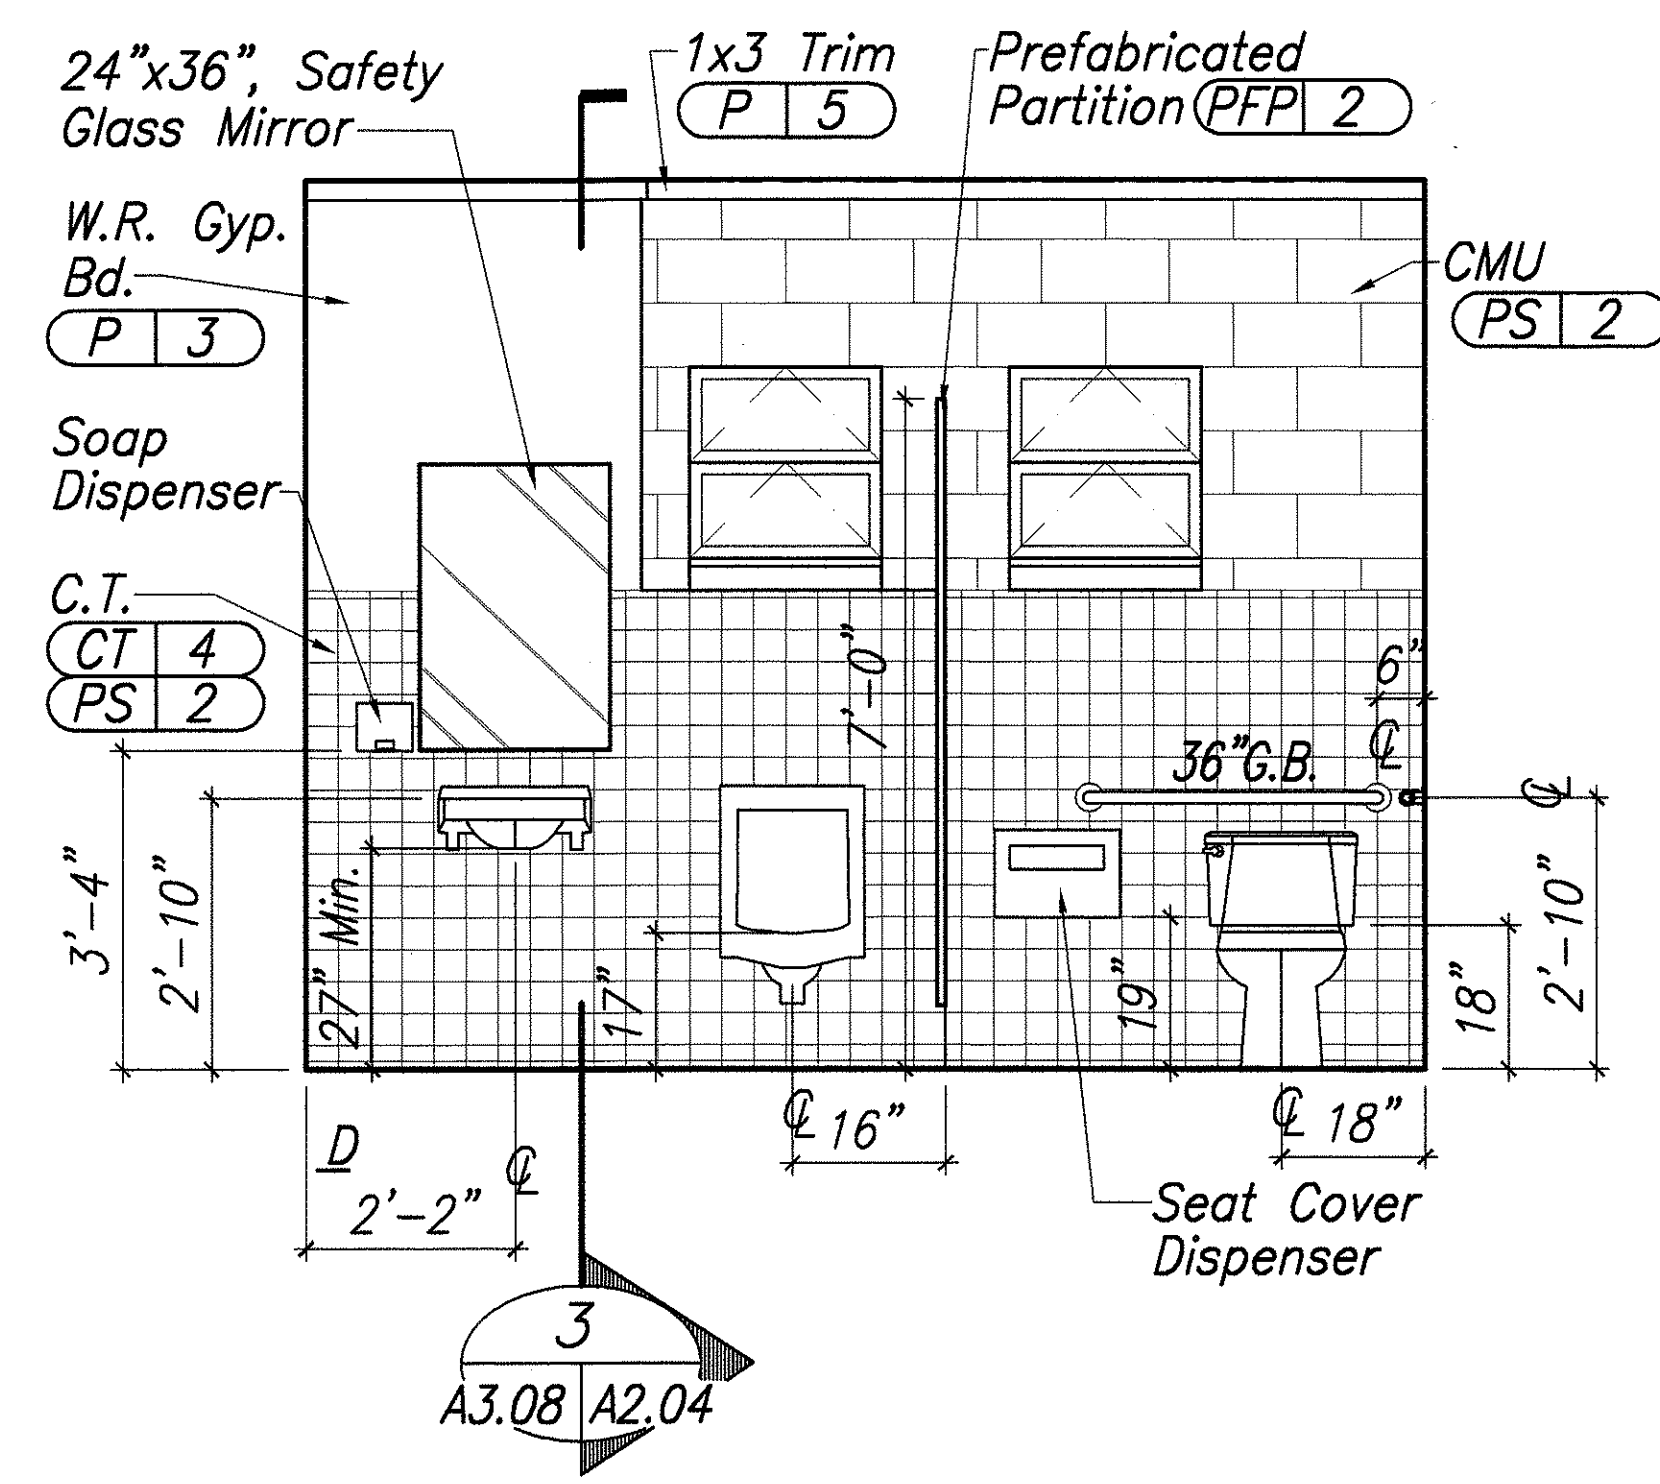

Legend


(CT 1) Material Finish Or Color, See COLOR AND MATERIAL SCHEDULE, Sheet A5.05

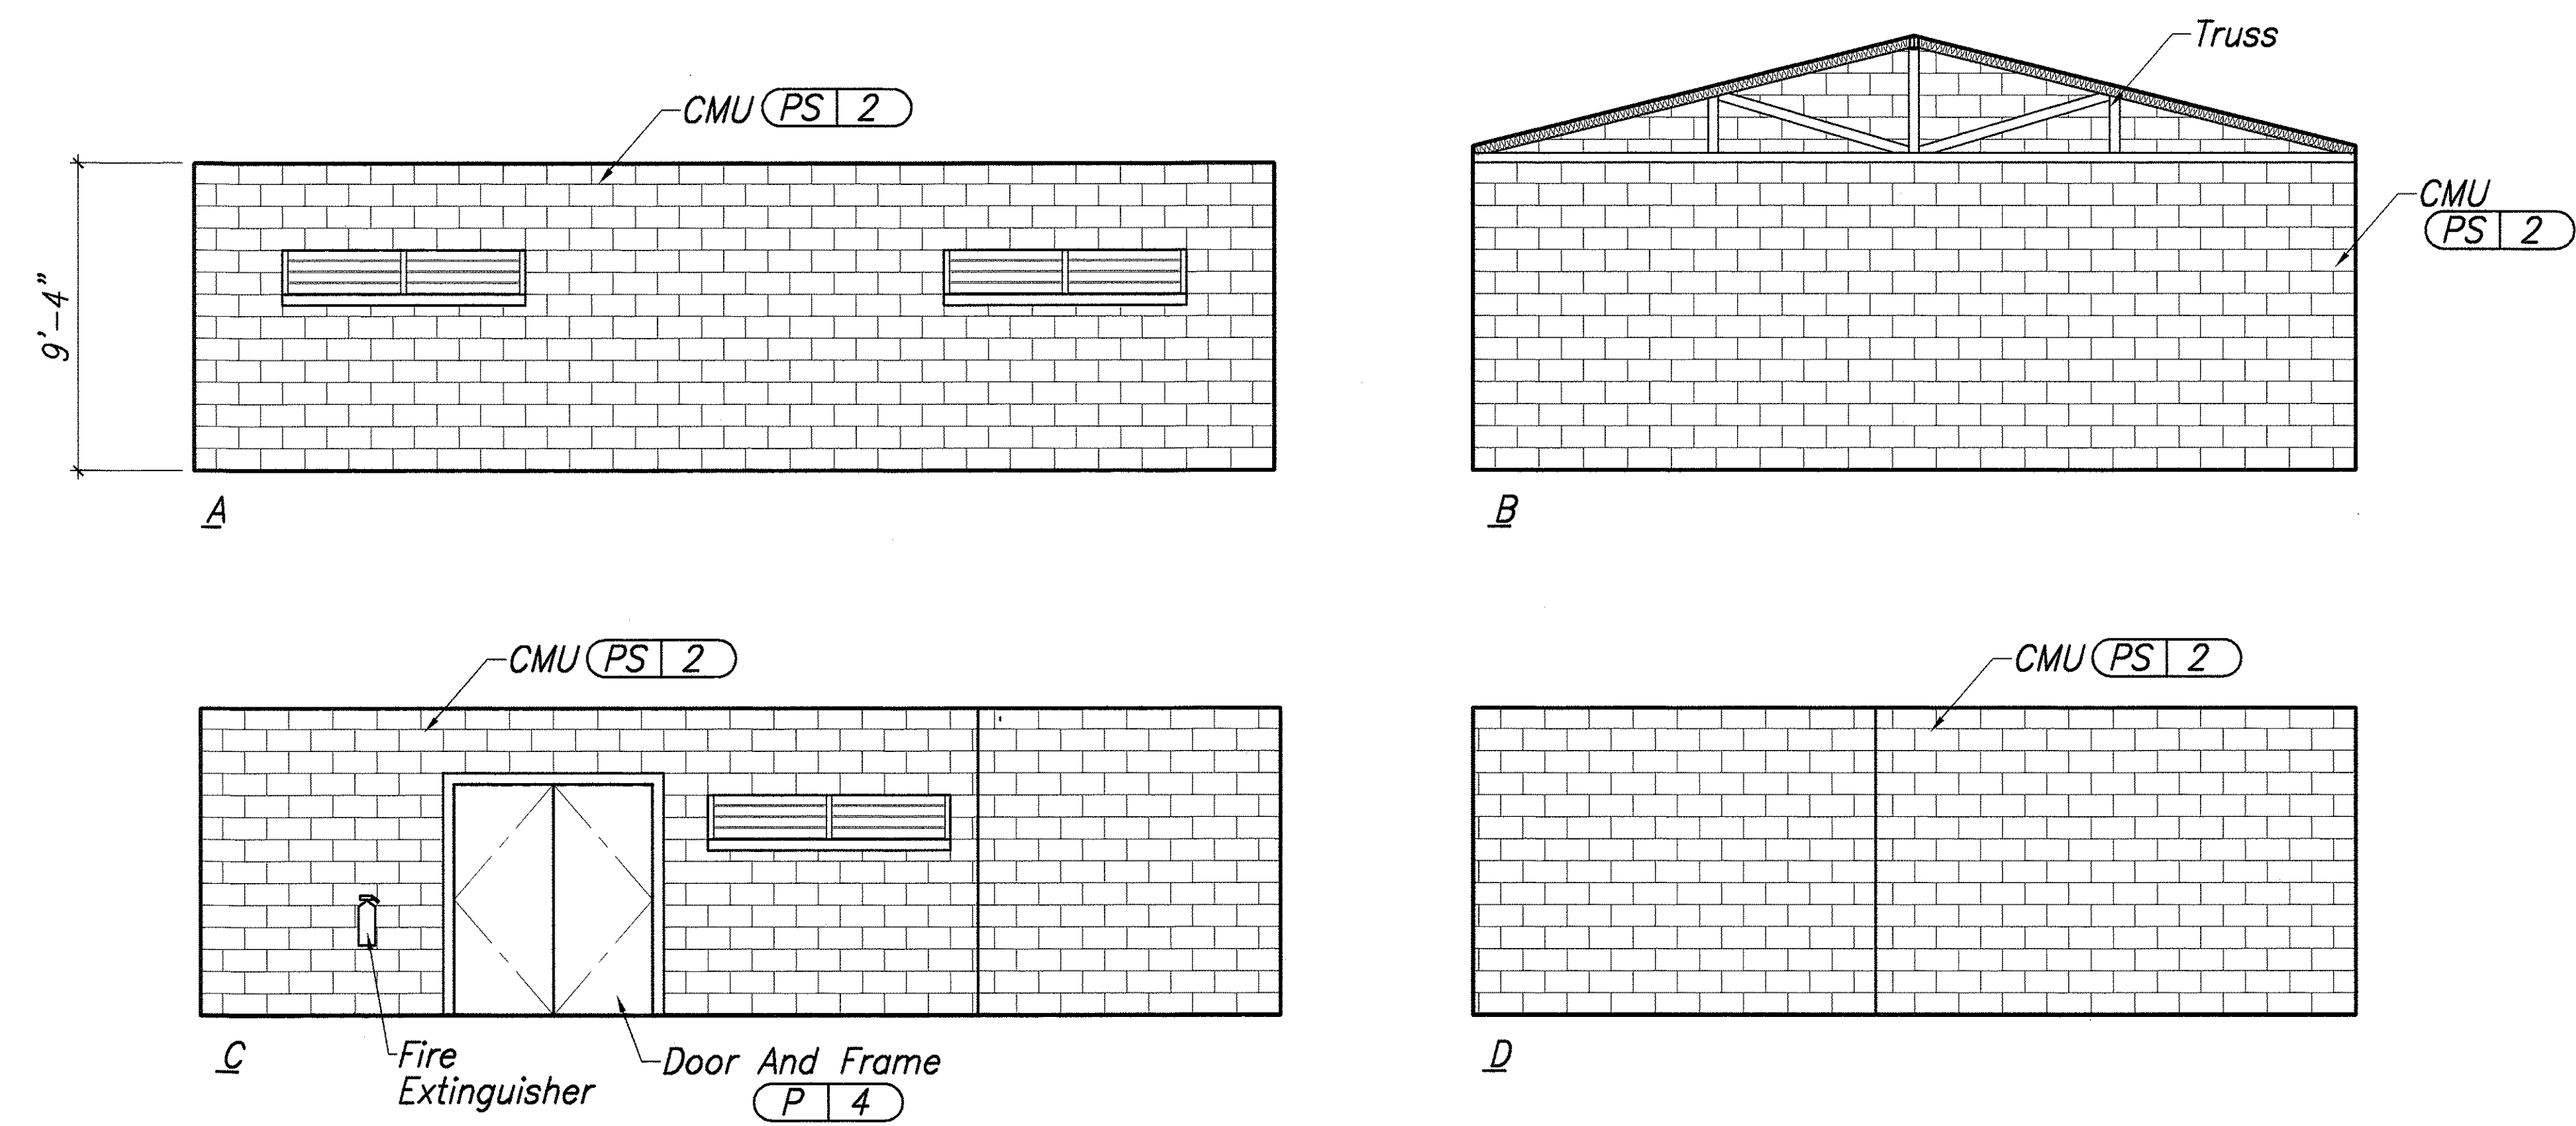

STORAGE ROOM

Scale: 1/4"=1'-0" A3.00 A3.08

SURVEY PLANNED BY	DATE
DRAWN BY	
DESIGNED BY	
CHECKED BY	
ORIGINAL PLAN	
NOTE BOOK	
No.	XX

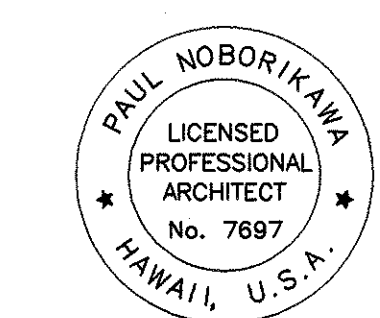

THIS WORK WAS PREPARED BY ME OR UNDER MY SUPERVISION

STATE OF HAWAII
DEPARTMENT OF TRANSPORTATION
HIGHWAYS DIVISION

**GARAGE/STORAGE BUILDING
INTERIOR ELEVATIONS**


WAIHAWA BASEYARD
IMPROVEMENTS

Project No. HWY-0-12-00

Scale: AS SHOWN Date: JAN. 2003

SHEET No. A3.08 OF 82 SHEETS


FED. ROAD DIST. NO.	STATE	PROJ. NO.	FISCAL YEAR	SHEET NO.	TOTAL SHEETS
HAWAII	HAW.	HWY-0-12-00	2004	44	82

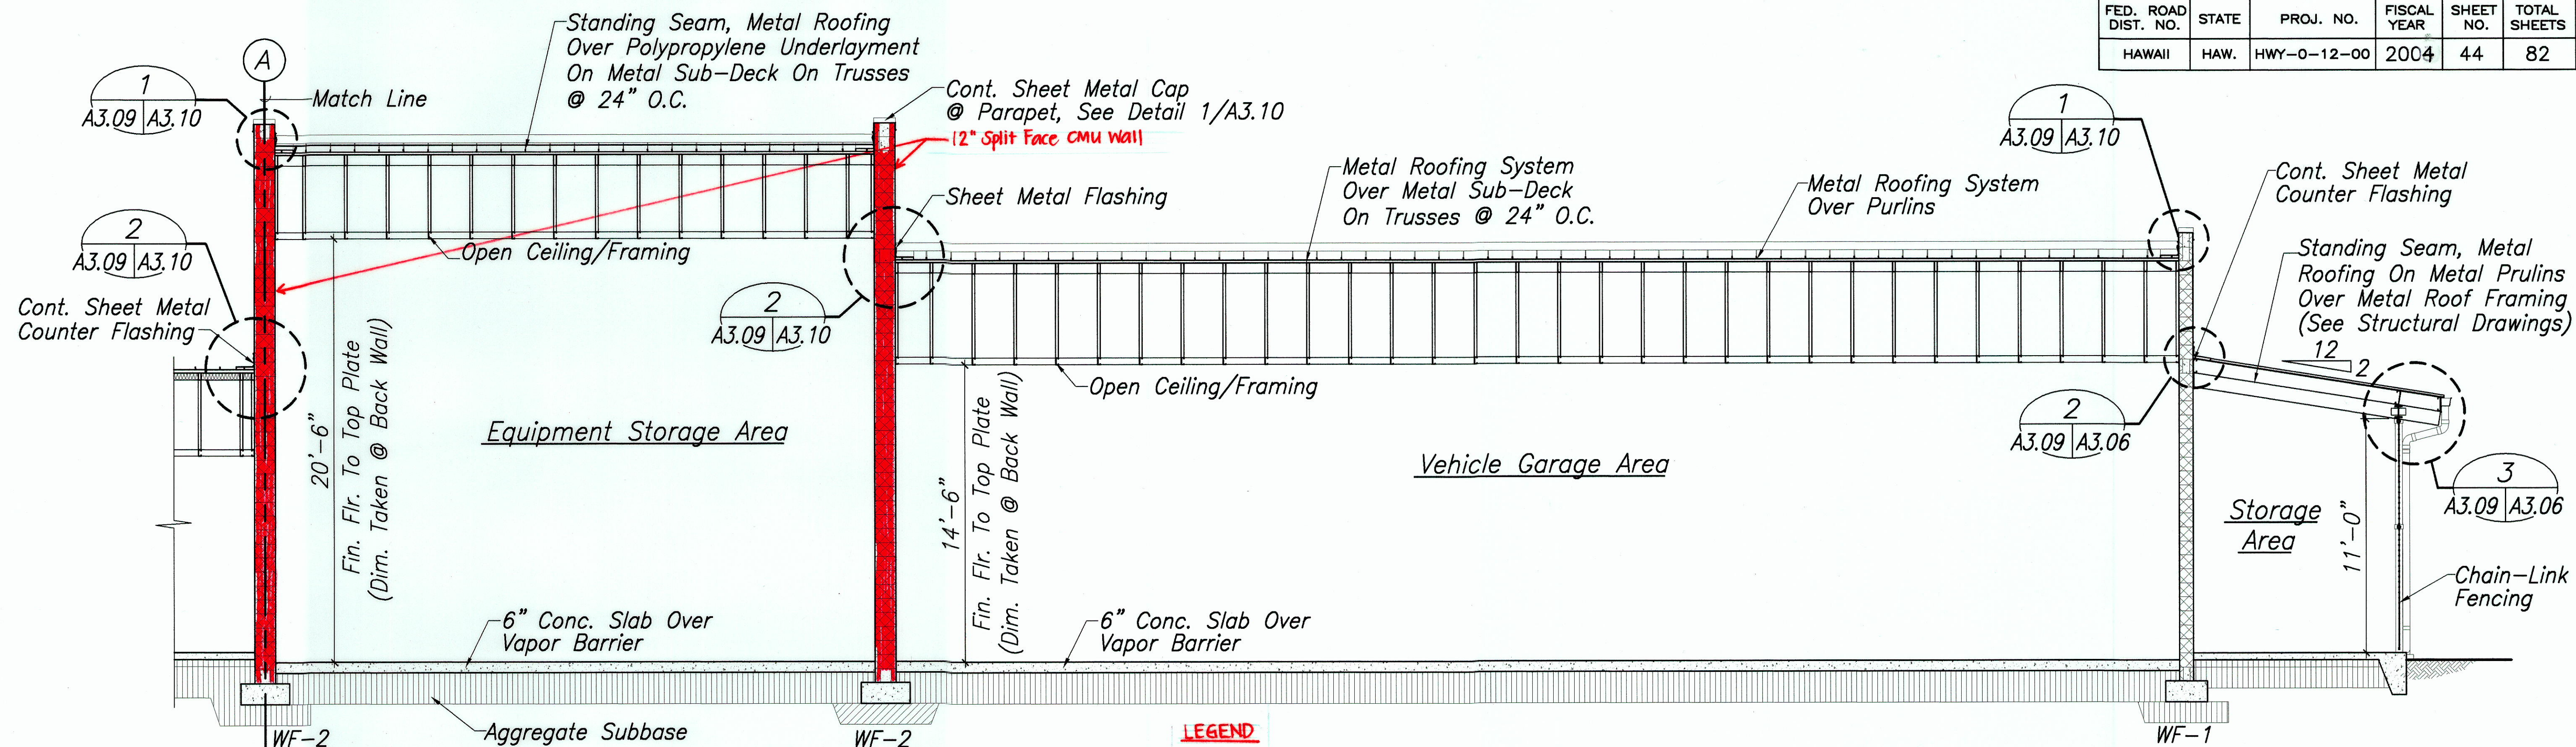


BUILDING SECTION A
Scale: 1/4"=1'-0"

LEGEND

	8" Split Face CMU Wall
	12" Split Face CMU Wall
	6" CMU Partition

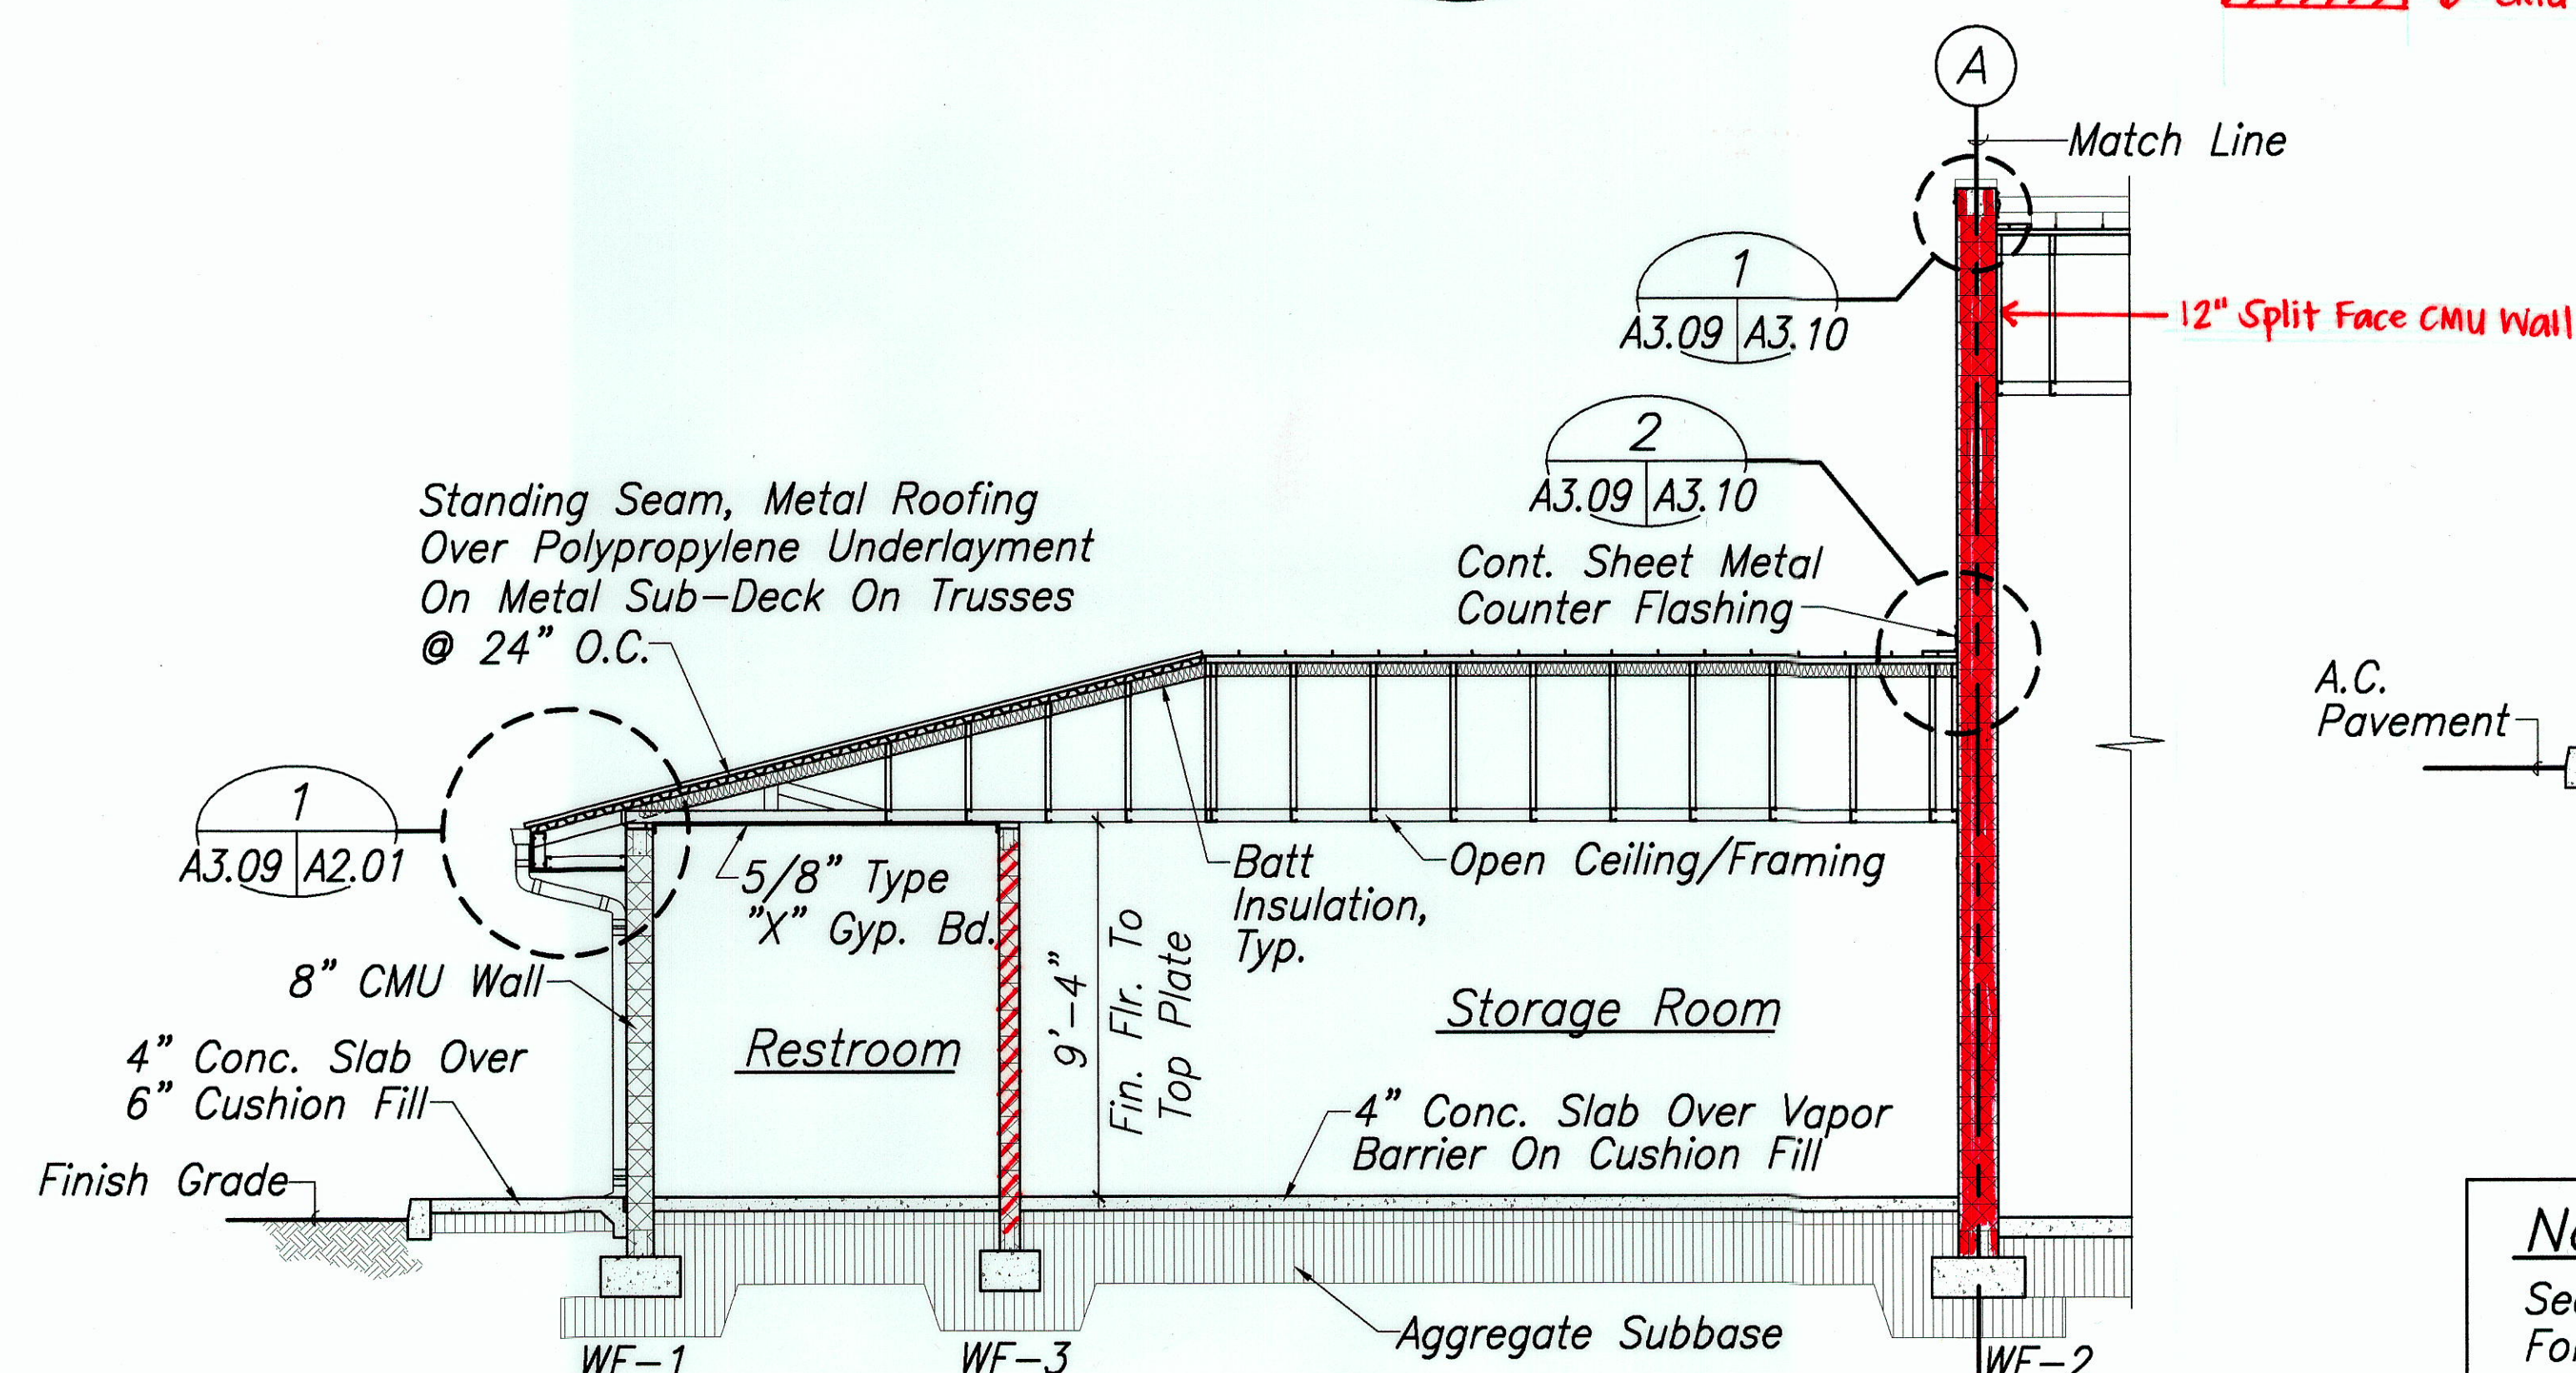


BUILDING SECTION A1
Scale: 1/4"=1'-0"

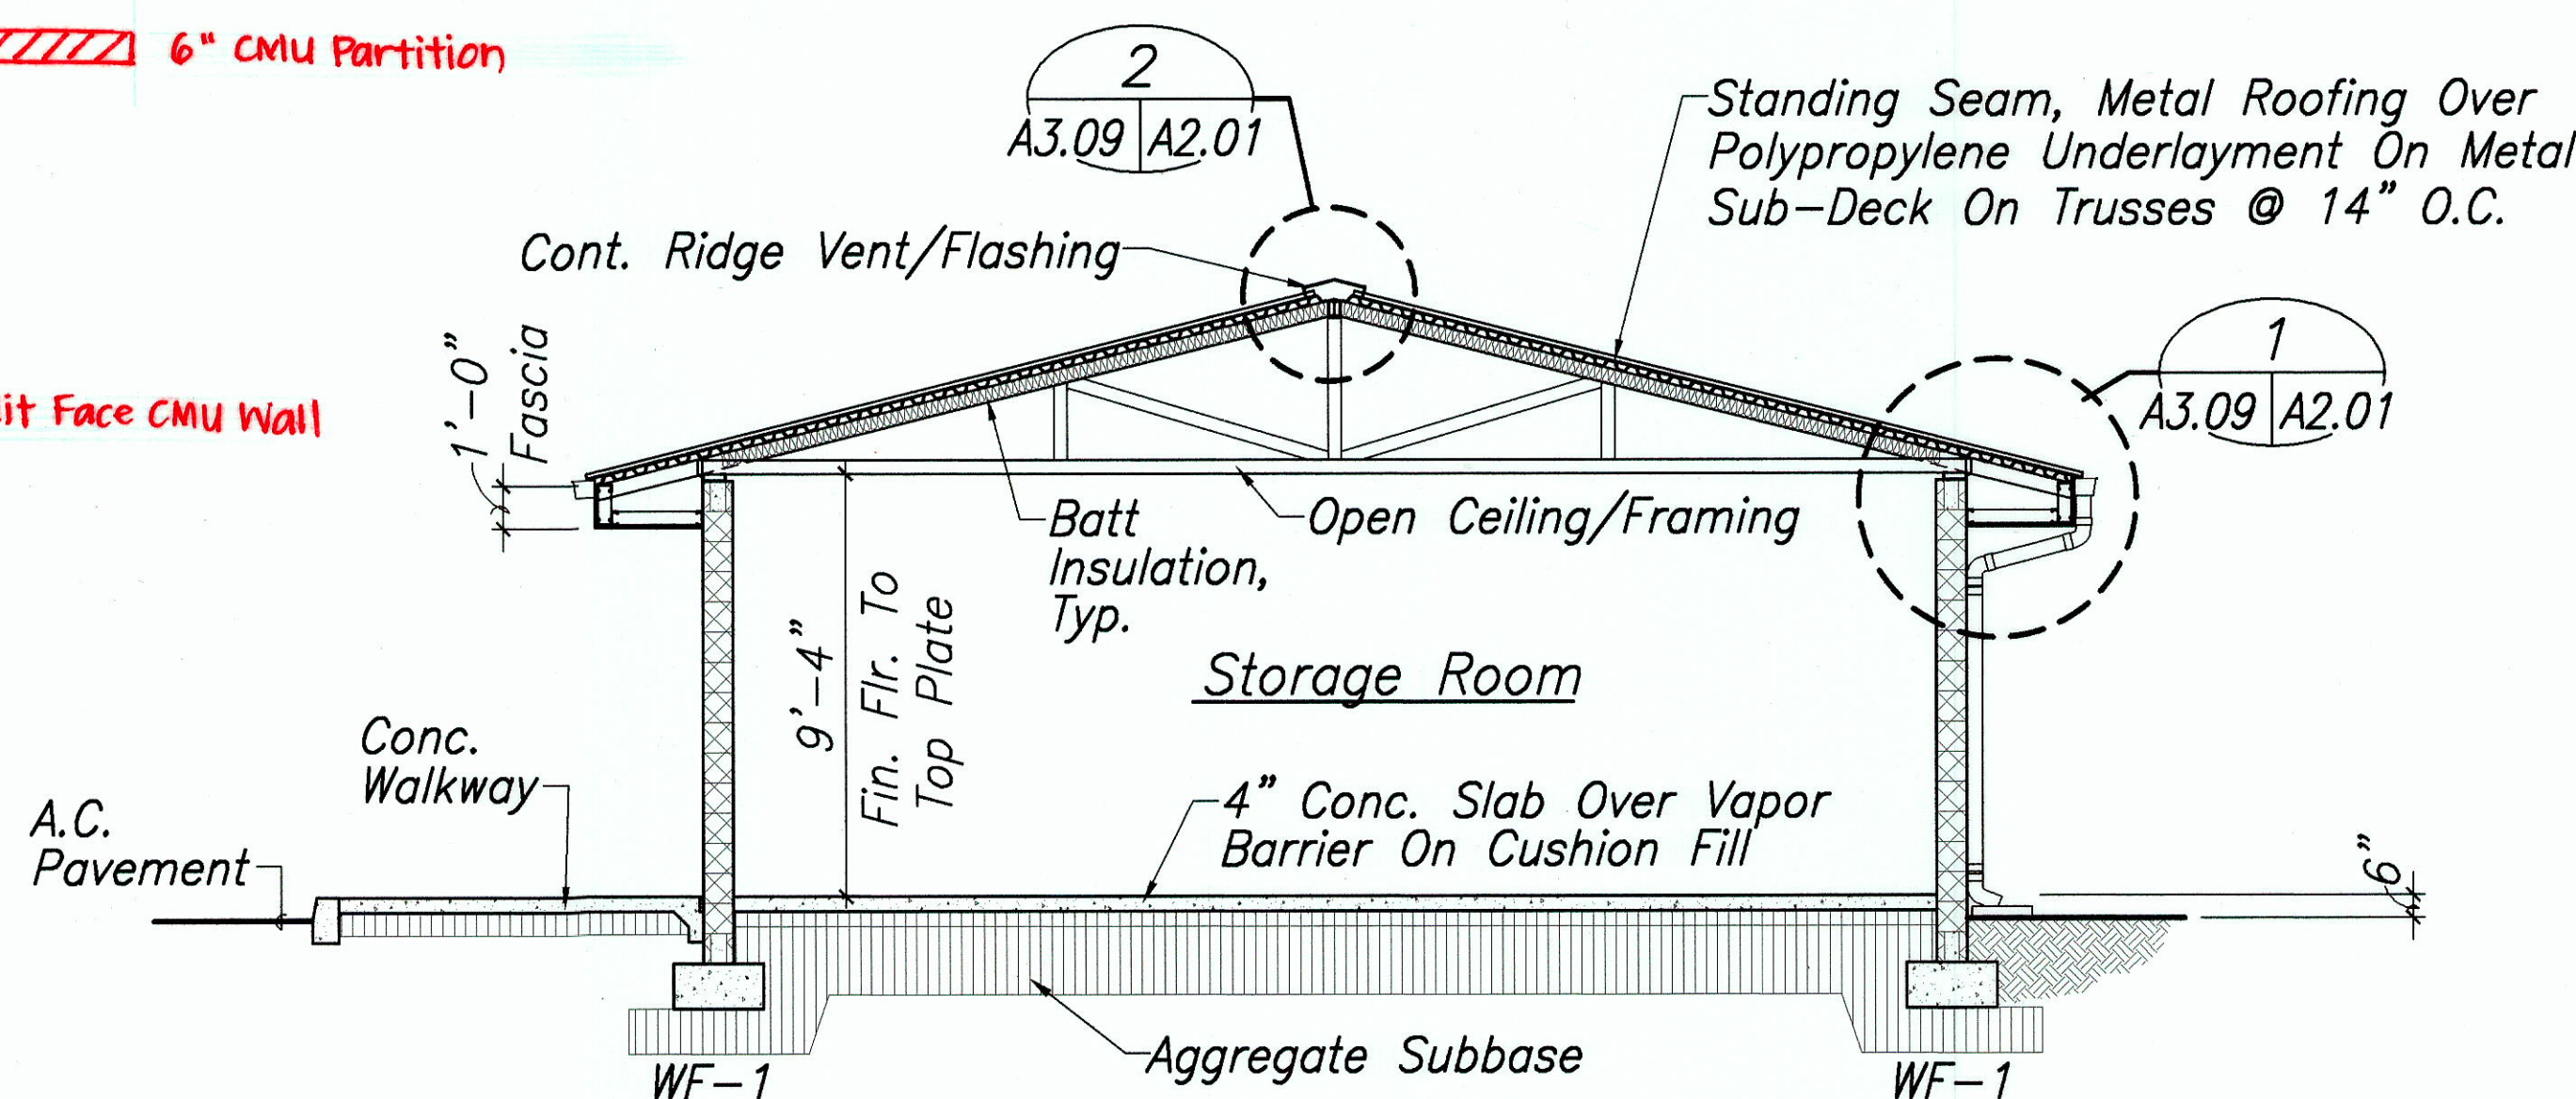

BUILDING SECTION B
Scale: 1/4"=1'-0"

Note:
See S3.01 And S3.02
For Structural Legend


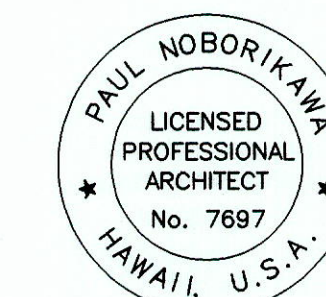


THIS WORK WAS PREPARED BY ME OR UNDER MY SUPERVISION



STATE OF HAWAII
DEPARTMENT OF TRANSPORTATION
HIGHWAYS DIVISION
GARAGE/STORAGE BUILDING BUILDING SECTIONS
WAHIAWA BASEYARD IMPROVEMENTS
Project No. HWY-0-12-00
Scale: AS SHOWN Date: JAN. 2003
SHEET No. A3.09 OF 82 SHEETS

"AS-BUILT"

FED. ROAD DIST. NO.	STATE	PROJ. NO.	FISCAL YEAR	SHEET NO.	TOTAL SHEETS
HAWAII	HAW.	HWY-0-12-00	2004	45	82

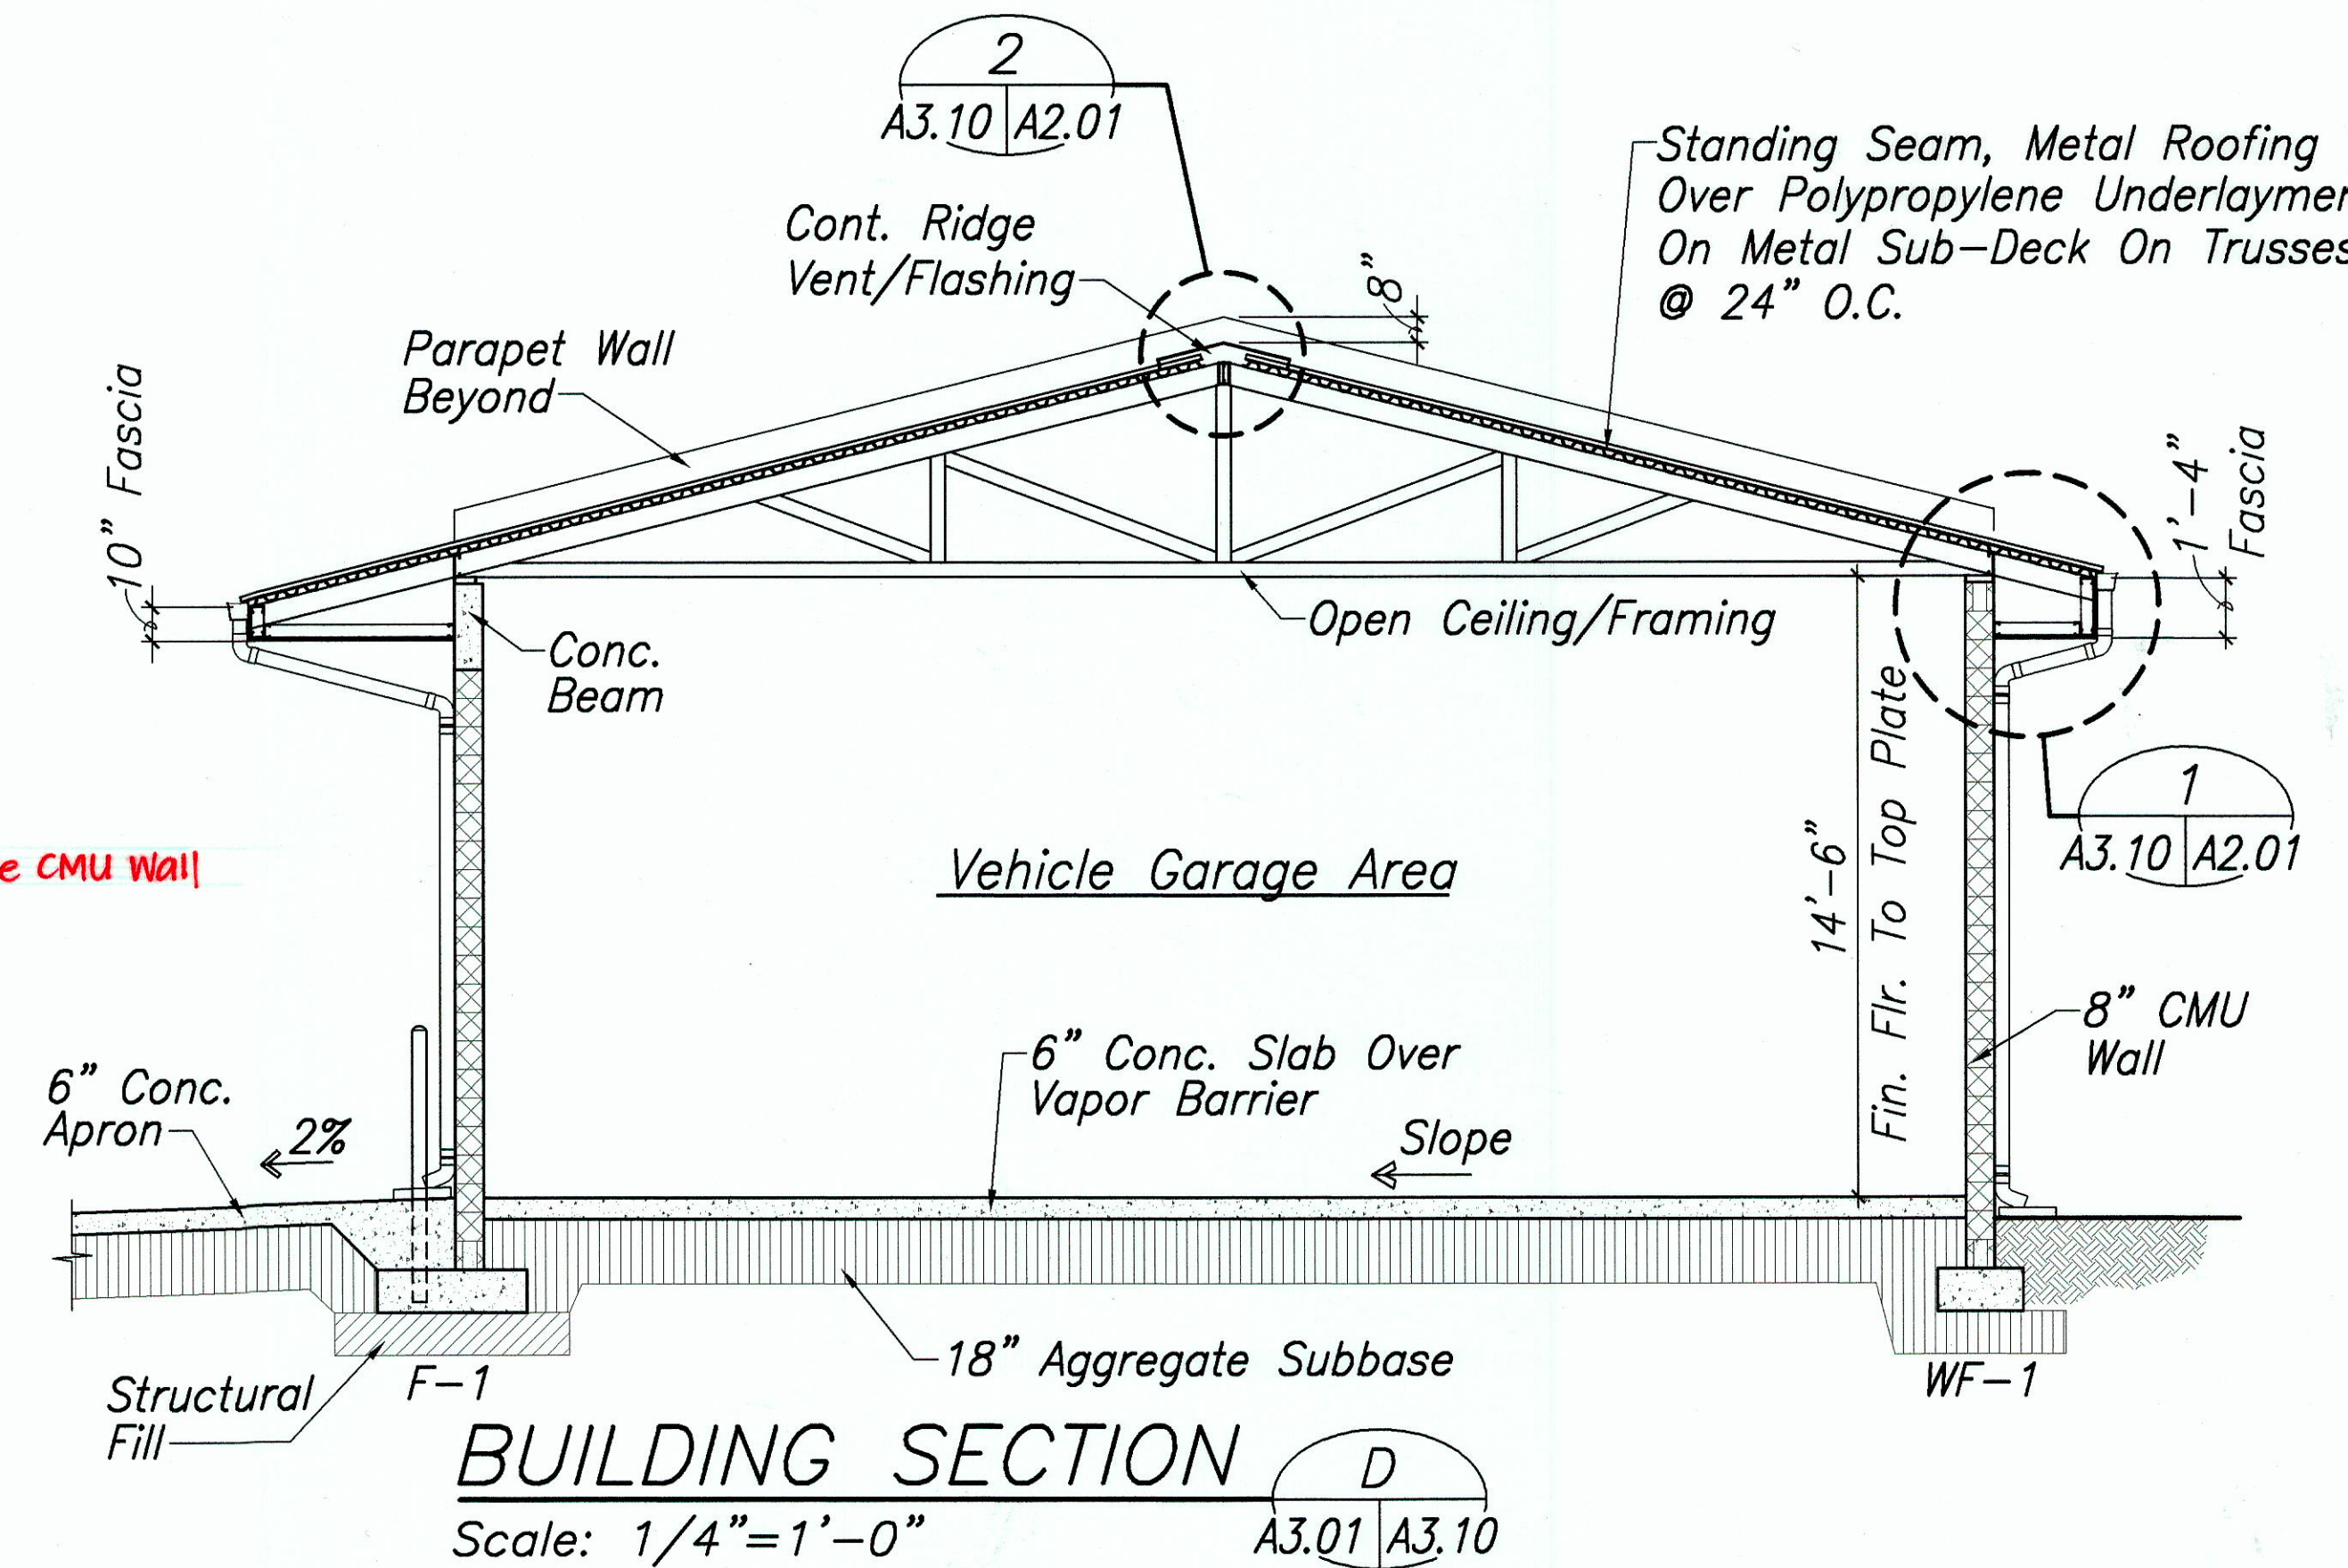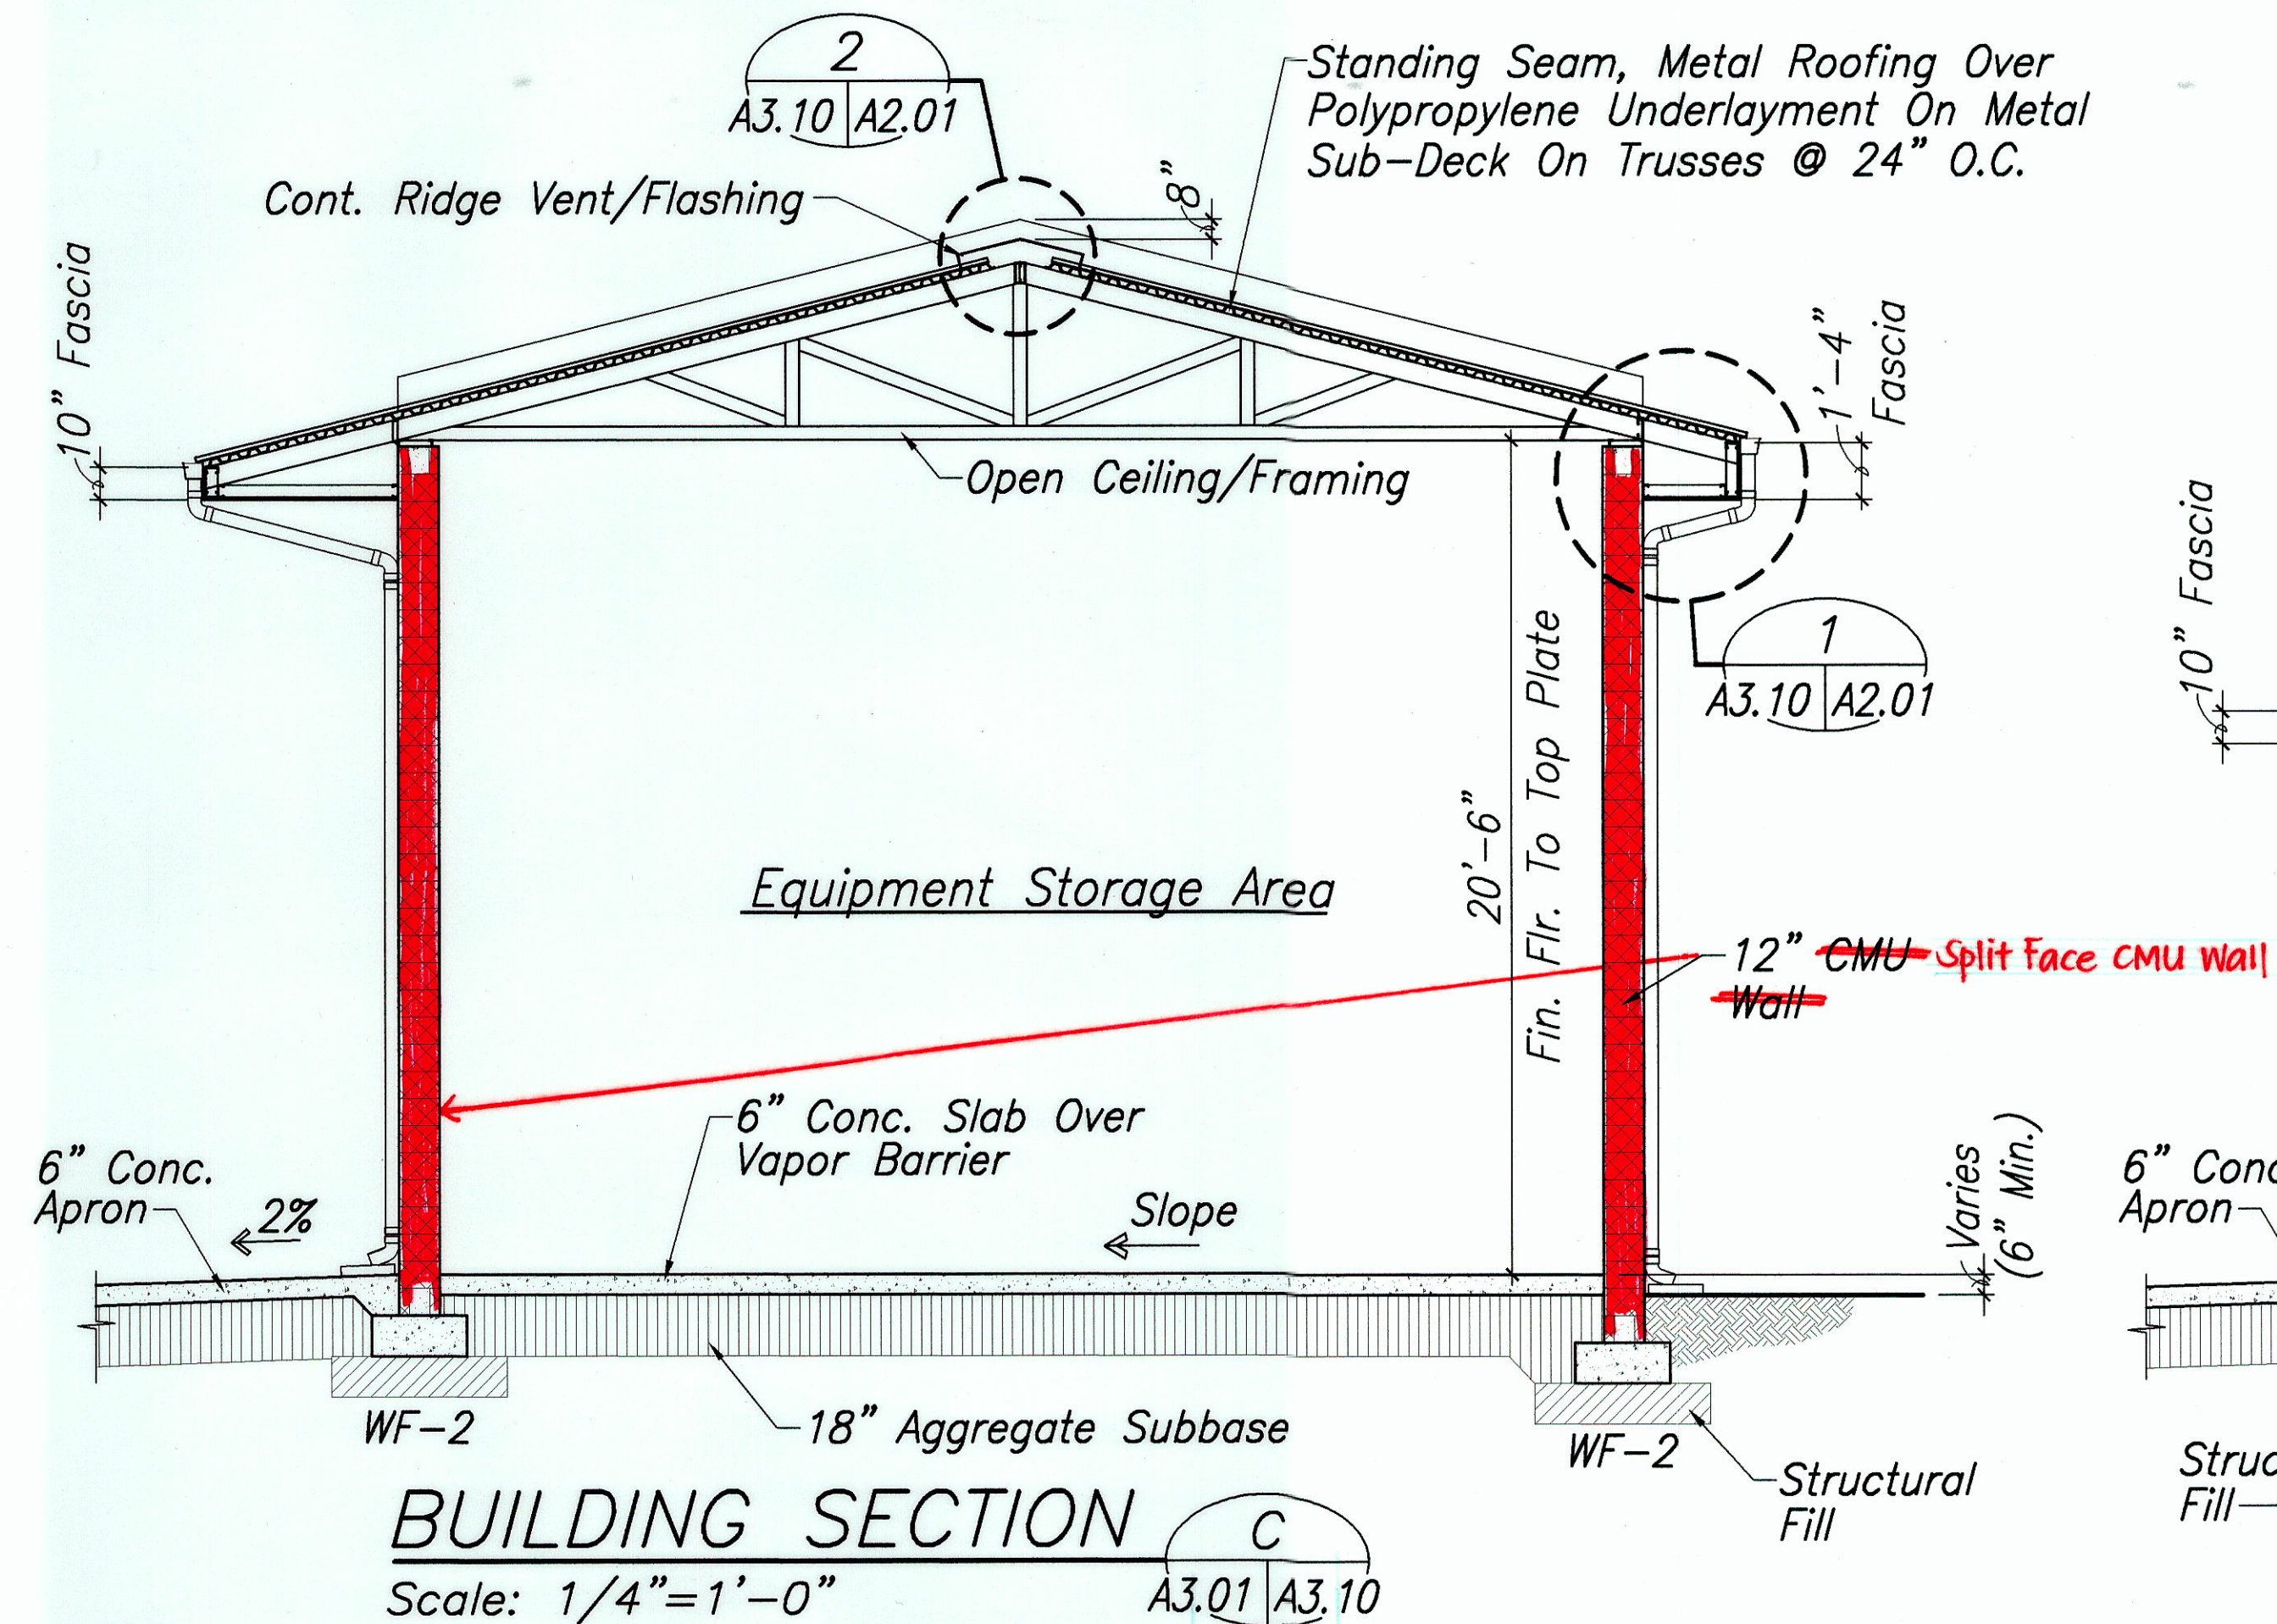

Note:
See S3.01 And S3.02
For Structural Legend

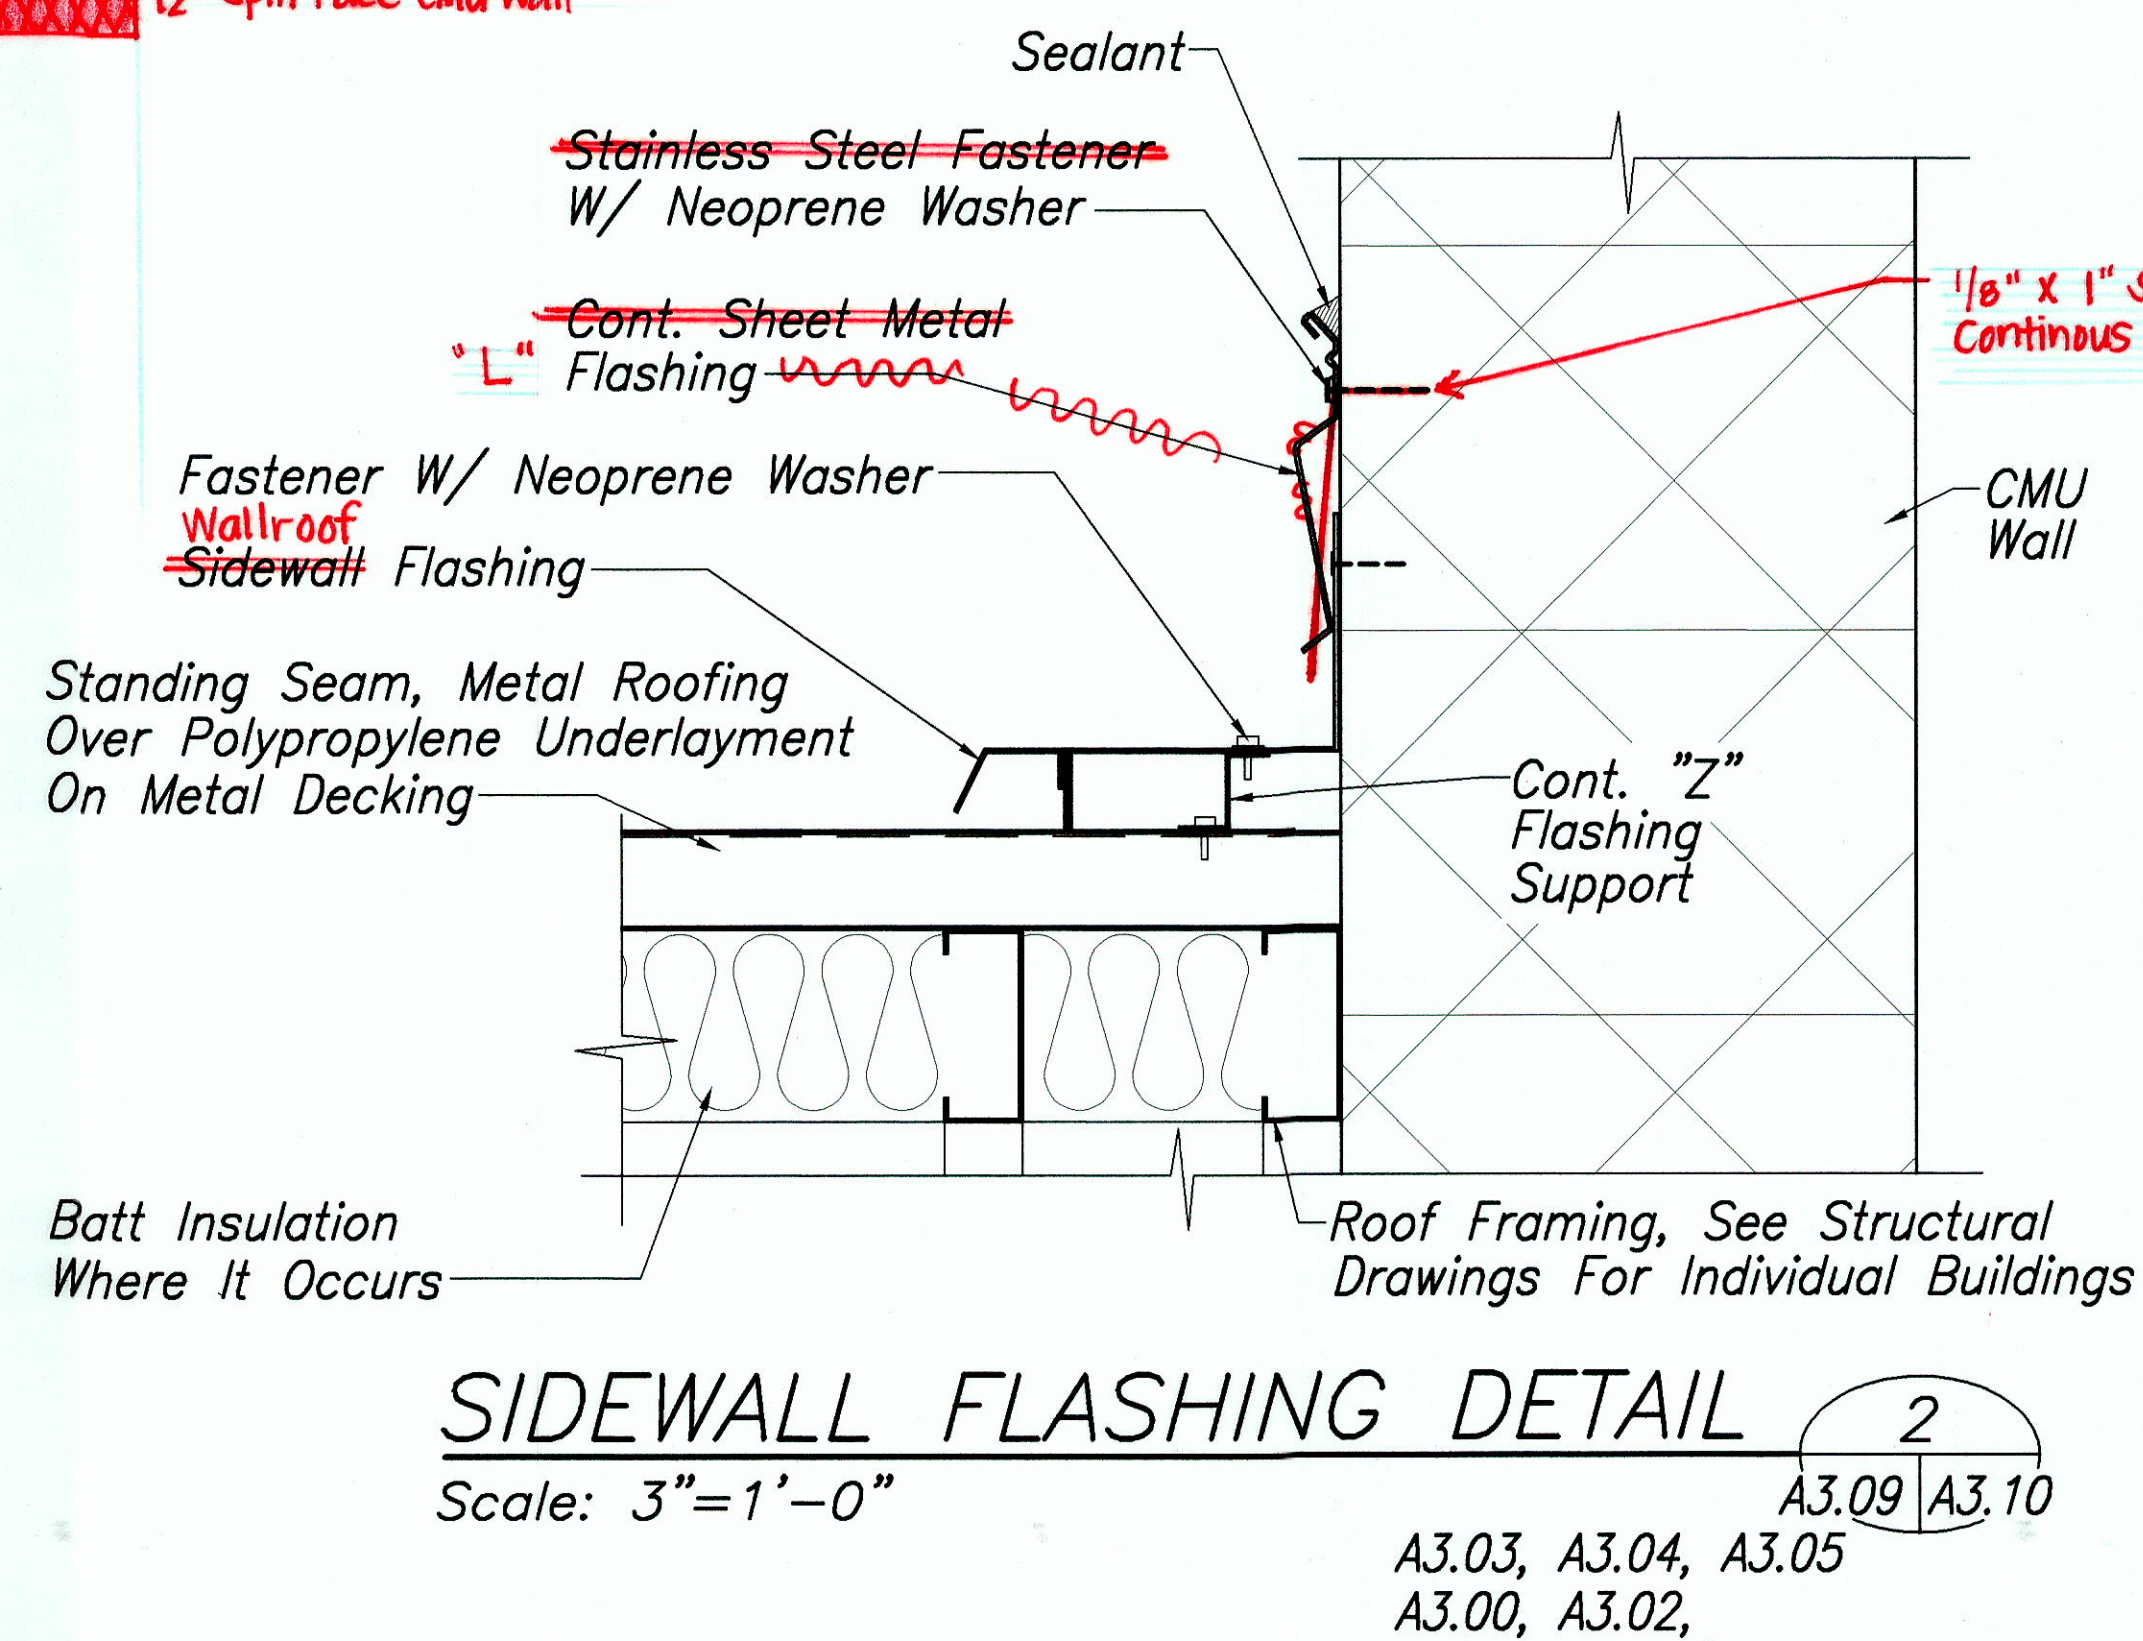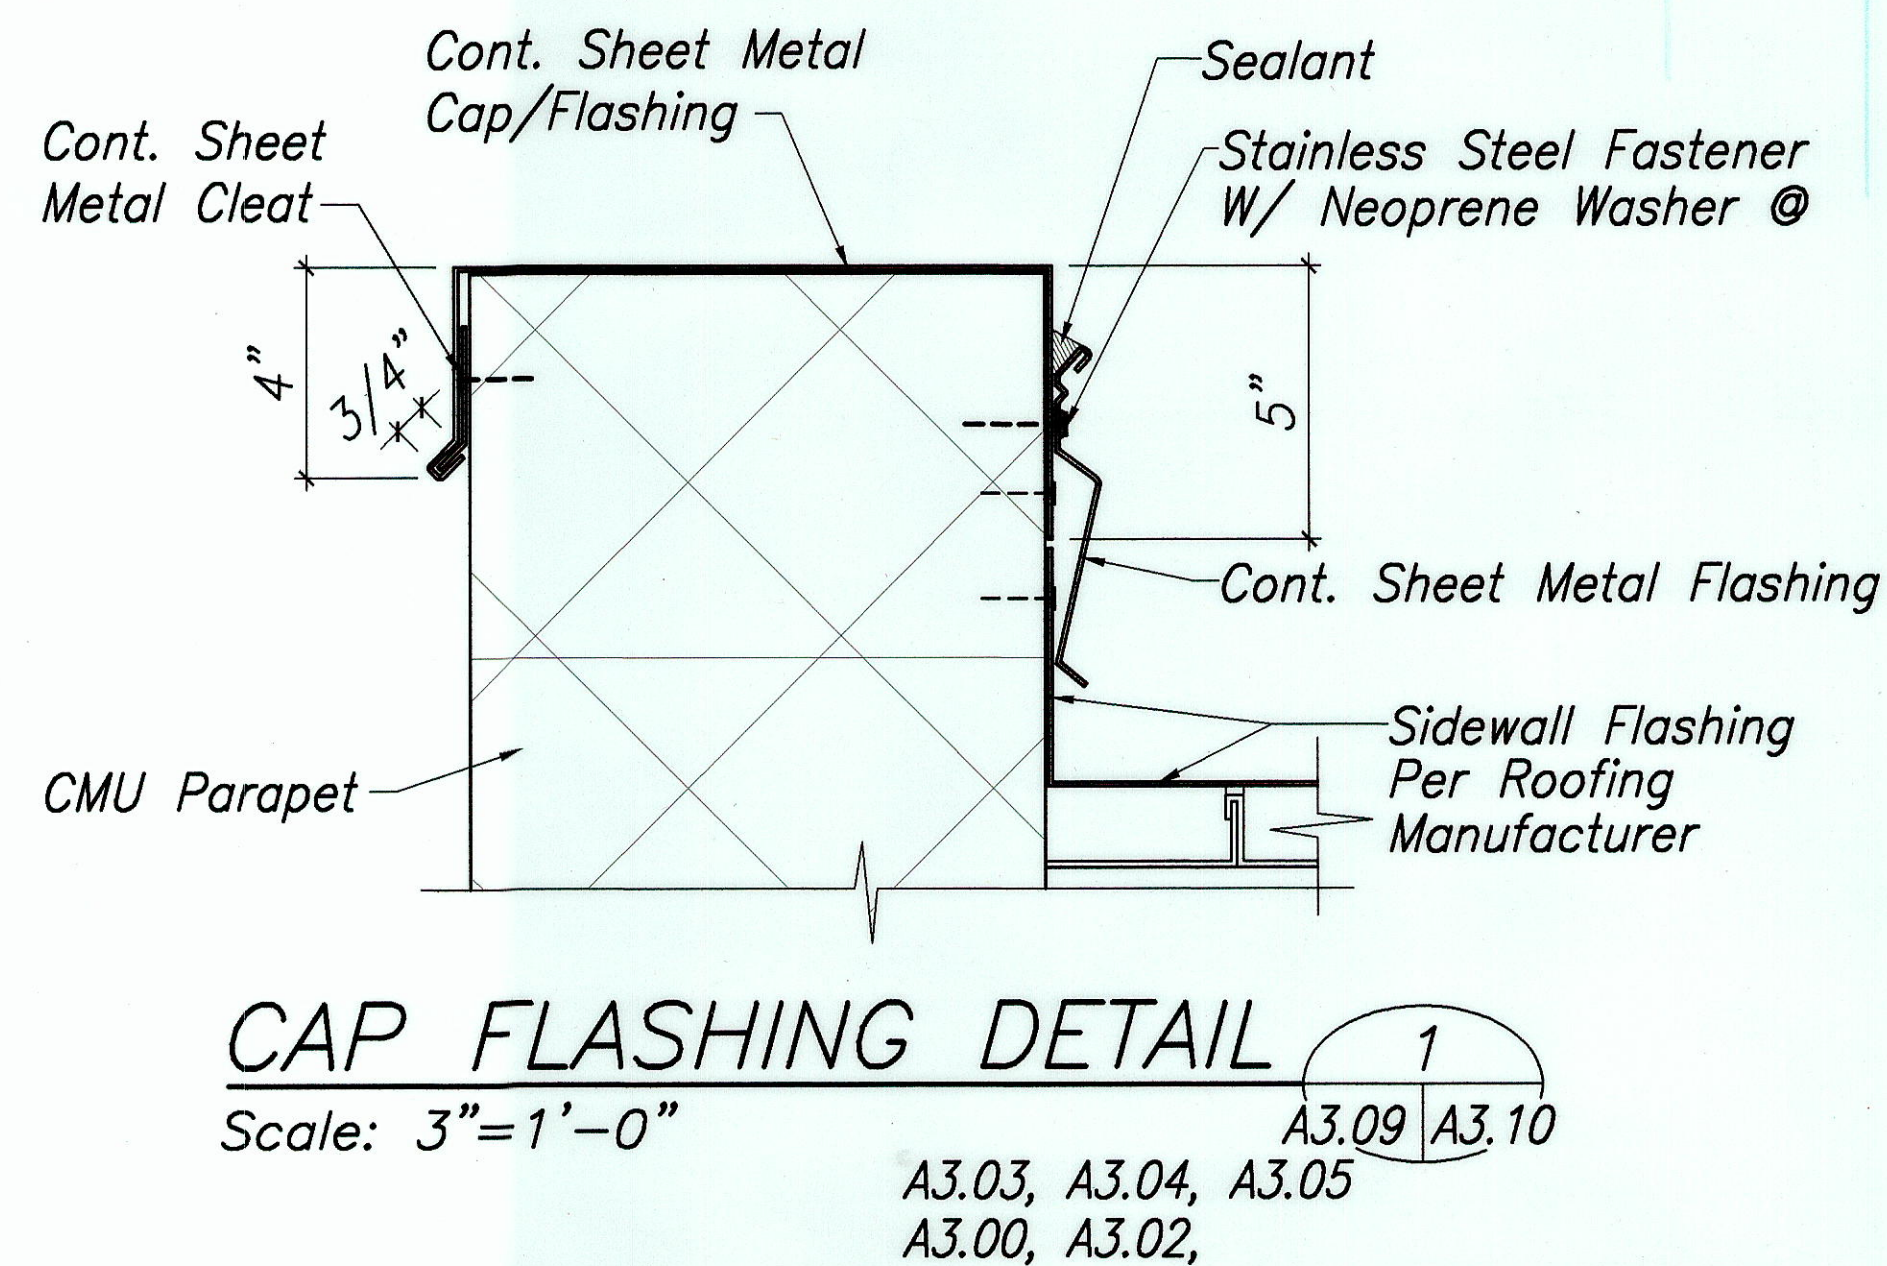

PAUL NOBORIKAWA
★
LICENSED
PROFESSIONAL
ARCHITECT
No. 7697
HAWAII, U.S.A.

STATE OF HAWAII
DEPARTMENT OF TRANSPORTATION
HIGHWAYS DIVISION

GARAGE/STORAGE BUILDING
BUILDING SECTIONS


WAHIAWA BASEYARD
IMPROVEMENTS

Project No. HWY-0-12-00

Scale: AS SHOWN Date: JAN, 2003

SHEET No. **A3.10** OF **82** SHEETS


FED. ROAD DIST. NO.	STATE	PROJ. NO.	FISCAL YEAR	SHEET NO.	TOTAL SHEETS
HAWAII	HAW.	HWY-0-12-00	2004	46	82

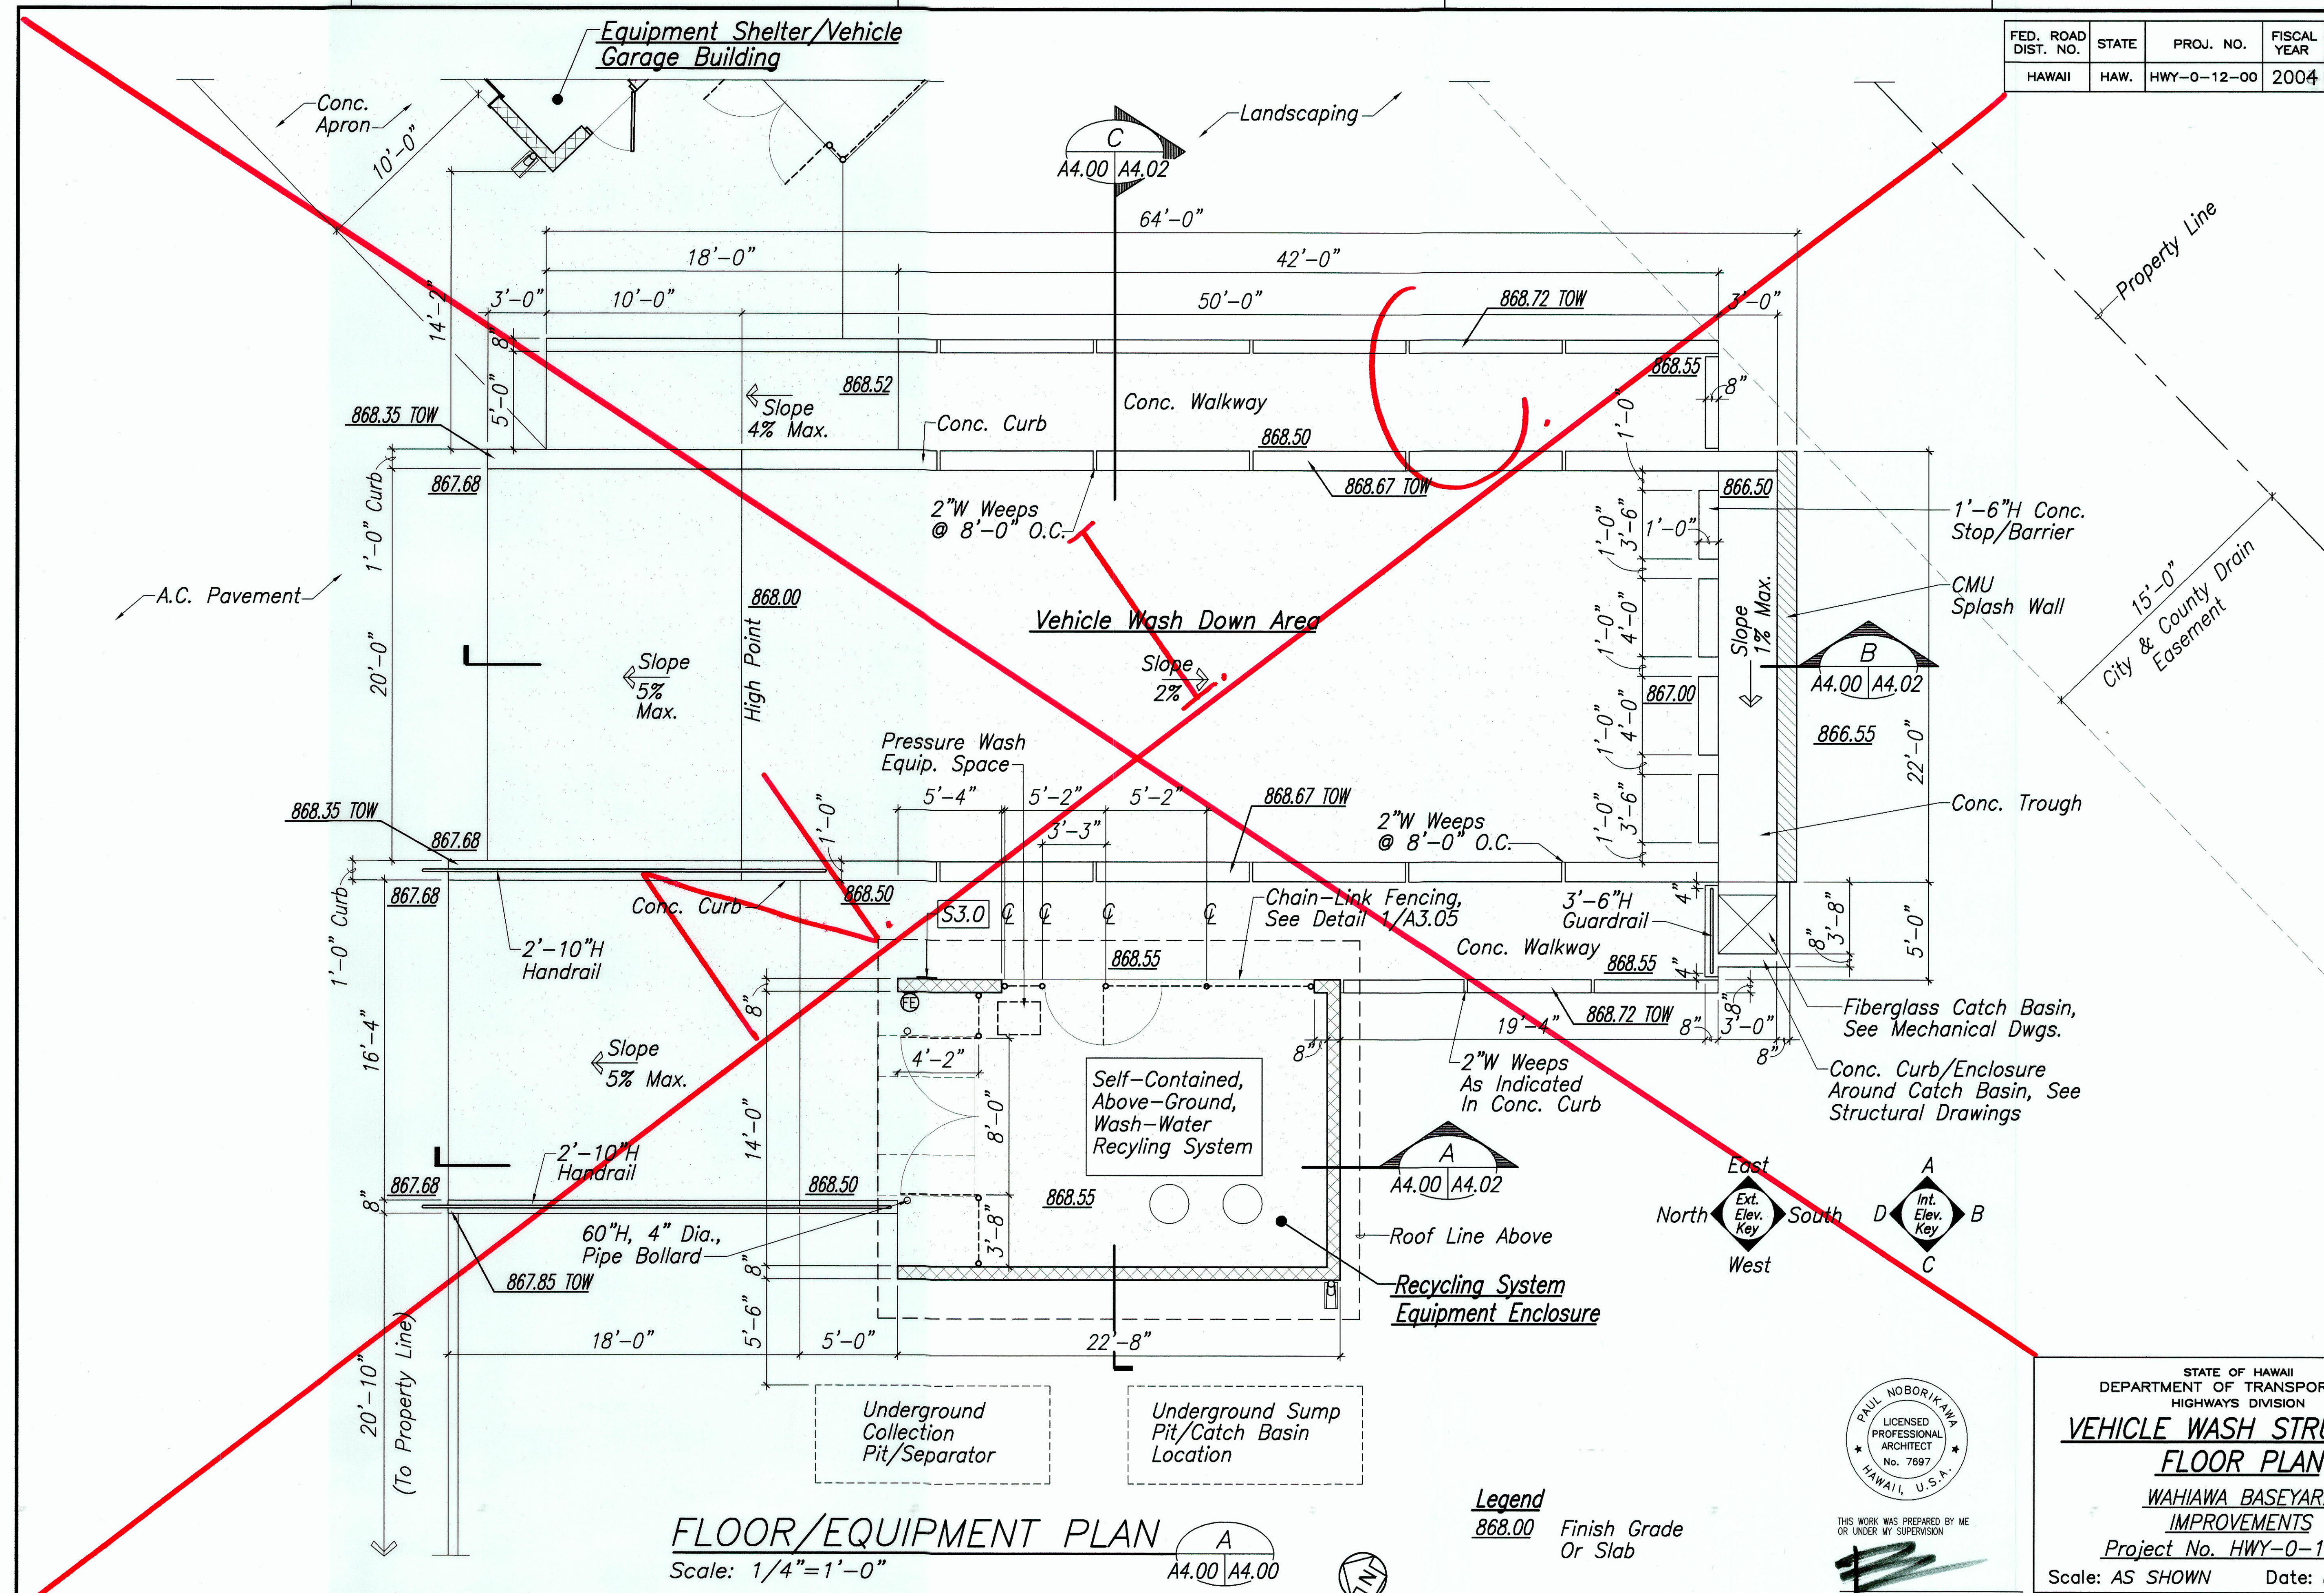

SURVEY PLOTTED BY	DATE
DRAWN BY	
TRACED BY	
NOTED BY	
CHECKED BY	
NO.	XX

FLOOR/EQUIPMENT PLAN
 Scale: 1/4"=1'-0"

Legend
 868.00 Finish Grade Or Slab

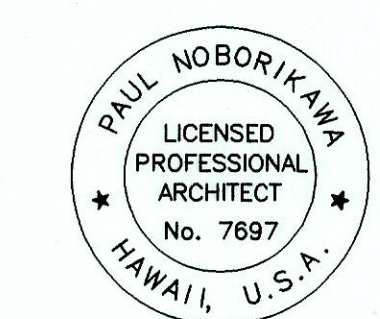

THIS WORK WAS PREPARED BY ME OR UNDER MY SUPERVISION

STATE OF HAWAII
 DEPARTMENT OF TRANSPORTATION
 HIGHWAYS DIVISION

VEHICLE WASH STRUCTURE FLOOR PLAN

WAIHAWA BASEYARD IMPROVEMENTS


Project No. HWY-0-12-00

Scale: AS SHOWN Date: JAN. 2003


SHEET No. A4.00 OF 82 SHEETS

"AS-BUILT"


FED. ROAD DIST. NO.	STATE	PROJ. NO.	FISCAL YEAR	SHEET NO.	TOTAL SHEETS
HAWAII	HAW.	HWY-0-12-00	2004	47	82

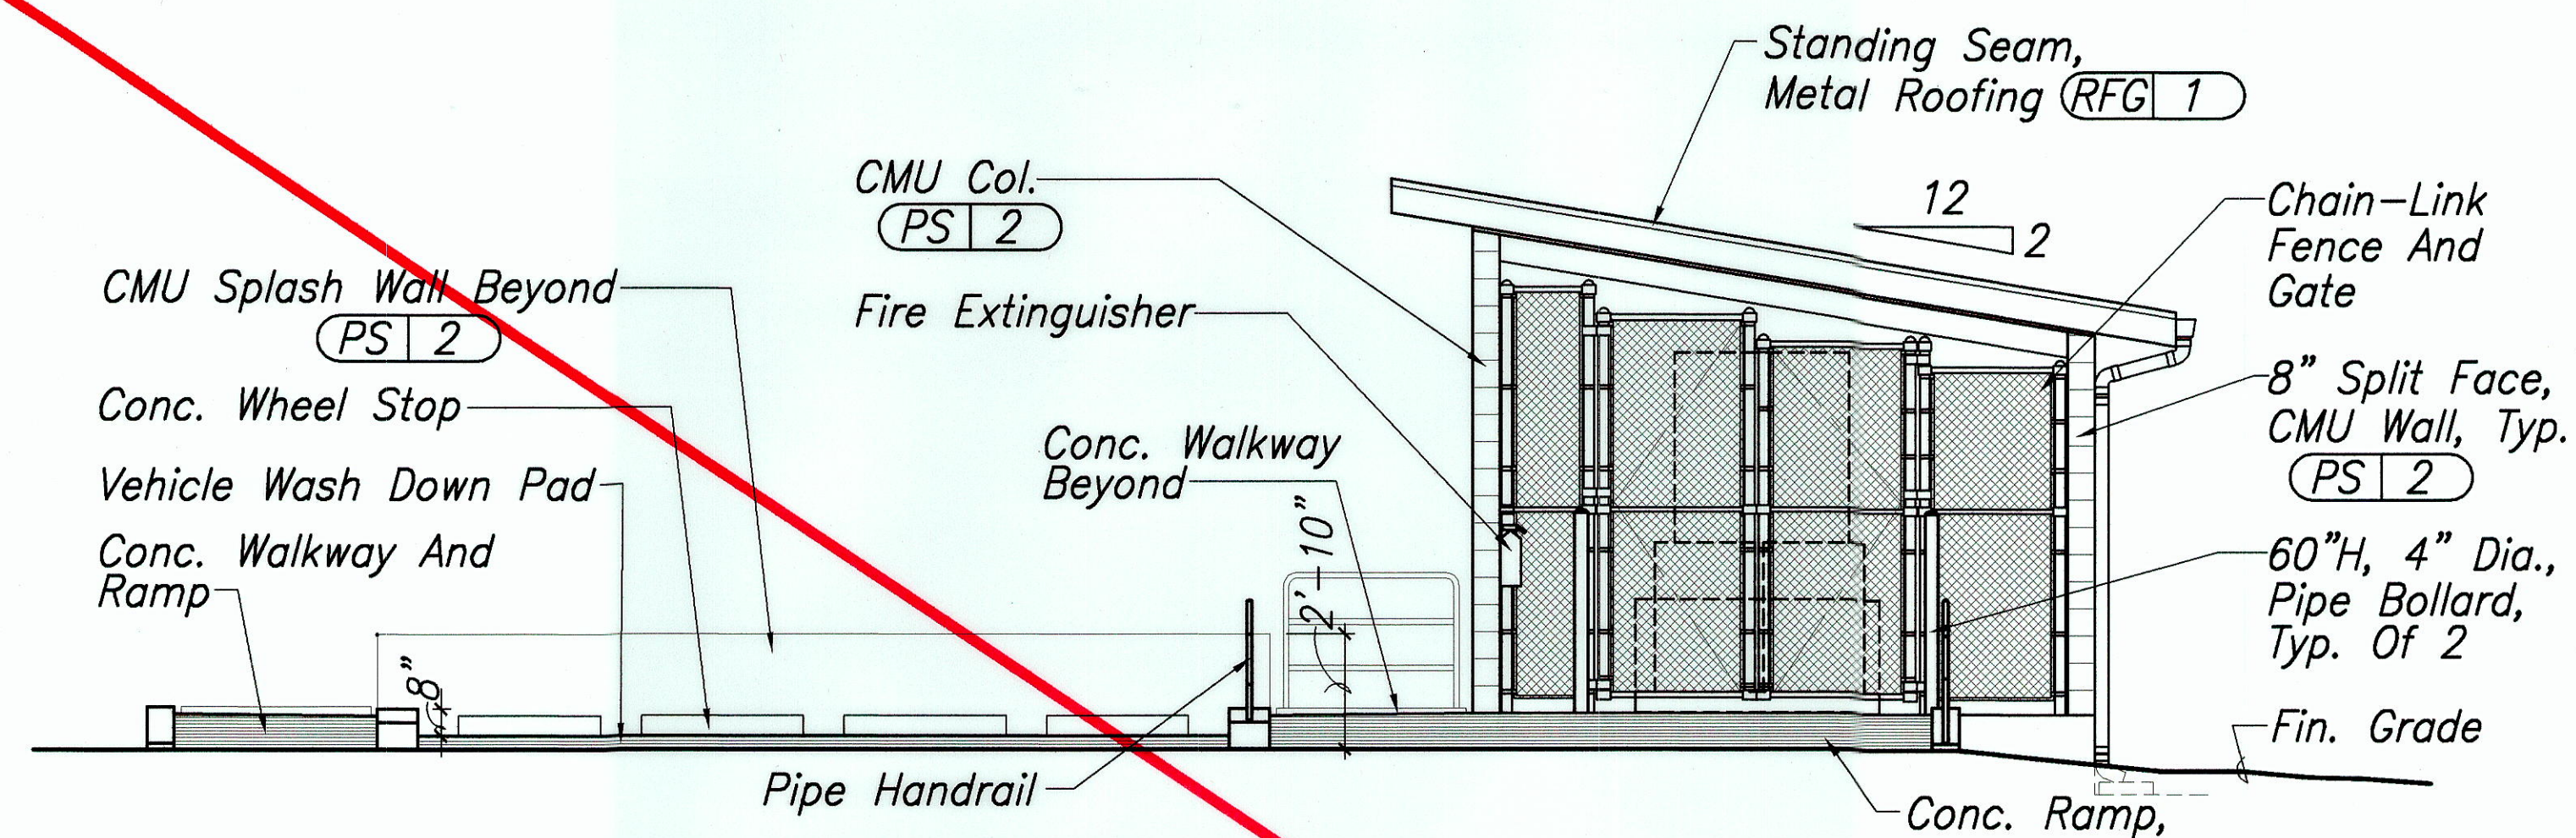



NORTH EXTERIOR ELEVATION
Scale: $1/4" = 1'-0"$

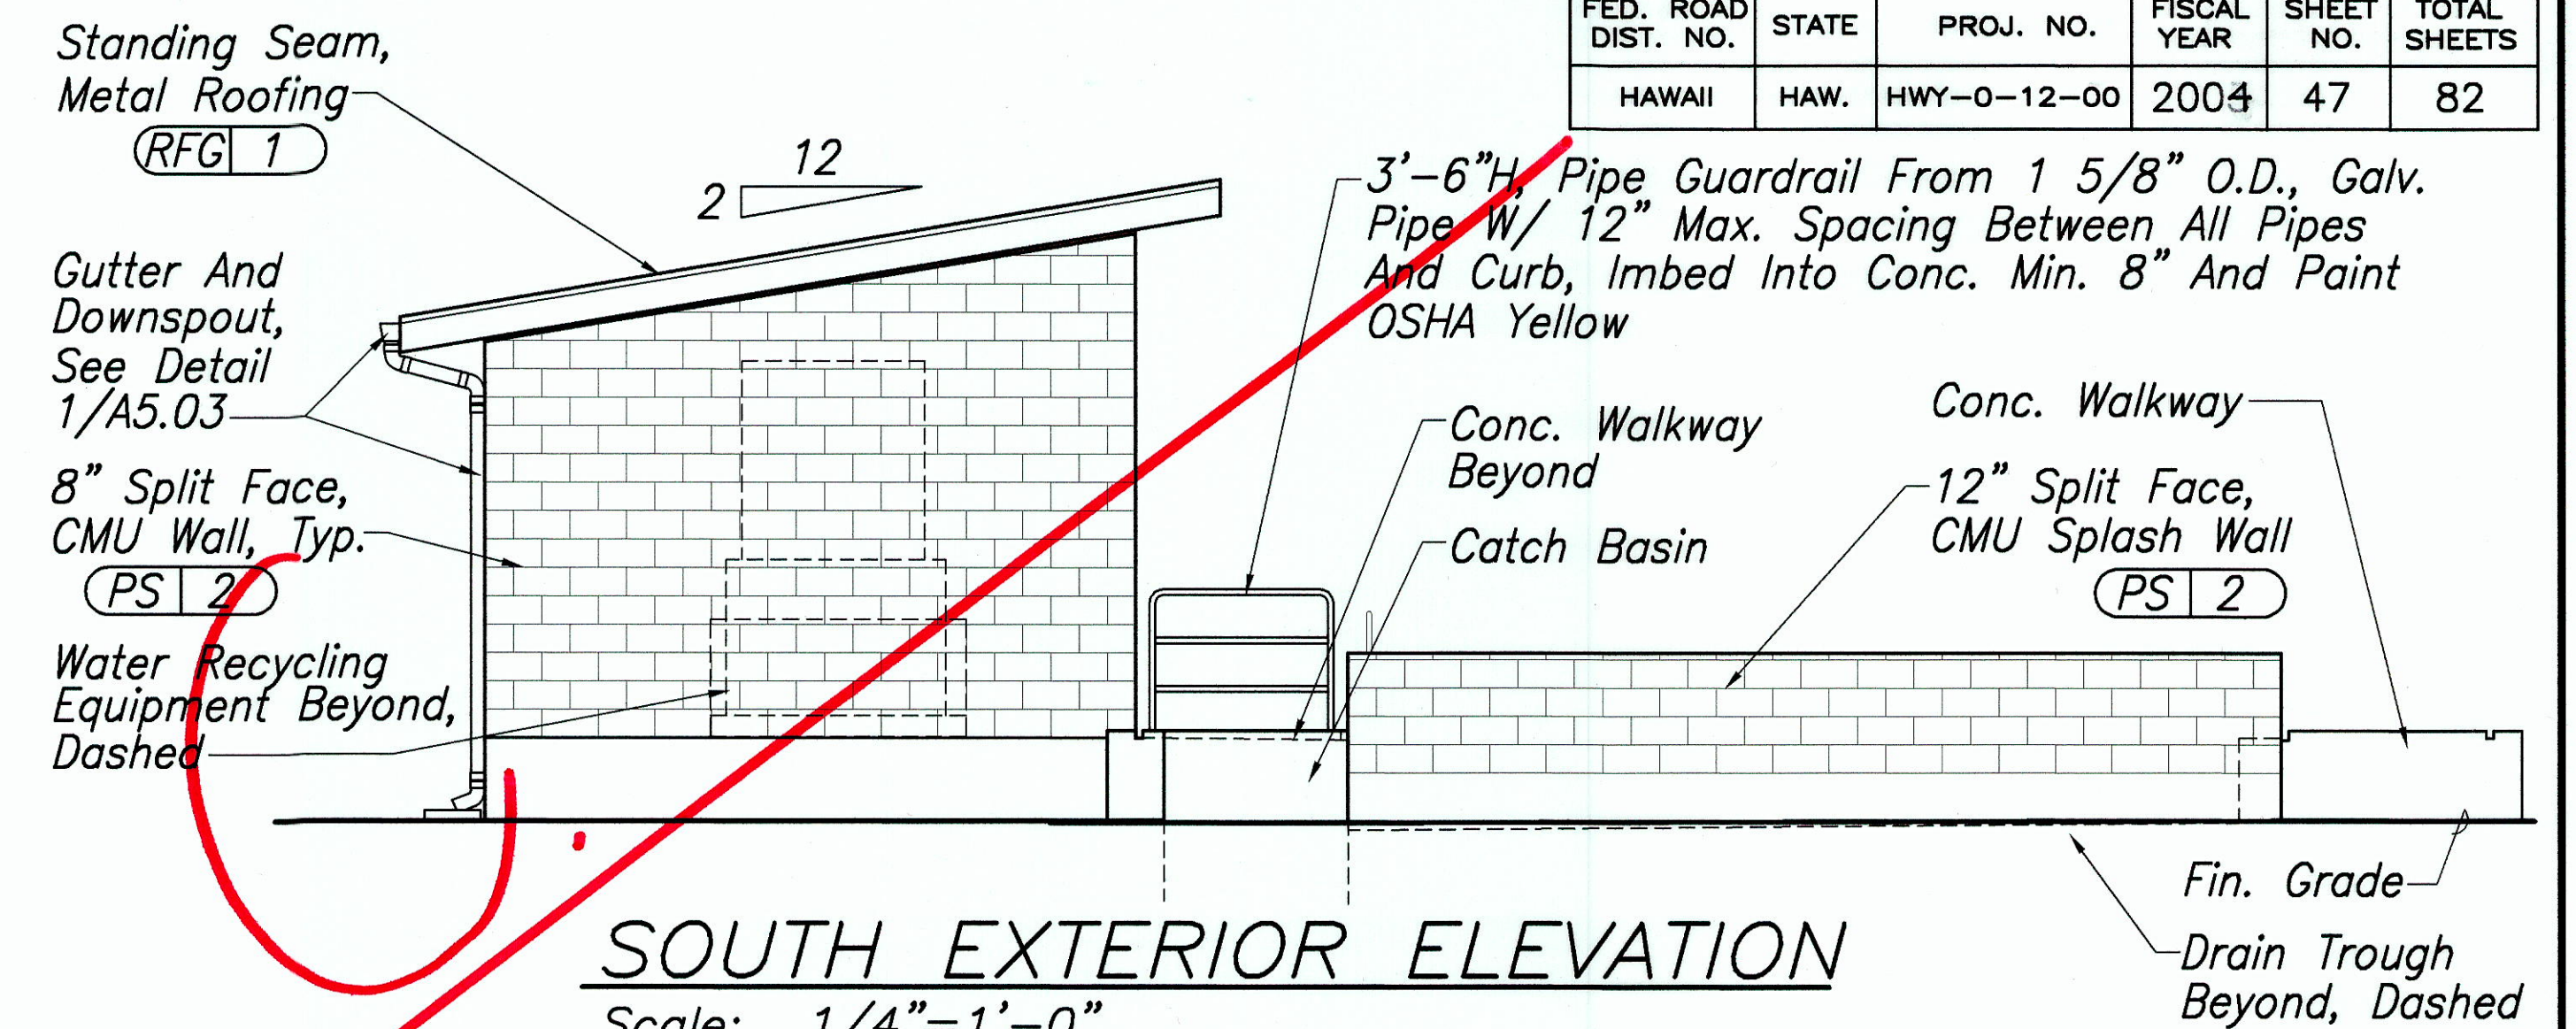

SOUTH EXTERIOR ELEVATION
Scale: $1/4" = 1'-0"$

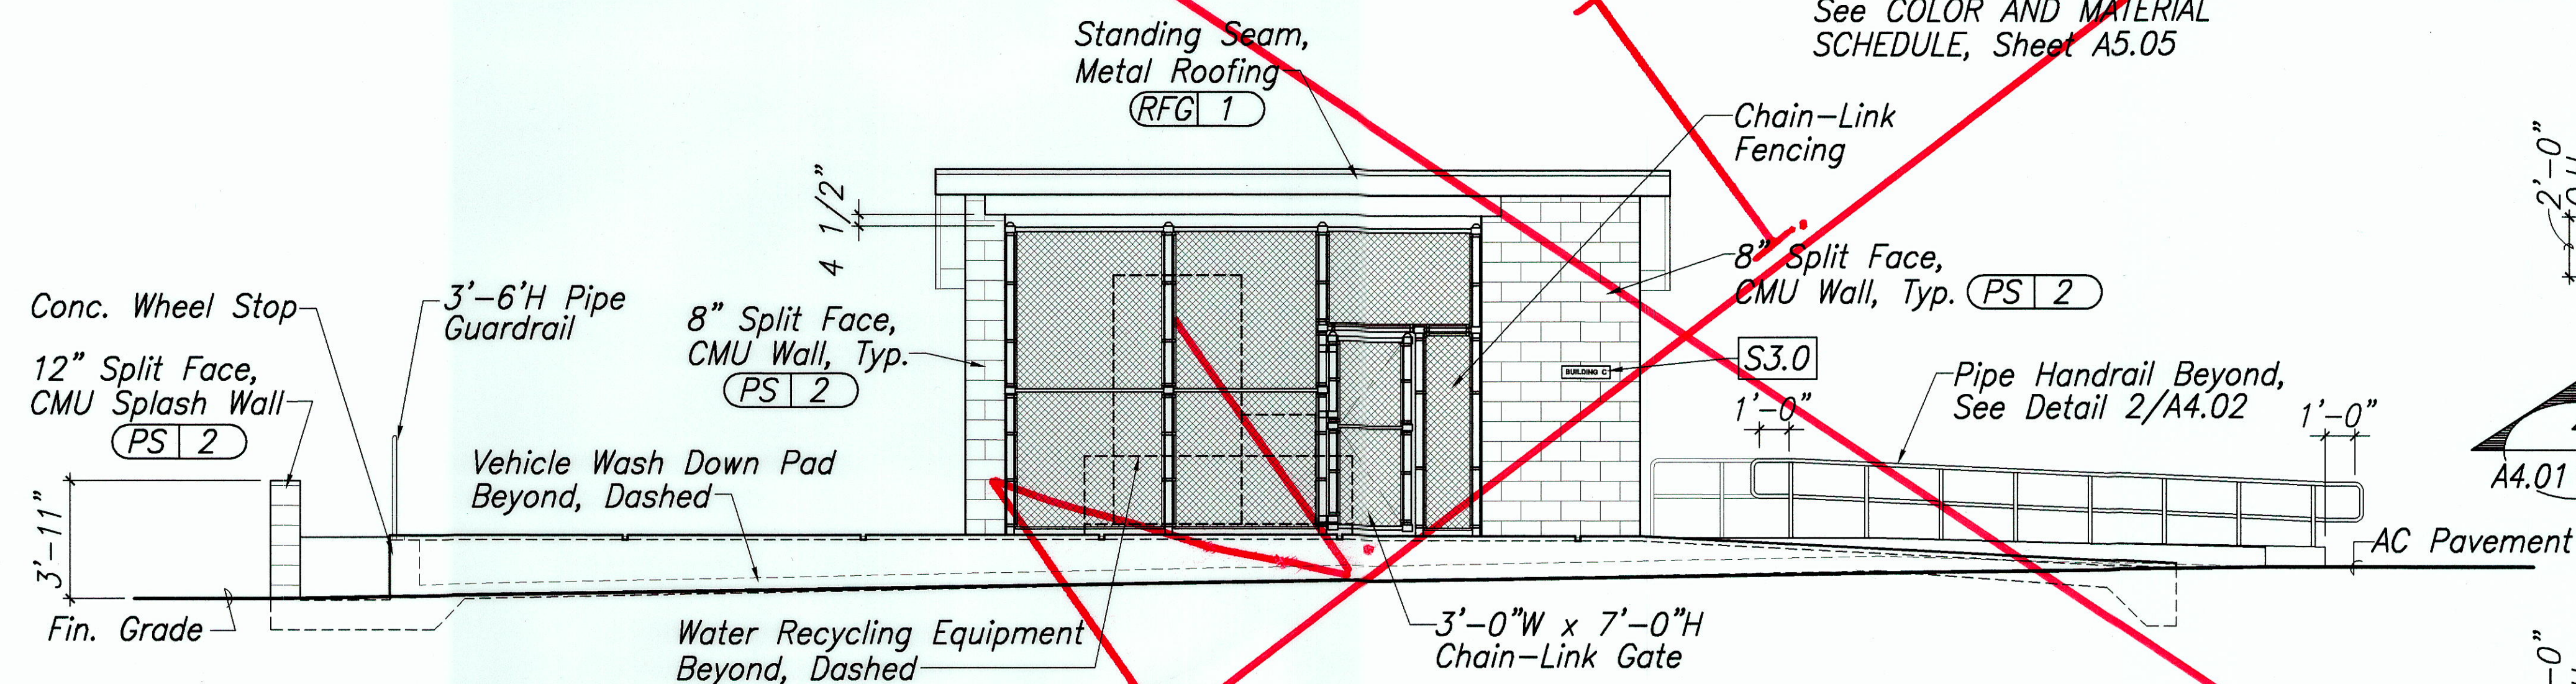


EAST EXTERIOR ELEVATION
Scale: 1/4"=1'-0"

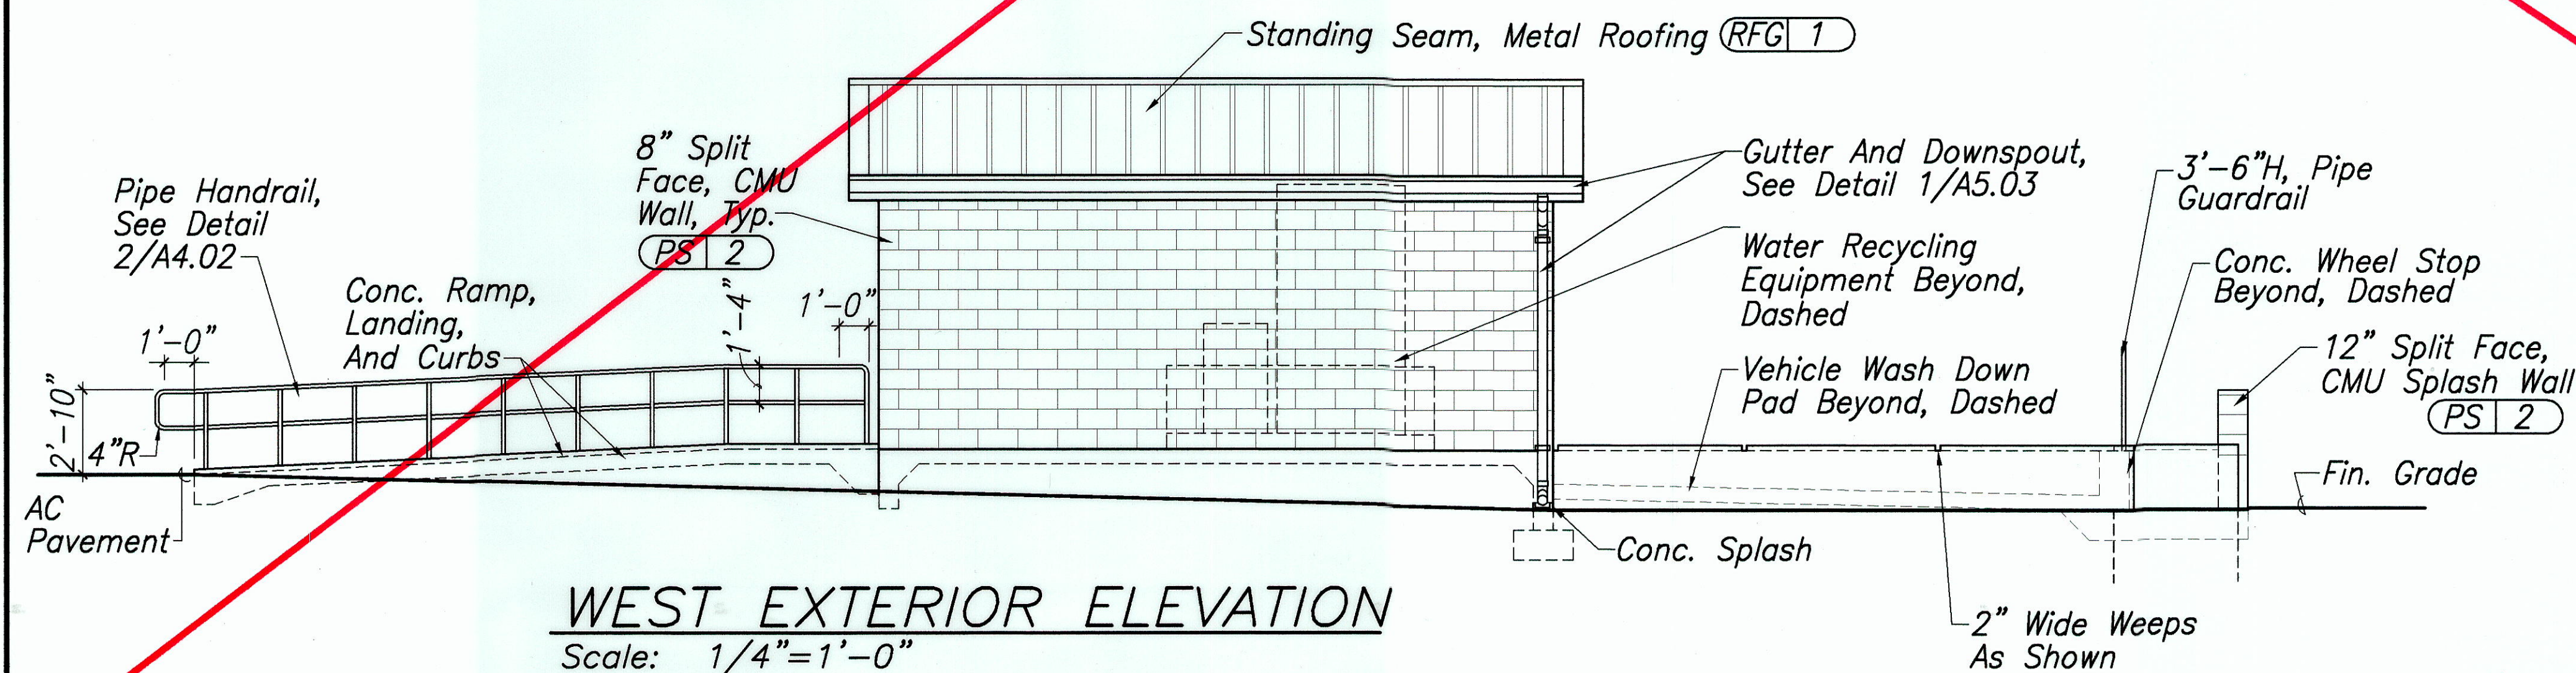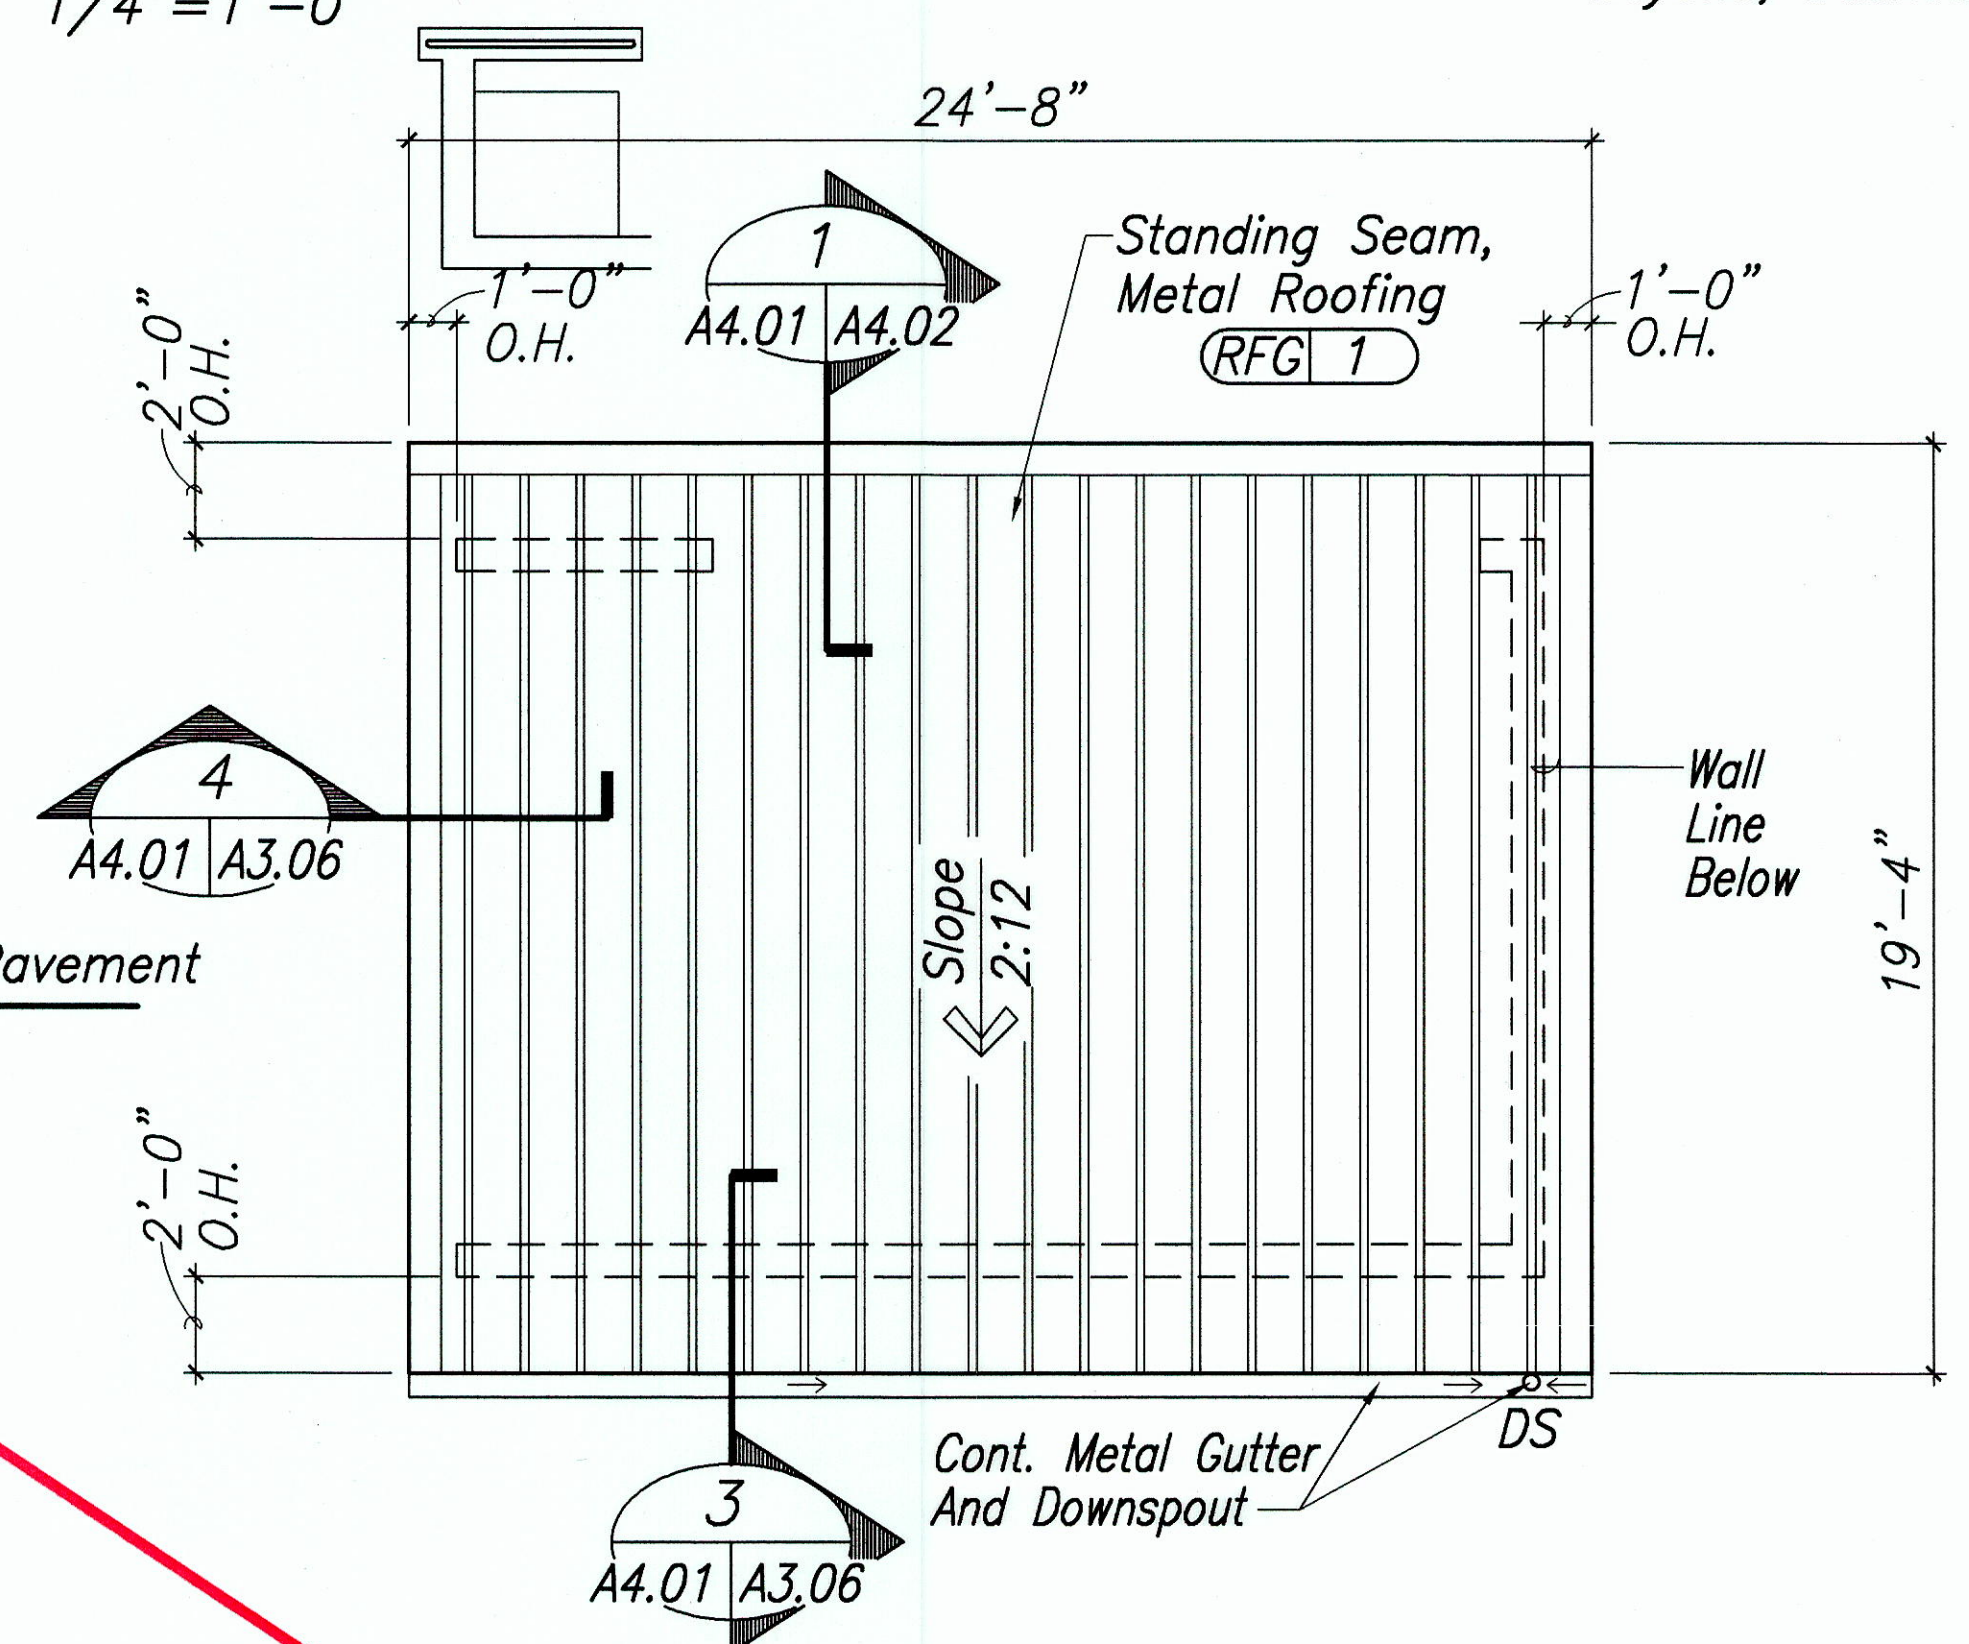

WEST EXTERIOR ELEVATION
Scale: 1/4"=1'-0"

WATER RECYCLING EQUIPMENT
SHED ROOF PLAN
Scale: $1/4" = 1'-0"$

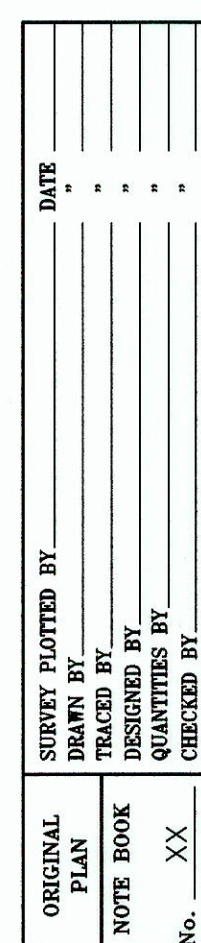

THIS WORK WAS PREPARED BY
OR UNDER MY SUPERVISION

STATE OF HAWAII
DEPARTMENT OF TRANSPORTATION
HIGHWAYS DIVISION

VEHICLE WASH STRUCTURE
ROOF PLAN, EXT. ELEVATIONS


WAHIAWA BASEYARD
IMPROVEMENTS

Project No. HWY-0-12-00


Scale: AS SHOWN Date: JAN. 2003

SHEET No. **A4.01** OF **82** SHEETS


FED. ROAD DIST. NO.	STATE	PROJ. NO.	FISCAL YEAR	SHEET NO.	TOTAL SHEETS
HAWAII	HAW.	HWY-0-12-00	2004	48	82

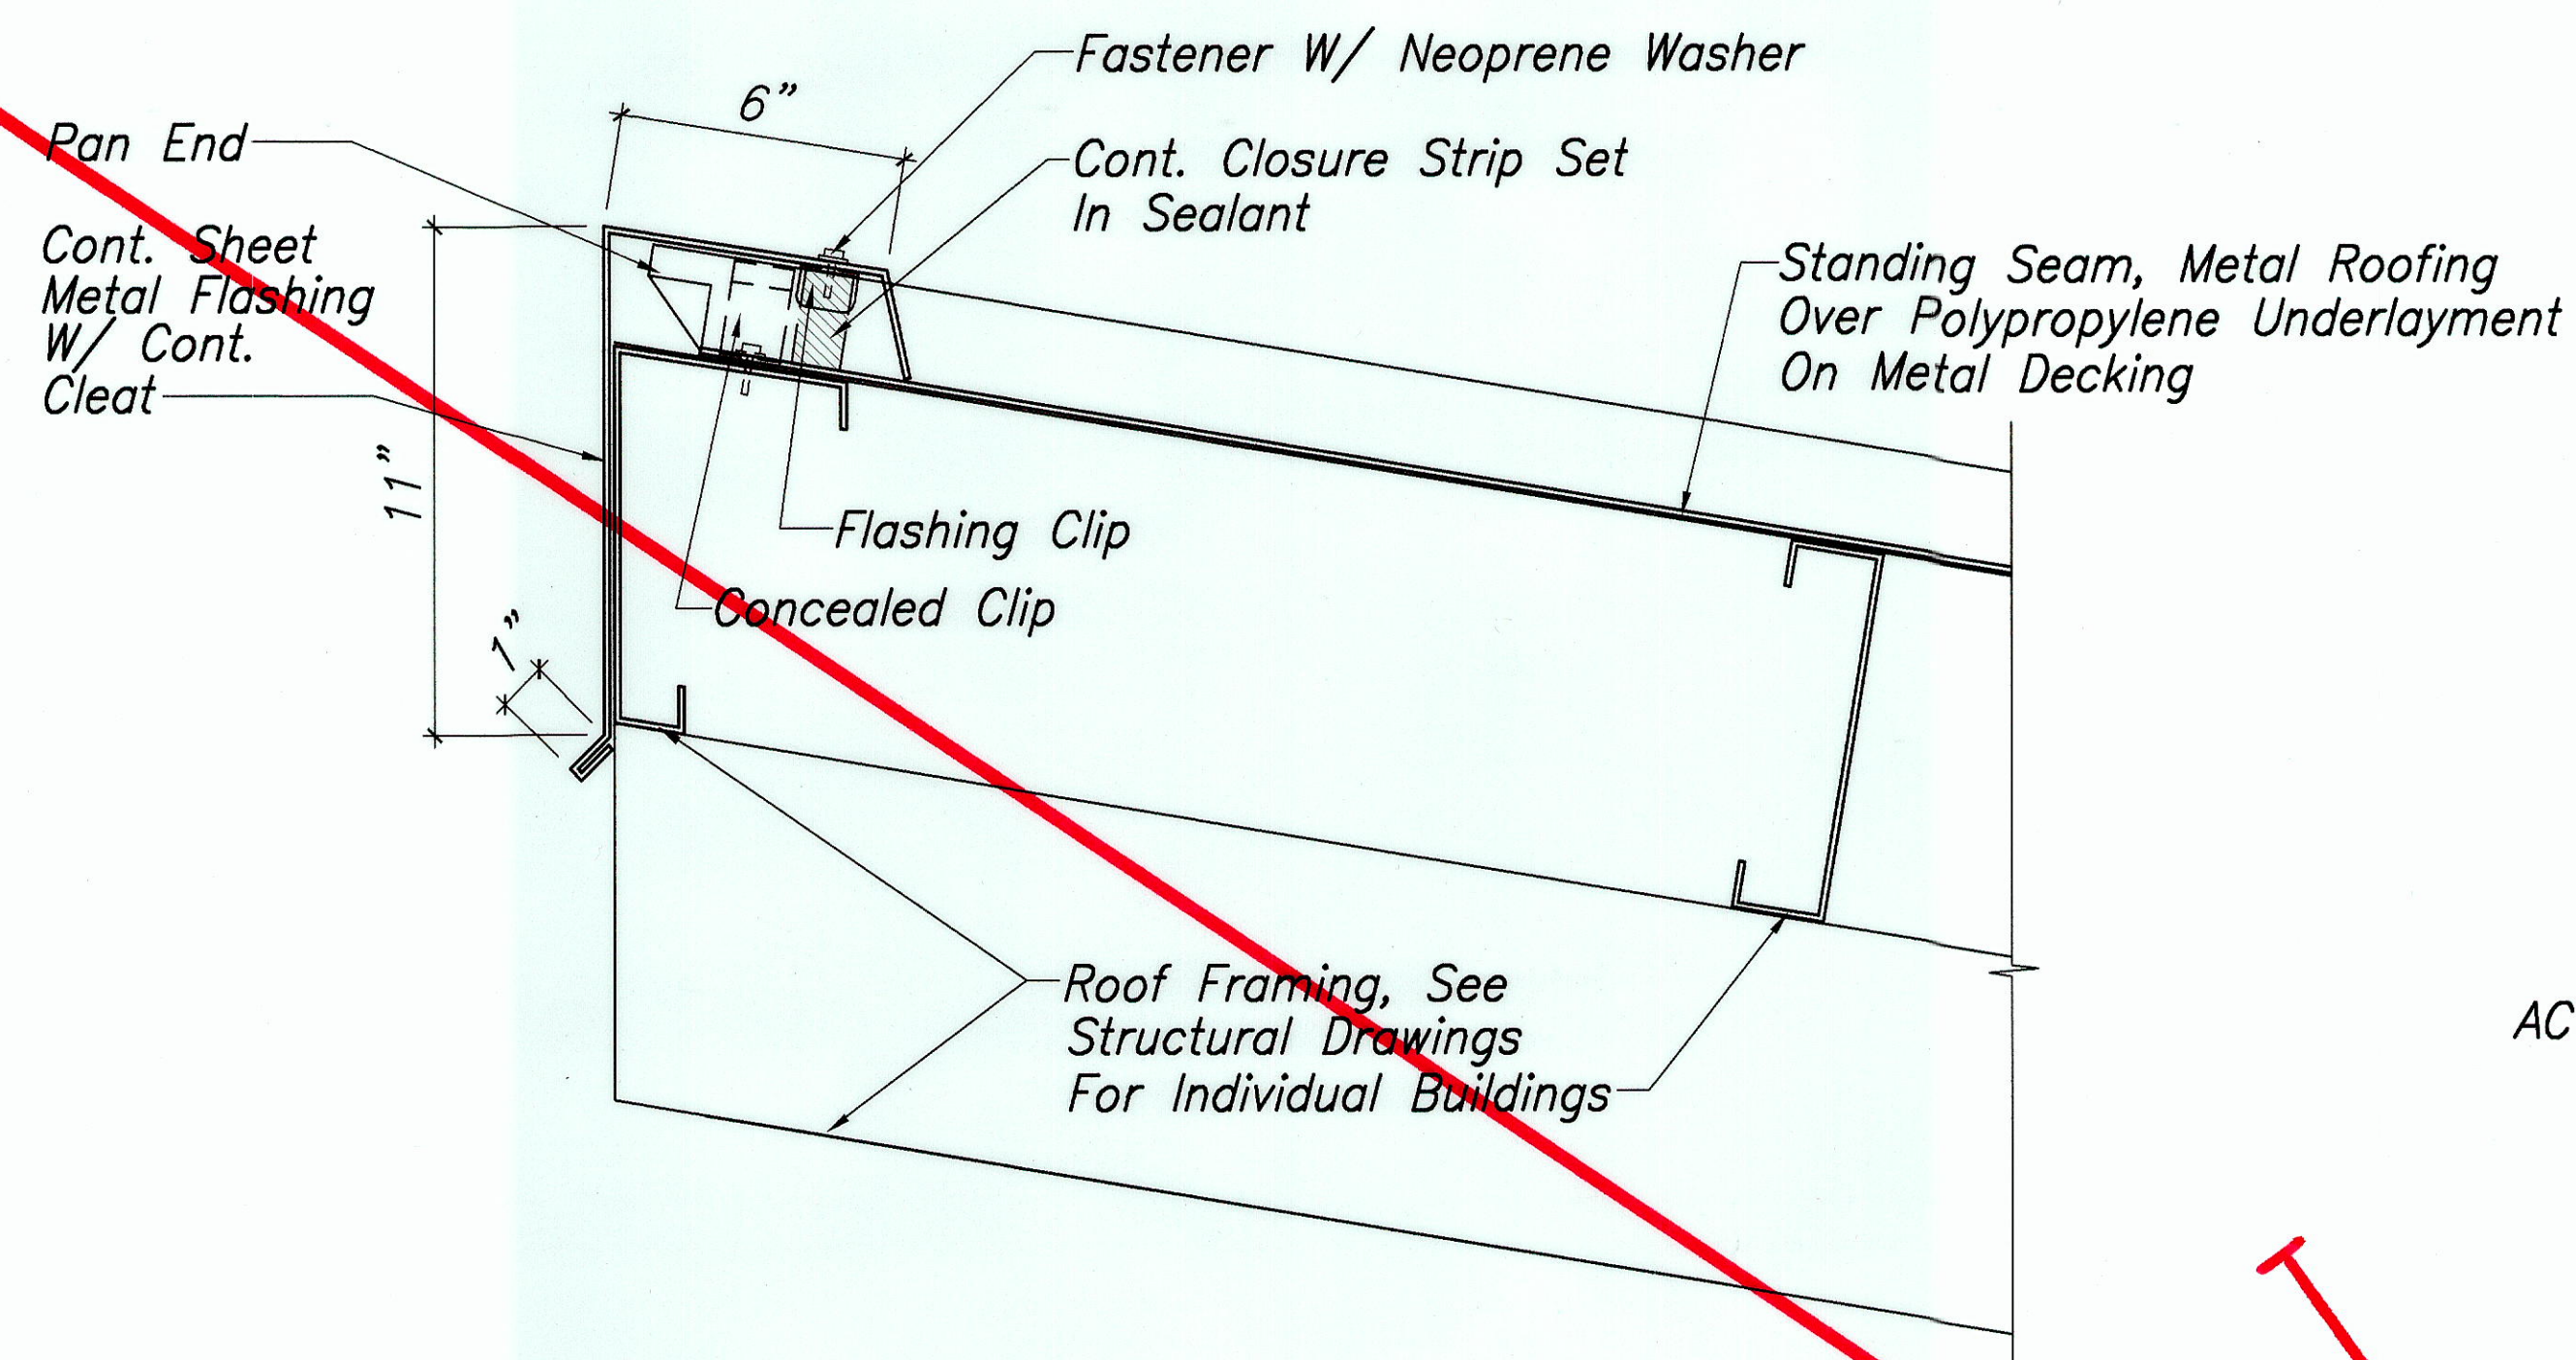


EAVE FLASHING DETAIL
Scale: 3"=1'-0"
A4.01 A4.02

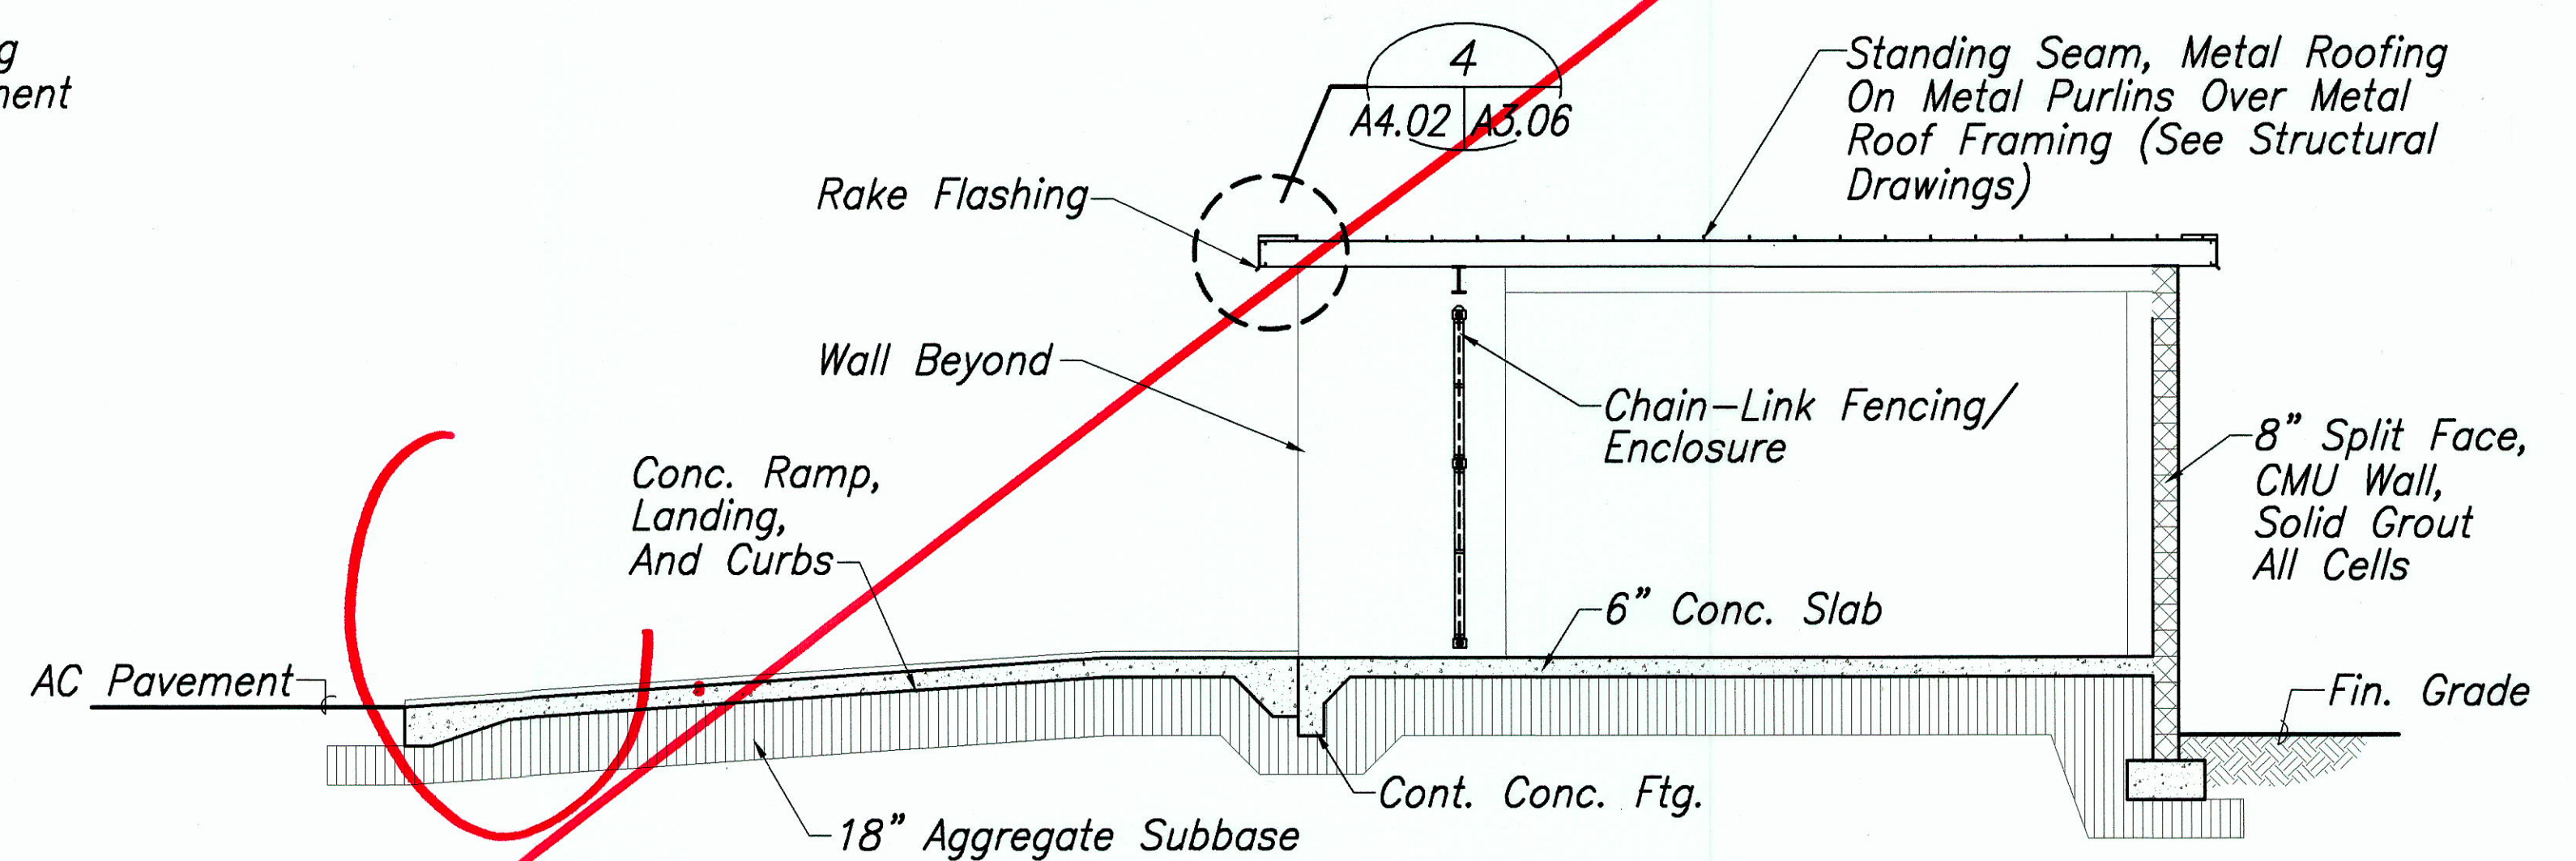


BUILDING SECTION A
Scale: 1/4"=1'-0"
A4.00 A4.02

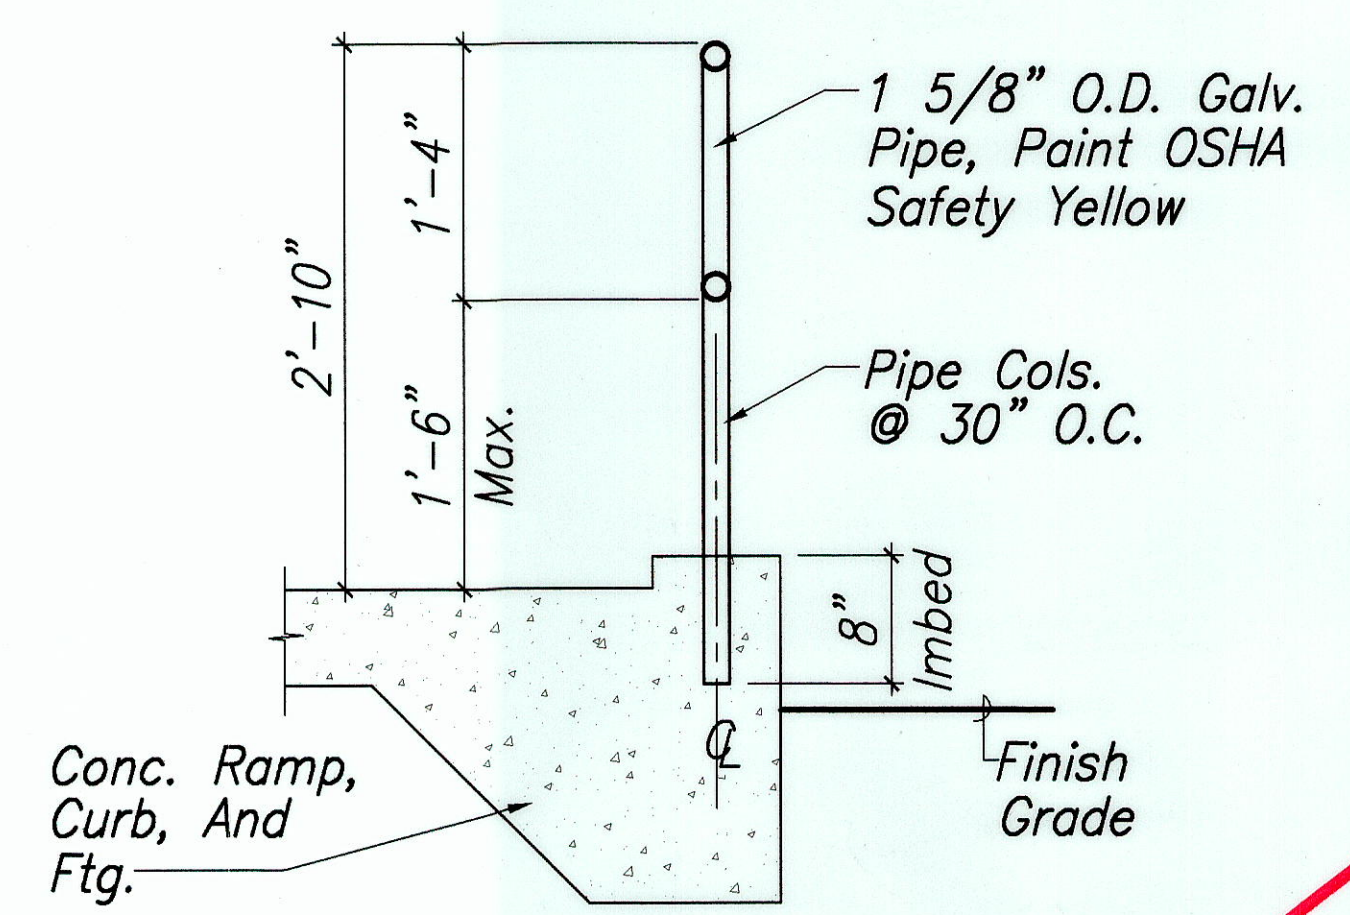

HANDRAIL DETAIL
Scale: 1"=1'-0"
A4.01 A4.02

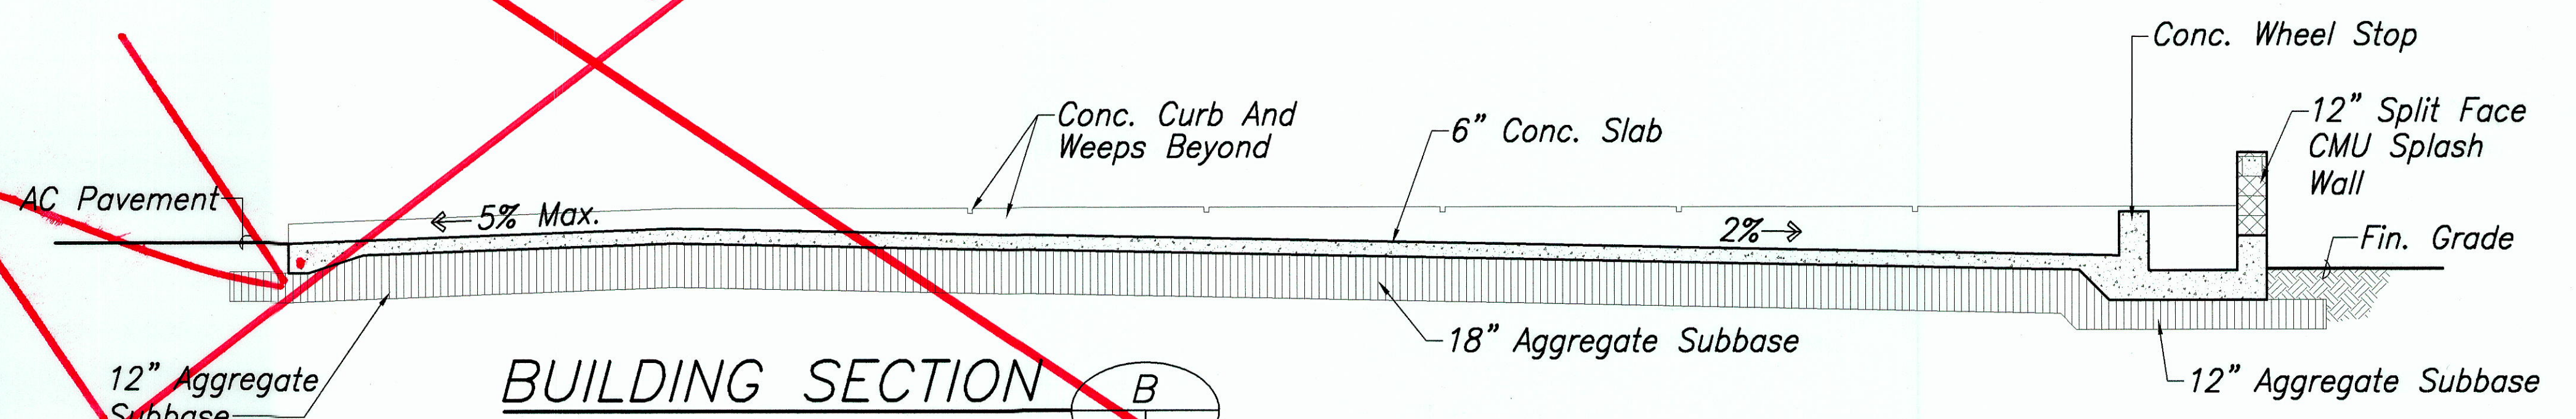


BUILDING SECTION B
Scale: 1/4"=1'-0"
A4.00 A4.02

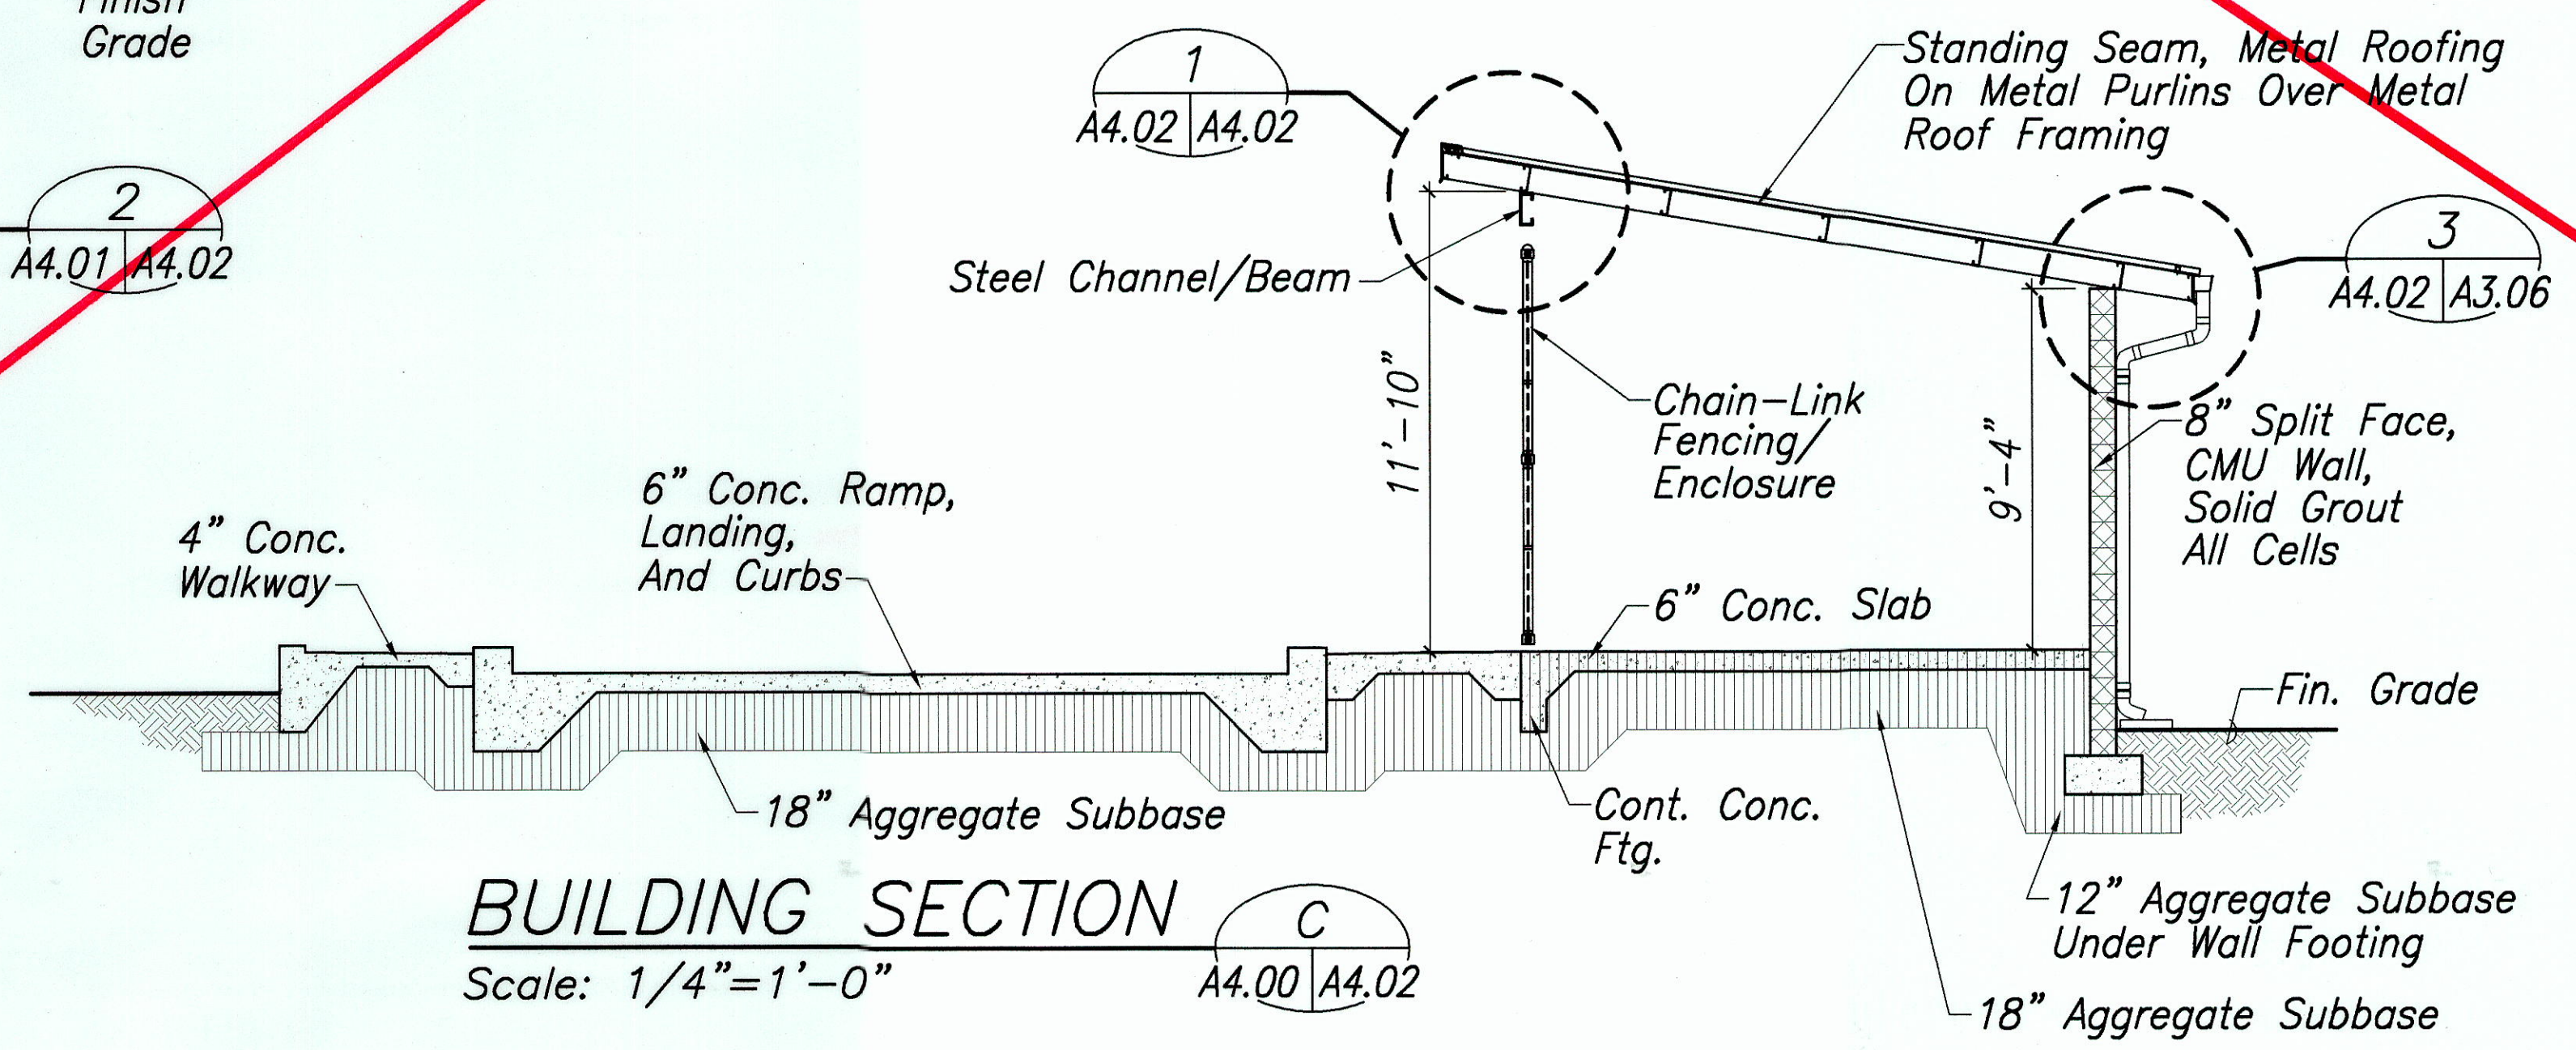

BUILDING SECTION C
Scale: 1/4"=1'-0"
A4.00 A4.02

DESIGNED BY	DATE
DRAWN BY	
CHECKED BY	
NOTED BY	
QUANTITIES BY	
NO.	XX

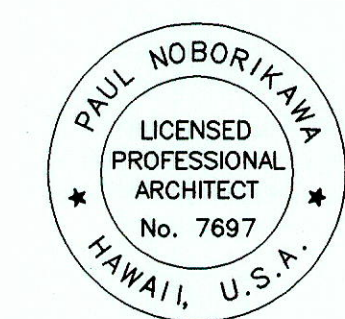

THIS WORK WAS PREPARED BY ME OR UNDER MY SUPERVISION

STATE OF HAWAII
DEPARTMENT OF TRANSPORTATION
HIGHWAYS DIVISION

**VEHICLE WASH STRUCTURE
BUILDING SECTIONS**

WAIHAWA BASEYARD
IMPROVEMENTS


Project No. HWY-0-12-00

Scale: AS SHOWN Date: JAN. 2003


SHEET No. A4.02 OF 82 SHEETS

"AS-BUILT"


FED. ROAD DIST. NO.	STATE	PROJ. NO.	FISCAL YEAR	SHEET NO.	TOTAL SHEETS
HAWAII	HAW.	HWY-0-12-00	2004	50	82

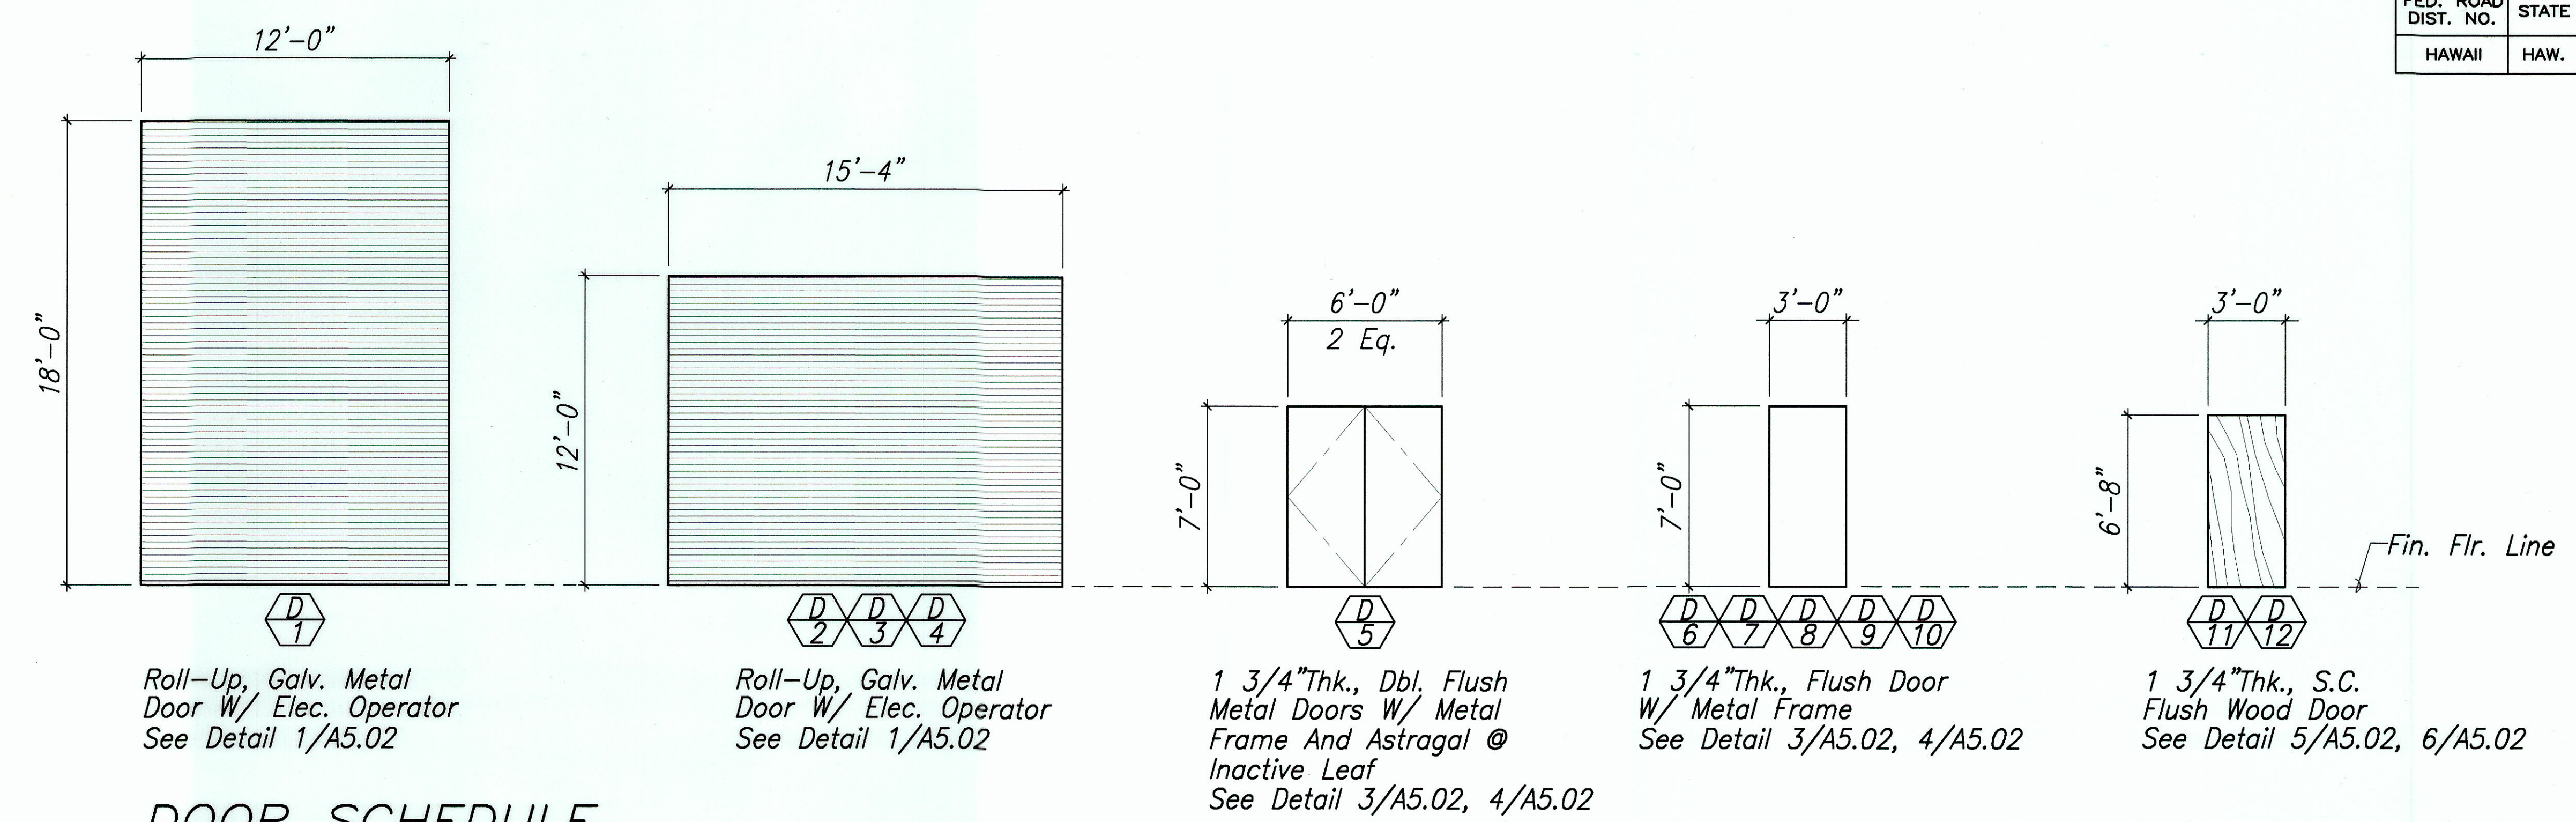

DOOR SCHEDULE
Scale: 1/4"=1'-0"

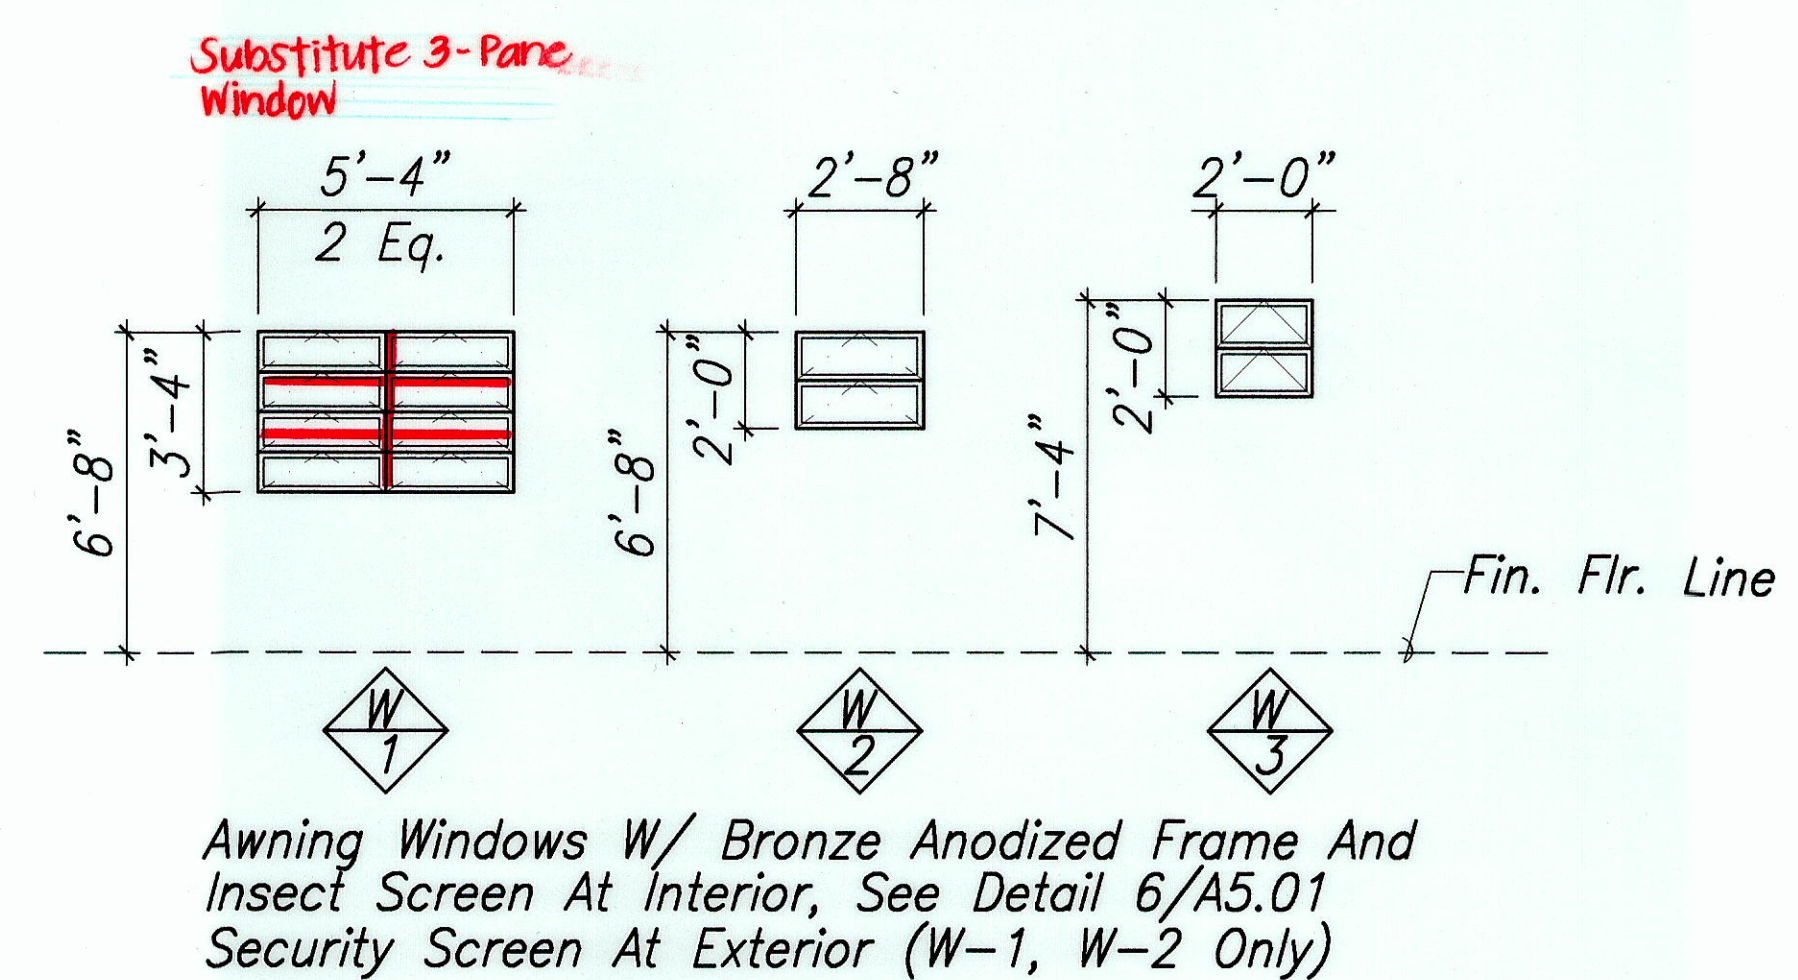

WINDOW SCHEDULE
Scale: 1/4"=1'-0"

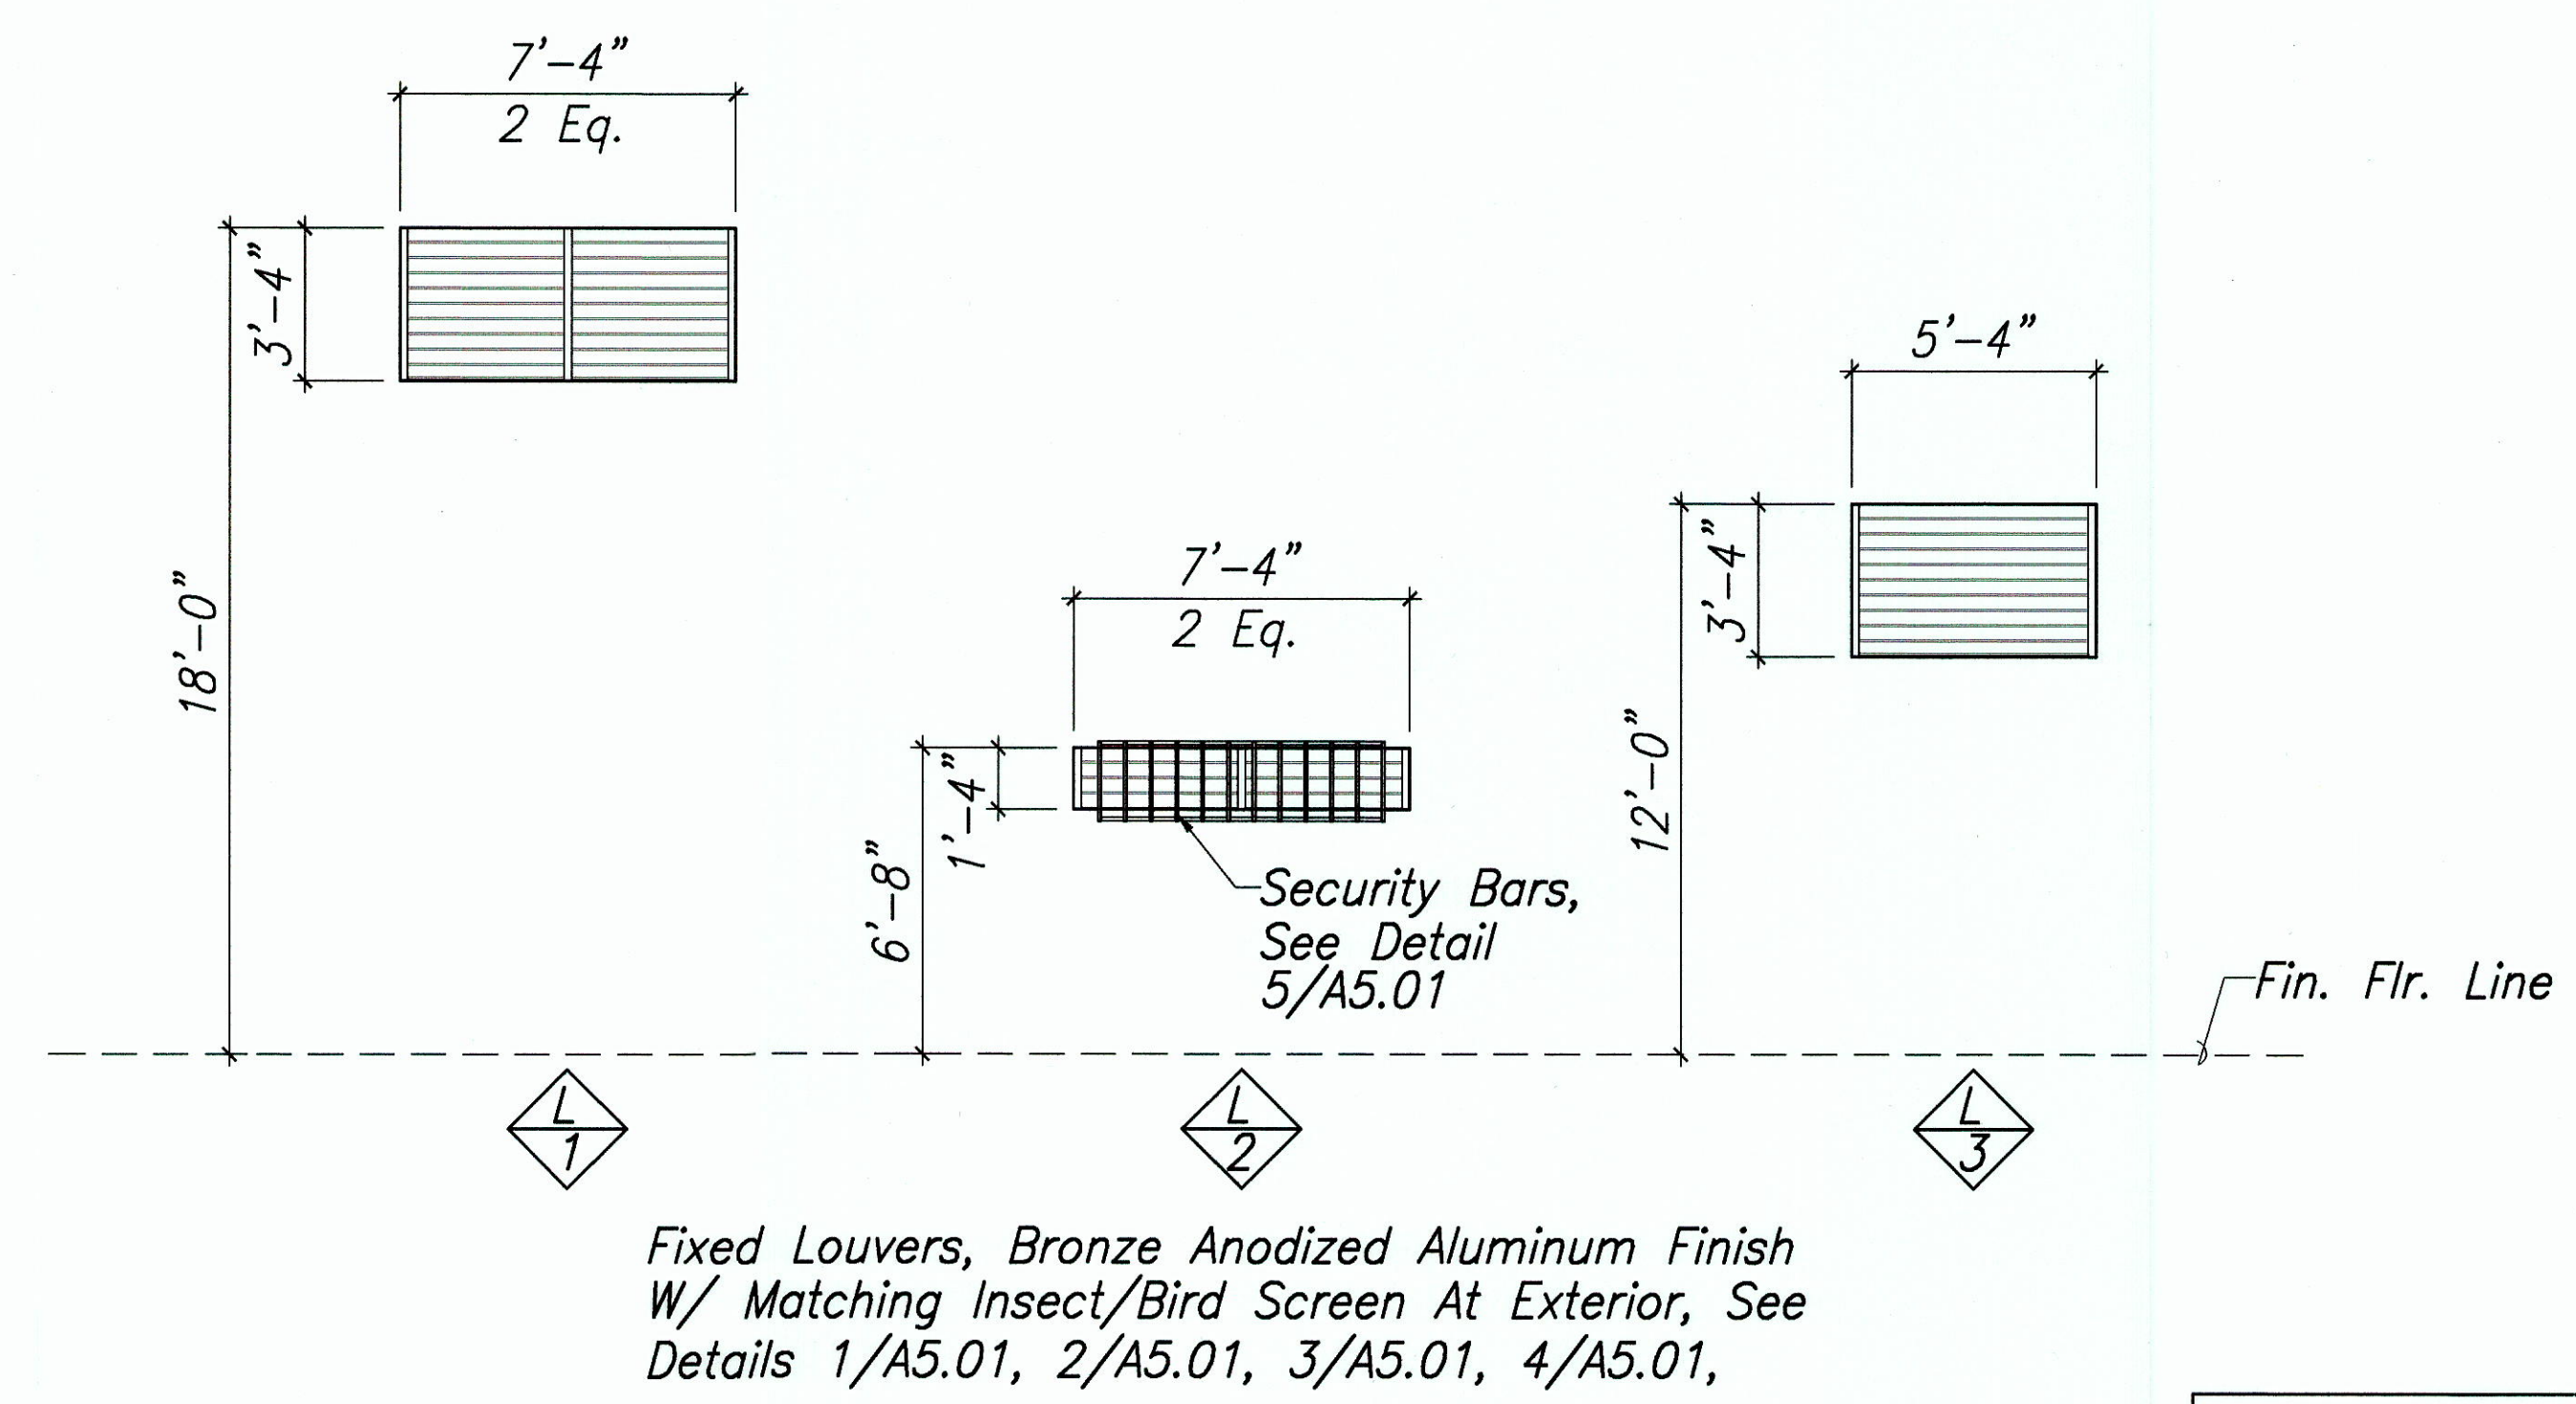

LOUVER SCHEDULE
Scale: 1/4"=1'-0"

SURVEY PLOTTED BY	DATE
DRAWN BY	
CHECKED BY	
NOTED BY	
QUANTITIES BY	
NO.	XX



THIS WORK WAS PREPARED BY ME
OR UNDER MY SUPERVISION

[Signature]

STATE OF HAWAII
DEPARTMENT OF TRANSPORTATION
HIGHWAYS DIVISION

DOOR, WINDOWS, AND LOUVER SCHEDULES

WAIHAWA BASEYARD
IMPROVEMENTS


Project No. HWY-0-12-00

Scale: AS SHOWN Date: JAN. 2003

SHEET No. A5.00 OF 82 SHEETS


"AS-BUILT"

FED. ROAD DIST. NO.	STATE	PROJ. NO.	FISCAL YEAR	SHEET NO.	TOTAL SHEETS
HAWAII	HAW.	HWY-0-12-00	2004	51	82

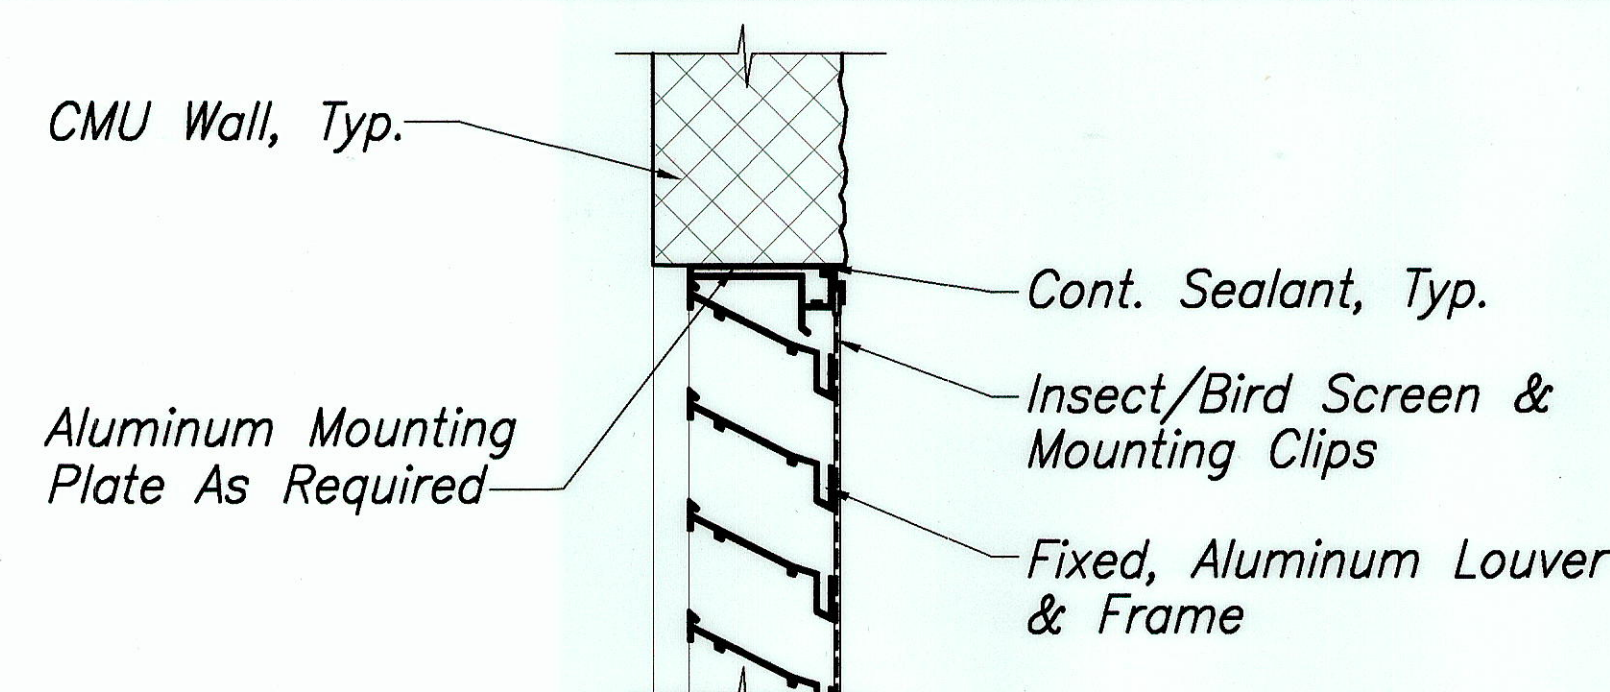


HEAD DETAIL

Scale: 1 1/2"=1'-0" A5.00 A5.01

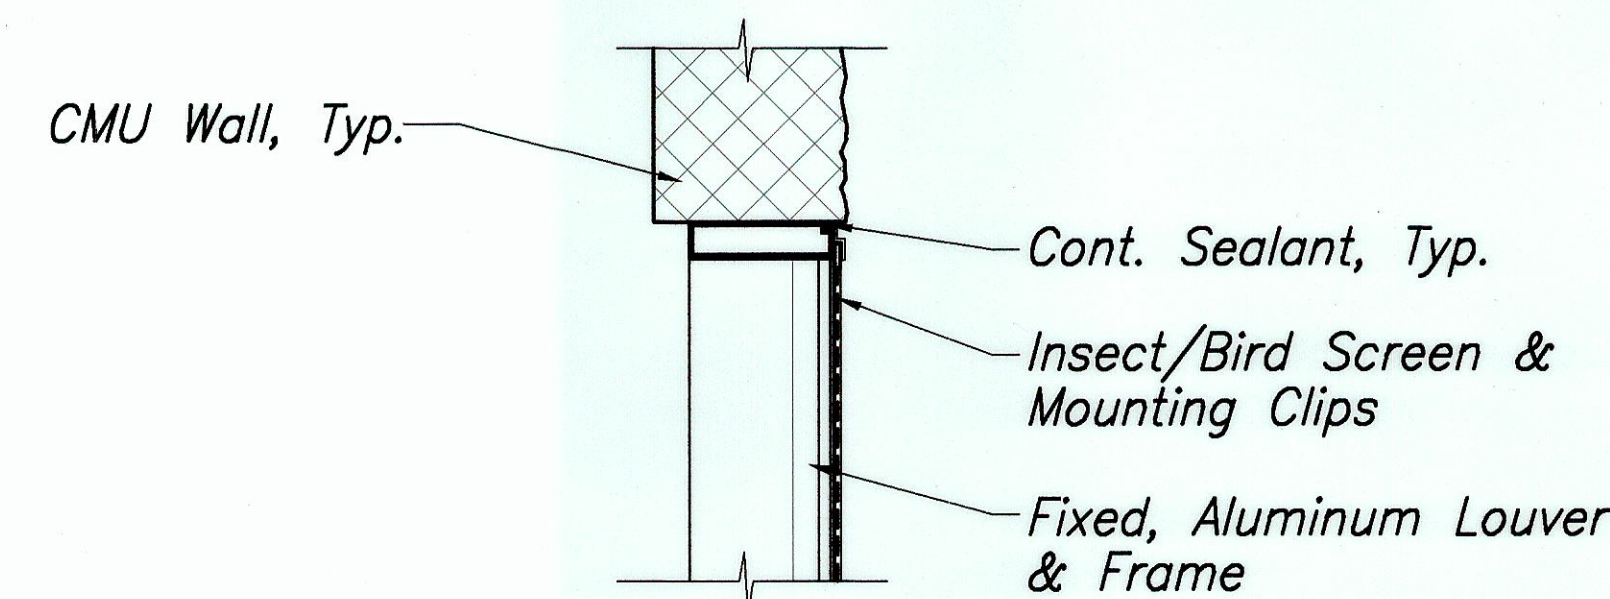


JAMB DETAIL

Scale: 1 1/2"=1'-0" A5.00 A5.01

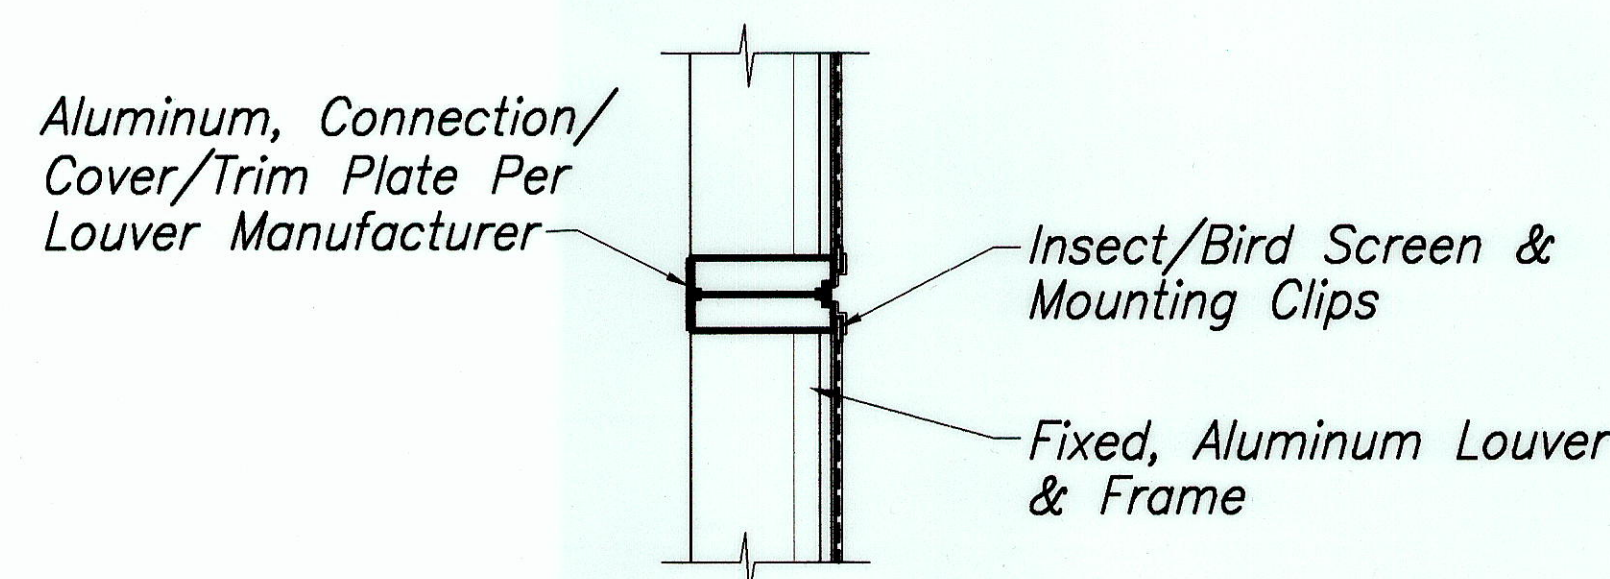

MULLION DETAIL

Scale: 1 1/2"=1'-0" A5.00 A5.01

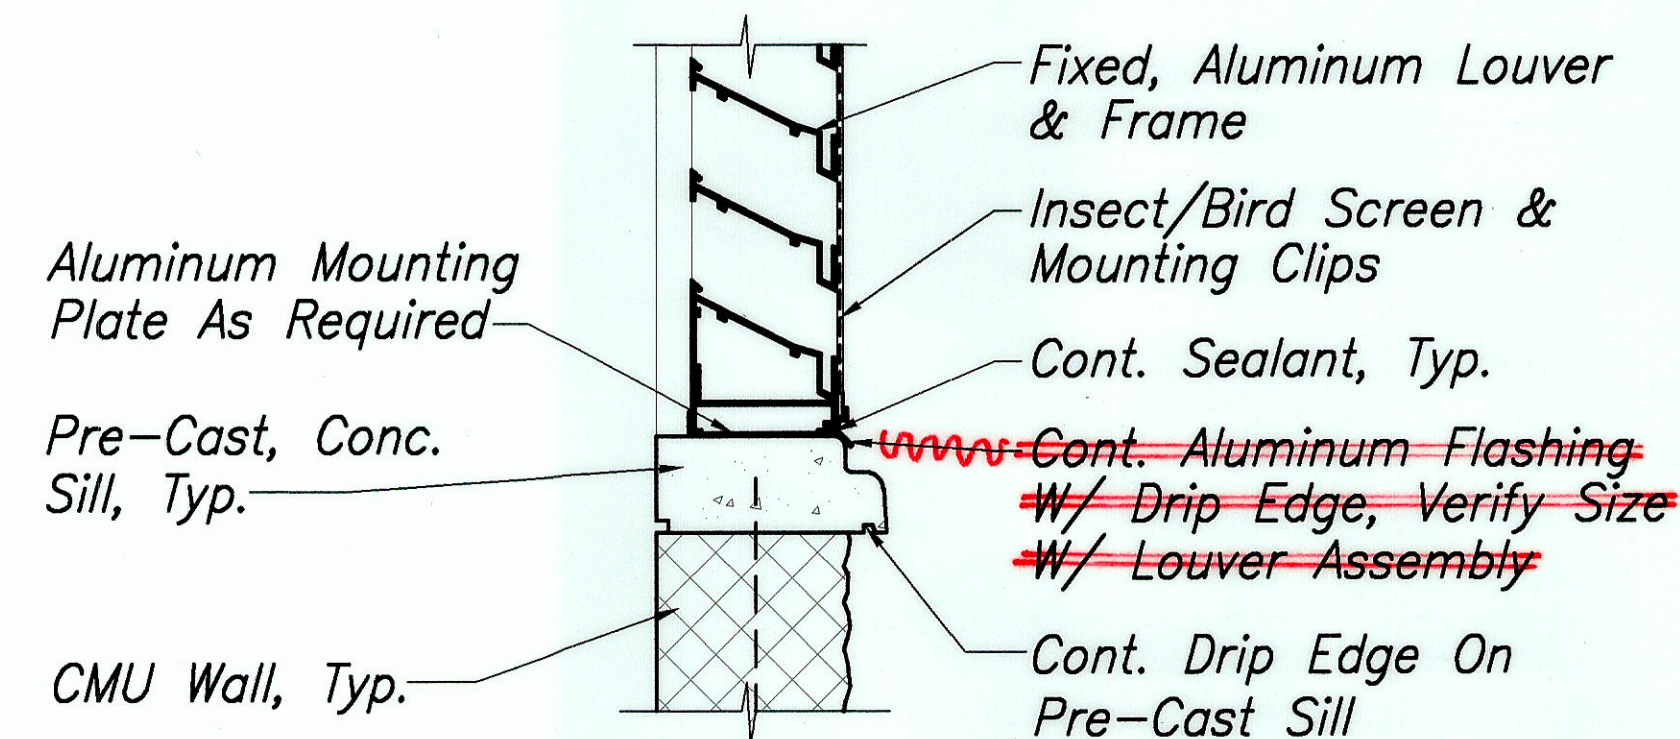


SILL DETAIL

Scale: 1 1/2"=1'-0" A5.00 A5.01


FIXED ALUMINIUM LOUVER DETAILS

Scale: As Noted

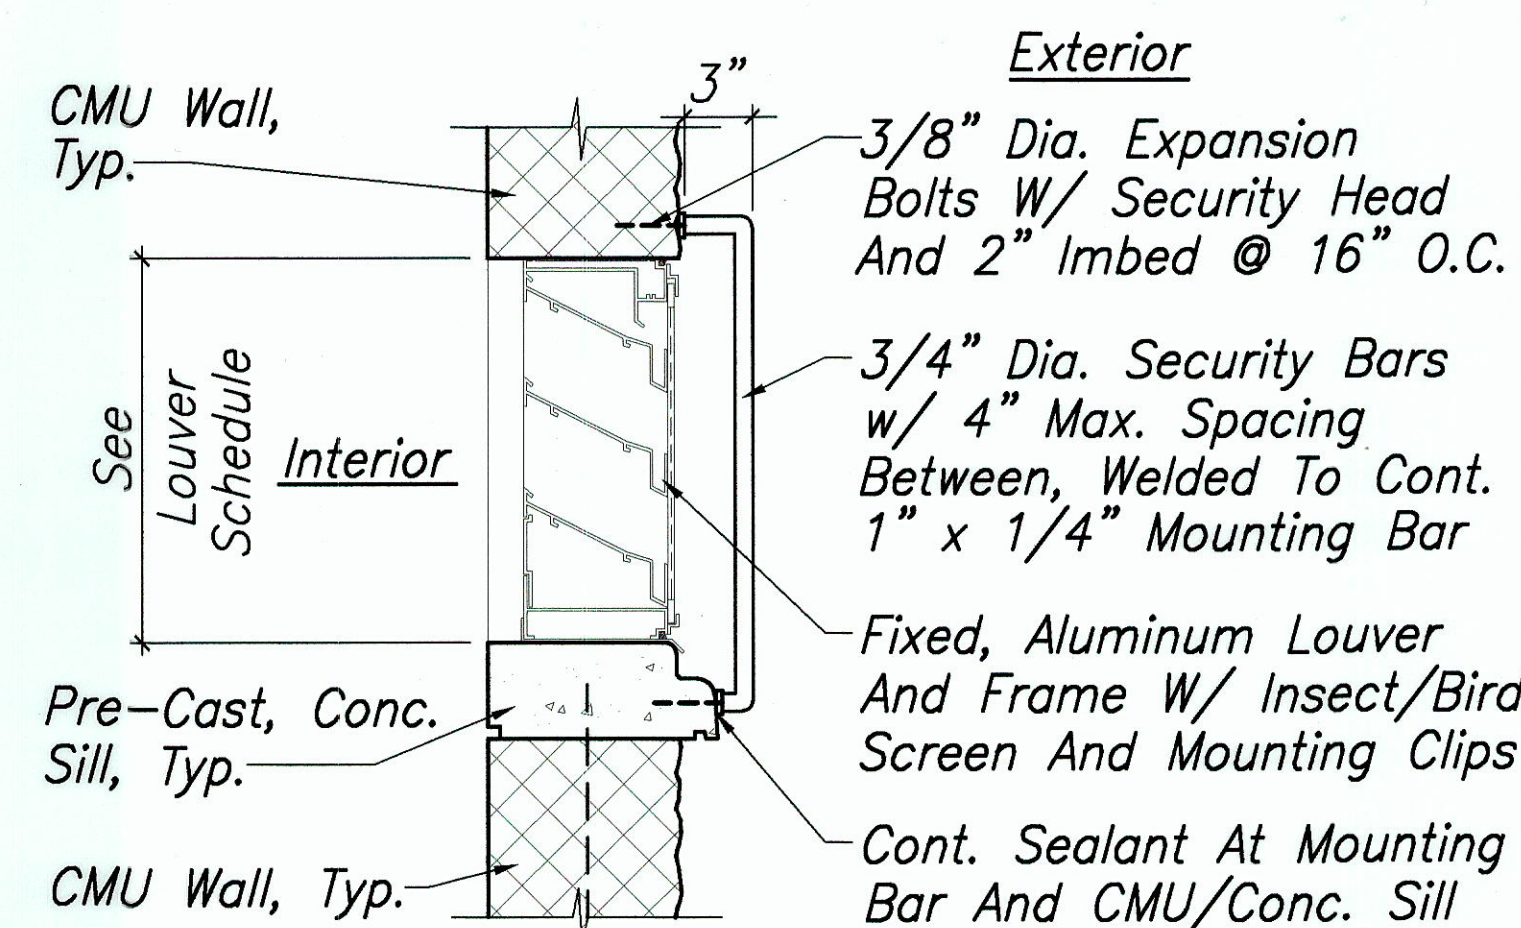


SECURITY BAR DETAIL

Scale: 1 1/2"=1'-0" A5.00 A5.01

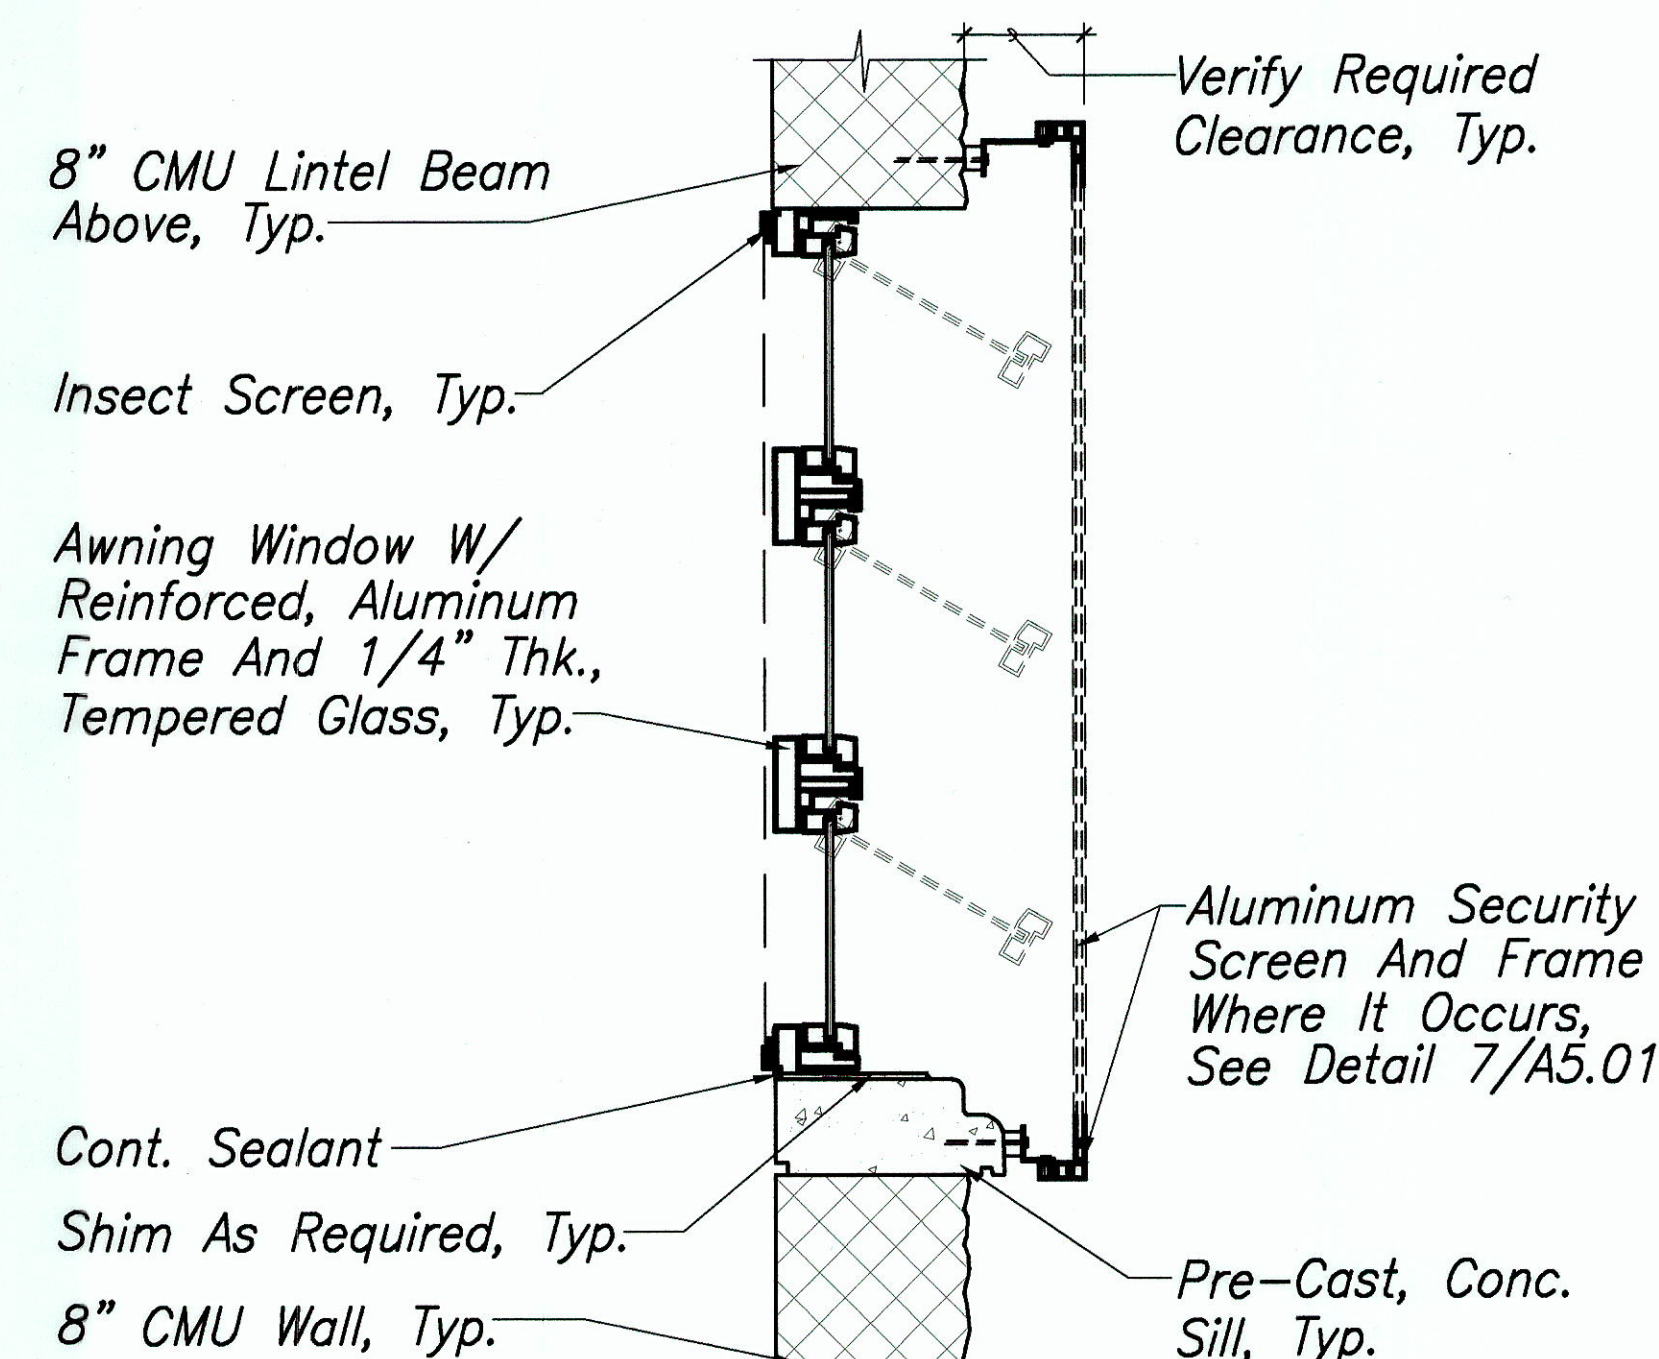

AWNING WINDOW DETAIL

Scale: 1 1/2"=1'-0" A5.00 A5.01

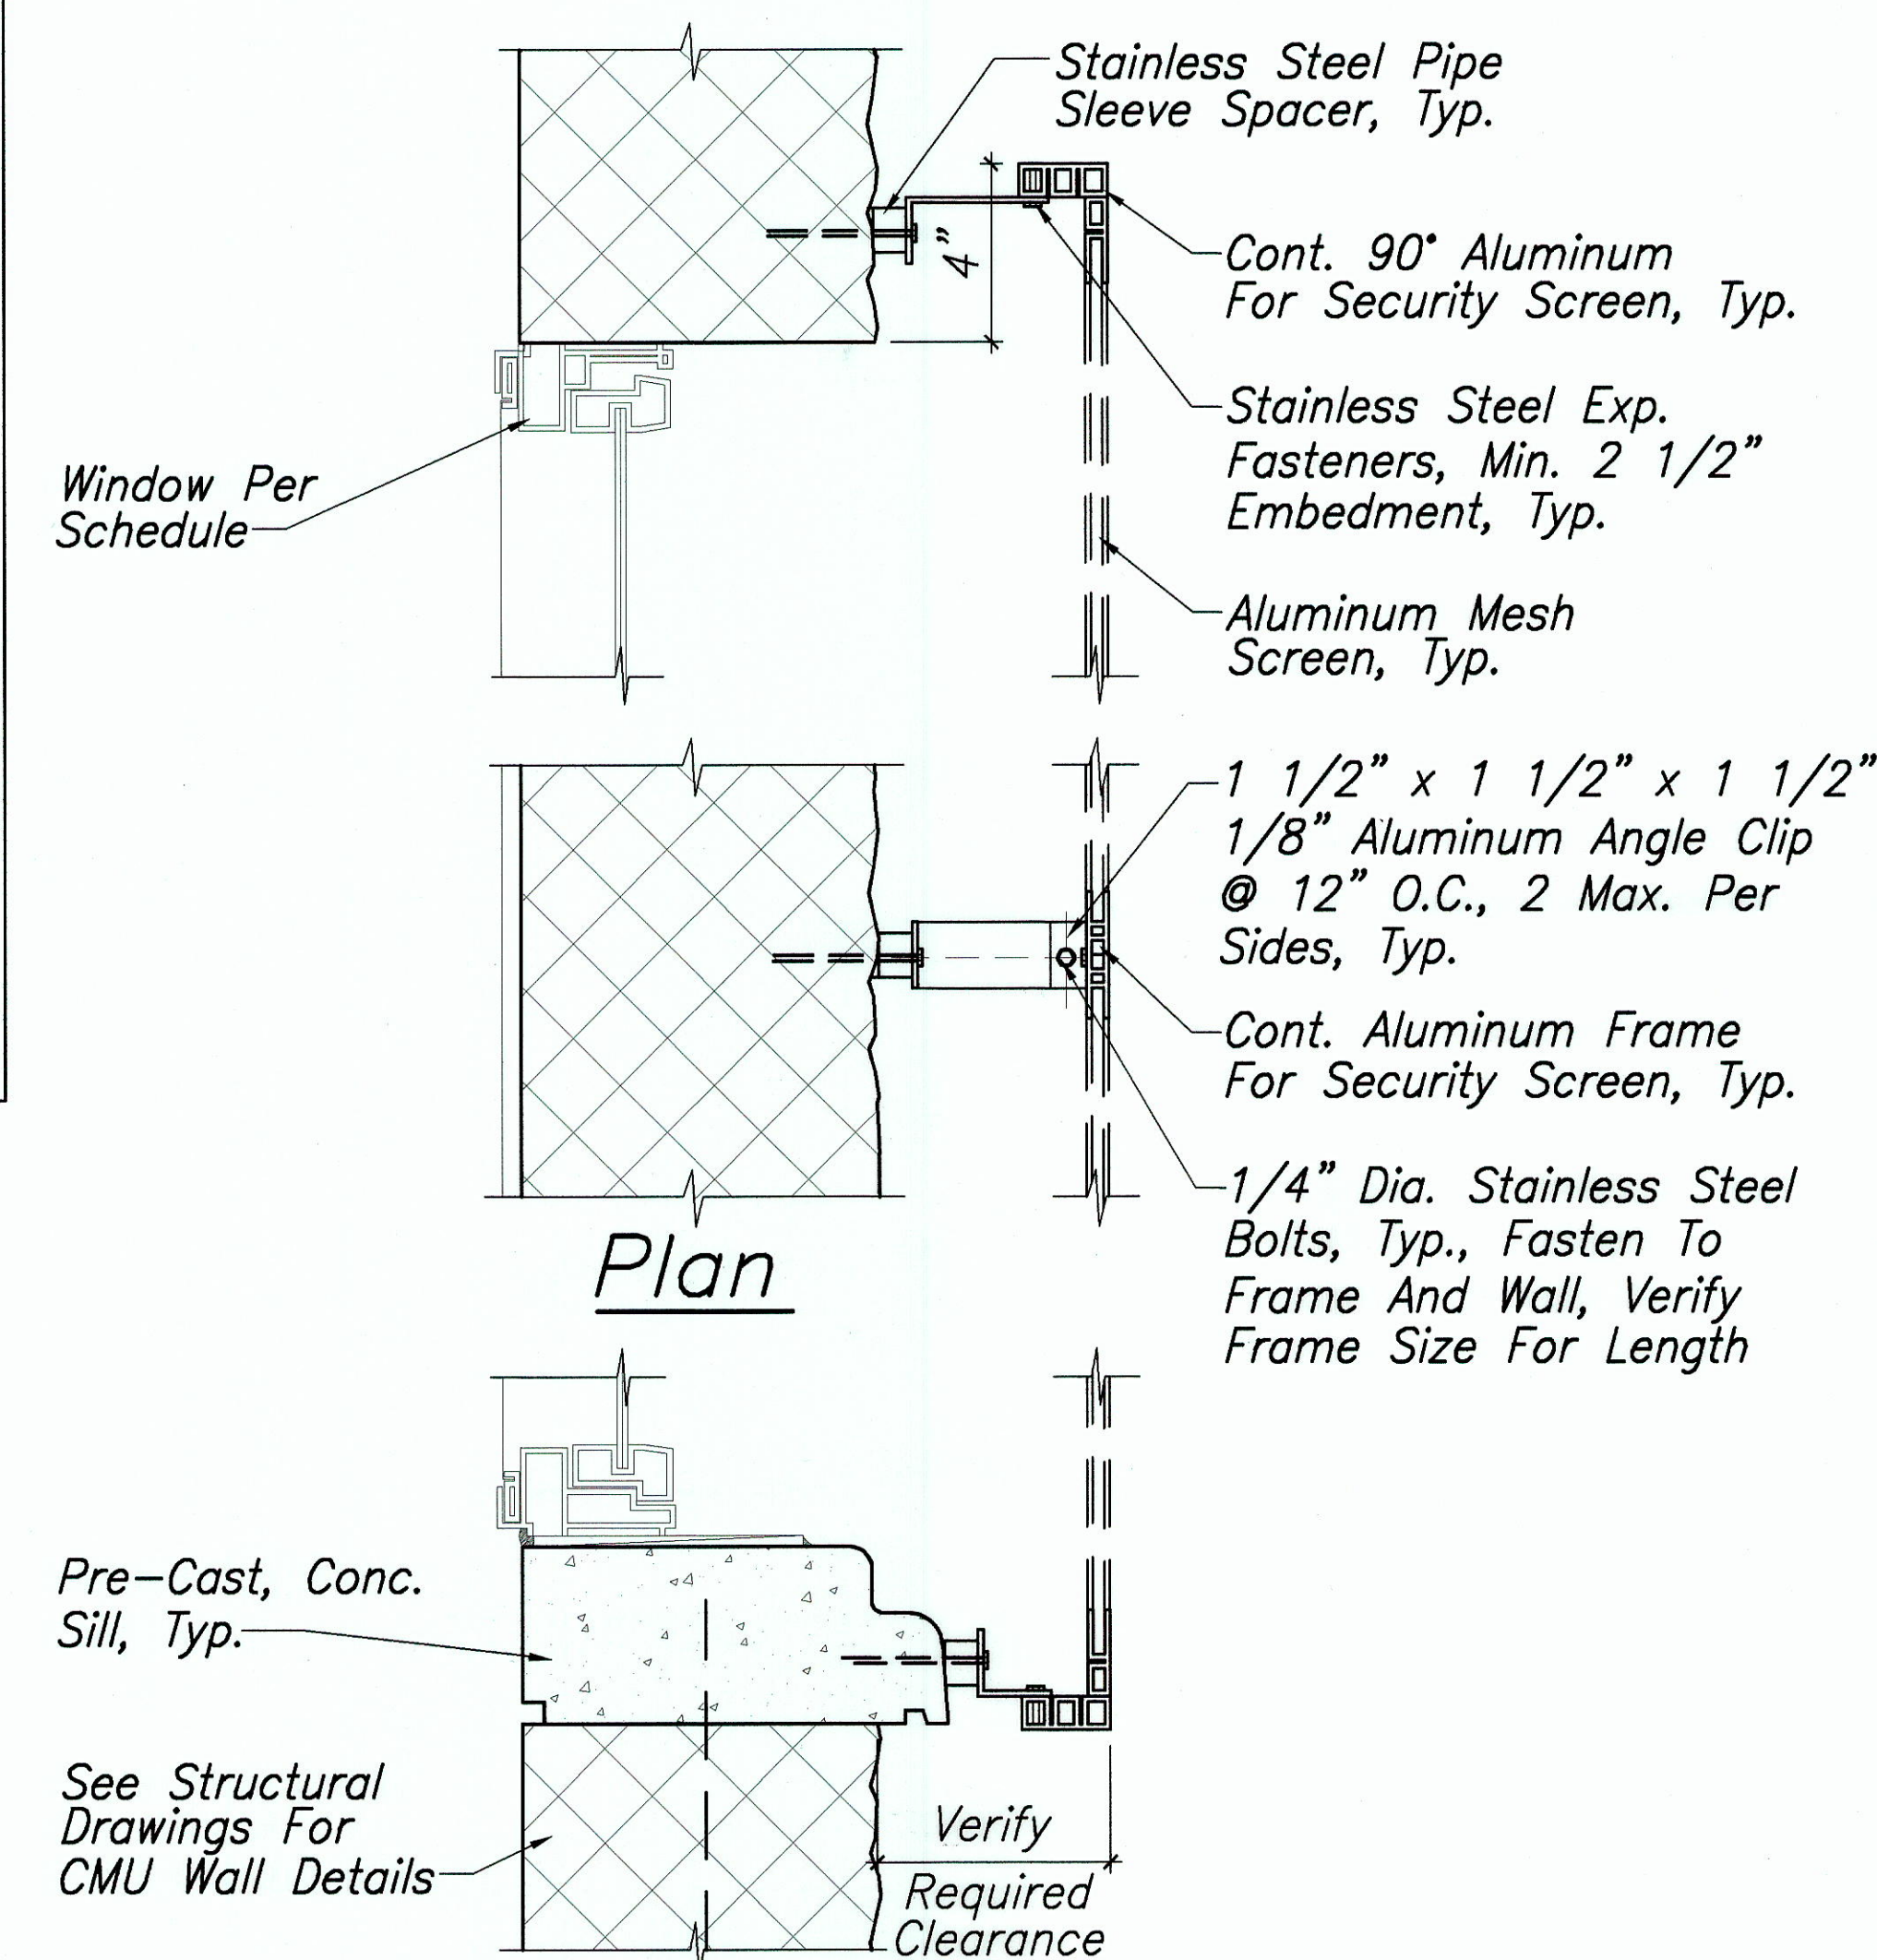

SECURITY SCREEN DETAIL

Scale: 3"=1'-0" A5.00 A5.01



THIS WORK WAS PREPARED BY ME OR UNDER MY SUPERVISION

STATE OF HAWAII
DEPARTMENT OF TRANSPORTATION
HIGHWAYS DIVISION

WINDOW DETAILS

WAHIAWA BASEYARD
IMPROVEMENTS

Project No. HWY-0-12-00

Scale: AS SHOWN Date: JAN. 2003

SHEET No. A5.01 OF 82 SHEETS

"AS-BUILT"

FED. ROAD DIST. NO.	STATE	PROJ. NO.	FISCAL YEAR	SHEET NO.	TOTAL SHEETS
HAWAII	HAW.	HWY-0-12-00	2004	52	82

Split Face CMU Wall,
Textured Side @ Exterior,
(Or Concrete Header, See
Structural Sheets)

Galv. Metal Angle Iron
And Flat Plate @ Head
(Jamb. Sim.), See Detail
2/A5.02

Corner Guard From
1/4" Thk. x 3" x 4"
Galv. Iron Angle

Pre-Finished,
Roll-Up Door
Housing, Mount
To CMU Per
Manufacturer's
Recommended
Installation
Requirements

Roll-Up Door
Assembly

1/4" Thk., Galv. Plate,
Cont., Full Weld To Angle
Iron, Field Verify Size &
See Detail 2/A5.02

Roll-Up Door
Guides And
Accessories Per
Door Manufacturer,
Typ. Both Sides

1/2" Galv. Exp. Bolts
@ 12" O.C., Alternate
Spacing Between Sides

Roll-Up Chain,
Provide Wall
Holder, Typ.

Finish Floor Or
Conc. Apron

ROLL-UP DOOR DETAIL 1
Scale: 1 1/2"=1'-0" 2 1/4" 2"

Non-Shrink Grout On
Split Face Surface Where
Corner Guard Occurs

Corner Guard From
1/4" Thk. x 3" x 4"
Galv. Iron Angle

1/4" Thk. Galv. Plate
(Size As Required To
Allow 1" Overlap Onto
Angle Iron), Cont. Full
Weld To Angle Iron

Roll-Up Door
Assembly

1/2" Galv. Exp. Bolts @ 12" O.C.,
Alternate Spacing Between Sides


Cont. Sealant, Typ.

Split Face CMU Wall, Textured
Side @ Exterior, Typ.


Guide Track Extension From
1/4" Thk. Galv. Angle Iron.

Roll-Up Door Guides Per Manufacturer,
Bolt & Full Weld, Typ. Both Sides

TYP. GUIDE TRACK DETAIL 2
Scale: 3"=1'-0" A3.01 A5.02 A3.03 A4.03

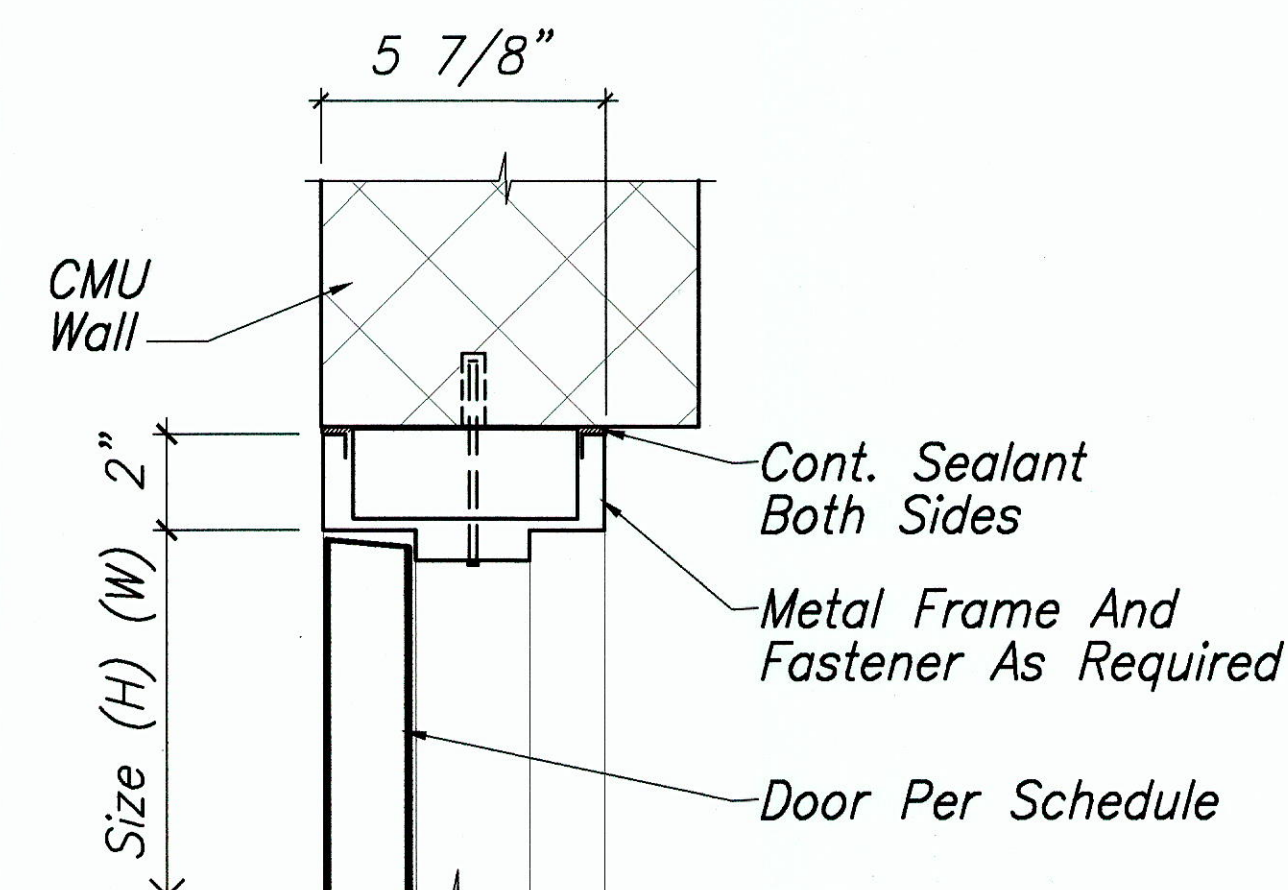


HEAD DETAIL (JAMB SIM.) 3
Scale: 3"=1'-0" A5.00 A5.02

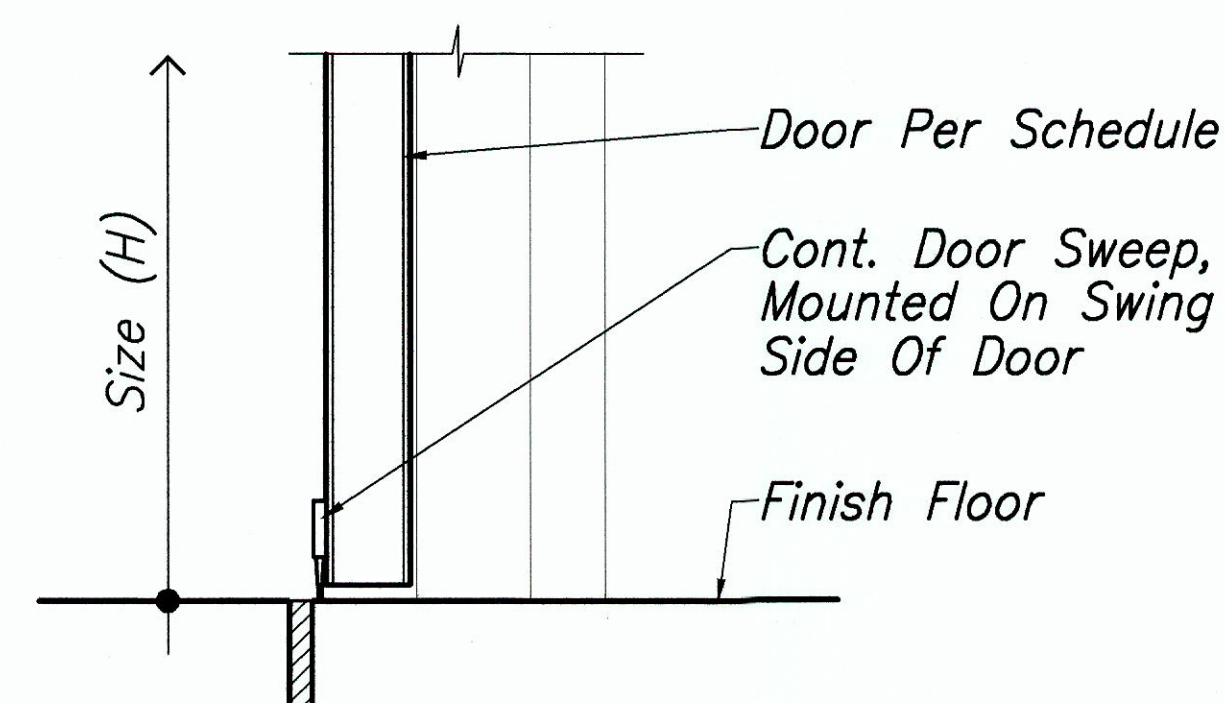


THRESHOLD DETAIL 4
Scale: 3"=1'-0" A5.00 A5.02

EXTERIOR DOOR DETAILS
Scale: As Noted

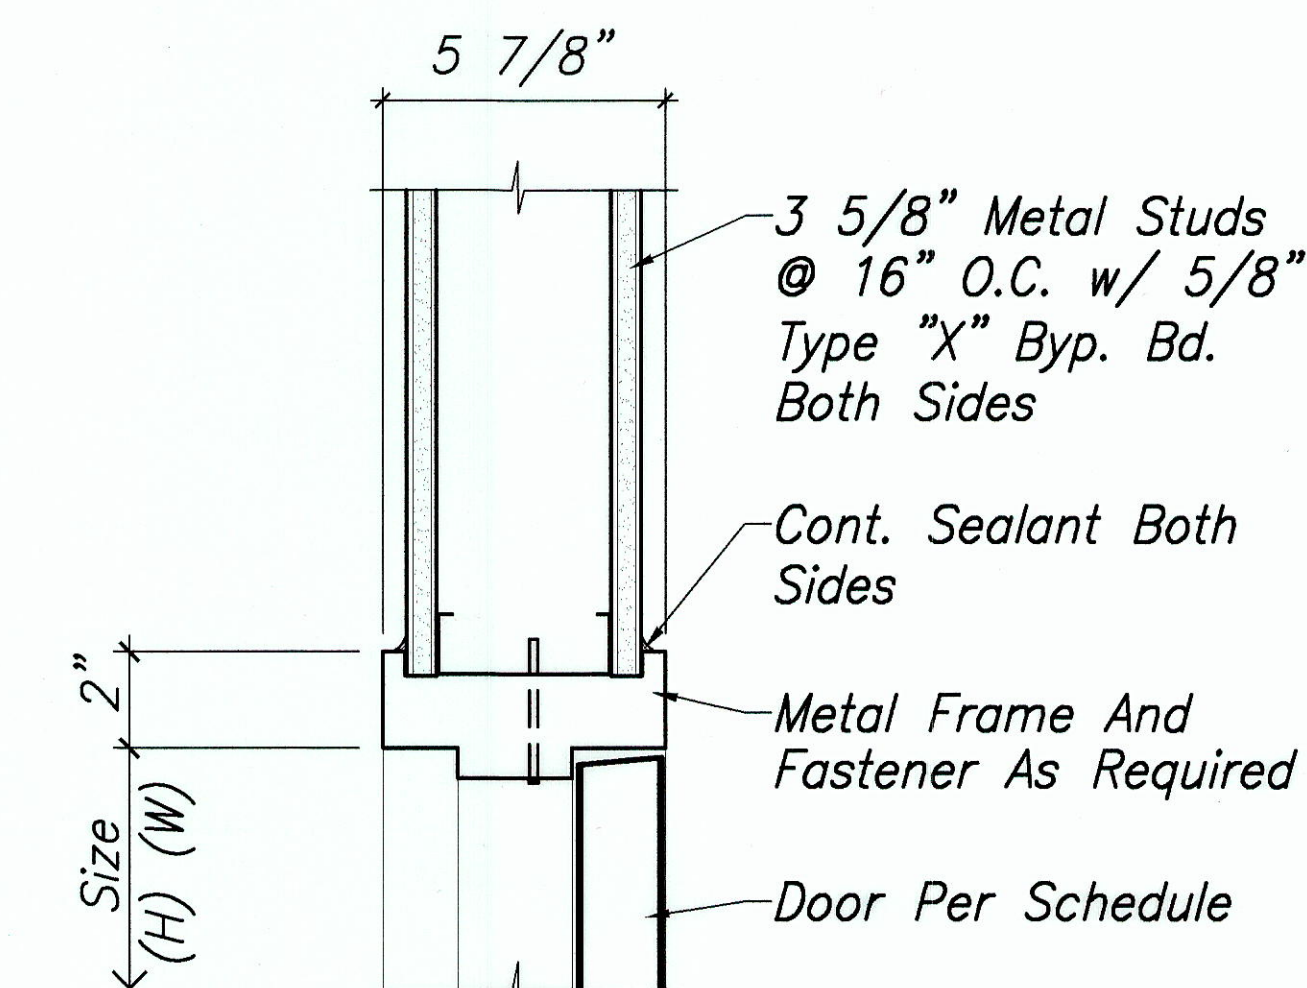


HEAD DETAIL (JAMB SIM.) 5
Scale: 3"=1'-0" A5.00 A5.02

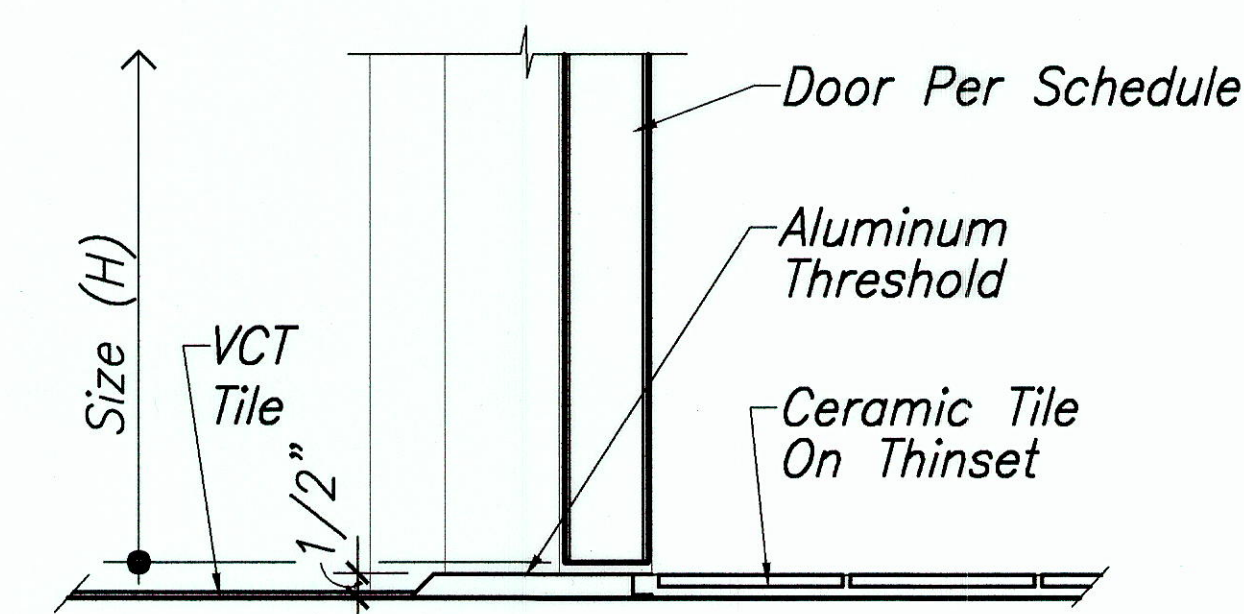

THRESHOLD DETAIL 6
Scale: 3"=1'-0" A5.00 A5.02

INTERIOR DOOR DETAILS
Scale: As Noted

SURVEY PLOTTED BY	DATE
DRAWN BY	
TRACED BY	
DESIGNED BY	
QUANTITIES BY	
CHECKED BY	
ORIGINAL PLAN	No. XX
NOTE BOOK	No. XX

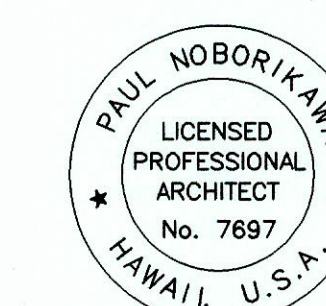

THIS WORK WAS PREPARED BY ME
OR UNDER MY SUPERVISION

STATE OF HAWAII
DEPARTMENT OF TRANSPORTATION
HIGHWAYS DIVISION

DOOR DETAILS

**WAHIAWA BASEYARD
IMPROVEMENTS**

Project No. HWY-0-12-00
Scale: AS SHOWN Date: JAN. 2003
SHEET No. A5.02 OF 82 SHEETS

"AS-BUILT"

52

SIGNAGE SCHEDULE

SIGN NO.	SIGNAGE TEXT	SIGN TYPE	SIGN MOUNTING	REMARKS
S1.0	BUILDING A / OFFICE	1/A5.04	FASTENER	18"W x 8"W
S1.1	RESTROOM	3/A5.04	ADHESIVE	
S1.2	None (Accessible Symbol)	4/A5.04	ADHESIVE	
S1.3	LOCKER ROOM	3/A5.04	ADHESIVE	
S1.4	None (Accessible Symbol)	4/A5.04	ADHESIVE	
S1.5	EXIT	5/A5.04	ADHESIVE	
S2.0	BUILDING B	1/A5.04	FASTENER	
S2.1	RESTROOM	3/A5.04	FASTENER	
S2.2	None (Accessible Symbol)	4/A5.04	FASTENER	
S2.3	STORAGE	2/A5.04	FASTENER	
S2.4	EQUIPMENT STORAGE	2/A5.04	FASTENER	12"W x 5"W
S2.5	GARAGE	2/A5.04	FASTENER	
S2.6	GARAGE	2/A5.04	FASTENER	
S2.7	EMERGENCY EYE WASH	2/A5.04	FASTENER	12"W x 5"W
S2.8	EMERGENCY EYE WASH	2/A5.04	FASTENER	12"W x 5"W
S3.0	BUILDING C	1/A5.04	FASTENER	

SIGNAGE NOTES:

- Signs To Be Melamine Plastic Or Equal With Min. 1/32" Raised Characters/Letters, Background To Be Matte Black With Matte White Borders And Raised Elements.
- Signage Text Noted On The SIGNAGE SCHEDULE Are Tentative And Subject To Change During The Shop Drawing Review Period. Contractor Shall Submit Signage For Review And Approval Prior To Any Signage Fabrication.
- Contractor Shall Verify All Signage Required For The Project With The Project Engineer And Shall Indicate This In The Shop Drawing Submittals.
- Contractor Shall Provide All Additional Signage As Indicated On The Civil, Landscape, Mechanical, And Electrical Drawings And Specifications Where Applicable.

SIGNAGE MOUNTING

FASTENER - Stainless Steel Screw Fastener With Expansion Shield And/Or Epoxy Set As Required. Where Split Face CMU Occurs, Fill Voids and Grooves Behind sign Plate With Grout.


ADHESIVE - Double Stick Tape At Interior Applications. And/Or Epoxy Set As Required. Where Split Face CMU Occurs, Fill Voids and Grooves Behind sign Plate With Grout.



THIS WORK WAS PREPARED BY ME OR UNDER MY SUPERVISION

[Signature]


STATE OF HAWAII DEPARTMENT OF TRANSPORTATION HIGHWAYS DIVISION	
SIGNAGE SCHEDULE, DETAILS	
WAHIAWA BASEYARD IMPROVEMENTS	
Project No. HWY-0-12-00	
Scale: AS SHOWN	Date: JAN. 2003
SHEET No. A5.04 OF 82 SHEETS	

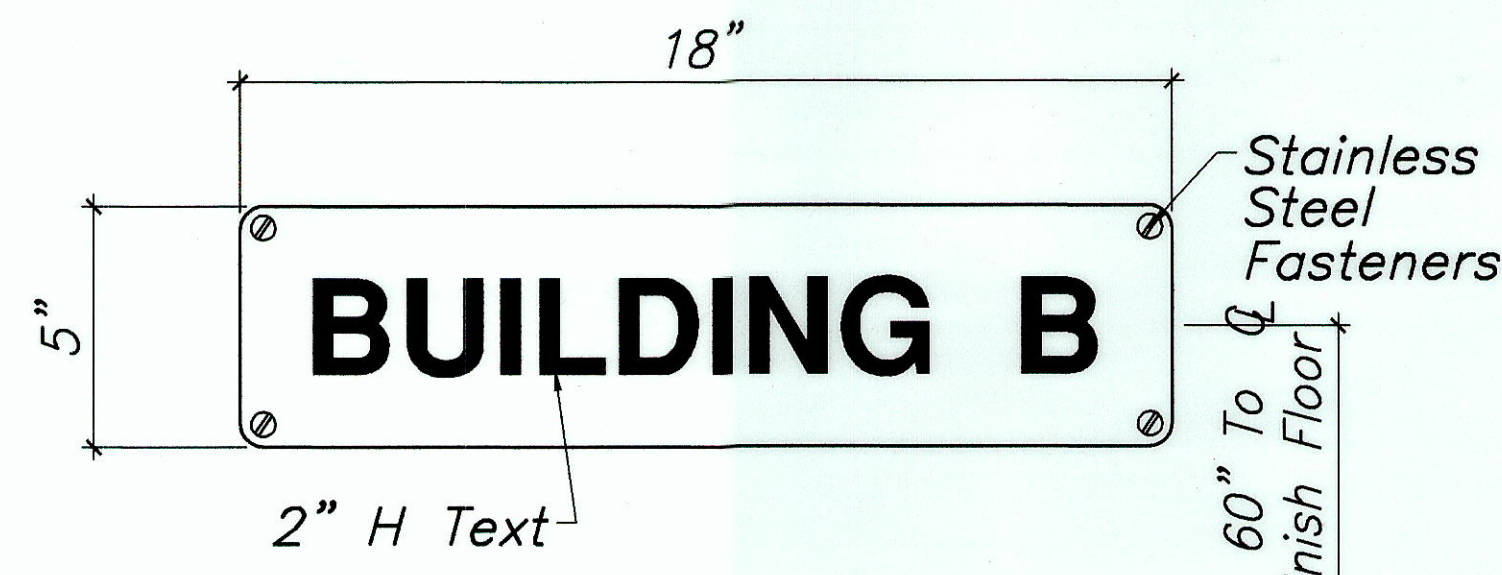

BUILDING SIGN DETAIL 1

Scale: 3"=1'-0"


A3.03, A4.00
A2.00, A2.01, A3.00,

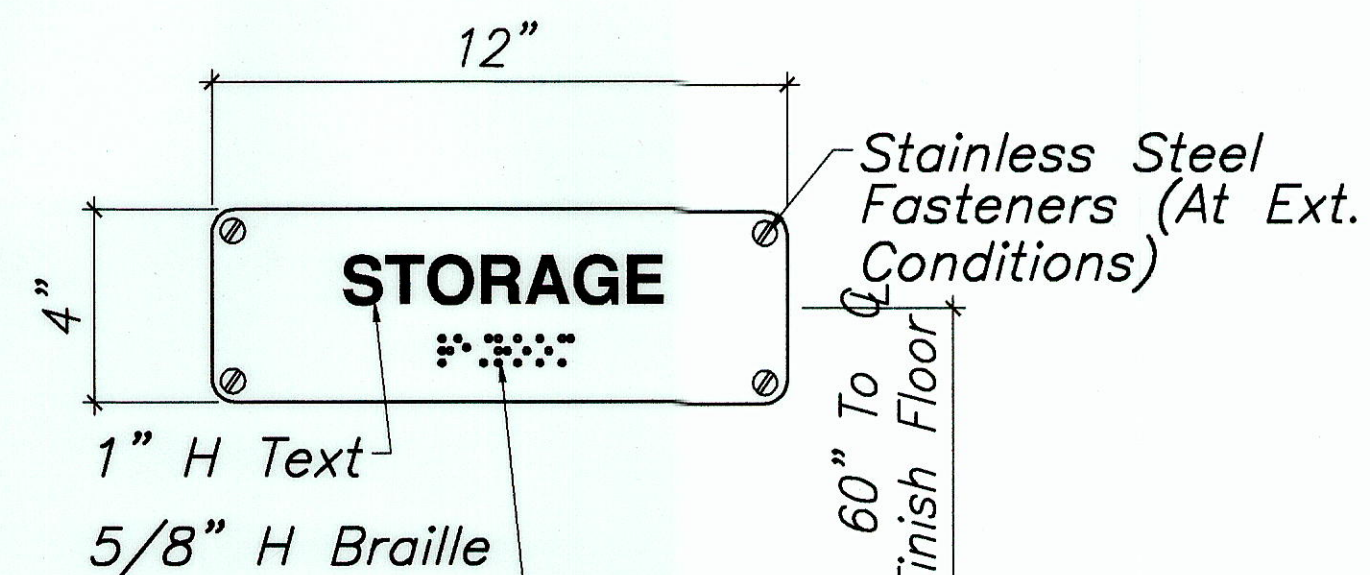

ROOM SIGN DETAIL 2

Scale: 3"=1'-0"


A3.05 A5.04
A3.03

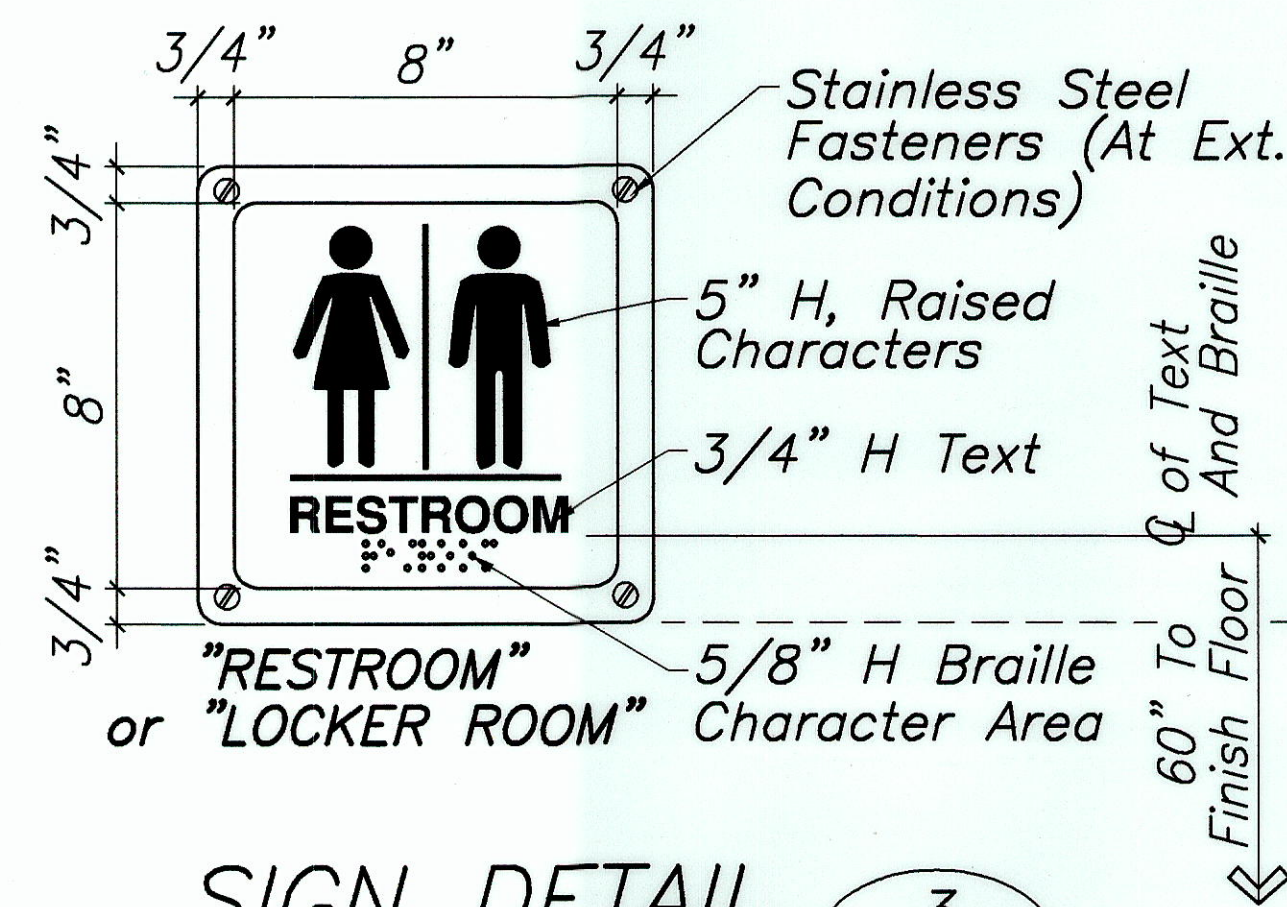

SIGN DETAIL 3

Scale: 3"=1'-0"

A3.03 A5.04
A2.02

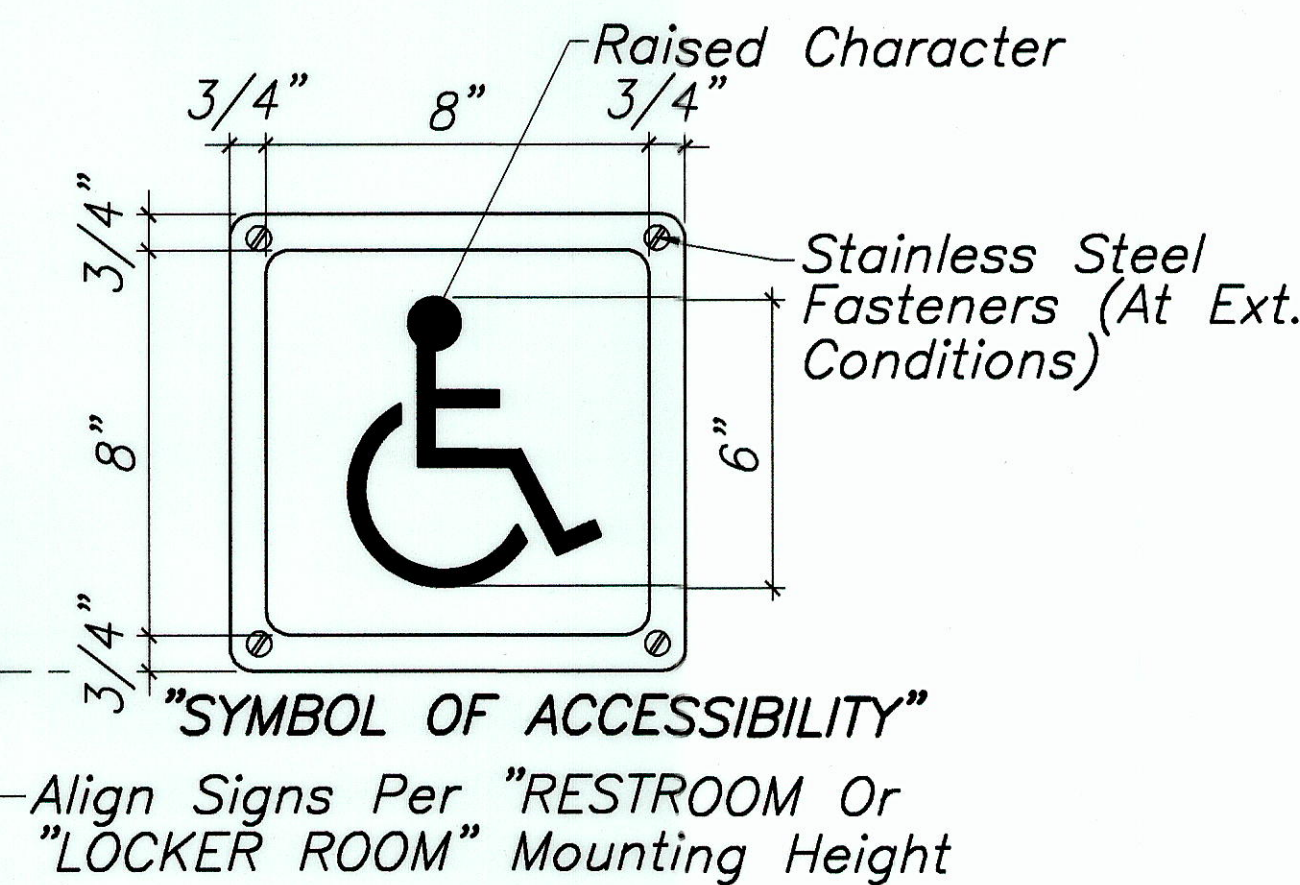

SIGN DETAIL 4

Scale: 3"=1'-0"

A3.03 A5.04
A2.02



SIGN DETAIL 5

Scale: 3"=1'-0"

A2.00 A5.04

SURVEY PLOTTED BY	DATE
DRAWN BY	
DESIGNED BY	
QUANTITIES BY	
CHECKED BY	
ORIGINAL PLAN	No. XX

COLOR AND MATERIAL SCHEDULE

FED. ROAD DIST. NO.	STATE	PROJ. NO.	FISCAL YEAR	SHEET NO.	TOTAL SHEETS
HAWAII	HAW.	HWY-0-12-00	2004	55	82

ROOM FINISH SCHEDULE


BUILDING	ROOM/AREA	FLOOR	BASE	WALLS	CEILING	REMARKS
OFFICE	Office/Staging Area	VCT-1	RB-1	P-2	CLG-1	
	Vestibule	VCT-1	RB-1	P-2	CLG-1	
	Unisex Toilet	CT-1	CT-3	P-2	CLG-1	
	Unisex Locker Room	CT-1	CT-3	P-2	CLG-1	
	Dressing Area	CT-2	CT-3	P-2	CLG-1	
	Shower	CT-2	N/A	CT-3	CLG-1	
GARAGE/STORAGE	Restroom	CT-4	CT-4	P-3	P-5	
	Storage Room	PS-1	N/A	PS-2	N/A	
	Equipment Storage Room	PS-1	N/A	PS-2	N/A	
	Vehicle Garage	PS-1	N/A	PS-2	N/A	

FINISH SCHEDULE NOTES:

1. Contractor Shall Submit Paint Color Samples For Review And Approval.
2. All Metal Items To Be Painted Shall Be Prepped With An Approved Metal Primer.
3. Contractor Shall Be Responsible For Obtaining Final Approvals For All Finish Materials From The Engineer.
4. All Finishes And Manufacturers Are Provided As A Guideline For Color And Material Quality And Are Intended For Reference.

[illegible]

ORIGINAL PLAN	SURVEY PLOTTED BY _____ DATE _____
NOTE BOOK	DRAWN BY _____
	TRACED BY _____
	DESIGNED BY _____
	QUANTITIES BY _____
	CHECKED BY _____
No. _____	XX

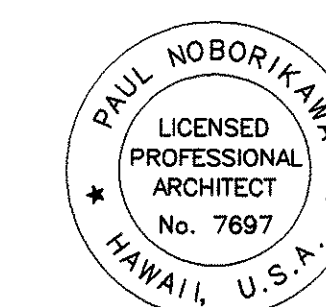

THIS WORK WAS PREPARED BY
OR UNDER MY SUPERVISION

STATE OF HAWAII
DEPARTMENT OF TRANSPORTATION
HIGHWAYS DIVISION

ROOM FINISH SCHEDULE

WAHIAWA BASEYARD
IMPROVEMENTS

Project No. HWY-0-12-00

Scale: AS SHOWN Date: JAN. 2003

SHEET No. A5.05 OF 82 SHEETS