

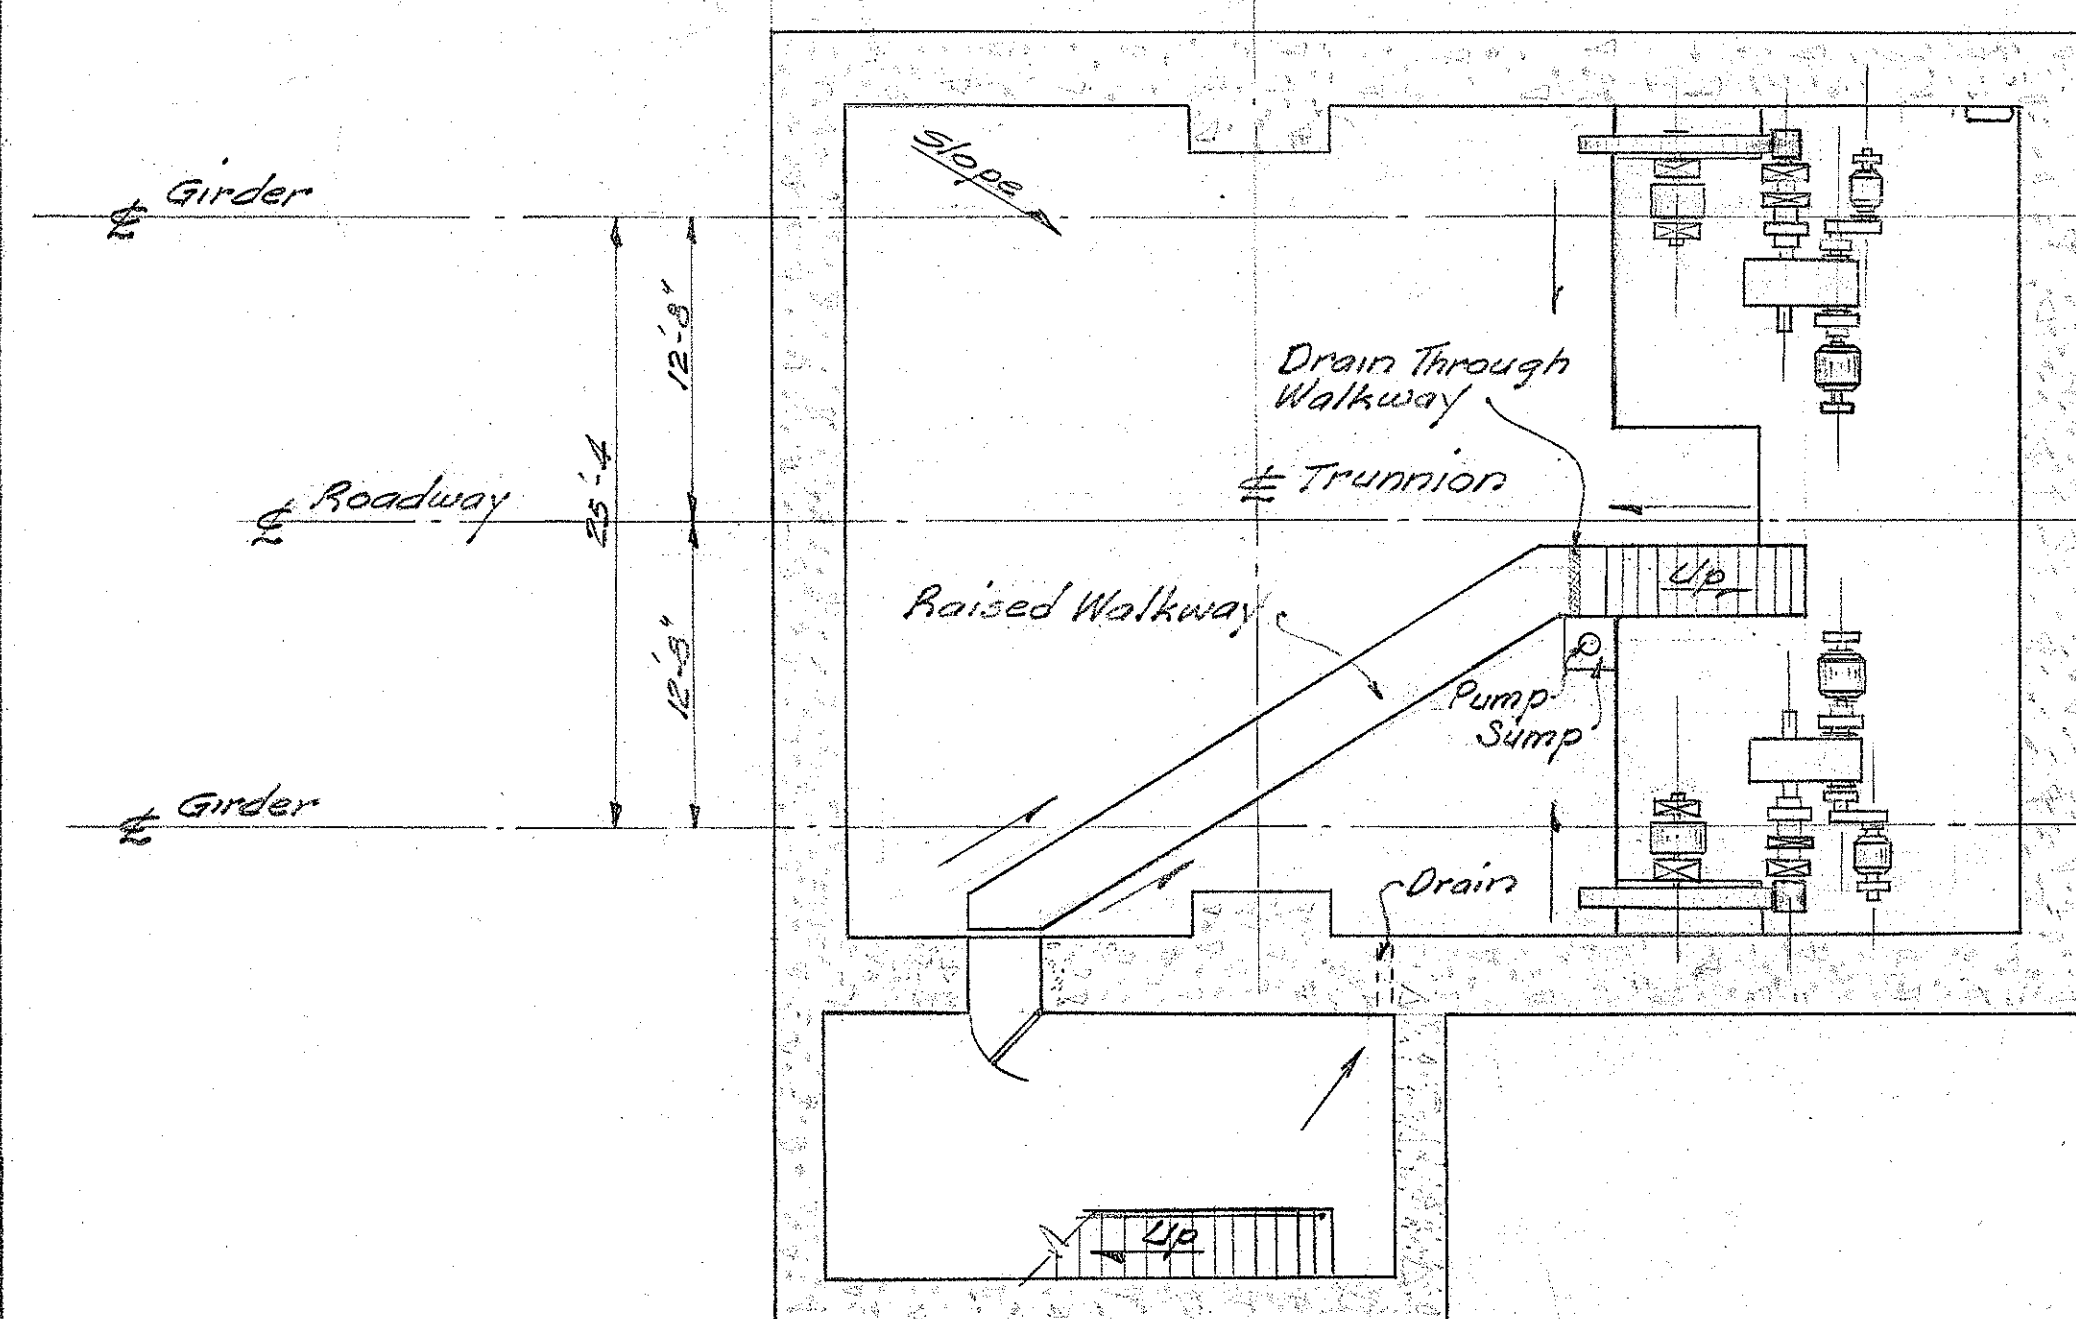
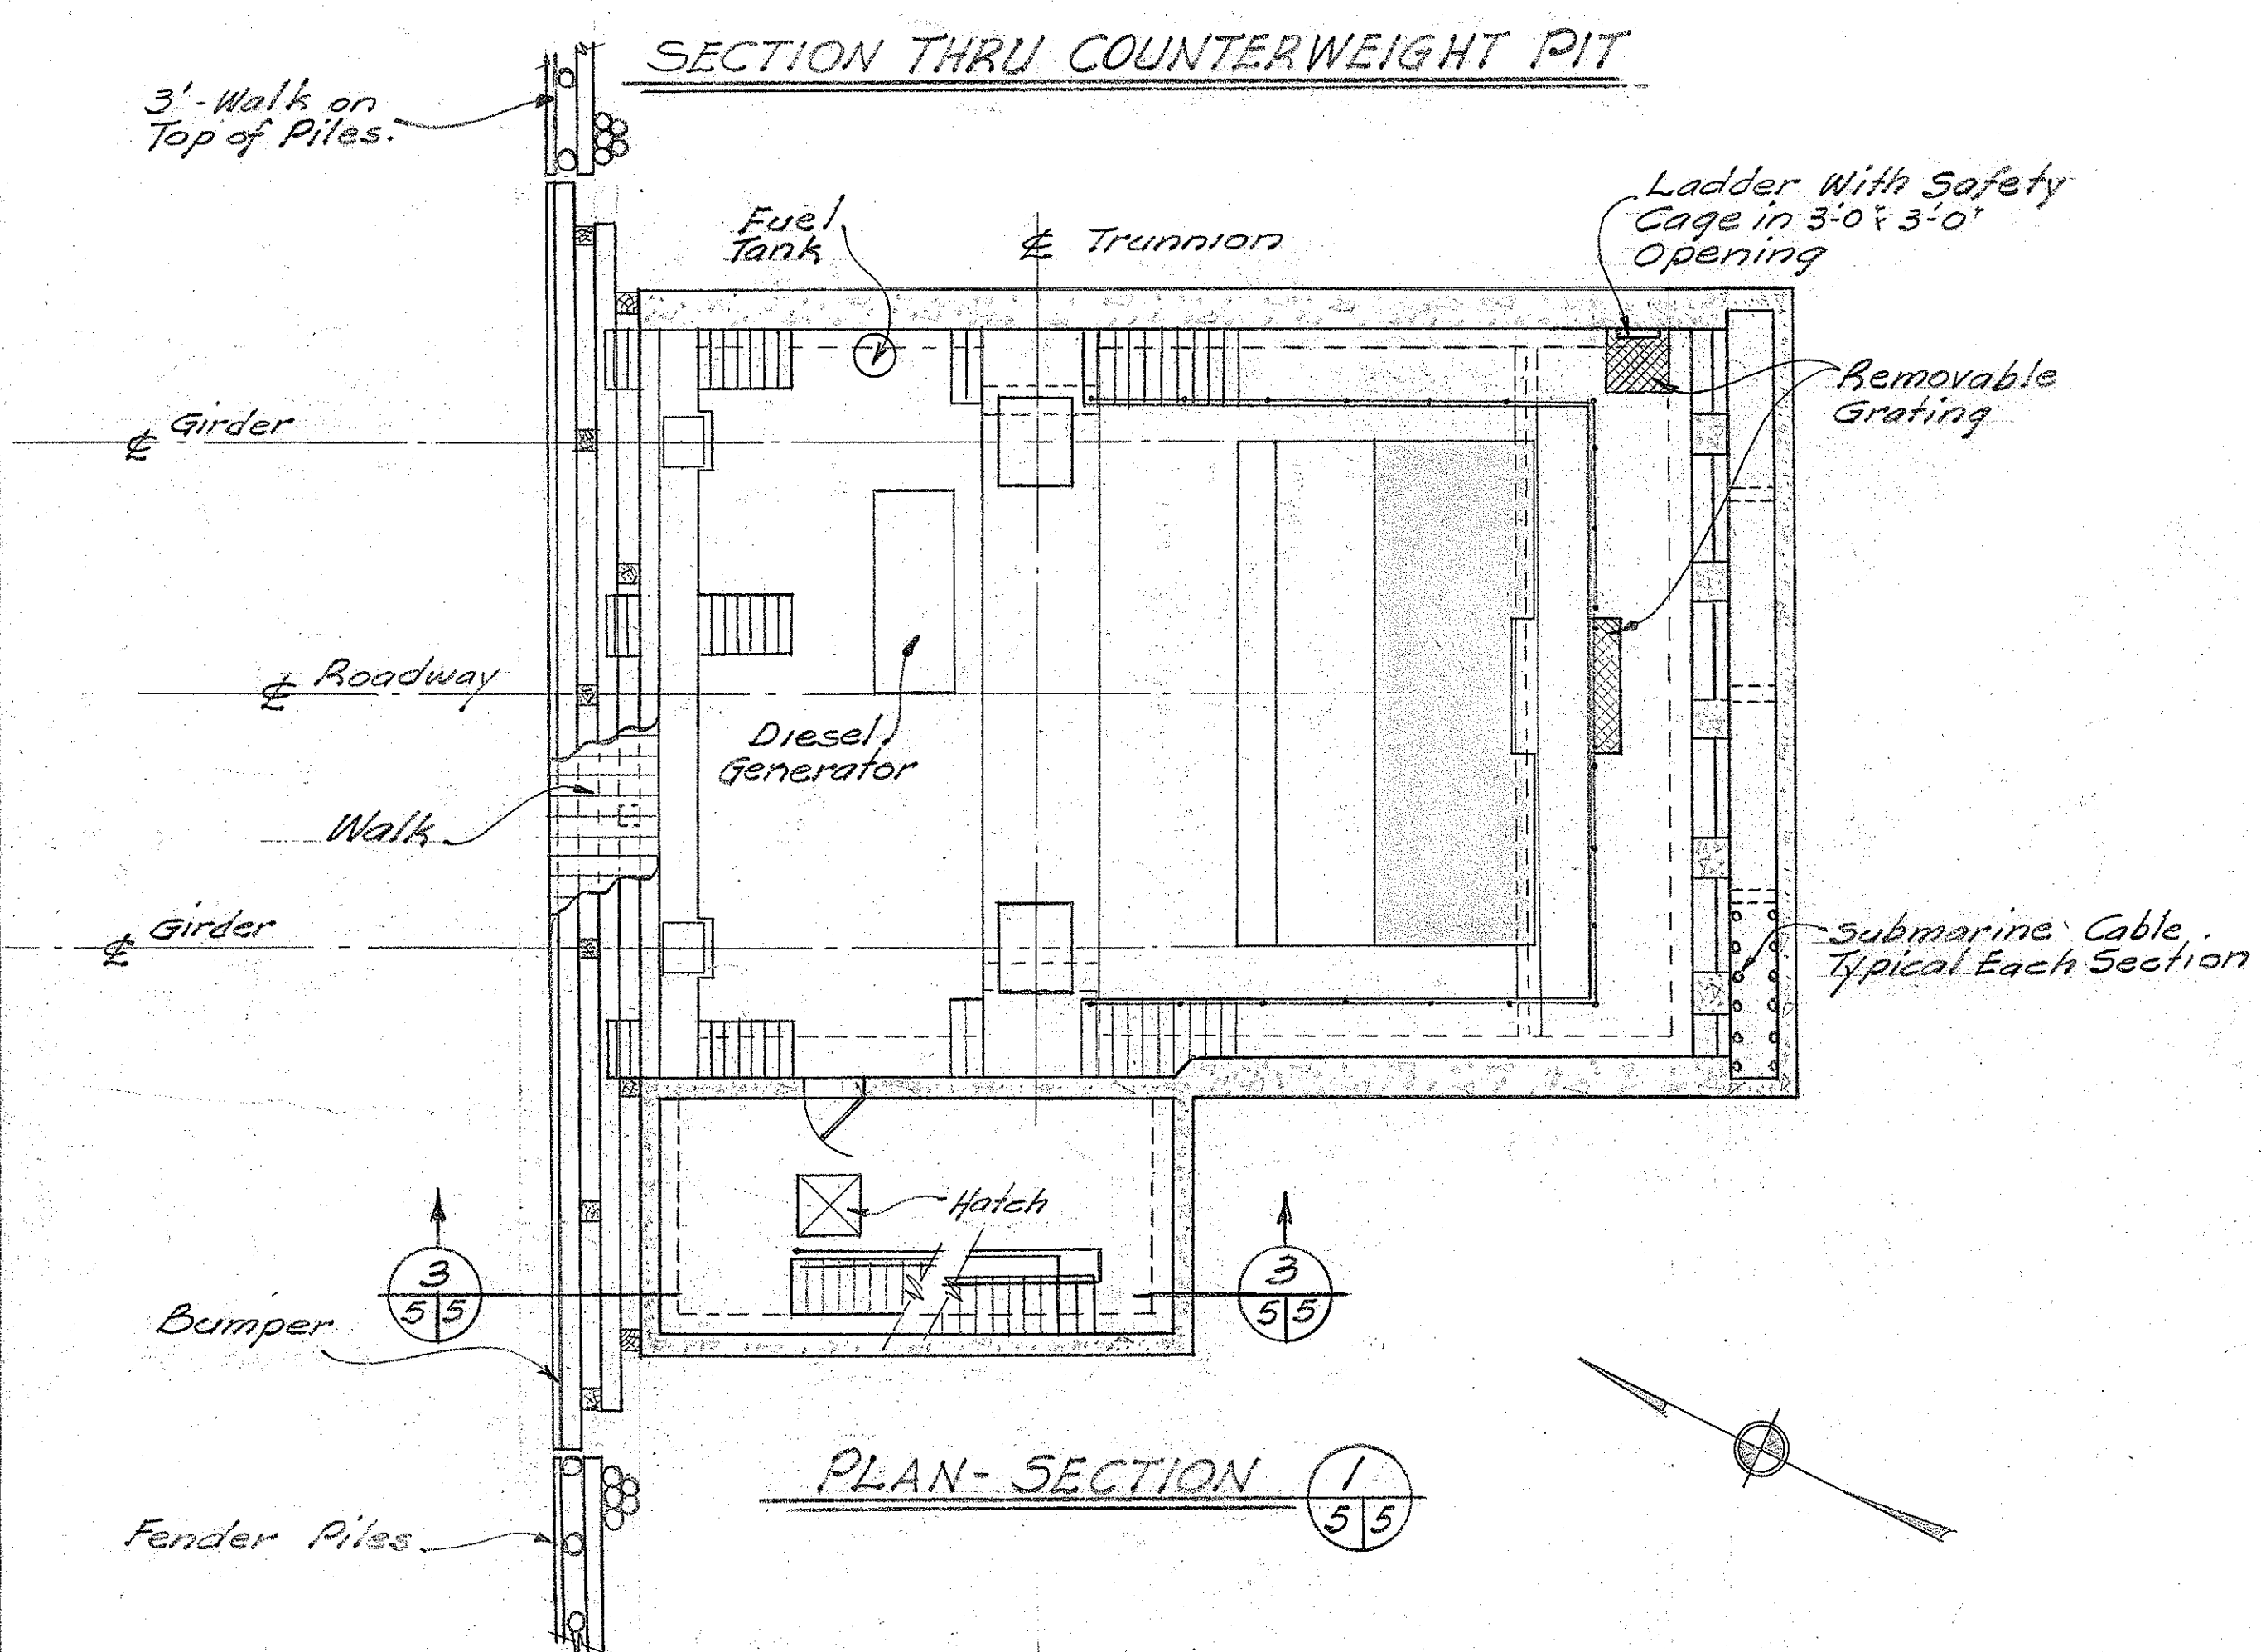


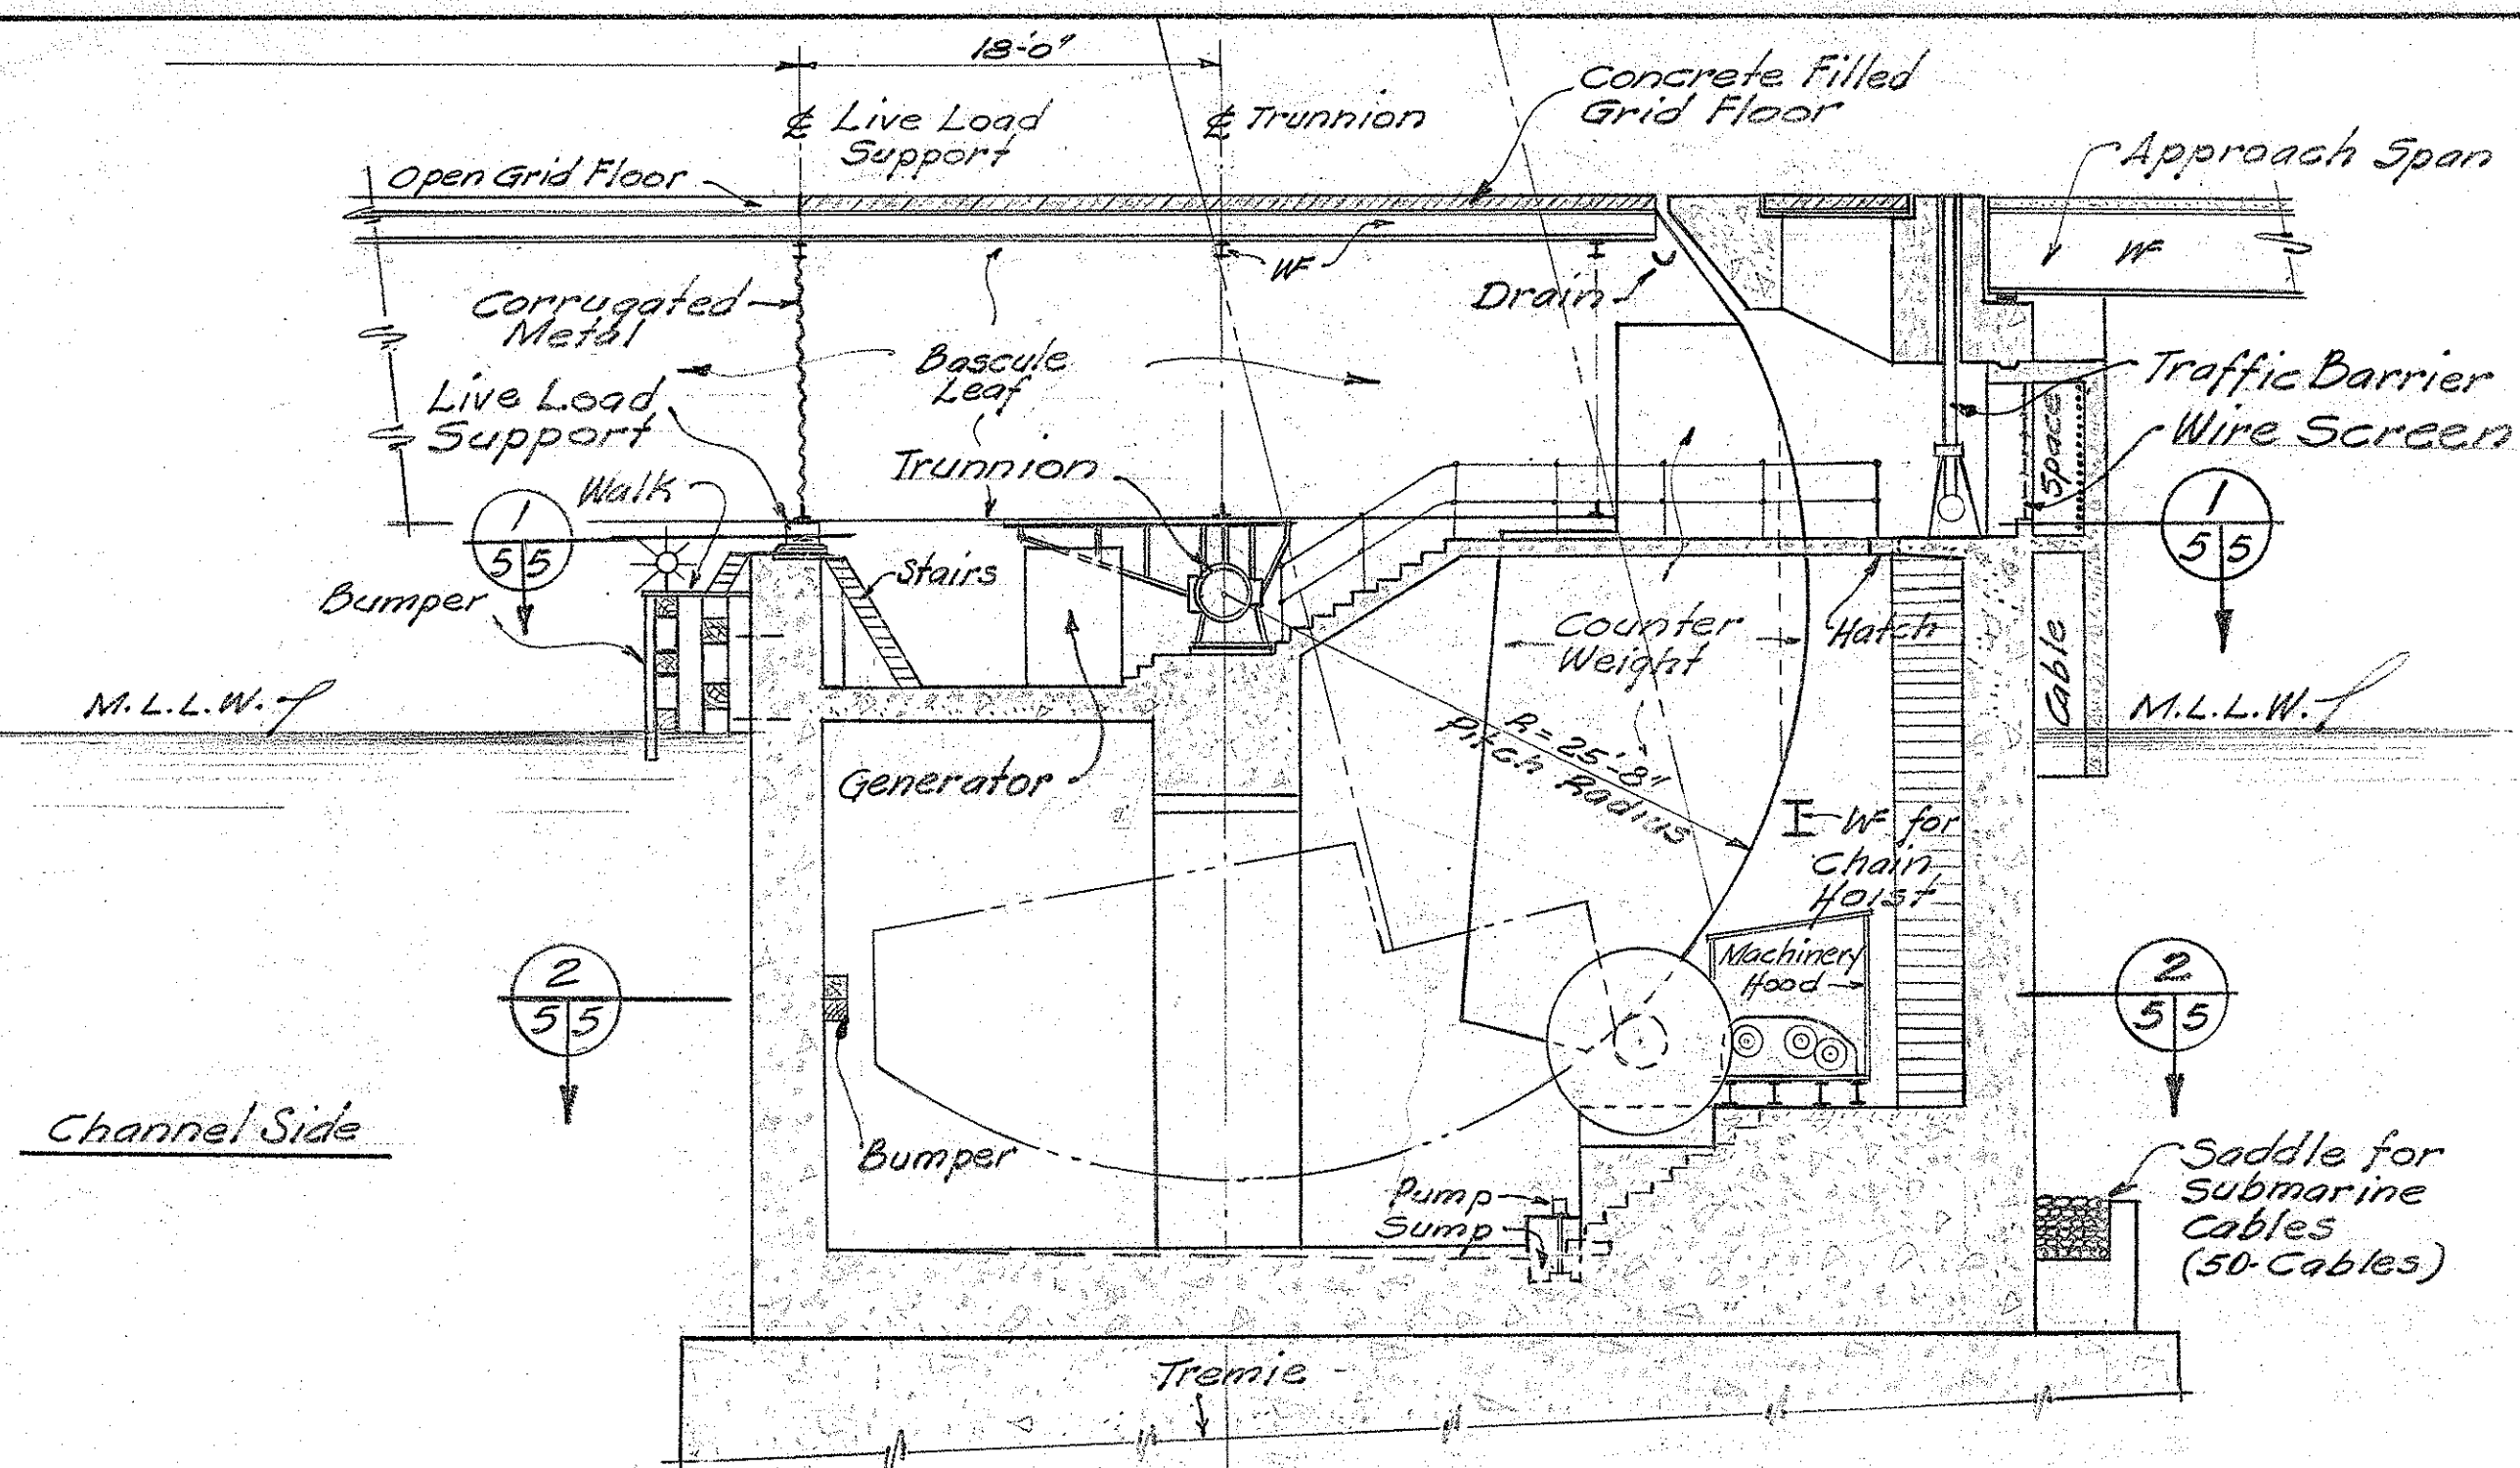


PLAN-SECTION 2
5/5


SOUTH PIER
Scale: 1/8" = 1'-0"

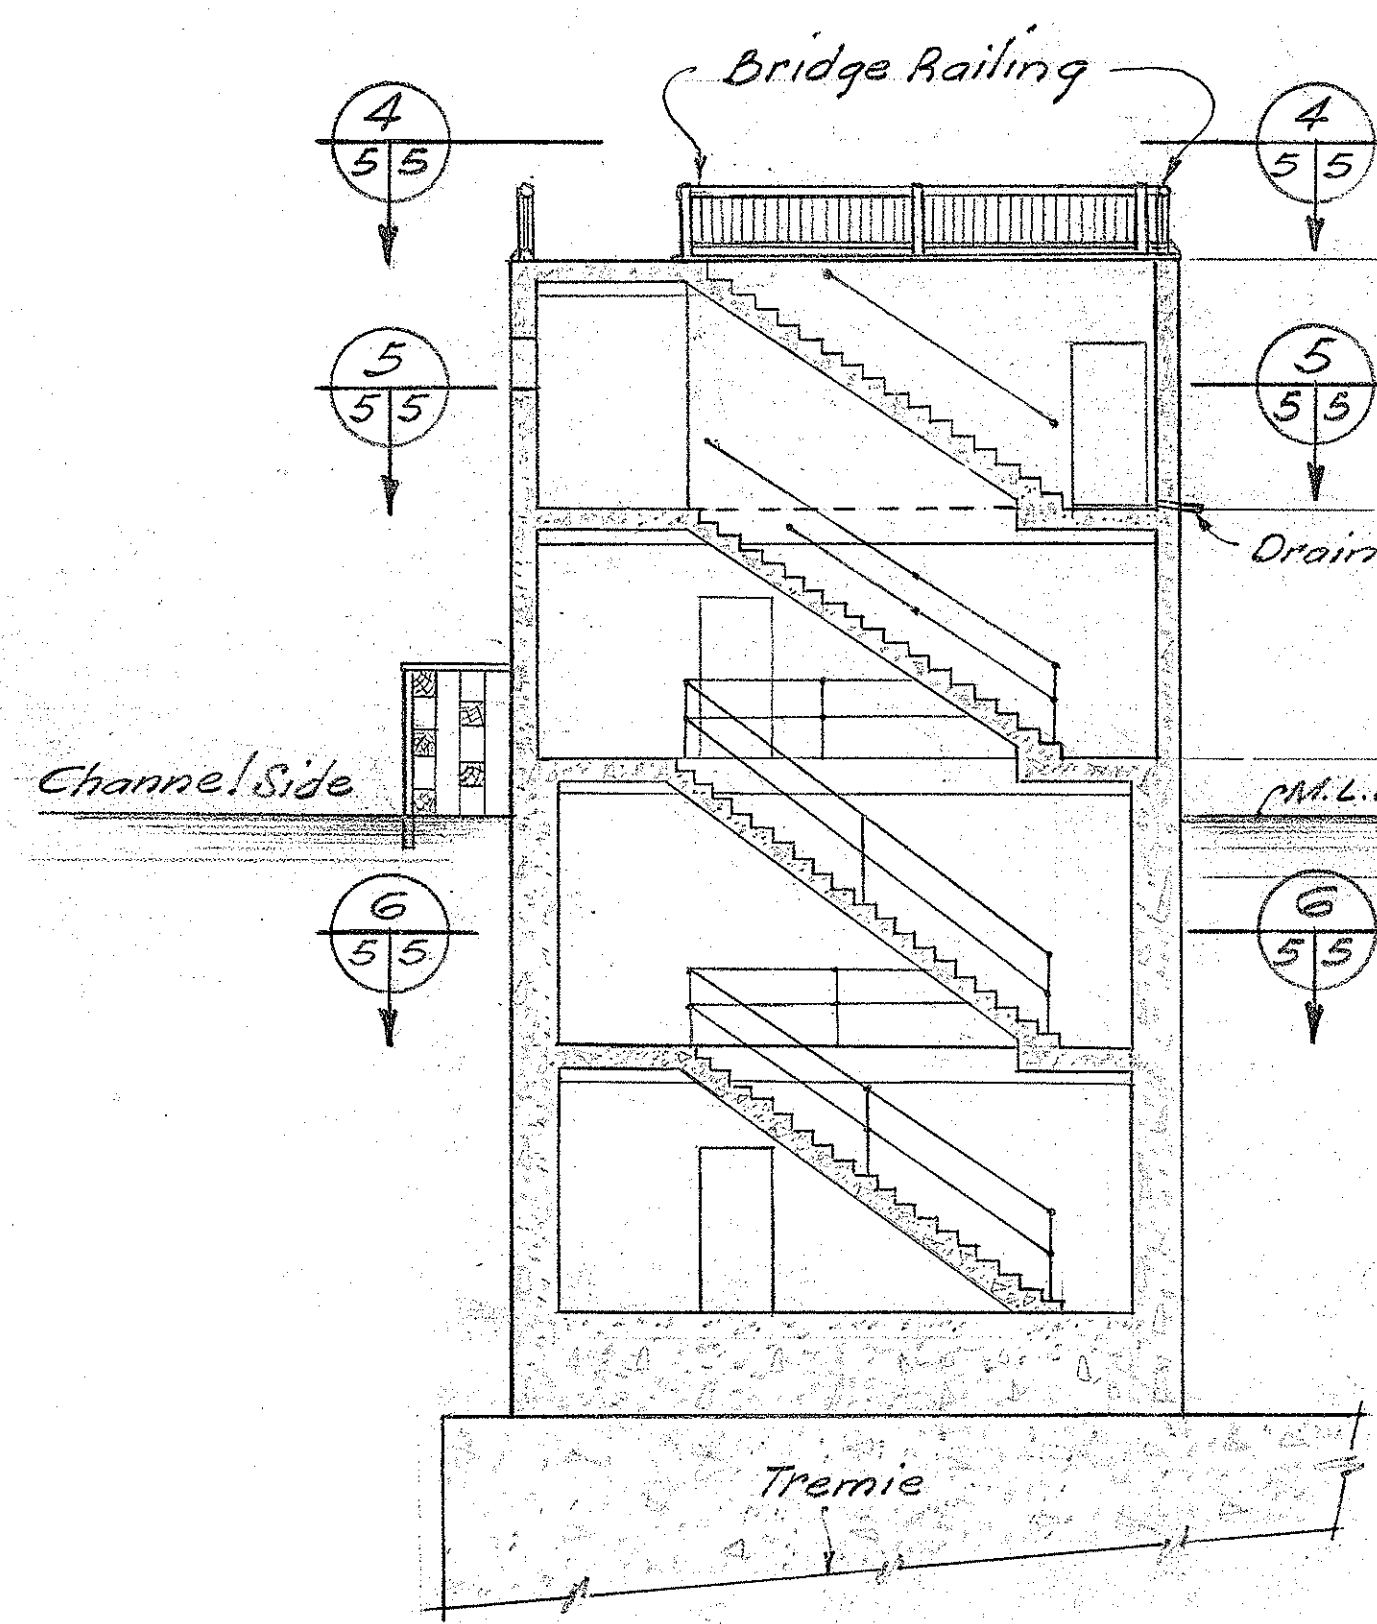


SECTION-ELEVATION 3
5/5

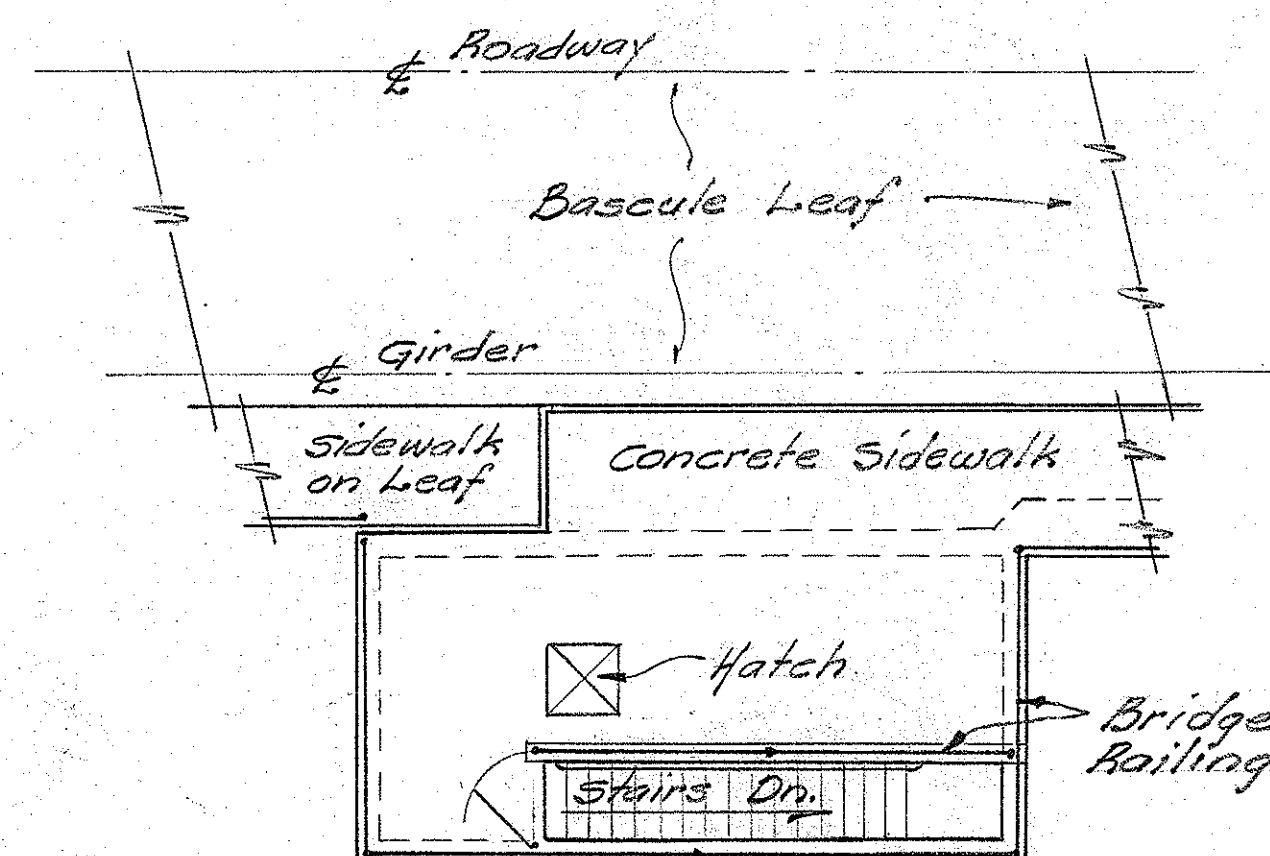


PLAN 4
5/5

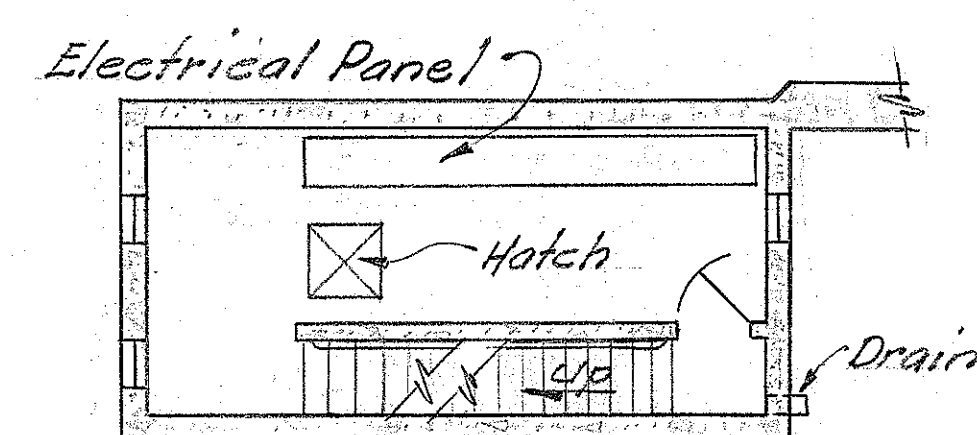


PLAN-SECTION 5
5/5

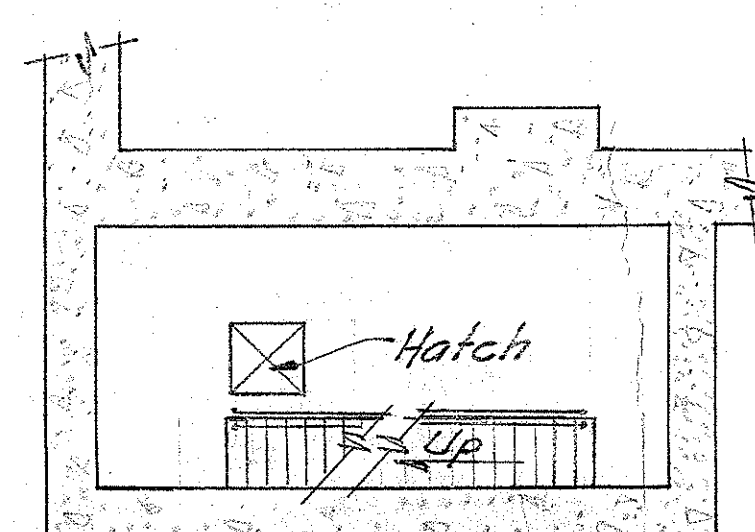


PLAN-SECTION 6
5/5

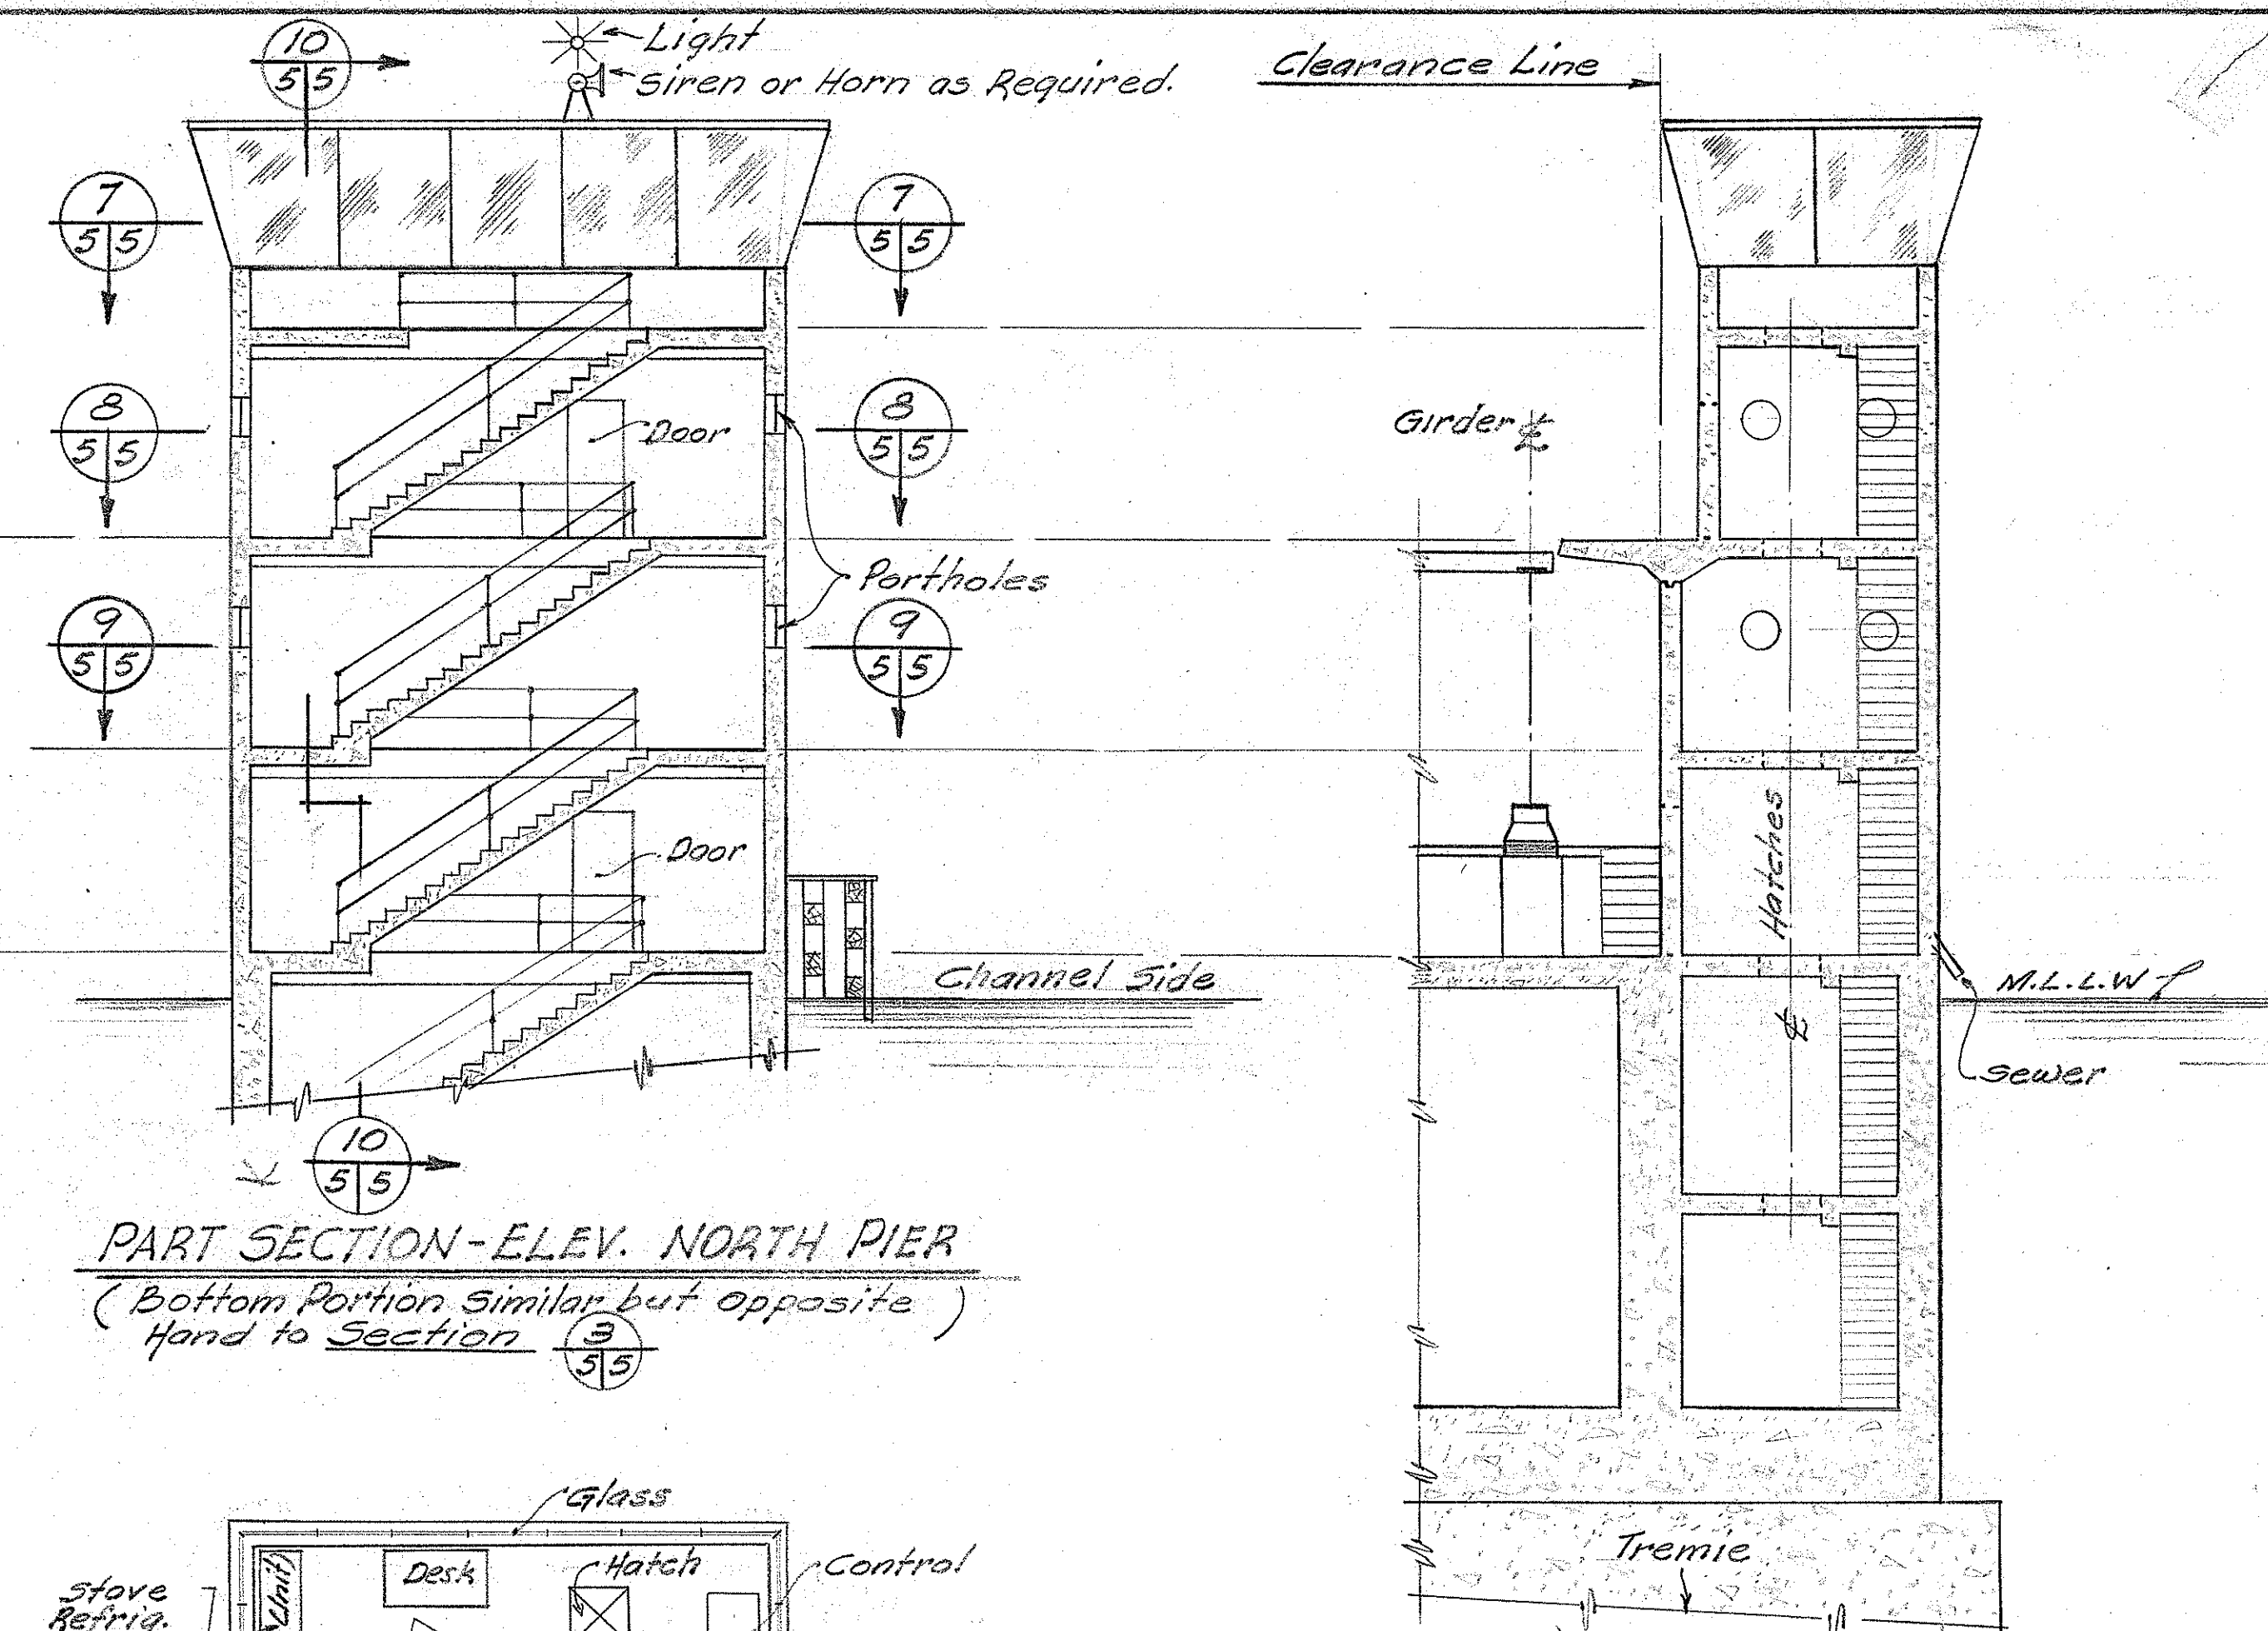


PART SECTION-ELEV. NORTH PIER
(Bottom Portion Similar but Opposite
Hand to Section 3/5)

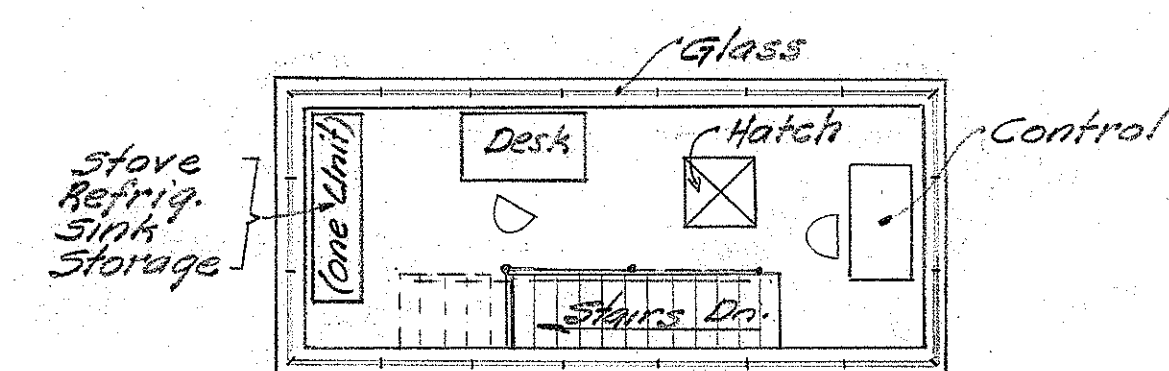

PLAN-SECTION 7
5/5

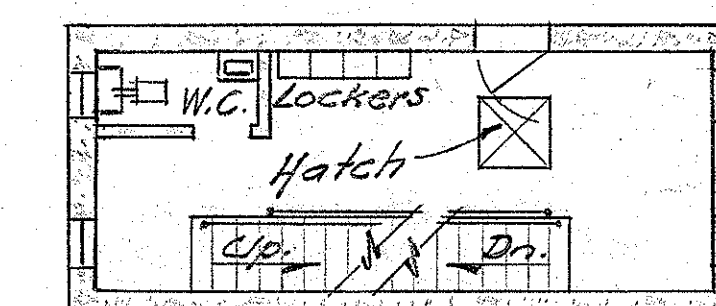


PLAN-SECTION 8
5/5

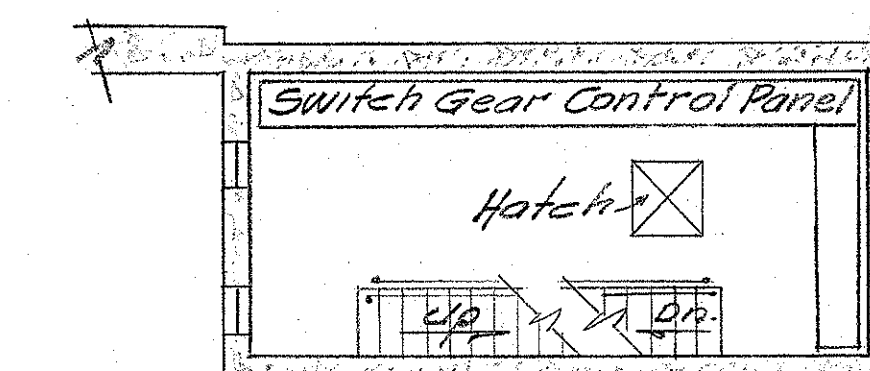

PLAN-SECTION 9
5/5

NORTH PIER
Scale: 1/8" = 1'-0"

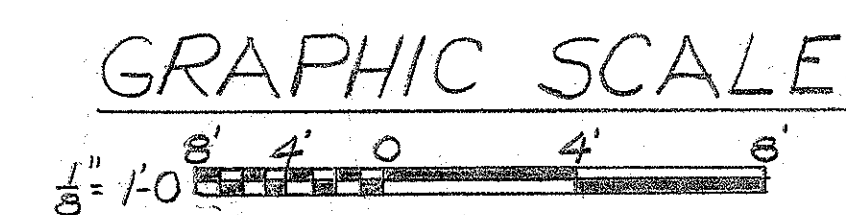

LAW & WILSON - TUDOR ENGINEERING CO. ARCHITECTS & ENGINEERS HONOLULU	U.S. ARMY ENGINEER DISTRICT, HONOLULU CORPS OF ENGINEERS SAN FRANCISCO HONOLULU, T.H.
DRAWN BY: Landold & Gibson	HONOLULU HARBOR OAHU, T.H.
CHECKED BY: PEP	SECOND ENTRANCE CHANNEL
SUBMITTED BY: R. A. Nelson	BASCULE BRIDGE
	MAIN PIER LAYOUT