
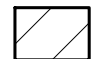


NOTES:


- SEE SHEET S-001 STRUCTURAL NOTES FOR DEMOLITION REQUIREMENTS INCLUDING DUST CONTROL, LIMITATIONS, AND CONTRACTOR RESPONSIBILITIES.
- SEE SHEET S-600 TO S-603 FOR PROPOSED DUST CONTROL MEASURES. SUBMIT PLAN-OF-ACTION OF DUST CONTROL MEASURES TO DOT-A IN WRITING FOR REVIEW PRIOR TO START OF DEMOLITION.

LEGEND:

-  TO BE REMOVED
-  PHASE 3 DEMOLITION

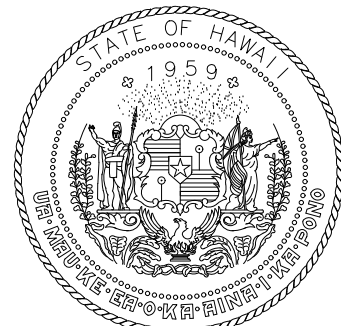

Airports Division
DEPARTMENT OF TRANSPORTATION
STATE OF HAWAII

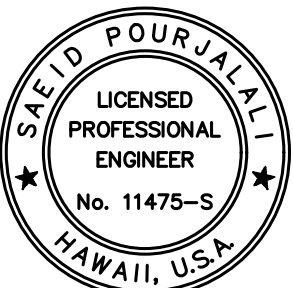


Saad Pourjalebi
04/30/2024
Licensed Expiration Date

This work was prepared by me or under my supervision

DSGN.	DRWN.	CHKD.	APPD.
MG	MG	SP	

KEY PLAN / NOTES:

2ND LEVEL DH ROADWAY

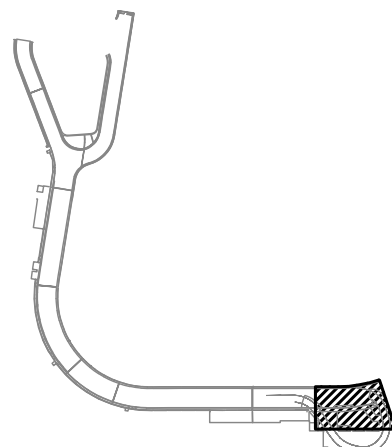

 10/20/22 ADDENDUM 1

NO.	DATE	REVISIONS
-----	------	-----------

CONSTRUCTION DOCUMENTS

SEPTEMBER, 2022
DATE

PROJECT TITLE :

EWA AND DH CONCOURSE
ROADWAY IMPROVEMENTS
PHASE 1

AT
DANIEL K. INOUE INTERNATIONAL AIRPORT
HONOLULU, OAHU, HAWAII

PROJECT NO.:

AO1043-32

SHEET TITLE:

DIAMOND HEAD
WING - SECOND
FLOOR PARTIAL
DEMOLITION PLAN A

DATE :

SEPTEMBER, 2022


SHEET :

96 OF 247 SHEETS

DWG. NO.

S-D-201

NORTH

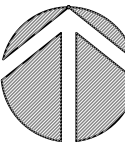

1
S-D-211
BLDG
SECT

CONTRACTOR TO SURVEY CURB FOR SPALLS
ADJACENT TO ROADWAY RECEIVING REPAIRS
AND SUBMIT REPAIR PLAN TO DOT-A FOR
APPROVAL. REPAIR SPALLS PER DETAIL

5
S-200

(E) PLANTER

(E) OUTER
CONCRETE COLUMN,
TYP.

(E) DRAIN TO BE REMOVED,
TYP. SEE MECHANICAL
DRAWINGS

(E) ASPHALT RAMP

71'30"00"
1.50'

P.C. 0+101.60
0+00

PHASE 3 DEMOLITION
AND REPAIR. SEE
SHEET S-E-500

(E) ASPHALT RAMP

(E) PAVEMENT SLAB TO
BE REMOVED. SEE
SHEET S-D-500 FOR
PHASING

CONTRACTOR TO SURVEY CURB FOR SPALLS
ADJACENT TO ROADWAY RECEIVING REPAIRS
AND SUBMIT REPAIR PLAN TO DOT-A FOR
APPROVAL. REPAIR SPALLS PER DETAIL

5
S-200

KEEP
OUT
RESTRICTED
AREA

CAUTION
CLEARANCE
11' - 6'

1+00

P.T. 0+80.61

2
S-500

3
S-500
SIM


MATCH LINE D2-A

1
S-D-201

ENLARGED DH LEVEL 2 DEMOLITION PLAN A

SCALE: 3/16" = 1'-0"


0' 2' 4' 8' 12' 16'
3/16" = 1'-0"

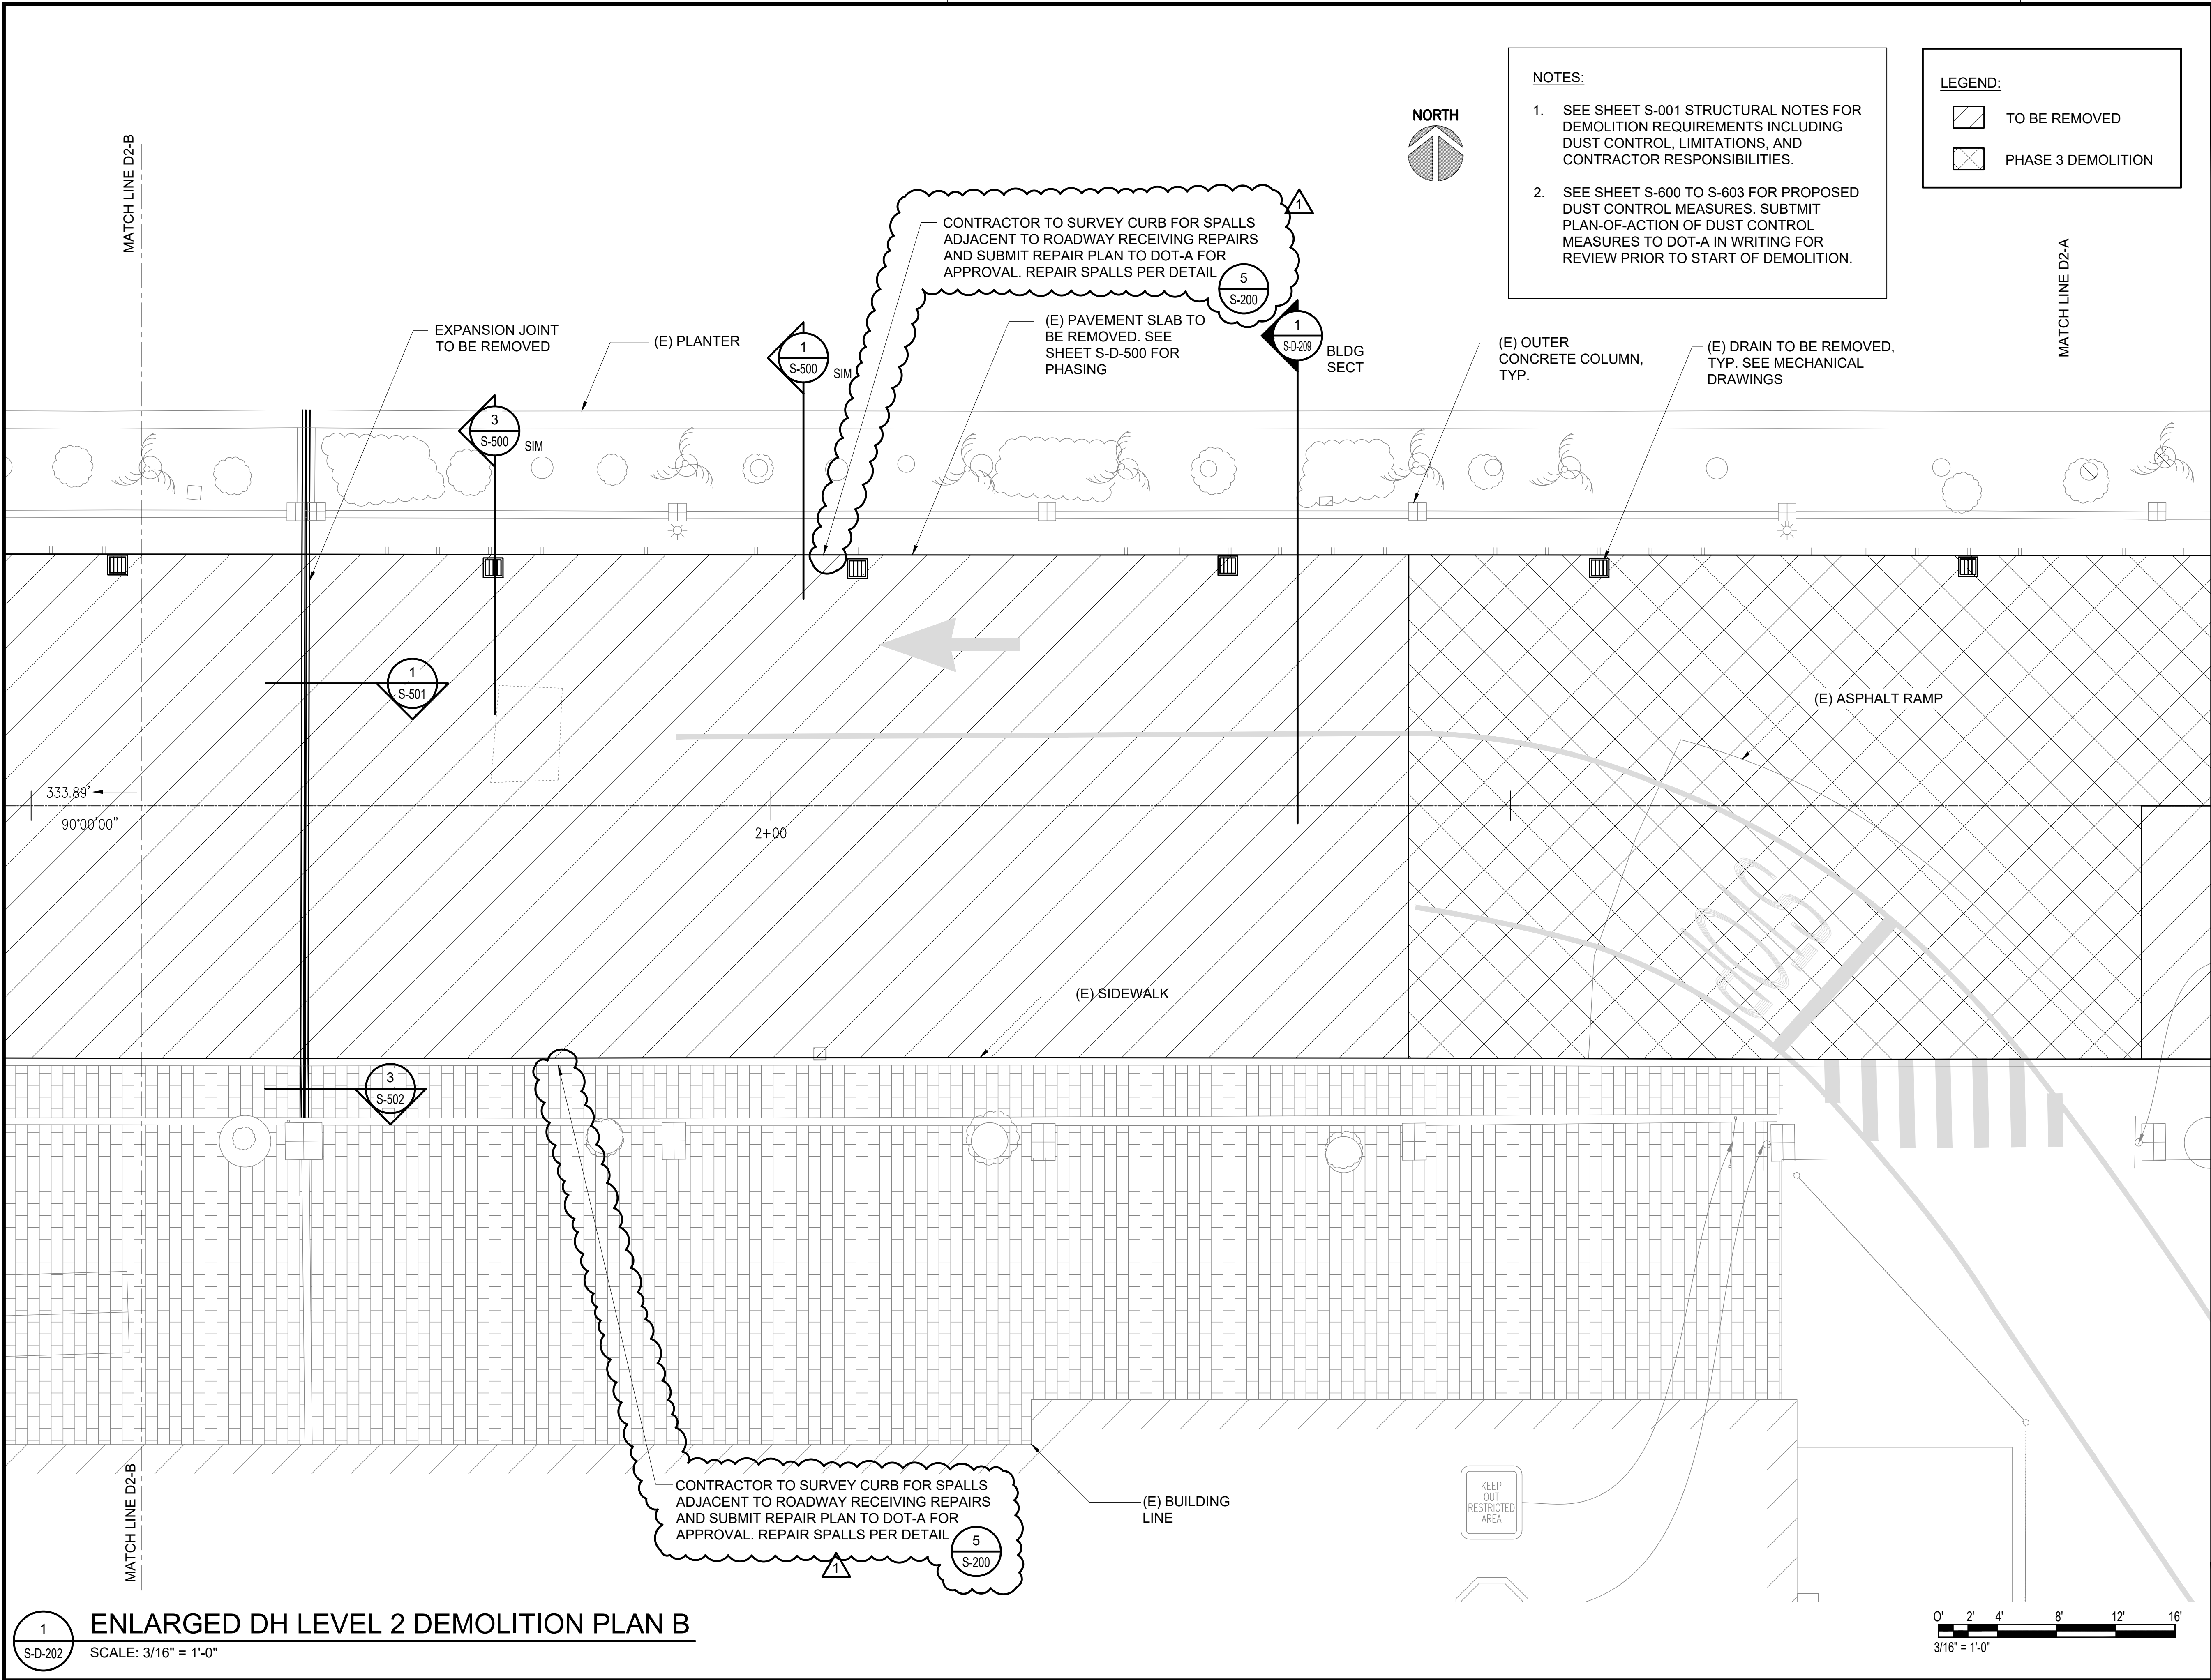


- NOTES:
- SEE SHEET S-001 STRUCTURAL NOTES FOR DEMOLITION REQUIREMENTS INCLUDING DUST CONTROL, LIMITATIONS, AND CONTRACTOR RESPONSIBILITIES.
 - SEE SHEET S-600 TO S-603 FOR PROPOSED DUST CONTROL MEASURES. SUBMIT PLAN-OF-ACTION OF DUST CONTROL MEASURES TO DOT-A IN WRITING FOR REVIEW PRIOR TO START OF DEMOLITION.

LEGEND:

- [Hatched Box] TO BE REMOVED
- [Cross-hatched Box] PHASE 3 DEMOLITION

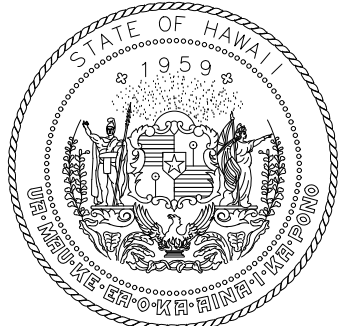

Airports Division
DEPARTMENT OF TRANSPORTATION
STATE OF HAWAII

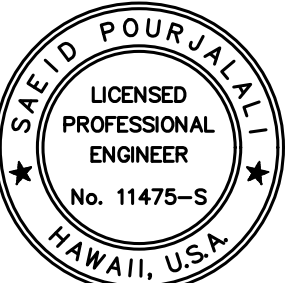


Saad Pourjafari
04/30/2024
Licensed Expiration Date

This work was prepared by me or under my supervision

DSGN.	DRWN.	CHKD.	APPD.
MG	MG	SP	

KEY PLAN / NOTES:

2ND LEVEL DH ROADWAY

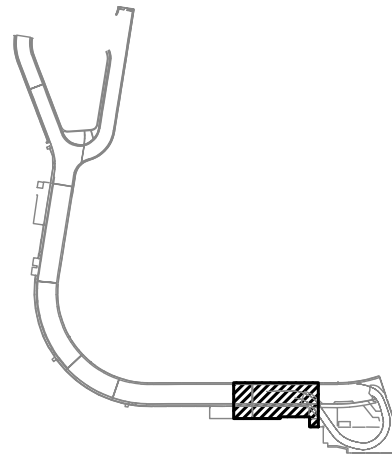

NO.	DATE	REVISIONS
1	10/20/22	ADDENDUM 1

CONSTRUCTION DOCUMENTS

SEPTEMBER, 2022
DATE

PROJECT TITLE :

EWA AND DH CONCOURSE
ROADWAY IMPROVEMENTS
PHASE 1

AT
DANIEL K. INOUE INTERNATIONAL AIRPORT
HONOLULU, OAHU, HAWAII

PROJECT NO.:

AO1043-32

SHEET TITLE:


DIAMOND HEAD
WING - SECOND
FLOOR PARTIAL
DEMOLITION PLAN B


DATE :
SEPTEMBER, 2022
SHEET :

DWG. NO.

S-D-202

97 OF 247 SHEETS

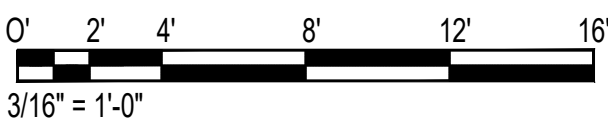


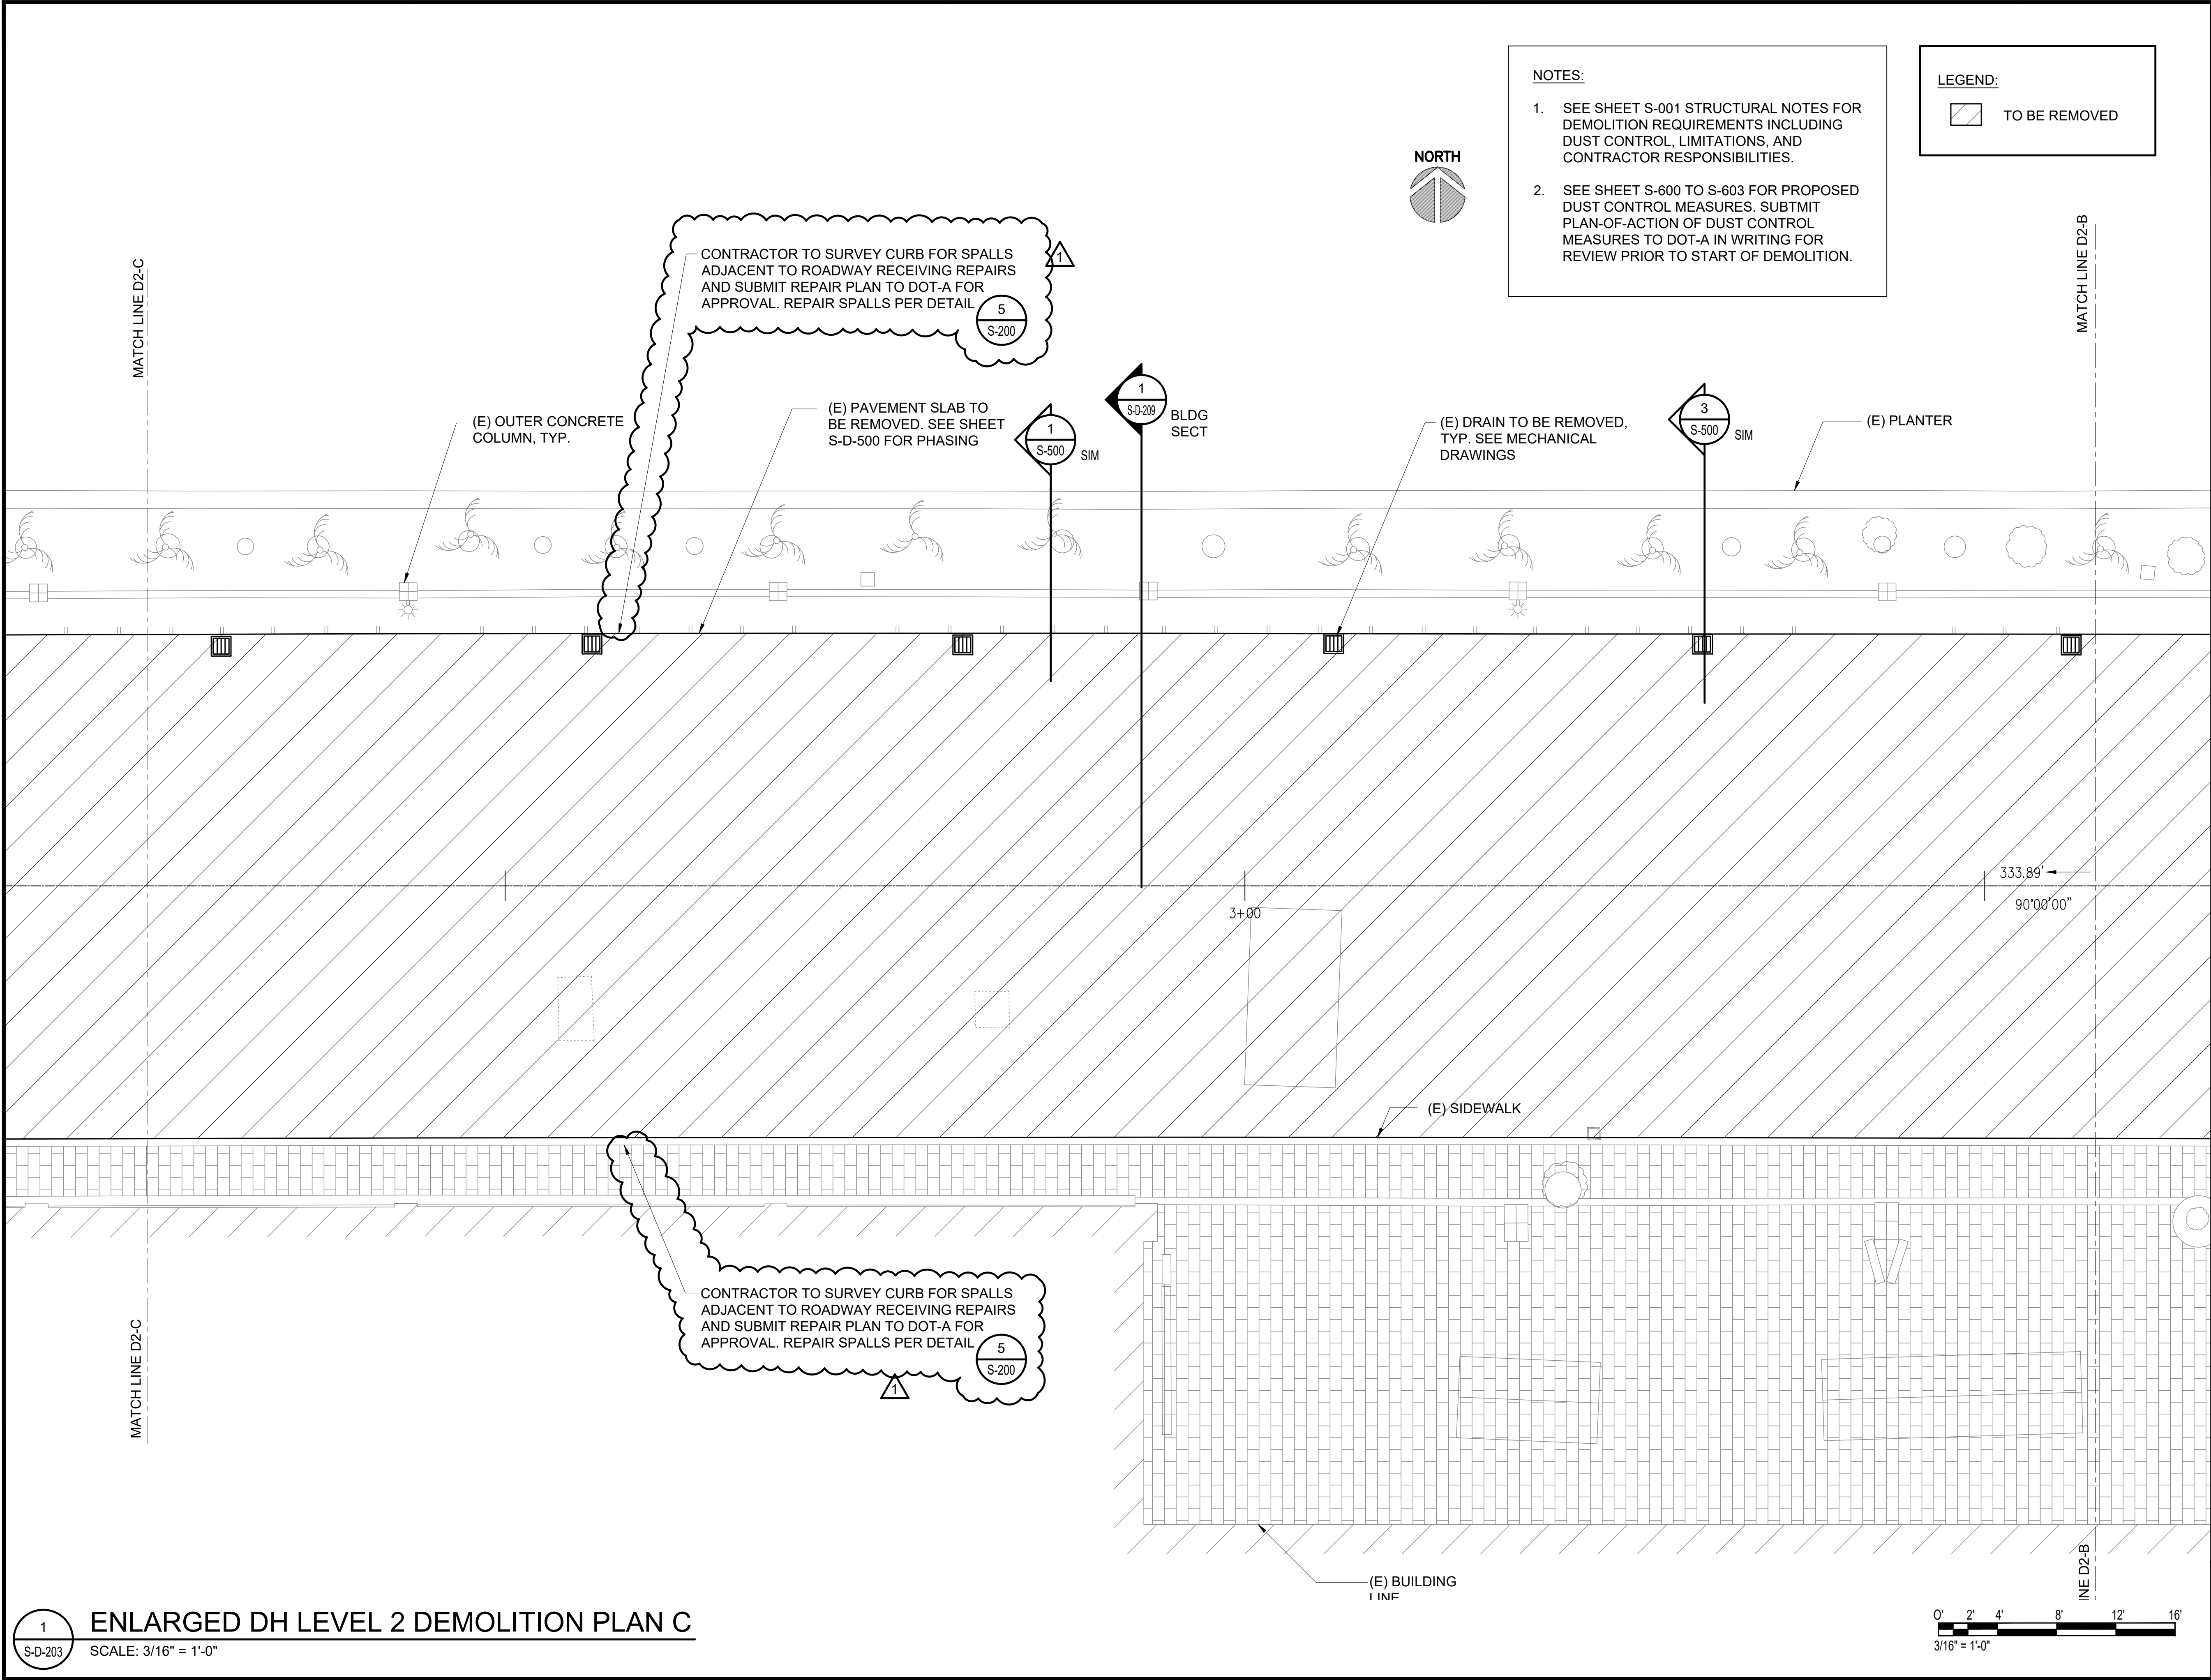


- NOTES:
- SEE SHEET S-001 STRUCTURAL NOTES FOR DEMOLITION REQUIREMENTS INCLUDING DUST CONTROL, LIMITATIONS, AND CONTRACTOR RESPONSIBILITIES.
 - SEE SHEET S-600 TO S-603 FOR PROPOSED DUST CONTROL MEASURES. SUBMIT PLAN-OF-ACTION OF DUST CONTROL MEASURES TO DOT-A IN WRITING FOR REVIEW PRIOR TO START OF DEMOLITION.

LEGEND:

TO BE REMOVED

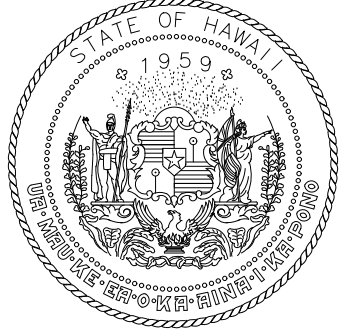

Airports Division
DEPARTMENT OF TRANSPORTATION
STATE OF HAWAII

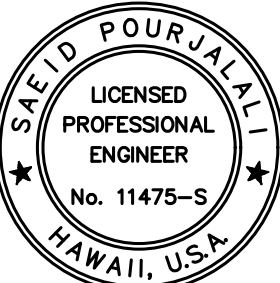


Saad Pourjalebi
04/30/2024
Licensed Expiration Date

This work was prepared by me or under my supervision

DSGN.	DRWN.	CHKD.	APPD.
MG	MG	SP	

KEY PLAN / NOTES:

2ND LEVEL DH ROADWAY

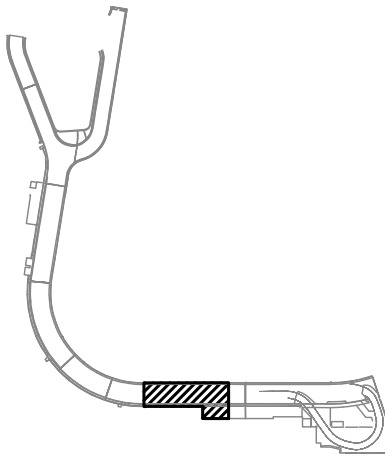

NO.	DATE	REVISIONS
1	10/20/22	ADDENDUM 1

CONSTRUCTION DOCUMENTS

SEPTEMBER, 2022
DATE

PROJECT TITLE :

EWA AND DH CONCOURSE
ROADWAY IMPROVEMENTS
PHASE 1

AT
DANIEL K. INOUE INTERNATIONAL AIRPORT
HONOLULU, OAHU, HAWAII

PROJECT NO.:

AO1043-32

SHEET TITLE:


DIAMOND HEAD
WING - SECOND
FLOOR PARTIAL
DEMOLITION PLAN C


DATE :
SEPTEMBER, 2022
SHEET :

DWG. NO.

S-D-203

98 OF 247 SHEETS

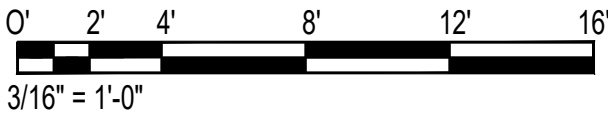

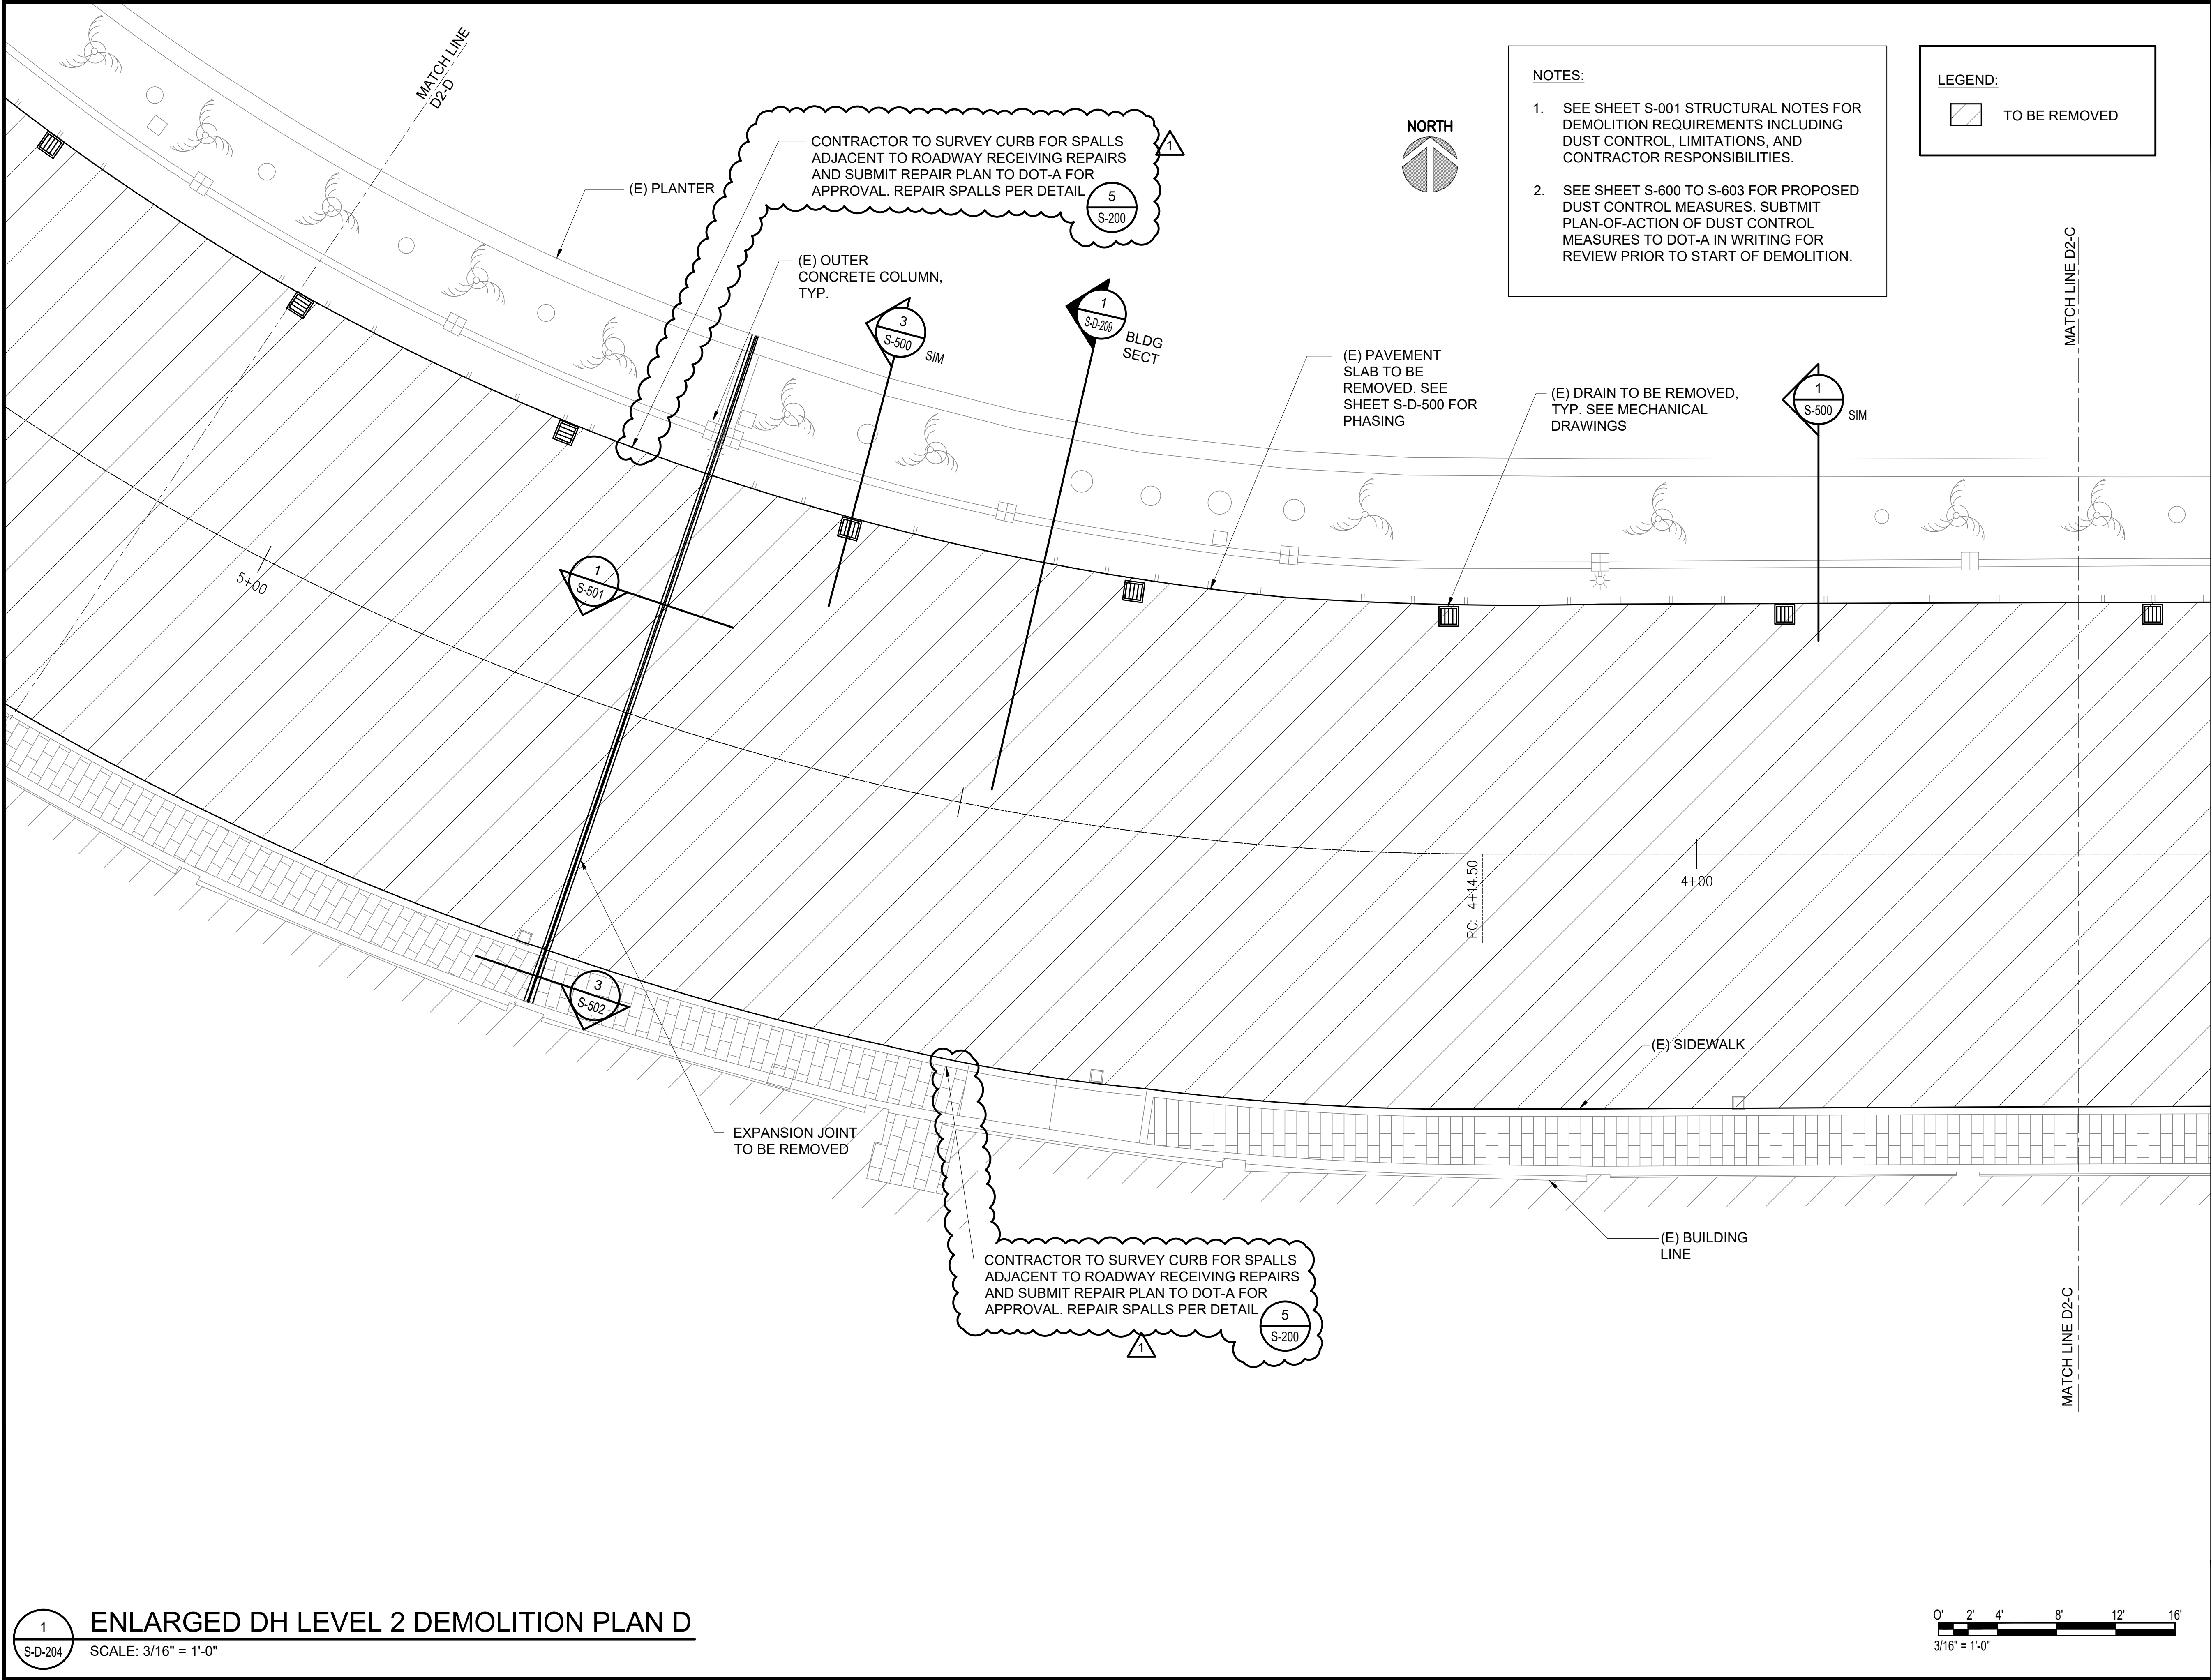


- NOTES:**
- SEE SHEET S-001 STRUCTURAL NOTES FOR DEMOLITION REQUIREMENTS INCLUDING DUST CONTROL, LIMITATIONS, AND CONTRACTOR RESPONSIBILITIES.
 - SEE SHEET S-600 TO S-603 FOR PROPOSED DUST CONTROL MEASURES. SUBMIT PLAN-OF-ACTION OF DUST CONTROL MEASURES TO DOT-A IN WRITING FOR REVIEW PRIOR TO START OF DEMOLITION.

LEGEND:


 TO BE REMOVED



MATCH LINE D2-C

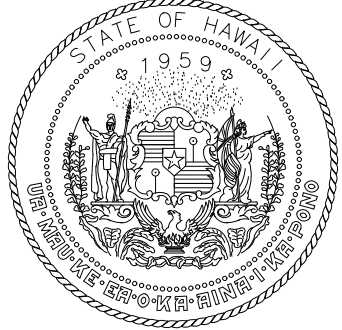

Airports Division
DEPARTMENT OF TRANSPORTATION
STATE OF HAWAII

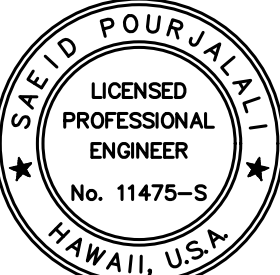


Saad Pourjafari
04/30/2024
Licensed Expiration Date

This work was prepared by me or under my supervision

DSGN.	DRWN.	CHKD.	APPD.
MG	MG	SP	

KEY PLAN / NOTES:

2ND LEVEL DH ROADWAY

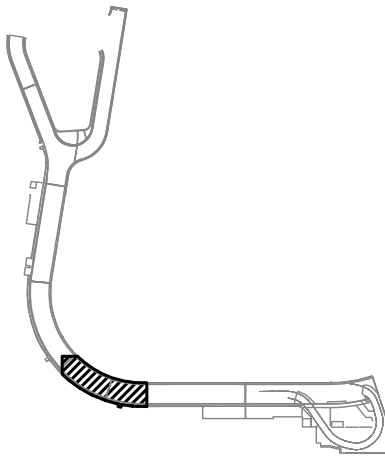

NO.	DATE	REVISIONS
1	10/20/22	ADDENDUM 1

CONSTRUCTION DOCUMENTS

SEPTEMBER, 2022
DATE

PROJECT TITLE :

**EWA AND DH CONCOURSE
ROADWAY IMPROVEMENTS
PHASE 1**

AT
DANIEL K. INOUE INTERNATIONAL AIRPORT
HONOLULU, OAHU, HAWAII

PROJECT NO.:

AO1043-32

SHEET TITLE:


**DIAMOND HEAD
WING - SECOND
FLOOR PARTIAL
DEMOLITION PLAN D**

DATE :
SEPTEMBER, 2022
SHEET :

DWG. NO.

S-D-204

99 OF 247 SHEETS

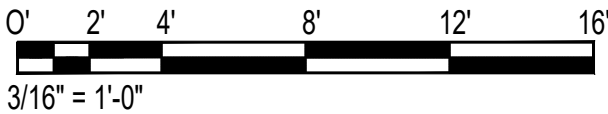

MATCH LINE D2-E

MATCH LINE D2-E

NORTH

LEGEND:

TO BE REMOVED

(E) DRAIN TO BE REMOVED,
TYP. SEE MECHANICAL
DRAWINGS

(E) DRAIN TO BE REMOVED,
TYP. SEE MECHANICAL
DRAWINGS

(E) PLANTER

(E) PAVEMENT SLAB TO BE
REMOVED. SEE SHEET
S-D-500 FOR PHASING

CONTRACTOR TO SURVEY CURB FOR SPALLS
ADJACENT TO ROADWAY RECEIVING REPAIRS
AND SUBMIT REPAIR PLAN TO DOT-A FOR
APPROVAL. REPAIR SPALLS PER DETAIL

(E) OUTER
CONCRETE COLUMN,
TYP.

G2/G3
WIKI AOA
SHUTTLE STOP

EXPANSION JOINT
TO BE REMOVED


(E) SIDEWALK

(E) BUILDING
LINE


CONTRACTOR TO SURVEY CURB FOR SPALLS—
ADJACENT TO ROADWAY RECEIVING REPAIRS
AND SUBMIT REPAIR PLAN TO DOT-A FOR
APPROVAL. REPAIR SPALLS PER DETAIL

NOTES:

- SEE SHEET S-001 STRUCTURAL NOTES FOR
DEMOLITION REQUIREMENTS INCLUDING
DUST CONTROL, LIMITATIONS, AND
CONTRACTOR RESPONSIBILITIES.
- SEE SHEET S-600 TO S-603 FOR PROPOSED
DUST CONTROL MEASURES. SUBMIT
PLAN-OF-ACTION OF DUST CONTROL
MEASURES TO DOT-A IN WRITING FOR
REVIEW PRIOR TO START OF DEMOLITION.

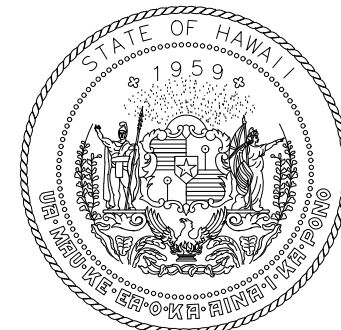

Airports Division
DEPARTMENT OF TRANSPORTATION
STATE OF HAWAII

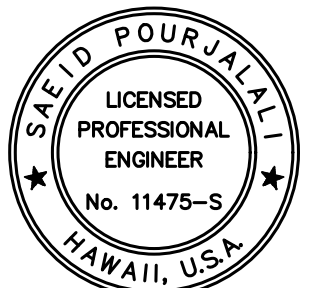


Saad Pourjafari
04/30/2024
Licensed Expiration Date

This work was prepared by me or under my supervision

DSGN.	DRWN.	CHKD.	APPD.
MG	MG	SP	

KEY PLAN / NOTES:

2ND LEVEL DH ROADWAY

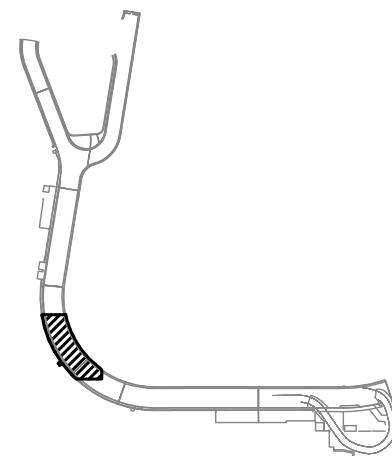

NO.	DATE	REVISIONS
1	10/20/22	ADDENDUM 1

CONSTRUCTION DOCUMENTS

SEPTEMBER, 2022
DATE

PROJECT TITLE :

**EWA AND DH CONCOURSE
ROADWAY IMPROVEMENTS
PHASE 1**

AT
DANIEL K. INOUE INTERNATIONAL AIRPORT
HONOLULU, OAHU, HAWAII

PROJECT NO.:

AO1043-32

SHEET TITLE:


**DIAMOND HEAD
WING - SECOND
FLOOR PARTIAL
DEMOLITION PLAN E**

DATE :
SEPTEMBER, 2022
SHEET :

DWG. NO.


S-D-205

100 OF 247 SHEETS

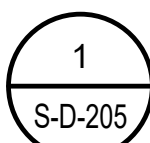

ENLARGED DH LEVEL 2 DEMOLITION PLAN E

SCALE: 3/16" = 1'-0"

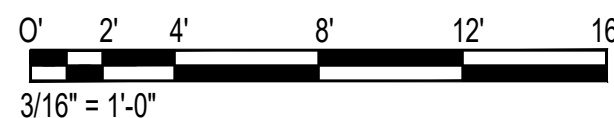

MATCH LINE D2-F

EXPANSION JOINT TO
BE REMOVED

MATCH LINE D2-F



LEGEND:
[Hatched box symbol] TO BE REMOVED

- NOTES:
- SEE SHEET S-001 STRUCTURAL NOTES FOR DEMOLITION REQUIREMENTS INCLUDING DUST CONTROL, LIMITATIONS, AND CONTRACTOR RESPONSIBILITIES.
 - SEE SHEET S-600 TO S-603 FOR PROPOSED DUST CONTROL MEASURES. SUBMIT PLAN-OF-ACTION OF DUST CONTROL MEASURES TO DOT-A IN WRITING FOR REVIEW PRIOR TO START OF DEMOLITION.

(E) DRAIN TO BE REMOVED,
TYP. SEE MECHANICAL
DRAWINGS

(E) DRAIN TO BE REMOVED,
TYP. SEE MECHANICAL
DRAWINGS

(E) OUTER CONCRETE
COLUMN, TYP.

(E) PLANTER

CONTRACTOR TO SURVEY CURB FOR SPALLS
ADJACENT TO ROADWAY RECEIVING REPAIRS
AND SUBMIT REPAIR PLAN TO DOT-A FOR
APPROVAL. REPAIR SPALLS PER DETAIL

(E) PAVEMENT SLAB TO BE
REMOVED. SEE SHEET
S-D-500 FOR PHASING


CONTRACTOR TO SURVEY CURB FOR SPALLS
ADJACENT TO ROADWAY RECEIVING REPAIRS
AND SUBMIT REPAIR PLAN TO DOT-A FOR
APPROVAL. REPAIR SPALLS PER DETAIL

(E) SIDEWALK


(E) BUILDING
LINE

MATCH LINE D2-E

MATCH LINE D2-E

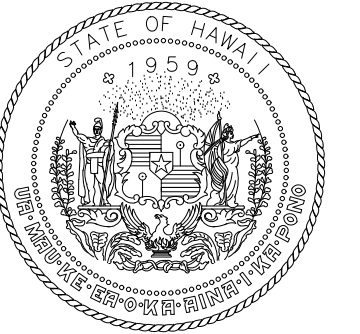

Airports Division
DEPARTMENT OF TRANSPORTATION
STATE OF HAWAII

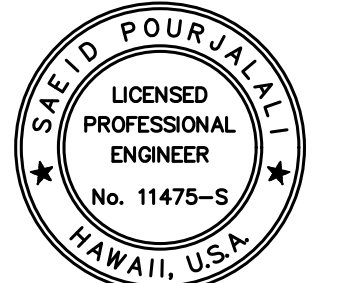

Saif Pourjafari
04/30/2024


Licensed Expiration Date

This work was prepared by me or under my supervision

DSGN.	DRWN.	CHKD.	APPD.
MG	MG	SP	

KEY PLAN / NOTES:

2ND LEVEL DH ROADWAY

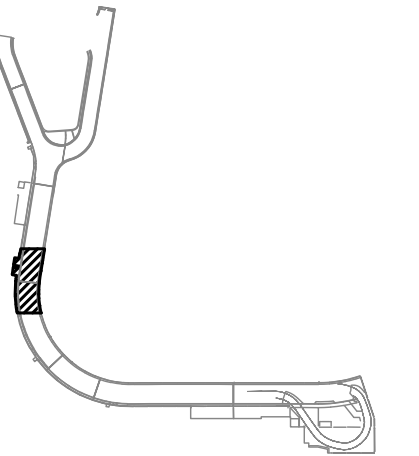

NO.	DATE	REVISIONS
1	10/20/22	ADDENDUM 1

CONSTRUCTION DOCUMENTS

SEPTEMBER, 2022
DATE

PROJECT TITLE :

**EWA AND DH CONCOURSE
ROADWAY IMPROVEMENTS
PHASE 1**

AT
DANIEL K. INOUE INTERNATIONAL AIRPORT
HONOLULU, OAHU, HAWAII

PROJECT NO.:

AO1043-32

SHEET TITLE:

**DIAMOND HEAD
WING - SECOND
FLOOR PARTIAL
DEMOLITION PLAN F**

DATE :
SEPTEMBER, 2022
SHEET :

DWG. NO.

S-D-206

101 OF 247 SHEETS



MATCH LINE D2-G

MATCH LINE D2-G

LEGEND:

TO BE REMOVED

- NOTES:
- SEE SHEET S-001 STRUCTURAL NOTES FOR DEMOLITION REQUIREMENTS INCLUDING DUST CONTROL, LIMITATIONS, AND CONTRACTOR RESPONSIBILITIES.
 - SEE SHEET S-600 TO S-603 FOR PROPOSED DUST CONTROL MEASURES. SUBMIT PLAN-OF-ACTION OF DUST CONTROL MEASURES TO DOT-A IN WRITING FOR REVIEW PRIOR TO START OF DEMOLITION.

CONTRACTOR TO SURVEY CURB FOR SPALLS ADJACENT TO ROADWAY RECEIVING REPAIRS AND SUBMIT REPAIR PLAN TO DOT-A FOR APPROVAL. REPAIR SPALLS PER DETAIL 5 S-200



(E) DRAIN TO BE REMOVED, TYP. SEE MECHANICAL DRAWINGS

(E) DRAIN TO BE REMOVED, TYP. SEE MECHANICAL DRAWINGS

(E) PLANTER

(E) OUTER CONCRETE COLUMN, TYP.

(E) PAVEMENT SLAB TO BE REMOVED. SEE SHEET S-D-500 FOR PHASING

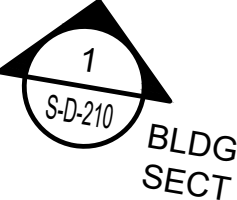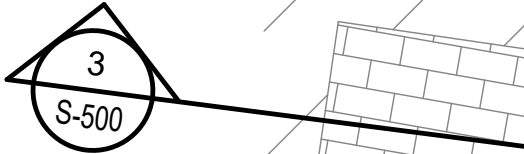

(E) BUILDING LINE

PT. 7+25.52



MATCH LINE D2-F

MATCH LINE D2-F


EXPANSION JOINT TO BE REMOVED



ENLARGED DH LEVEL 2 DEMOLITION PLAN G
SCALE: 3/16" = 1'-0"

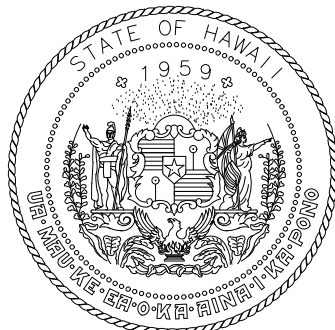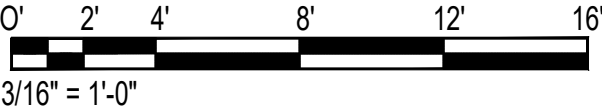

Airports Division
DEPARTMENT OF TRANSPORTATION
STATE OF HAWAII

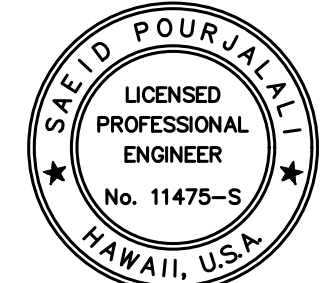


Saad Pourjafari
04/30/2024
Licensed Expiration Date

This work was prepared by me or under my supervision

DSGN.	DRWN.	CHKD.	APPD.
MG	MG	SP	

KEY PLAN / NOTES:

2ND LEVEL DH ROADWAY

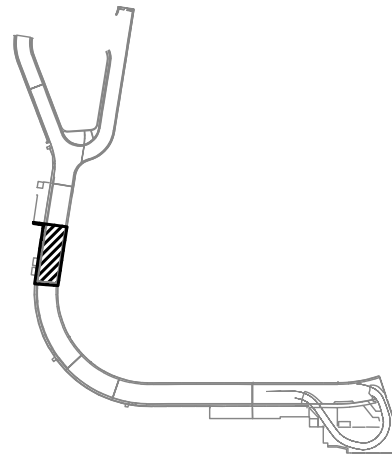

NO.	DATE	REVISIONS
	10/20/22	ADDENDUM 1

CONSTRUCTION DOCUMENTS

SEPTEMBER, 2022
DATE

PROJECT TITLE :

EWA AND DH CONCOURSE
ROADWAY IMPROVEMENTS
PHASE 1

AT
DANIEL K. INOUE INTERNATIONAL AIRPORT
HONOLULU, OAHU, HAWAII

PROJECT NO.:

AO1043-32

SHEET TITLE:

DIAMOND HEAD
WING - SECOND
FLOOR PARTIAL
DEMOLITION PLAN G

DATE :
SEPTEMBER, 2022
SHEET :

DWG. NO.

S-D-207

102 OF 247 SHEETS



EXPANSION JOINT TO BE REMOVED

(E) DRAIN TO BE REMOVED, TYP. SEE MECHANICAL DRAWINGS

CONTRACTOR TO SURVEY CURB FOR SPALLS ADJACENT TO ROADWAY RECEIVING REPAIRS AND SUBMIT REPAIR PLAN TO DOT-A FOR APPROVAL. REPAIR SPALLS PER DETAIL

(E) BUILDING LINE

(E) SIDEWALK

LIMIT OF SCOPE

(E) DRAIN TO BE REMOVED, TYP. SEE MECHANICAL DRAWINGS

(E) PLANTER

CONTRACTOR TO SURVEY CURB FOR SPALLS ADJACENT TO ROADWAY RECEIVING REPAIRS AND SUBMIT REPAIR PLAN TO DOT-A FOR APPROVAL. REPAIR SPALLS PER DETAIL

(E) OUTER CONCRETE COLUMN, TYP.

(E) PAVEMENT SLAB TO BE REMOVED. SEE SHEET S-D-500 FOR PHASING

NOTES:

- SEE SHEET S-001 STRUCTURAL NOTES FOR DEMOLITION REQUIREMENTS INCLUDING DUST CONTROL, LIMITATIONS, AND CONTRACTOR RESPONSIBILITIES.
- SEE SHEET S-600 TO S-603 FOR PROPOSED DUST CONTROL MEASURES. SUBMIT PLAN-OF-ACTION OF DUST CONTROL MEASURES TO DOT-A IN WRITING FOR REVIEW PRIOR TO START OF DEMOLITION.


MATCH LINE D2-G

MATCH LINE D2-G


KEEP OUT RESTRICTED AREA

LEGEND:

TO BE REMOVED

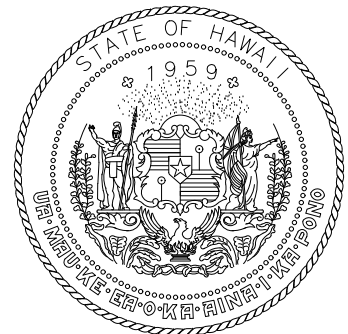

Airports Division
DEPARTMENT OF TRANSPORTATION
STATE OF HAWAII

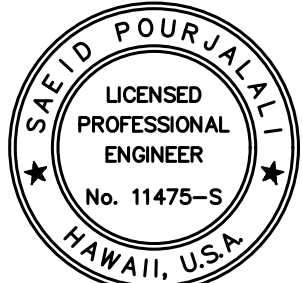


Sa'iah Pau'alahi
04/30/2024
Licensed Expiration Date

This work was prepared by me or under my supervision

DSGN.	DRWN.	CHKD.	APPD.
MG	MG	SP	

KEY PLAN / NOTES:

2ND LEVEL DH ROADWAY

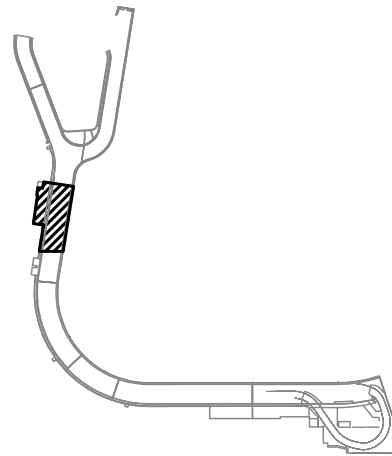

NO.	DATE	REVISIONS
1	10/20/22	ADDENDUM 1

CONSTRUCTION DOCUMENTS

SEPTEMBER, 2022
DATE

PROJECT TITLE :

EWA AND DH CONCOURSE
ROADWAY IMPROVEMENTS
PHASE 1

AT
DANIEL K. INOUE INTERNATIONAL AIRPORT
HONOLULU, OAHU, HAWAII

PROJECT NO.:

AO1043-32

SHEET TITLE:

DIAMOND HEAD
WING - SECOND
FLOOR PARTIAL
DEMOLITION PLAN H

DATE :
SEPTEMBER, 2022
SHEET :

DWG. NO.

S-D-208

103 OF 247 SHEETS

1
S-D-208

ENLARGED DH LEVEL 2 DEMOLITION PLAN H

SCALE: 3/16" = 1'-0"

0' 2' 4' 8' 12' 16'
3/16" = 1'-0"