



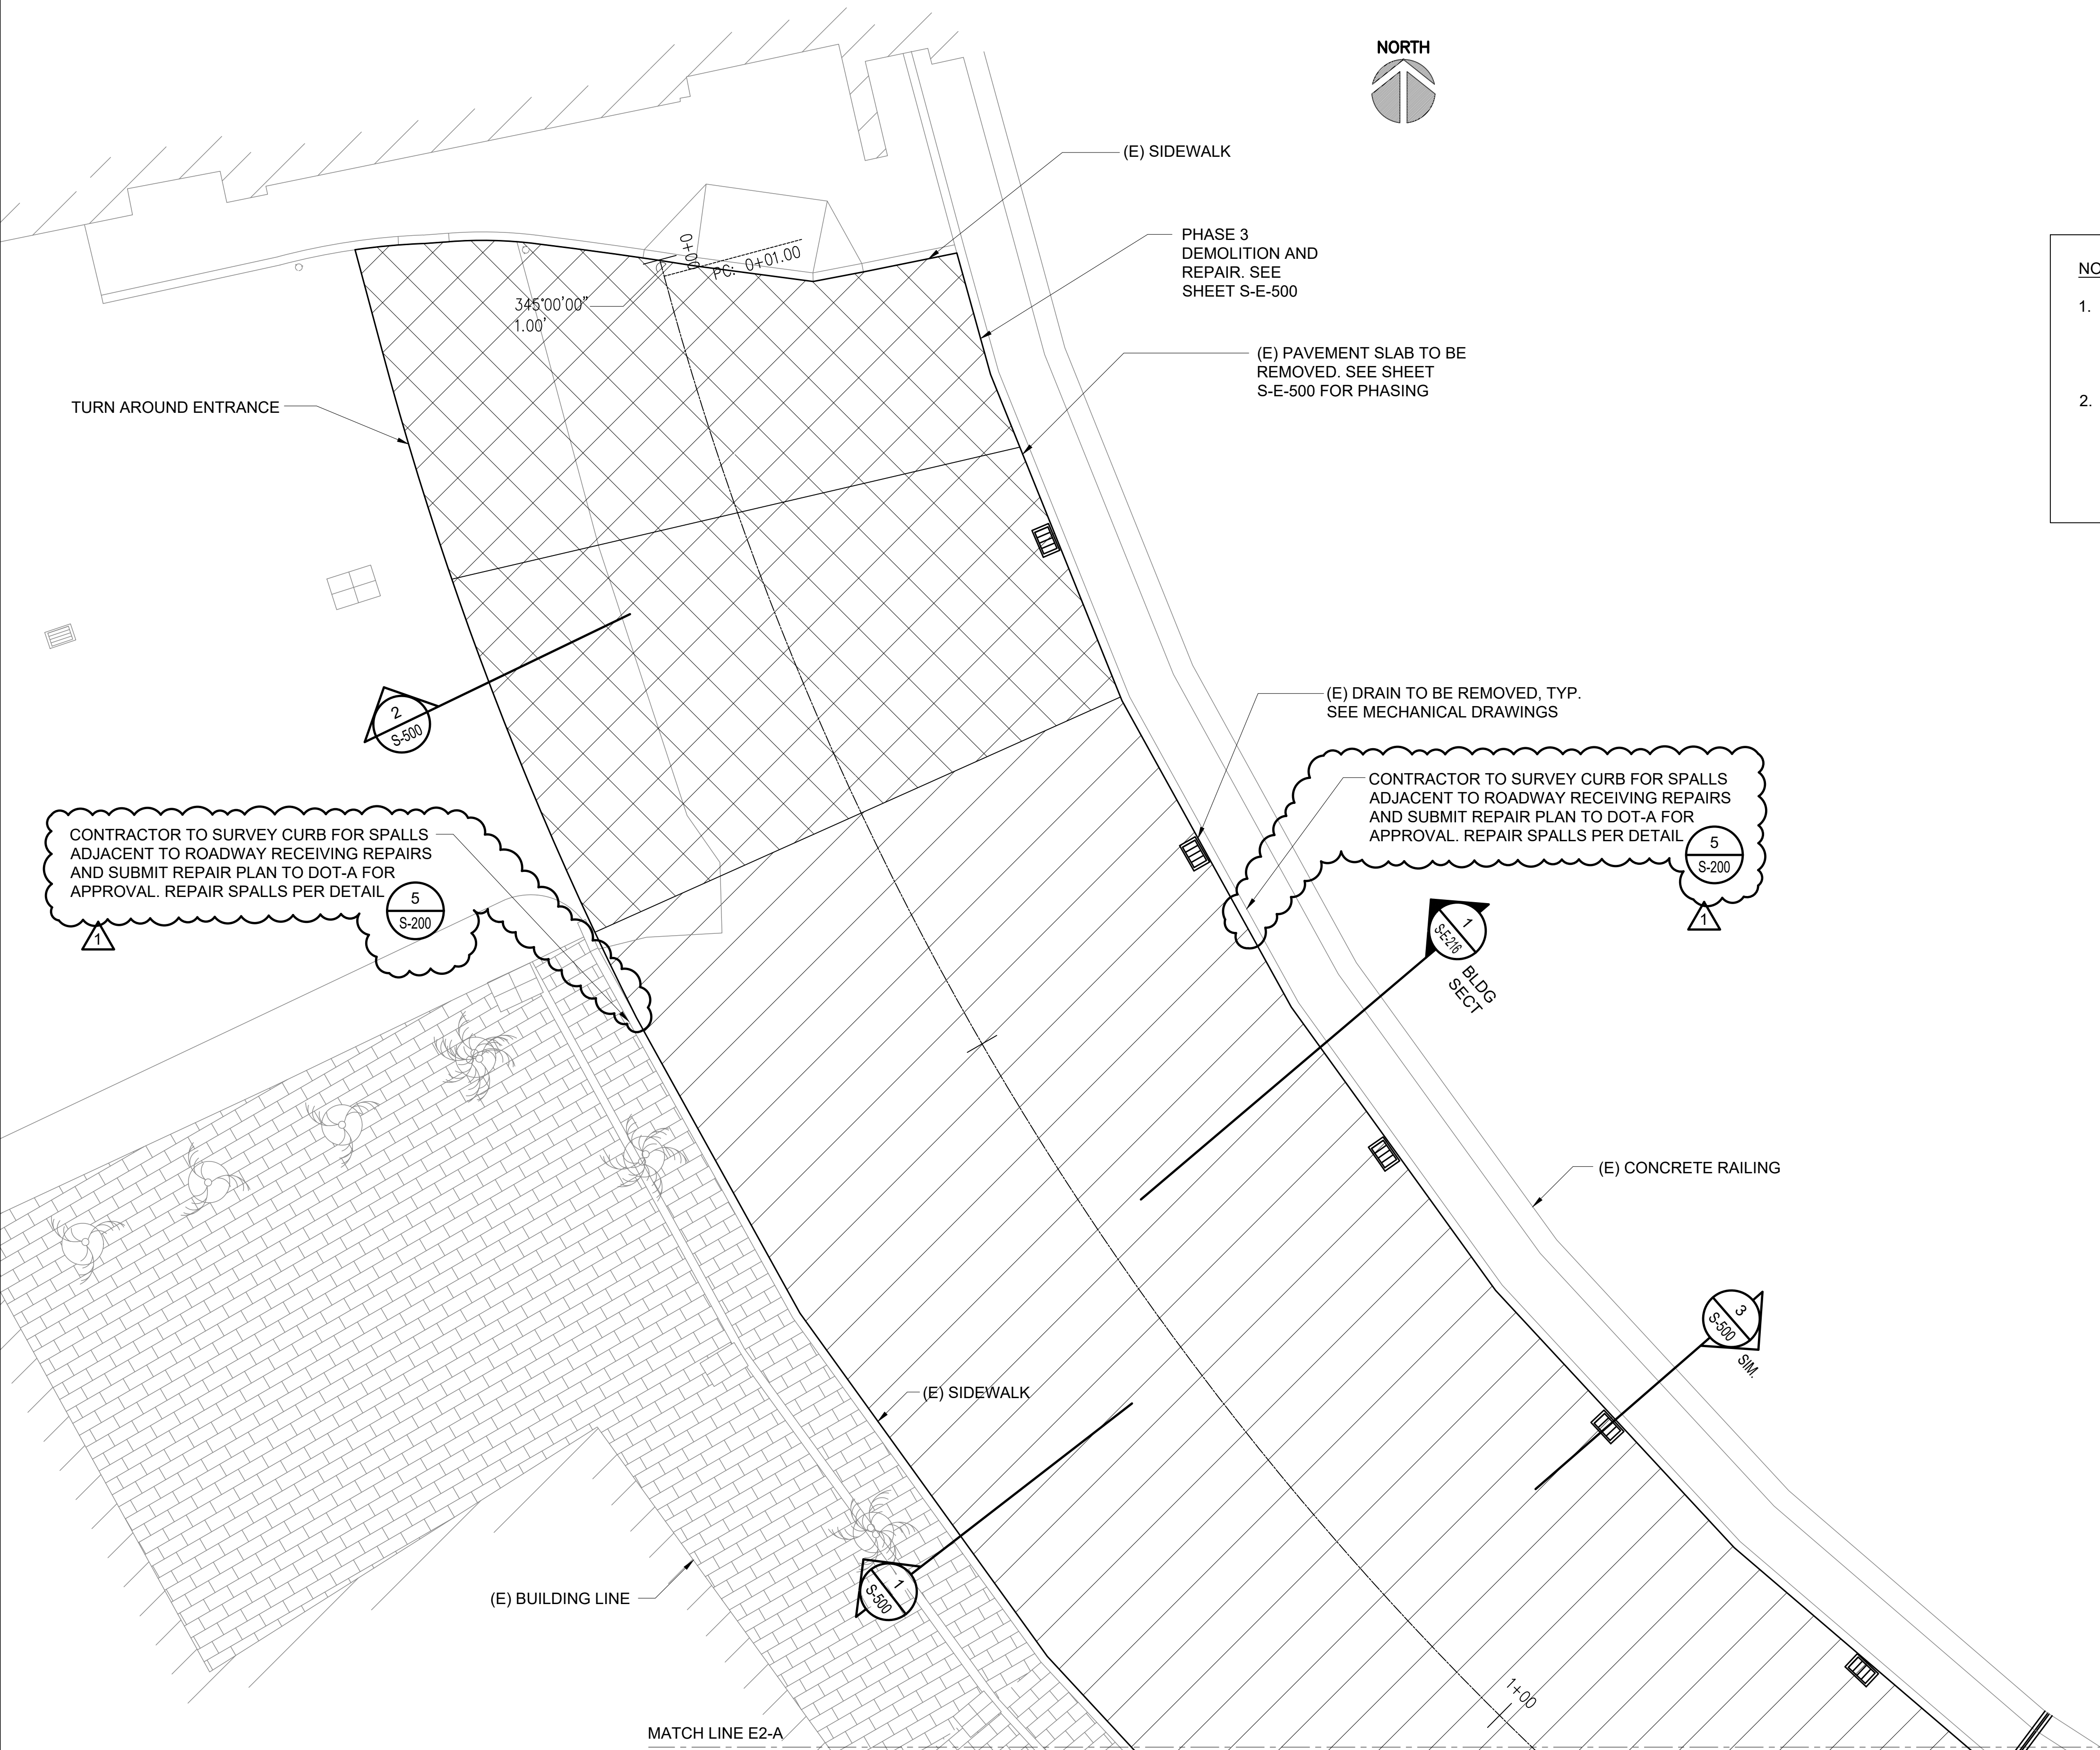


- LEGEND:
- DENOTES DEMOLITION AREA
 - DENOTES PHASE 3 DEMOLITION AREA

- NOTES:
- SEE SHEET S-001 STRUCTURAL NOTES FOR DEMOLITION REQUIREMENTS INCLUDING DUST CONTROL, LIMITATIONS, AND CONTRACTOR RESPONSIBILITIES.
 - SEE SHEET S-600 TO S-603 FOR PROPOSED DUST CONTROL MEASURES. SUBMIT PLAN-OF-ACTION OF DUST CONTROL MEASURES TO DOT-A IN WRITING FOR REVIEW PRIOR TO START OF DEMOLITION.

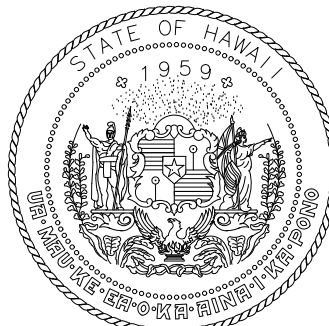

Airports Division
DEPARTMENT OF TRANSPORTATION
STATE OF HAWAII

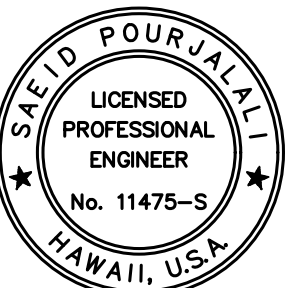


Saif Pourjalebi
04/30/2024
Licensed Expiration Date

This work was prepared by me or under my supervision

DSGN.	DRWN.	CHKD.	APPD.
MG	MG	SP	

KEY PLAN / NOTES:

2ND LEVEL EWA
ROADWAY

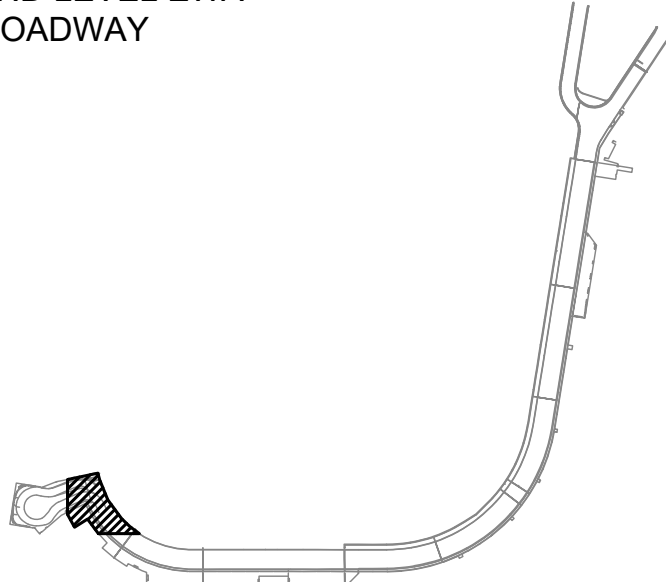

NO.	DATE	REVISIONS
1	10/20/22	ADDENDUM 1

CONSTRUCTION
DOCUMENTS

SEPTEMBER, 2022
DATE

PROJECT TITLE :

EWA AND DH CONCOURSE
ROADWAY IMPROVEMENTS
PHASE 1

AT
DANIEL K. INOUE INTERNATIONAL AIRPORT
HONOLULU, OAHU, HAWAII

PROJECT NO.:

AO1043-32

SHEET TITLE:

EWA WING - SECOND
FLOOR PARTIAL
DEMOLITION PLAN A

DATE :
SEPTEMBER, 2022
SHEET :

DWG. NO.


S-E-201


47 OF 247 SHEETS



ENLARGED EWA LEVEL 2 DEMOLITION PLAN A

SCALE: 3/16" = 1'-0"

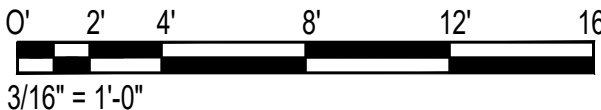

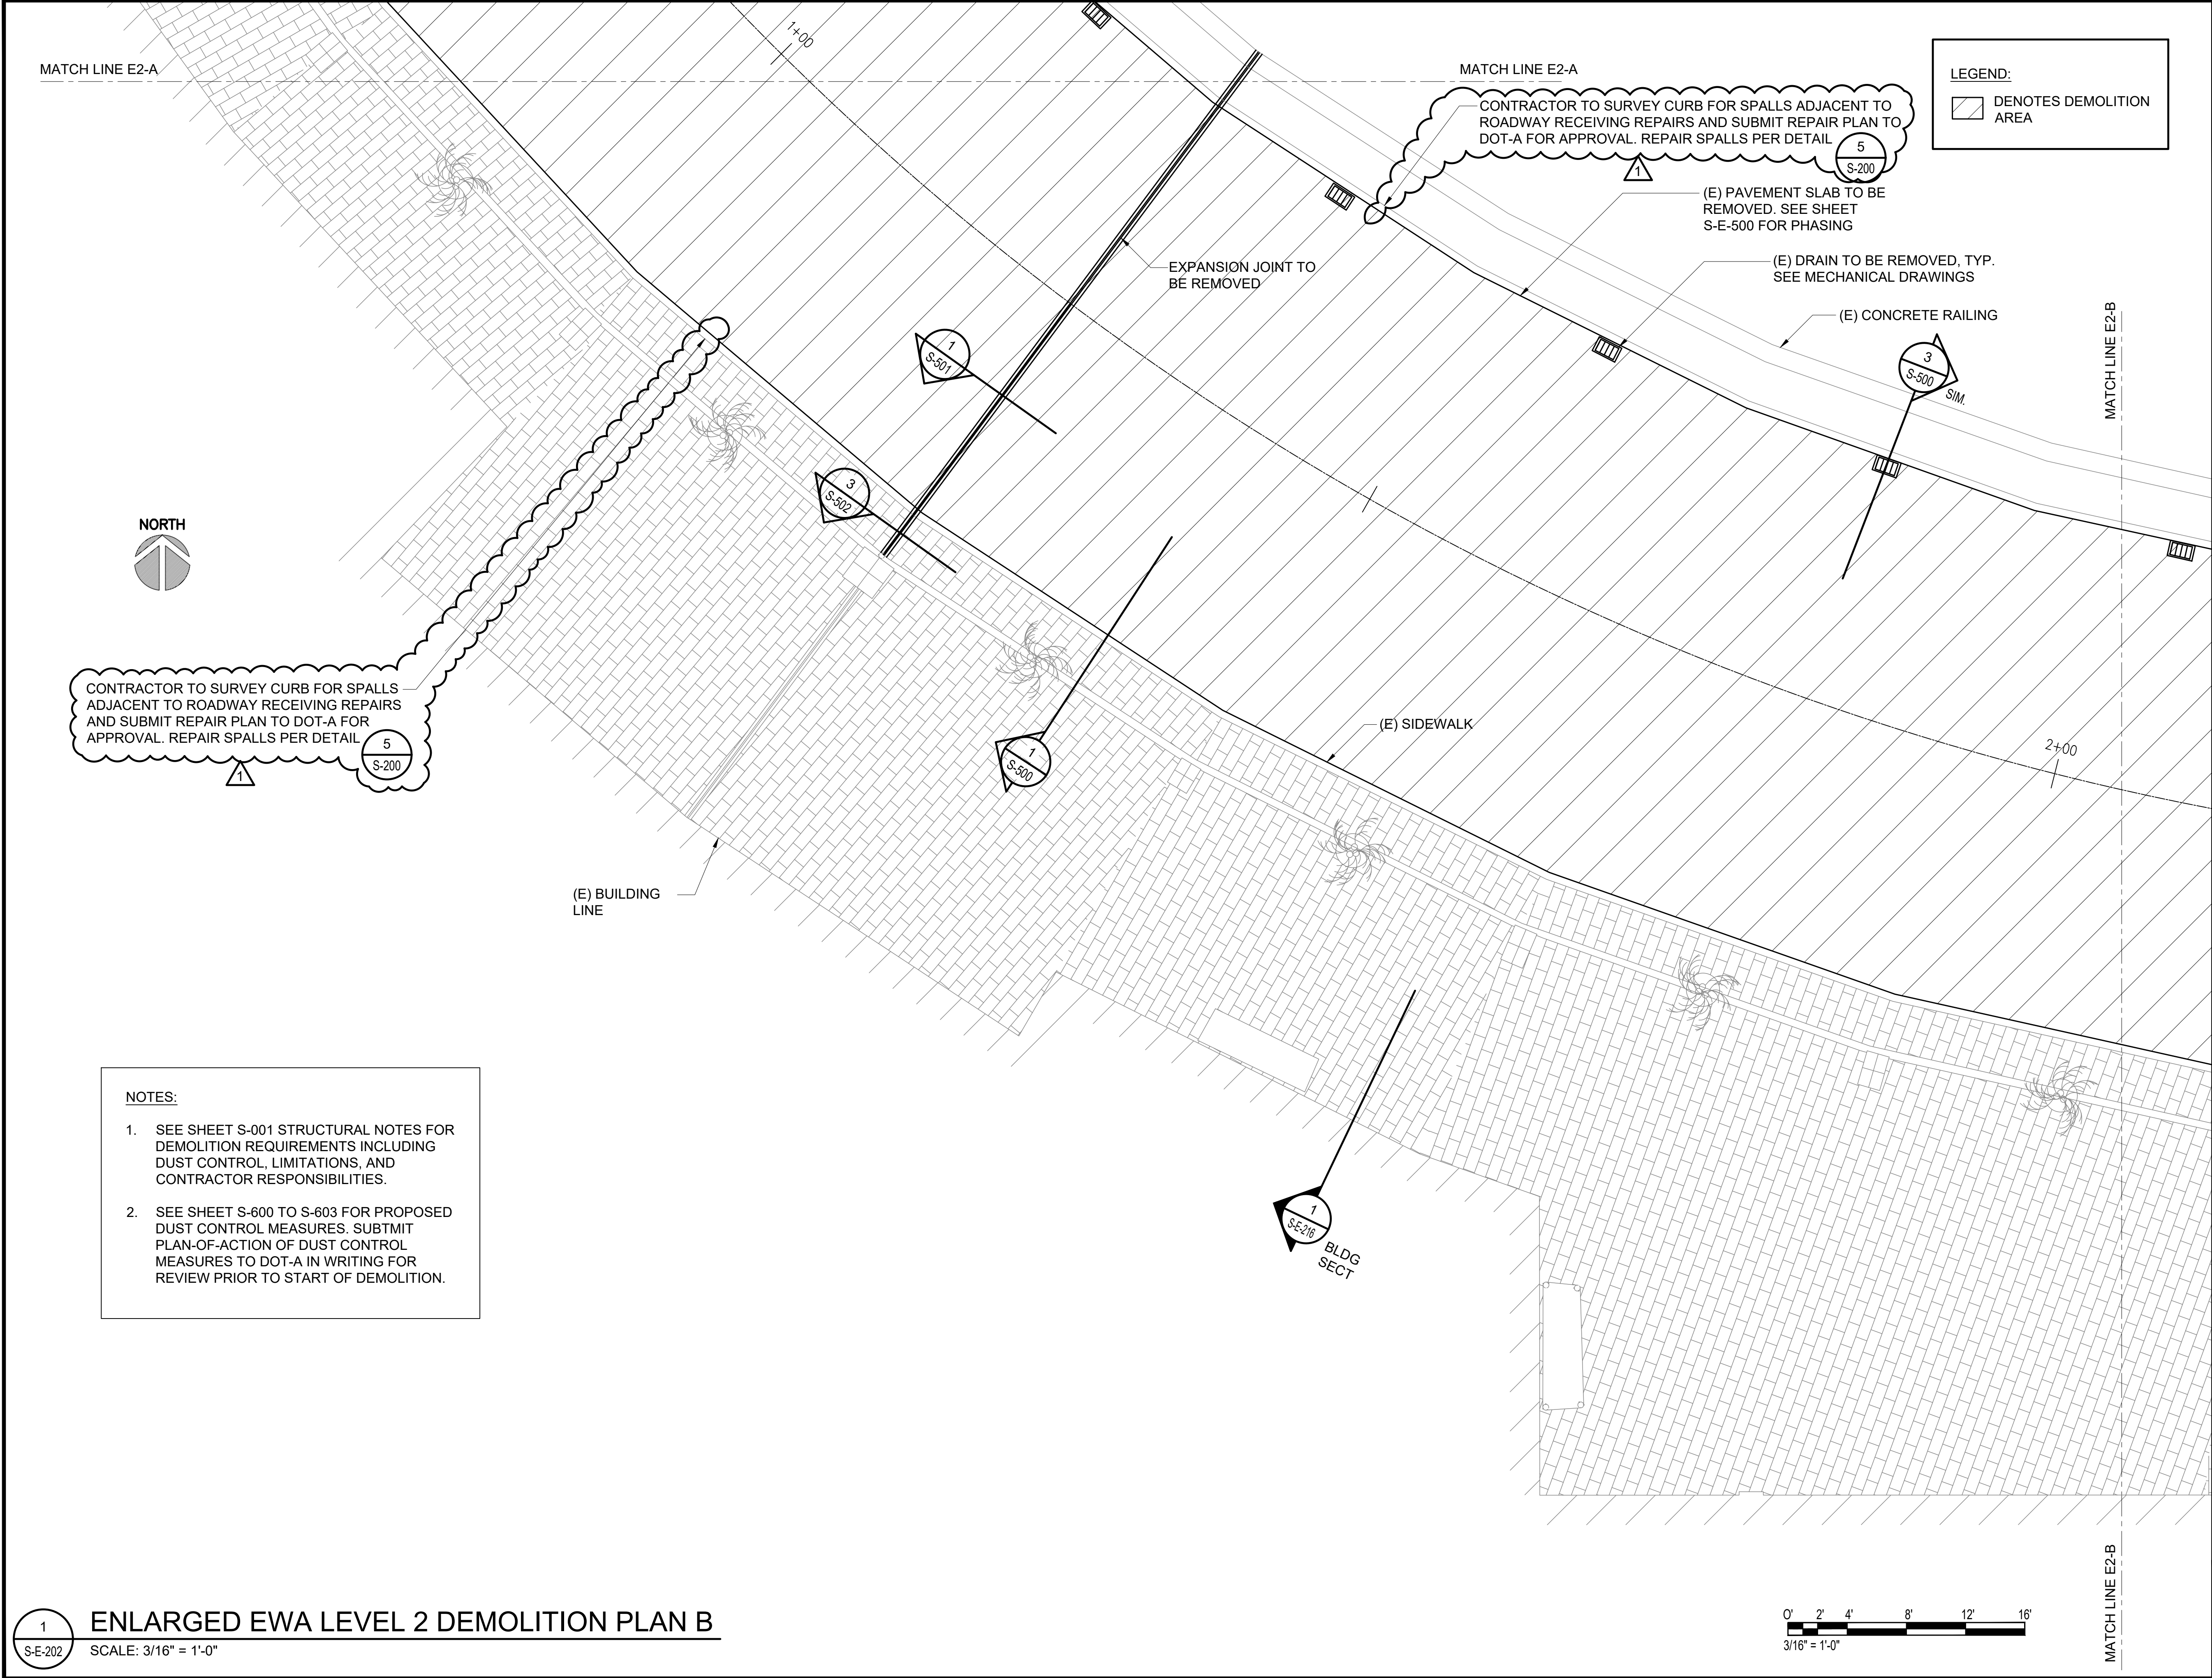


LEGEND:

DENOTES DEMOLITION AREA



CONTRACTOR TO SURVEY CURB FOR SPALLS ADJACENT TO ROADWAY RECEIVING REPAIRS AND SUBMIT REPAIR PLAN TO DOT-A FOR APPROVAL. REPAIR SPALLS PER DETAIL.

CONTRACTOR TO SURVEY CURB FOR SPALLS ADJACENT TO ROADWAY RECEIVING REPAIRS AND SUBMIT REPAIR PLAN TO DOT-A FOR APPROVAL. REPAIR SPALLS PER DETAIL.

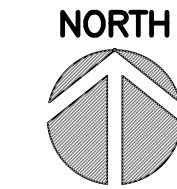


NOTES:

- SEE SHEET S-001 STRUCTURAL NOTES FOR DEMOLITION REQUIREMENTS INCLUDING DUST CONTROL, LIMITATIONS, AND CONTRACTOR RESPONSIBILITIES.
- SEE SHEET S-600 TO S-603 FOR PROPOSED DUST CONTROL MEASURES. SUBMIT PLAN-OF-ACTION OF DUST CONTROL MEASURES TO DOT-A IN WRITING FOR REVIEW PRIOR TO START OF DEMOLITION.

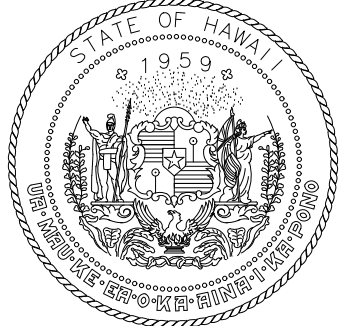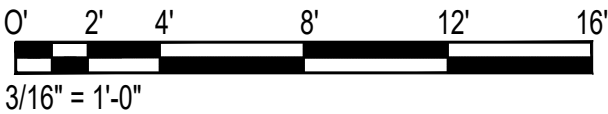

Airports Division
DEPARTMENT OF TRANSPORTATION
STATE OF HAWAII

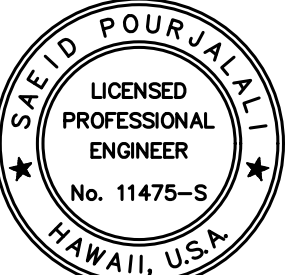


Saad Pourjafari
04/30/2024
Licensed Expiration Date

This work was prepared by me or under my supervision

DSGN.	DRWN.	CHKD.	APPD.
MG	MG	SP	

KEY PLAN / NOTES:

2ND LEVEL EWA
ROADWAY

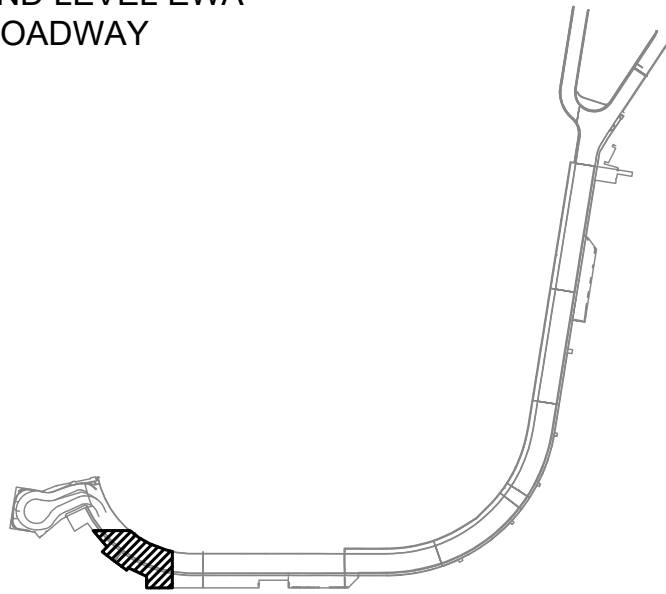

NO.	DATE	REVISIONS
1	10/20/22	ADDENDUM 1

CONSTRUCTION
DOCUMENTS

SEPTEMBER, 2022
DATE

PROJECT TITLE :

EWA AND DH CONCOURSE
ROADWAY IMPROVEMENTS
PHASE 1

AT
DANIEL K. INOUE INTERNATIONAL AIRPORT
HONOLULU, OAHU, HAWAII

PROJECT NO.:

A01043-32

SHEET TITLE:


EWA WING - SECOND
FLOOR PARTIAL
DEMOLITION PLAN B

DATE :
SEPTEMBER, 2022
SHEET :


DWG. NO.

S-E-202


48 OF 247 SHEETS

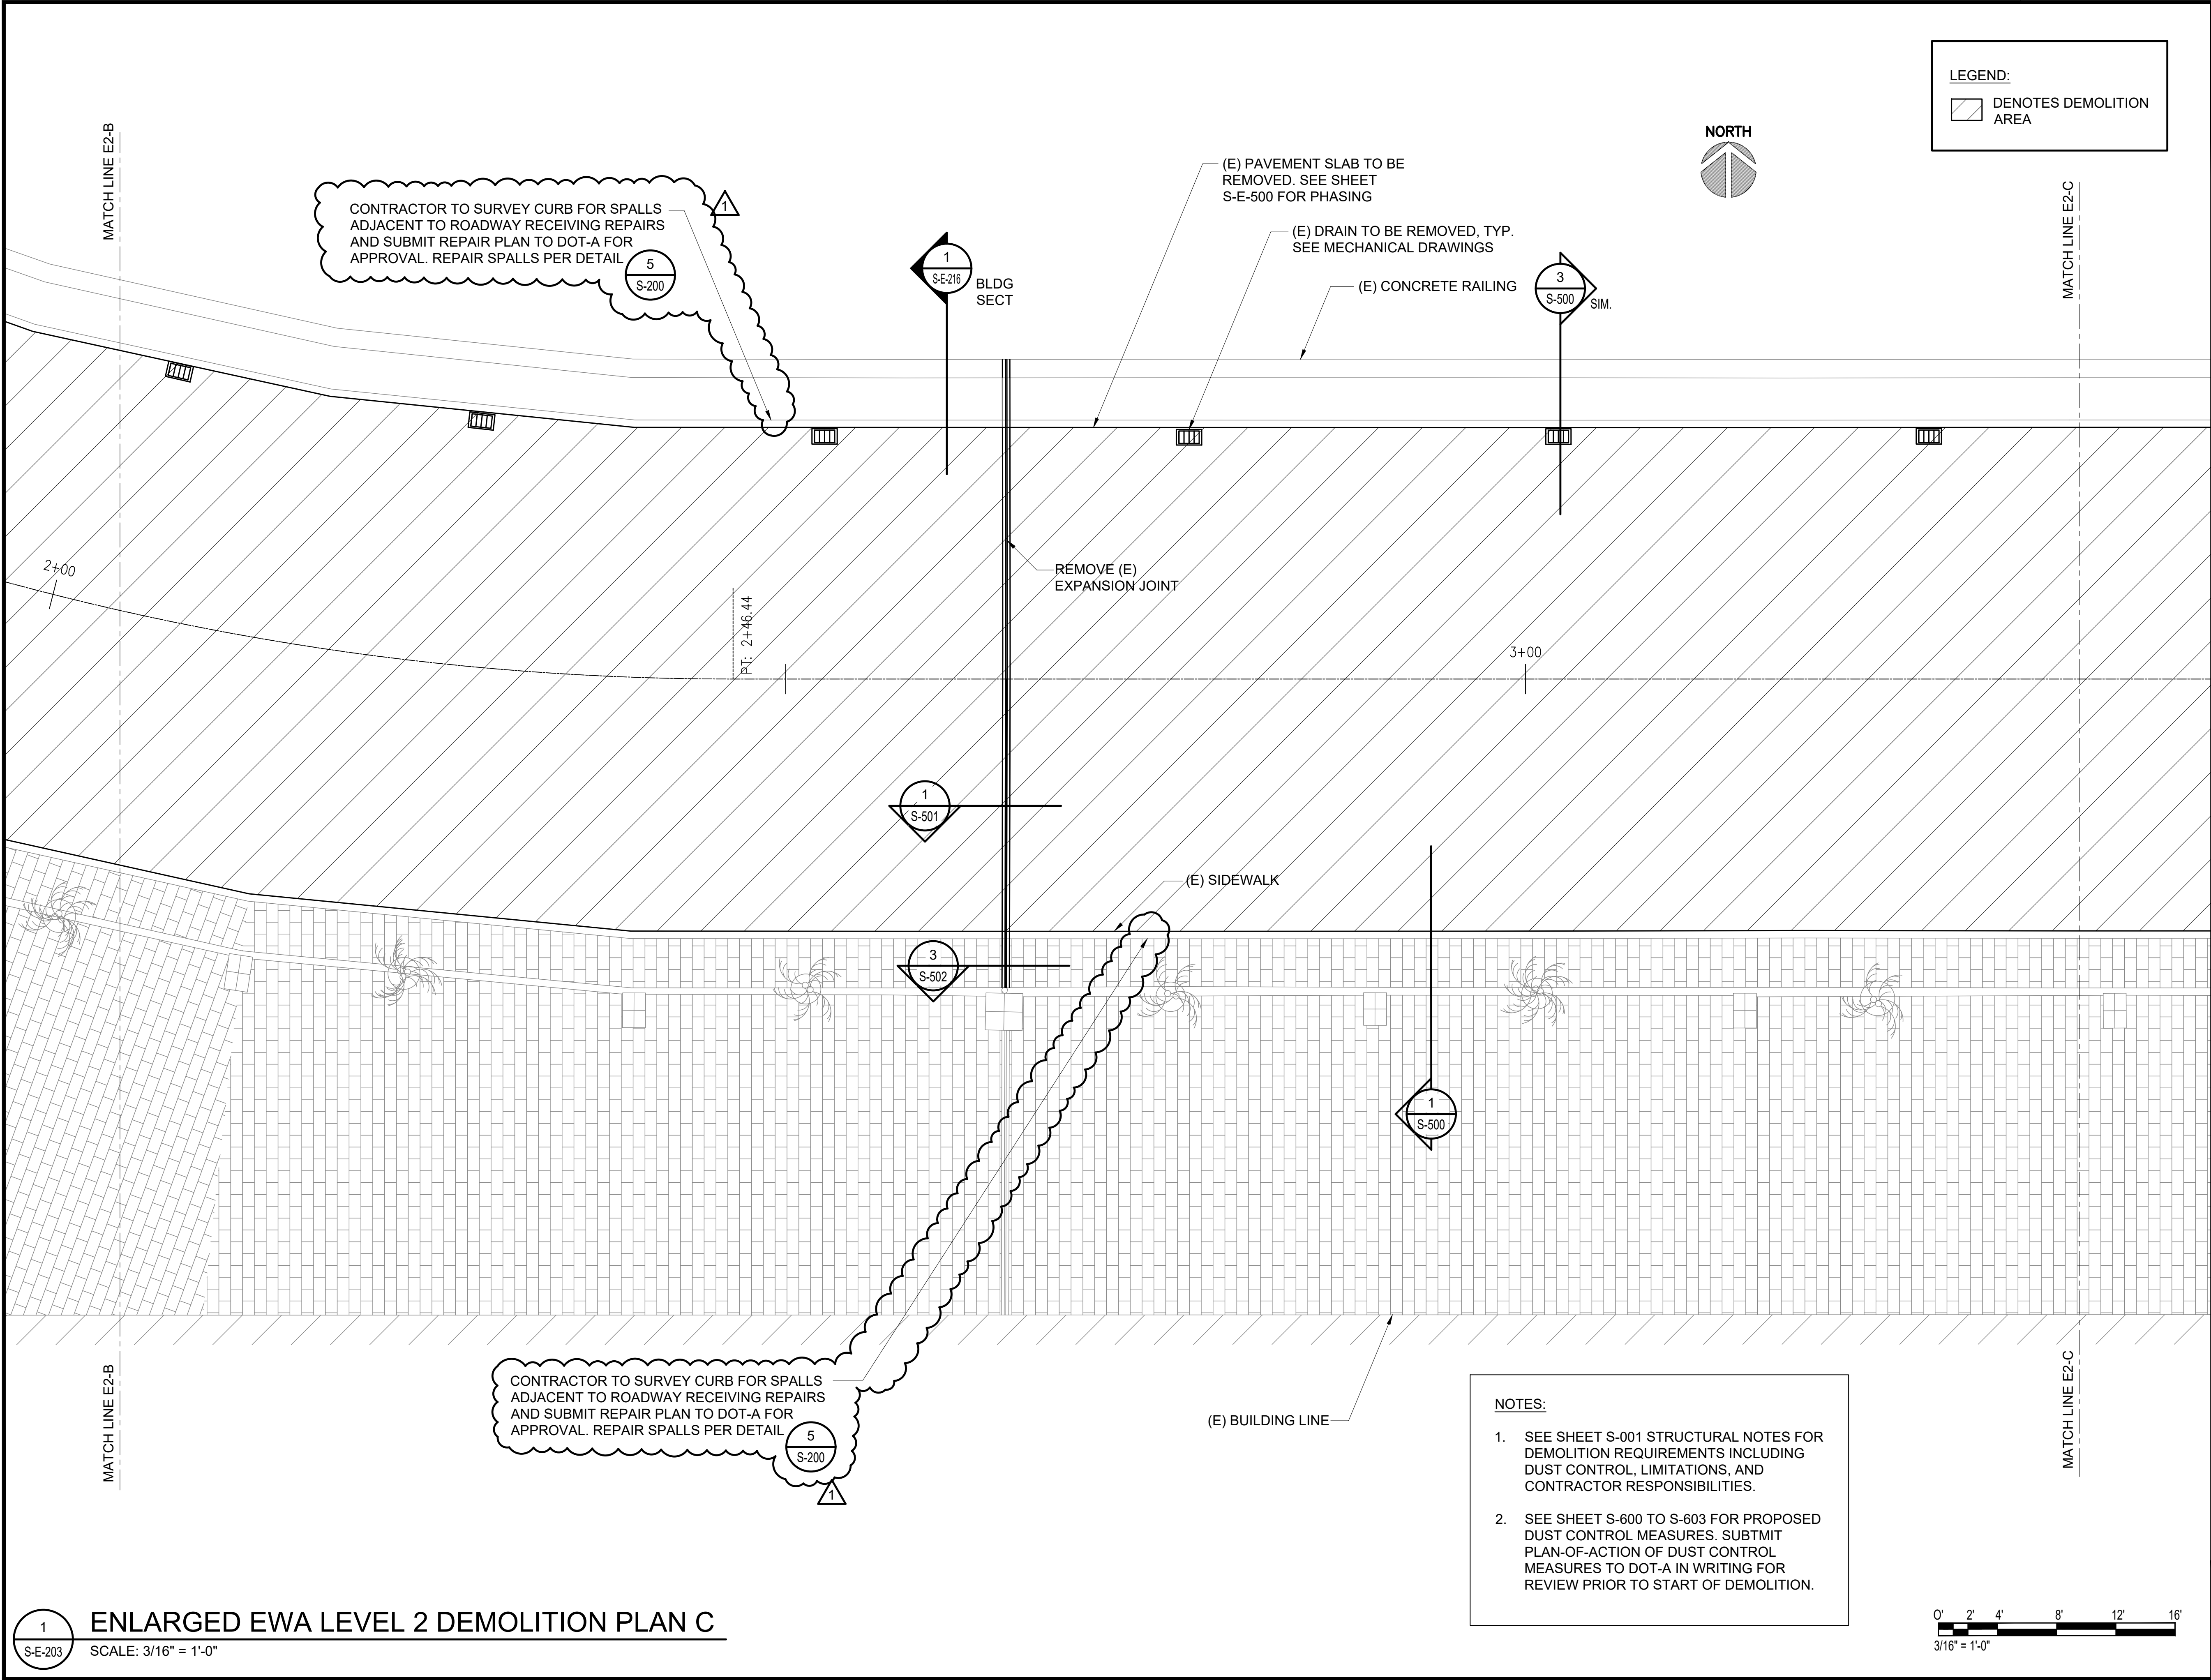

LEGEND:
DENOTES DEMOLITION
AREA

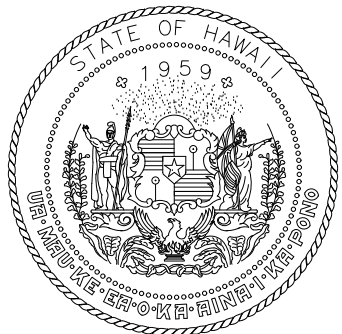

Airports Division
DEPARTMENT OF TRANSPORTATION
STATE OF HAWAII

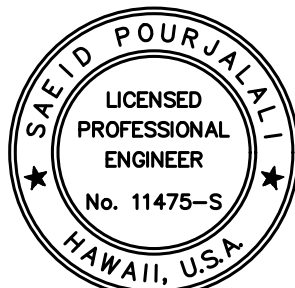


Saif Pourjafari
04/30/2024
Licensed Expiration Date

This work was prepared by me or under my supervision

DSGN.	DRWN.	CHKD.	APPD.
MG	MG	SP	

KEY PLAN / NOTES:

2ND LEVEL EWA
ROADWAY

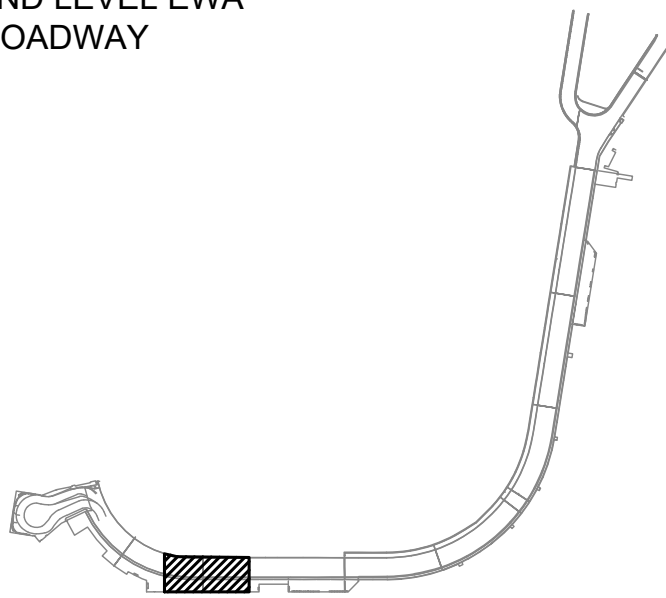

NO.	DATE	REVISIONS
1	10/20/22	ADDENDUM 1

CONSTRUCTION
DOCUMENTS

SEPTEMBER, 2022
DATE

PROJECT TITLE :

EWA AND DH CONCOURSE
ROADWAY IMPROVEMENTS
PHASE 1

AT
DANIEL K. INOUE INTERNATIONAL AIRPORT
HONOLULU, OAHU, HAWAII

PROJECT NO.:

AO1043-32

SHEET TITLE:


EWA WING - SECOND
FLOOR PARTIAL
DEMOLITION PLAN C

DATE :
SEPTEMBER, 2022
SHEET :

DWG. NO.

S-E-203

49 OF 247 SHEETS

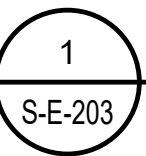



ENLARGED EWA LEVEL 2 DEMOLITION PLAN C

SCALE: 3/16" = 1'-0"

NOTES:


- SEE SHEET S-001 STRUCTURAL NOTES FOR DEMOLITION REQUIREMENTS INCLUDING DUST CONTROL, LIMITATIONS, AND CONTRACTOR RESPONSIBILITIES.
- SEE SHEET S-600 TO S-603 FOR PROPOSED DUST CONTROL MEASURES. SUBMIT PLAN-OF-ACTION OF DUST CONTROL MEASURES TO DOT-A IN WRITING FOR REVIEW PRIOR TO START OF DEMOLITION.

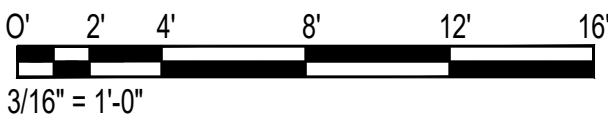

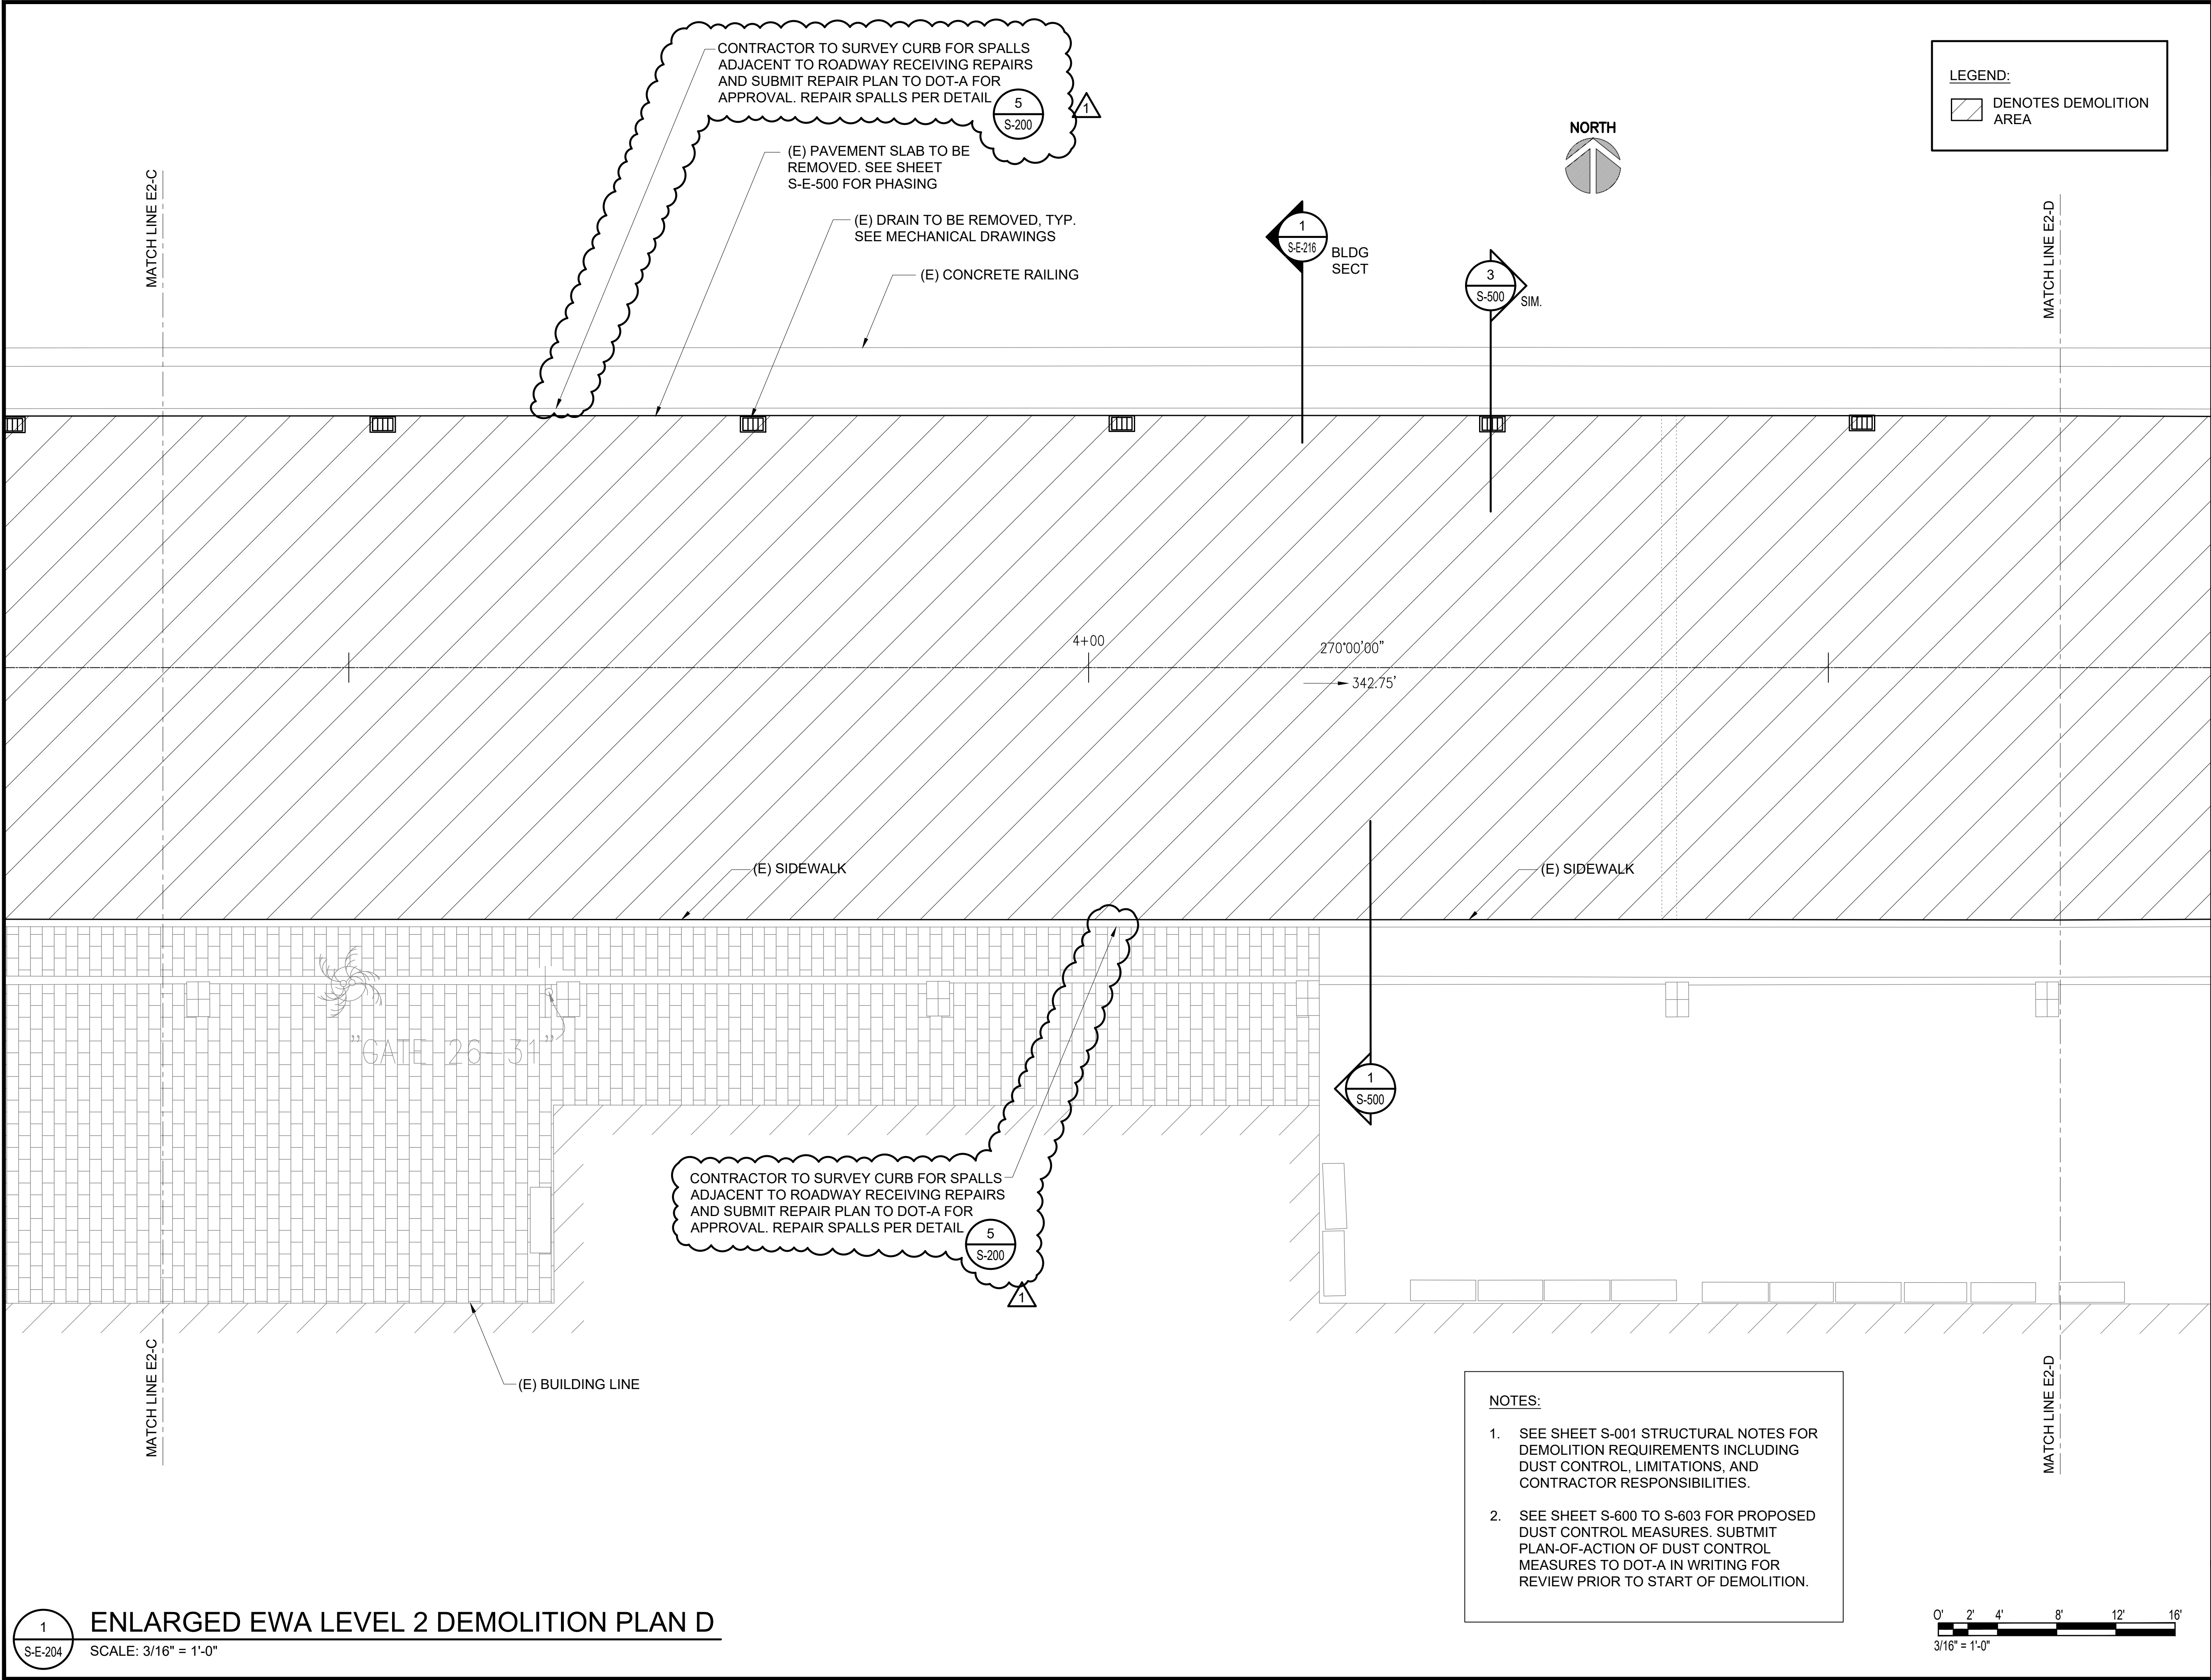


LEGEND:

DENOTES DEMOLITION AREA

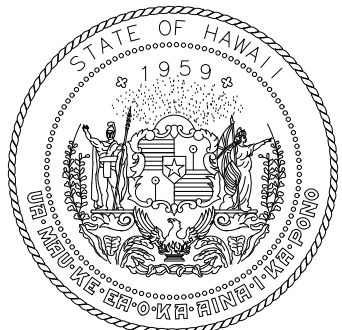

Airports Division
DEPARTMENT OF TRANSPORTATION
STATE OF HAWAII

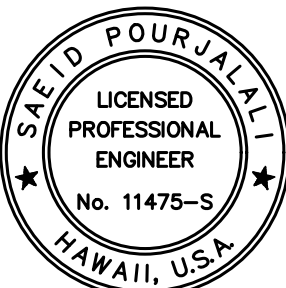

Saad Pourjafari
04/30/2024


Licensed Expiration Date

This work was prepared by me or under my supervision

DSGN.	DRWN.	CHKD.	APPD.
MG	MG	SP	

KEY PLAN / NOTES:

2ND LEVEL EWA
ROADWAY

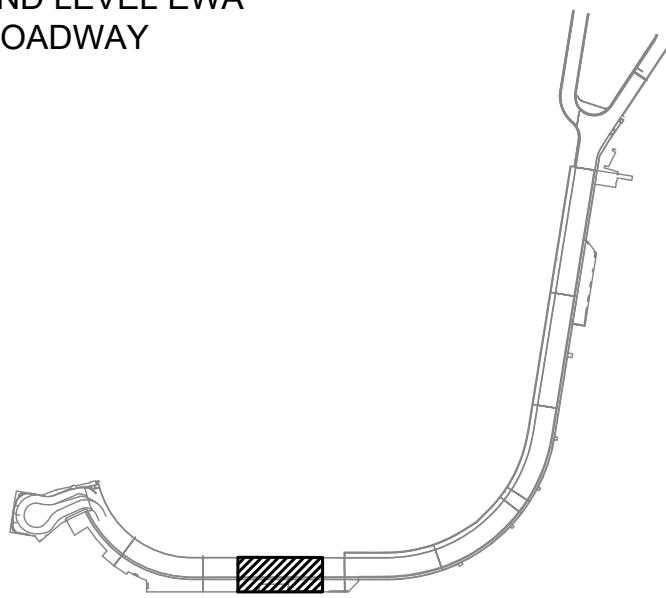

NO.	DATE	REVISIONS
	10/20/22	ADDENDUM 1

CONSTRUCTION
DOCUMENTS

SEPTEMBER, 2022
DATE

PROJECT TITLE :

EWA AND DH CONCOURSE
ROADWAY IMPROVEMENTS
PHASE 1

AT
DANIEL K. INOUE INTERNATIONAL AIRPORT
HONOLULU, OAHU, HAWAII

PROJECT NO.:

AO1043-32

SHEET TITLE:

EWA WING - SECOND
FLOOR PARTIAL
DEMOLITION PLAN D

DATE :

SEPTEMBER, 2022

SHEET :

50 OF 247 SHEETS

DWG. NO.

S-E-204





ENLARGED EWA LEVEL 2 DEMOLITION PLAN D

SCALE: 3/16" = 1'-0"

NOTES:


- SEE SHEET S-001 STRUCTURAL NOTES FOR DEMOLITION REQUIREMENTS INCLUDING DUST CONTROL, LIMITATIONS, AND CONTRACTOR RESPONSIBILITIES.
- SEE SHEET S-600 TO S-603 FOR PROPOSED DUST CONTROL MEASURES. SUBMIT PLAN-OF-ACTION OF DUST CONTROL MEASURES TO DOT-A IN WRITING FOR REVIEW PRIOR TO START OF DEMOLITION.

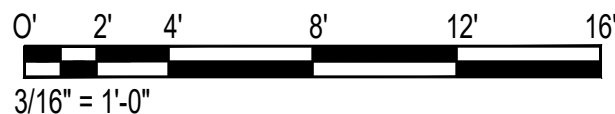

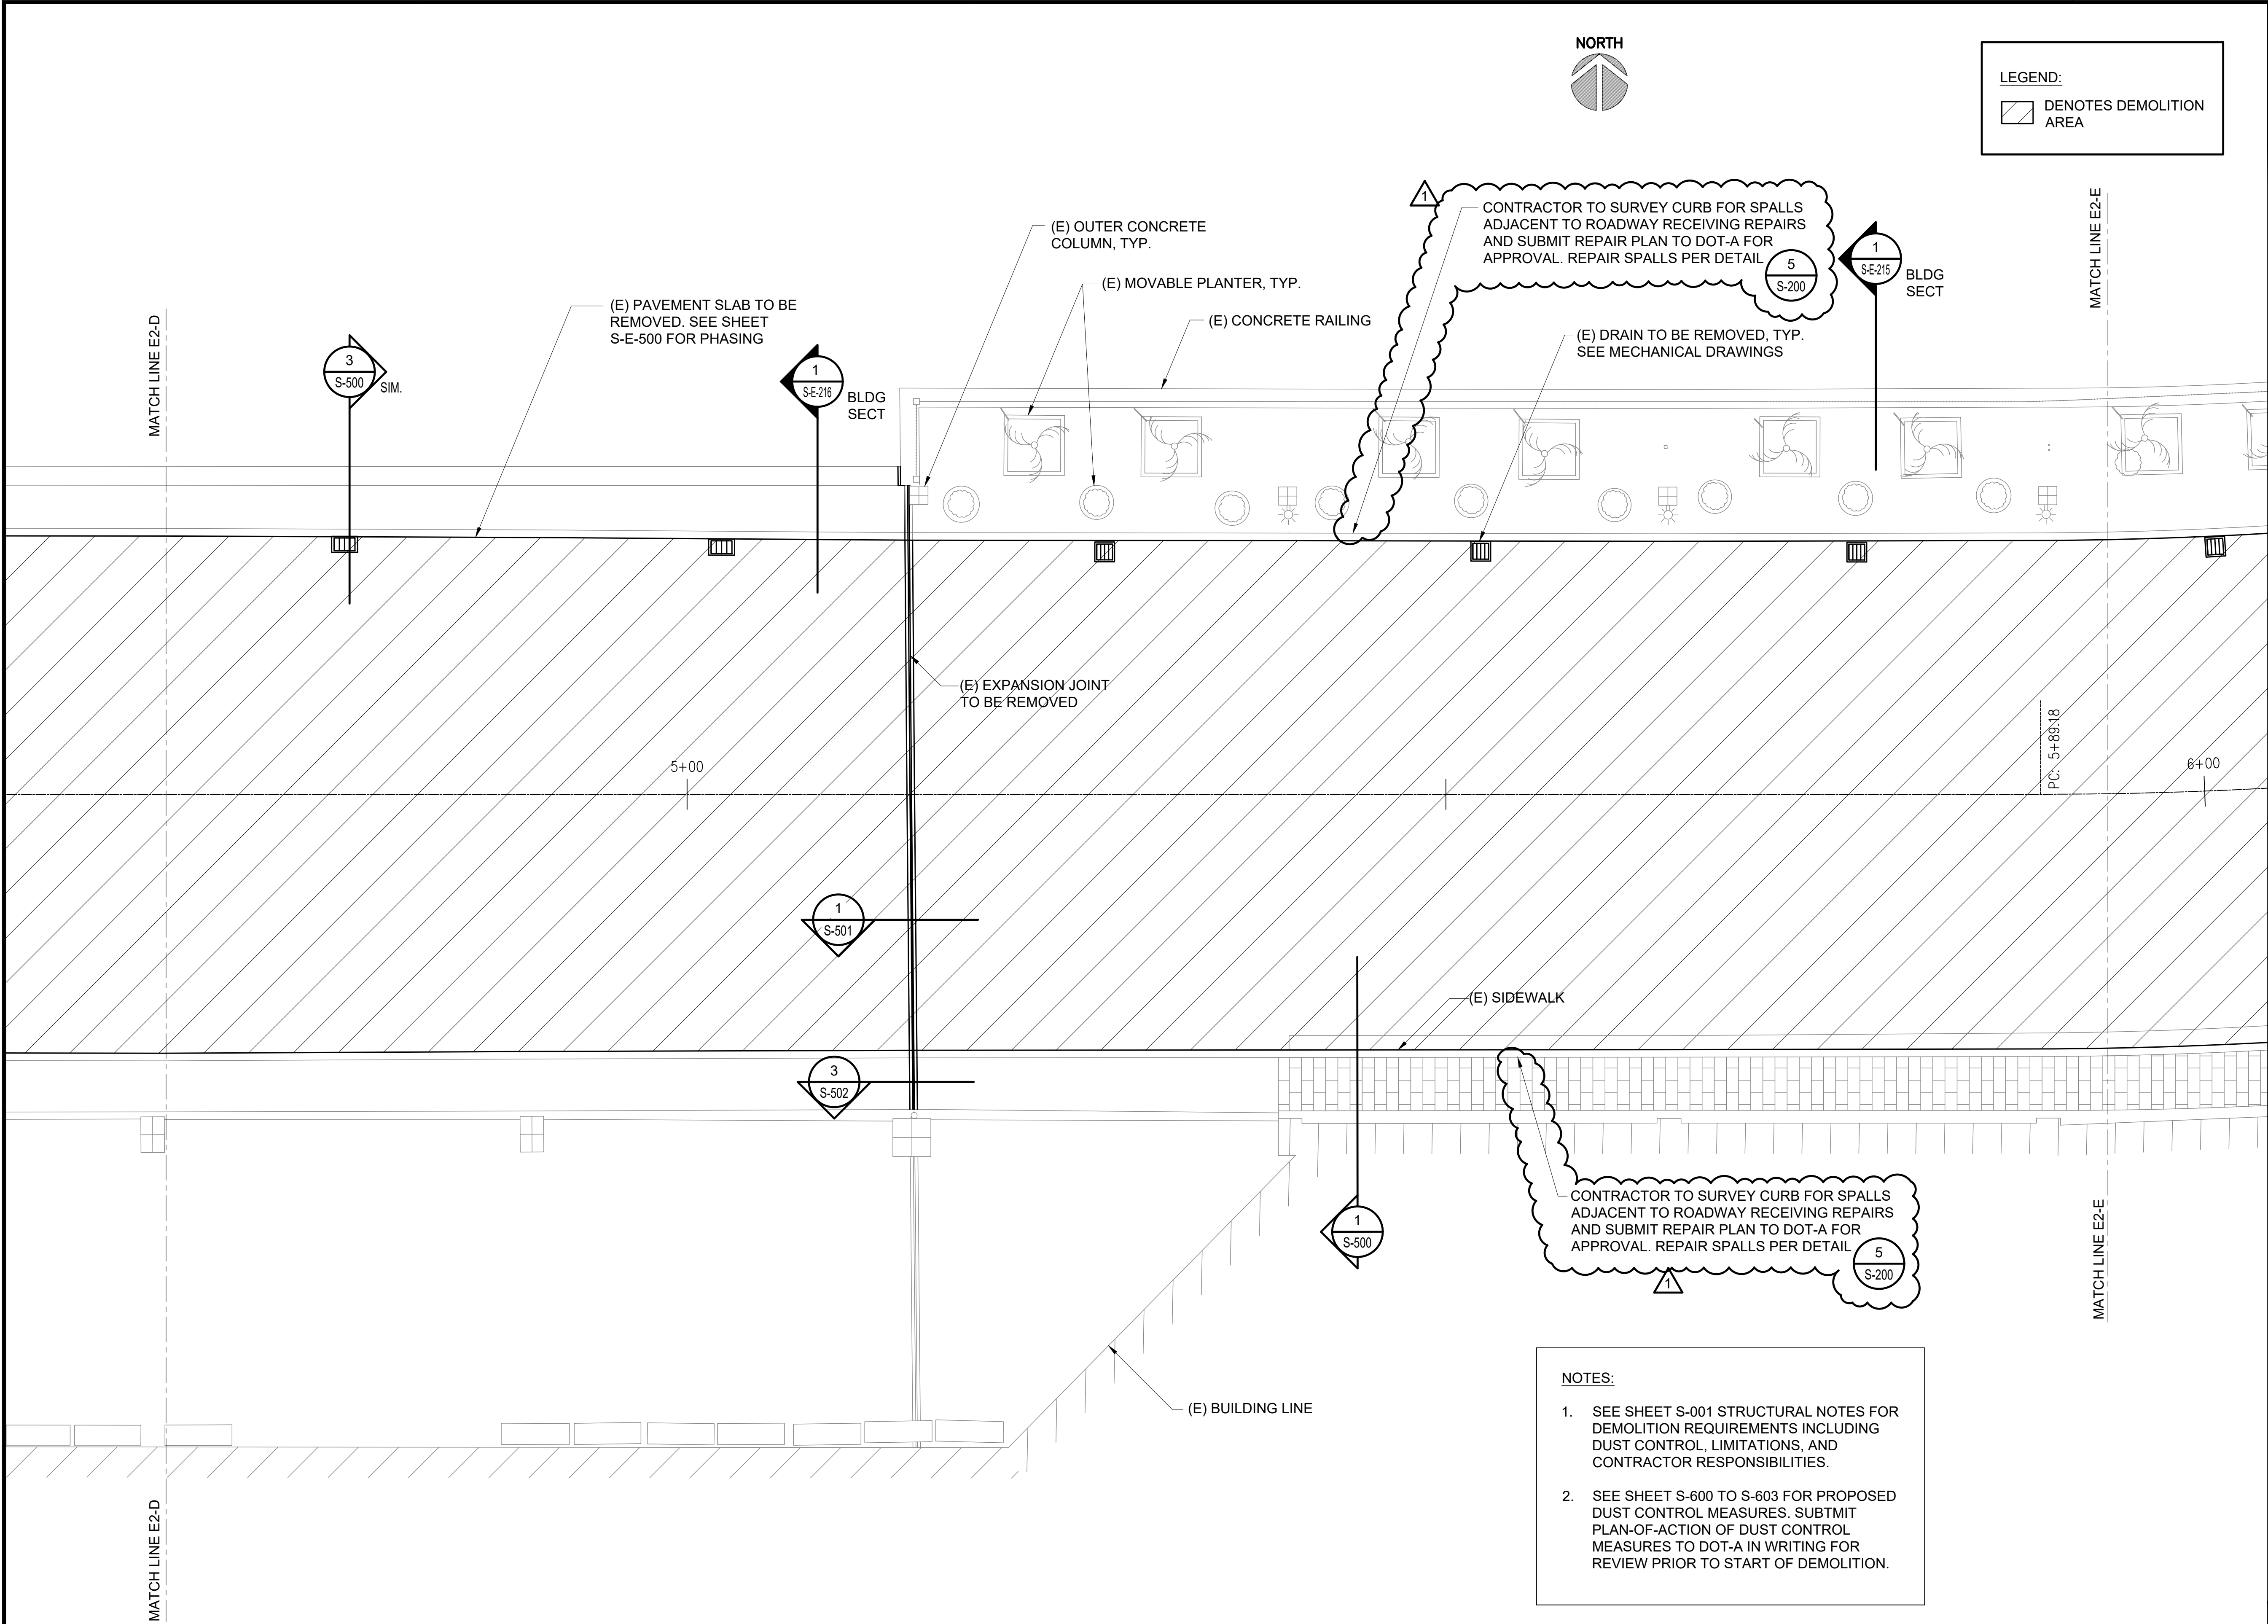


NORTH

LEGEND:
DENOTES DEMOLITION
AREA

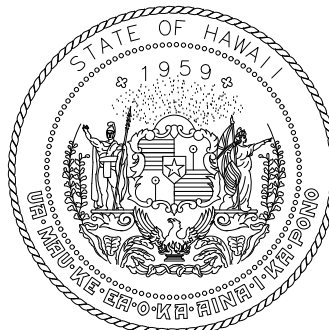

Airports Division
DEPARTMENT OF TRANSPORTATION
STATE OF HAWAII

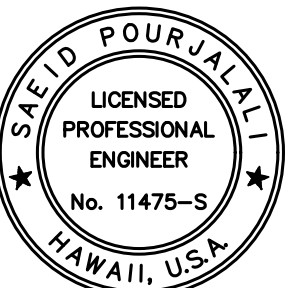


Saad Pourjalebi
04/30/2024
Licensed Expiration Date

This work was prepared by me or under my supervision

DSGN.	DRWN.	CHKD.	APPD.
MG	MG	SP	

KEY PLAN / NOTES:

2ND LEVEL EWA
ROADWAY

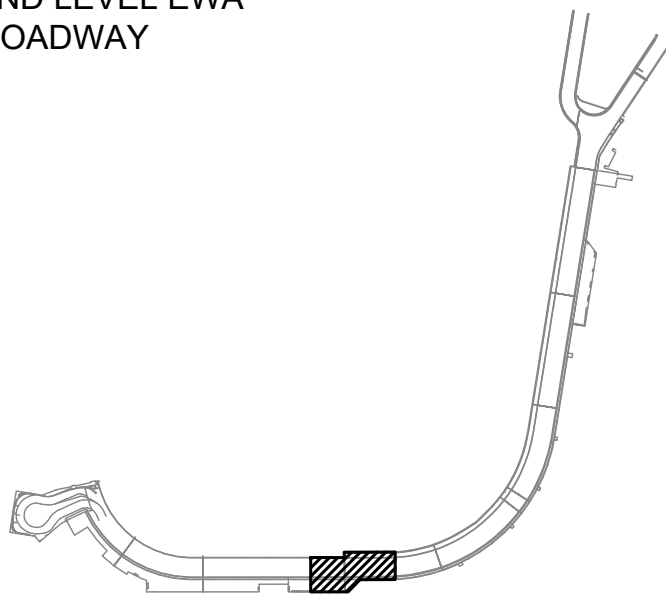

10/20/22 ADDENDUM 1

NO. DATE REVISIONS

CONSTRUCTION
DOCUMENTS

SEPTEMBER, 2022
DATE

PROJECT TITLE :

EWA AND DH CONCOURSE
ROADWAY IMPROVEMENTS
PHASE 1

AT
DANIEL K. INOUE INTERNATIONAL AIRPORT
HONOLULU, OAHU, HAWAII

PROJECT NO.:

AO1043-32

SHEET TITLE:

EWA WING - SECOND
FLOOR PARTIAL
DEMOLITION PLAN E

DATE :

SEPTEMBER, 2022

SHEET :

51 OF 247 SHEETS


DWG. NO.

S-E-205




ENLARGED EWA LEVEL 2 DEMOLITION PLAN E


SCALE: 3/16" = 1'-0"

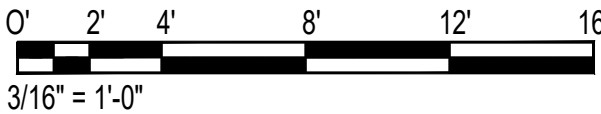


NOTES:

- SEE SHEET S-001 STRUCTURAL NOTES FOR DEMOLITION REQUIREMENTS INCLUDING DUST CONTROL, LIMITATIONS, AND CONTRACTOR RESPONSIBILITIES.
- SEE SHEET S-600 TO S-603 FOR PROPOSED DUST CONTROL MEASURES. SUBMIT PLAN-OF-ACTION OF DUST CONTROL MEASURES TO DOT-A IN WRITING FOR REVIEW PRIOR TO START OF DEMOLITION.

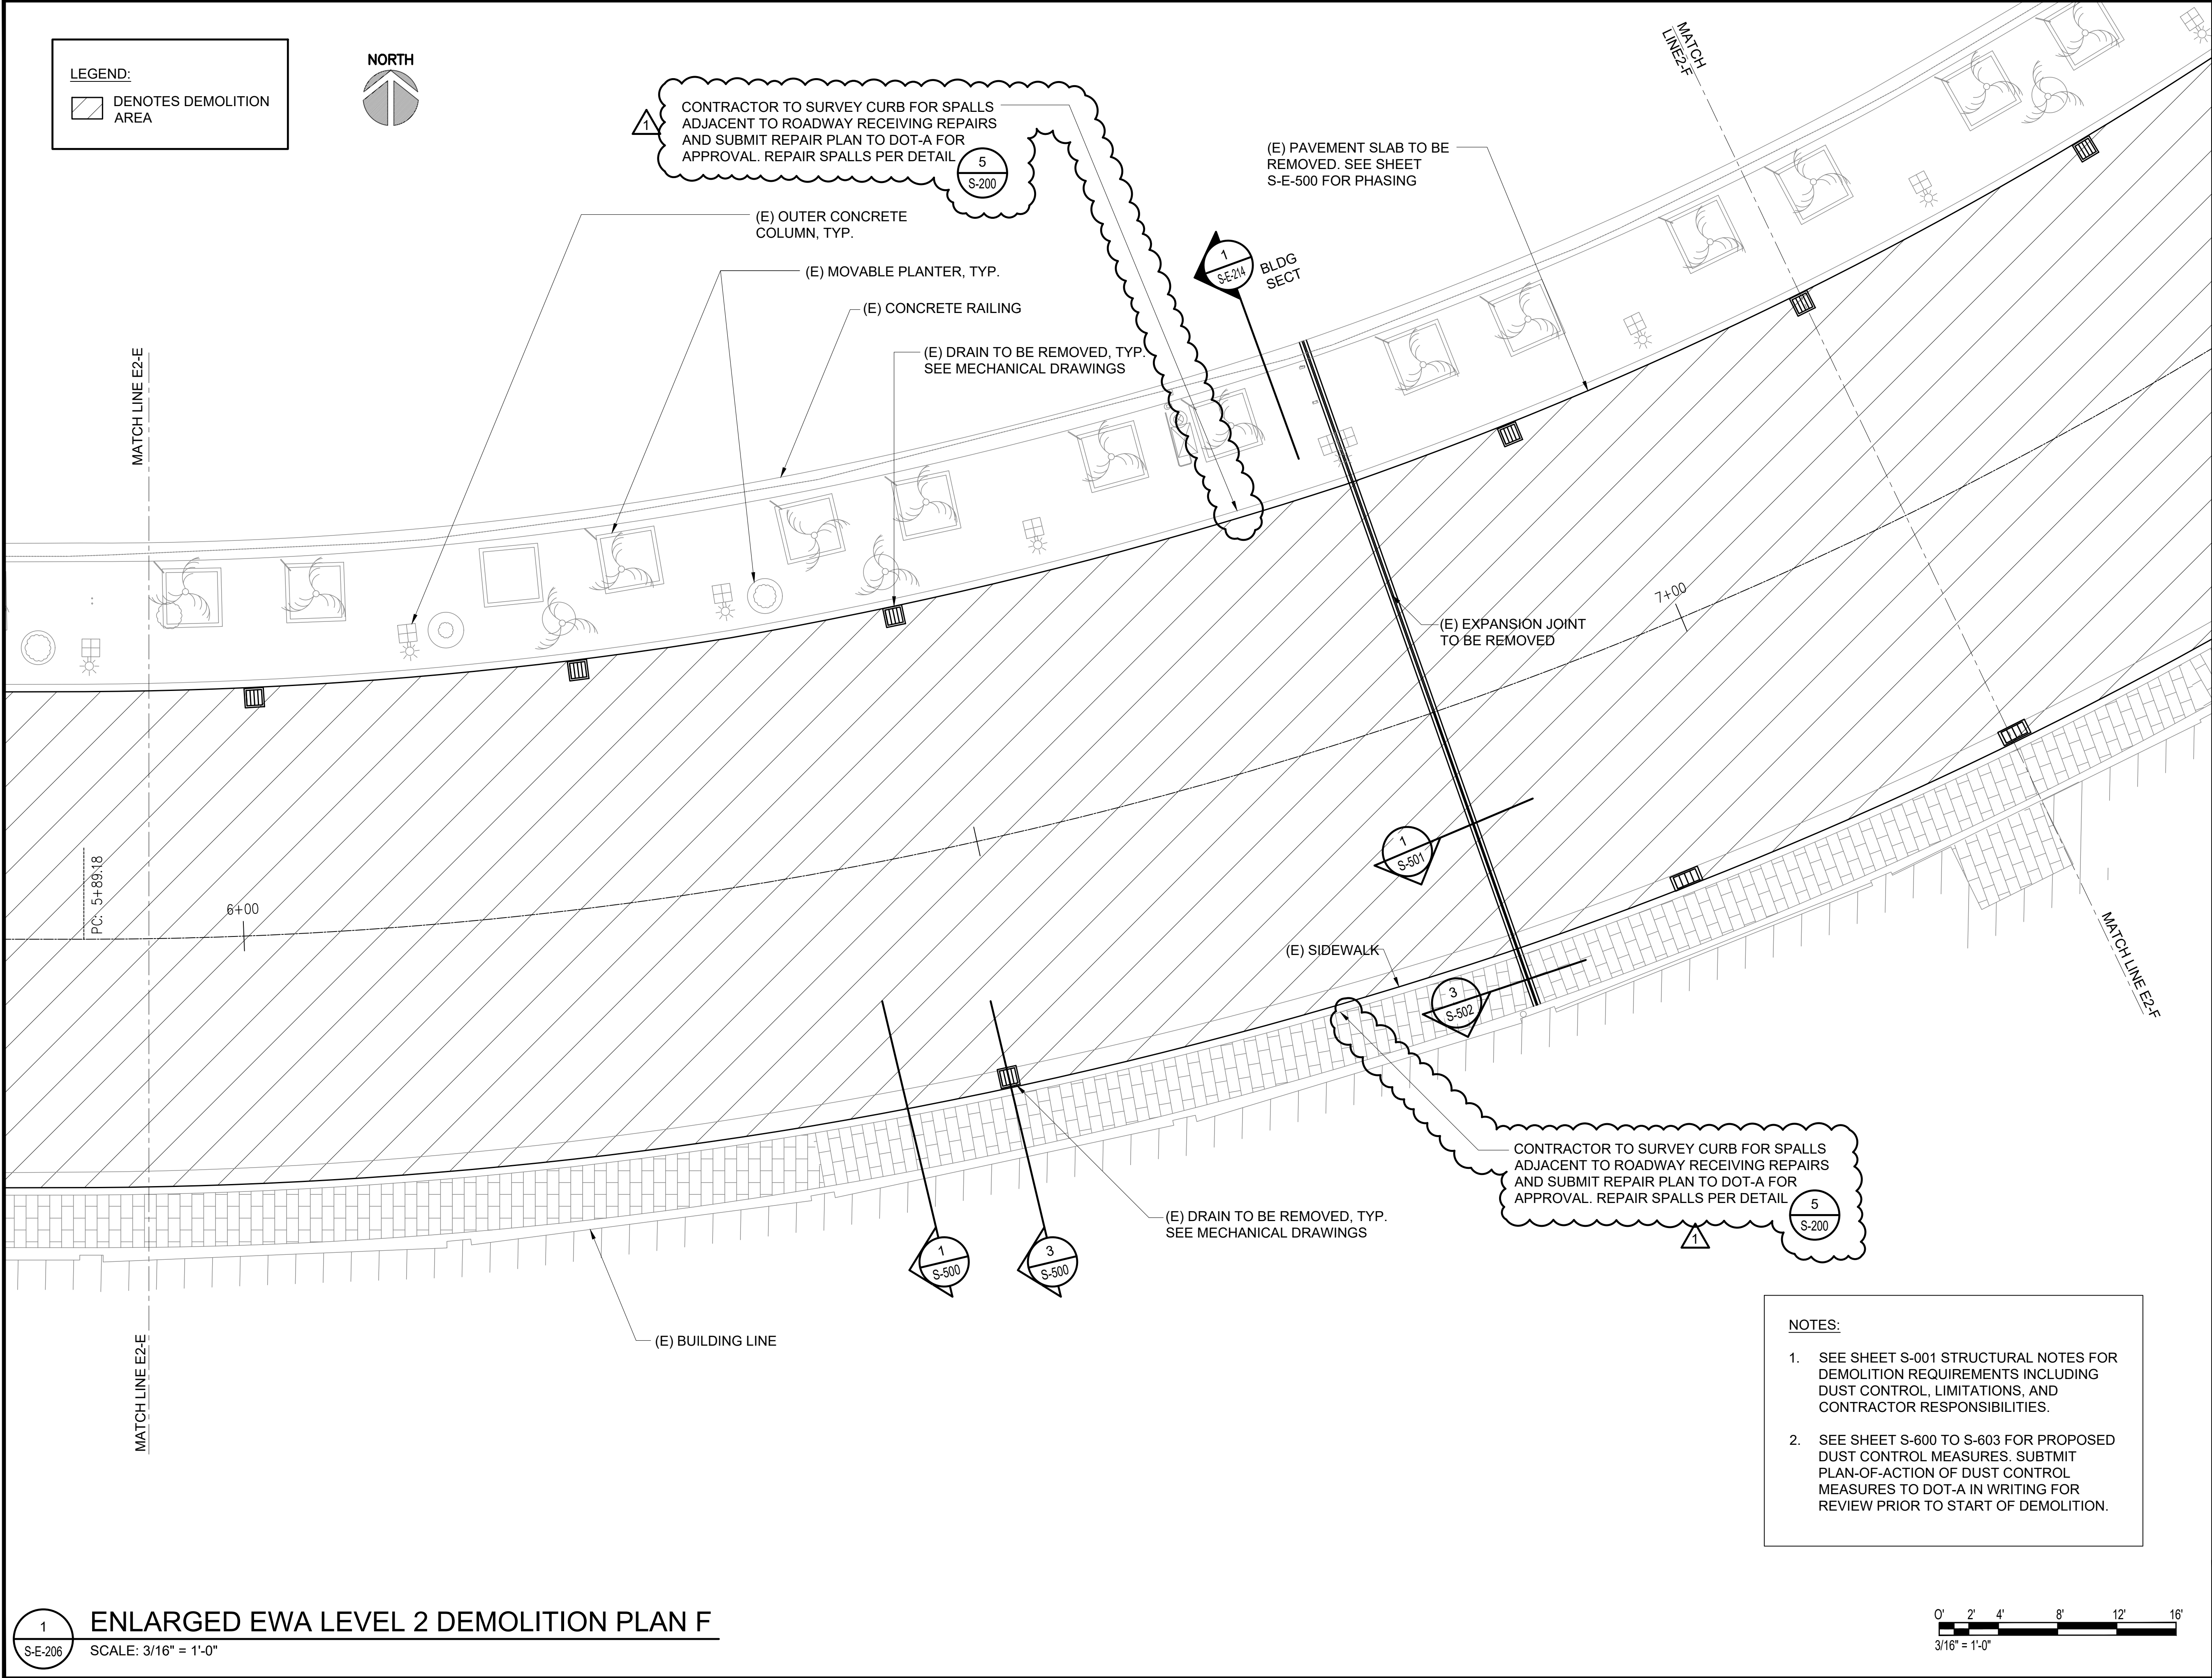

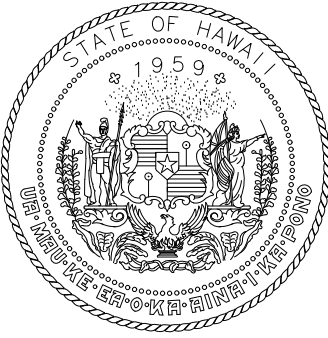

Airports Division
DEPARTMENT OF TRANSPORTATION
STATE OF HAWAII

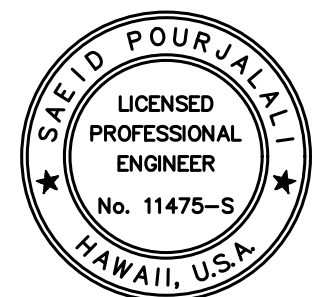


Saeed Pourjafari
04/30/2024
Licensed Expiration Date

This work was prepared by me or under my supervision

DSGN.	DRWN.	CHKD.	APPD.
MG	MG	SP	

KEY PLAN / NOTES:

2ND LEVEL EWA ROADWAY

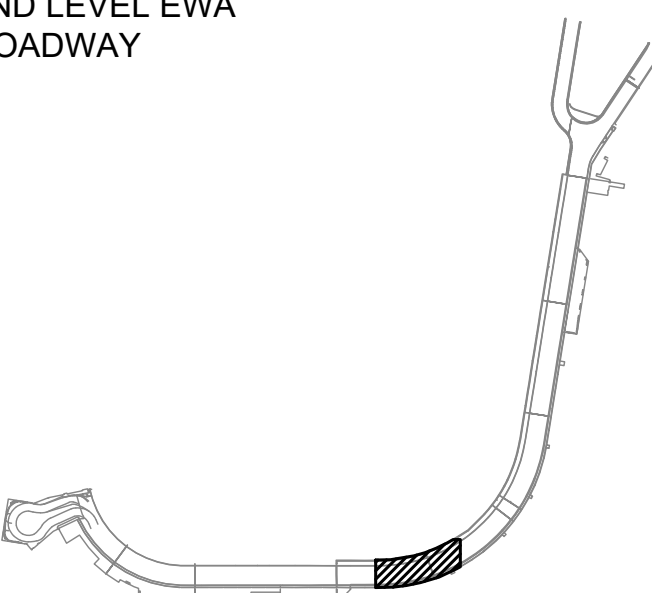

NO.	DATE	REVISIONS
1	10/20/22	ADDENDUM 1

CONSTRUCTION DOCUMENTS

SEPTEMBER, 2022

DATE

PROJECT TITLE :

EWA AND DH CONCOURSE ROADWAY IMPROVEMENTS PHASE 1

AT DANIEL K. INOUE INTERNATIONAL AIRPORT HONOLULU, OAHU, HAWAII

PROJECT NO.:

AO1043-32

SHEET TITLE:

EWA WING - SECOND FLOOR PARTIAL DEMOLITION PLAN F

DATE :	DWG. NO.
SEPTEMBER, 2022	S-E-206
SHEET :	
52 OF 247 SHEETS	

LEGEND:



 DENOTES DEMOLITION AREA

- NOTES:
- SEE SHEET S-001 STRUCTURAL NOTES FOR DEMOLITION REQUIREMENTS INCLUDING DUST CONTROL, LIMITATIONS, AND CONTRACTOR RESPONSIBILITIES.
 - SEE SHEET S-600 TO S-603 FOR PROPOSED DUST CONTROL MEASURES. SUBMIT PLAN-OF-ACTION OF DUST CONTROL MEASURES TO DOT-A IN WRITING FOR REVIEW PRIOR TO START OF DEMOLITION.




MATCH LINE E2-H

MATCH LINE E2-H

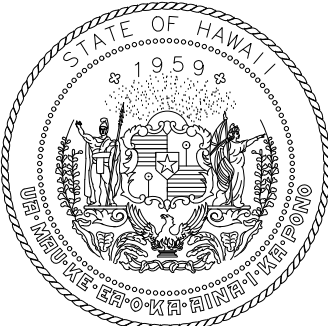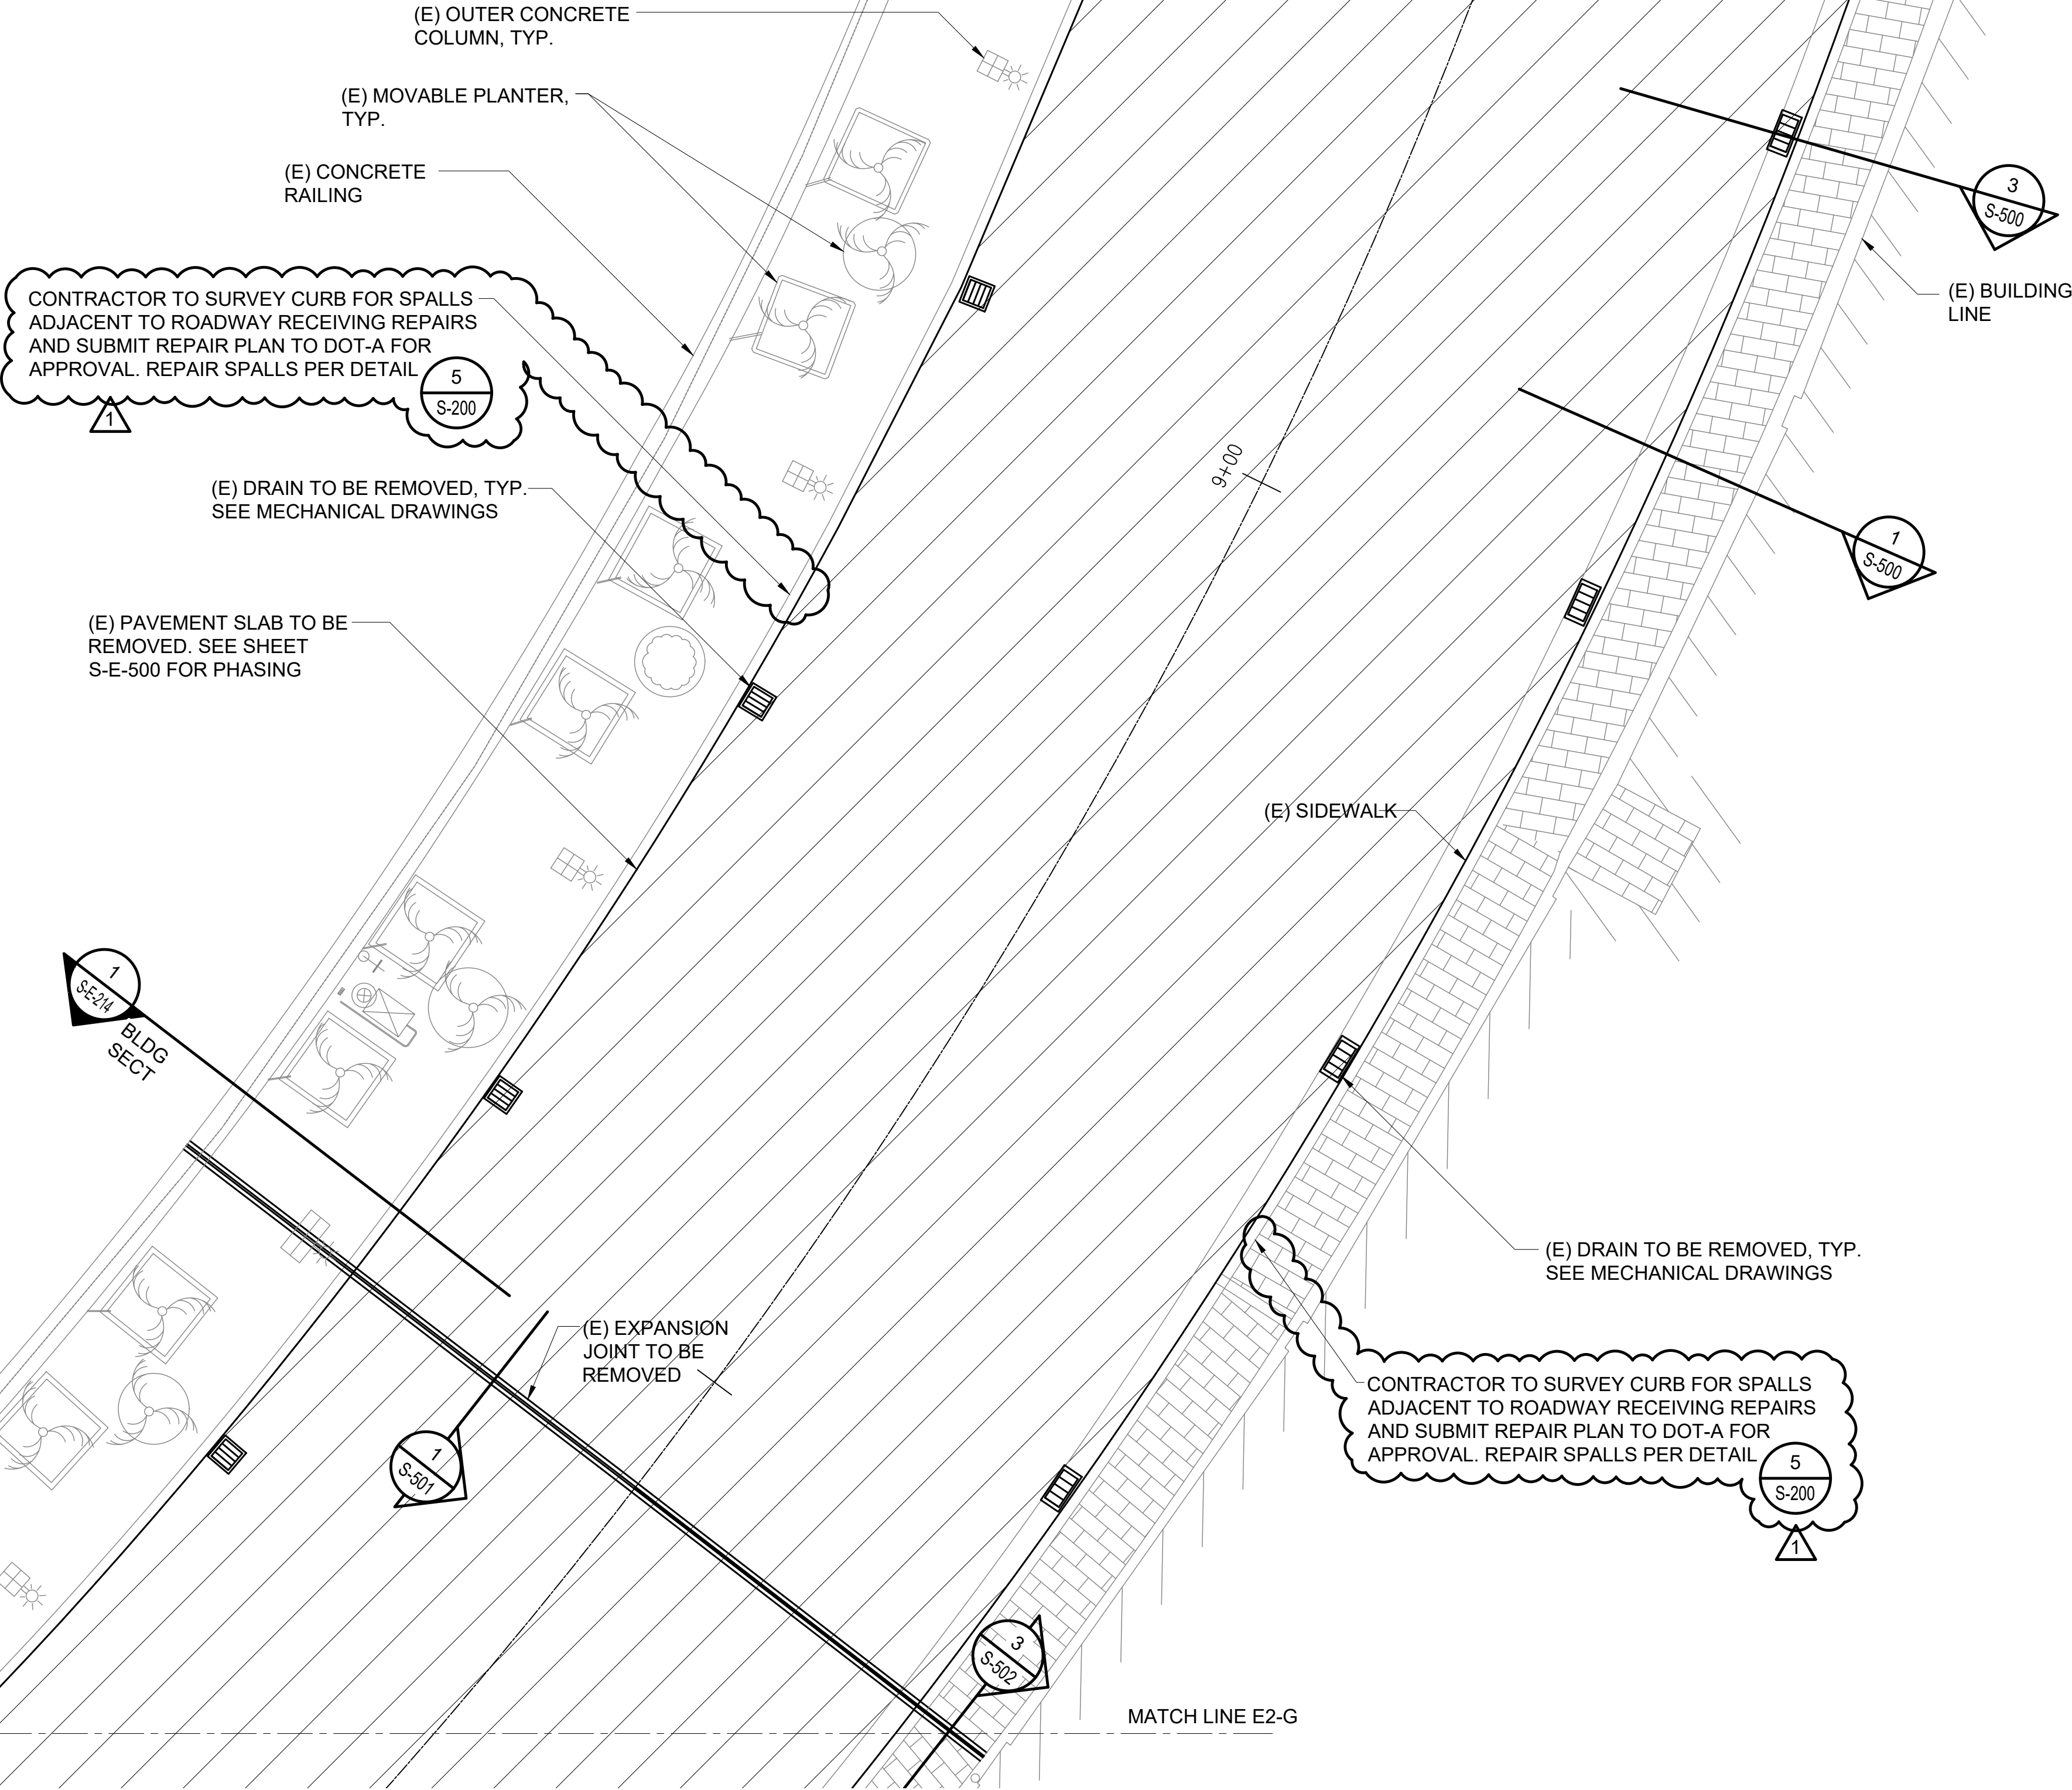

Airports Division
DEPARTMENT OF TRANSPORTATION
STATE OF HAWAII

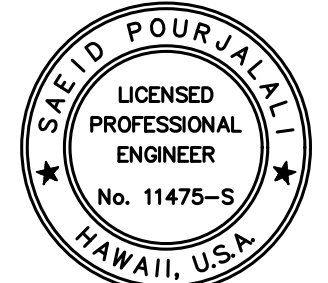


Saad Pourjafari
04/30/2024
Licensed Expiration Date

This work was prepared by me or under my supervision

DSGN.	DRWN.	CHKD.	APPD.
MG	MG	SP	

KEY PLAN / NOTES:

2ND LEVEL EWA
ROADWAY

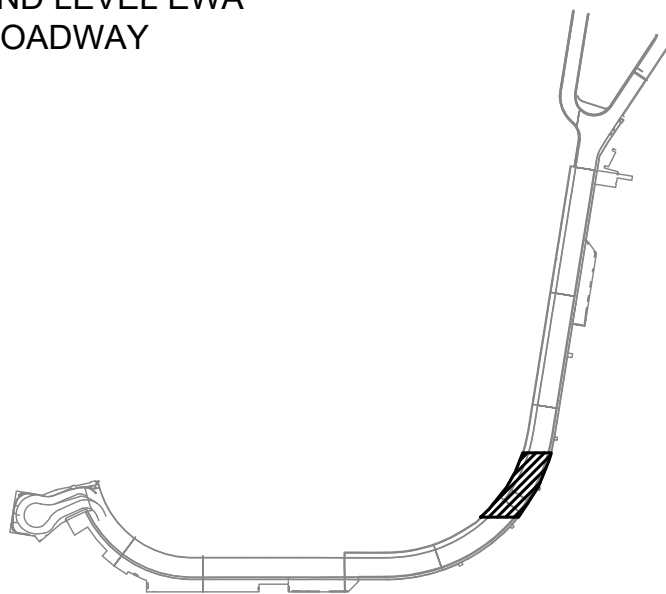

	10/20/22	ADDENDUM 1
NO.	DATE	REVISIONS

CONSTRUCTION
DOCUMENTS

SEPTEMBER, 2022
DATE

PROJECT TITLE :

EWA AND DH CONCOURSE
ROADWAY IMPROVEMENTS
PHASE 1

AT
DANIEL K. INOUE INTERNATIONAL AIRPORT
HONOLULU, OAHU, HAWAII

PROJECT NO.:

AO1043-32

SHEET TITLE:


EWA WING - SECOND
FLOOR PARTIAL
DEMOLITION PLAN H

DATE :
SEPTEMBER, 2022
SHEET :

DWG. NO.


S-E-208

54 OF 247 SHEETS

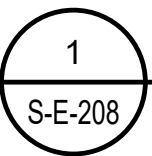

ENLARGED EWA LEVEL 2 DEMOLITION PLAN H


SCALE: 3/16" = 1'-0"

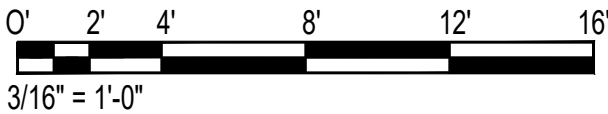

LEGEND:
DENOTES DEMOLITION
AREA

NOTES:

- SEE SHEET S-001 STRUCTURAL NOTES FOR DEMOLITION REQUIREMENTS INCLUDING DUST CONTROL, LIMITATIONS, AND CONTRACTOR RESPONSIBILITIES.
- SEE SHEET S-600 TO S-603 FOR PROPOSED DUST CONTROL MEASURES. SUBMIT PLAN-OF-ACTION OF DUST CONTROL MEASURES TO DOT-A IN WRITING FOR REVIEW PRIOR TO START OF DEMOLITION.

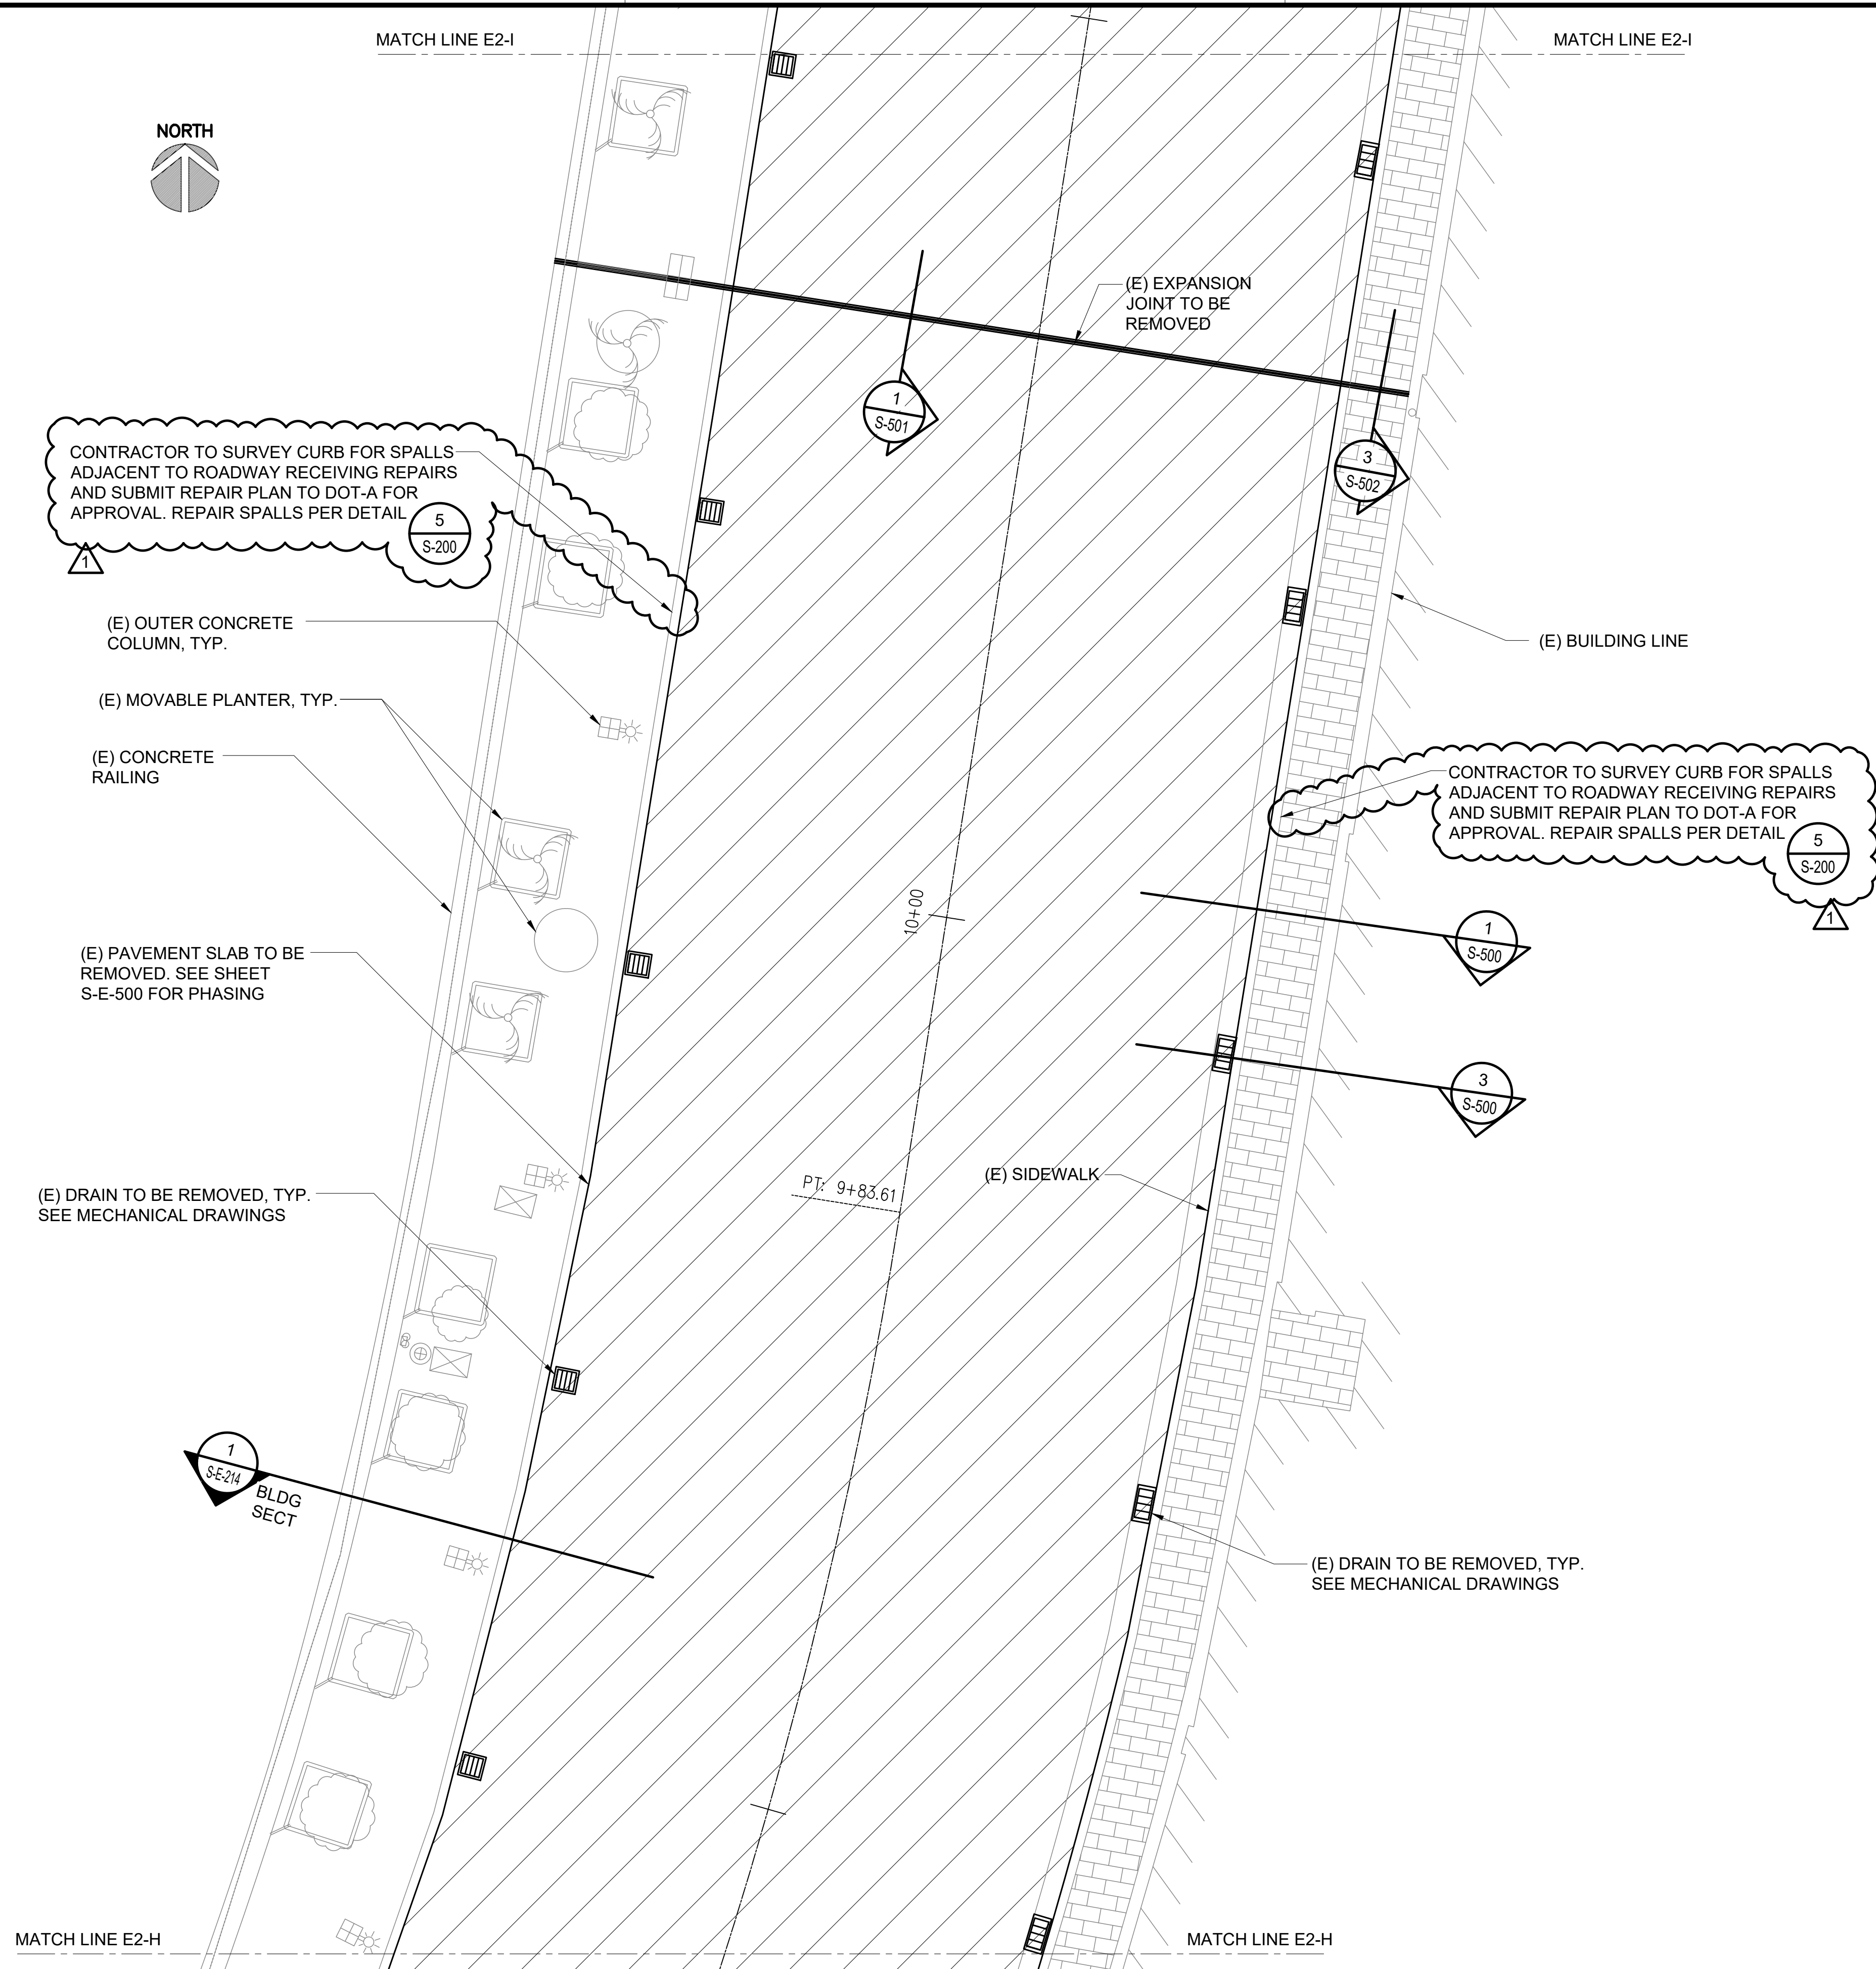


1
S-E-209

ENLARGED EWA LEVEL 2 DEMOLITION PLAN I


SCALE: 3/16" = 1'-0"

0' 2' 4' 8' 12' 16'

3/16" = 1'-0"

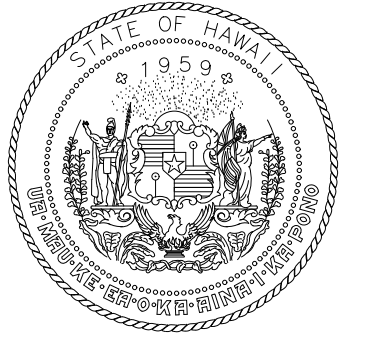

Airports Division
DEPARTMENT OF TRANSPORTATION
STATE OF HAWAII

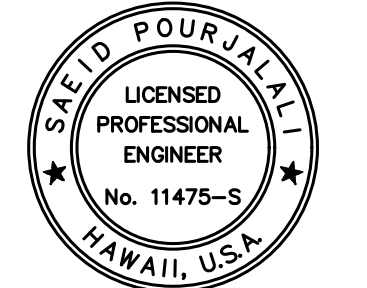


Saad Pourjafari
04/30/2024
Licensed Expiration Date

This work was prepared by me or under my supervision

DSGN.	DRWN.	CHKD.	APPD.
MG	MG	SP	

KEY PLAN / NOTES:

2ND LEVEL EWA
ROADWAY

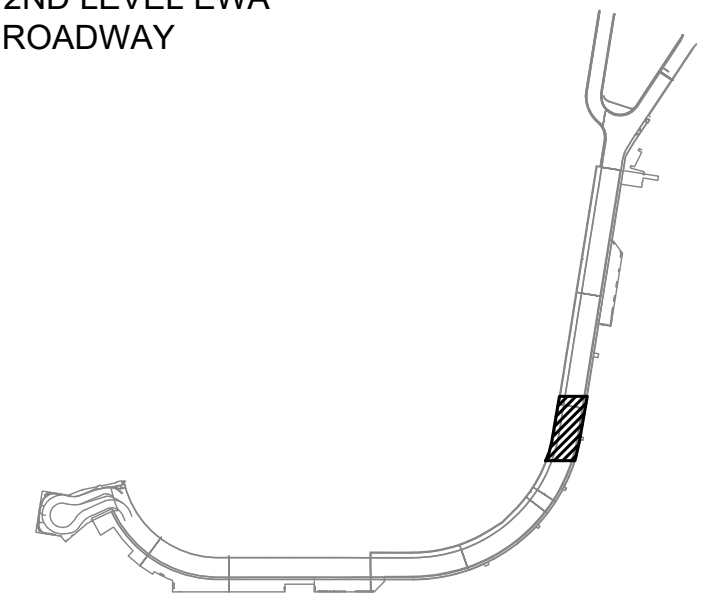

NO.	DATE	REVISIONS
1	10/20/22	ADDENDUM 1

CONSTRUCTION
DOCUMENTS

SEPTEMBER, 2022
DATE

PROJECT TITLE :

EWA AND DH CONCOURSE
ROADWAY IMPROVEMENTS
PHASE 1

AT
DANIEL K. INOUE INTERNATIONAL AIRPORT
HONOLULU, OAHU, HAWAII

PROJECT NO.:

AO1043-32

SHEET TITLE:




EWA WING - SECOND
FLOOR PARTIAL
DEMOLITION PLAN I

DATE :	DWG. NO.
SEPTEMBER, 2022	S-E-209
SHEET :	
55 OF 247 SHEETS	


LEGEND:

 DENOTES DEMOLITION AREA

- NOTES:
- SEE SHEET S-001 STRUCTURAL NOTES FOR DEMOLITION REQUIREMENTS INCLUDING DUST CONTROL, LIMITATIONS, AND CONTRACTOR RESPONSIBILITIES.
 - SEE SHEET S-600 TO S-603 FOR PROPOSED DUST CONTROL MEASURES. SUBMIT PLAN-OF-ACTION OF DUST CONTROL MEASURES TO DOT-A IN WRITING FOR REVIEW PRIOR TO START OF DEMOLITION.

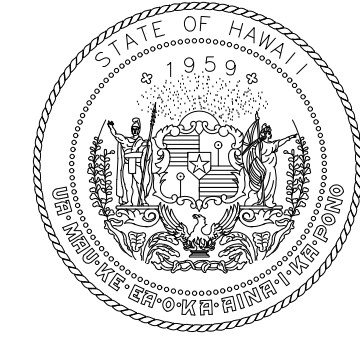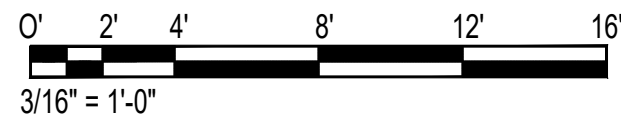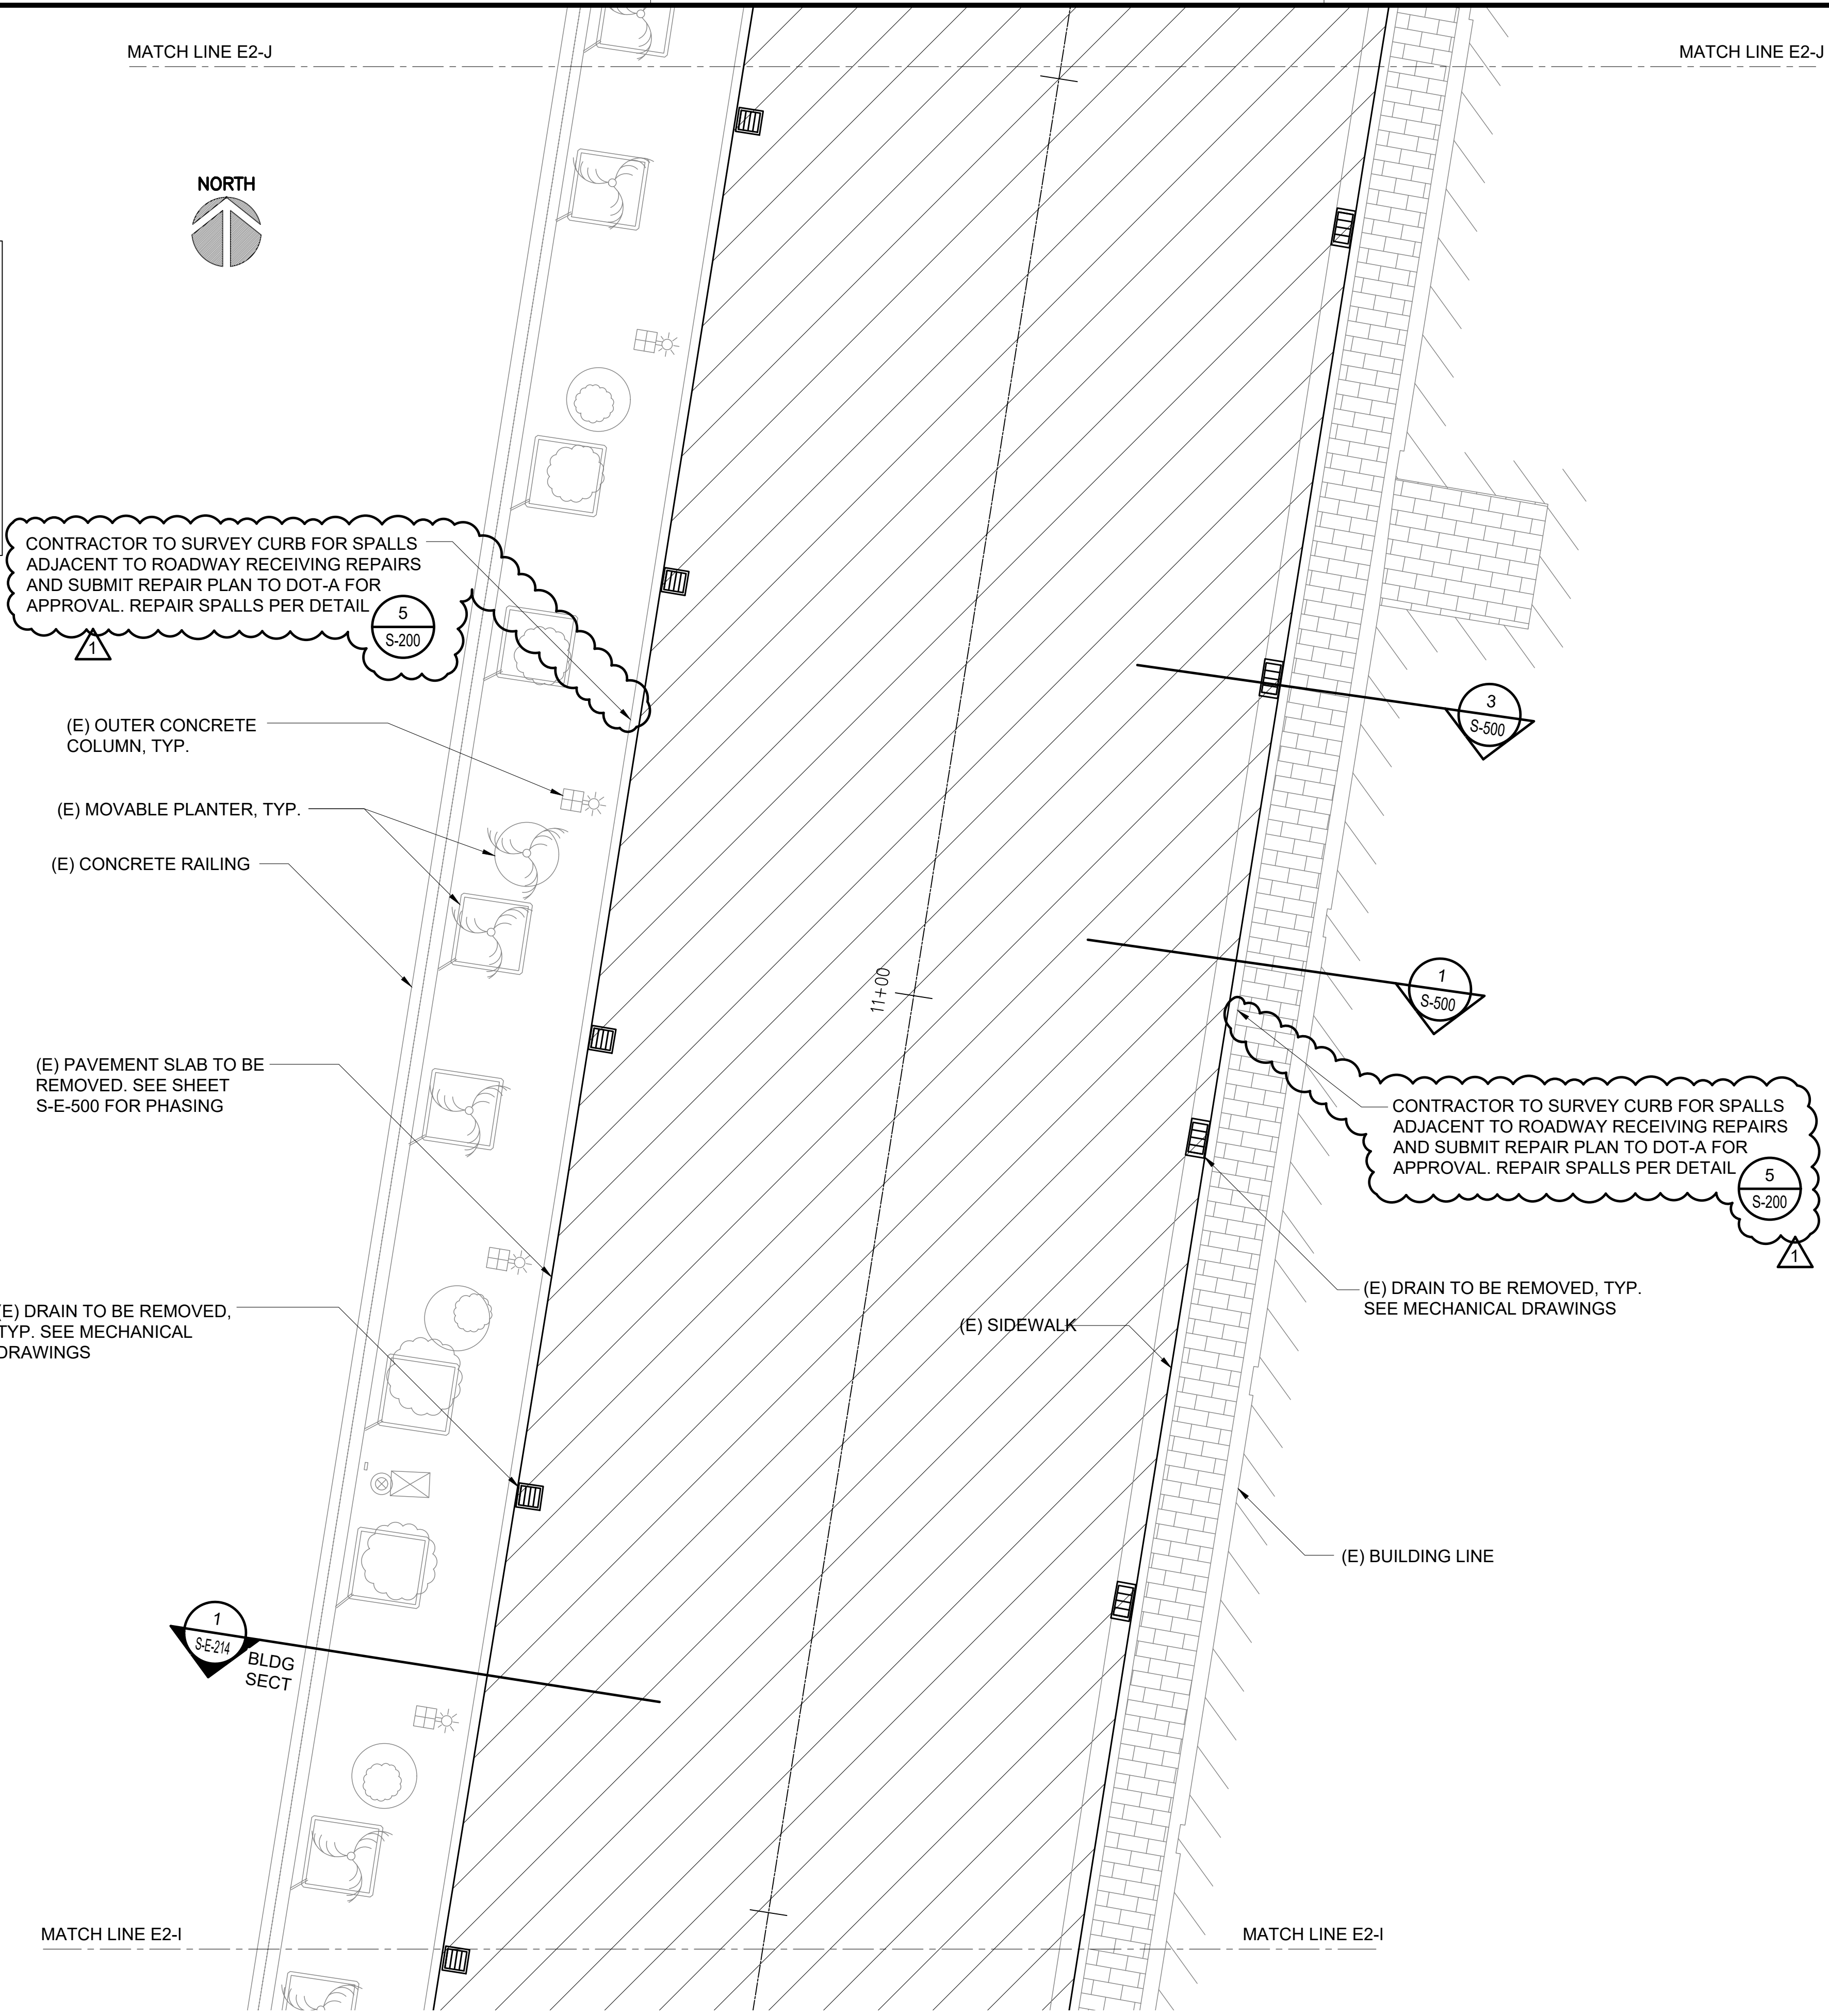

Airports Division
DEPARTMENT OF TRANSPORTATION
STATE OF HAWAII

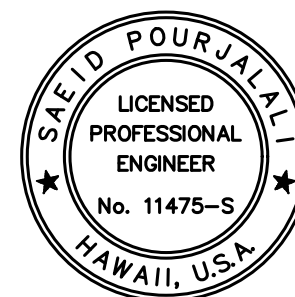


Saad Pourjafari
04/30/2024
Licensed Expiration Date

This work was prepared by me or under my supervision

DSGN.	DRWN.	CHKD.	APPD.
MG	MG	SP	

KEY PLAN / NOTES:

2ND LEVEL EWA
ROADWAY

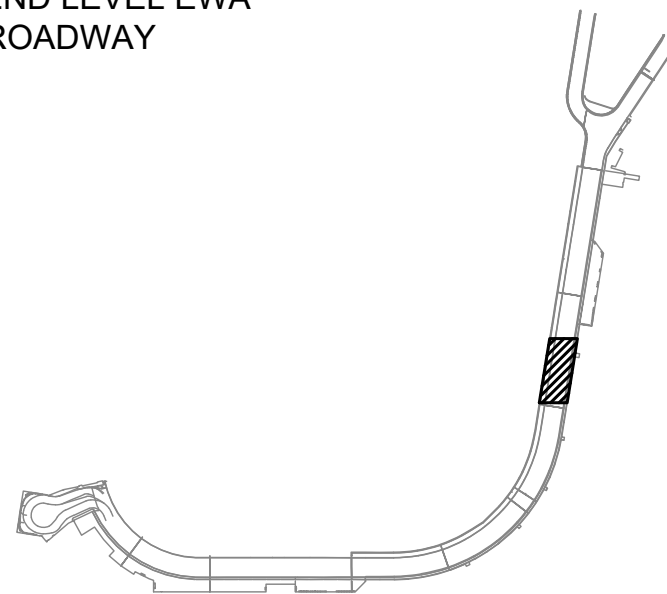

NO.	DATE	REVISIONS
1	10/20/22	ADDENDUM 1

CONSTRUCTION
DOCUMENTS

SEPTEMBER, 2022
DATE

PROJECT TITLE :

EWA AND DH CONCOURSE
ROADWAY IMPROVEMENTS
PHASE 1

AT
DANIEL K. INOUE INTERNATIONAL AIRPORT
HONOLULU, OAHU, HAWAII

PROJECT NO.:

AO1043-32

SHEET TITLE:

EWA WING - SECOND
FLOOR PARTIAL
DEMOLITION PLAN J

DATE :
SEPTEMBER, 2022
SHEET :

DWG. NO.

S-E-210

56 OF 247 SHEETS

LEGEND:
DENOTES DEMOLITION
AREA

NOTES:

- SEE SHEET S-001 STRUCTURAL NOTES FOR DEMOLITION REQUIREMENTS INCLUDING DUST CONTROL, LIMITATIONS, AND CONTRACTOR RESPONSIBILITIES.
- SEE SHEET S-600 TO S-603 FOR PROPOSED DUST CONTROL MEASURES. SUBMIT PLAN-OF-ACTION OF DUST CONTROL MEASURES TO DOT-A IN WRITING FOR REVIEW PRIOR TO START OF DEMOLITION.



(E) MOVABLE PLANTER,
TYP.

(E) CONCRETE RAILING
(E) OUTER CONCRETE
COLUMN, TYP.

(E) PAVEMENT SLAB TO BE
REMOVED. SEE SHEET
S-E-500 FOR PHASING

(E) DRAIN TO BE REMOVED,
TYP. SEE MECHANICAL
DRAWINGS

CONTRACTOR TO SURVEY CURB FOR SPALLS
ADJACENT TO ROADWAY RECEIVING REPAIRS
AND SUBMIT REPAIR PLAN TO DOT-A FOR
APPROVAL. REPAIR SPALLS PER DETAIL

(E) SIDEWALK

(E) EXPANSION JOINT
TO BE REMOVED

(E) DRAIN TO BE REMOVED, TYP.
SEE MECHANICAL DRAWINGS

(E) SIDEWALK

(E) BUILDING LINE

CONTRACTOR TO SURVEY CURB FOR SPALLS
ADJACENT TO ROADWAY RECEIVING REPAIRS
AND SUBMIT REPAIR PLAN TO DOT-A FOR
APPROVAL. REPAIR SPALLS PER DETAIL

ENLARGED EWA LEVEL 2 DEMOLITION PLAN K

SCALE: 3/16" = 1'-0"

0' 2' 4' 8' 12' 16'
3/16" = 1'-0"

MATCH LINE E2-K


MATCH LINE E2-K

MATCH LINE E2-J

MATCH LINE E2-J



Airports Division
DEPARTMENT OF TRANSPORTATION
STATE OF HAWAII

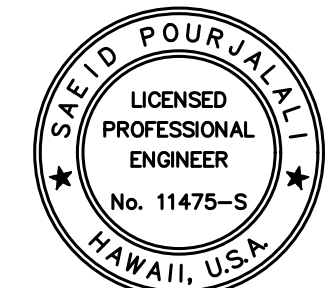


Saad Pourjafari
04/30/2024
Licensed Expiration Date

This work was prepared by me or under my supervision

DSGN.	DRWN.	CHKD.	APPD.
MG	MG	SP	

KEY PLAN / NOTES:

2ND LEVEL EWA
ROADWAY

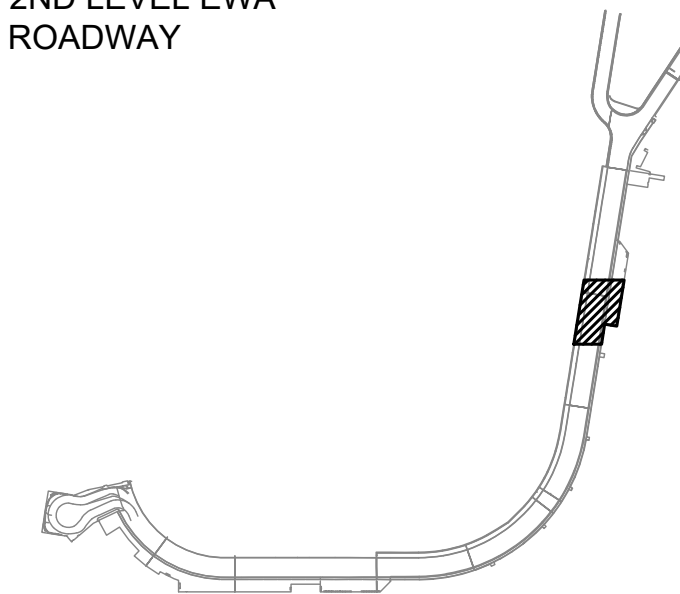

NO.	DATE	REVISIONS
1	10/20/22	ADDENDUM 1

CONSTRUCTION
DOCUMENTS

SEPTEMBER, 2022
DATE

PROJECT TITLE :

EWA AND DH CONCOURSE
ROADWAY IMPROVEMENTS
PHASE 1

AT
DANIEL K. INOUE INTERNATIONAL AIRPORT
HONOLULU, OAHU, HAWAII

PROJECT NO.:

AO1043-32

SHEET TITLE:

EWA WING - SECOND
FLOOR PARTIAL
DEMOLITION PLAN K

DATE :
SEPTEMBER, 2022
SHEET :

DWG. NO.

S-E-211

57 OF 247 SHEETS


LEGEND:

 DENOTES DEMOLITION AREA

NOTES:

1. SEE SHEET S-001 STRUCTURAL NOTES FOR DEMOLITION REQUIREMENTS INCLUDING DUST CONTROL, LIMITATIONS, AND CONTRACTOR RESPONSIBILITIES.

2. SEE SHEET S-600 TO S-603 FOR PROPOSED DUST CONTROL MEASURES. SUBMIT PLAN-OF-ACTION OF DUST CONTROL MEASURES TO DOT-A IN WRITING FOR REVIEW PRIOR TO START OF DEMOLITION.

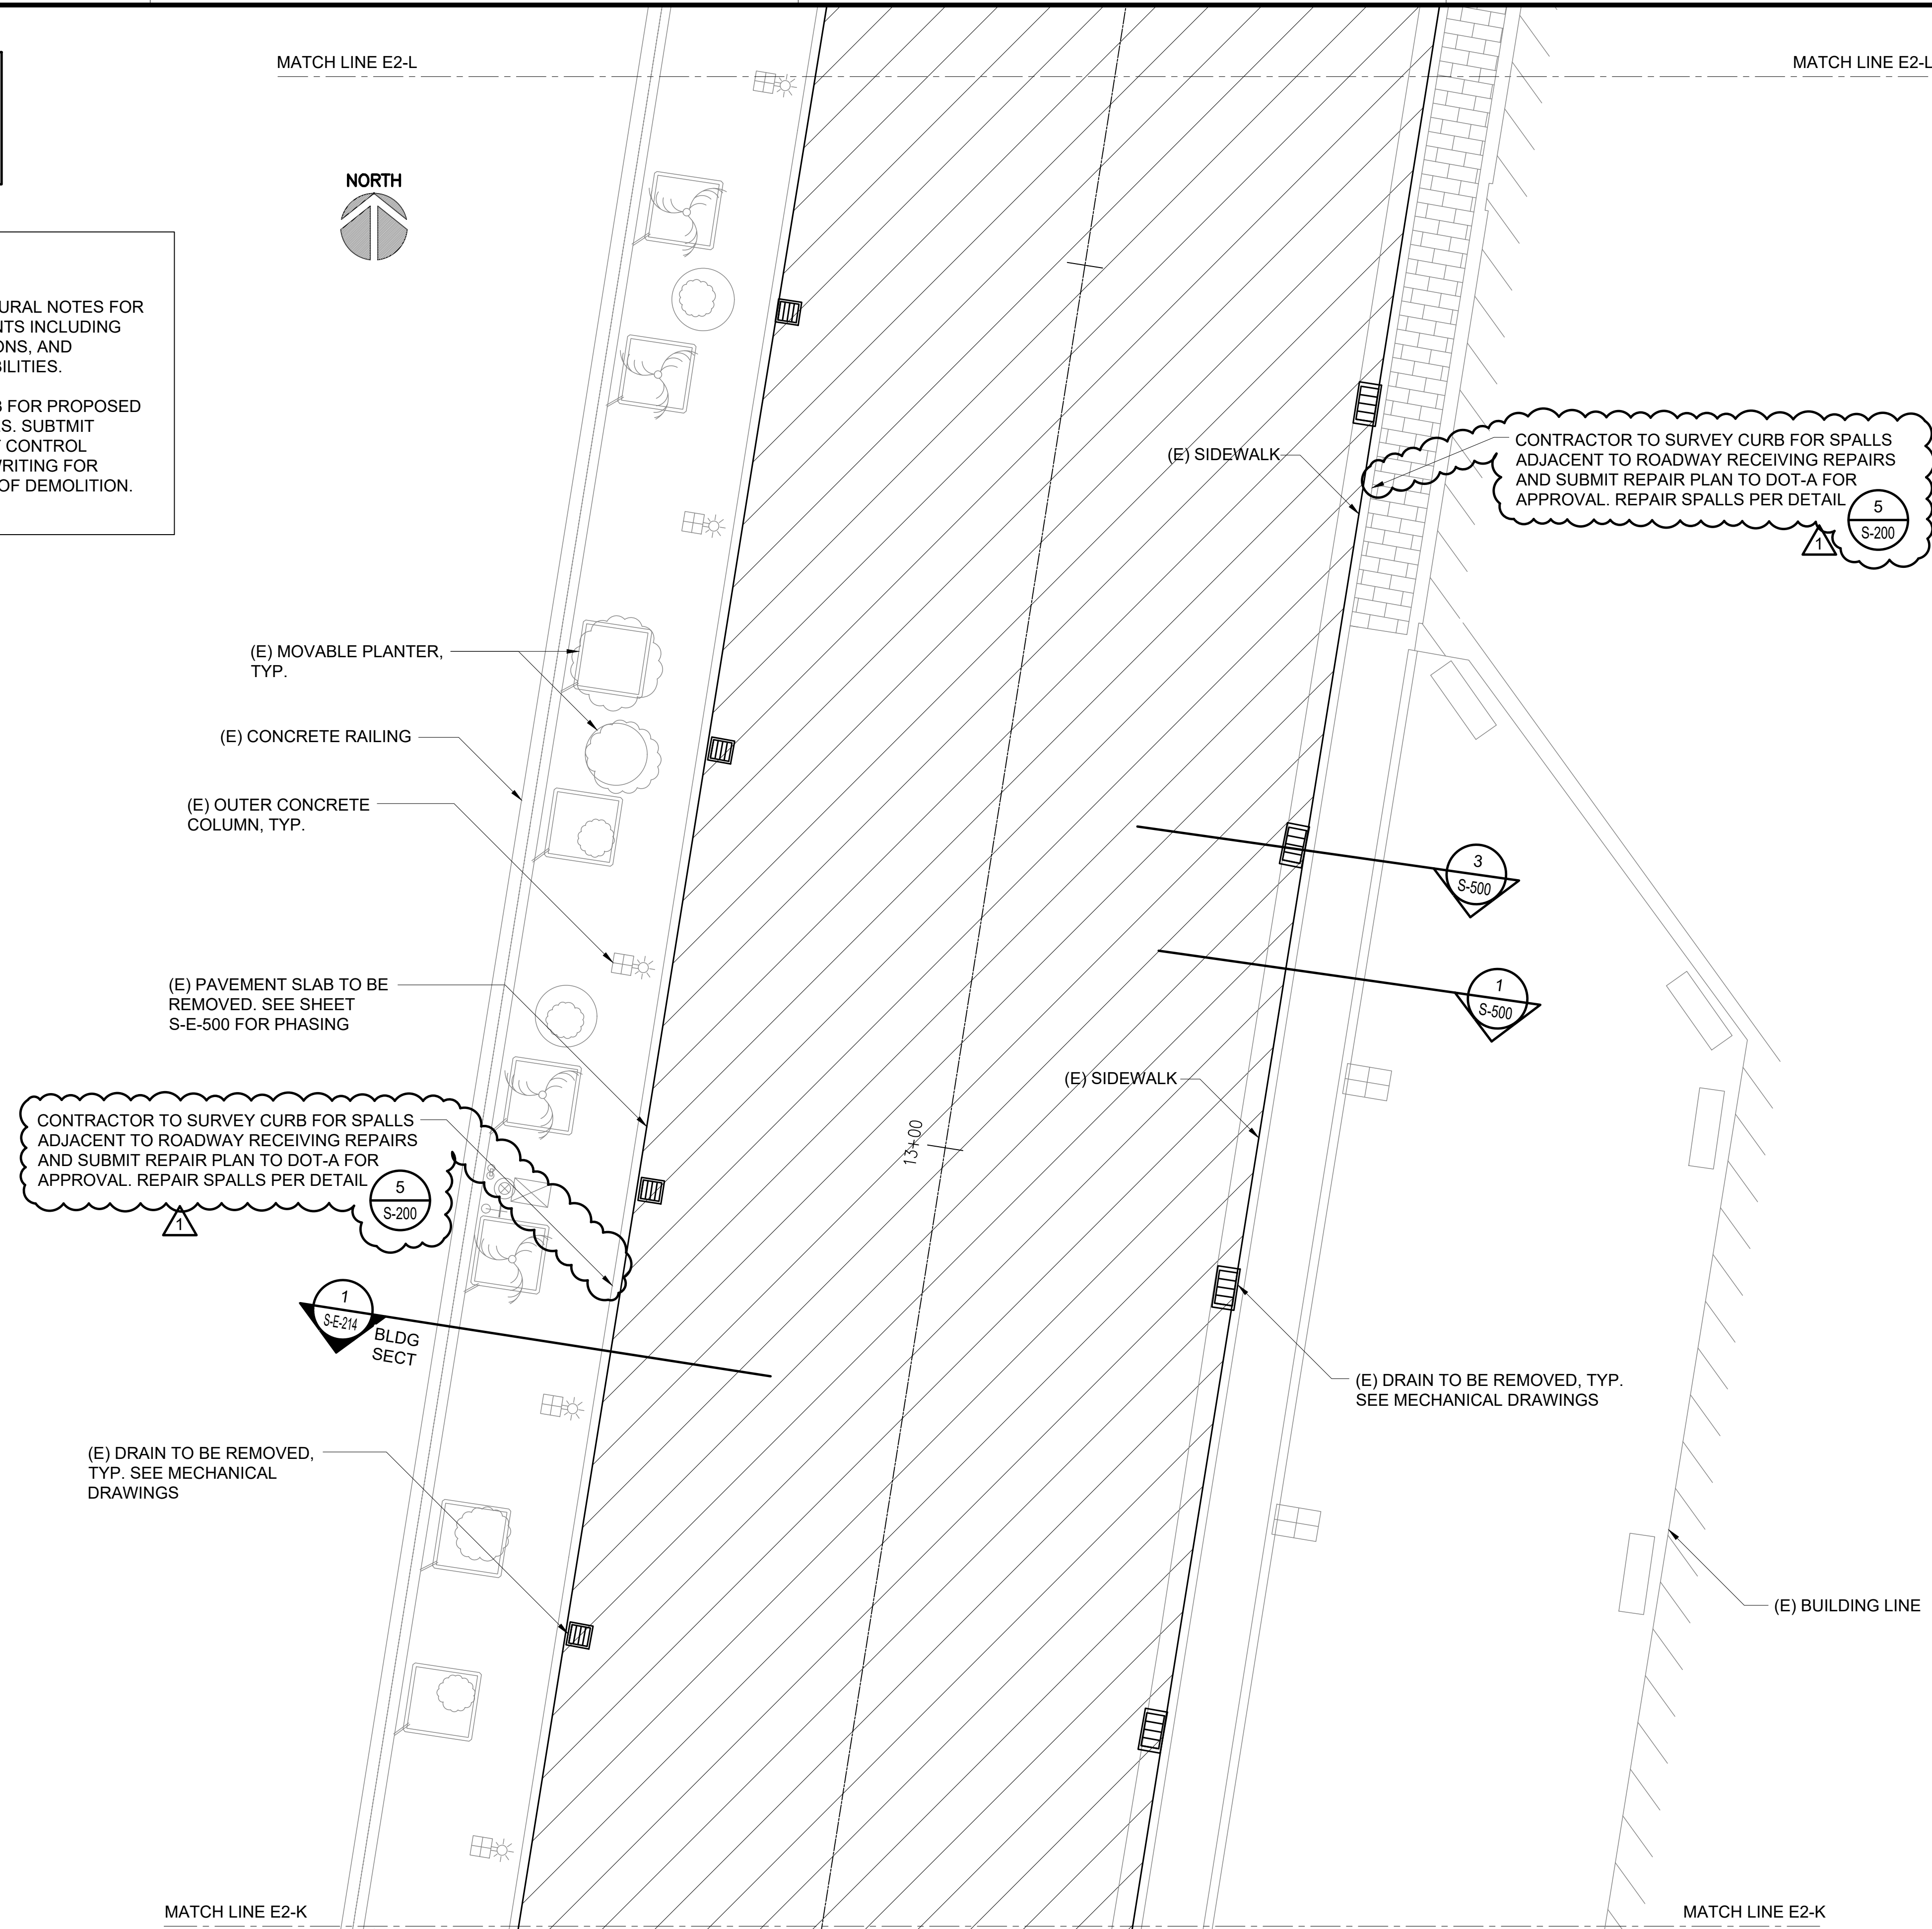


1 S-E-212

ENLARGED EWA LEVEL 2 DEMOLITION PLAN L


SCALE: 3/16" = 1'-0"

0' 2' 4' 8' 12' 16'

3/16" = 1'-0"

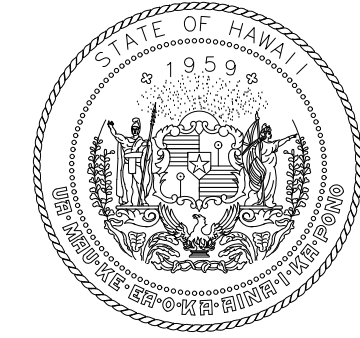

Airports Division
DEPARTMENT OF TRANSPORTATION
STATE OF HAWAII

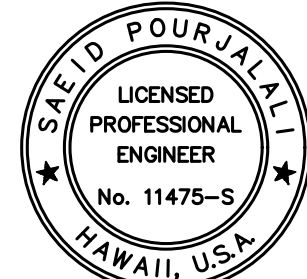


Saad Pourjafari
04/30/2024
Licensed Expiration Date

This work was prepared by me or under my supervision

DSGN.	DRWN.	CHKD.	APPD.
MG	MG	SP	

KEY PLAN / NOTES:

2ND LEVEL EWA
ROADWAY

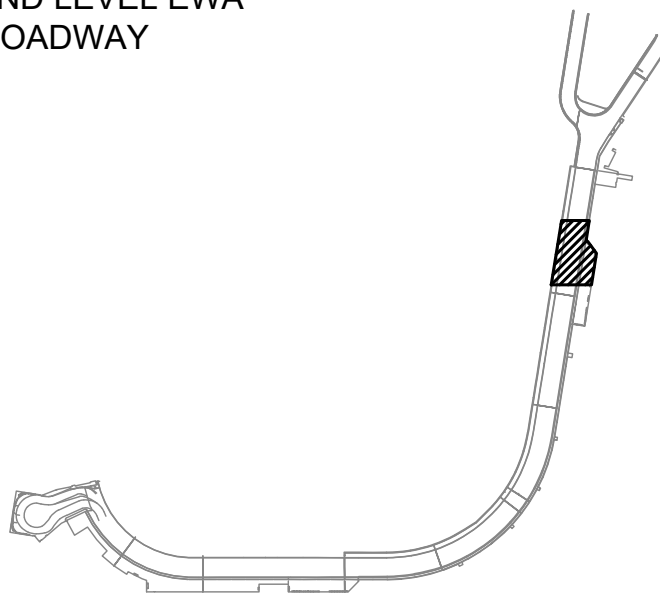

NO.	DATE	REVISIONS
1	10/20/22	ADDENDUM 1

CONSTRUCTION
DOCUMENTS

SEPTEMBER, 2022
DATE

PROJECT TITLE :

EWA AND DH CONCOURSE
ROADWAY IMPROVEMENTS
PHASE 1

AT
DANIEL K. INOUE INTERNATIONAL AIRPORT
HONOLULU, OAHU, HAWAII

PROJECT NO.:

AO1043-32

SHEET TITLE:

EWA WING - SECOND
FLOOR PARTIAL
DEMOLITION PLAN L

DATE :

SEPTEMBER, 2022

SHEET :

58 OF 247 SHEETS

DWG. NO.

S-E-212


LEGEND:

 DENOTES DEMOLITION AREA



NOTES:

1. SEE SHEET S-001 STRUCTURAL NOTES FOR DEMOLITION REQUIREMENTS INCLUDING DUST CONTROL, LIMITATIONS, AND CONTRACTOR RESPONSIBILITIES.


2. SEE SHEET S-600 TO S-603 FOR PROPOSED DUST CONTROL MEASURES. SUBMIT PLAN-OF-ACTION OF DUST CONTROL MEASURES TO DOT-A IN WRITING FOR REVIEW PRIOR TO START OF DEMOLITION.

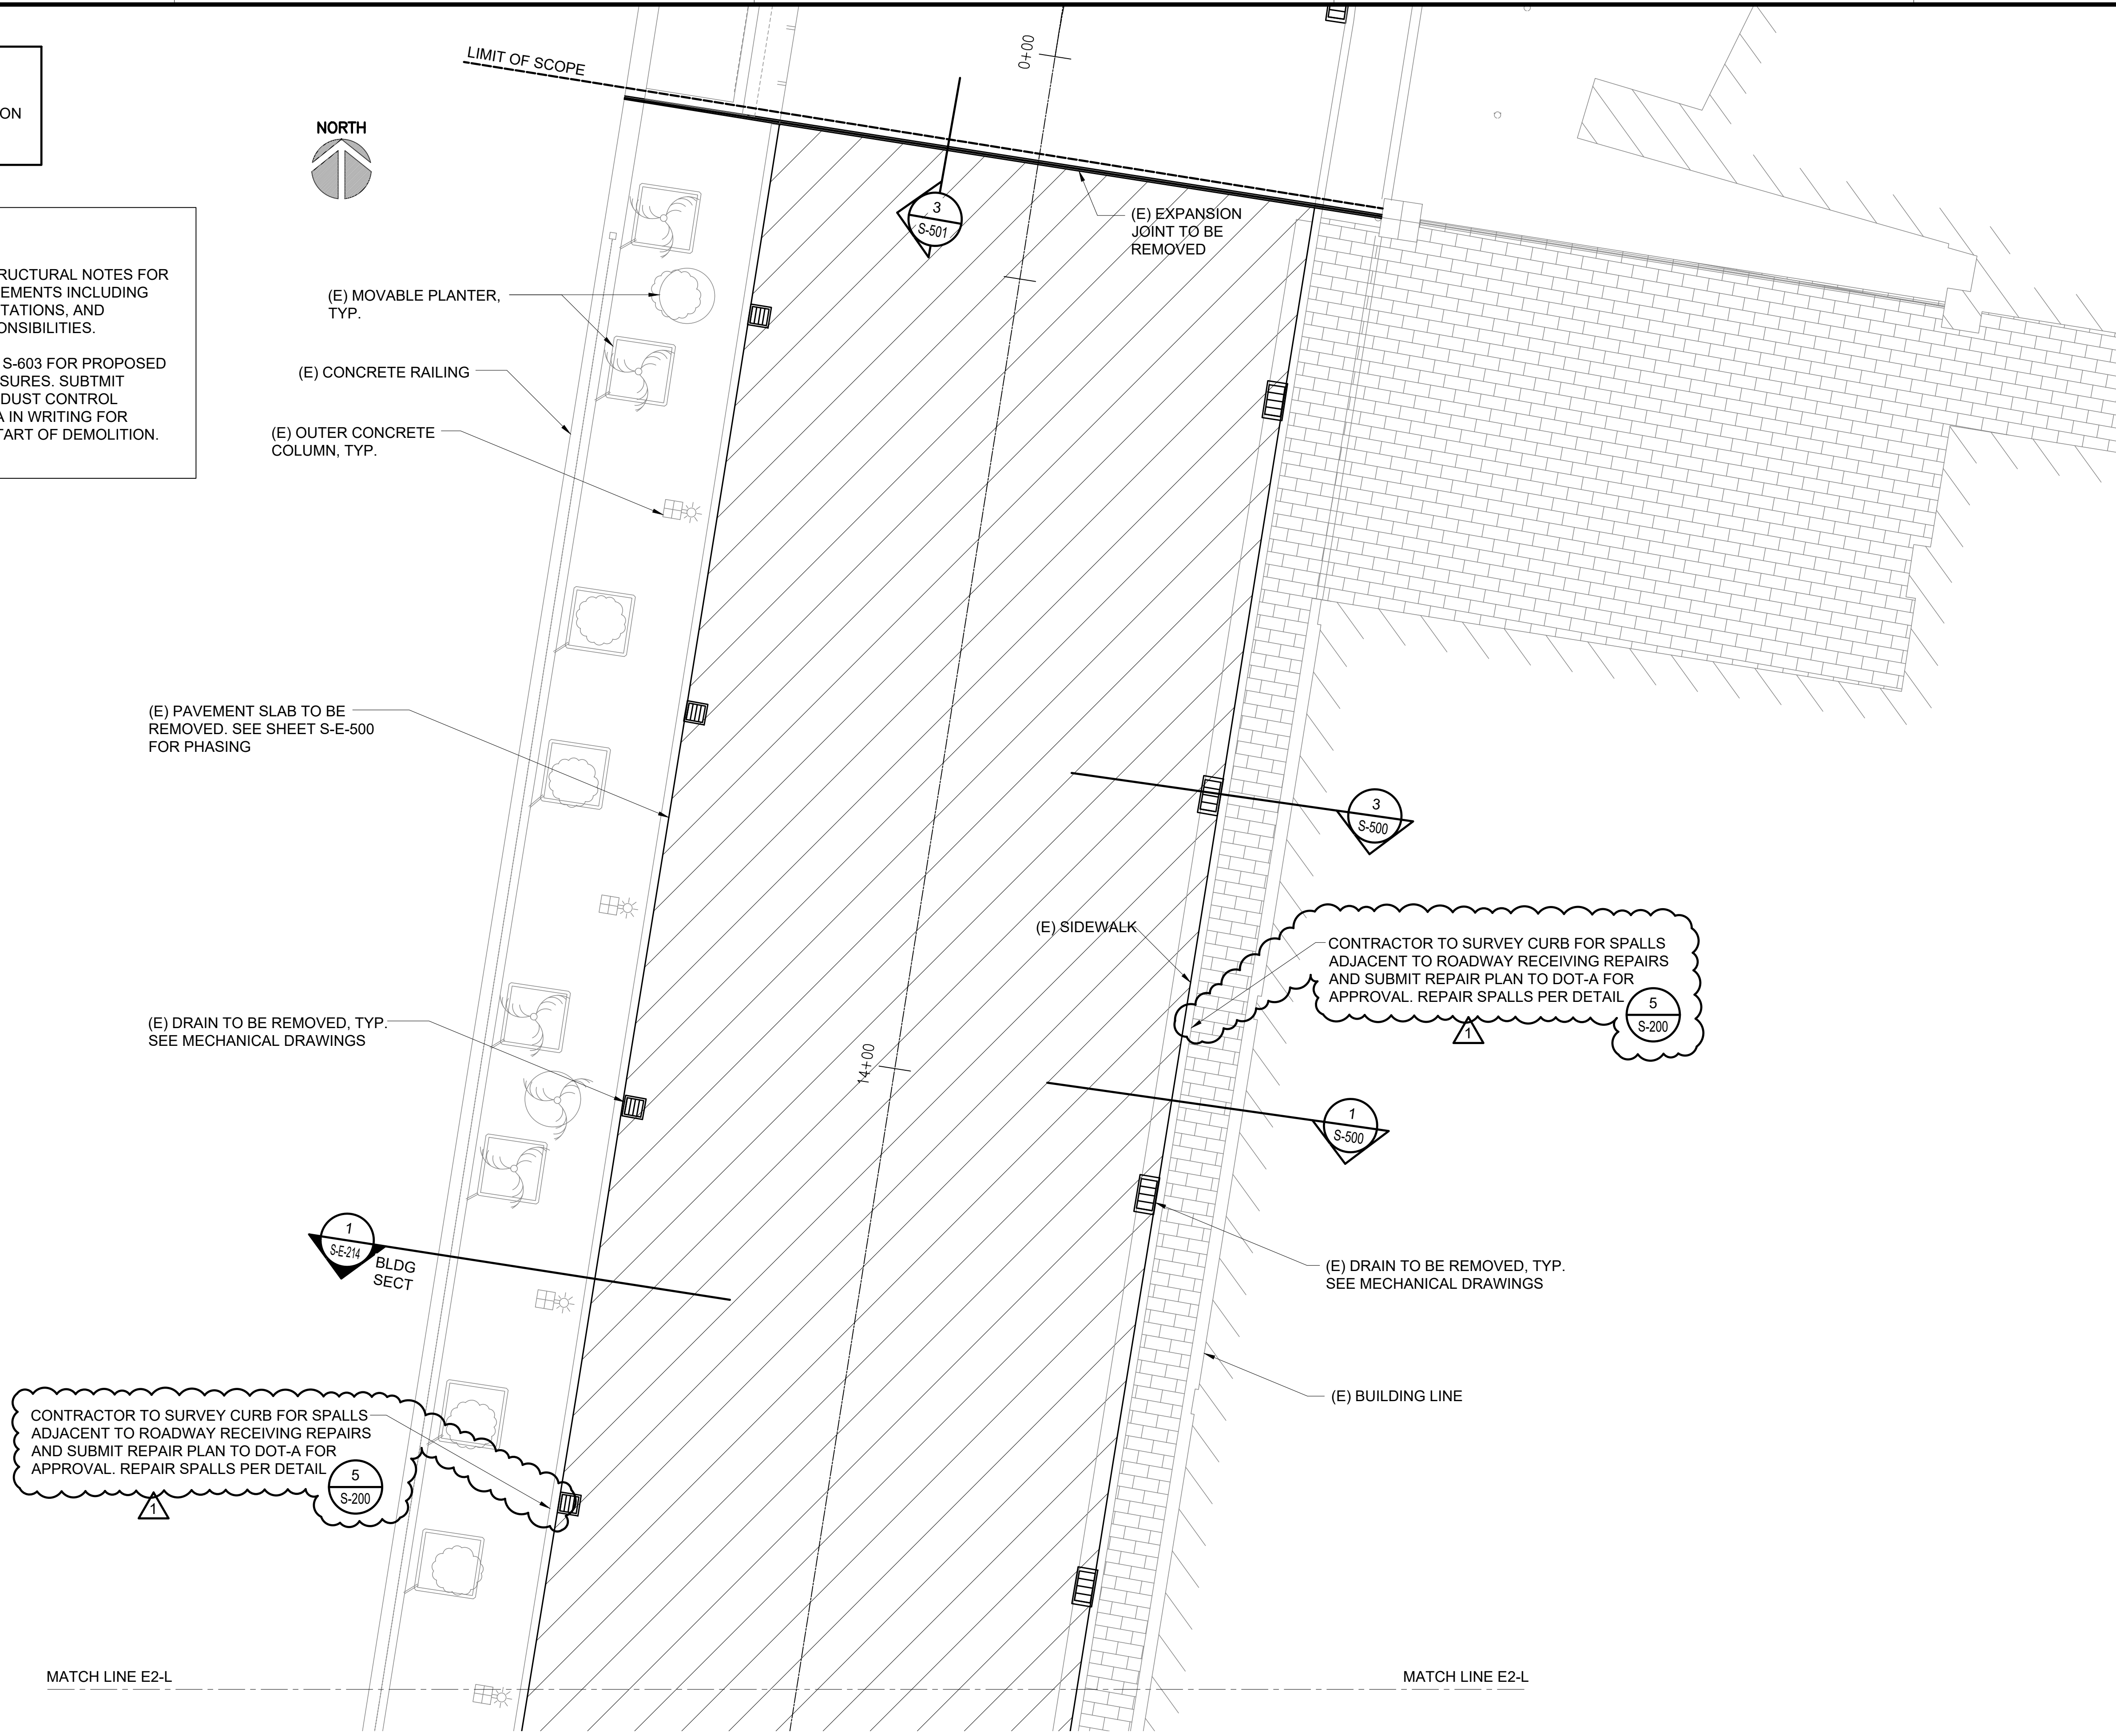

1 ENLARGED EWA LEVEL 2 DEMOLITION PLAN M
S-E-213 SCALE: 3/16" = 1'-0"

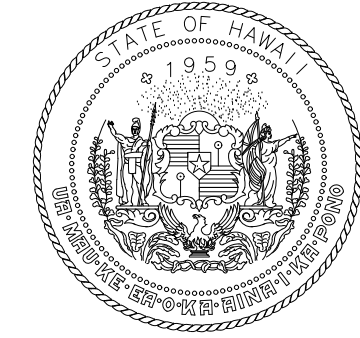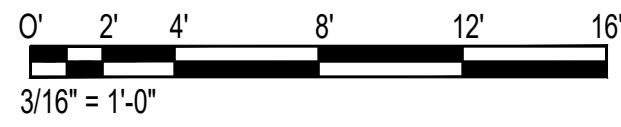

Airports Division
DEPARTMENT OF TRANSPORTATION
STATE OF HAWAII

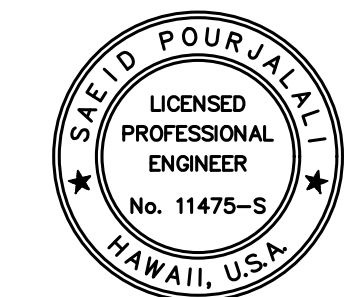


Saad Pourjafari
04/30/2024
Licensed Expiration Date

This work was prepared by me or under my supervision

DSGN.	DRWN.	CHKD.	APPD.
MG	MG	SP	

KEY PLAN / NOTES:

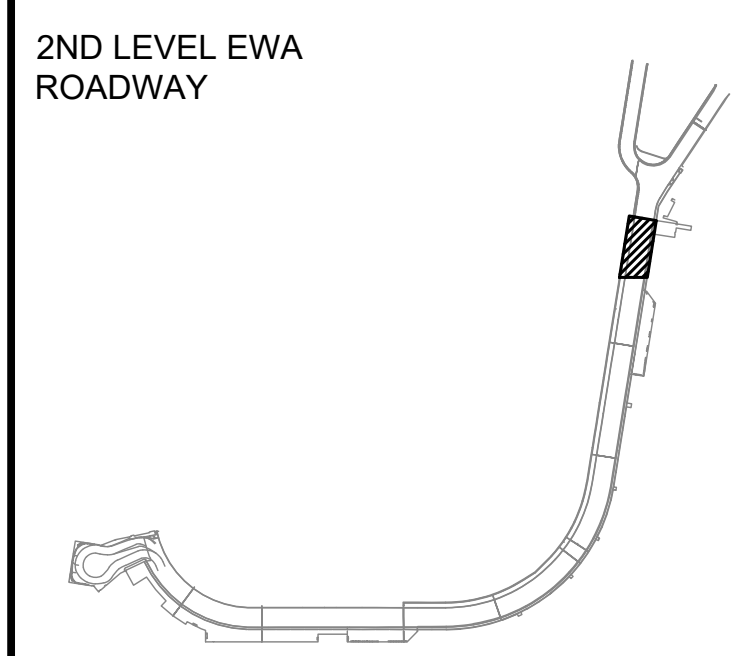

	10/20/22	ADDENDUM 1
NO.	DATE	REVISIONS

CONSTRUCTION DOCUMENTS
SEPTEMBER, 2022
DATE

PROJECT TITLE :

**EWA AND DH CONCOURSE
ROADWAY IMPROVEMENTS
PHASE 1**
AT
DANIEL K. INOUE INTERNATIONAL AIRPORT
HONOLULU, OAHU, HAWAII

PROJECT NO.:

A01043-32

SHEET TITLE:

**EWA WING - SECOND
FLOOR PARTIAL
DEMOLITION PLAN M**

DATE :	DWG. NO.
SEPTEMBER, 2022	S-E-213
SHEET :	
59 OF 247 SHEETS	